
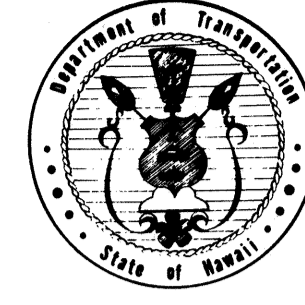


| INDEX TO DRAWINGS | |
|----------------------|---|
| SHEET NO. | DESCRIPTION |
| 1 | TITLE SHEET |
| 2 | LEGEND & MISCELLANEOUS NOTES |
| 3-4 | EQUIPMENT LIST |
| INTERSECTION DETAILS | |
| 5-6 | ALA MOANA BLVD.-JOHN ENA RD. |
| 7-8 | " - HOBRON LANE |
| 9-10 | NIMITZ HWY - FORT ST. |
| 11 | " - RIVER ST. |
| 12 | " - PACIFIC ST. (MAUKA) |
| 13 | " - PACIFIC ST. (MAKAI) |
| 14 | " - HAWAIIAN PINE GATE |
| 15-17 | " - WAIKAMILO RD. |
| 18-20 | " - KALIHI ST. |
| 21-23 | " - MOKAUEA ST. |
| 24-25 | " - PUUHALE RD. |
| 26-27 | " - SAND ISLAND ACC. RD. |
| 28-29 | KAMEHAMEHA HWY - HALAWA GATE |
| 30-31 | " - HONOMANU ST. |
| 32-33 | " - WAIMANO HOME RD. |
| 34 | FARRINGTON HWY - KUNIA RD. |
| 35 | WILIKINA DR. - KUNIA RD. |
| 36-37 | VINEYARD BLVD. - PALAMA ST. |
| 38-39 | " - PUA LANE |
| 40-41 | " - LILIHA ST. |
| 42-43 | LIKELIKE HWY - KULA KOLEA DR. |
| 44-46 | " - KAMEHAMEHA HWY |
| 47 | KAMEHAMEHA HWY - PALI HWY |
| 48 | KALANIANAOLE HWY - KAILUA RD. |
| 49 | " - EAST HALEMAU - MAU ST. |
| 50-51 | " - AINA KOA DR. |
| 52-53 | KAMEHAMEHA HWY - MAKALAPA GATE INTERCONNECTING CONDUIT AND CABLE NIMITZ HIGHWAY |
| 54-57 | VINEYARD BLVD. |
| 61-67 | TYPICAL DETAILS |
| 68-79 | STANDARD DETAILS |

LT. J.T. DESIGNED BY
 D. BEVIER
 P. S. & E. BY
 548-7537 PHONE
 Sept. 20, 1977 DATE

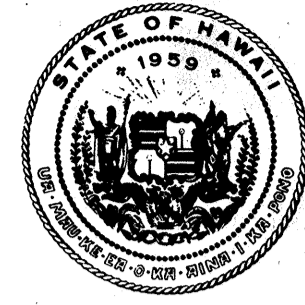

STATE OF HAWAII
 DEPARTMENT OF TRANSPORTATION
 LAND TRANSPORTATION FACILITIES DIVISION

HONOLULU, HAWAII

"AS BUILT"
 PLANS TO

**UPGRADE EXISTING TRAFFIC SIGNALS
 AT VARIOUS LOCATIONS, OAHU**



FEDERAL AID PROJECT NO. TQF-0300(6)

ISLAND OF OAHU

NOTE:

WHEREVER THE PROJECT NO. HWY-0-03-75
 APPEARS IN THESE PLANS, IT SHALL BE
 AMENDED TO READ "FEDERAL AID PROJECT
 NO. TQF-0300(6)".

| FED. ROAD DIST. NO. | STATE | FED. AID PROJ. NO. | FISCAL YEAR | SHEET NO. | TOTAL SHEETS |
|---------------------|-------|--------------------|-------------|-----------|--------------|
| HAWAII | HAW. | TQF-0300(6) | 1978 | 1 | 79 |

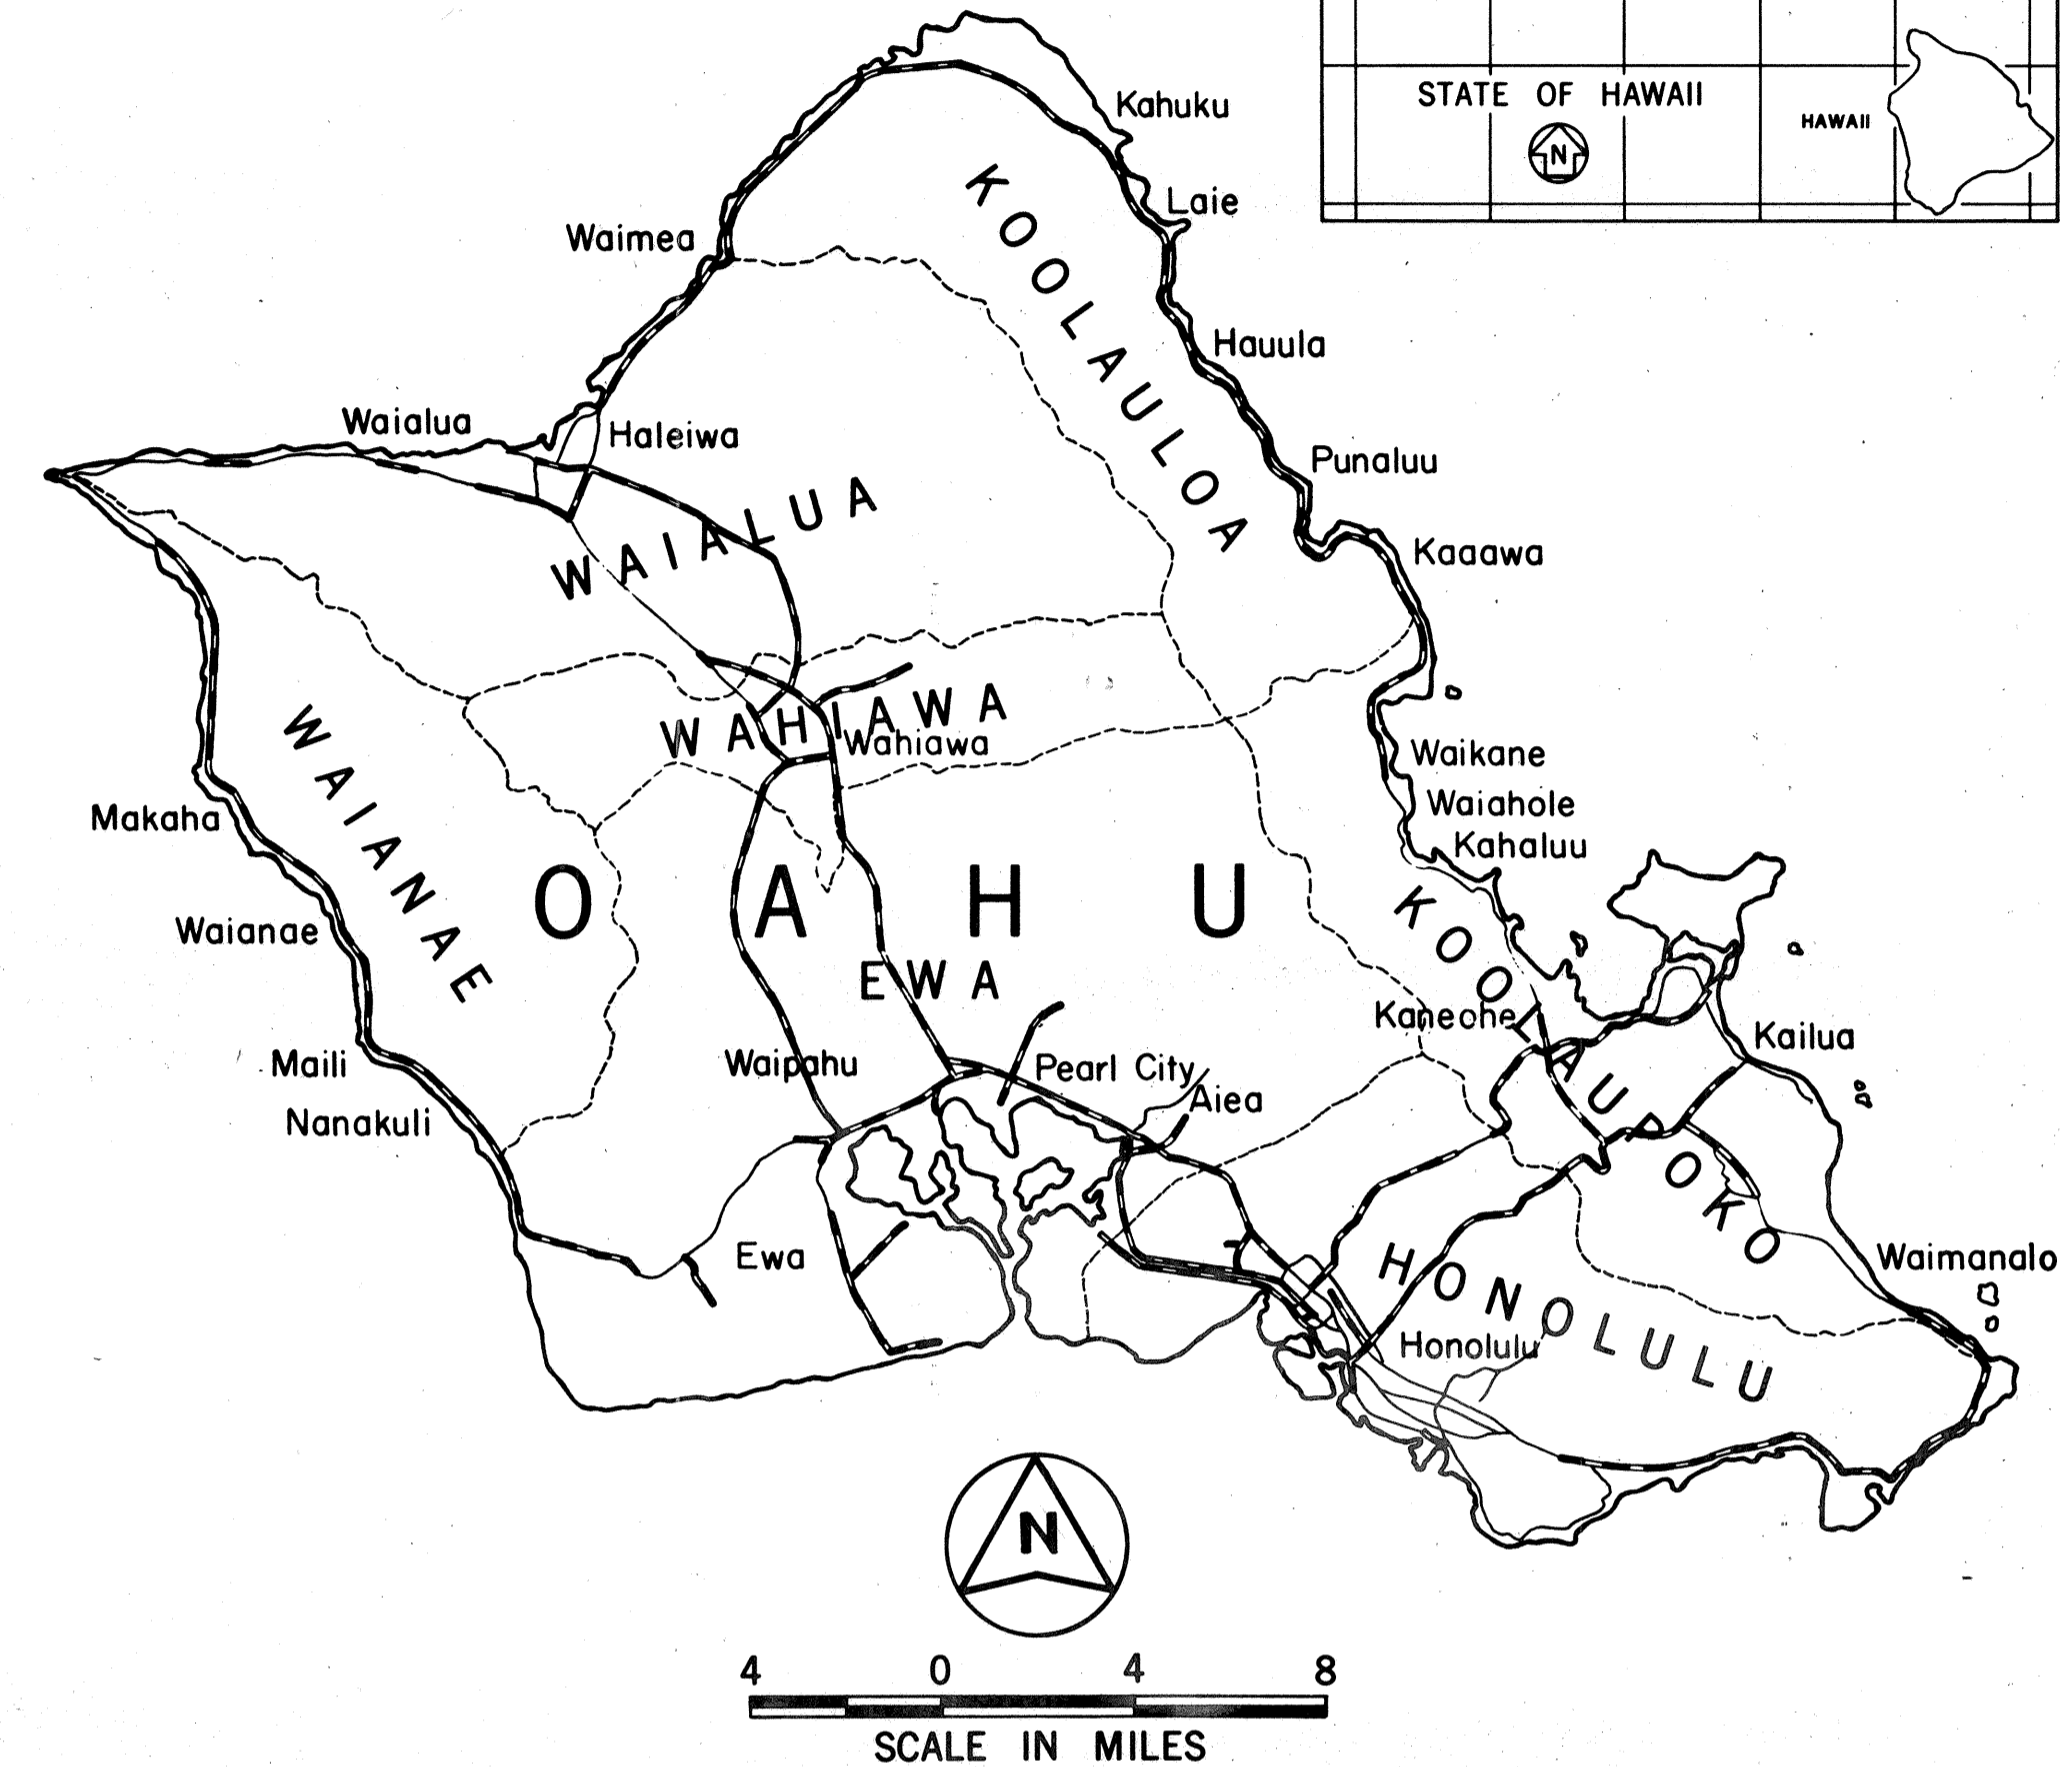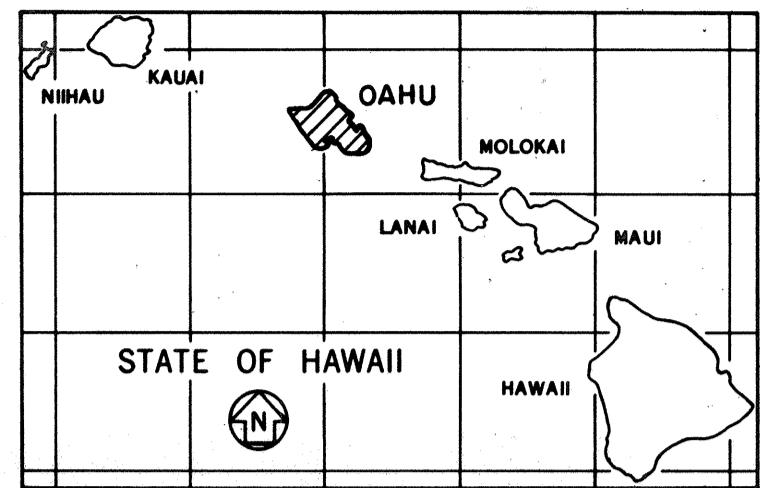

FEDERAL AID PROJECTS PREVIOUSLY CONSTRUCTED OR UNDER CONSTRUCTION

ALL CHANGES MADE DURING CONSTRUCTION
 HAVE BEEN INCORPORATED ON THESE PLANS
 EXCEPT CHANGES IN THE ORIGINAL
 THEORETICAL QUANTITIES.

Phil Alencastre
 PHIL ALENCASTRE
 PROJECT ENGINEER

DEPARTMENT OF TRANSPORTATION
 FEDERAL HIGHWAY ADMINISTRATION
 APPROVED:

 DIVISION ADMINISTRATOR DATE 9.29.77

DEPARTMENT OF TRANSPORTATION
 STATE OF HAWAII
 APPROVED:

 DIR. OF TRANSPORTATION DATE 9/20/77

#240-2 (as built)

D.D.-D-5-5