


FED. ROAD DIST. NO.	STATE	FED. AID PROJ. NO.	FISCAL YEAR	SHEET NO.	TOTAL SHEETS
HAWAII	HAW.	M-7600(1)	1978	5	198

SURVEY PLOTTED BY	DATE
DRAWN BY	
TRACED BY	
CHECKED BY	
NOTE BOOK	
QUANTITIES BY	
CHECKED BY	
No.	

CURVE DATA TABLE					
NO.	N COORDINATE	E COORDINATE	DATA		
520	PC	79823.84	488,266.35	Δ	1°-49'-50.7"
	PT	79570.75	488,460.08	R	10,000.00
	CC	73635.42	480,411.98	L	319.53
	PI	79699.34	488,365.25	T	159.78

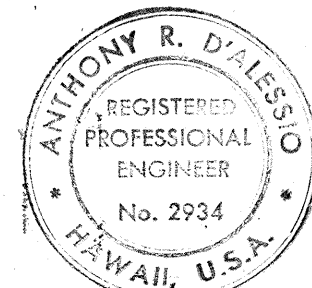


THIS WORK WAS PREPARED BY
ME OR UNDER MY SUPERVISION.
A.R. D'Alessio

STATE OF HAWAII
DEPARTMENT OF TRANSPORTATION
HIGHWAYS DIVISION

ALIGNMENT PLAN
FORT WEAVER ROAD
STA. 57+77.64 TO STA. 70+00.00
FORT WEAVER ROAD
ROUTE H-1 TO SOUTH OF
FARRINGTON HIGHWAY


SCALE: 1" = 50' DATE: AUG. 1978
SHEET NO. 1 OF 5 SHEETS

FED. ROAD DIST. NO.	STATE	FED. AID PROJ. NO.	FISCAL YEAR	SHEET NO.	TOTAL SHEETS
HAWAII	HAW.	M-7600(1)	1978	6	198

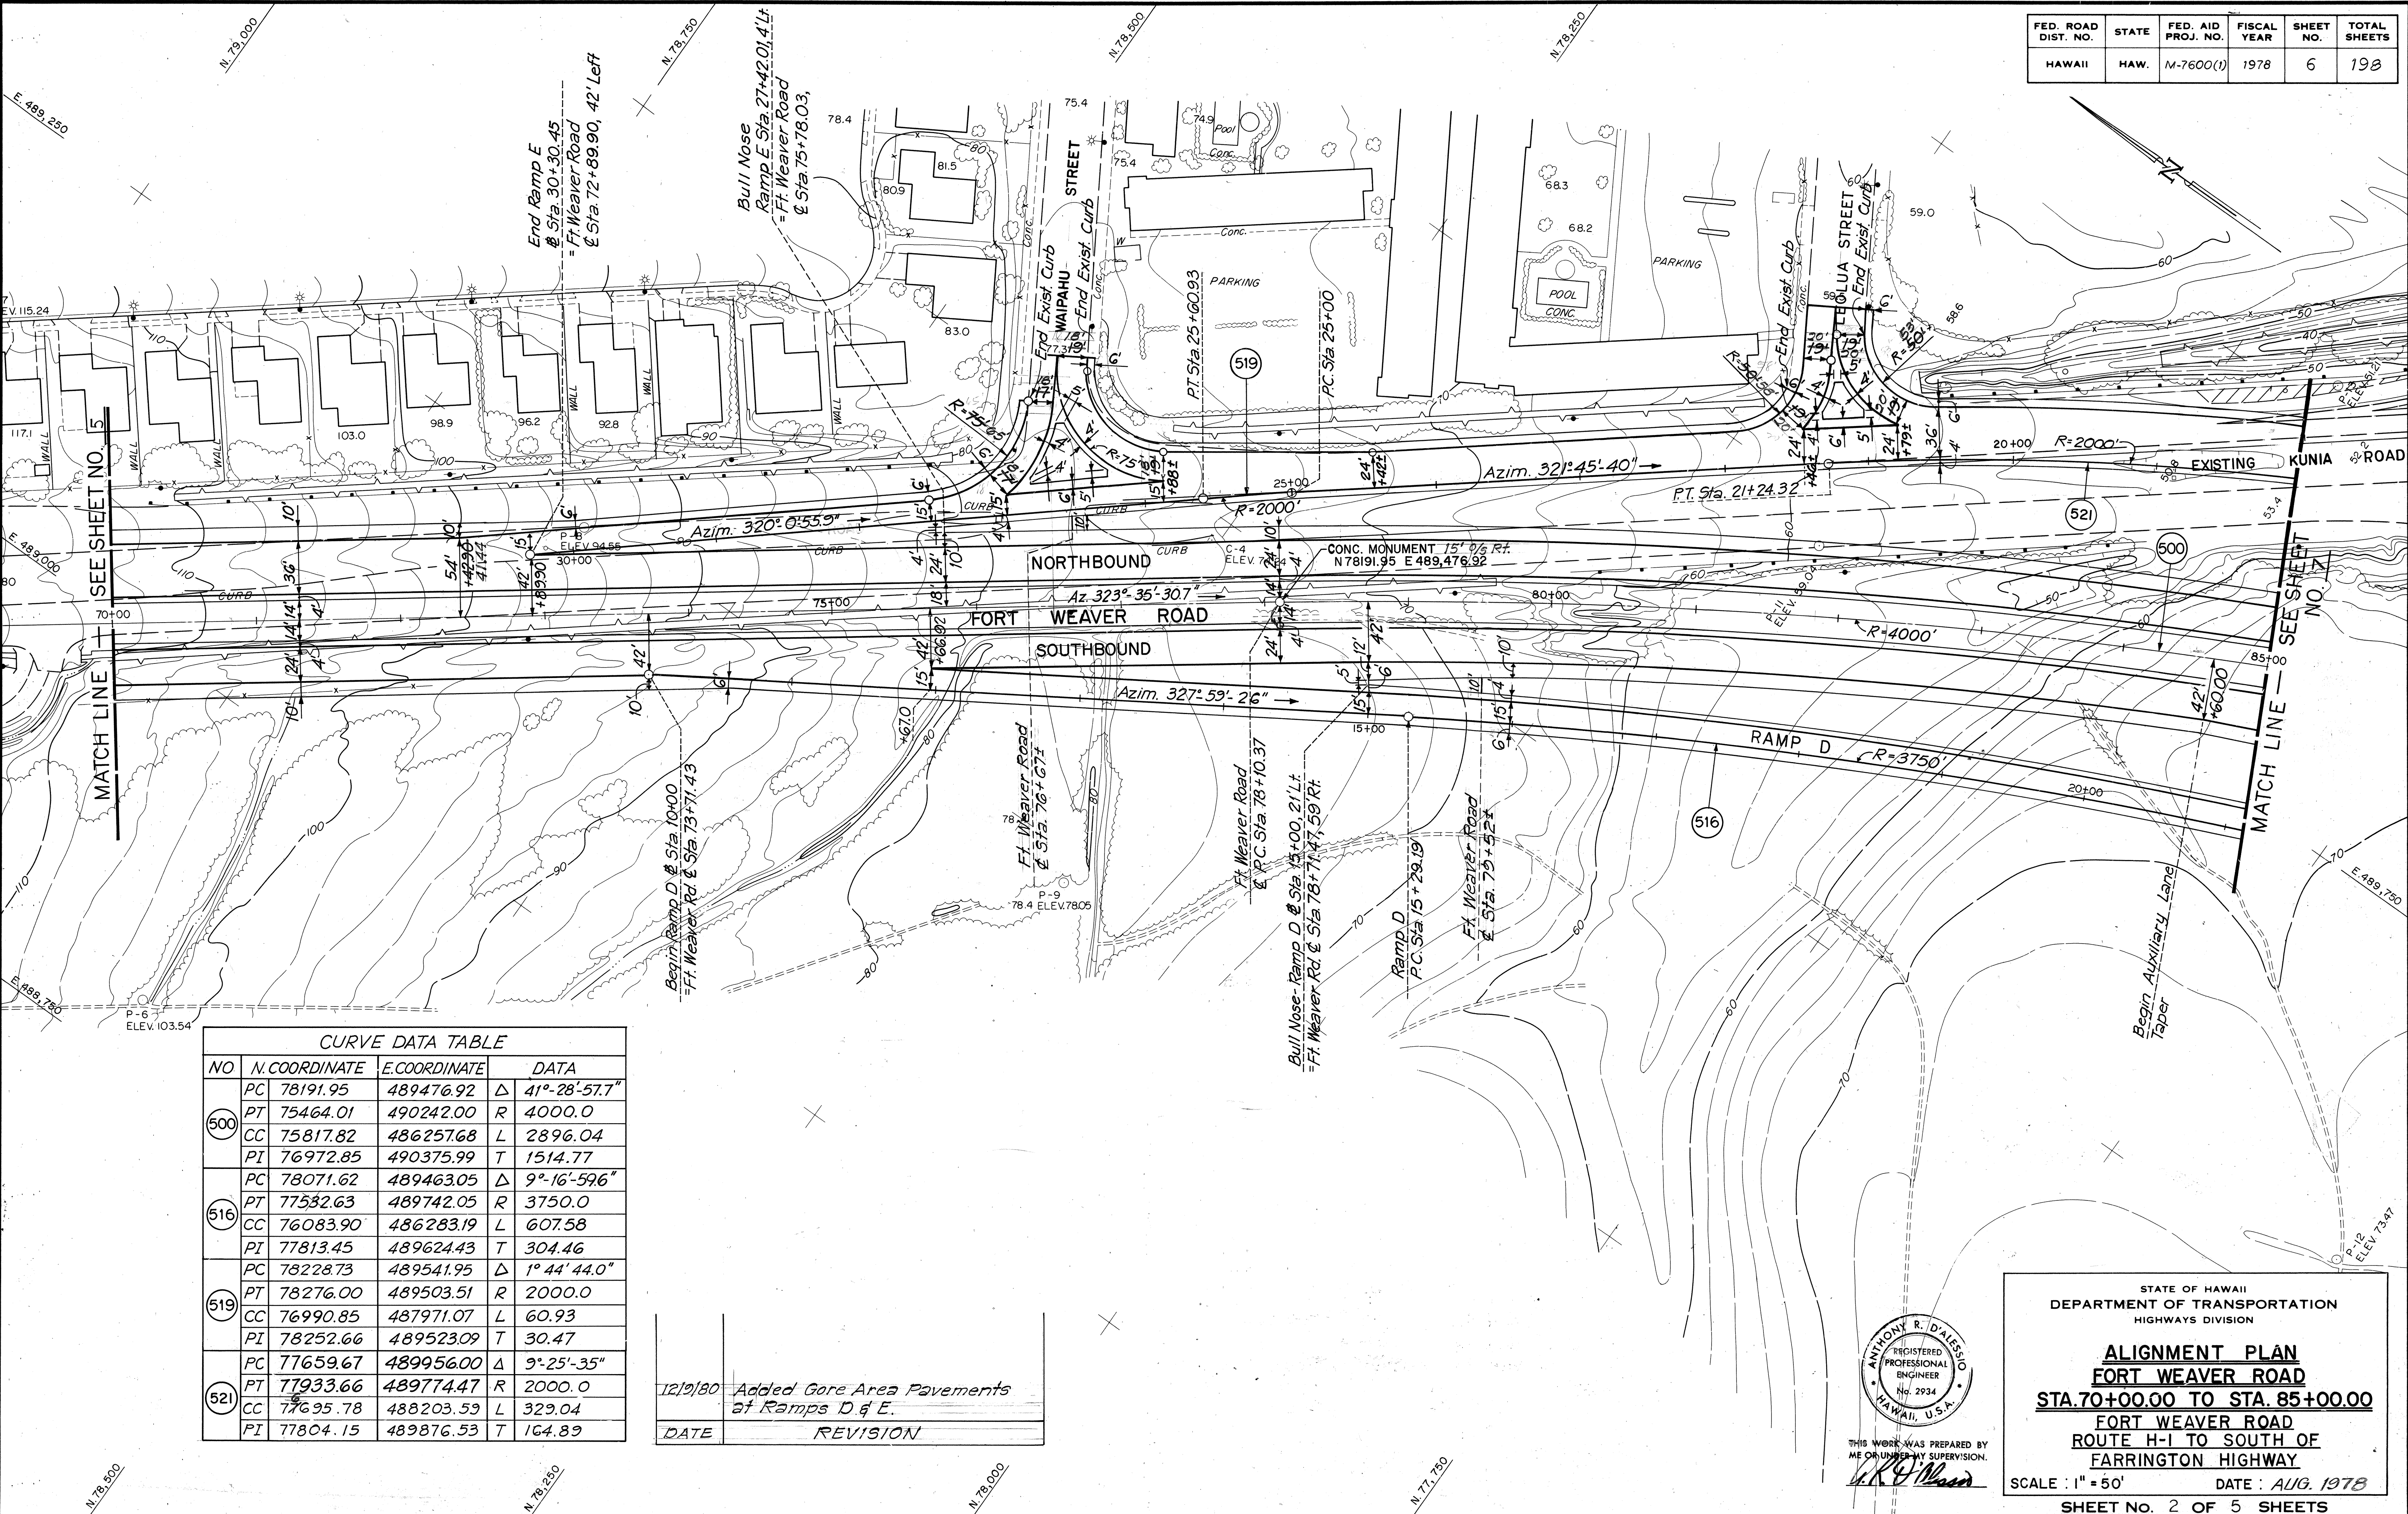

CURVE DATA TABLE				
NO	N. COORDINATE	E. COORDINATE	DATA	
(500)	PC 78191.95	489476.92	Δ	41°-28'-57.7"
	PT 75464.01	490242.00	R	4000.0
	CC 75817.82	486257.68	L	2896.04
	PI 76972.85	490375.99	T	1514.77
(516)	PC 78071.62	489463.05	Δ	9°-16'-59.6"
	PT 77532.63	489742.05	R	3750.0
	CC 76083.90	486283.19	L	607.58
	PI 77813.45	489624.43	T	304.46
(519)	PC 78228.73	489541.95	Δ	1°-44'-44.0"
	PT 78276.00	489503.51	R	2000.0
	CC 76990.85	487971.07	L	60.93
	PI 78252.66	489523.09	T	30.47
(521)	PC 77659.67	489956.00	Δ	9°-25'-35"
	PT 77933.66	489774.47	R	2000.0
	CC 77695.78	488203.59	L	329.04
	PI 77804.15	489876.53	T	164.89

12/9/80	Added Gore Area Pavements at Ramps D & E.
DATE	REVISION

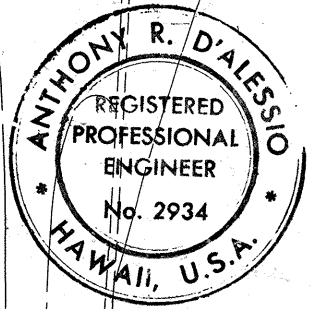

THIS WORK WAS PREPARED BY ME OR UNDER MY SUPERVISION.

STATE OF HAWAII
DEPARTMENT OF TRANSPORTATION
HIGHWAYS DIVISION


ALIGNMENT PLAN
FORT WEAVER ROAD
STA. 70+00.00 TO STA. 85+00.00
FORT WEAVER ROAD
ROUTE H-1 TO SOUTH OF
FARRINGTON HIGHWAY

SCALE: 1" = 50'
DATE: AUG. 1978
SHEET NO. 2 OF 5 SHEETS

SURVEY PLOTTED BY	DATE
DRAWN BY	
TRACED BY	
CHECKED BY	
NOTE BOOK	
NO.	

FED. ROAD DIST. NO.	STATE	FED. AID PROJ. NO.	FISCAL YEAR	SHEET NO.	TOTAL SHEETS
HAWAII	HAW.	M-7600(1)	1978	7	198

CURVE DATA TABLE				
NO.	N.COORDINATE	E.COORDINATE	DATA	
504	PC 77078.45	489996.90	Δ	22°57'39.9"
	PT 76782.22	490034.06	R	750.0
	CC 76838.85	489286.20	L	300.56
	PI 76934.11	490045.56	T	152.32
505	PC 76782.22	490034.06	Δ	212°41'56.4"
	PT 76917.76	489674.96	R	200.0
	CC 76797.32	489834.63	L	742.46
	PI	N/A	T	N/A
506	PC 76917.76	489674.96	Δ	20°18'54.6"
	PT 77013.65	489778.46	R	400.0
	CC 76676.87	489994.30	L	141.83
	PI 76974.98	489718.12	T	71.67
514	PC 76762.52	488973.18	Δ	12°09'42"
	PT 76997.05	489532.97	R	2864.79
	CC 79507.19	488152.30	L	608.08
	PI 76849.97	489265.57	T	305.19
515	PC 76602.41	488291.11	Δ	27°34'00"
	PT 76942.23	489556.76	R	2750.2
	CC 79351.96	488231.32	L	1323.20
	PI 76617.07	488965.61	T	674.67
517	PC 77532.63	489742.05	Δ	76°33'31"
	PT 77114.86	489625.78	R	350.0
	CC 77397.41	489419.22	L	467.67
	PI 77277.87	489848.76	T	276.21
518	PC 77114.86	489625.78	Δ	11°47'52.8"
	PT 76829.94	489137.57	R	2750.0
	CC 79334.92	488002.86	L	566.26
	PI 76947.18	489396.39	T	284.14

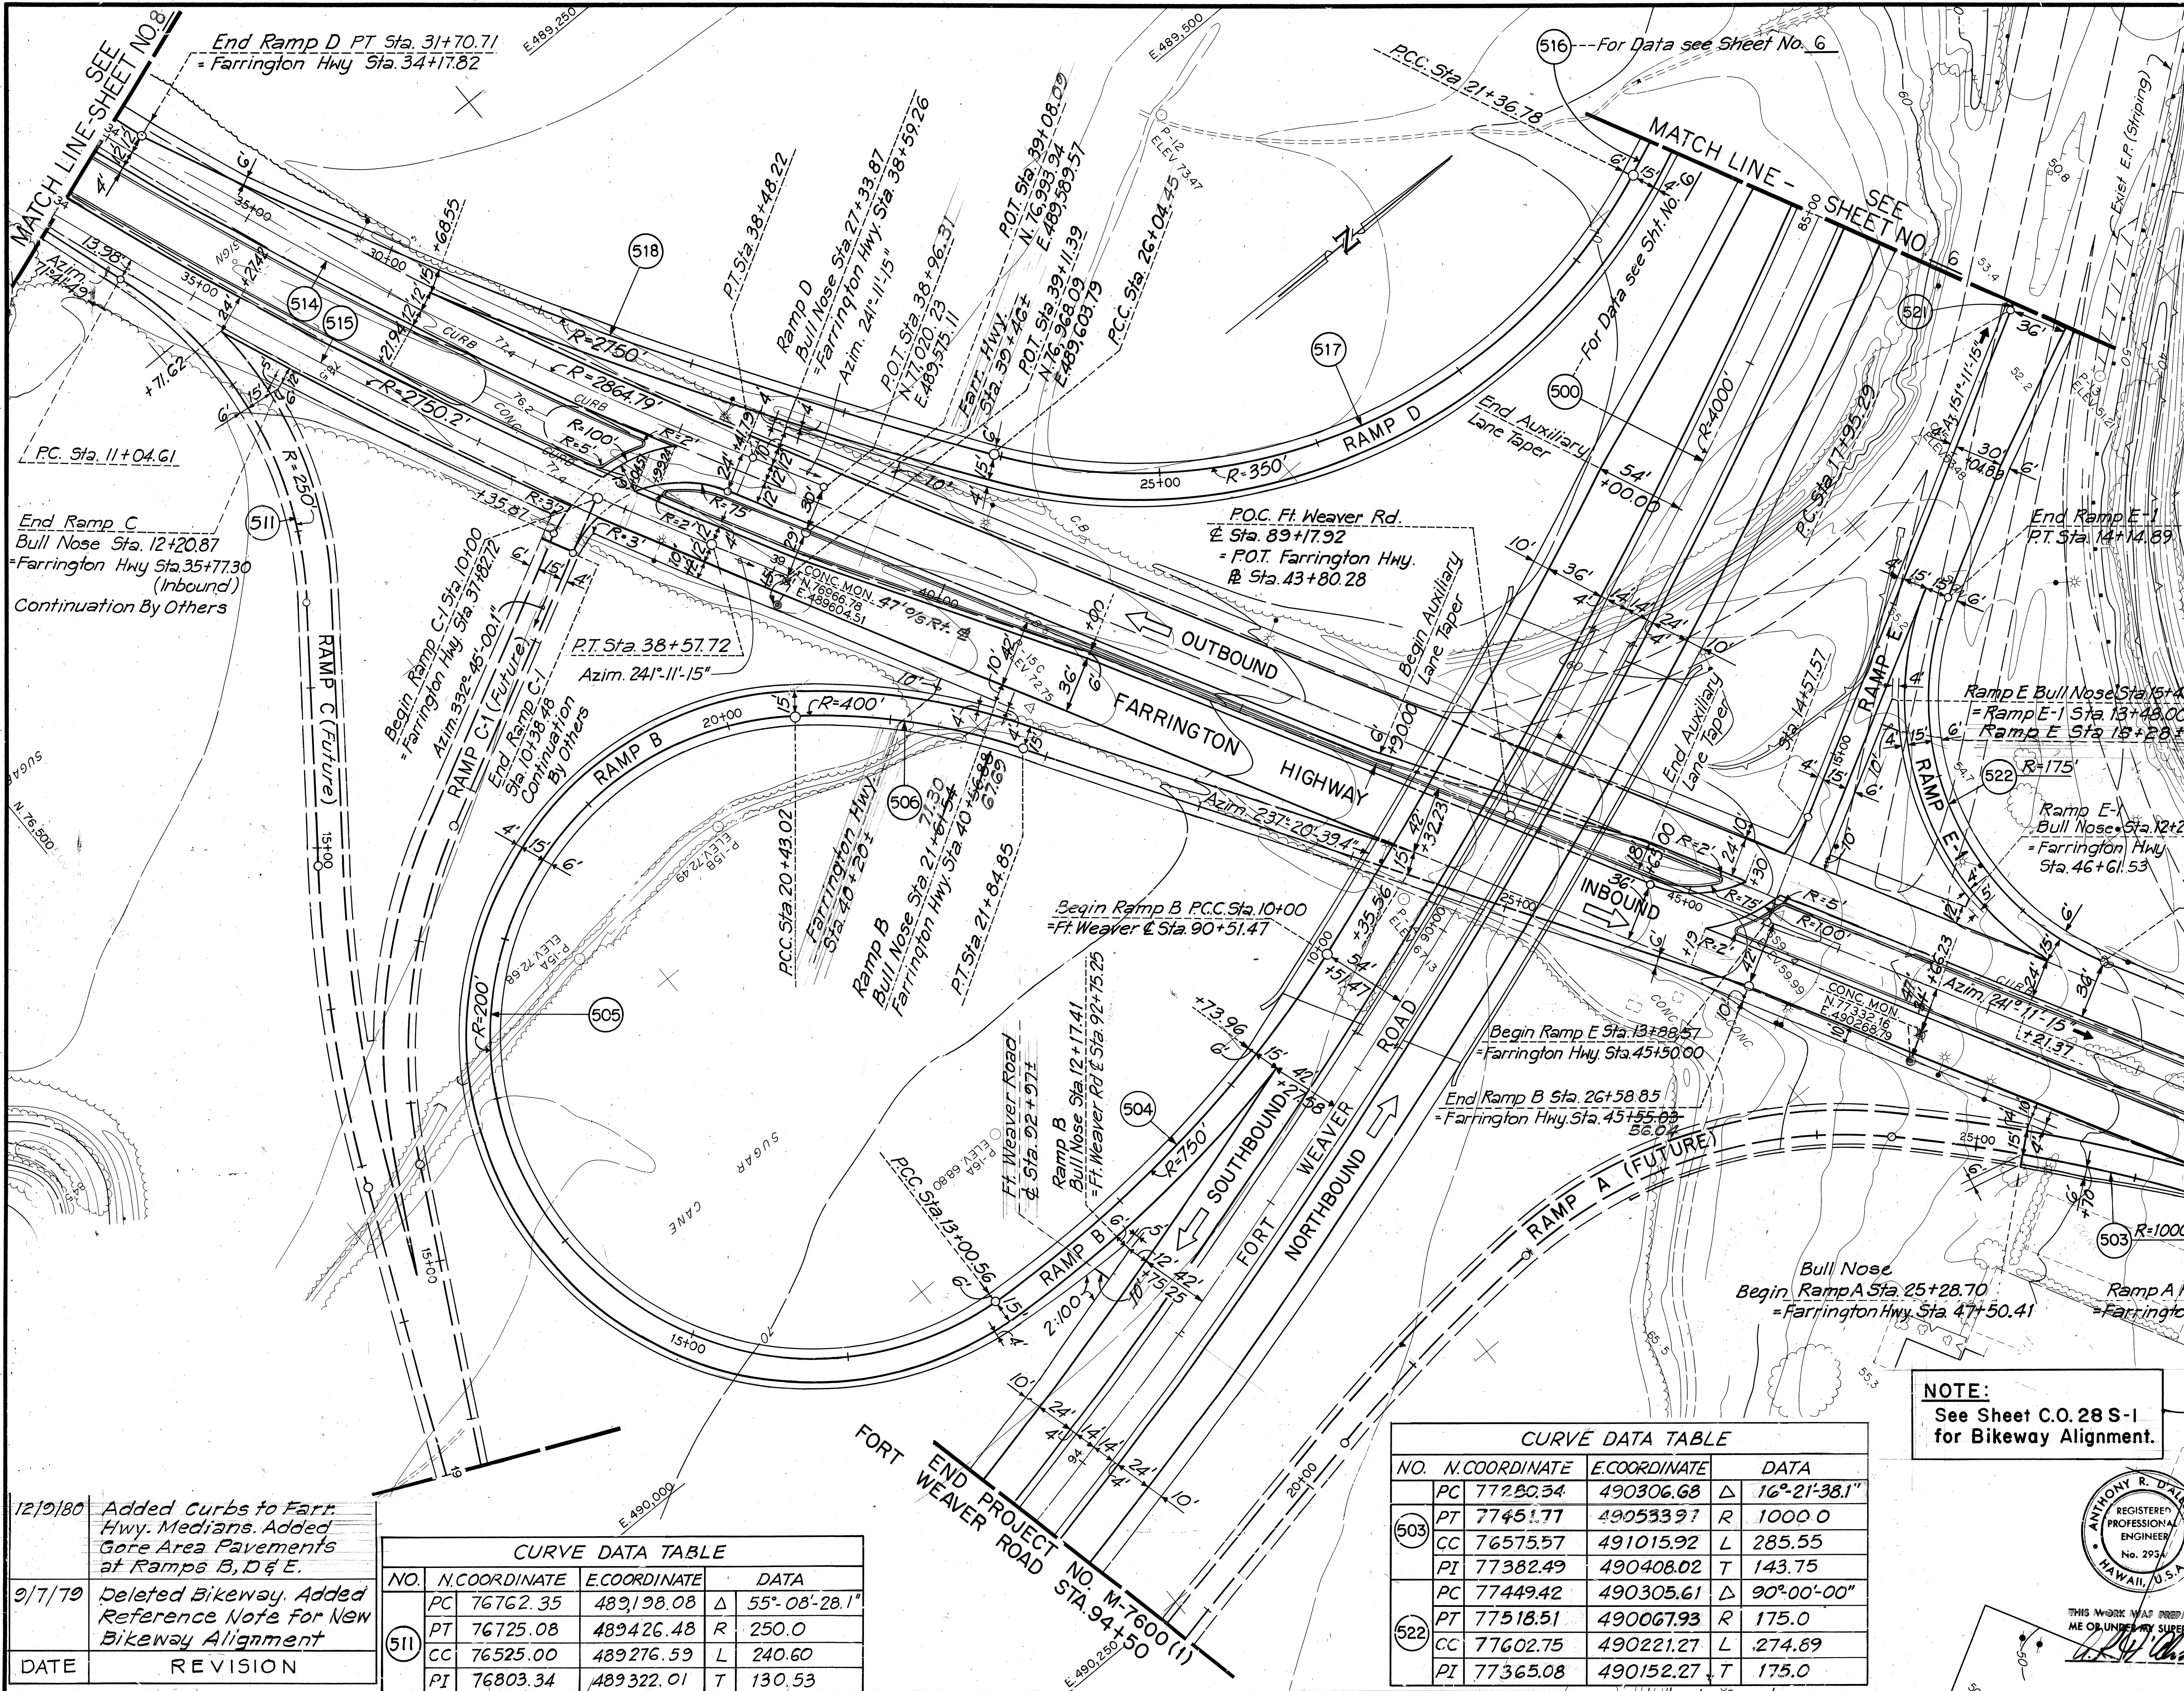

DATE	12/9/80
ORIGINAL PLAN	Added Curbs to Farr. Hwy. Medians. Added Gate Area Pavements at Ramps B, D & E.
TRACED BY	9/7/79
NOTED BY	Deleted Bikeway. Added Reference Note for New Bikeway Alignment
CHECKED BY	
NO.	

CURVE DATA TABLE			
NO.	N.COORDINATE	E.COORDINATE	DATA
511	PC 76762.35	489198.08	Δ 55°08'28.1"
	PT 76725.08	489426.48	R 250.0
	CC 76525.00	489276.59	L 240.60
	PI 76803.34	489322.01	T 130.53

CURVE DATA TABLE			
NO.	N.COORDINATE	E.COORDINATE	DATA
503	PC 77250.34	490306.68	Δ 16°21'38.1"
	PT 77451.77	490533.97	R 1000.0
	CC 76575.57	491015.92	L 285.55
	PI 77382.49	490408.02	T 143.75
522	PC 77449.42	490305.61	Δ 90°00'00"
	PT 77518.51	490067.93	R 175.0
	CC 77602.75	490221.27	L 274.69
	PI 77365.08	490152.27	T 175.0

NOTE:
See Sheet C.O. 28 S-1
for Bikeway Alignment.


ANTHONY R. DAVIS
REGISTERED PROFESSIONAL ENGINEER
No. 2934
HAWAII, U.S.A.

STATE OF HAWAII
DEPARTMENT OF TRANSPORTATION
HIGHWAYS DIVISION


ALIGNMENT PLAN
FORT WEAVER ROAD
STA. 85+00.00 TO STA. 94+50.00
FARRINGTON HIGHWAY
STA. 34+00.00 TO STA. 51+00.00
FORT WEAVER ROAD
ROUTE H-1 TO SOUTH OF
FARRINGTON HIGHWAY

SCALE: 1" = 50' DATE: AUG. 1978
SHEET NO. 3 OF 5 SHEETS

FED. ROAD DIST. NO.	STATE	FED. AID PROJ. NO.	FISCAL YEAR	SHEET NO.	TOTAL SHEETS
HAWAII	HAW.	M-7600(1)	1978	8	198

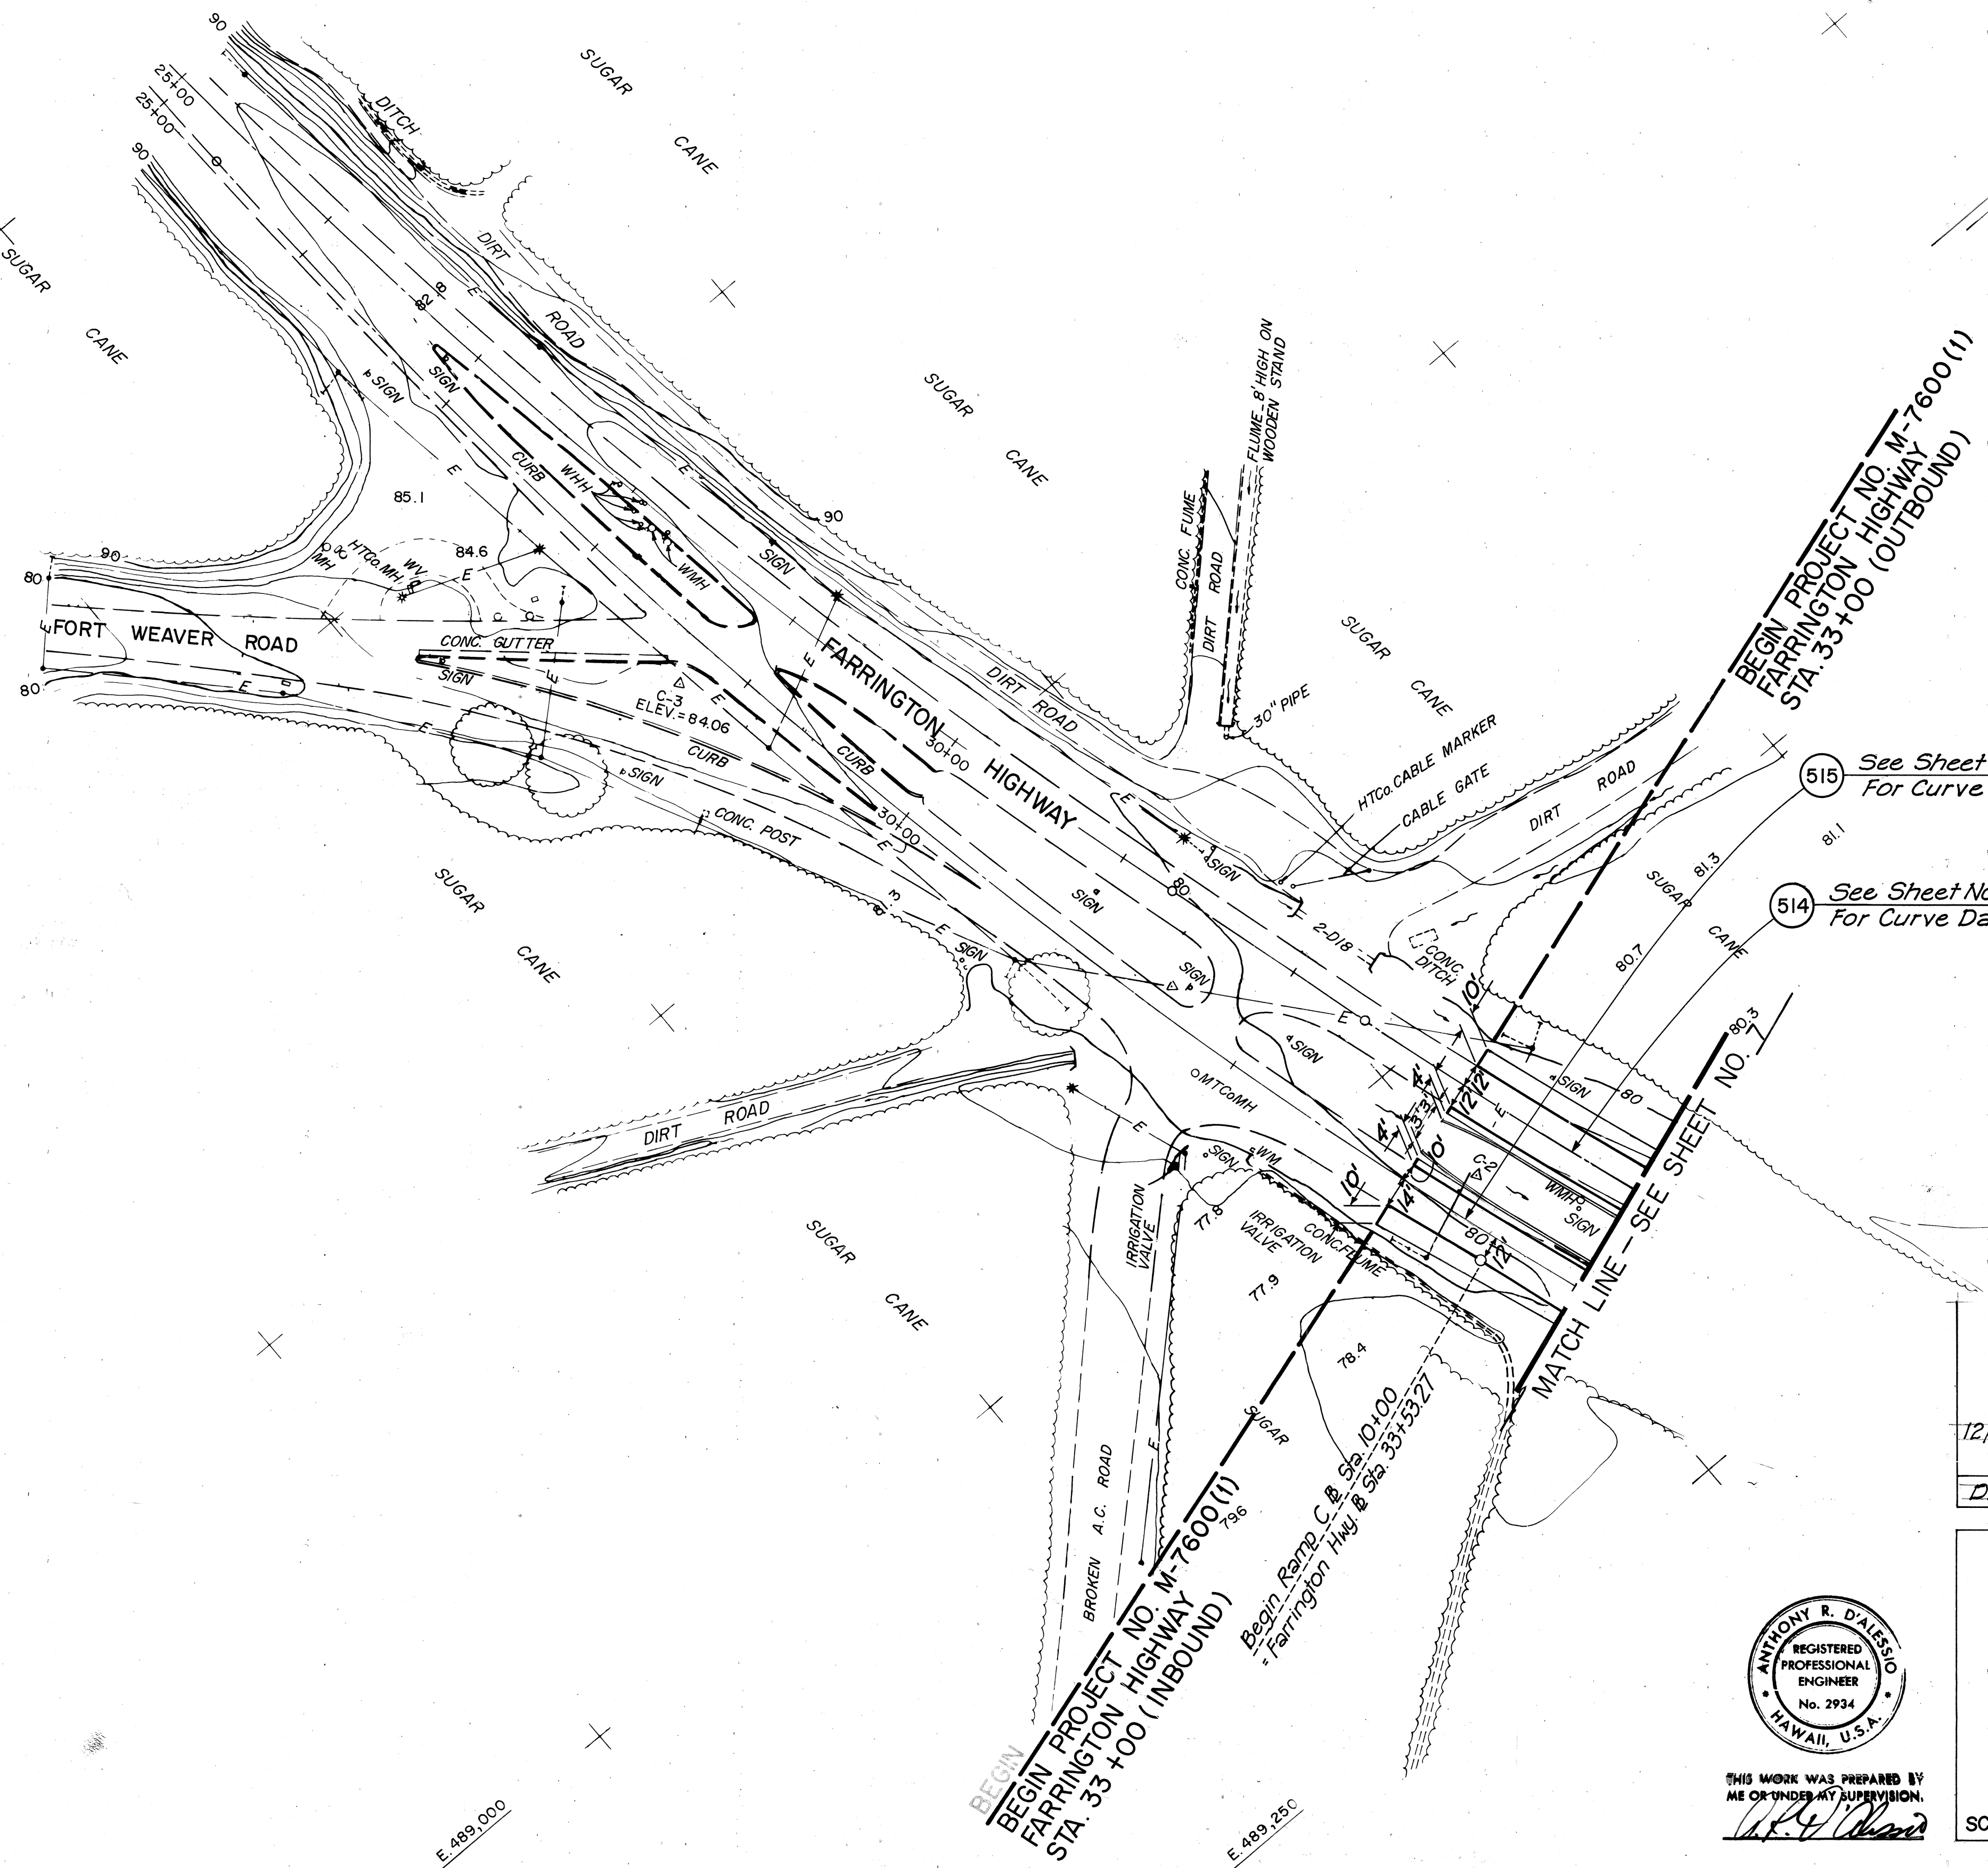

12/9/80	Added Curbs to Farr. Hwy. Median from Sta. 33+00 to Sta. 34+00.
DATE	REVISION

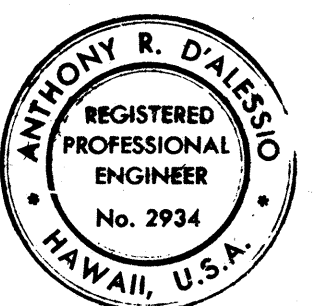

THIS WORK WAS PREPARED BY ME OR UNDER MY SUPERVISION.
[Signature]

STATE OF HAWAII
DEPARTMENT OF TRANSPORTATION
HIGHWAYS DIVISION
ALIGNMENT PLAN
FARRINGTON HIGHWAY
STA. 33+00.00 TO STA. 34+00.00
FORT WEAVER ROAD
ROUTE H-1 TO SOUTH OF
FARRINGTON HIGHWAY
SCALE: 1" = 50' DATE: AUG. 1978
SHEET NO. 4 OF 5 SHEETS

FED. ROAD DIST. NO.	STATE	FED. AID PROJ. NO.	FISCAL YEAR	SHEET NO.	TOTAL SHEETS
HAWAII	HAW.	M-7600(1)	1978	9	198

SURVEY PLOTTED BY	DATE
DESIGNED BY	
TRACED BY	
NOTE BOOK	
QUANTITIES BY	
CHECKED BY	
NO.	

NOTE:
See Sheet C.O.28 S-1
for Bikeway Alignment.

12/2/80 Added Curbs to Farr. Hwy. Median
Added Median Shoulder to
Farr. Hwy. Outbound Lanes.

9/7/79 Deleted Bikeway. Added Refer-
ence Note for New Bikeway
Alignment. Corrected Pavement
Width at Sta. 53+57

DATE	REVISION
------	----------


STATE OF HAWAII
DEPARTMENT OF TRANSPORTATION
HIGHWAYS DIVISION

ALIGNMENT PLAN
FARRINGTON HIGHWAY
STA. 51+00.00 TO STA. 56+30.00

FORT WEAVER ROAD
ROUTE H-1 TO SOUTH OF
FARRINGTON HIGHWAY

SCALE: 1" = 50' DATE: AUG. 1978

SHEET NO. 5 OF 5 SHEETS

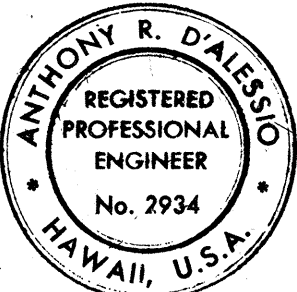

THIS WORK WAS PREPARED BY
ME OR UNDER MY SUPERVISION.
[Signature]

C09R