



FED. ROAD DIST. NO.	STATE	FED. AID PROJ. NO.	FISCAL YEAR	SHEET NO.	TOTAL SHEETS
HAWAII	HAW.	M-7600(1)	1978	18	198

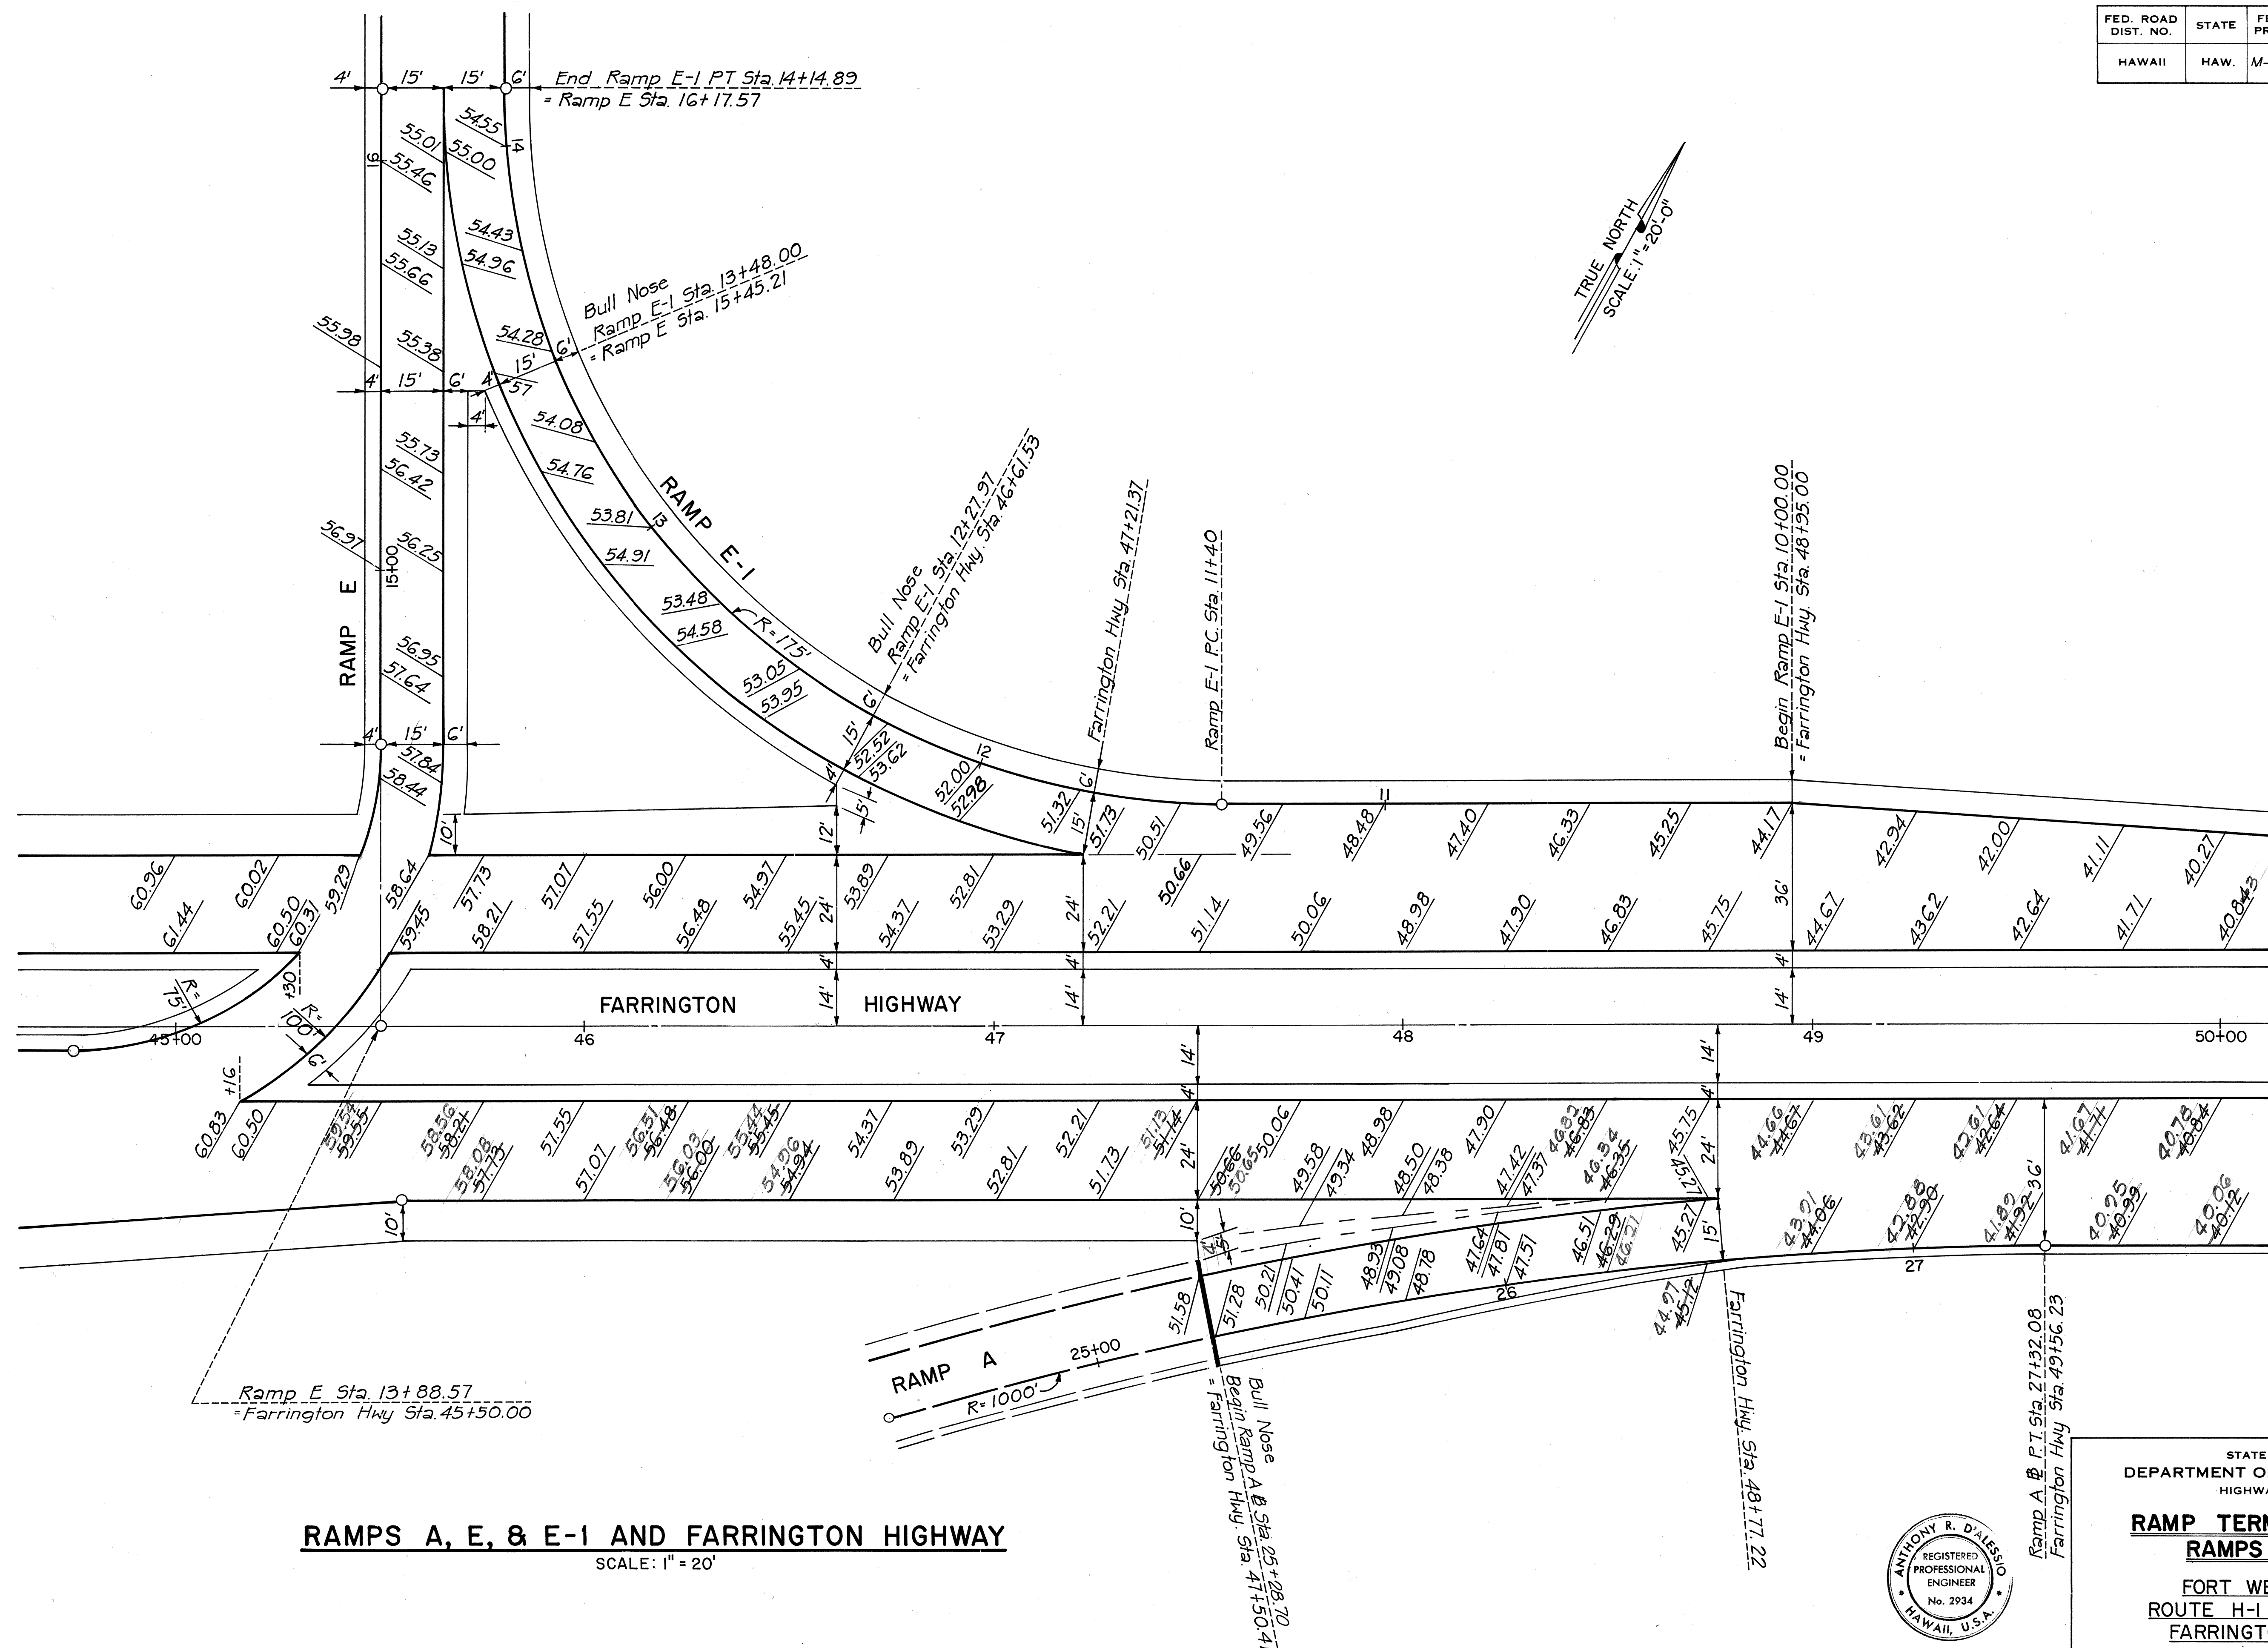

RAMPS A, E, & E-1 AND FARRINGTON HIGHWAY
SCALE: 1" = 20'

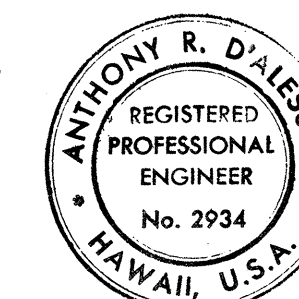


THIS WORK WAS PREPARED BY
ME OR UNDER MY SUPERVISION.
A.R. Dalessio

STATE OF HAWAII
DEPARTMENT OF TRANSPORTATION
HIGHWAYS DIVISION
RAMP TERMINAL DETAILS
RAMPS A, E, & E-1


FORT WEAVER ROAD
ROUTE H-1 TO SOUTH OF
FARRINGTON HIGHWAY

SCALE: 1" = 20' DATE: AUG. 1978
SHEET NO. 1 OF 4 SHEETS

FED. ROAD DIST. NO.	STATE	FED. AID PROJ. NO.	FISCAL YEAR	SHEET NO.	TOTAL SHEETS
HAWAII	HAW.	M-7600(1)	1978	19	198

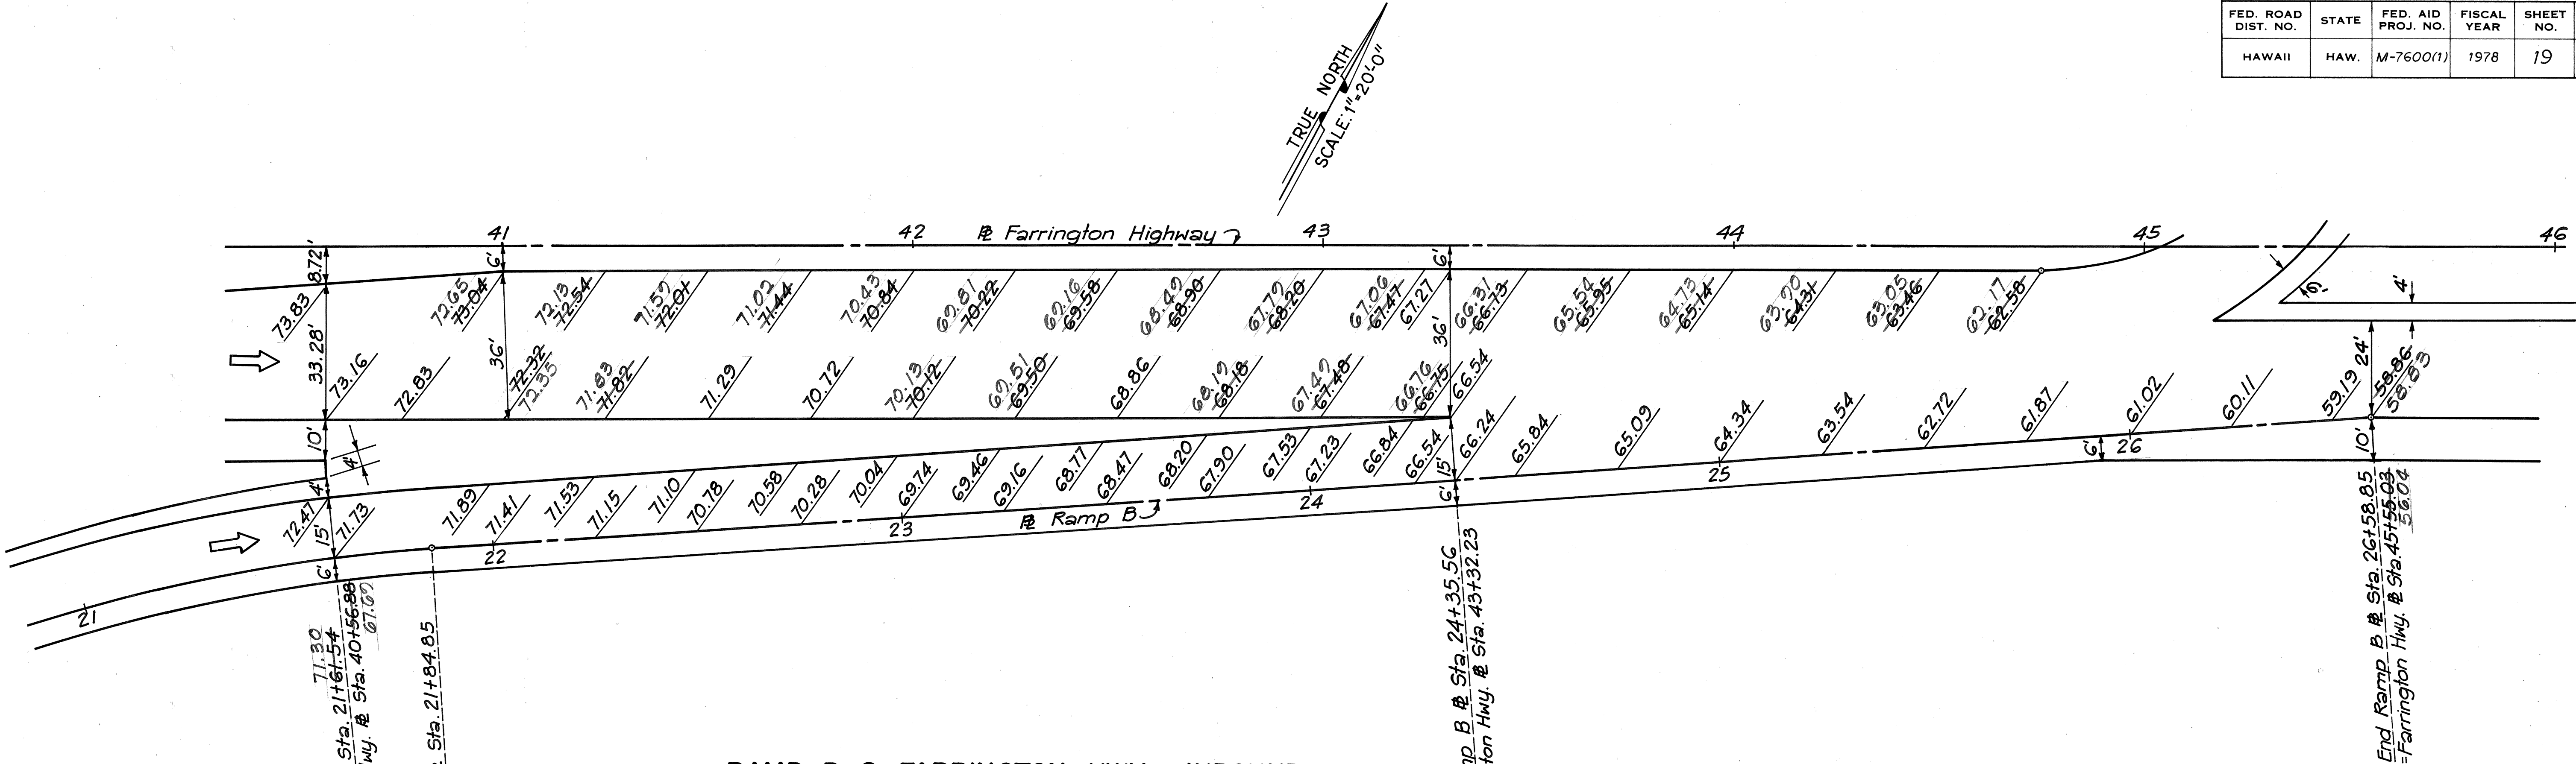


RAMP B & FARRINGTON HWY - INBOUND
Scale: 1" = 20'

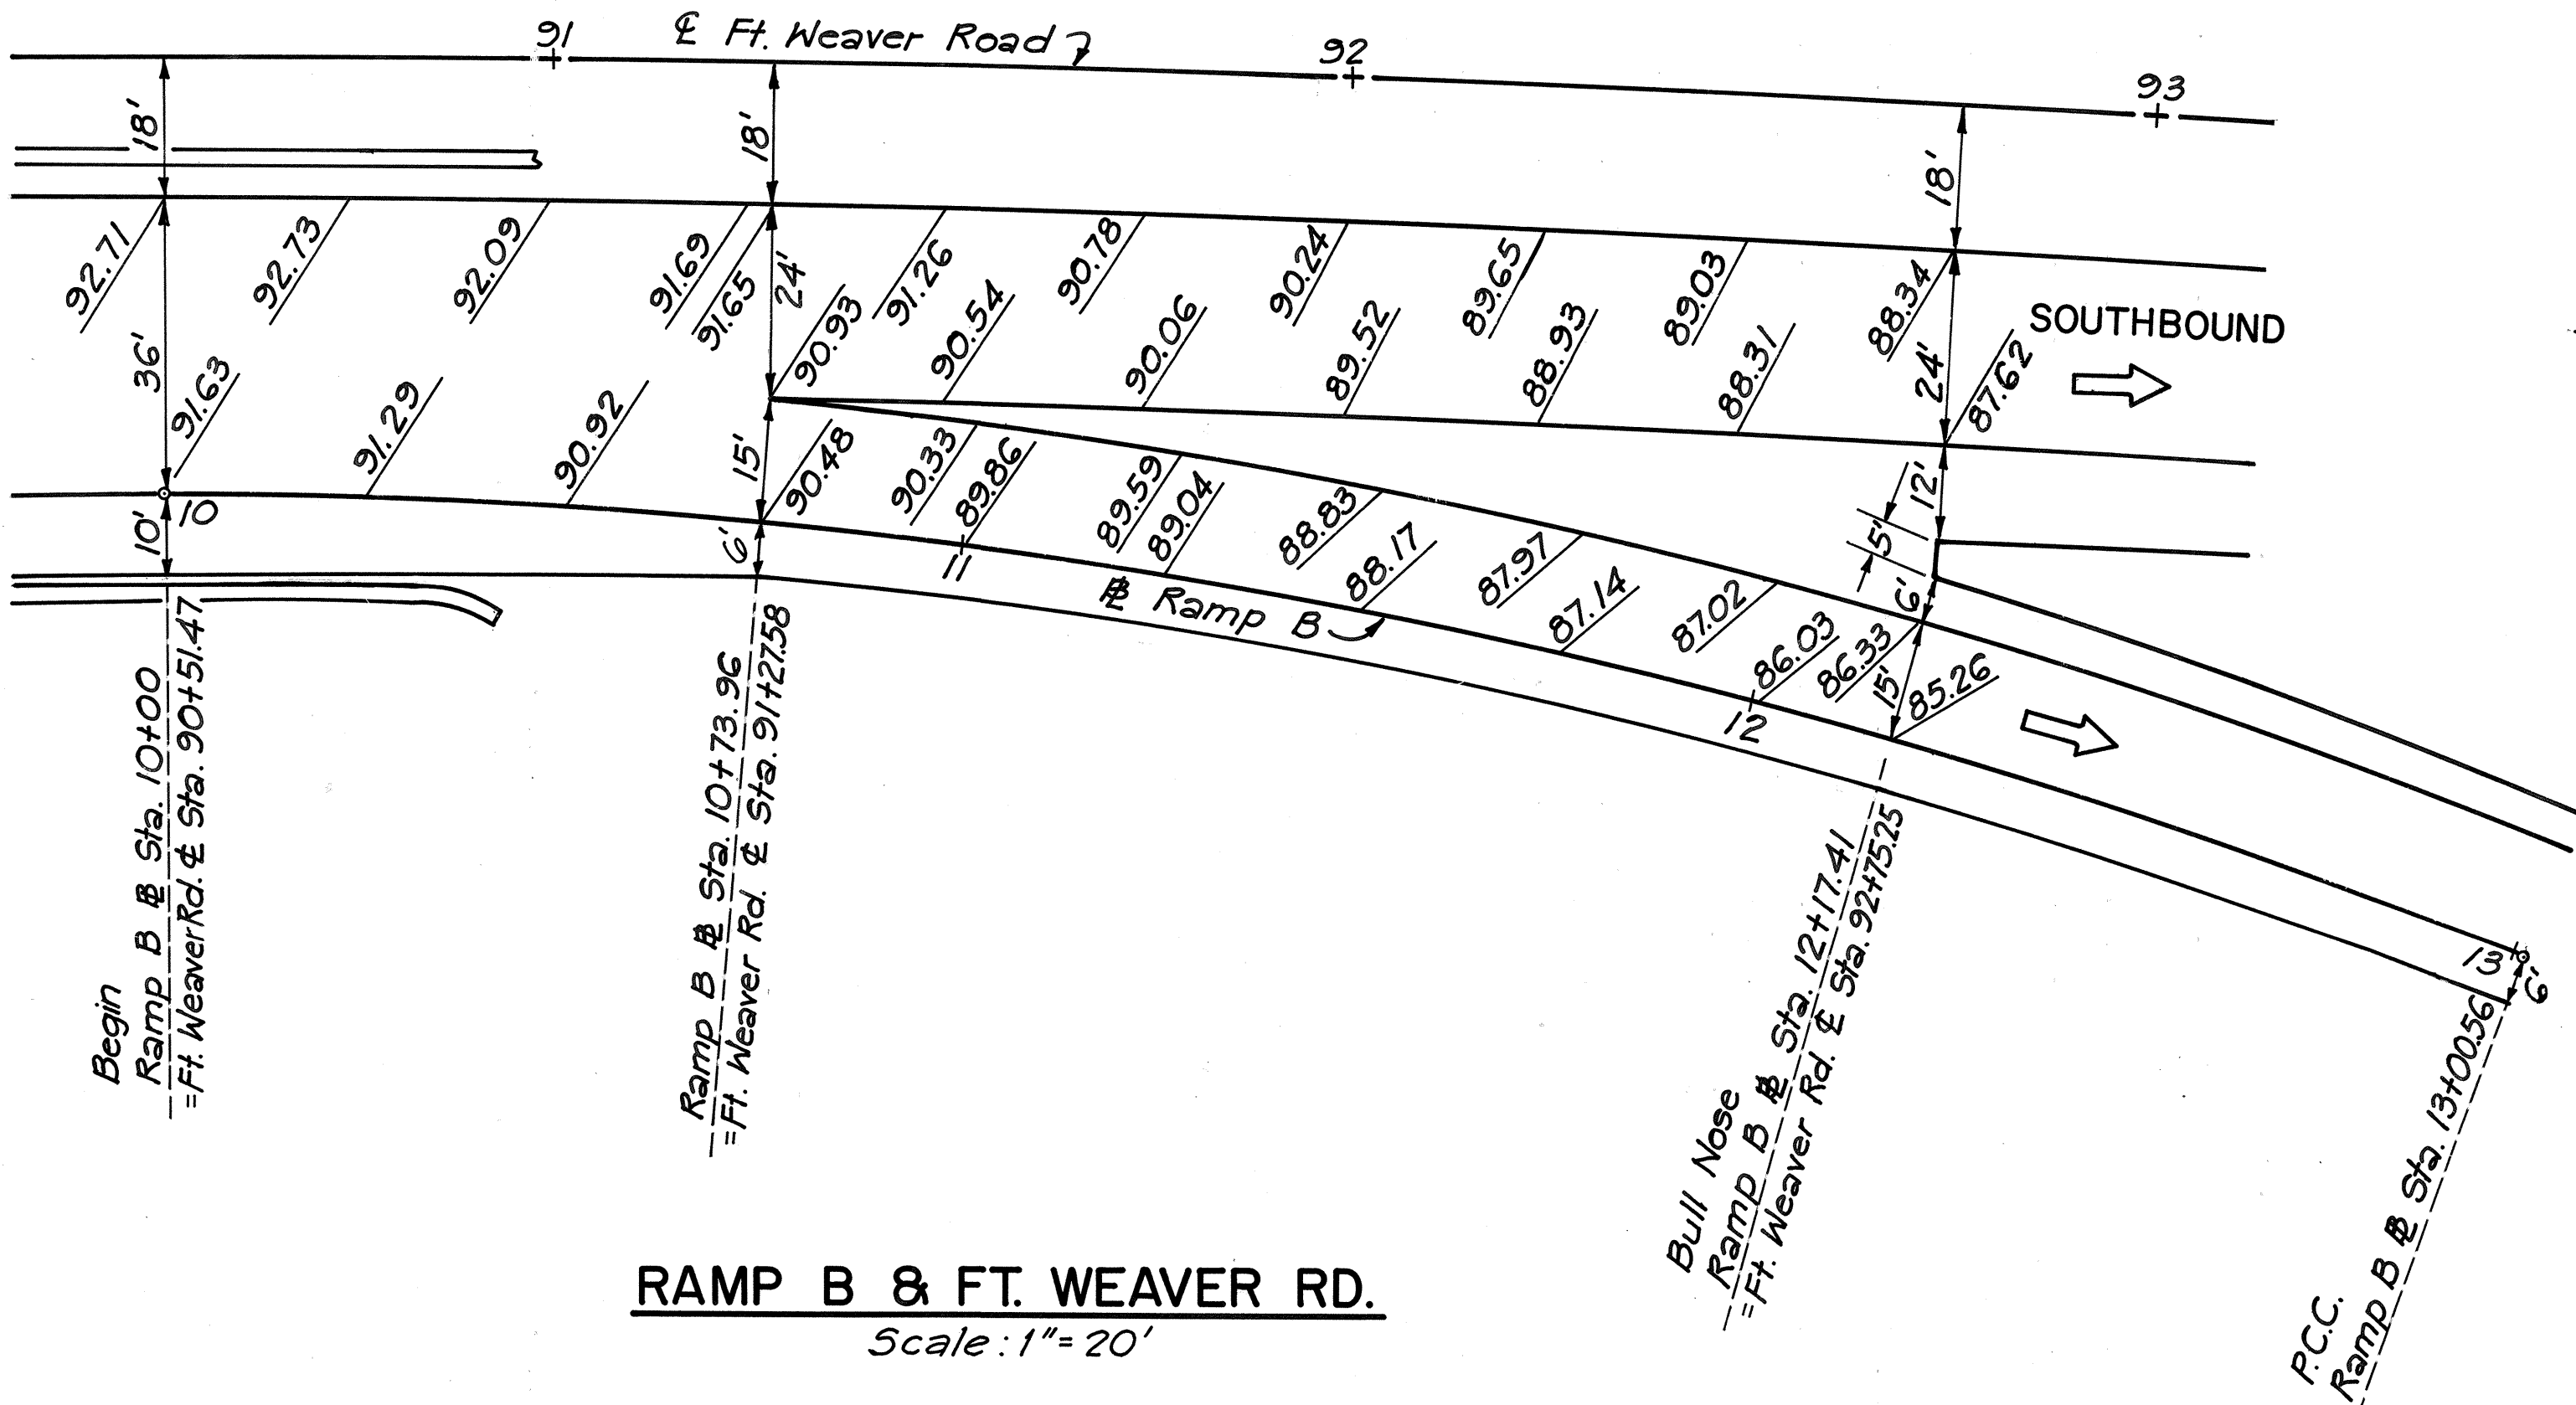

RAMP B & FT. WEAVER RD.
Scale: 1" = 20'


ORIGINAL PLAN	DATE
SURVEY PLOTTED BY	
DRAWN BY	
DESIGNED BY	
CHECKED BY	
NO.	

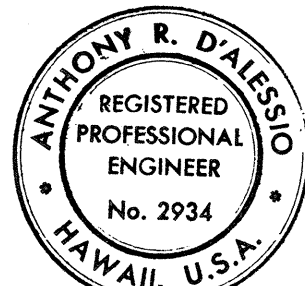


THIS WORK WAS PREPARED BY
ME OR UNDER MY SUPERVISION.
[Signature]

STATE OF HAWAII
DEPARTMENT OF TRANSPORTATION
HIGHWAYS DIVISION
RAMP TERMINAL DETAILS
RAMP B
FORT WEAVER ROAD
ROUTE H-1 TO SOUTH OF
FARRINGTON HIGHWAY
SCALE: 1" = 20'
DATE: AUG. 1978
SHEET NO. 2 OF 4 SHEETS

FED. ROAD DIST. NO.	STATE	FED. AID PROJ. NO.	FISCAL YEAR	SHEET NO.	TOTAL SHEETS
HAWAII	HAW.	M-7600(1)	1978	20	198

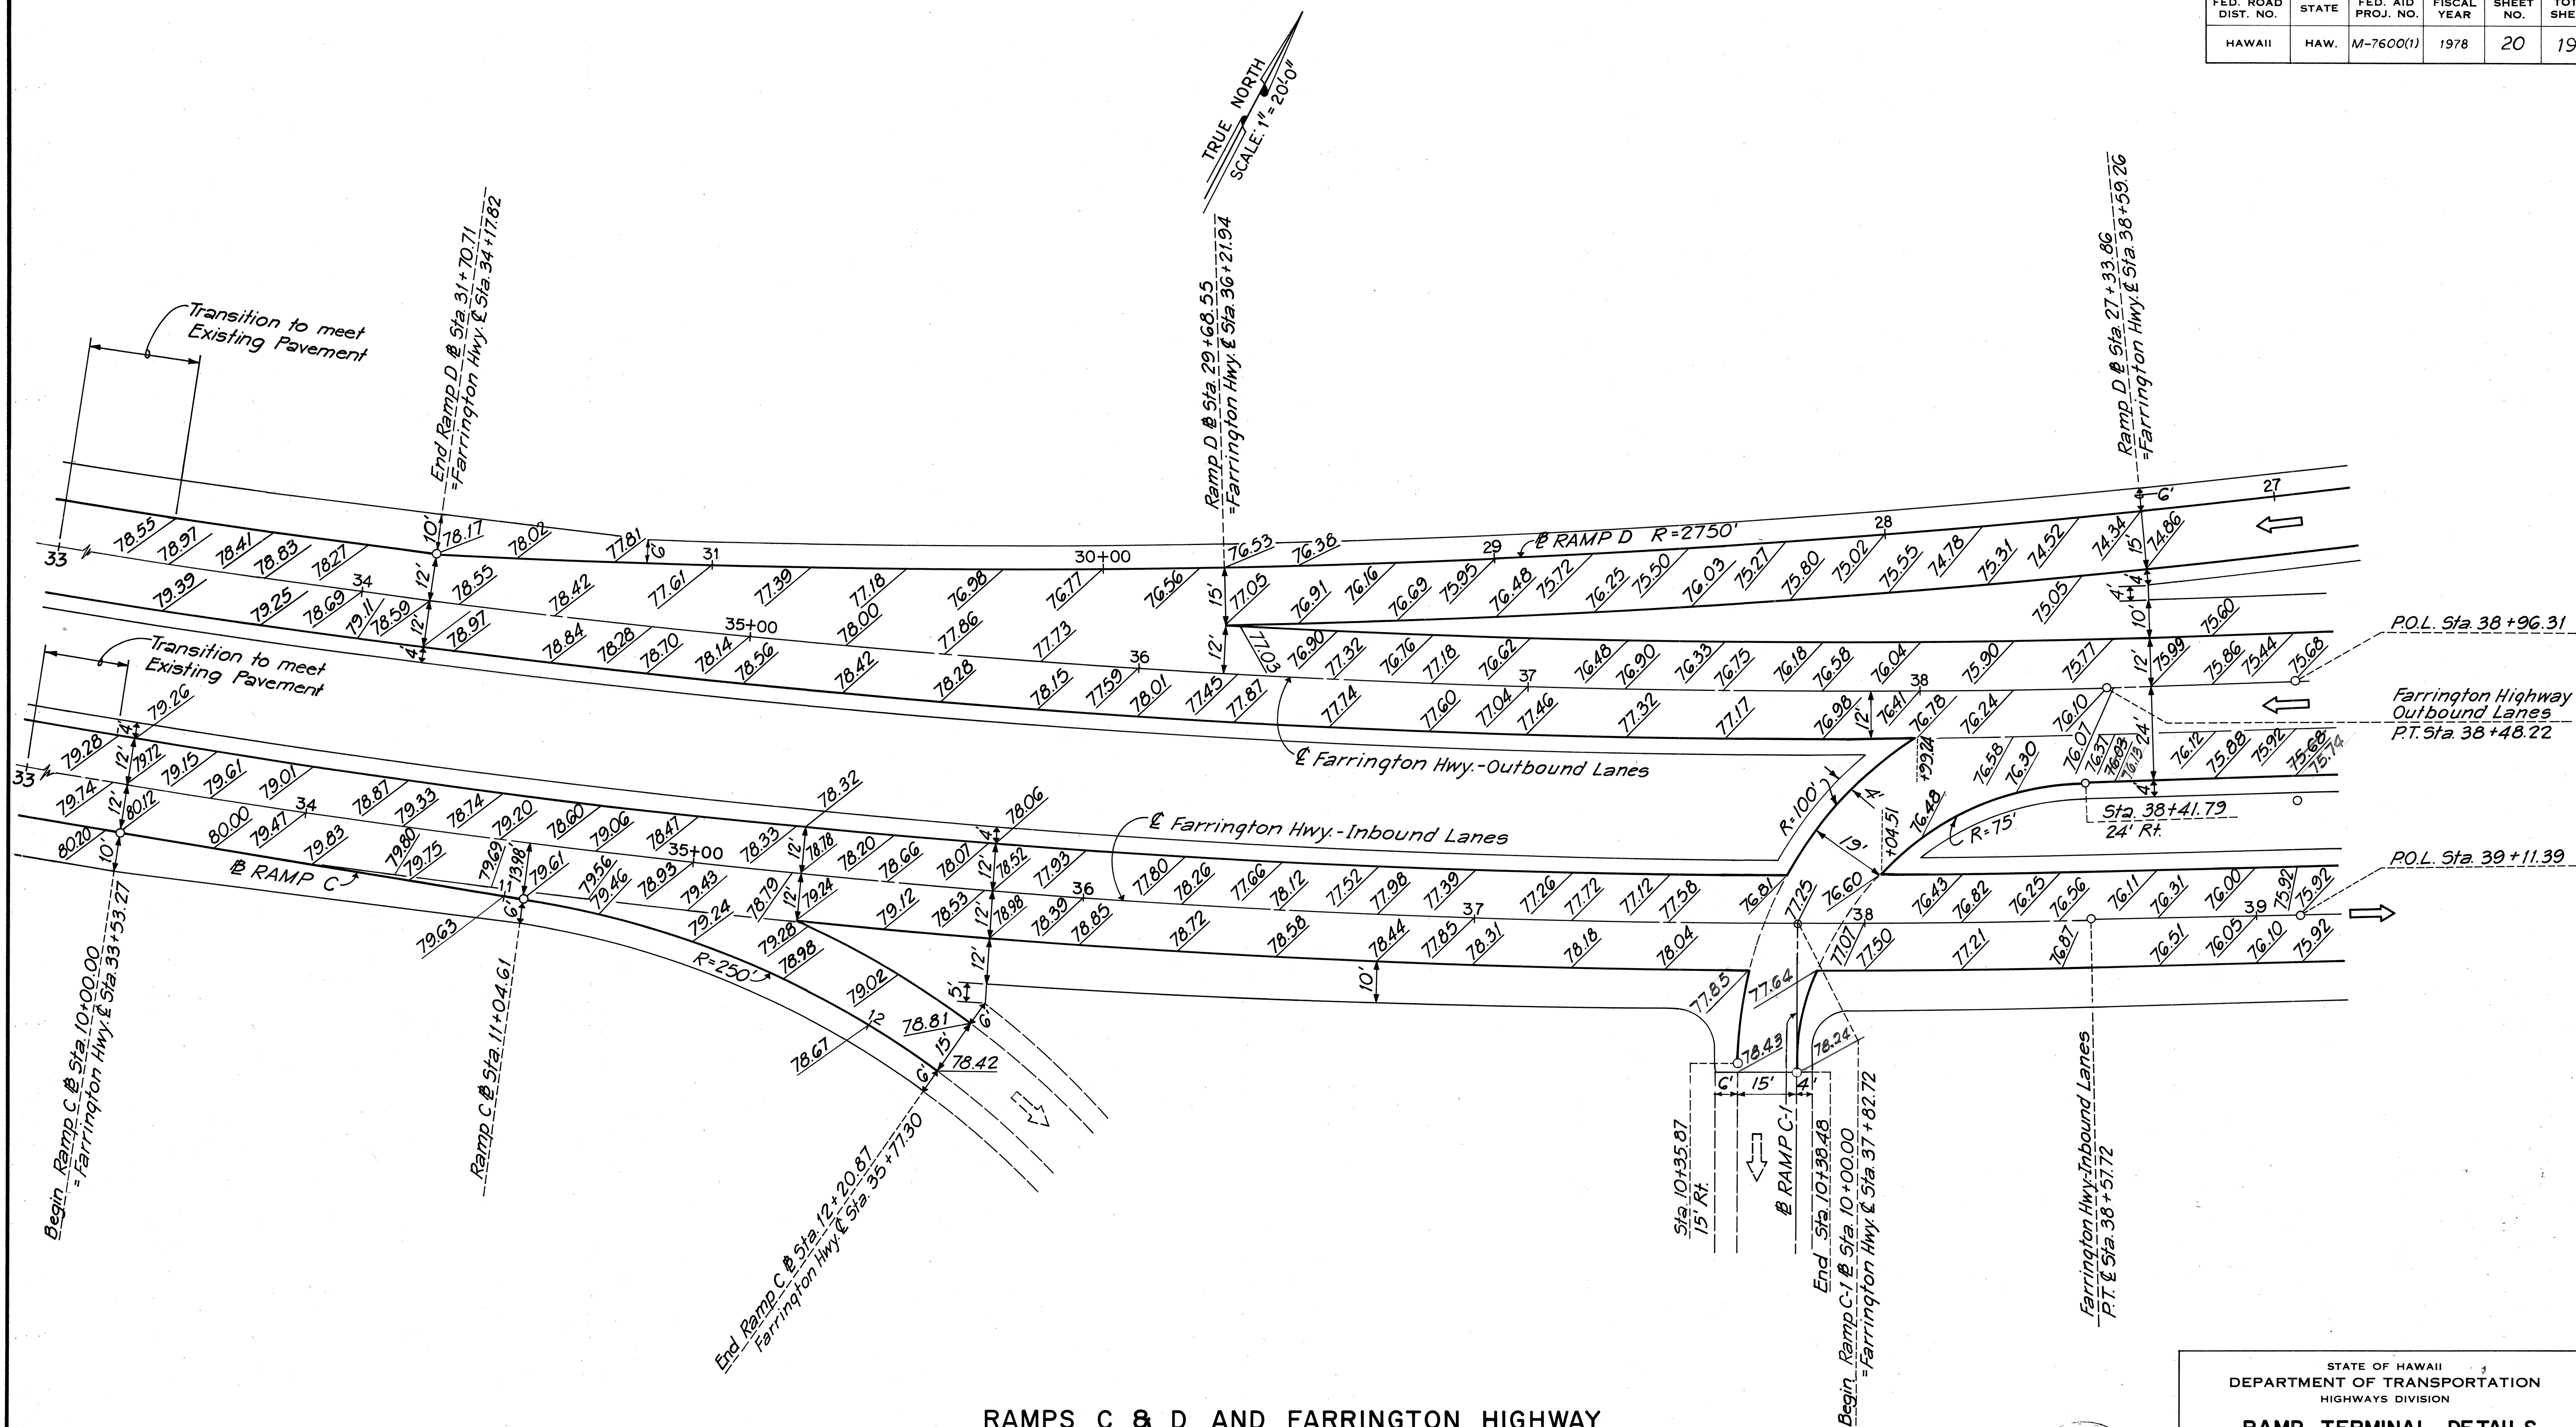

RAMPS C & D AND FARRINGTON HIGHWAY
Scale: 1"=20'

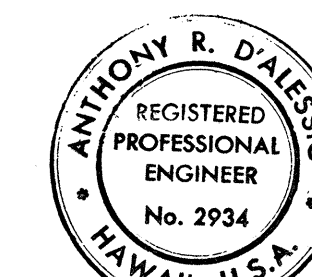

THIS WORK WAS PREPARED BY
ME OR UNDER MY SUPERVISION.

[Signature]


STATE OF HAWAII
DEPARTMENT OF TRANSPORTATION
HIGHWAYS DIVISION

**RAMP TERMINAL DETAILS
RAMPS C & D**


FORT WEAVER ROAD
ROUTE H-1 TO SOUTH OF
FARRINGTON HIGHWAY

SCALE: 1"=20' DATE: AUG. 1978
SHEET NO. 3 OF 4 SHEETS


FED. ROAD DIST. NO.	STATE	FED. AID PROJ. NO.	FISCAL YEAR	SHEET NO.	TOTAL SHEETS
HAWAII	HAW.	M-7600(1)	1978	21	198

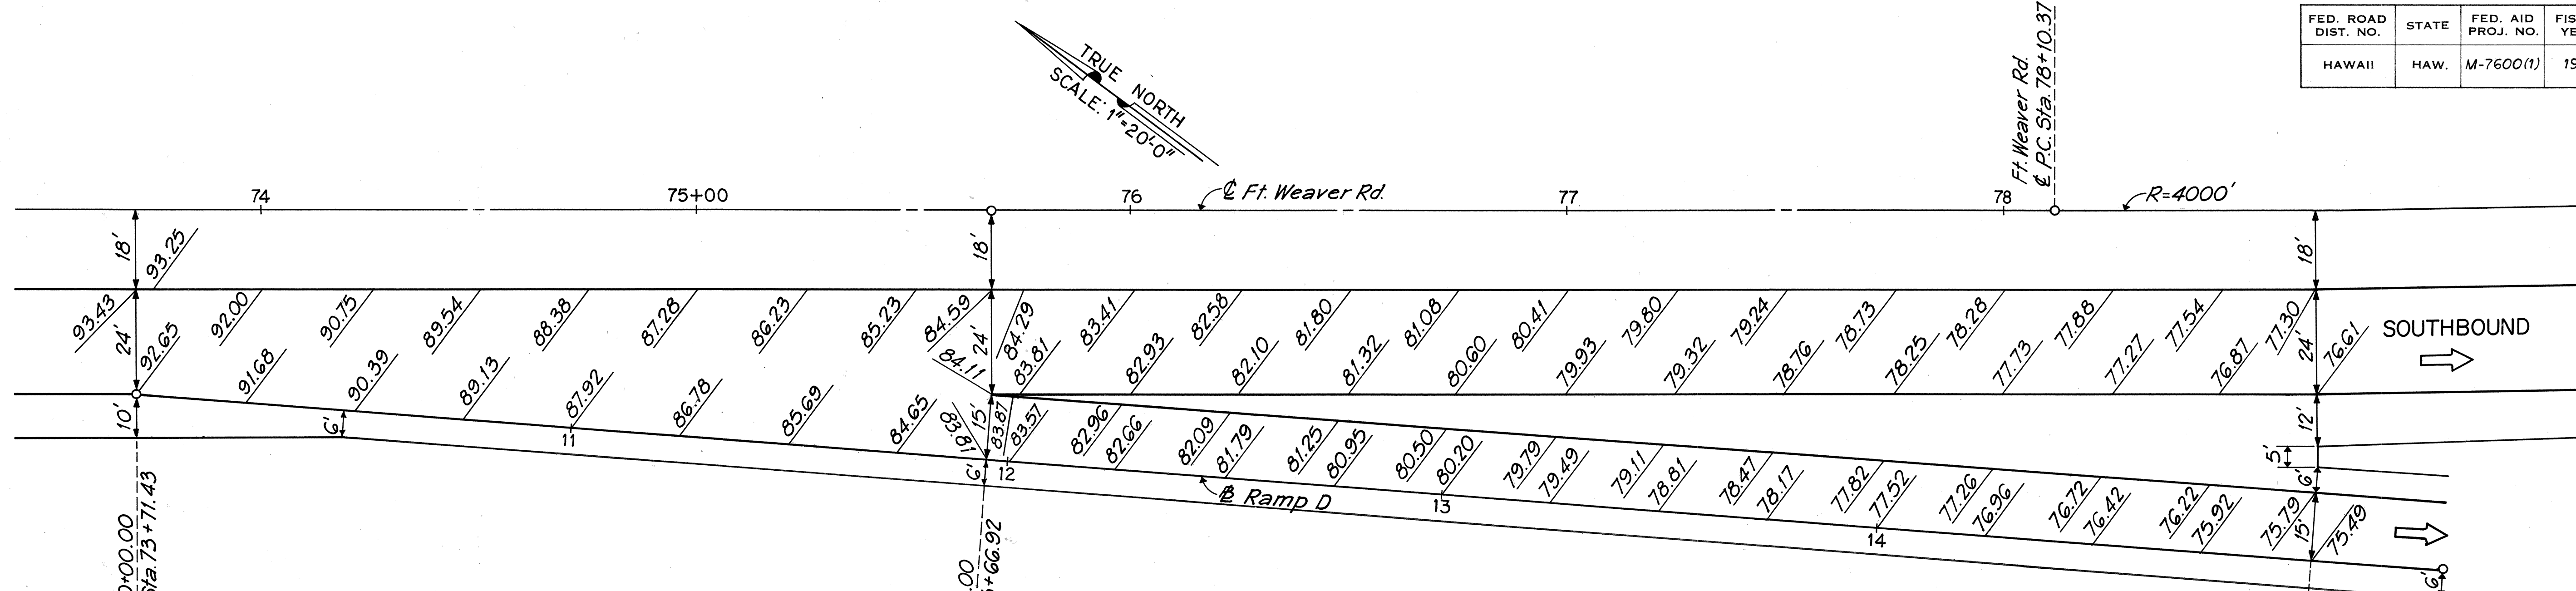


RAMP D & FT. WEAVER RD.
Scale: 1" = 20'

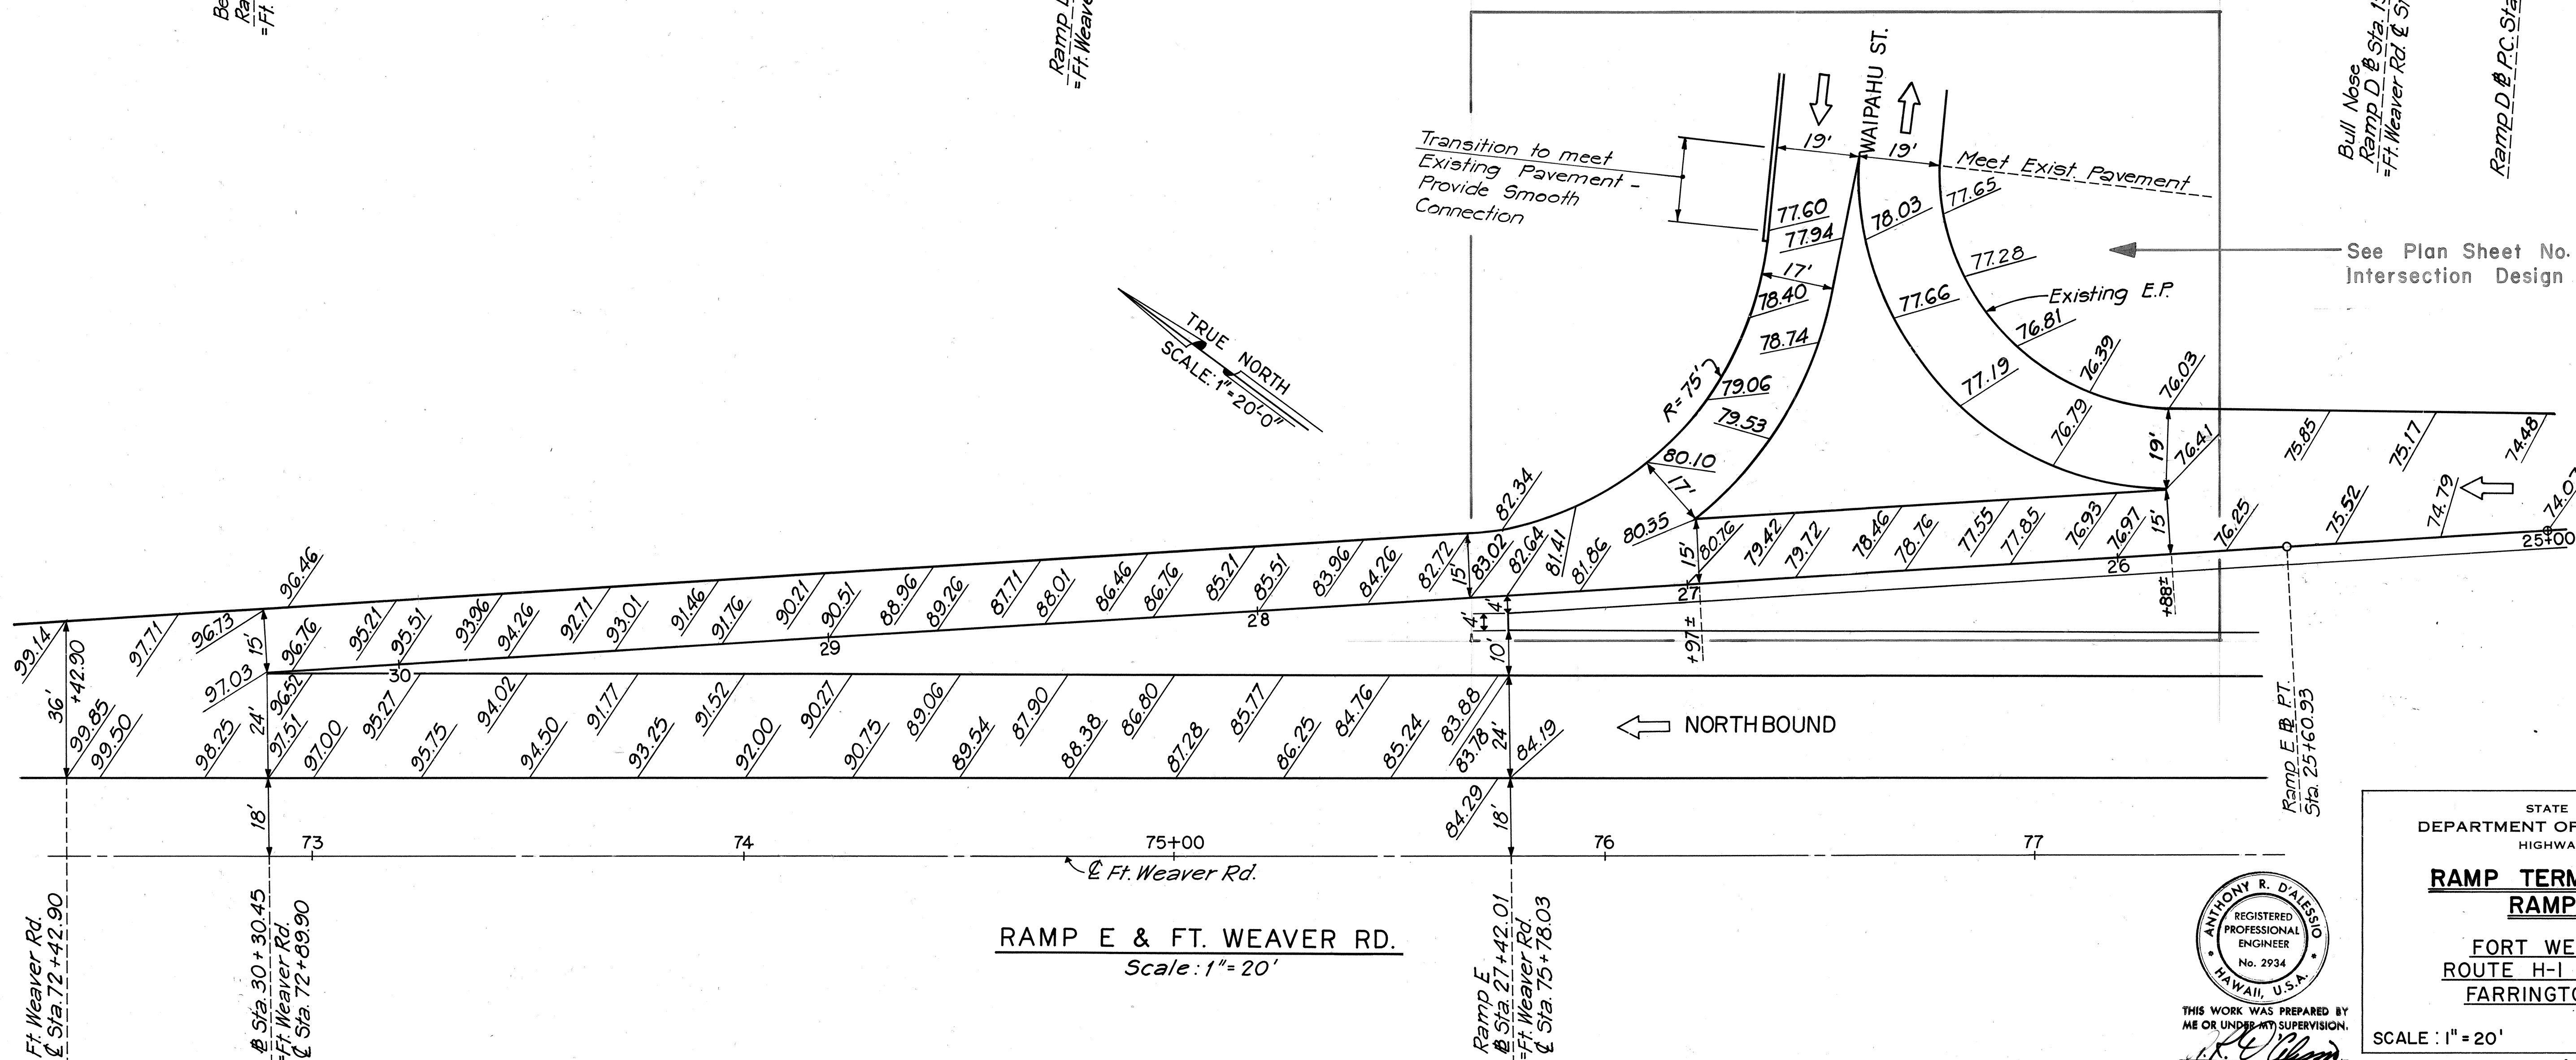

RAMP E & FT. WEAVER RD.
Scale: 1" = 20'

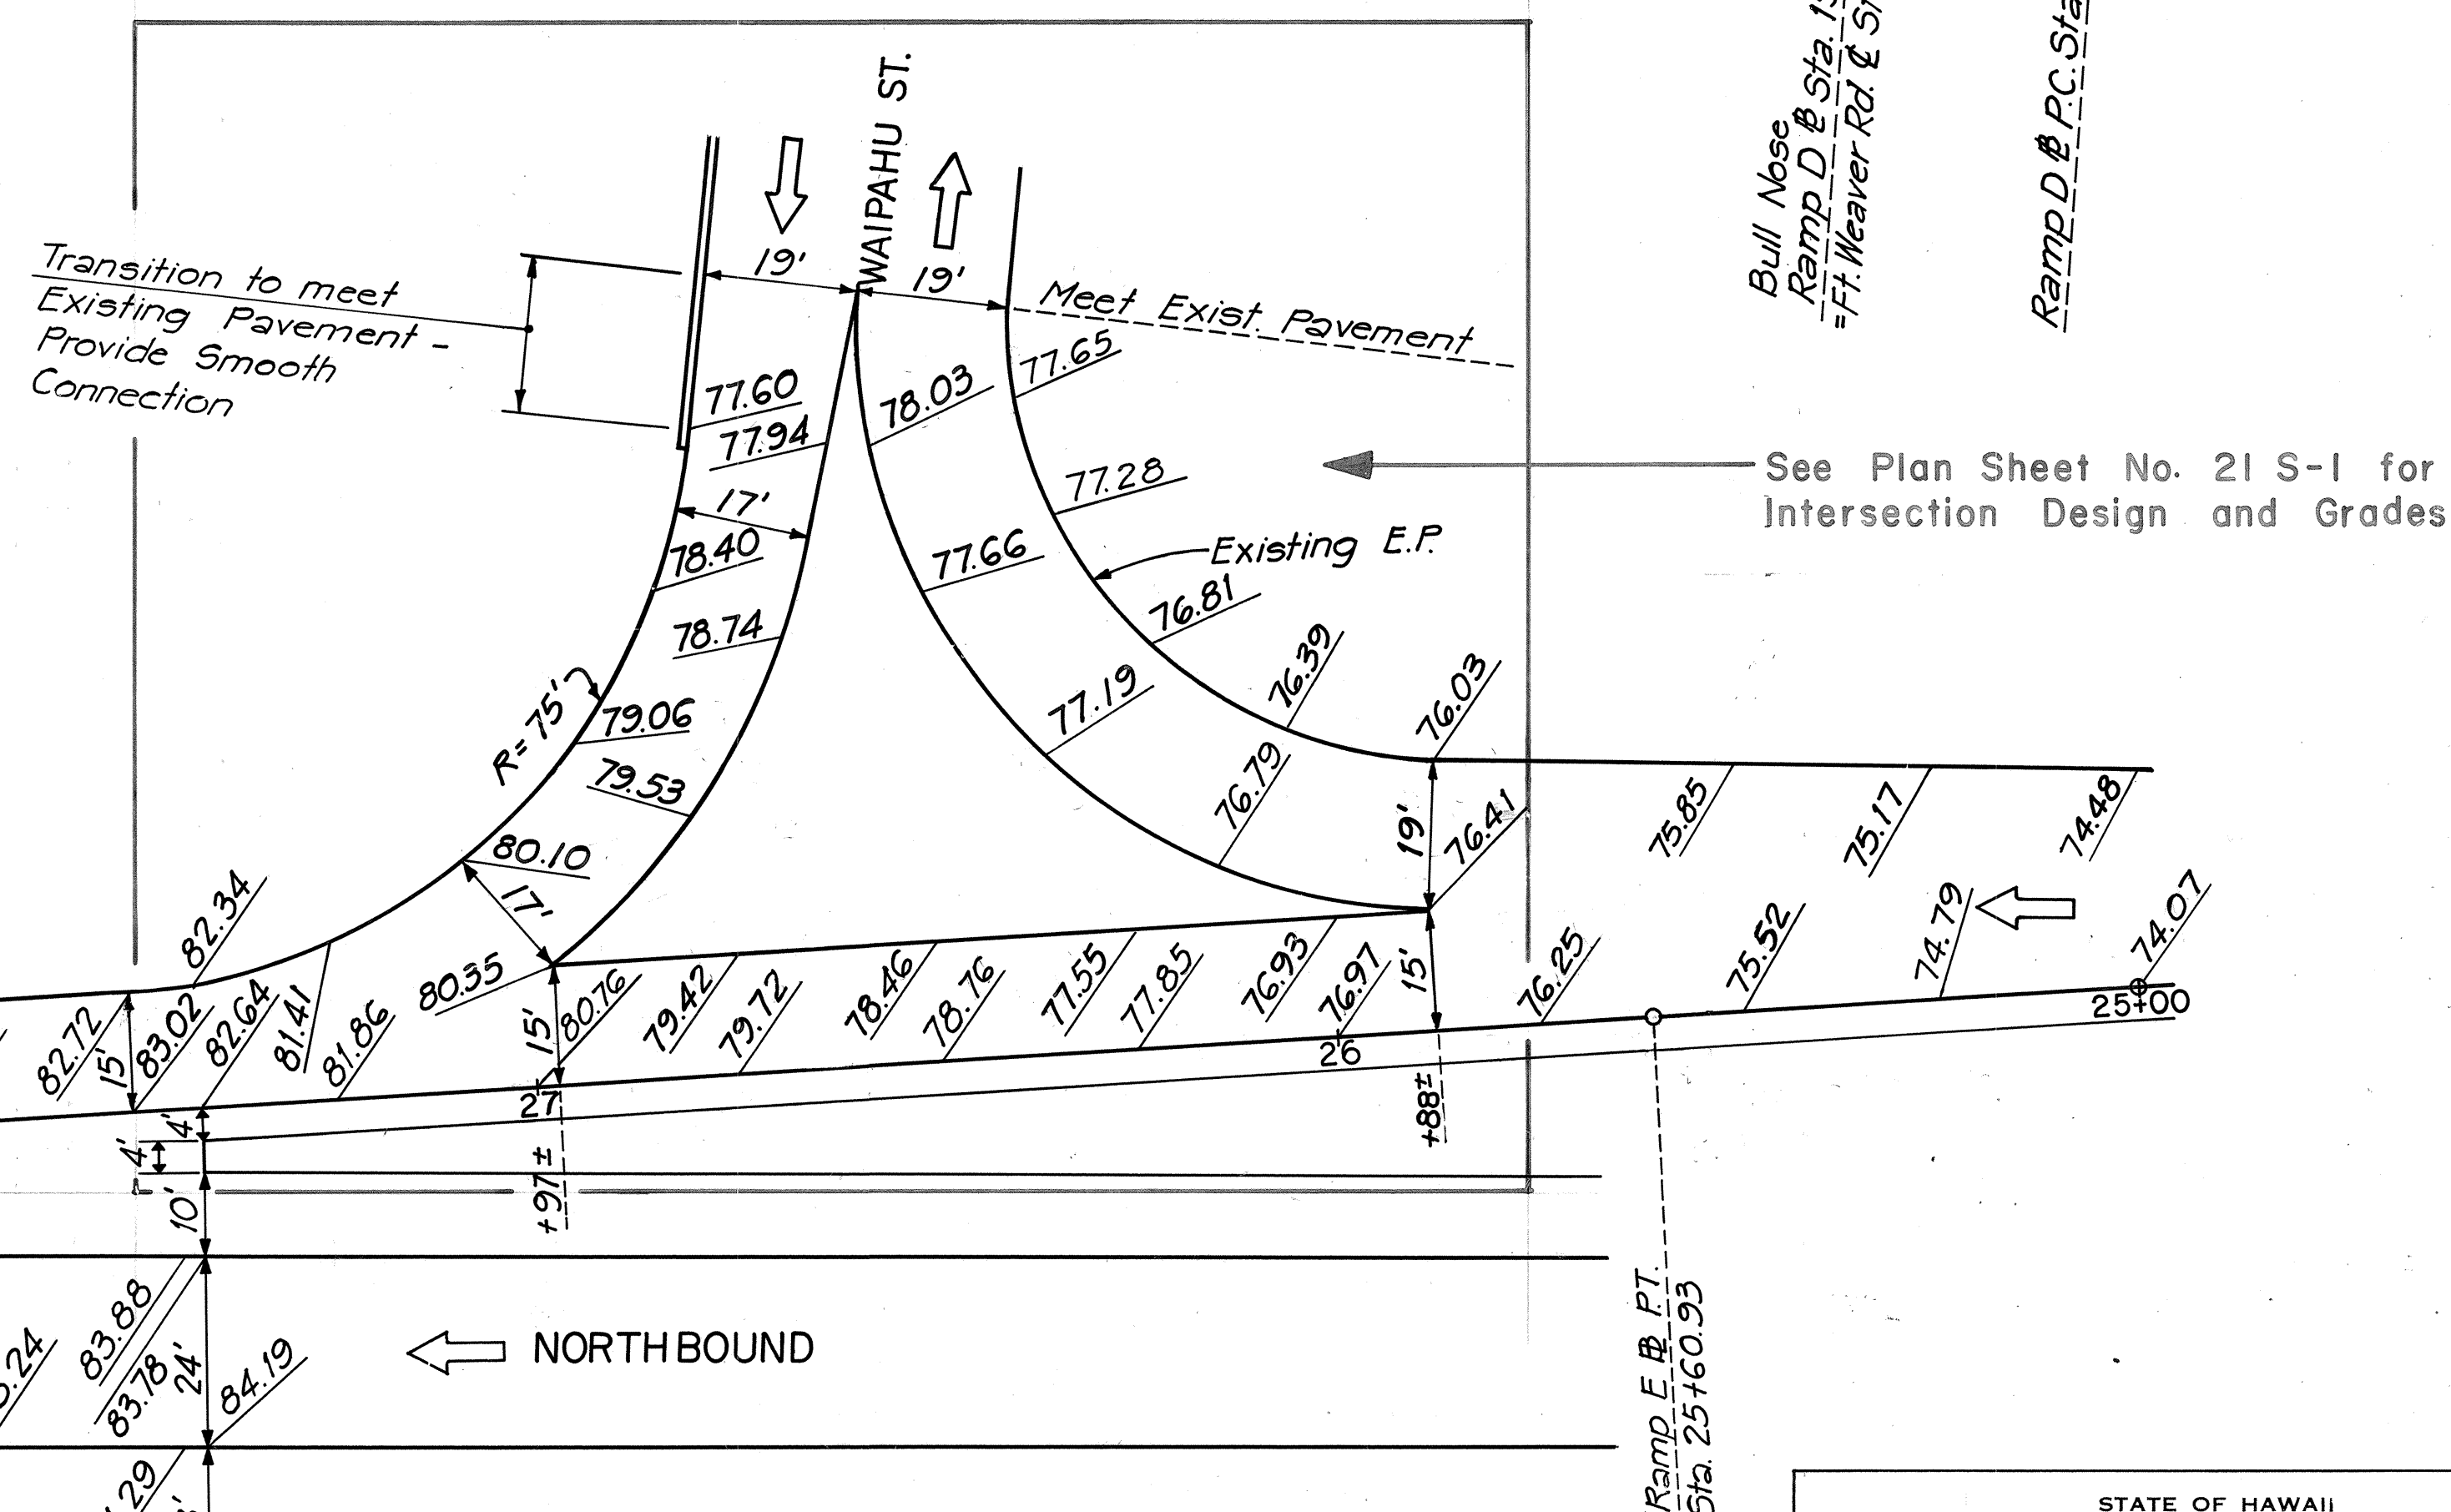

See Plan Sheet No. 21 S-1 for Intersection Design and Grades.

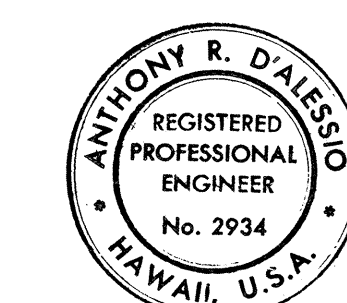

THIS WORK WAS PREPARED BY ME OR UNDER MY SUPERVISION.
A.R. Dalesio

STATE OF HAWAII
DEPARTMENT OF TRANSPORTATION
HIGHWAYS DIVISION



**RAMP TERMINAL DETAILS
RAMPS D & E**

FORT WEAVER ROAD
ROUTE H-1 TO SOUTH OF
FARRINGTON HIGHWAY

SCALE: 1" = 20' DATE: AUG. 1978

SHEET NO. 4 OF 4 SHEETS

FED. ROAD DIST. NO.	STATE	FED. AID PROJ. NO.	FISCAL YEAR	SHEET NO.	TOTAL SHEETS
HAWAII	HAW.	M-7600 (1)	1978	215-1	198

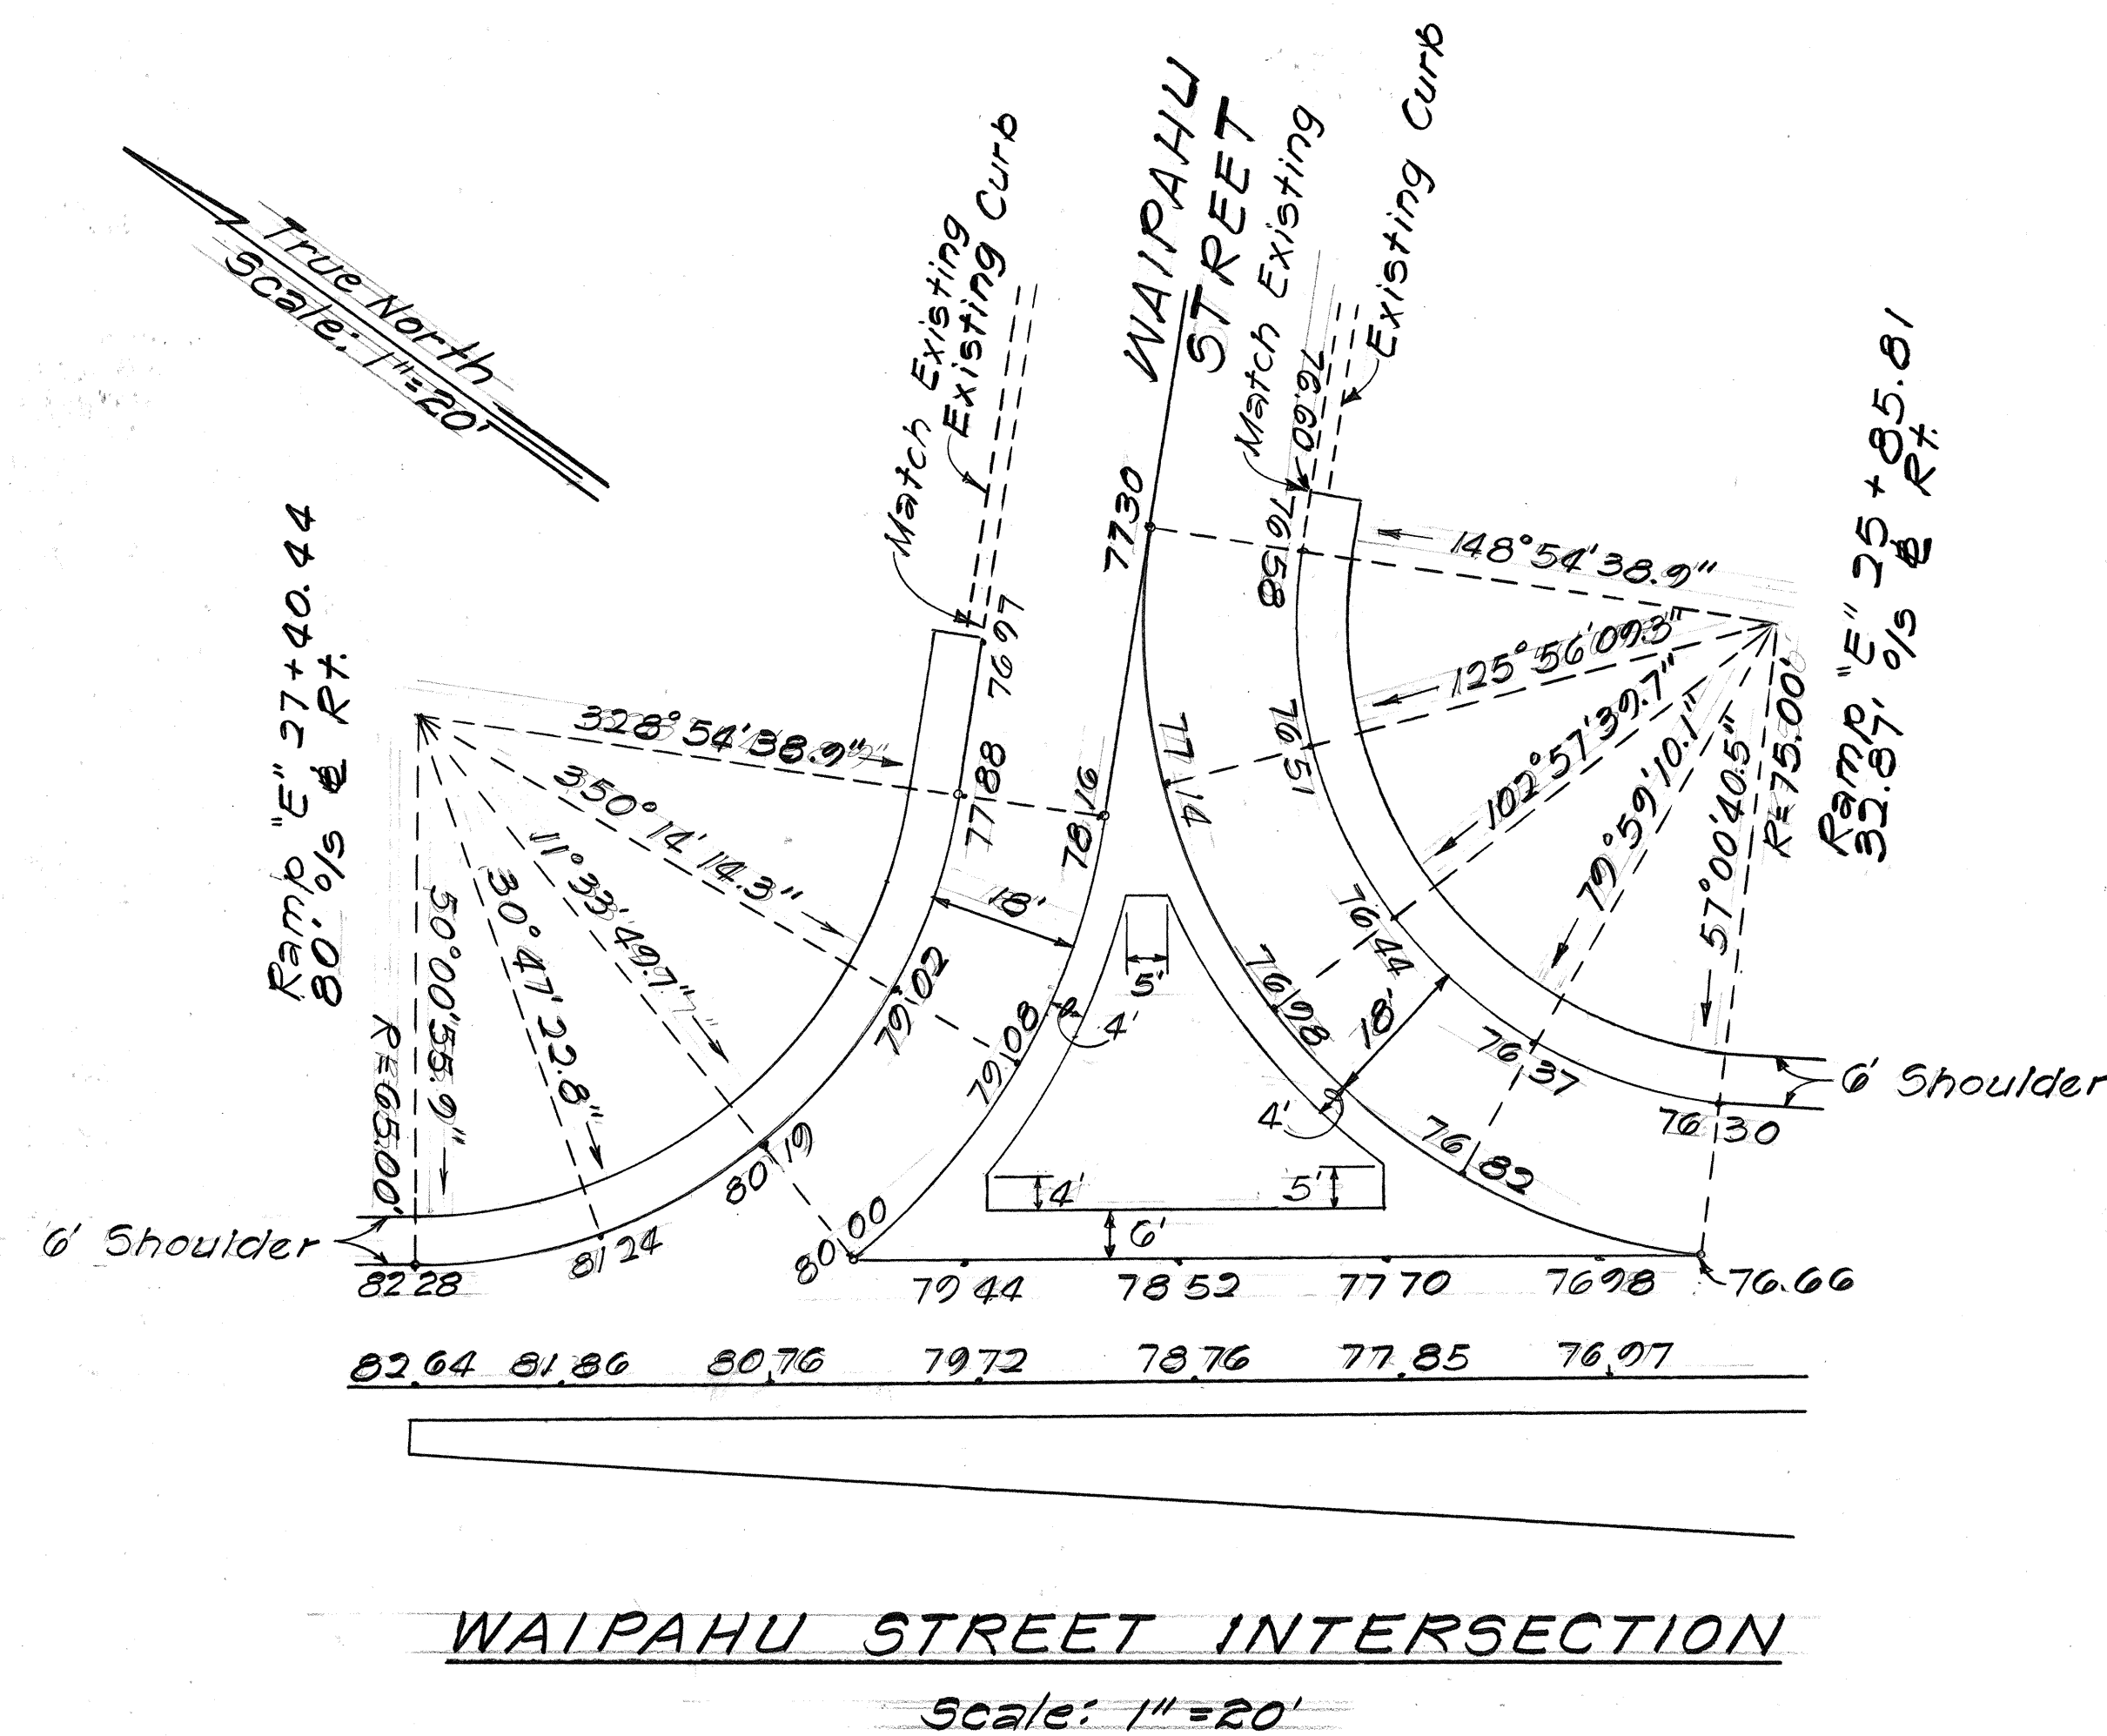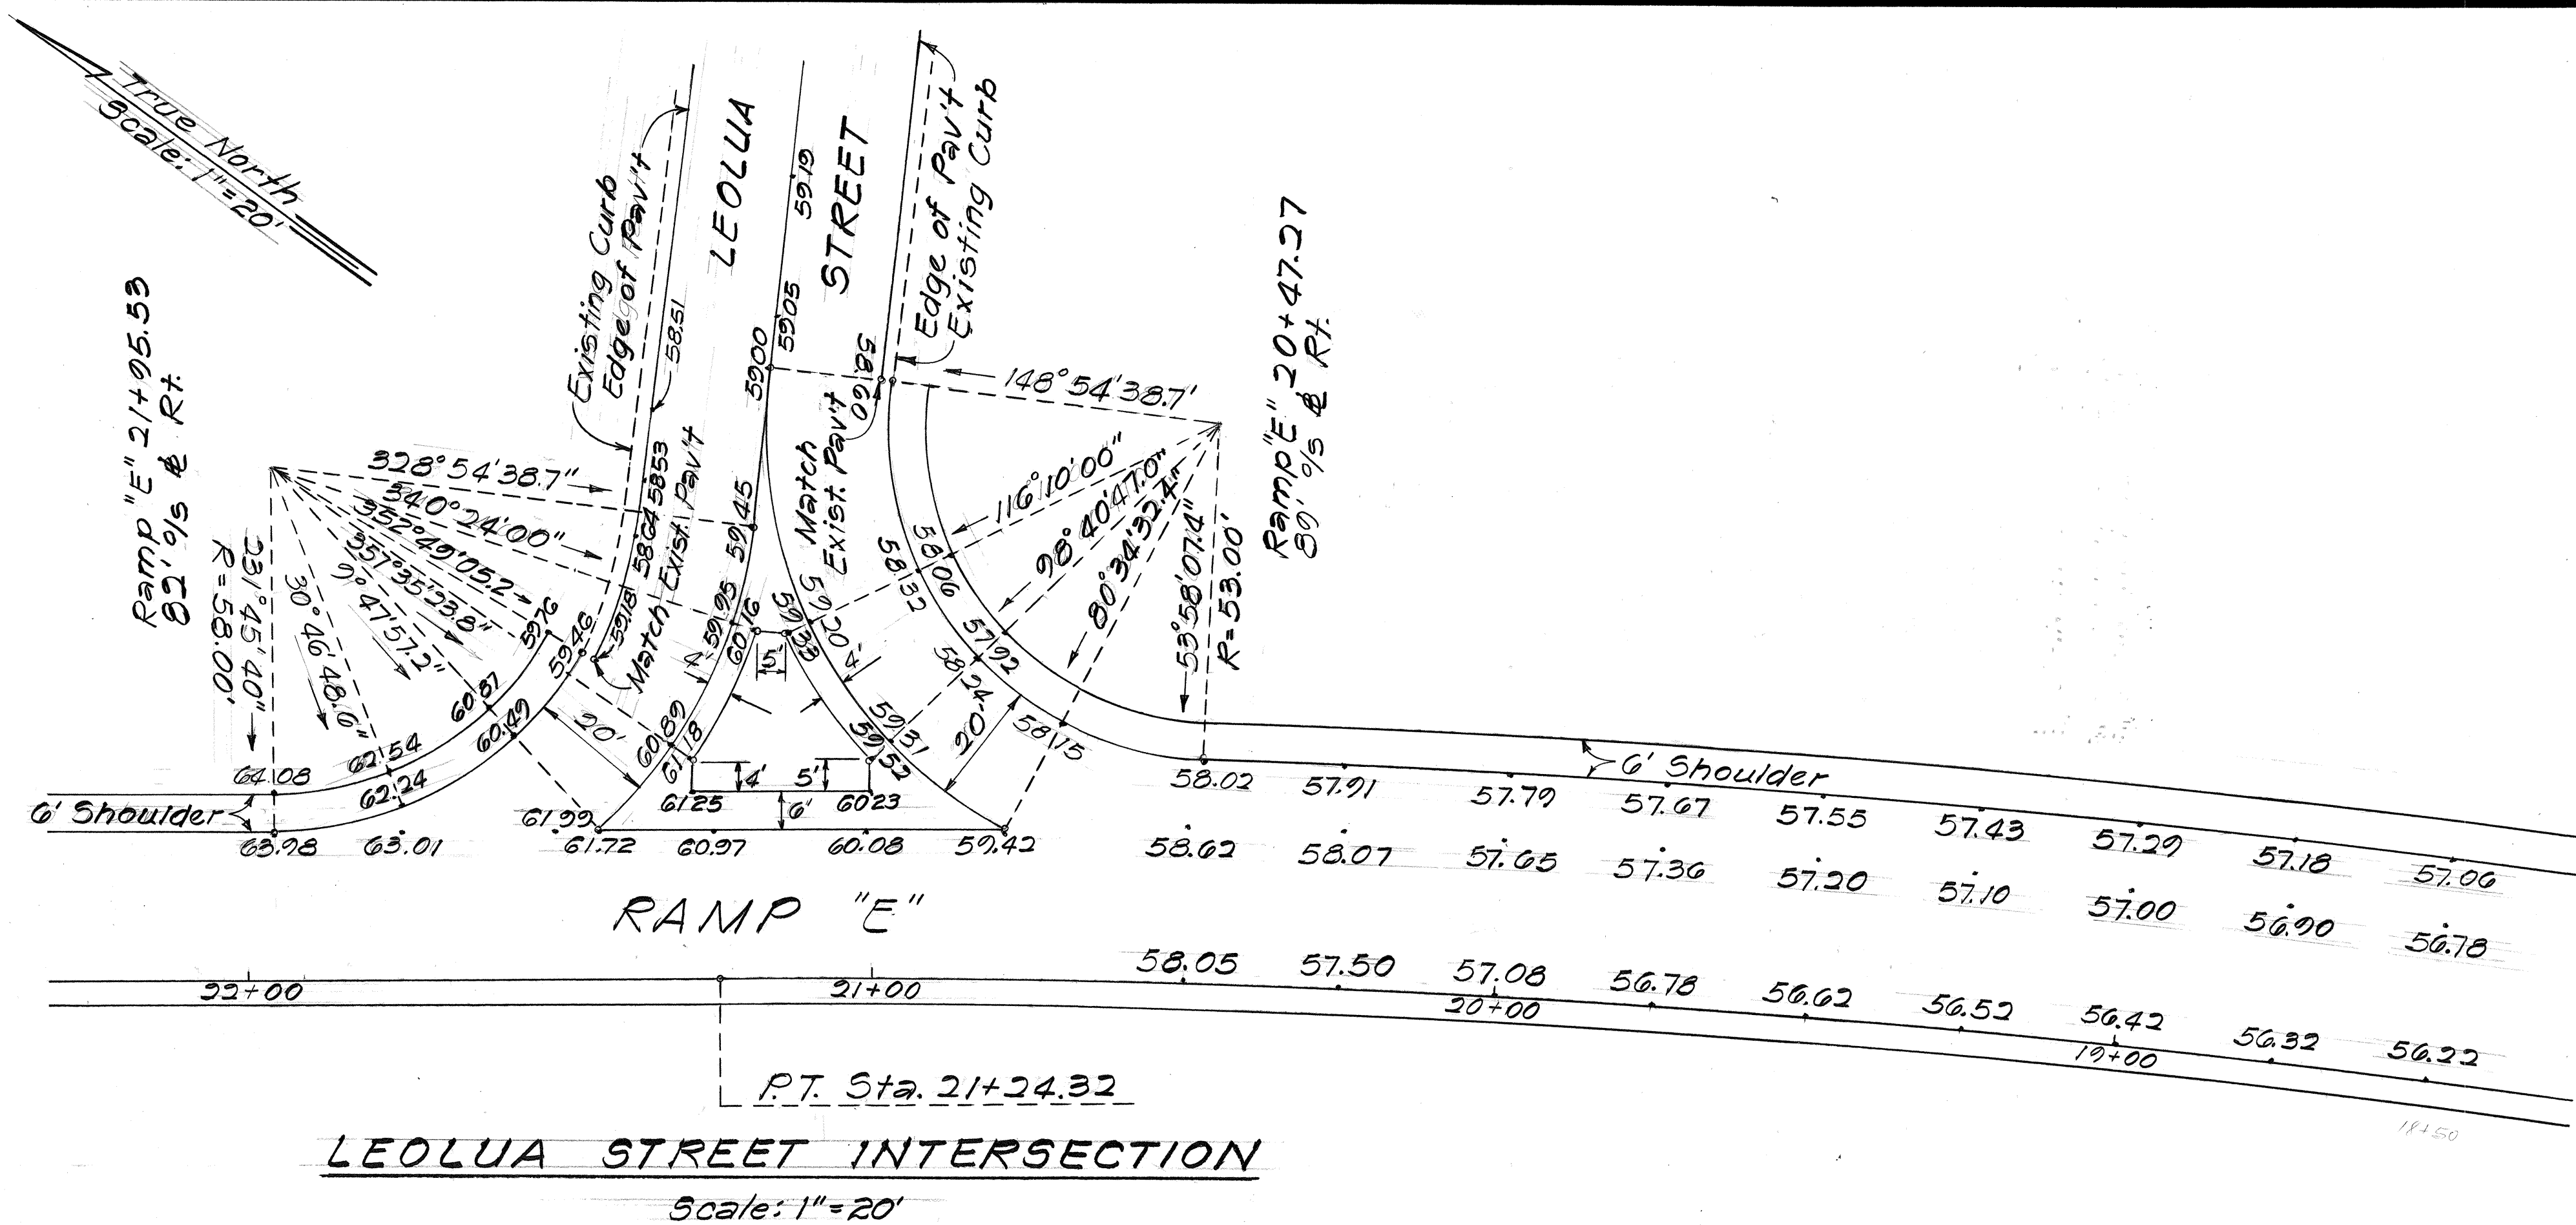

THIS TRACING PREPARED
DURING "AS-BUILT" POSTING

STATE OF HAWAII
DEPARTMENT OF TRANSPORTATION
LAND TRANSPORTATION FACILITIES DIVISION

INTERSECTION DETAILS

FORT WEAVER ROAD
ROUTE H-1 TO SOUTH OF
FARRINGTON HIGHWAY

SCALE: 1" = 20' DATE: August, 1981

SHEET No. OF SHEETS

ORIGINAL PLAN	SURVEY PLOTTED BY	DATE
NOTE BOOK	DRAWN BY	
	TRACED BY	
	DESIGNED BY	
	QUANTITIES BY	
	CHECKED BY	