	INDEX TO DRAWINGS	
SHEET NO.	DESCRIPTION	
1 .	TITLE SHEET	
2	TRAFFIC CONTROL PLAN AND NOTES	
3	TRAFFIC SIGNAL PLAN	
4	SIGNING AND STRIPING PLAN	
5	MISCELLANEOUS DETAILS	
6-7	TYPICAL DETAILS OF WHEELCHAIR RAMPS	
8 - 20	STANDARD DETAILS	
-		
/		



STATE OF HAWAII




DEPARTMENT OF TRANSPORTATION HIGHWAYS DIVISION


HONOLULU, HAWAII

"AS BUILT"
PLANS FOR

FARRINGTON HIGHWAY TRAFFIC SIGNALS AT PUPUPUHI STREET PROJECT NO. 9000A-01-81

DISTRICT OF EWA
ISLAND OF OAHU

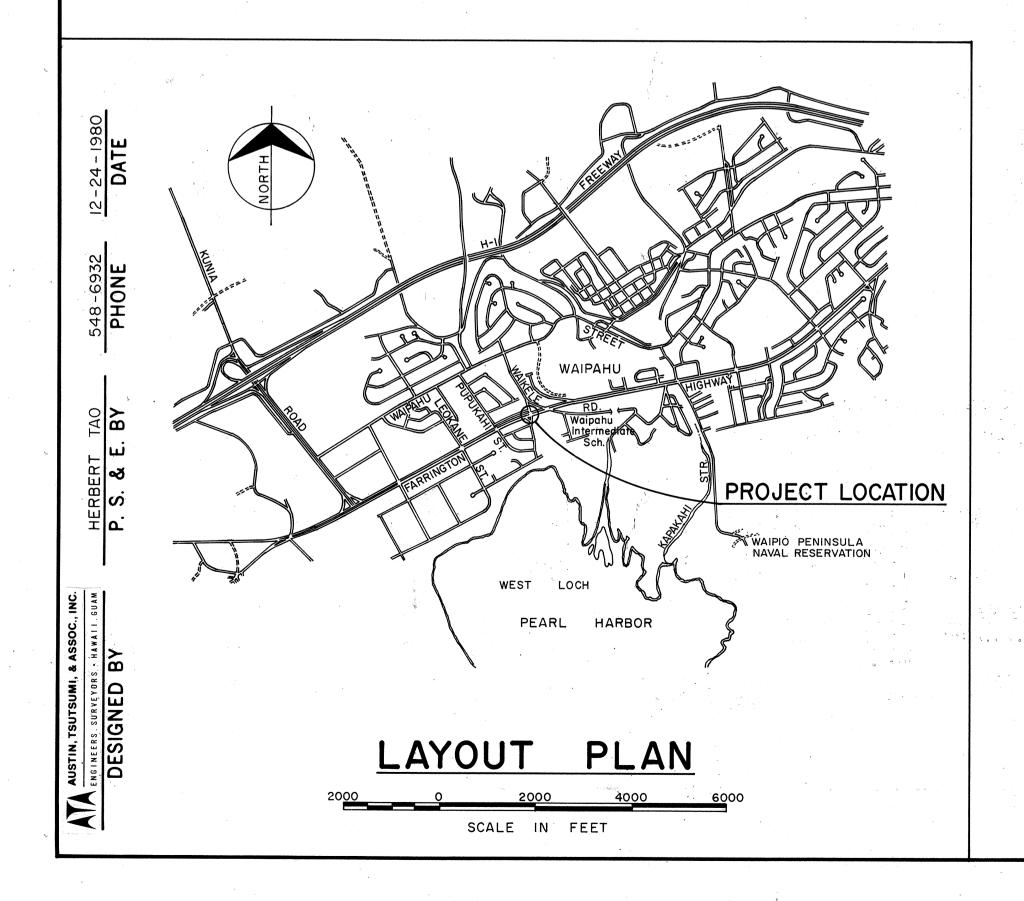

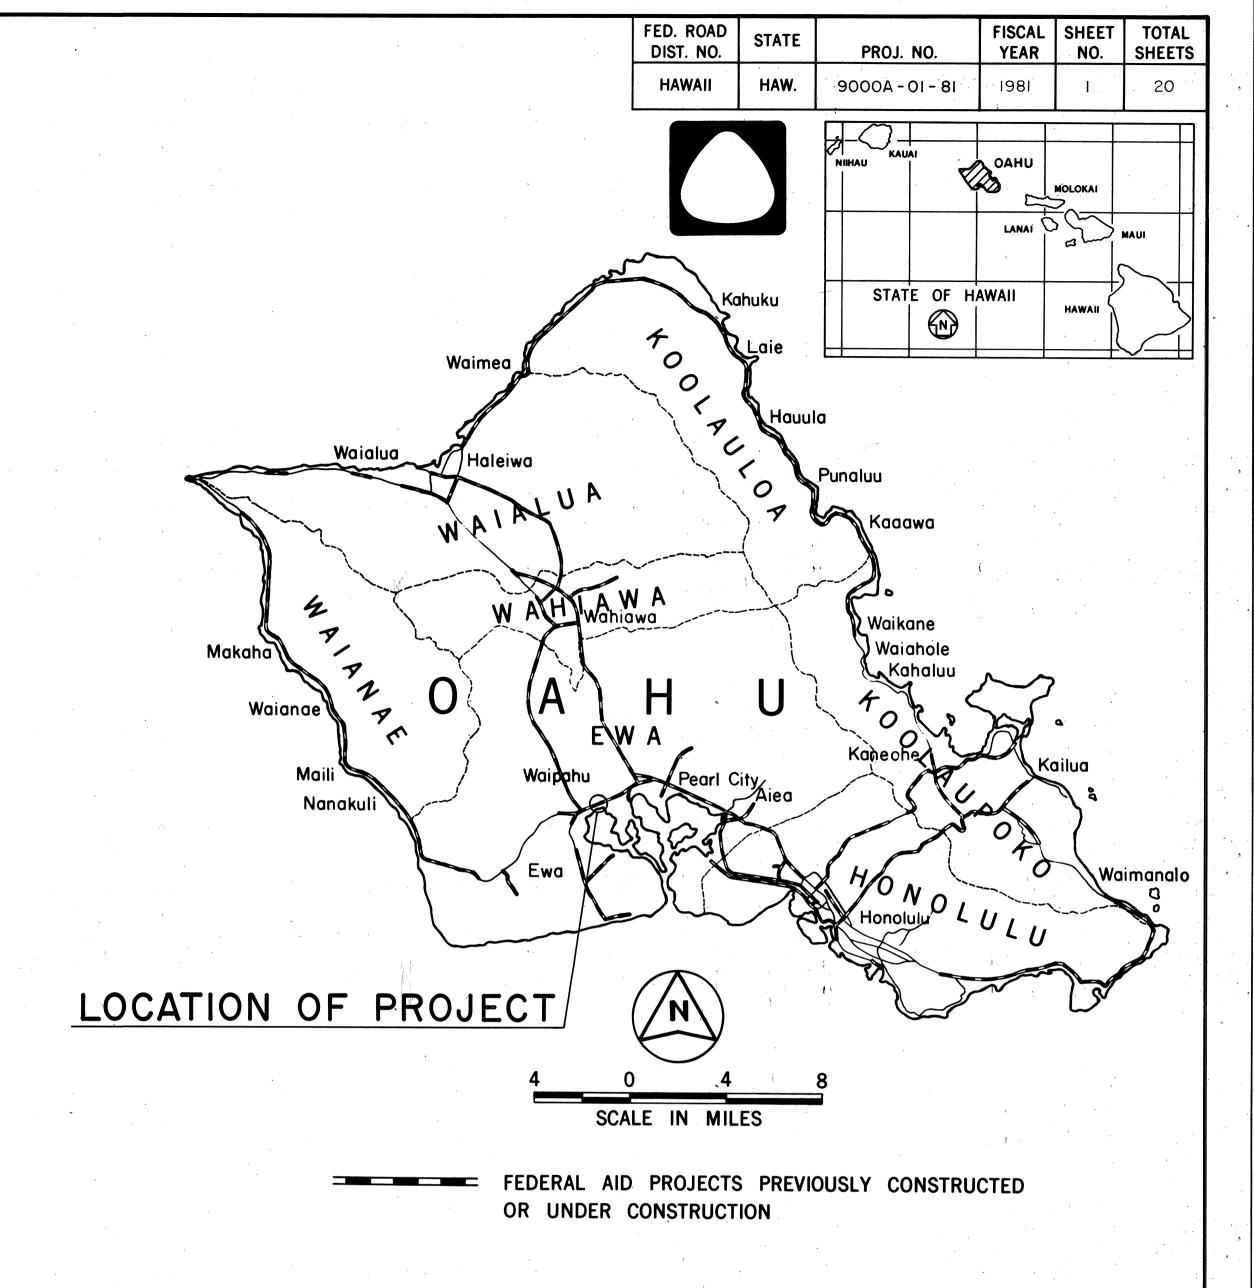

ALL CHANGES MADE DURING CONSTRUCTION HAVE BEEN NOTED IN RED ON THESE TRACINGS AND CHECKED BY

RESIDENT ENGINEER DATE

*	DEPARTMENT OF TRANSPOR	TATION
	STATE OF HAWAII	
	APPROVED:	
	James R. Carras GADIR. OF TRANSPORTATION	5/20/81
	MOIR. OF TRANSPORTATION	DÁTE