	INDEX TO DRAWINGS
SHEET NO.	DESCRIPTION
1	TITLE SHEET
2	LEGEND AND NOTES
3	TRAFFIC SIGNAL PLAN
4	DRAINAGE DETAILS
5-6	TYPICAL DETAILS OF WHEELCHAIR RAMPS
7-19	STANDARD DETAILS



STATE OF HAWAII




DEPARTMENT OF TRANSPORTATION HIGHWAYS DIVISION


HONOLULU, HAWAII

"AS BUILT"
PLANS FOR

FARRINGTON HIGHWAY
TRAFFIC SIGNALS AT MOKUOLA STREET
PROJECT NO. 9000A-02-82

DISTRICT OF EWA ISLAND OF OAHU

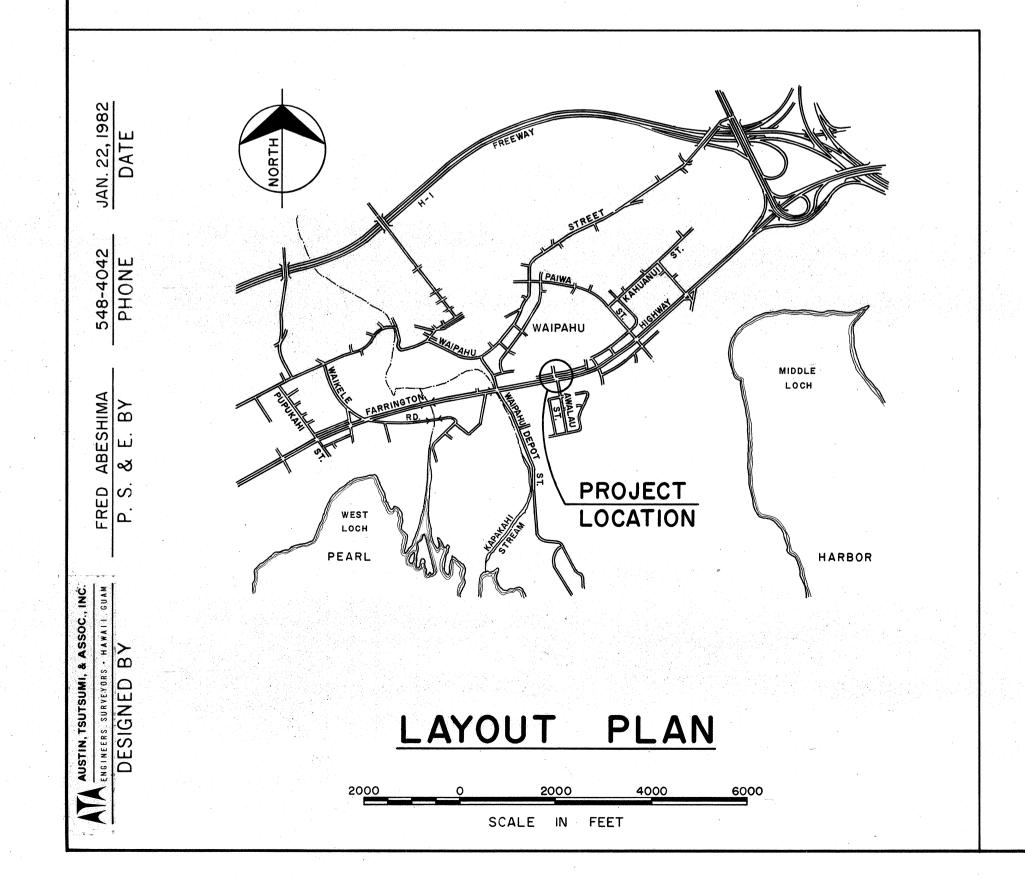

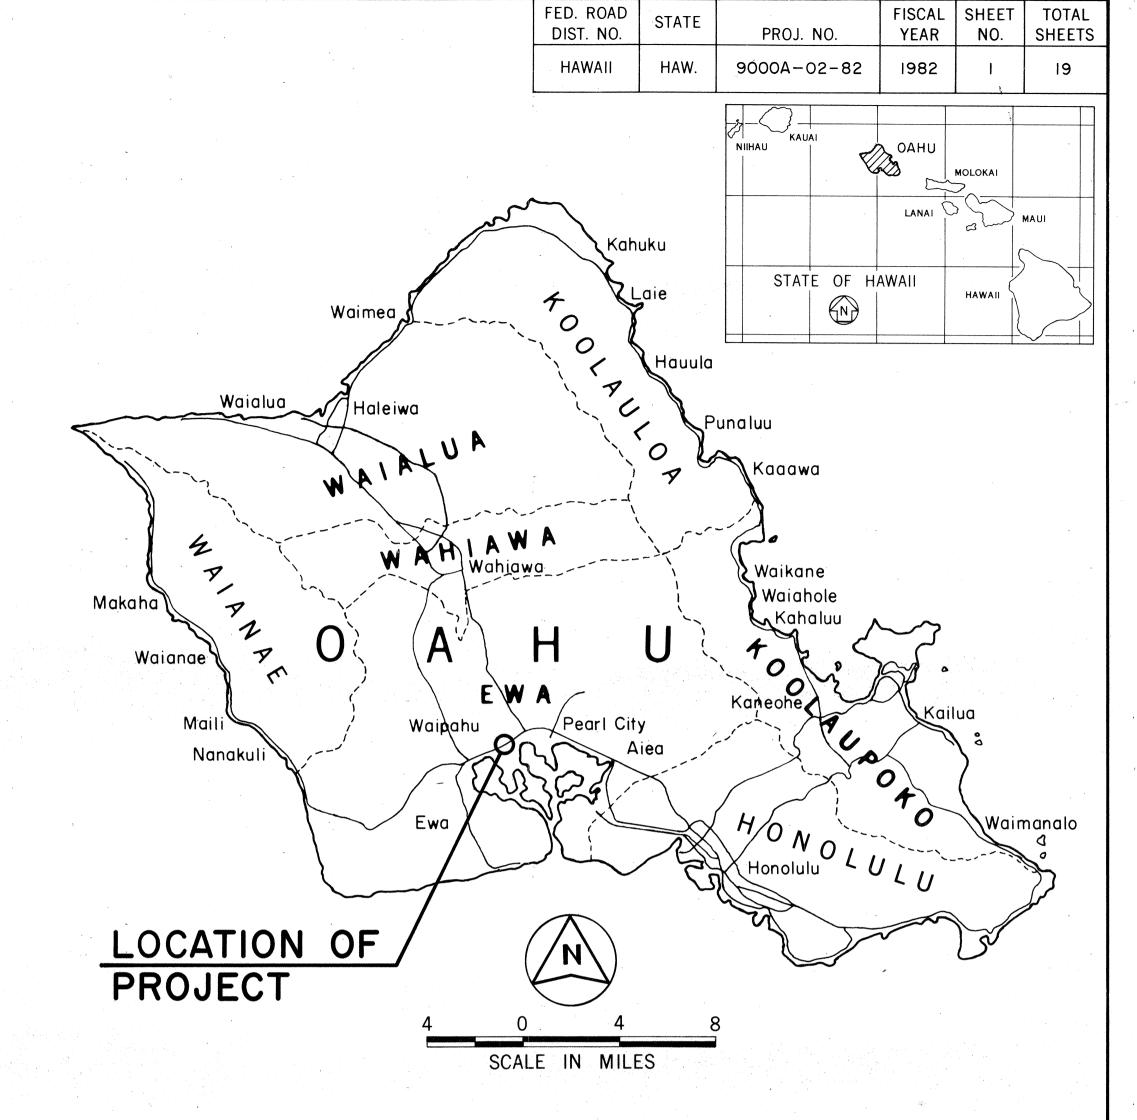

CHANGES MADE DURING CONSTRUCTION HAVE BEEN INCORPORATED ON THESE PLANS EXCEPT CHANGES IN THE ORIGINAL THEORETICAL QUANTITIES. FOR ACTUAL QUANTITIES, REFER TO PROJECT LEDGER AND/OR COMPUTATION BOOK.

Robert y. Amai RESIDENT ENGINEER

DATE

DEPARTMENT OF TRANSPORTATION
STATE OF HAWAII

APPROVED:

Larras
LISTAZ

DIR. OF TRANSPORTATION

DATE