	INDEX TO DRAWINGS
SHEET NO.	DESCRIPTION
l	TITLE SHEET
2	TYPICAL SECTION AND
- Parl Parl Parl Parl Parl Parl Parl Parl	MISCELLANEOUS DETAILS
3	PLAN
4-7	STANDARD DETAILS
<del>en de resta el como en celebra de esc</del> epara en entre epochez (compagyo escapaciones com period	
	ı



STATE OF HAWAII

## DEPARTMENT OF TRANSPORTATION HIGHWAYS DIVISION


"AS-BUILT" PLANS FOR

## FARRINGTON HIGHWAY


IMPROVEMENT OF TRIANGLE AT WAIPAHU HIGH SCHOOL

PROJECT NO. 9000A-01-82

DISTRICT OF EWA ISLAND OF OAHU

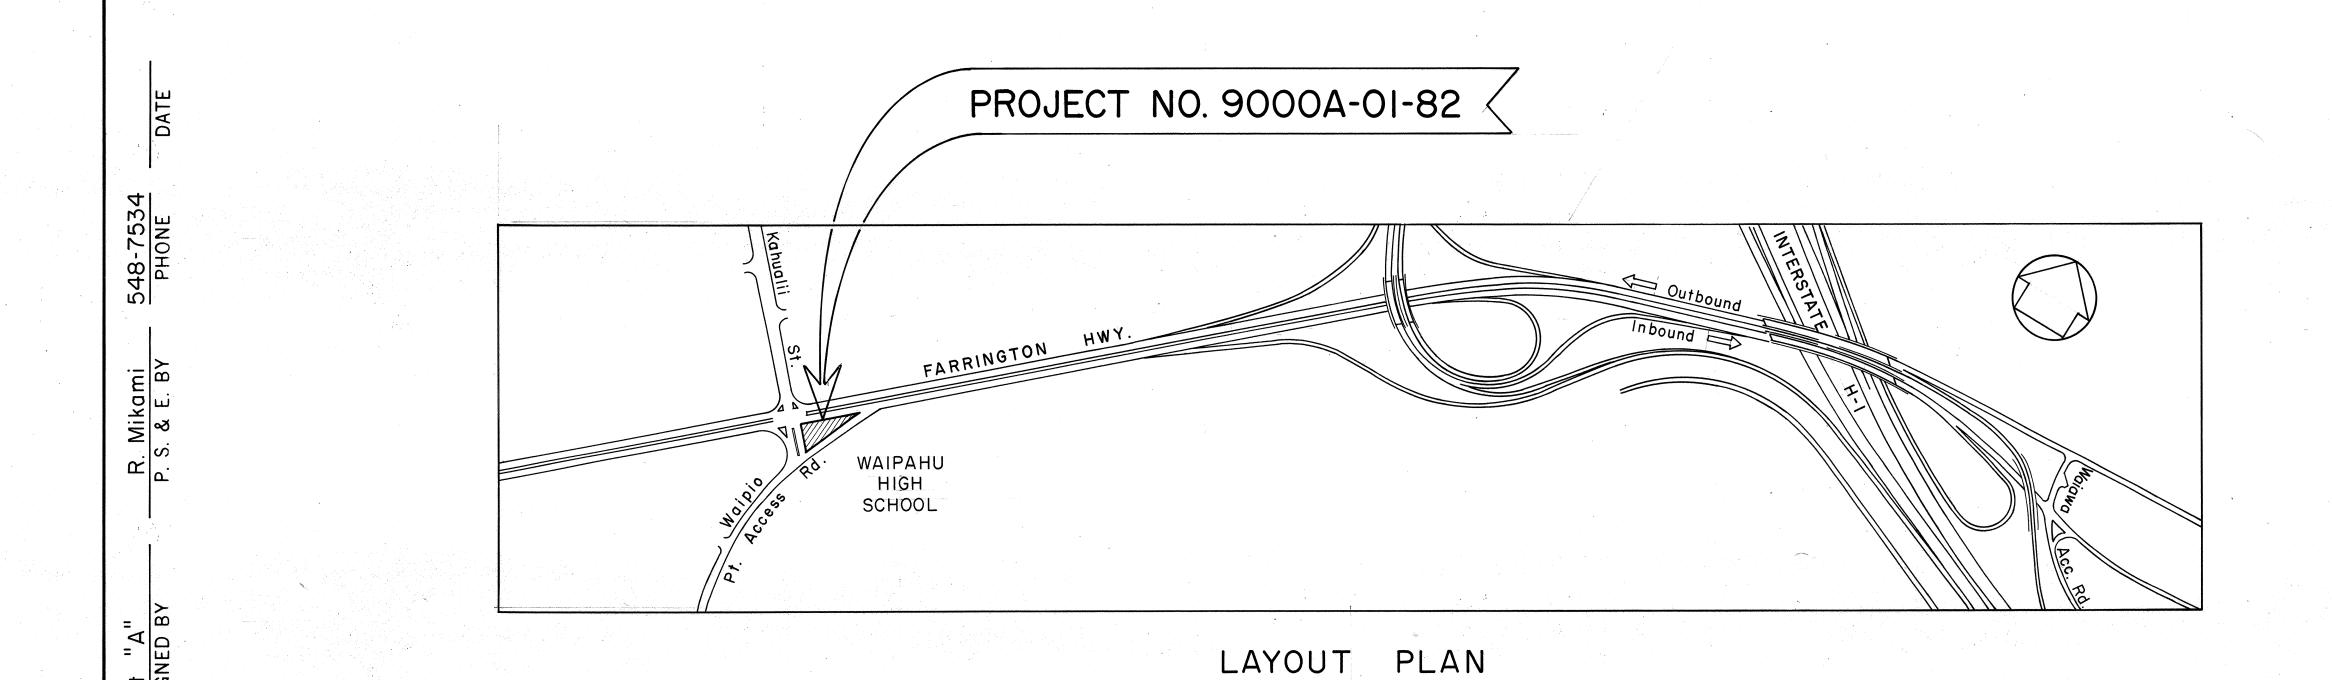

SCALE IN HUNDRED FEET

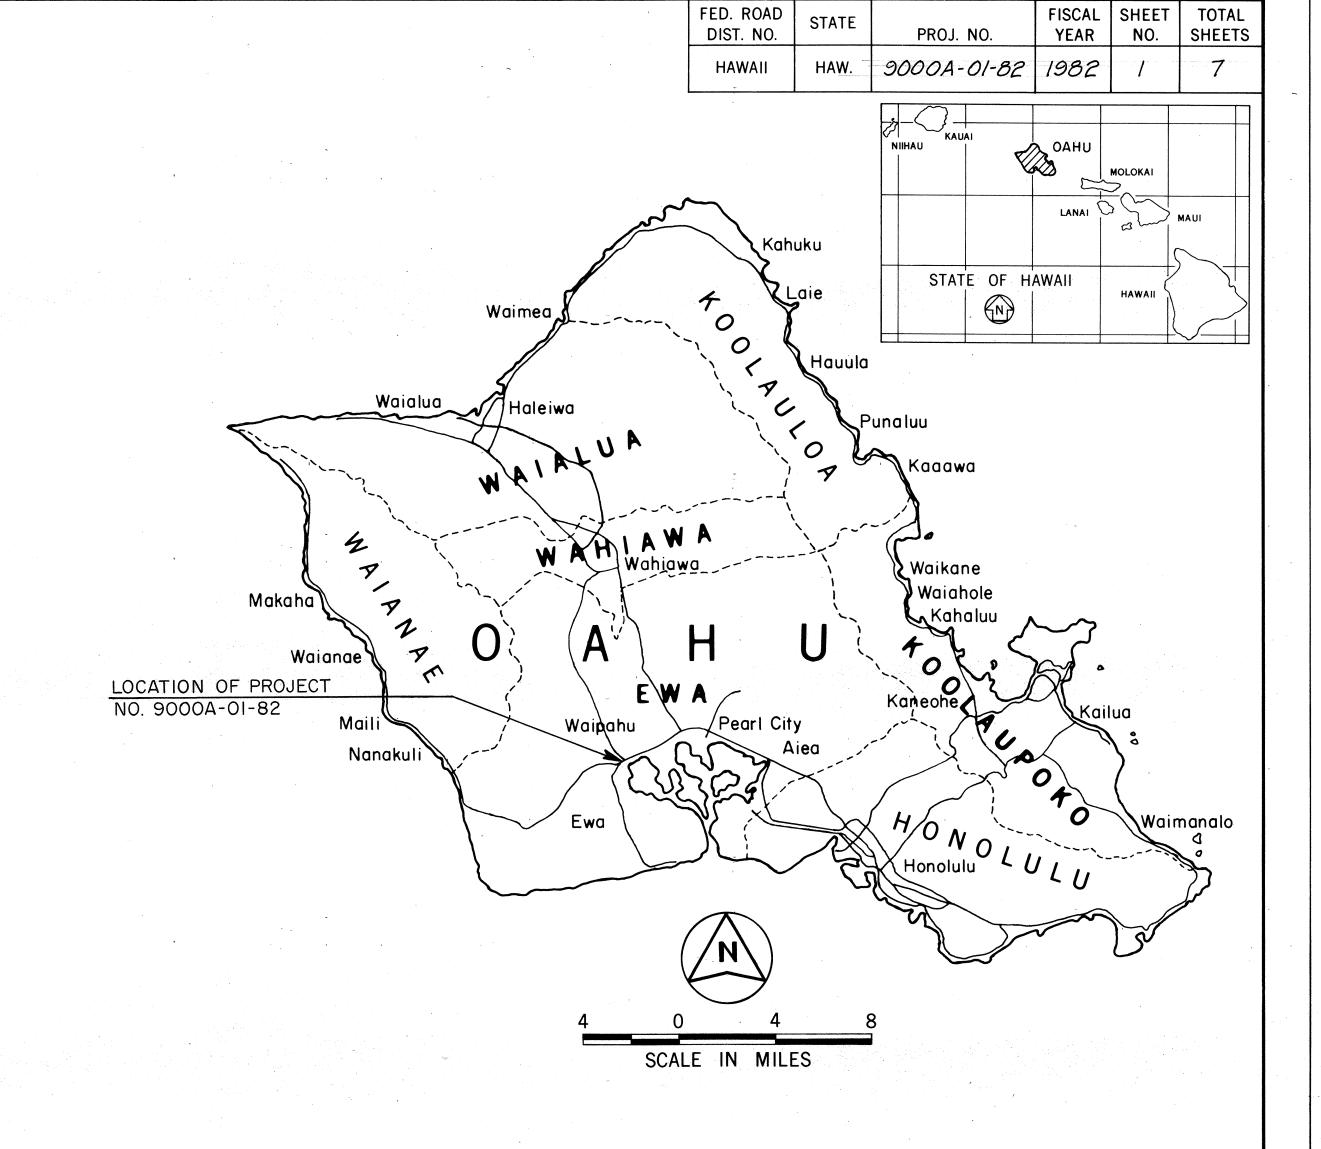

ALL CHANGES MADE DURING CONSTRUCTION HAVE BEEN INCORPORATED ON THESE PLANS IN RED EXCEPT CHANGES IN THE ORIGINAL THEORETICAL QUANTITIES. FOR ACTUAL QUANTITIES, REFER TO PROJECT LEDGER AND/OR COMPUTATION BOOK.

Robert G. Smail RESIDENT ENGINEER

DEPARTMENT OF TRANSPORTATION STATE OF HAWAII APPROVED:

DIR. OF TRANSPORTATION