
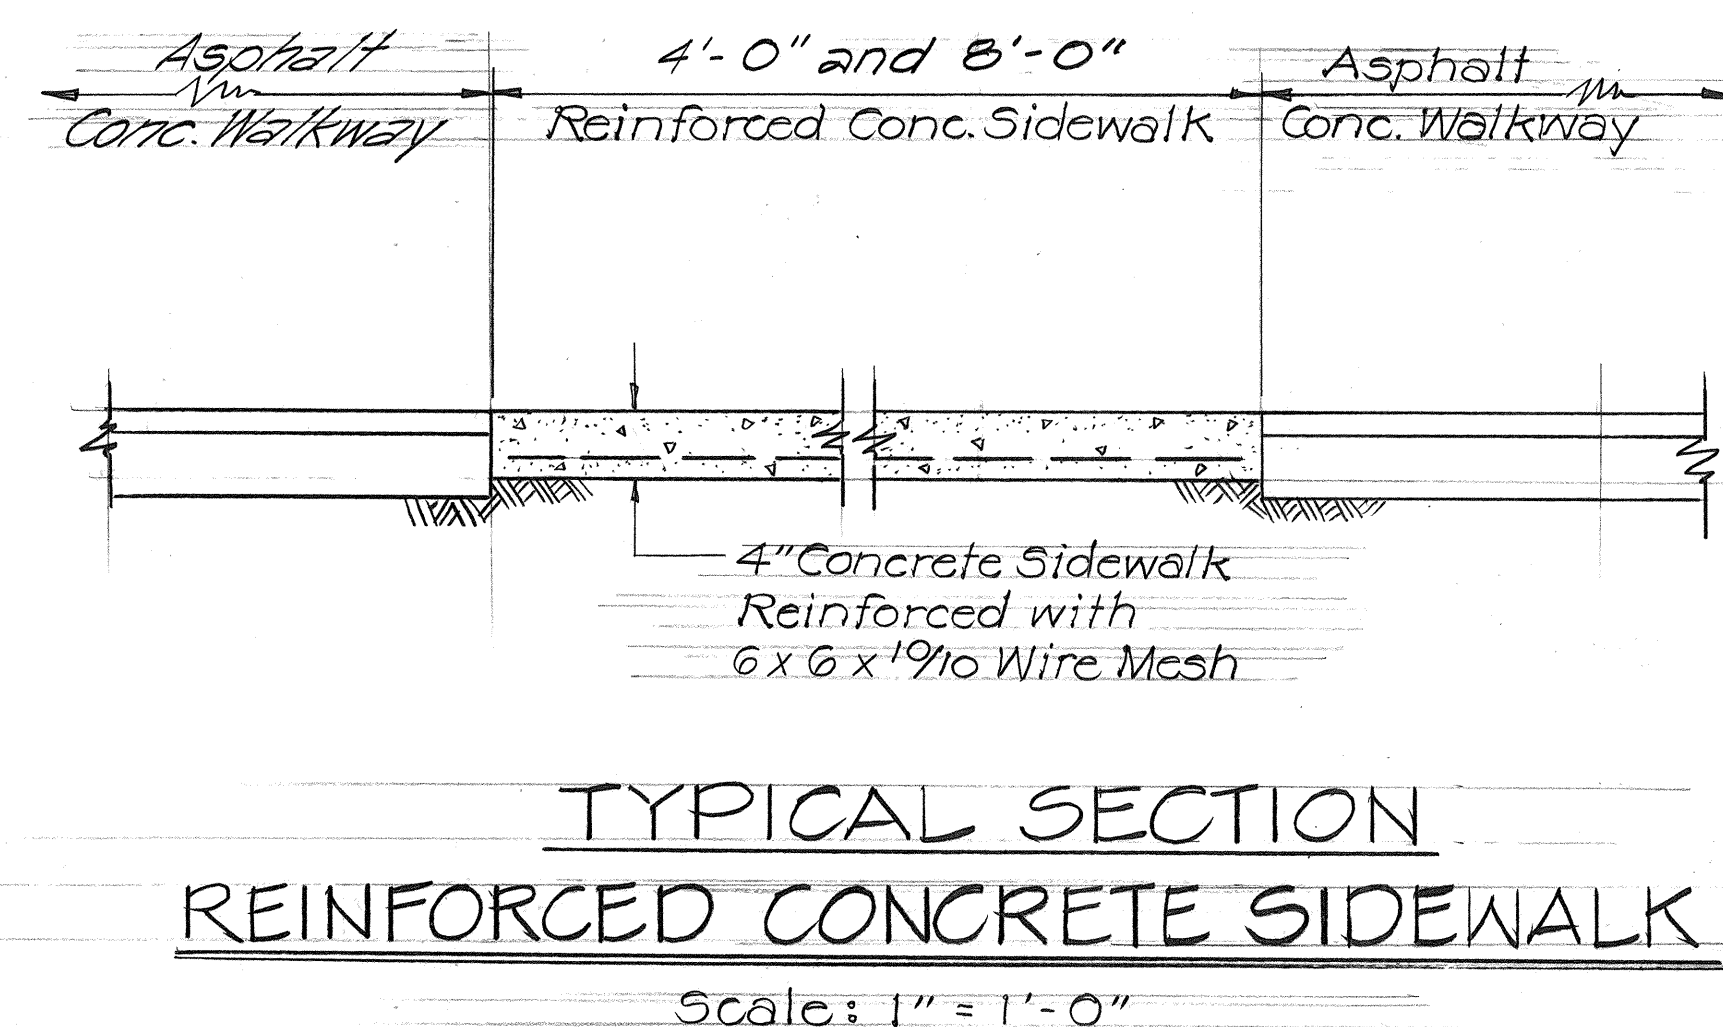
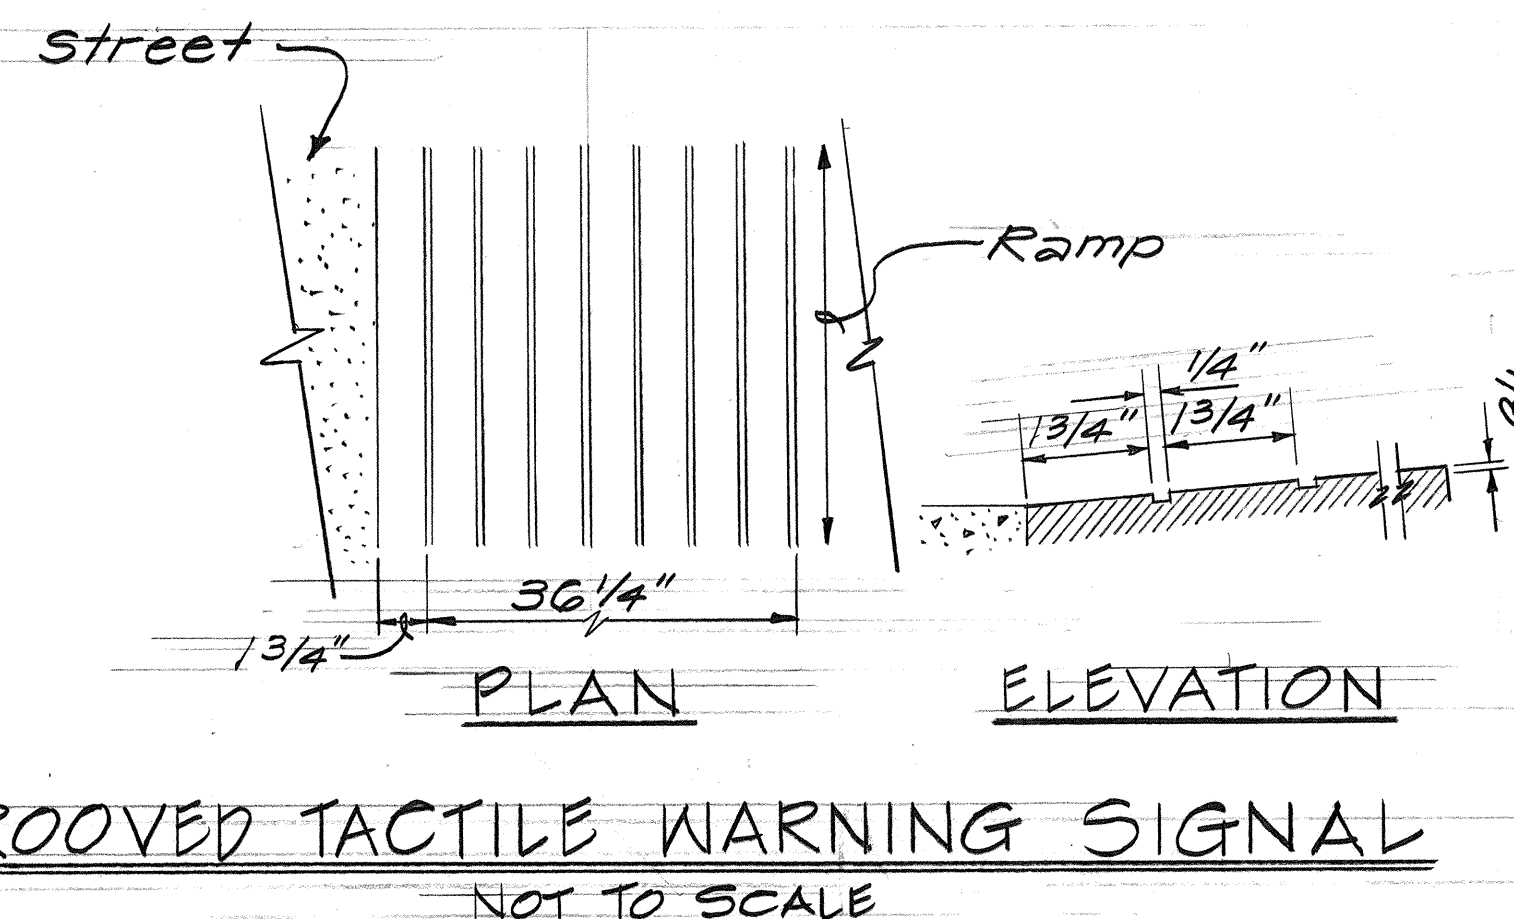
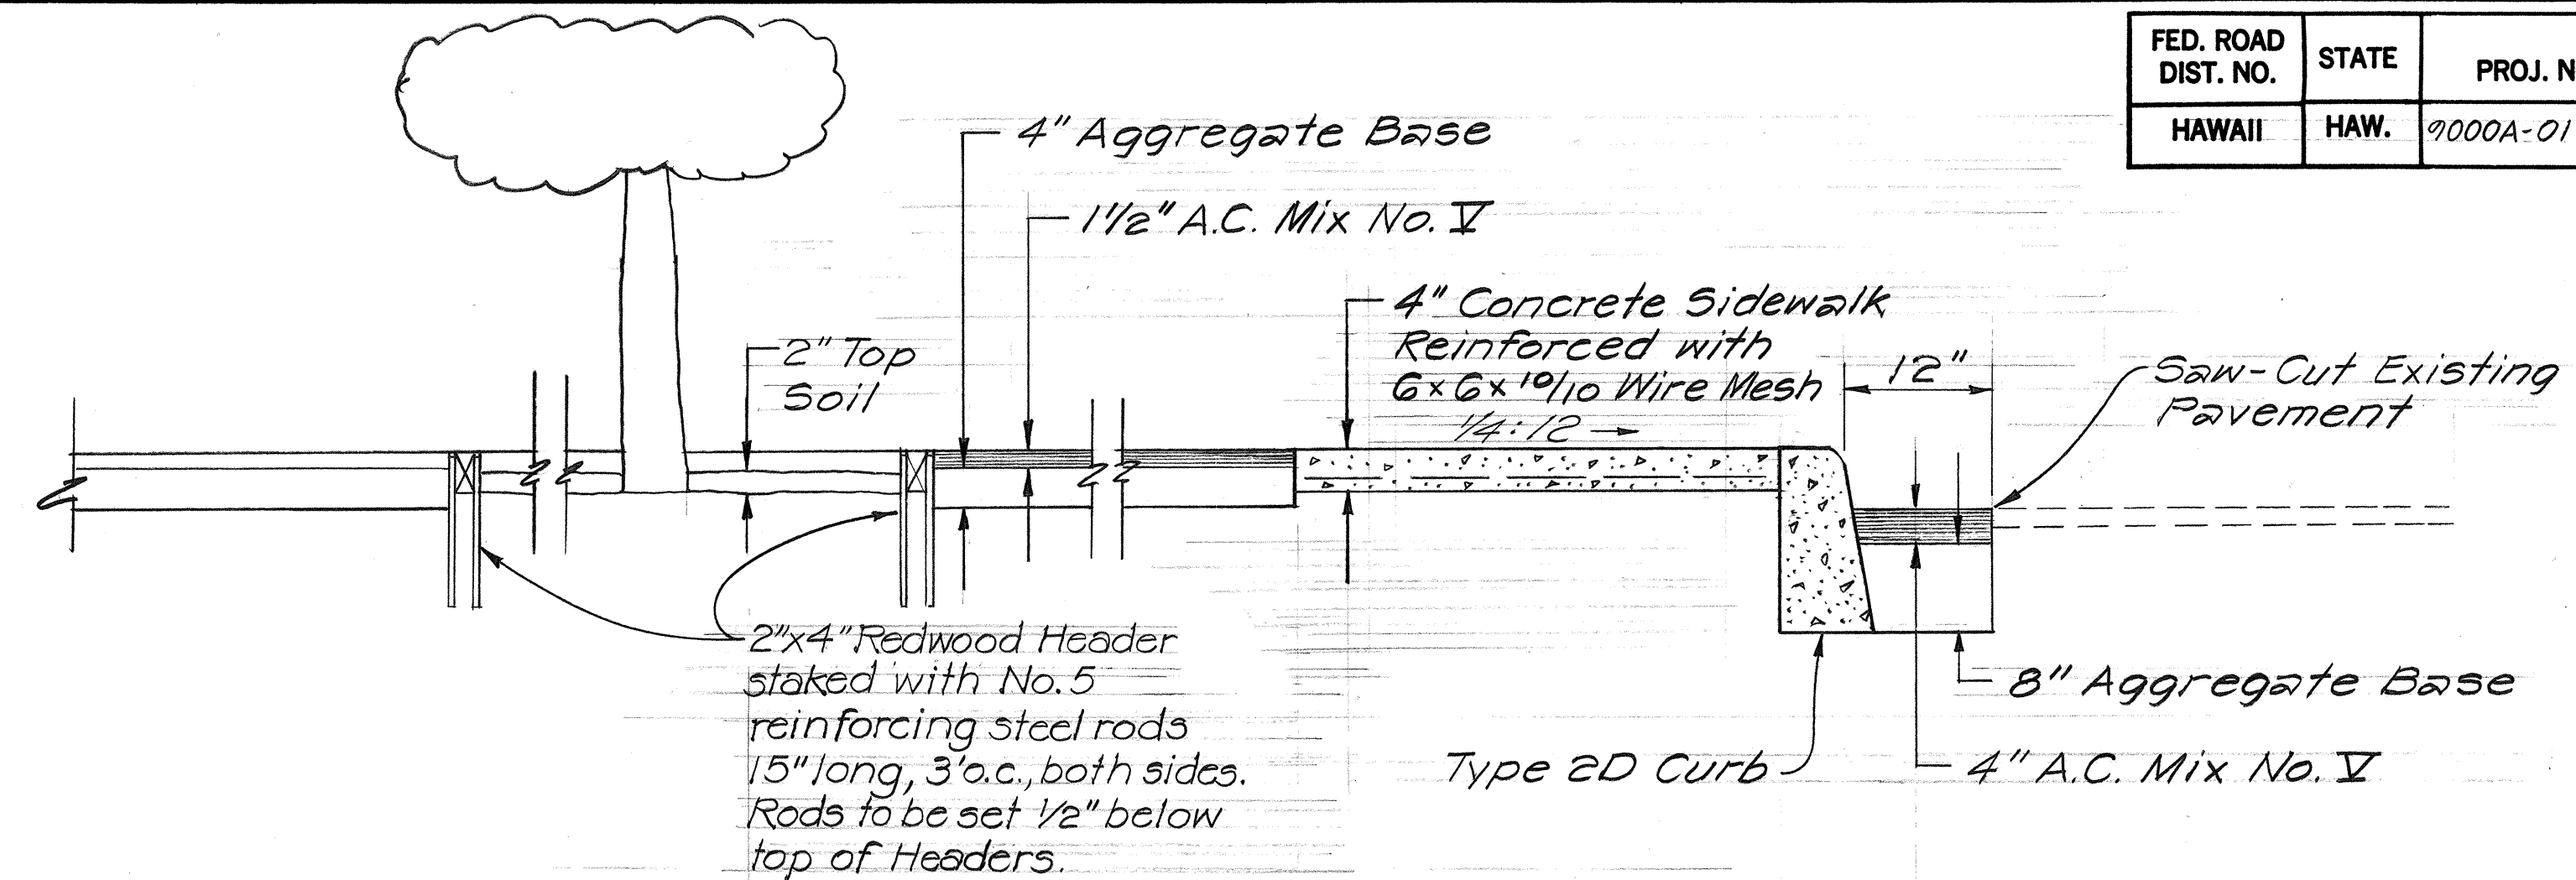
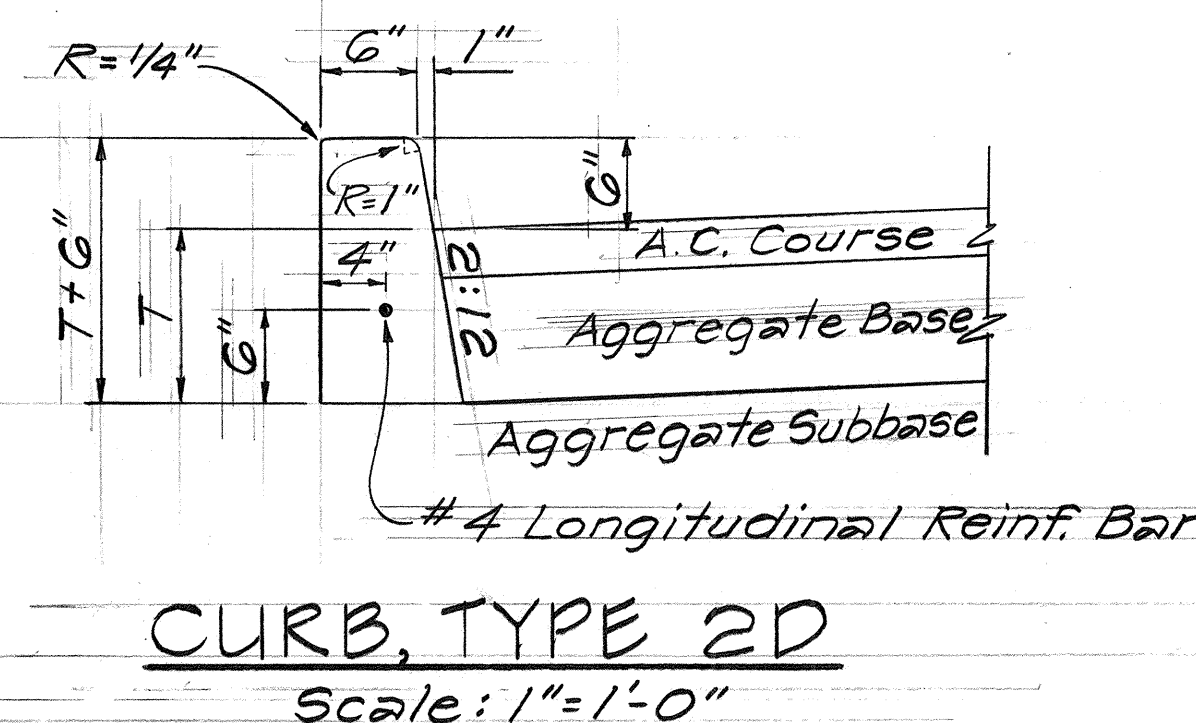
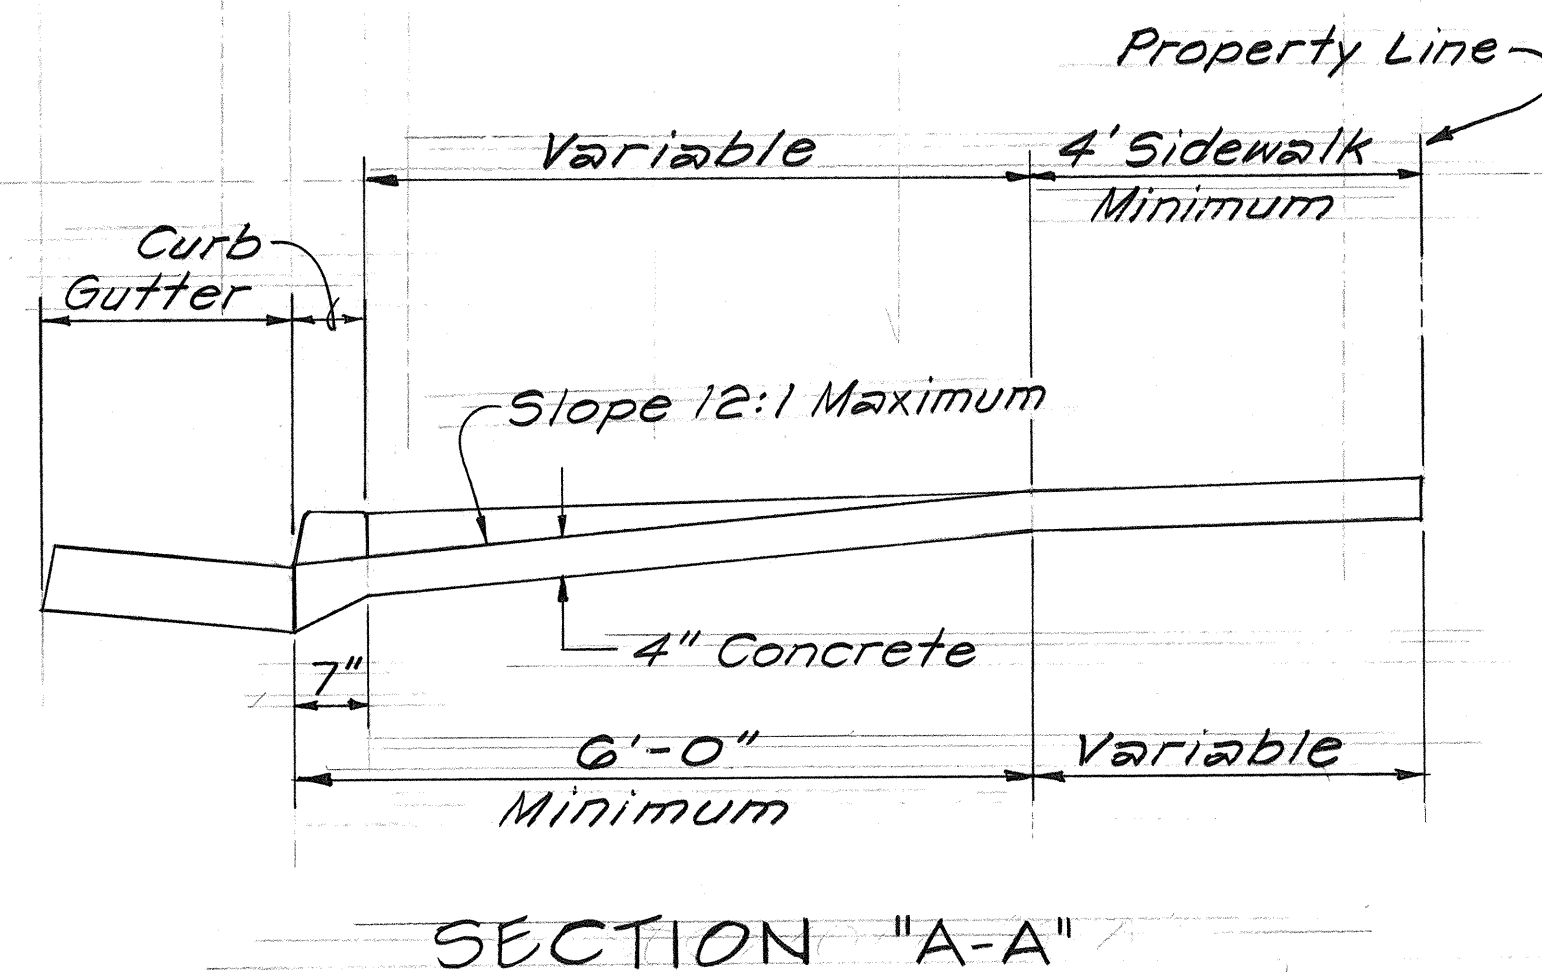
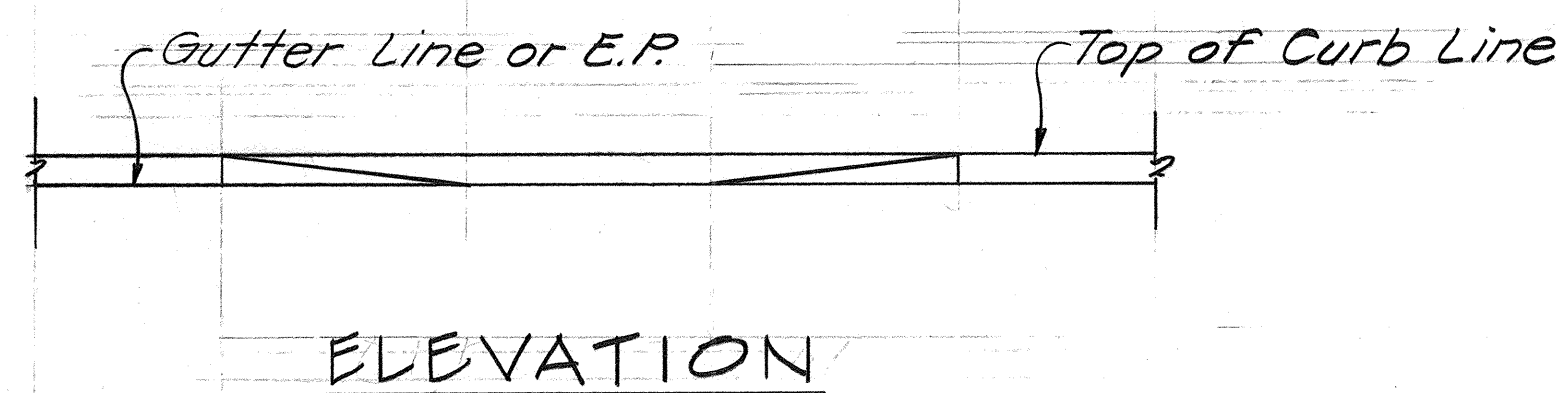


FED. ROAD DIST. NO.	STATE	PROJ. NO.	FISCAL YEAR	SHEET NO.	TOTAL SHEETS
HAWAII	HAW.	9000A-01-82	1982	2	7

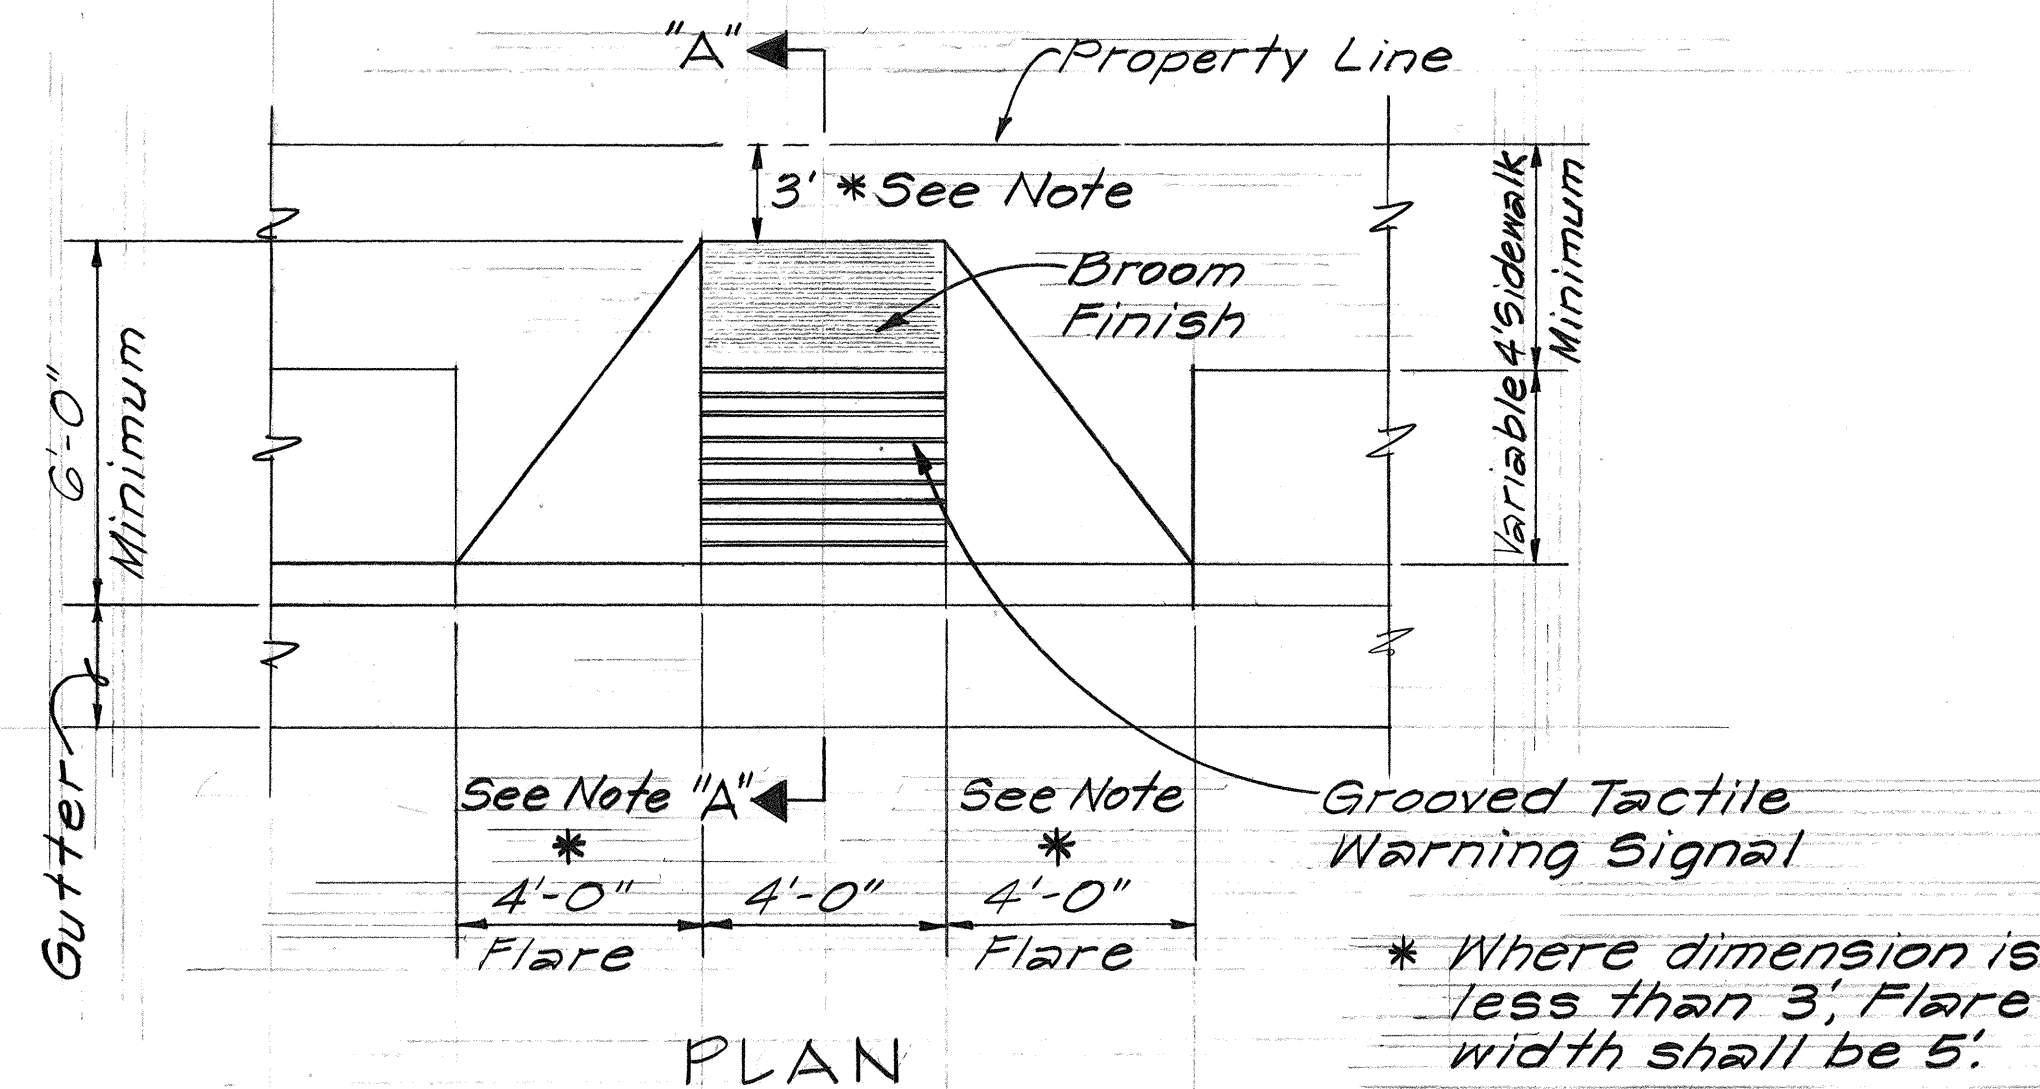

GENERAL NOTES:

- Items of work for this project are as follows:
 - Remove existing curbs around the triangle and construct new Type 2D Curbs.
 - Clear, grade, compact and spray nonemergent weed killer on the triangle area.
 - Construct concrete sidewalk.
 - Construct wheel chair ramps.
 - Construct asphalt concrete walkway.
 - Adjust existing pullboxes to conform to new sidewalk elevation.
 - Install, remove and replace existing regulatory signs.
 - Repaint existing crosswalks and stop bars.
- Locations of the underground conduits for the traffic signal system as shown on the plans are approximate. The Contractor shall verify the exact locations before the curb removal operations. The Contractor shall exercise caution during this operation as he may uncover other underground facilities not shown on the plans. If any facilities should be damaged as a result of his operations, the Contractor will be held liable and he shall replace all damaged facilities in accordance with the Standards and Specifications of the State and/or the affected utility agency.
- The Contractor shall provide safe and convenient access to the bus shelter and school campus throughout the duration of construction.
- The top surfaces of concrete sidewalks shall have an abrasive coating. Refer to Sections 503.03(11)(3)(b) and 712.11 of the Standard Specifications.
- Exact location of "NO PARKING" signs on the roadway shoulder to be determined in the field by the Engineer.

STATE OF HAWAII
DEPARTMENT OF TRANSPORTATION
HIGHWAYS DIVISION

FARRINGTON HIGHWAY
IMPROVEMENT OF TRIANGLE
AT WAIPAHU HIGH SCHOOL
PROJECT NO. 9000A-01-82

Scale: As Shown

SHEET NO. OF SHEETS