	INDEX TO DRAWINGS
SHEET NO.	DESCRIPTION
	TITLE SHEET
2 - 6	PLANS, SCHEDULES, GENERAL NOTES AND TYPICAL DETAILS
•	
·	
·	
,	,
<u>U</u>	



STATE OF HAWAII


TRANSPORTATION DEPARTMENT DIVISION HIGHWAYS HONOLULU, HAWAII

> "AS-BUILT" PLANS FOR

VARIOUS INTERSTATE ROUTES CONVERSION OF MERCURY LUMINAIRES HIGH PRESSURE SODIUM

FEDERAL AID INTERSTATE PROJECT NO. IR - 0300(185)

DISTRICTS OF EWA, HONOLULU, KOOLAUPOKO & WAHIAWA ISLAND OF OAHU

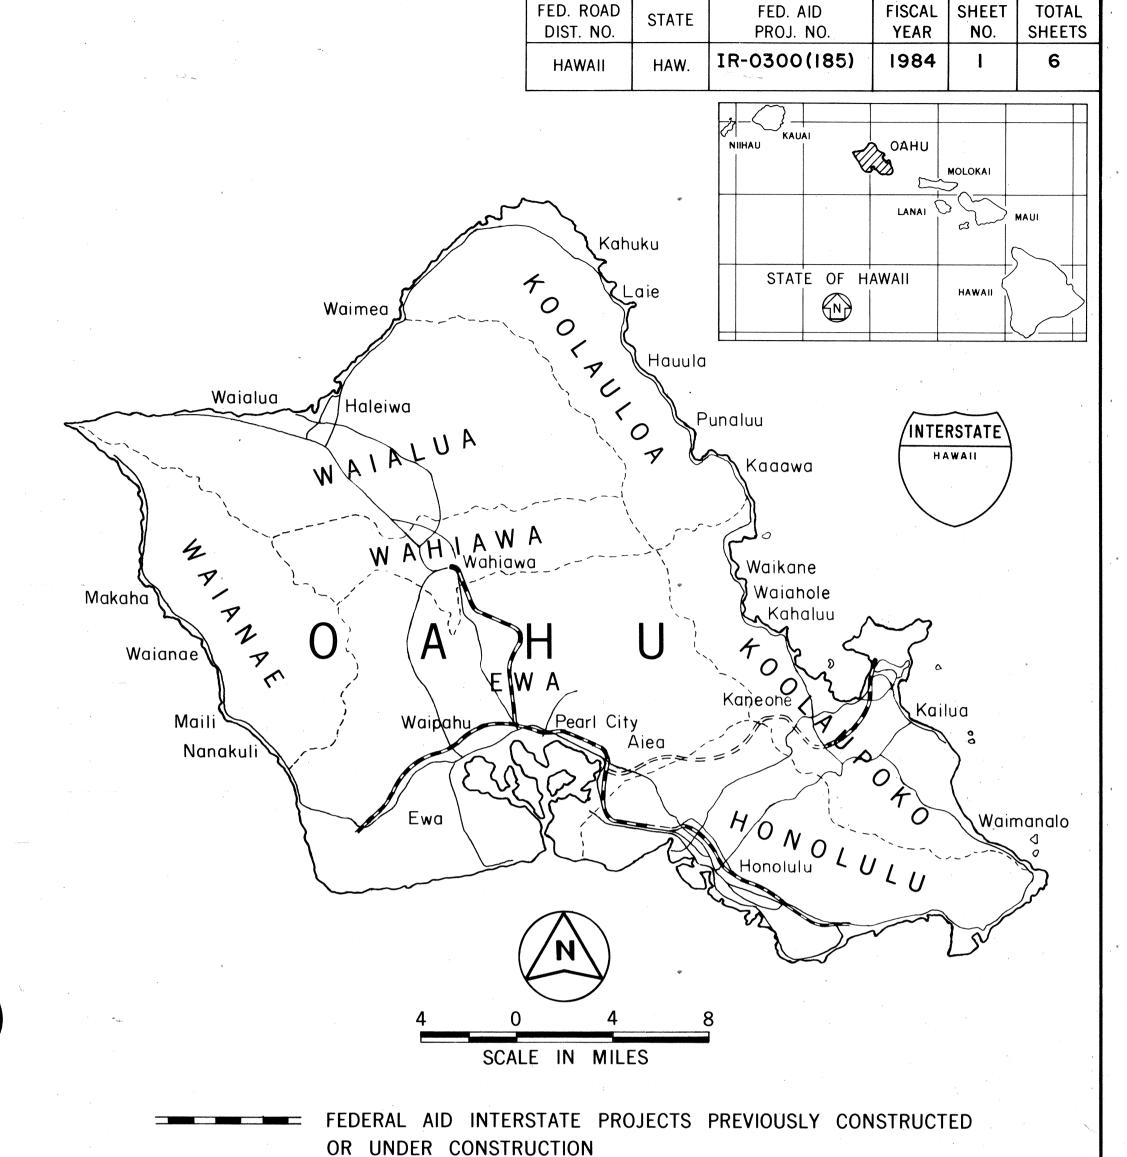

PROJECT DESCRIPTION

Improvements consist of replacing existing mercury vapor luminaires with new high pressure sodium luminaires at the following locations:

INTERSTATE RT. H-I: Palailai I.C. to Keeaumoku St.

- " H-2: Wahiawa I.C. to Leilehua I.C.
 - " H-3: Kailua I.C. to Mokapu I.C.

NO SIGNIFICANT CHANGES WERE MADE DURING CONSTRUCTION ON THESE PLANS EXCEPT CHANGES IN THE ORIGINAL THEORETICAL QUANTITIES. FOR ACTUAL QUANTITIES, REFER TO PROJECT LEDGER AND/OR COMPUTATION BOOK.

RESIDENT ENGINEER DATE

DEPARTMENT OF TRANSPORTATION FEDERAL HIGHWAY ADMINISTRATION APPROVED: DIVISION ADMINISTRATOR

DEPARTMENT OF TRANSPORTATION STATE OF HAWAII