

DRAINAGE NOTES:

- Existing drainage system shall be functional at all times during construction. Contractor shall furnish materials, equipment, labor, tools, and incidentals necessary to accomplish maintenance of flow. The cost shall be incidental to the various contract items.
- Contractor shall verify the locations of all existing culverts in the field. Any existing culverts damaged during construction shall be repaired or replaced by the contractor at his expense.
- Concrete shall be class A unless otherwise noted.
- Location of Manhole Rungs for Type "B" Grated Drop Inlet shall be determined by the Engineer.
- For typical detail of reinforcing steel around 24" and 36" Culvert See Plan sht. no. 6.
- Grass Swale located along 36" culvert shall not be measured separately but shall be considered incidental to imported borrow.
- Existing elevations are based on D.M. Datum MSL = R-13 = 11.565' (Vertical Control Data Book dated August, 1973)

Sta. 124+13± Rt. =
Drain Sta. 0+00

Type "A" G.D.I.
Inv. = 2.25±
Begin Grass Swale

Demolish and
Remove Existing
Concrete Headwall

Line Parking (Pk.)
2060.5327 S
8301.5513 W

Existing 36" RCP

124+00

78°22'49" → 20.20'

Existing 24" RCP

78°42' → 10.36'

Demolish and Remove
Exist. Concrete Ret. Wall

Kim You Pang & Wif.
Gladys Koon Heu (Owners)

258°42' → 10.00'

Drain Sta. 0+62

Type "B" G.D.I.

Inv. = 2.00

Drain Sta. 0+05

Relocate Exist. 8" Waterline

For details, see sht. no. C085-1

Drain Sta. 1+22±

Type "B" G.D.I.

Inv. = 1.76

Construction Limits

330°13'52" → 113.40'

Existing Earth Swale

153°36' → 115.04'

36" Culvert (Steel Spiral Rib Pipe)

2-story bldg.

Construction Limits along Drainage Easement

Richard K.L. Pang
Lawrence J.T. Ching
& Wif. Jennie P. (Owners)

Drain Sta. 2+44±

Type "B" G.D.I.

Inv. = 1.29

Drain Sta. 2+44± to Drain Sta. 4+17±

Construct: Type "B" G.D.I. (For detail, see Plan sht. no. 6)
Install: 36" Culvert (For Profile, see Plan sht. no. 4)

Estimated Quantities

Imported Borrow 81 CY
Structural Excavation 206 CY
Bed Course Material 40 CY
36" Culvert (Aluminum Spiral Rib Pipe, Sheet Thickness, 0.075") 169 LF
Type "B" Grated Drop Inlet, 4.00 feet to 4.00 feet 1 Ea.

Drain Sta. 4+17± to Drain Sta. 6+33±

Construct: Type "C" C.B. (For detail, see Plan sht. no. 7)
Install: 36" Culvert (For Profile, see Plan sht. no. 4)

Estimated Quantities

Imported Borrow 166 CY
Structural Excavation 264 CY
Bed Course Material 50 CY
36" Culvert (Aluminum Spiral Rib Pipe, Sheet Thickness, 0.075") 212 LF
Type "C" Catch Basin, 5.00 feet to 5.00 feet 1 Ea.

Drain Sta. 4+17±

Type "B" G.D.I.

Inv. = 0.50

10' Drainage Easement in Favor of State of Hawaii

36" Culvert (Aluminum Spiral Rib Pipe)

314°45' → 17.84'

Existing Ditch

10' Drainage Easement in Favor of State of Hawaii

36" Culvert (Aluminum Spiral Rib Pipe)

315°16'30" → 3310.4285 S

7952.7221 N

Line Ake (Hub)

3244.9530 S

7950.0474 N

School (3/4" pipe)

3404.7230 S

7943.8077 W

Drain Sta. 0+00 to Drain Sta. 0+62

Construct: Type "A" G.D.I. (For detail, see Plan sht. no. 5)
Type "B" G.D.I. (For detail, see Plan sht. no. 6)
Install: 36" Culvert (For Profile, see Plan sht. no. 4)

Estimated Quantities

Removal of Existing Concrete Wall 1 Ea.
Imported Borrow 83 CY
Structural Excavation 53 CY
Bed Course Material 14 CY
36" Culvert (Steel Spiral Rib Pipe, Sheet Thickness, 0.079 Inch) 58 LF
Type "A" Grated Drop Inlet, 3.00 feet to 3.00 feet 1 Ea.
Type "B" Grated Drop Inlet, 4.00 feet to 4.00 feet 1 Ea.

Drain Sta. 0+62 to Drain Sta. 1+22±

Construct: Type "B" G.D.I. (For detail, see Plan sht. no. 6)
Install: 36" Culvert (For Profile, see Plan sht. no. 4)

Estimated Quantities

Imported Borrow 40 CY
Structural Excavation 51 CY
Bed Course Material 13 CY
36" Culvert (Steel Spiral Rib Pipe, Sheet Thickness, 0.079 Inch) 56 LF
Type "B" Grated Drop Inlet, 4.00 feet to 4.00 feet 1 Ea.

Drain Sta. 1+22± to Drain Sta. 2+44±

Construct: Type "B" G.D.I. (For detail, see Plan sht. no. 6)
Install: 36" Culvert (For Profile, see Plan sht. no. 4)

Estimated Quantities

Imported Borrow 41 CY
Structural Excavation 132 CY
Bed Course Material 28 CY
36" Culvert (Steel Spiral Rib Pipe, Sheet Thickness, 0.079 Inch) 118 LF
Type "B" Grated Drop Inlet, 4.00 feet to 4.00 feet 1 Ea.

Drain Sta. 2+44± to Drain Sta. 4+17±

Construct: Type "B" G.D.I. (For detail, see Plan sht. no. 6)
Install: 36" Culvert (For Profile, see Plan sht. no. 4)

Estimated Quantities

Imported Borrow 81 CY
Structural Excavation 206 CY
Bed Course Material 40 CY
36" Culvert (Aluminum Spiral Rib Pipe, Sheet Thickness, 0.075") 169 LF
Type "B" Grated Drop Inlet, 4.00 feet to 4.00 feet 1 Ea.

PLAN

APPROVED: Date 12-1-87

R. Hagata
Chief, Planning & Engineering, BWS

11/27/87 Additional Note for 8" Waterline Relocation

DATE REVISION

FED. ROAD DIST. NO.	STATE	PROJ. NO.	FISCAL YEAR	SHEET NO.	TOTAL SHEETS
HAWAII	HAW.	7101A-02-87	1987	3	8



STATE OF HAWAII
DEPARTMENT OF TRANSPORTATION
HIGHWAYS DIVISION
DRAINAGE PLAN
FARRINGTON HIGHWAY
DRAINAGE IMPROVEMENTS
Vicinity of Kapakahi Stream
Project No. 7101A-02-87

Scale: As Noted Date: Oct. 1986

SHEET NO. OF SHEETS

C03

FED. ROAD DIST. NO.	STATE	PROJ. NO.	FISCAL YEAR	SHEET NO.	TOTAL SHEETS
HAWAII	HAW.	7101A-02-87	1987	4	8

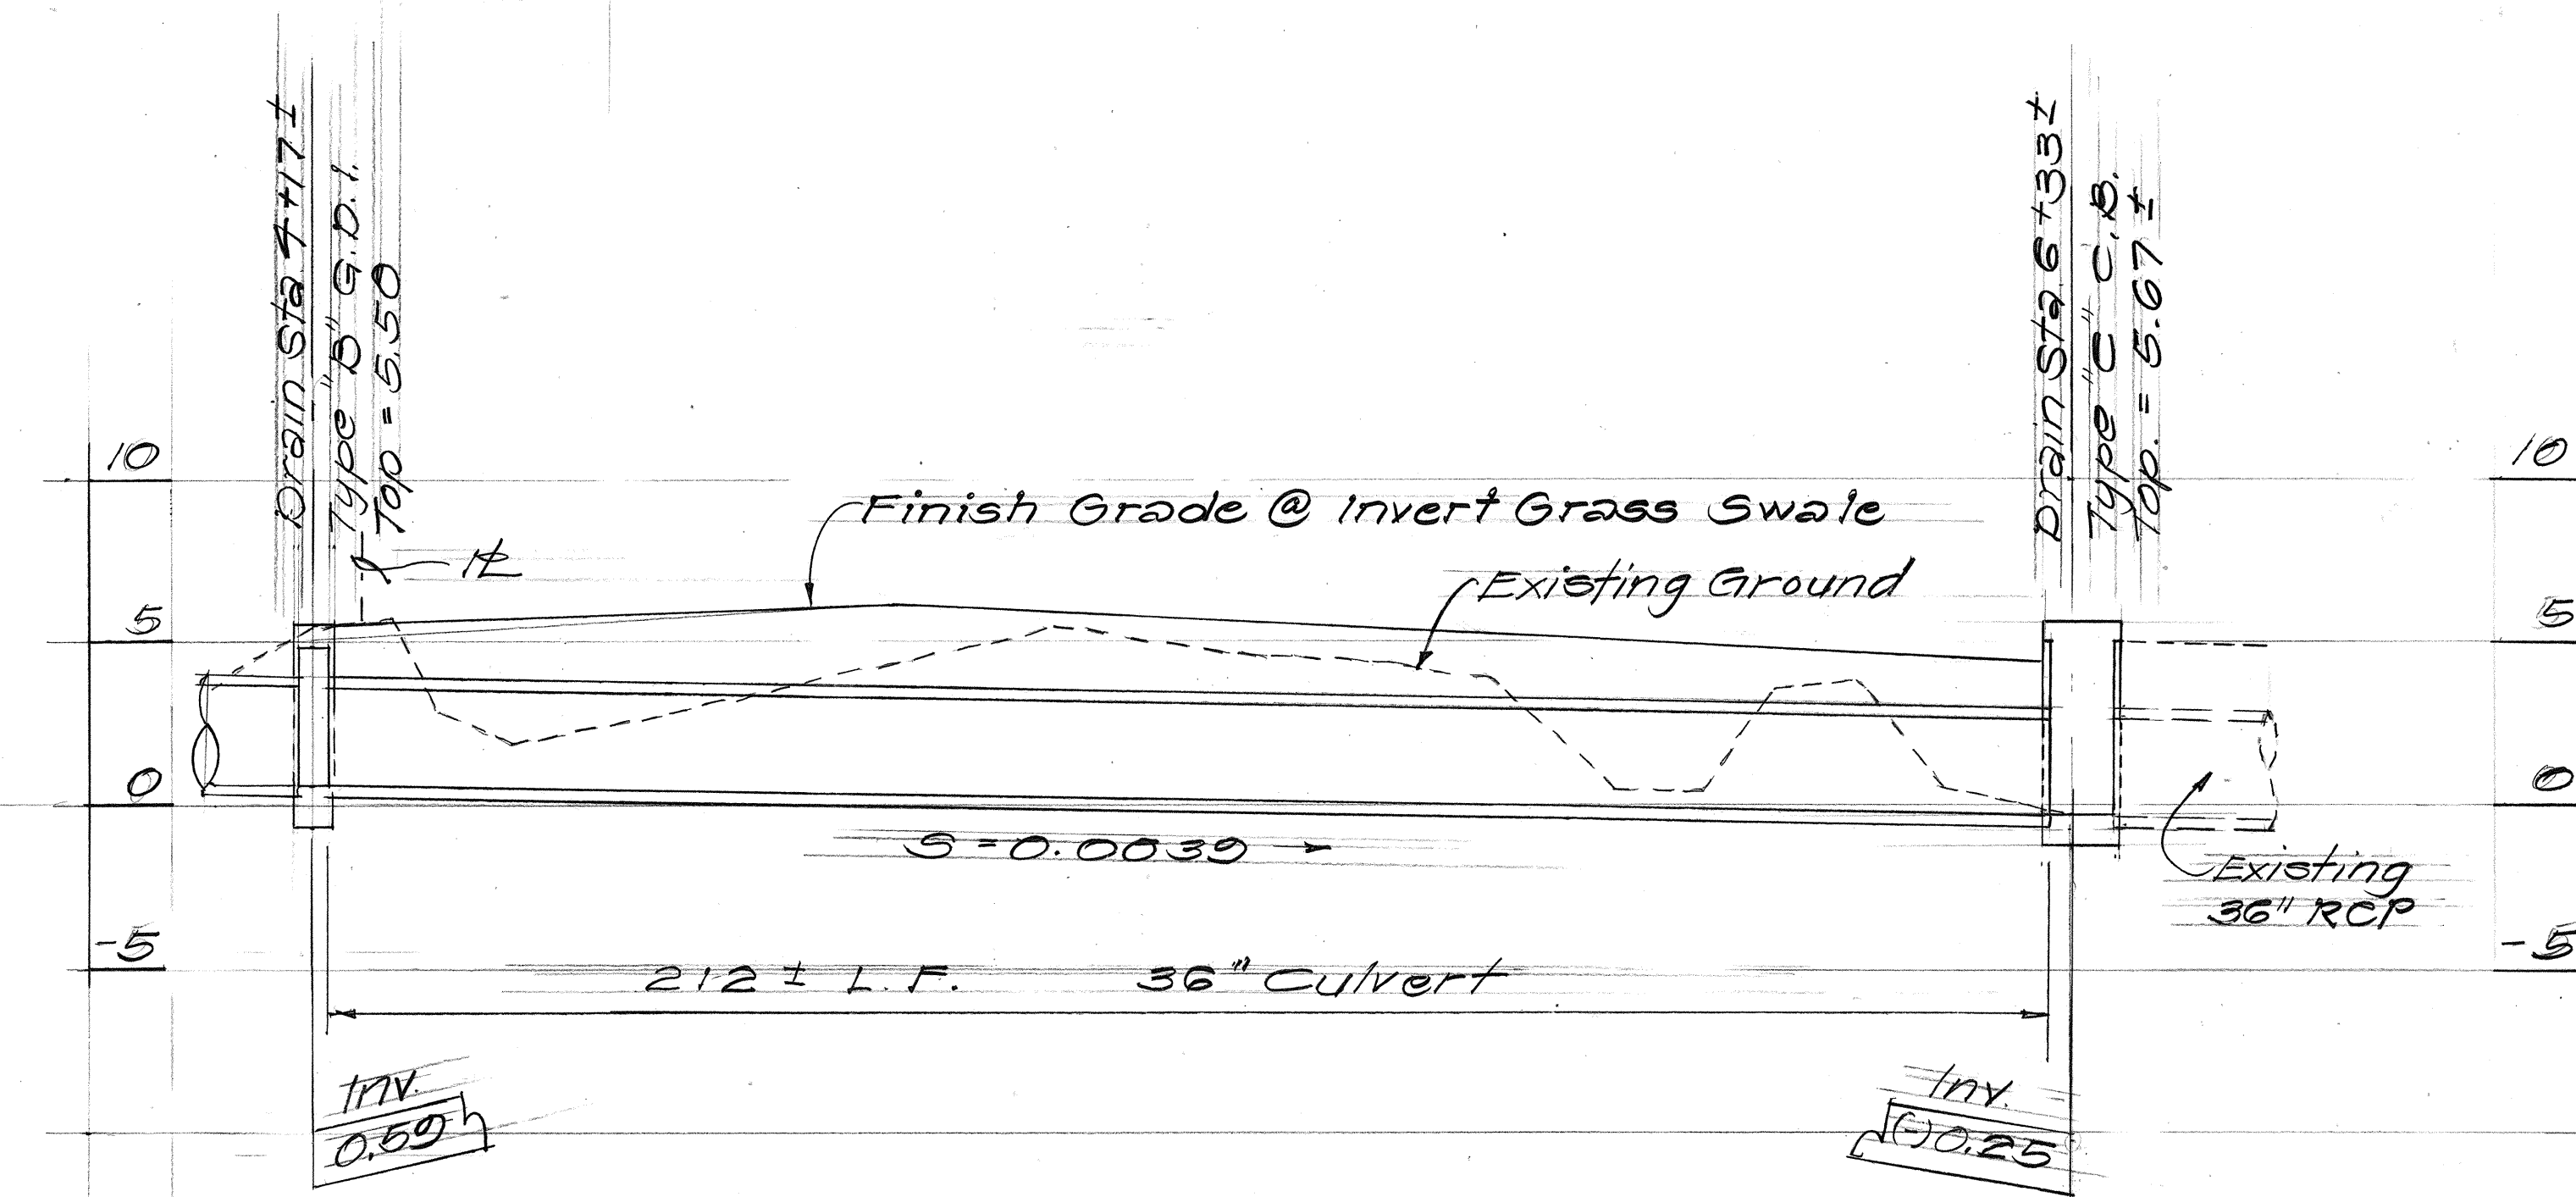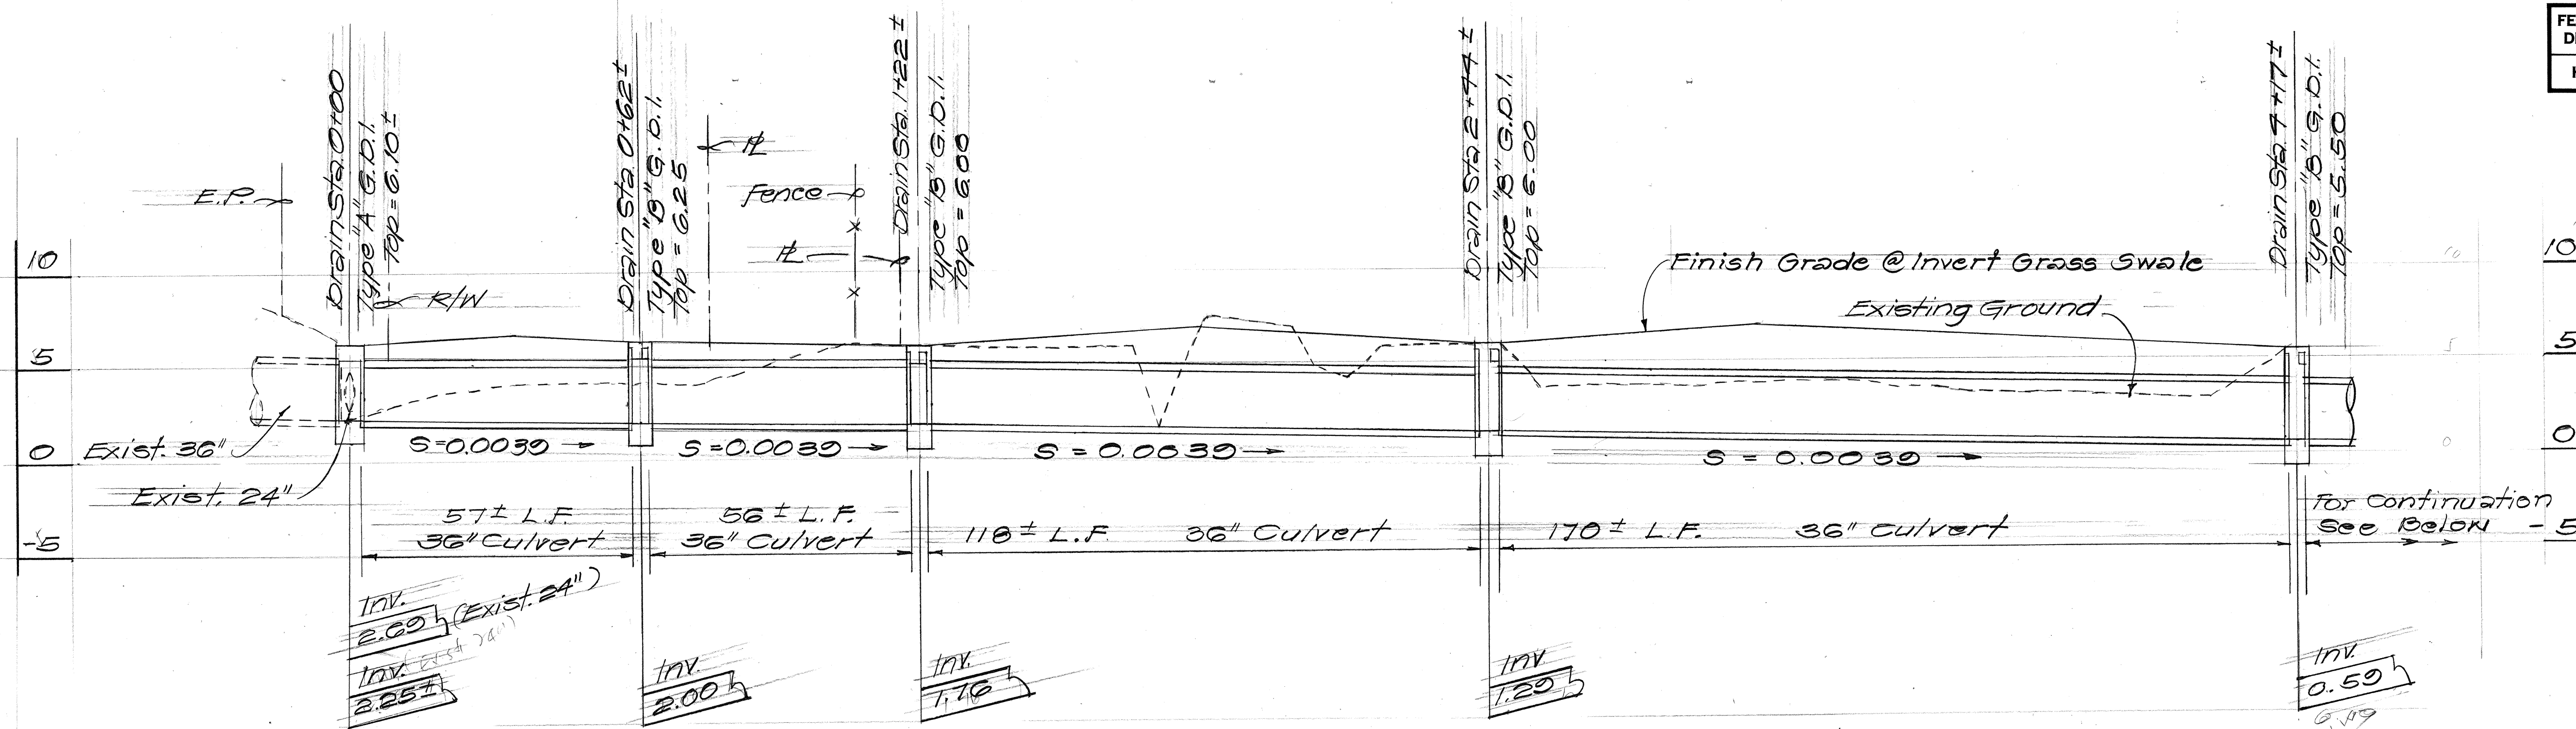

PROFILE # 36 inch CULVERT
 Scale: Horiz. 1" = 20'
 Vert. 1" = 5'


STATE OF HAWAII
 DEPARTMENT OF TRANSPORTATION
 HIGHWAYS DIVISION

DRAINAGE DETAILS
FARRINGTON HIGHWAY
DRAINAGE IMPROVEMENTS
 Vicinity of Kapaeha Stream
 Project No. 7101A-02-87
 Scale: As Noted Date: Oct. 1986

SHEET NO. 4 OF 8 SHEETS

ORIGINAL PLAN	DATE
SURVEY PLOTTED BY	
DRAWN BY	
DESIGNED BY	
CHECKED BY	
NOTE BOOK	
No.	





FED. ROAD DIST. NO.	STATE	PROJ. NO.	FISCAL YEAR	SHEET NO.	TOTAL SHEETS
HAWAII	HAW.	7101A-02-87	1987	5	8

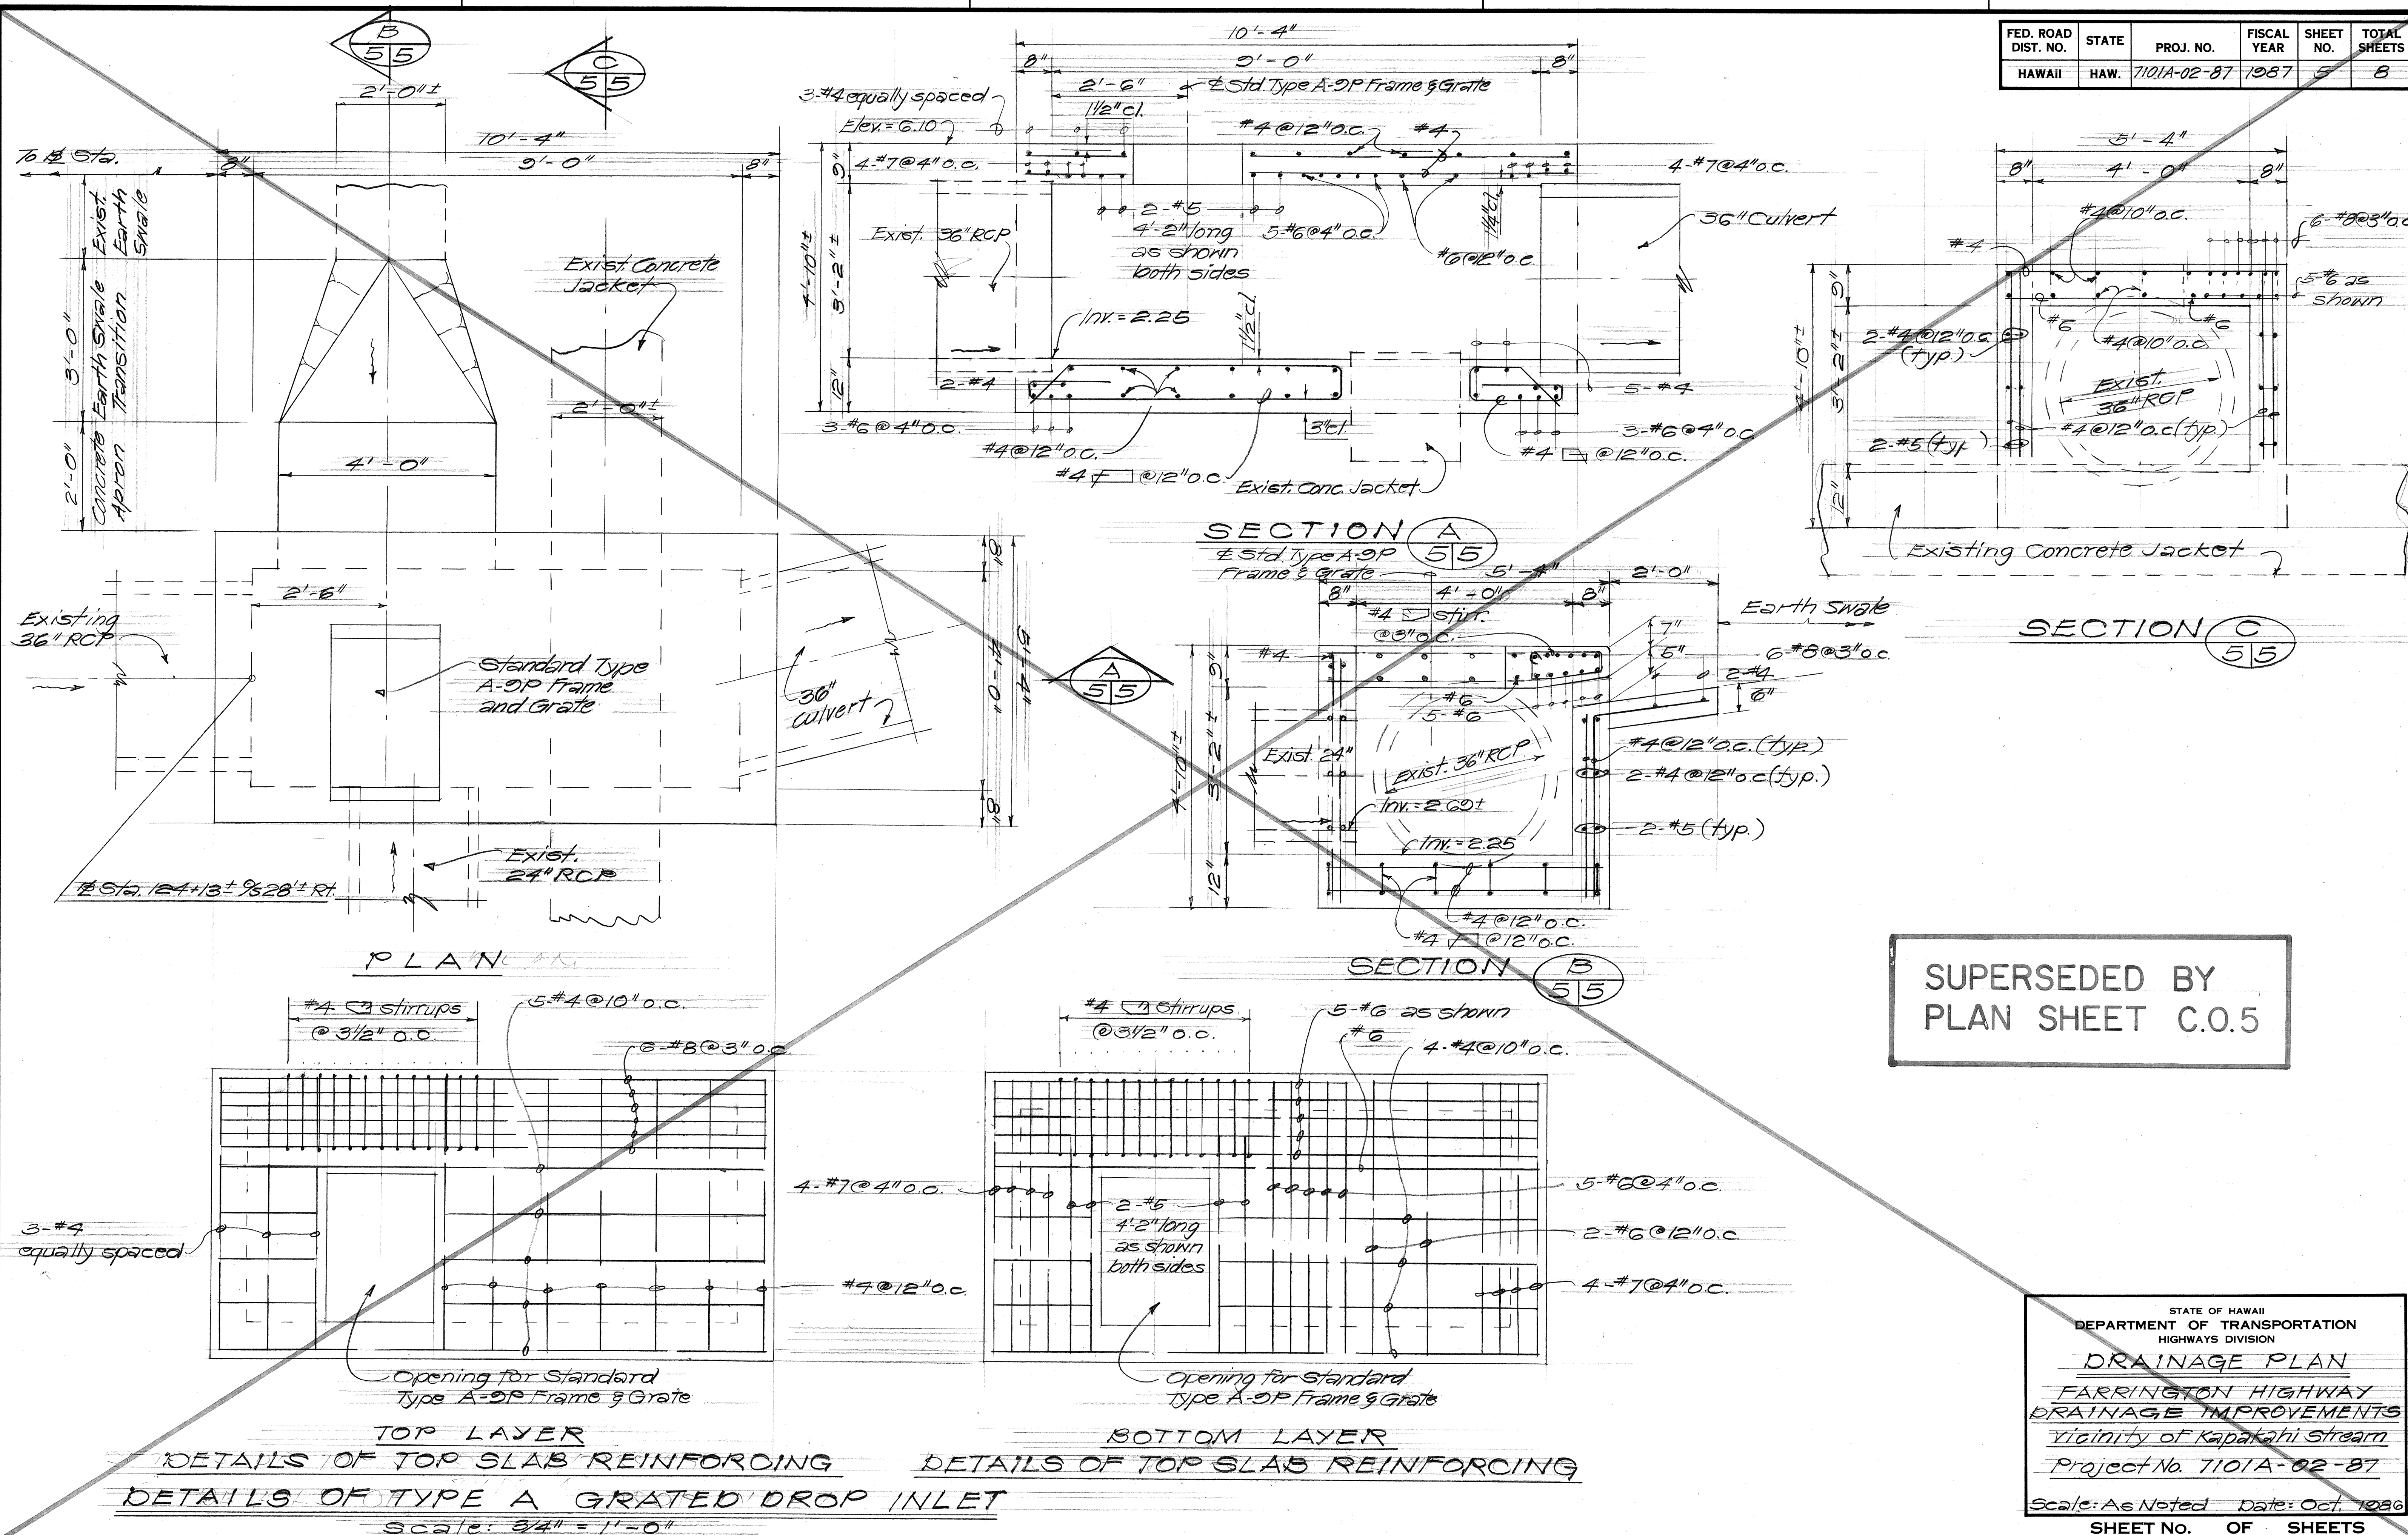

DATE	
DESIGNED BY	
CHECKED BY	
NOTED BY	
ORIGINAL PLAN	

STATE OF HAWAII
DEPARTMENT OF TRANSPORTATION
HIGHWAYS DIVISION
DRAINAGE PLAN
FARRINGTON HIGHWAY
DRAINAGE IMPROVEMENTS
Vicinity of Kapakahi Stream
Project No. 7101A-02-87
Scale: As Noted Date: Oct. 1986
SHEET No. OF SHEETS

FED. ROAD DIST. NO.	STATE	PROJ. NO.	FISCAL YEAR	SHEET NO.	TOTAL SHEETS
HAWAII	HAW.	7101A-02-87	1987	5	8

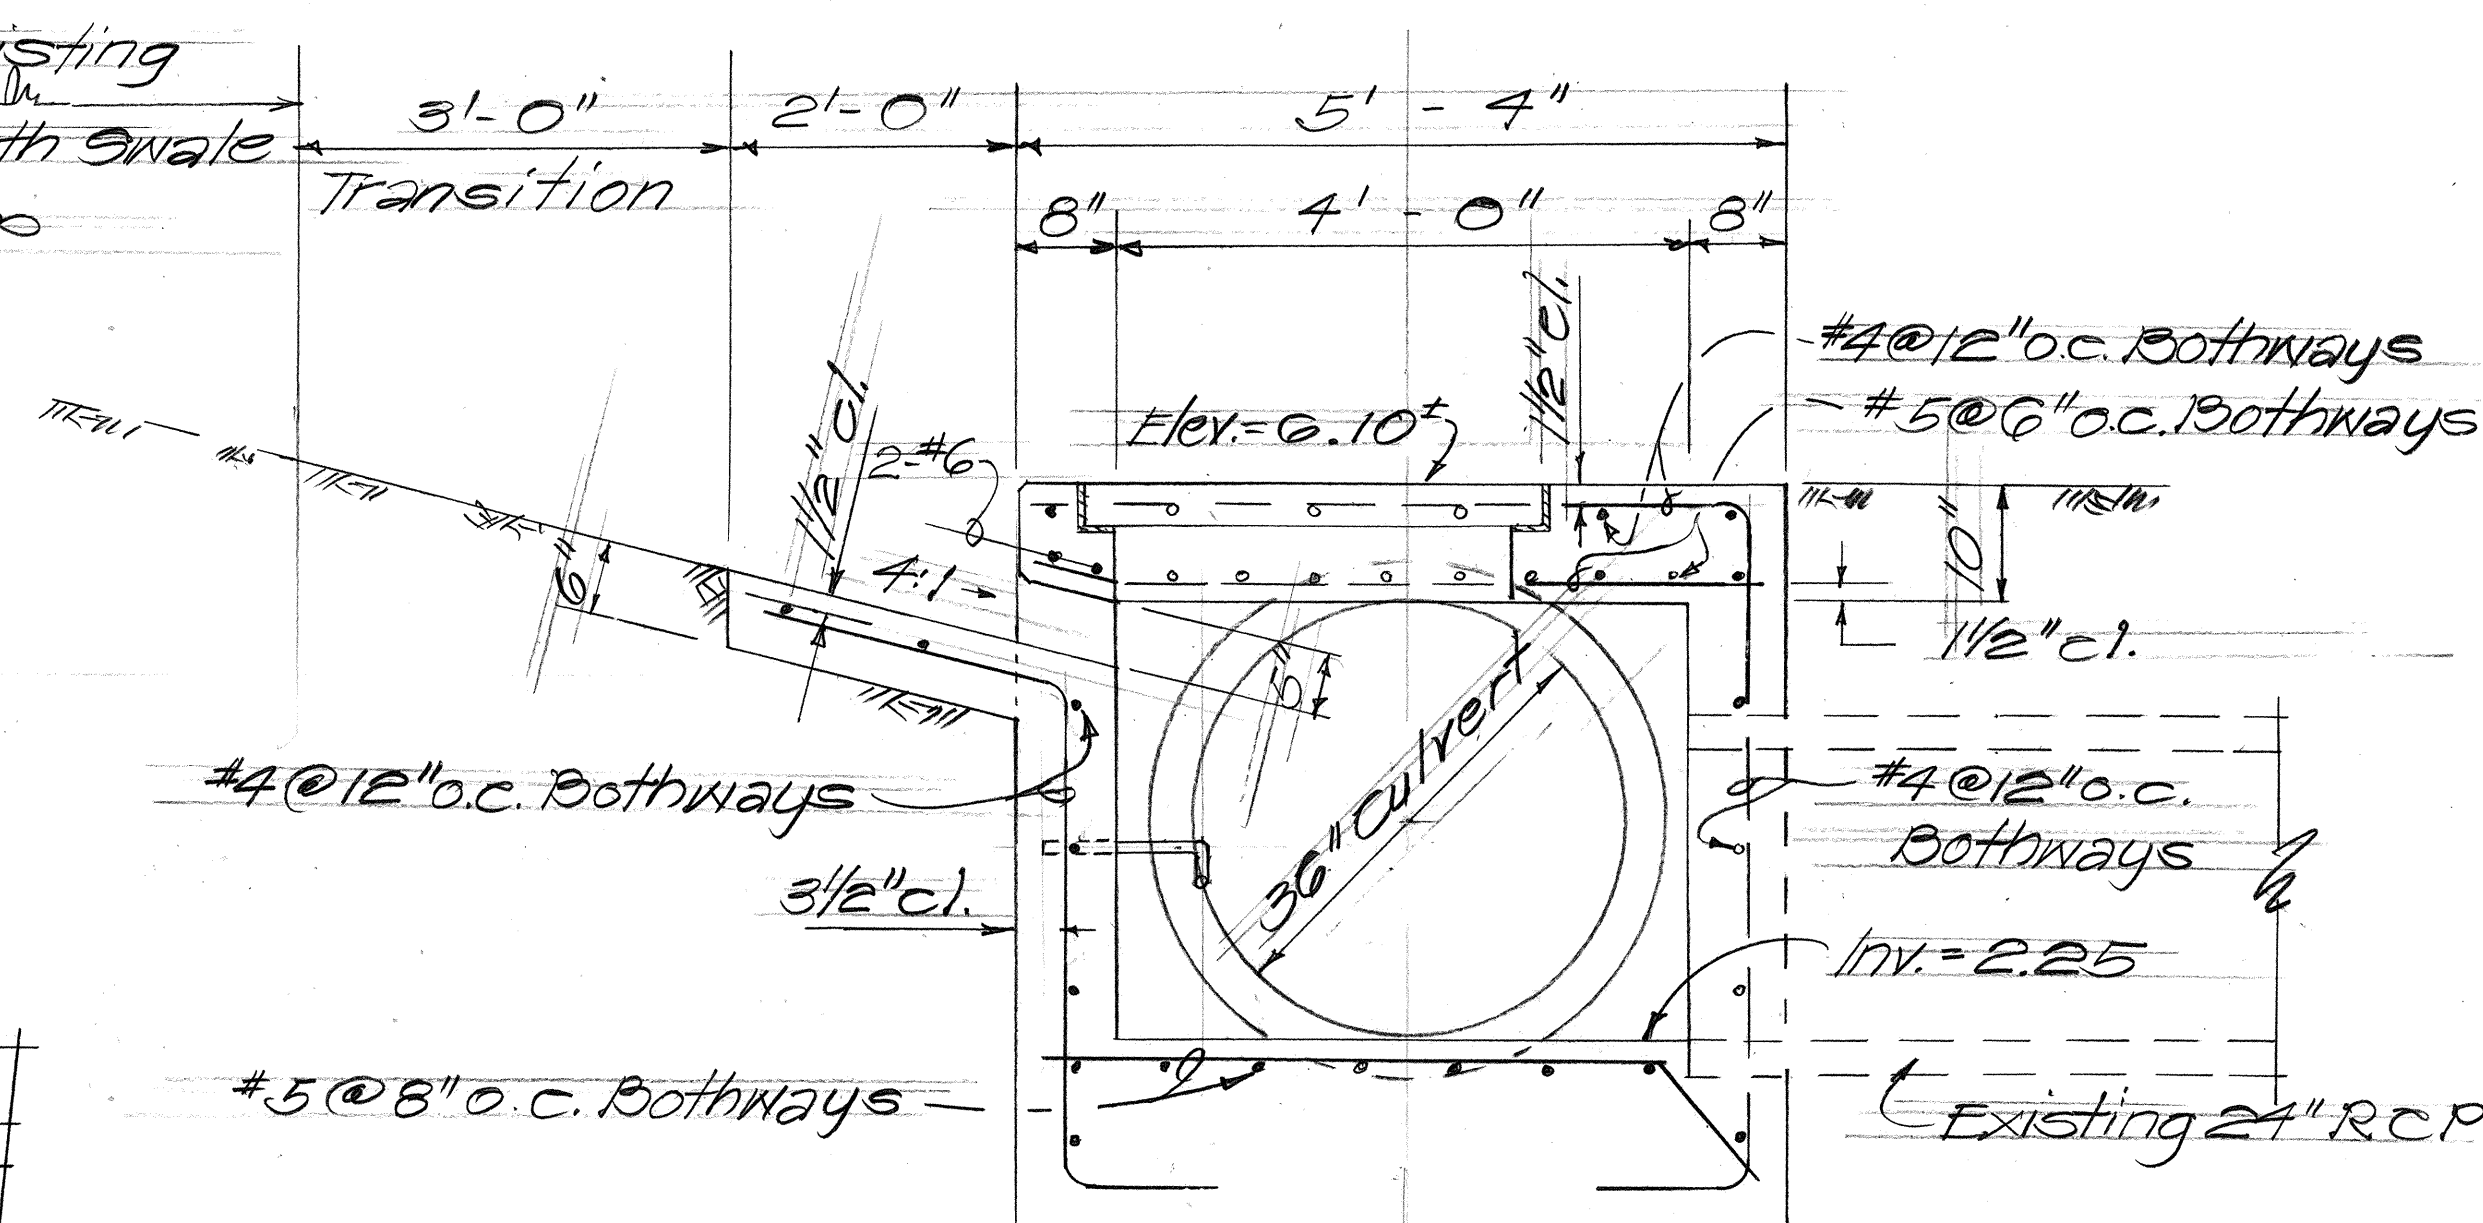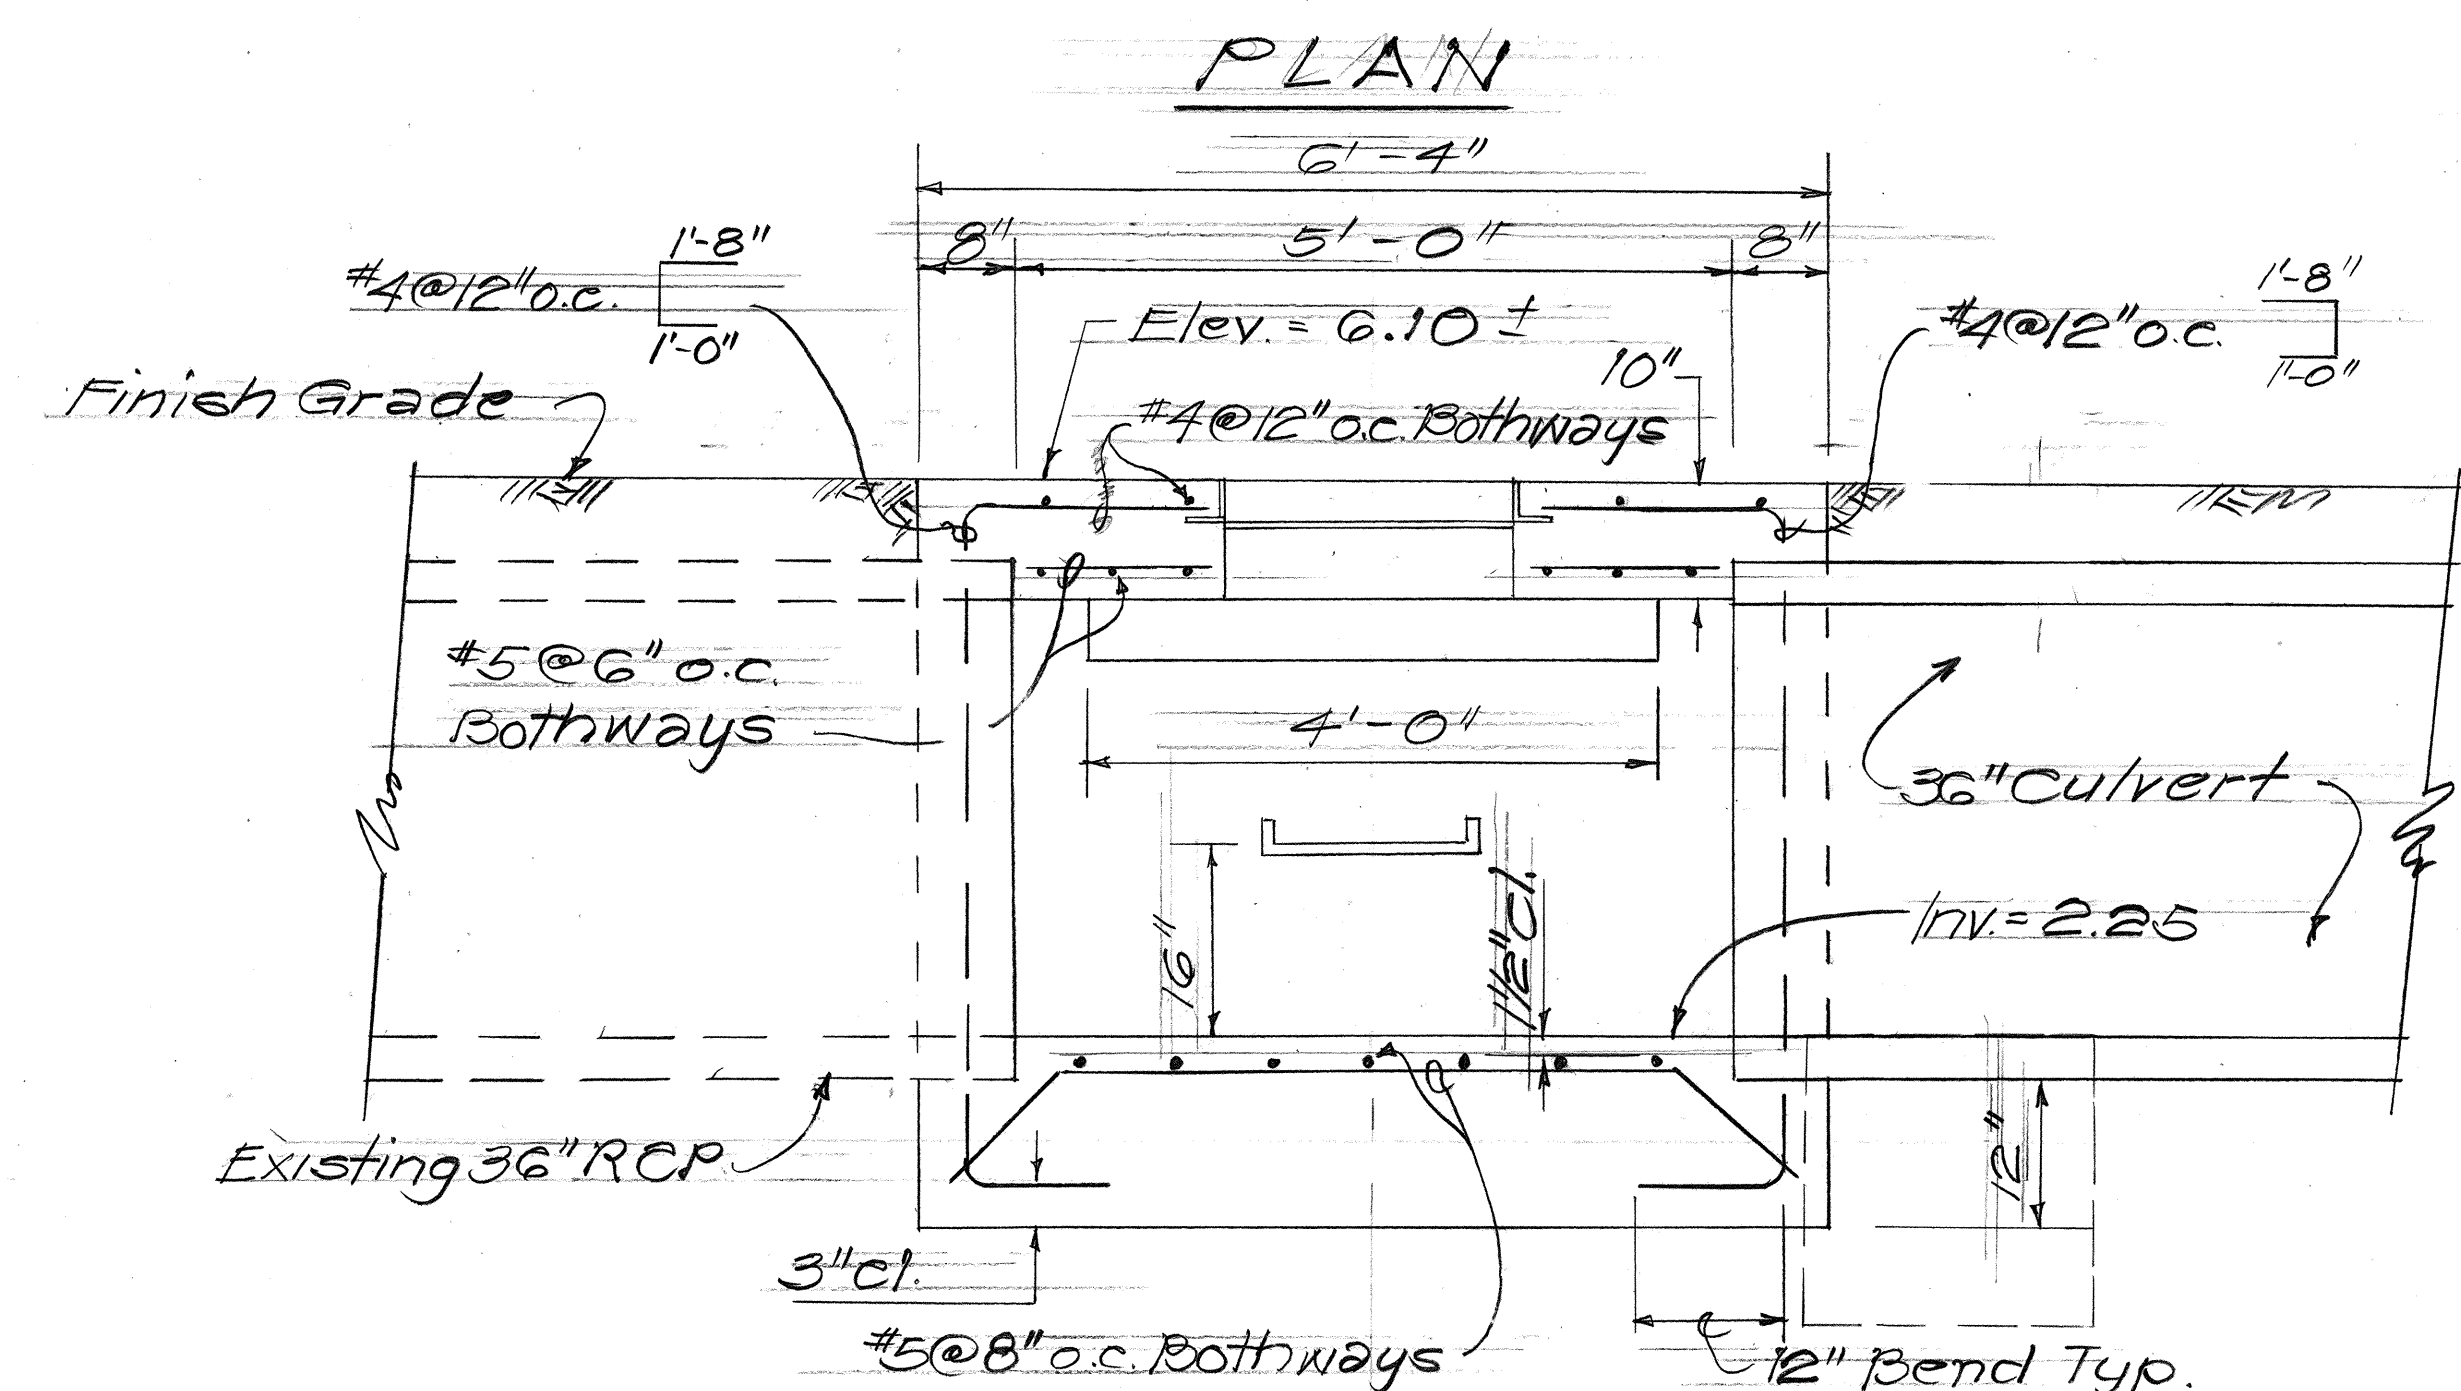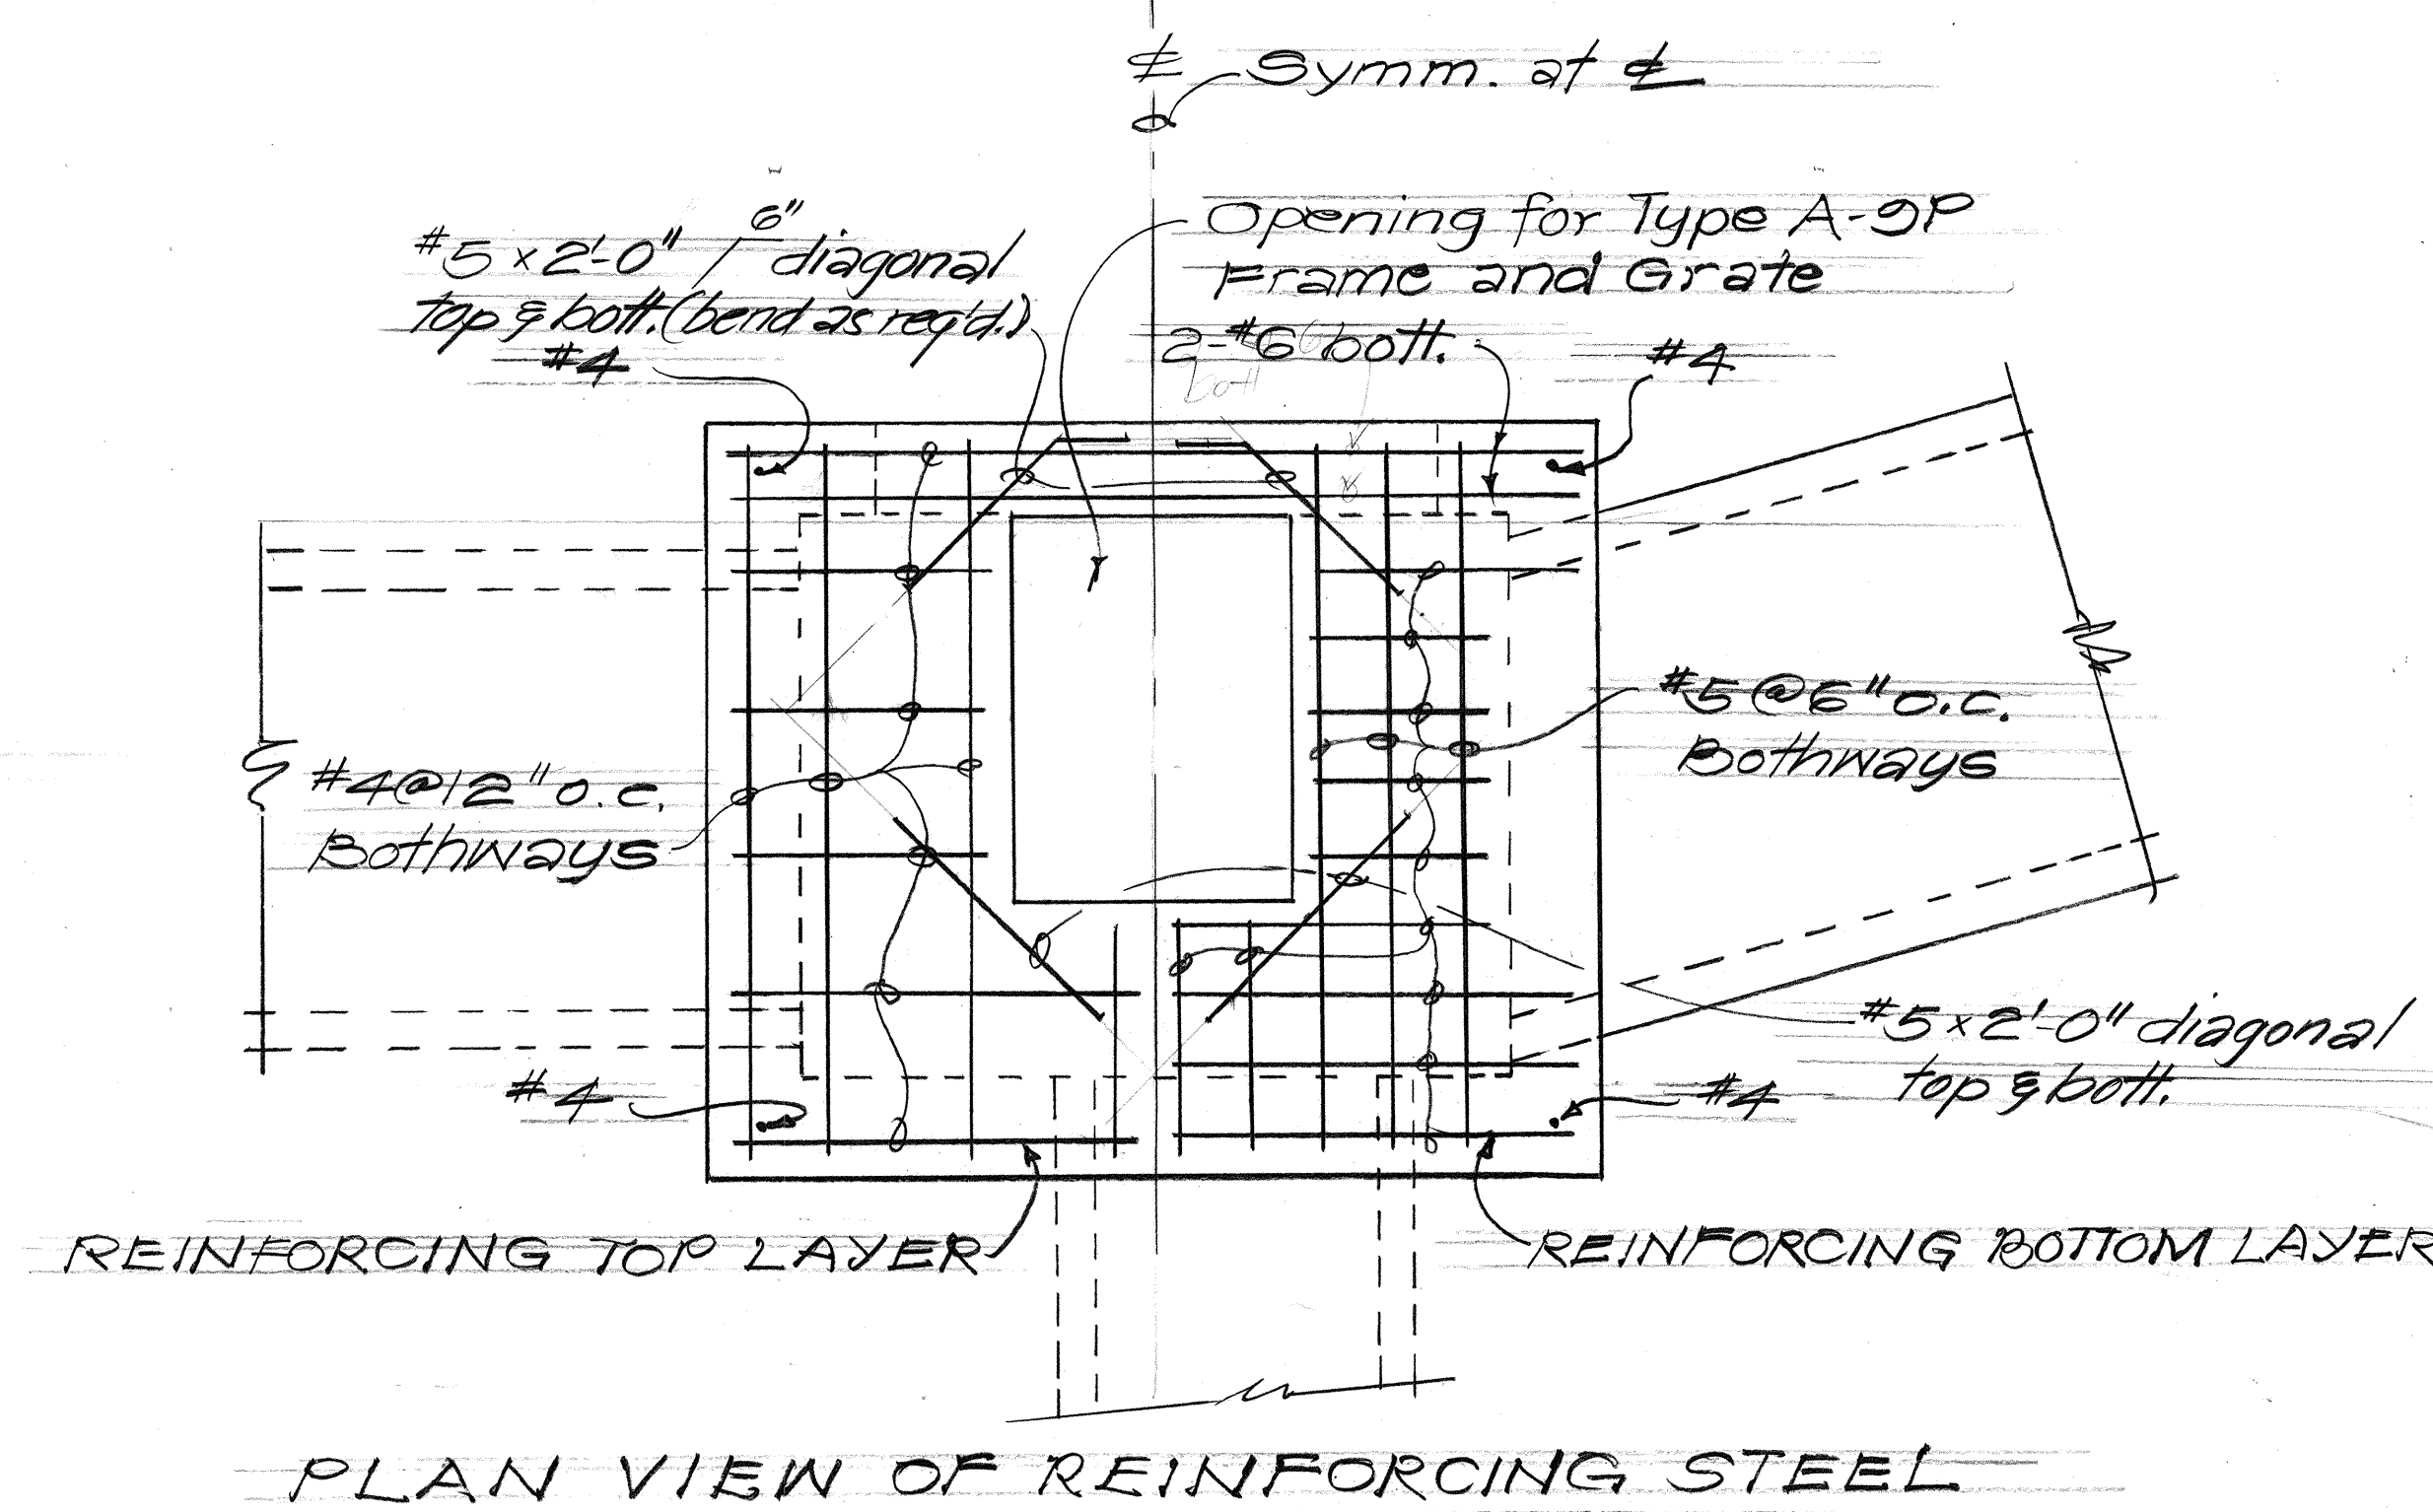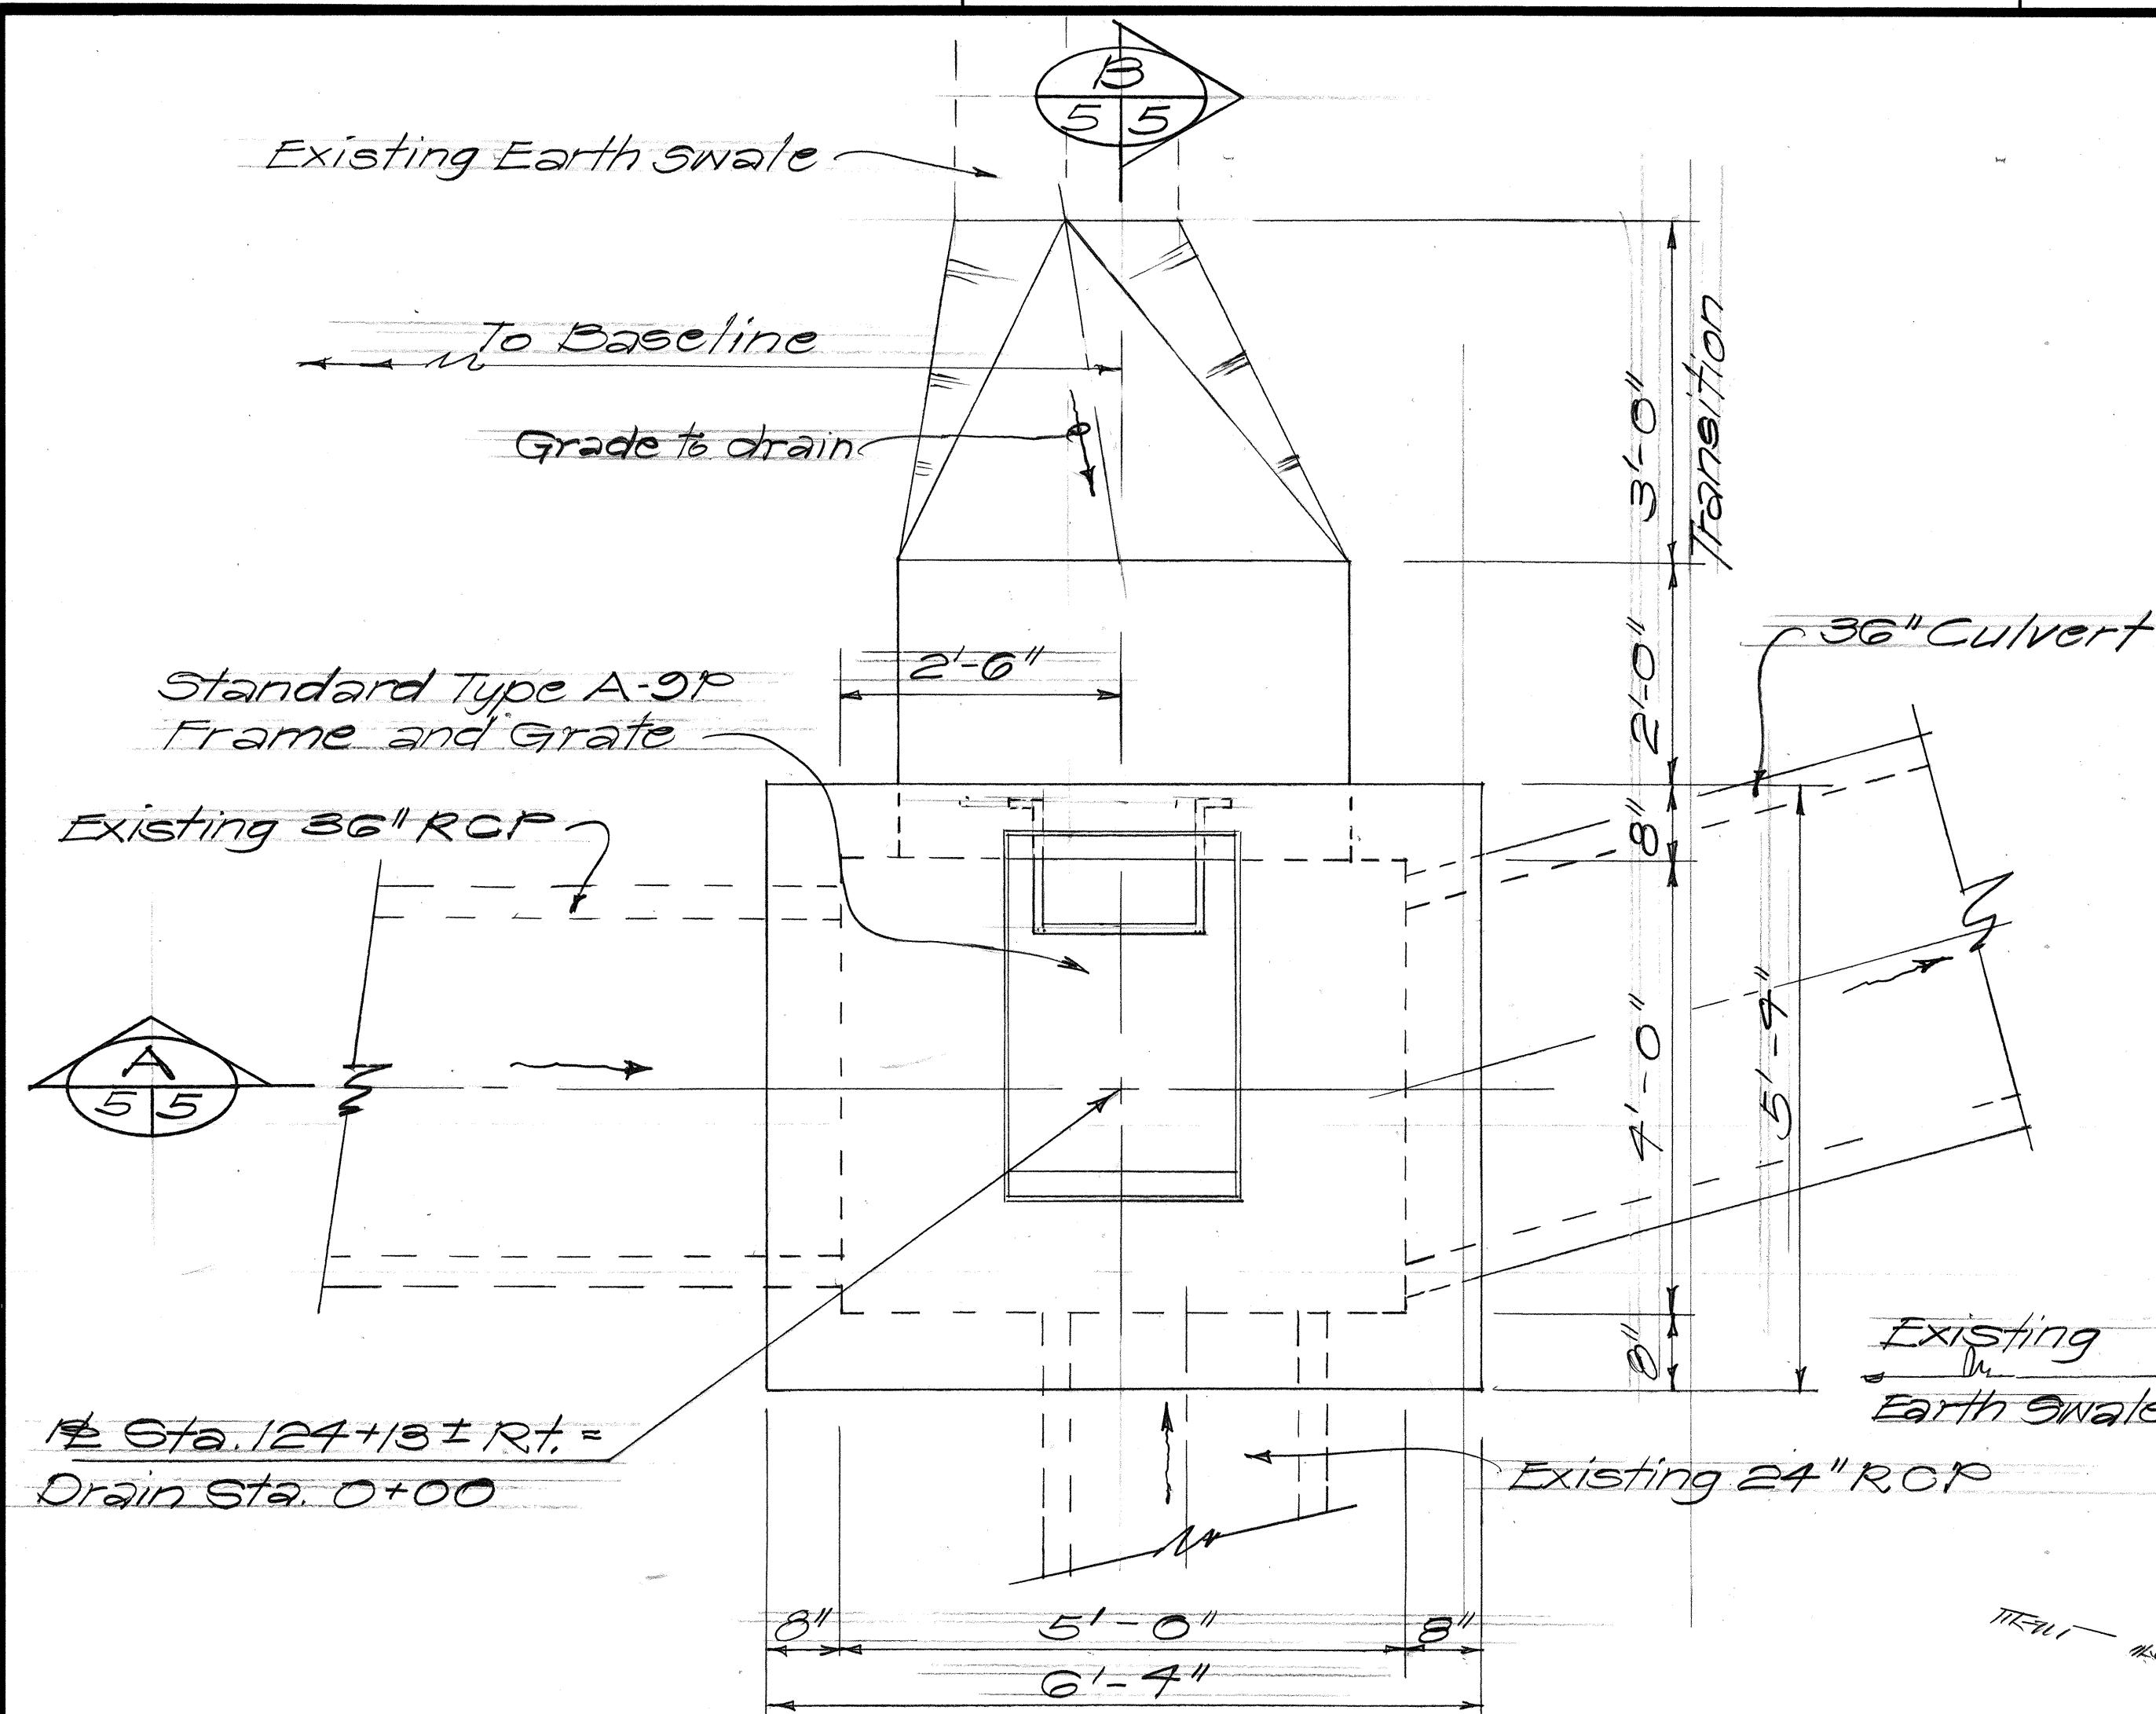


DETAILS OF TYPE "A" GRATED DROP INLET.

Scale: 3/4" = 1'-0"


11/3/87 Supersede Plan Sheet 5, Changed Type "A" G.D.I. detail		STATE OF HAWAII DEPARTMENT OF TRANSPORTATION HIGHWAYS DIVISION	
		DRAINAGE DETAILS FARRINGTON HIGHWAY DRAINAGE IMPROVEMENTS Vicinity of Kapakahi Stream Project No. 7101A-02-87 Scale: As Noted Date: Nov. 1987 SHEET No. 45 OF 8 SHEETS	
DATE	REVISION		

FED. ROAD DIST. NO.	STATE	PROJ. NO.	FISCAL YEAR	SHEET NO.	TOTAL SHEETS
HAWAII	HAW.	7101A-02-87	1987	6	8

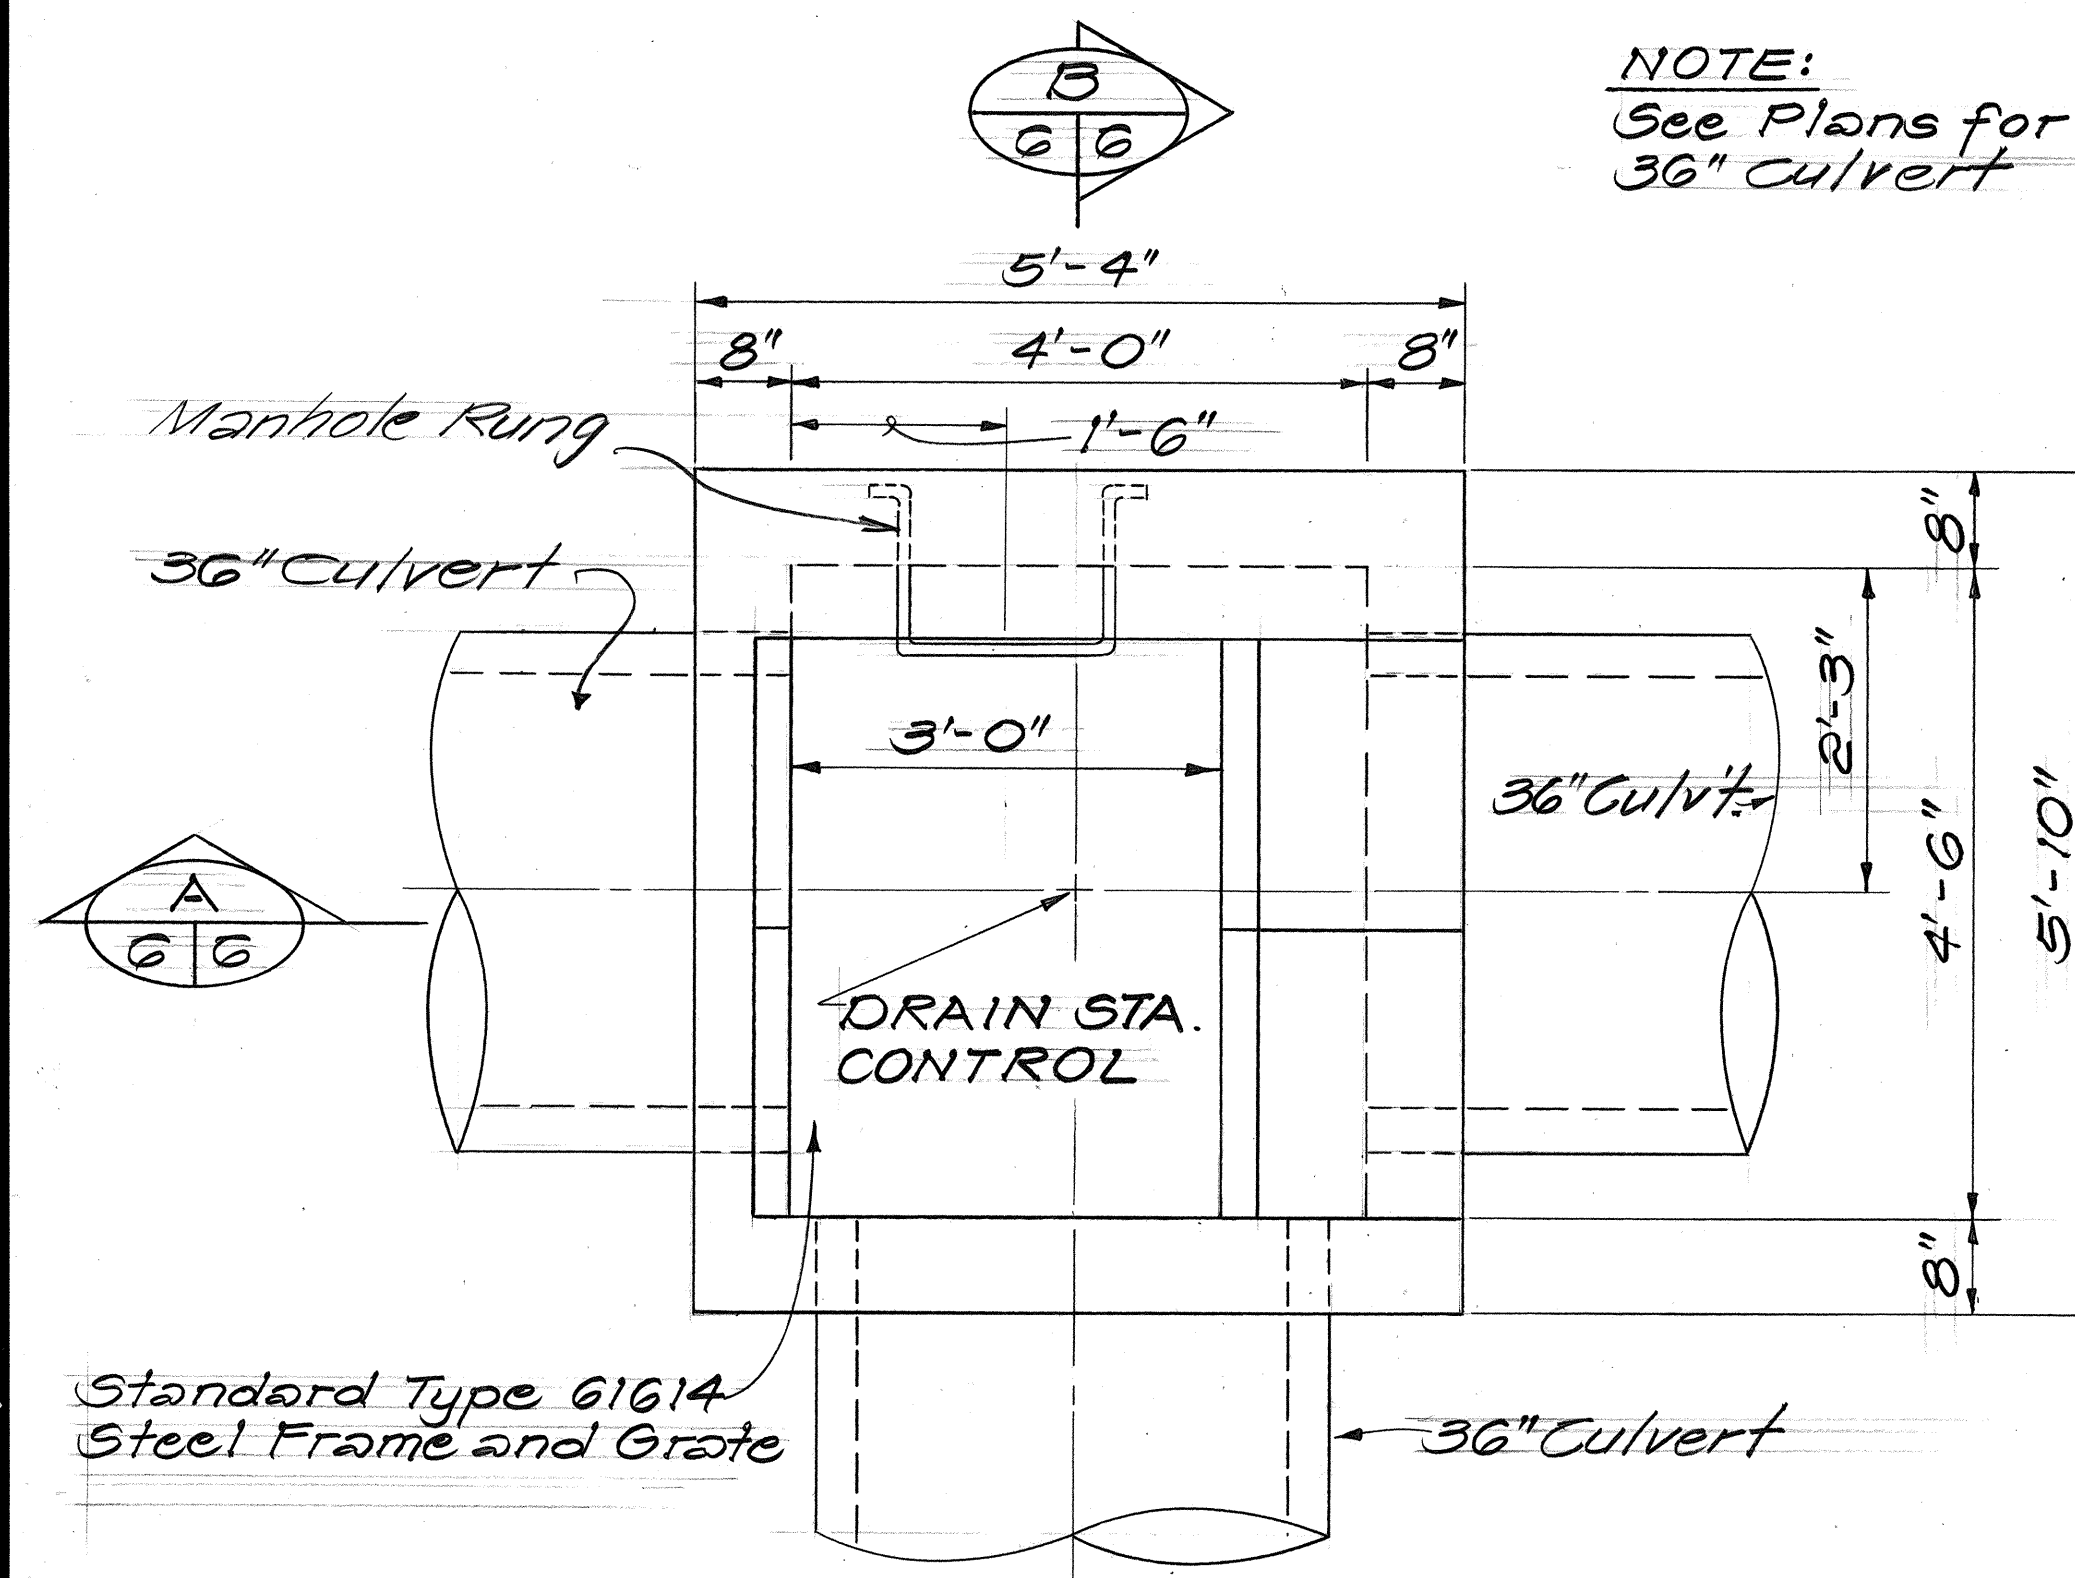


PLAN

NOTE:
See Plans for Location of
36" Culvert

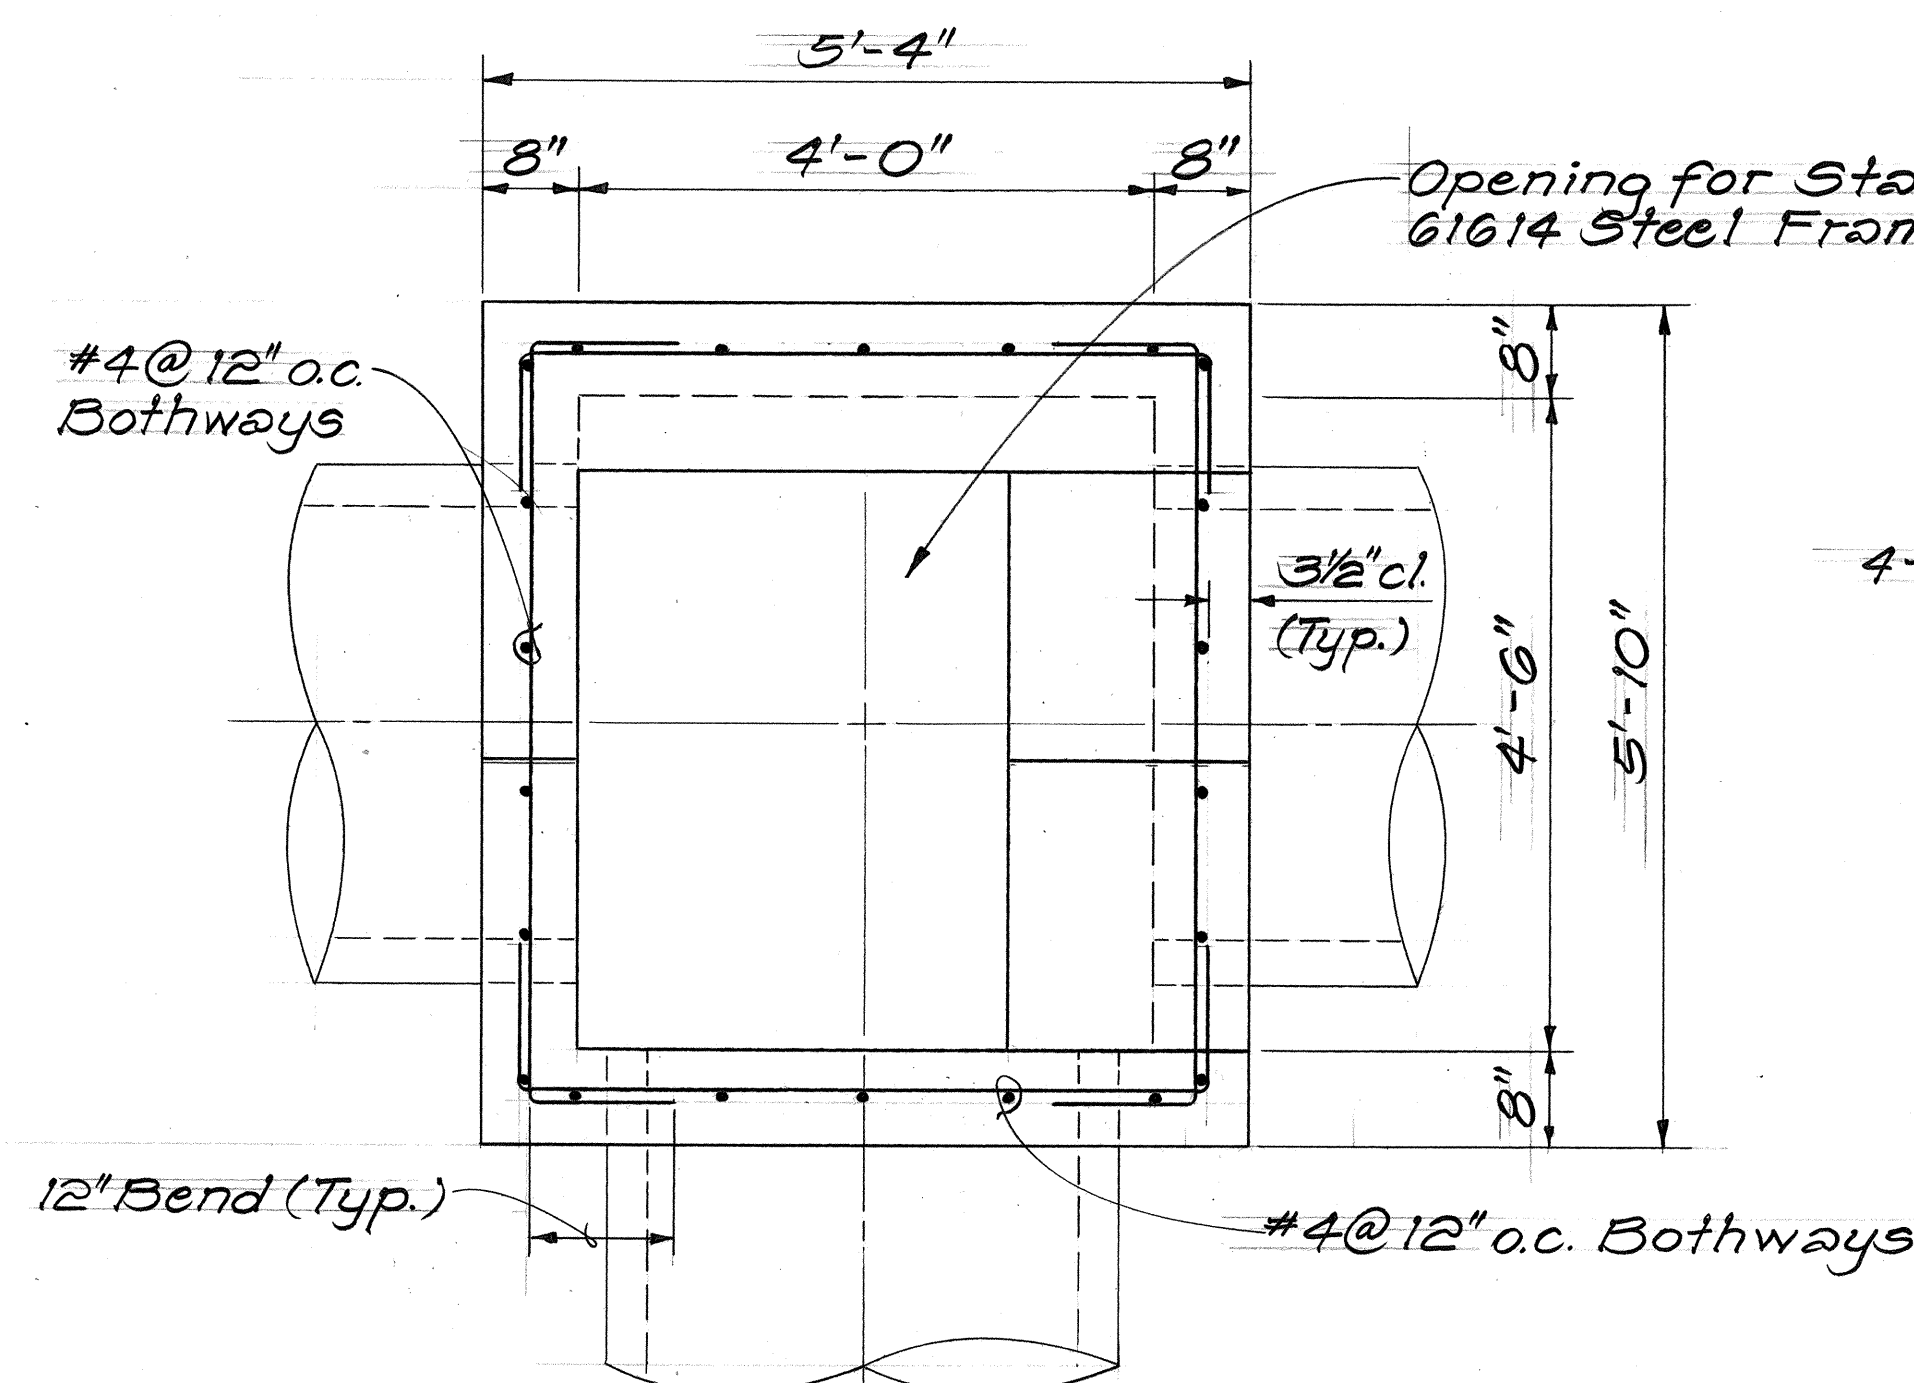


PLAN VIEW OF WALL REINFORCING

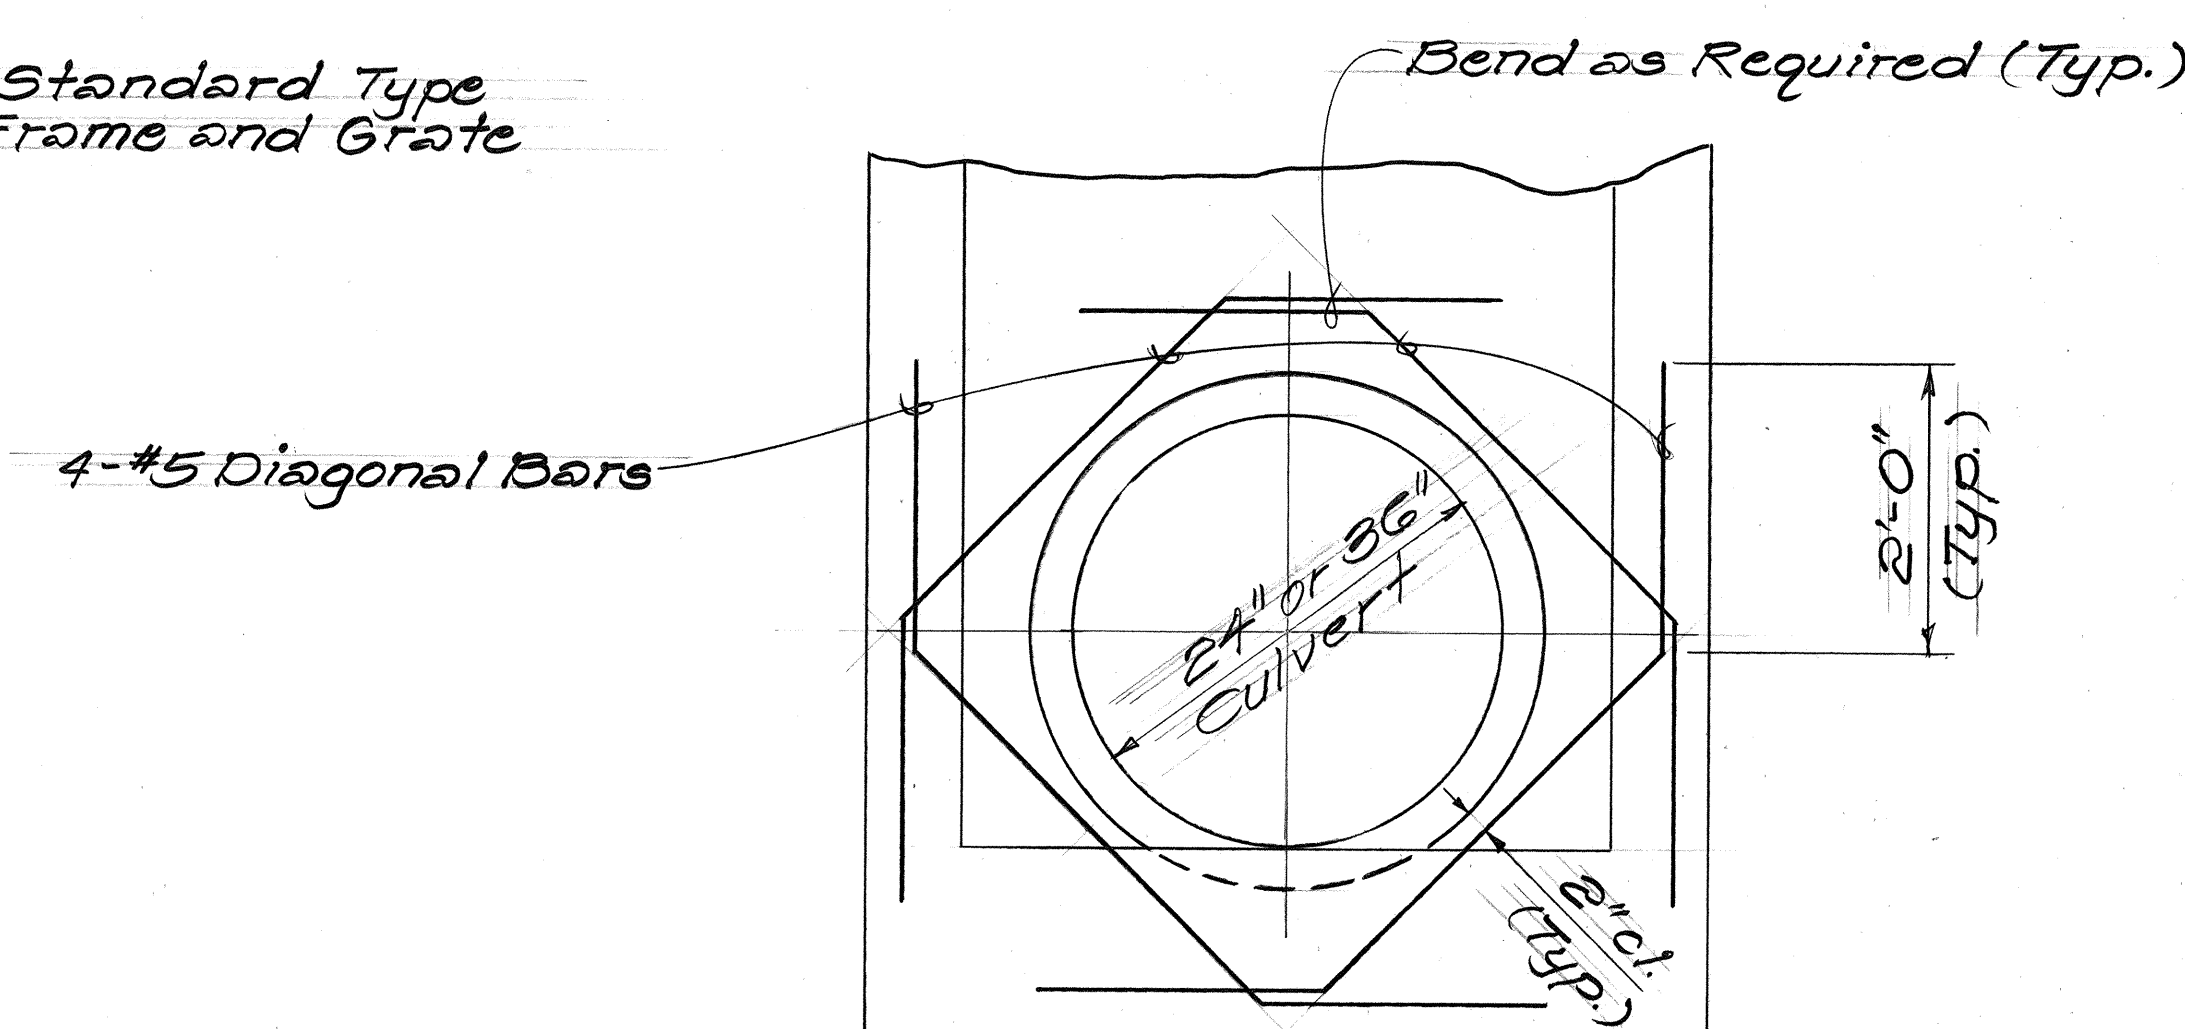


TYPICAL DETAIL OF ADDED REINFORCING
AT 24" AND 36" CULVERT OPENINGS

Scale: 3/4" = 1'-0"

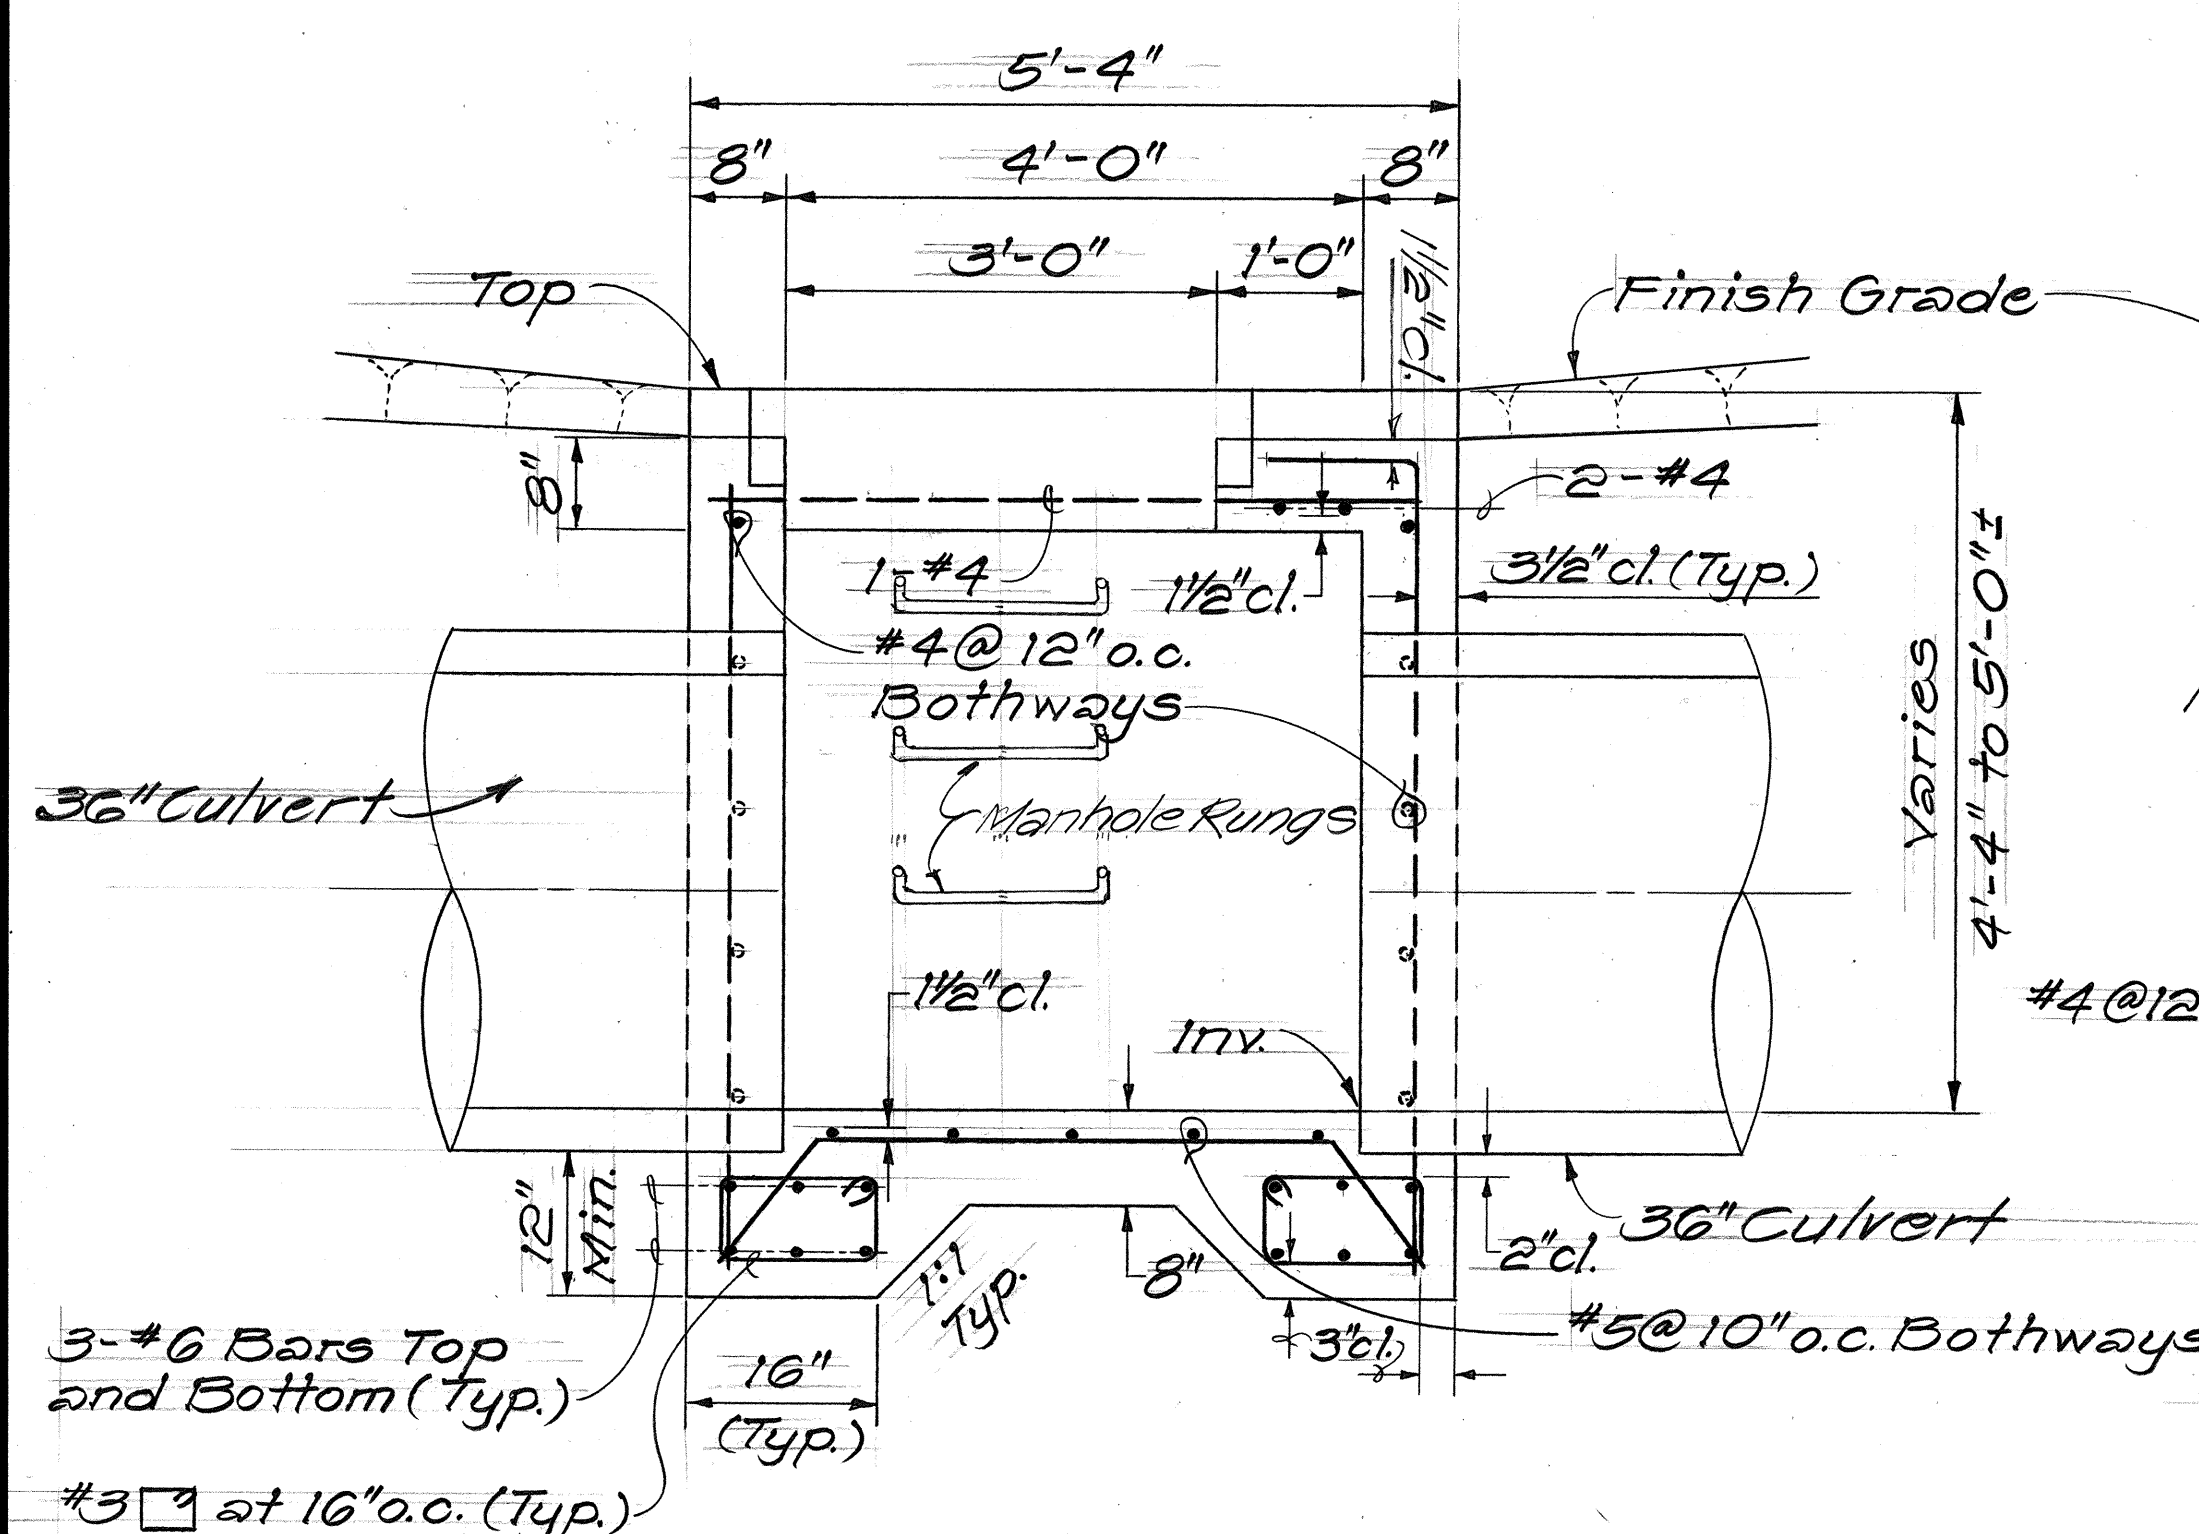

SECTION A

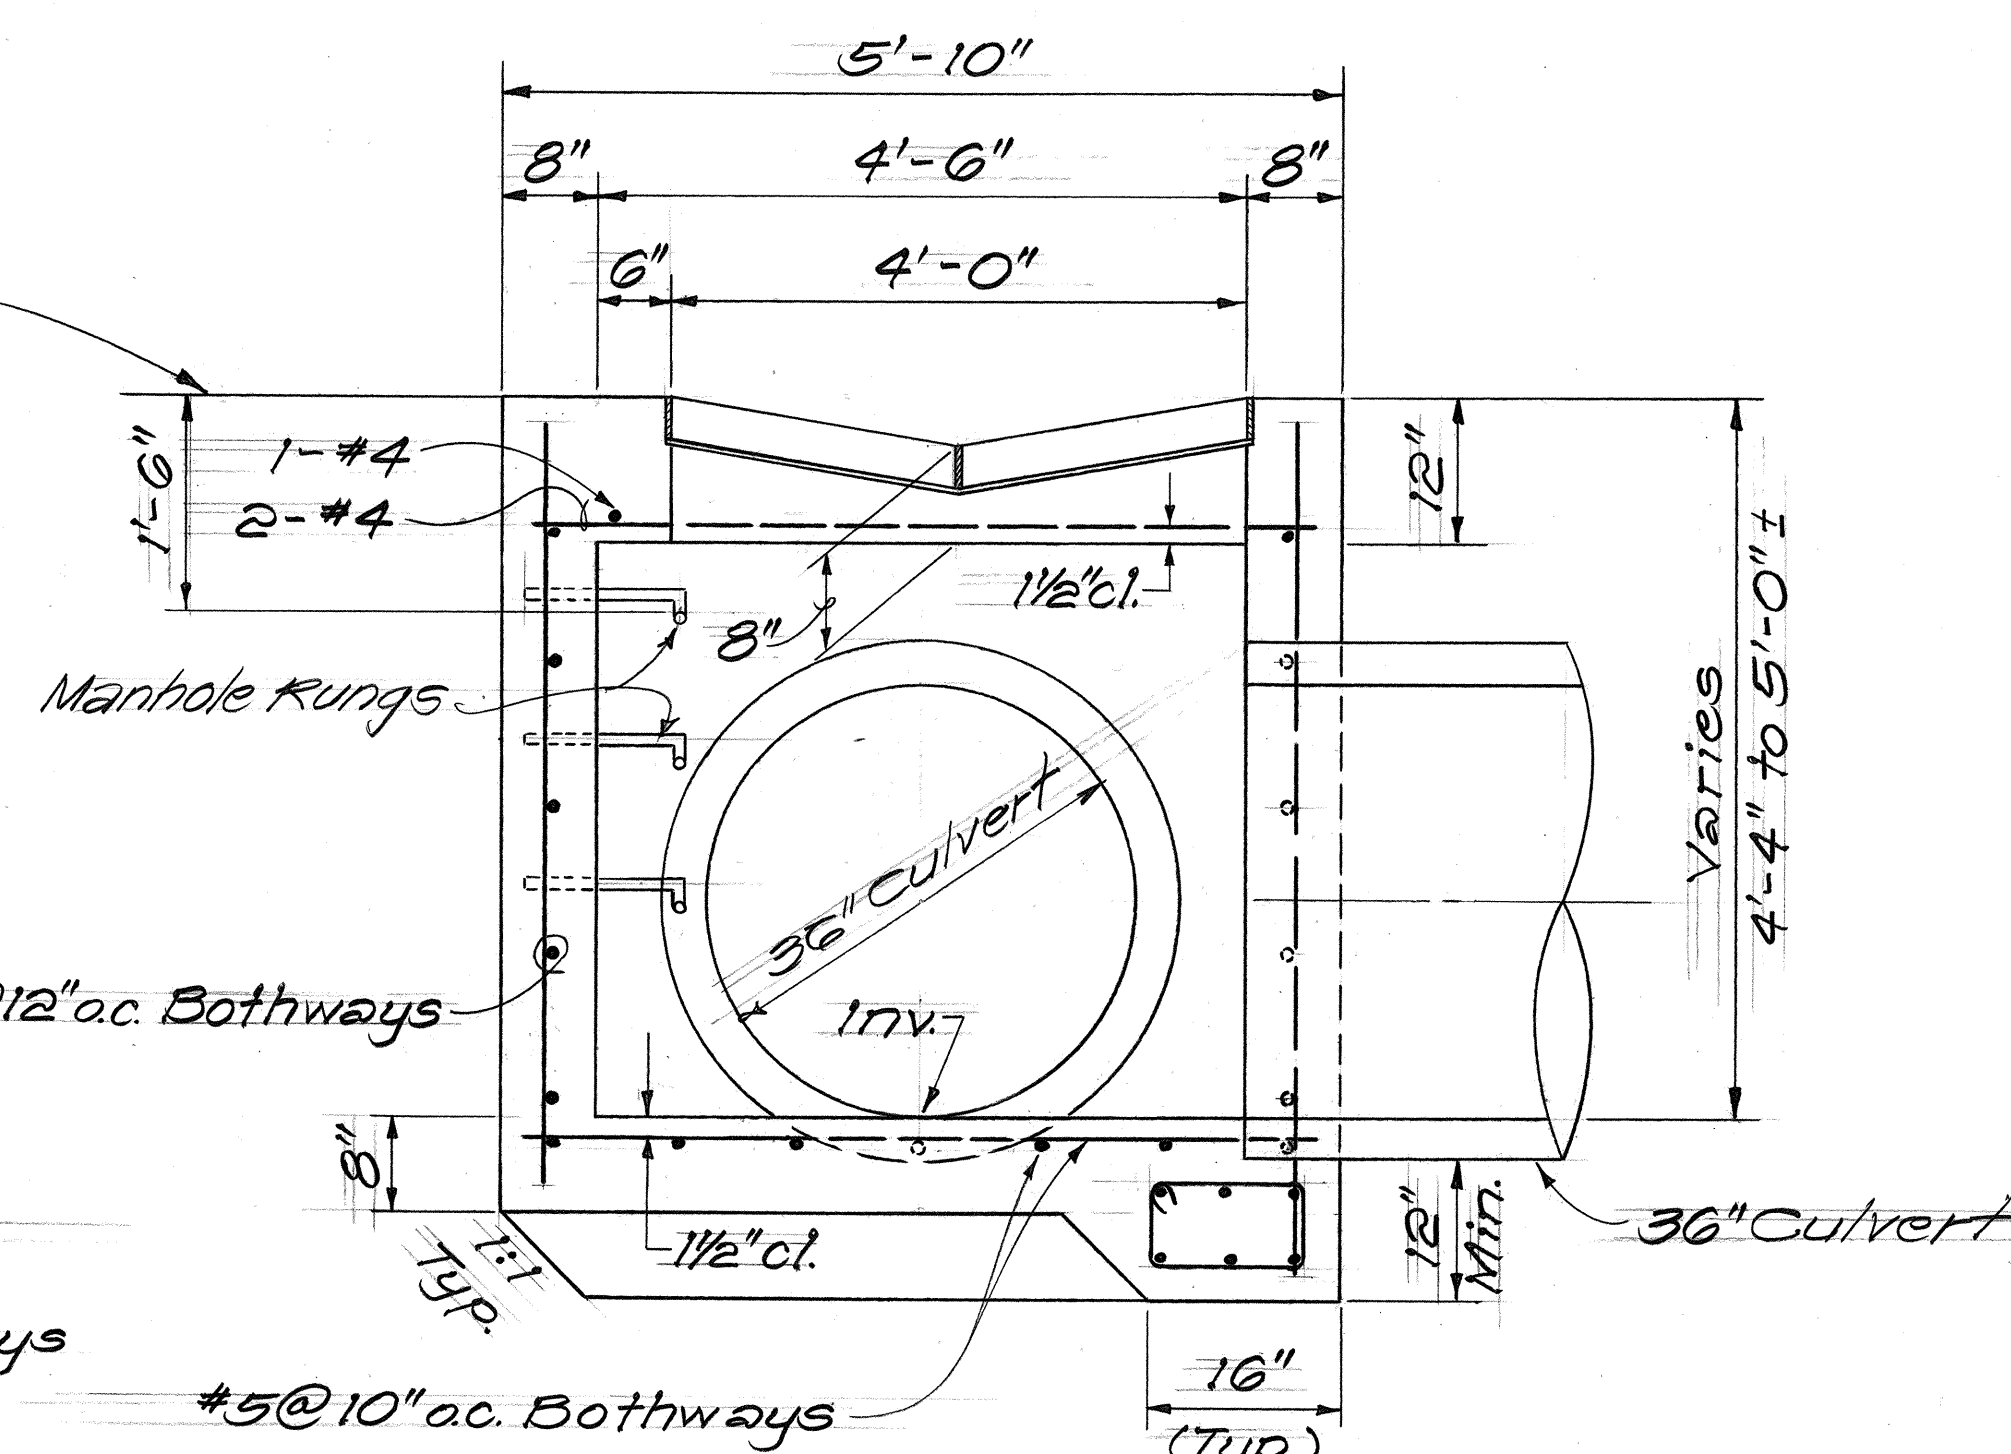



SECTION B

TYPICAL DETAILS OF TYPE "B" GRATED DROP INLET


Scale: 3/4" = 1'-0"

STATE OF HAWAII DEPARTMENT OF TRANSPORTATION HIGHWAYS DIVISION	
DRAINAGE DETAILS	
FARRINGTON HIGHWAY	
DRAINAGE IMPROVEMENTS	
Vicinity of Kapakahi Stream	
Project No. 7101A-02-87	
Scale: As Noted Date: Oct. 1986	
SHEET No.	OF SHEETS


FED. ROAD DIST. NO.	STATE	PROJ. NO.	FISCAL YEAR	SHEET NO.	TOTAL SHEETS
HAWAII	HAW.	7101A-02-87	1987	7	8

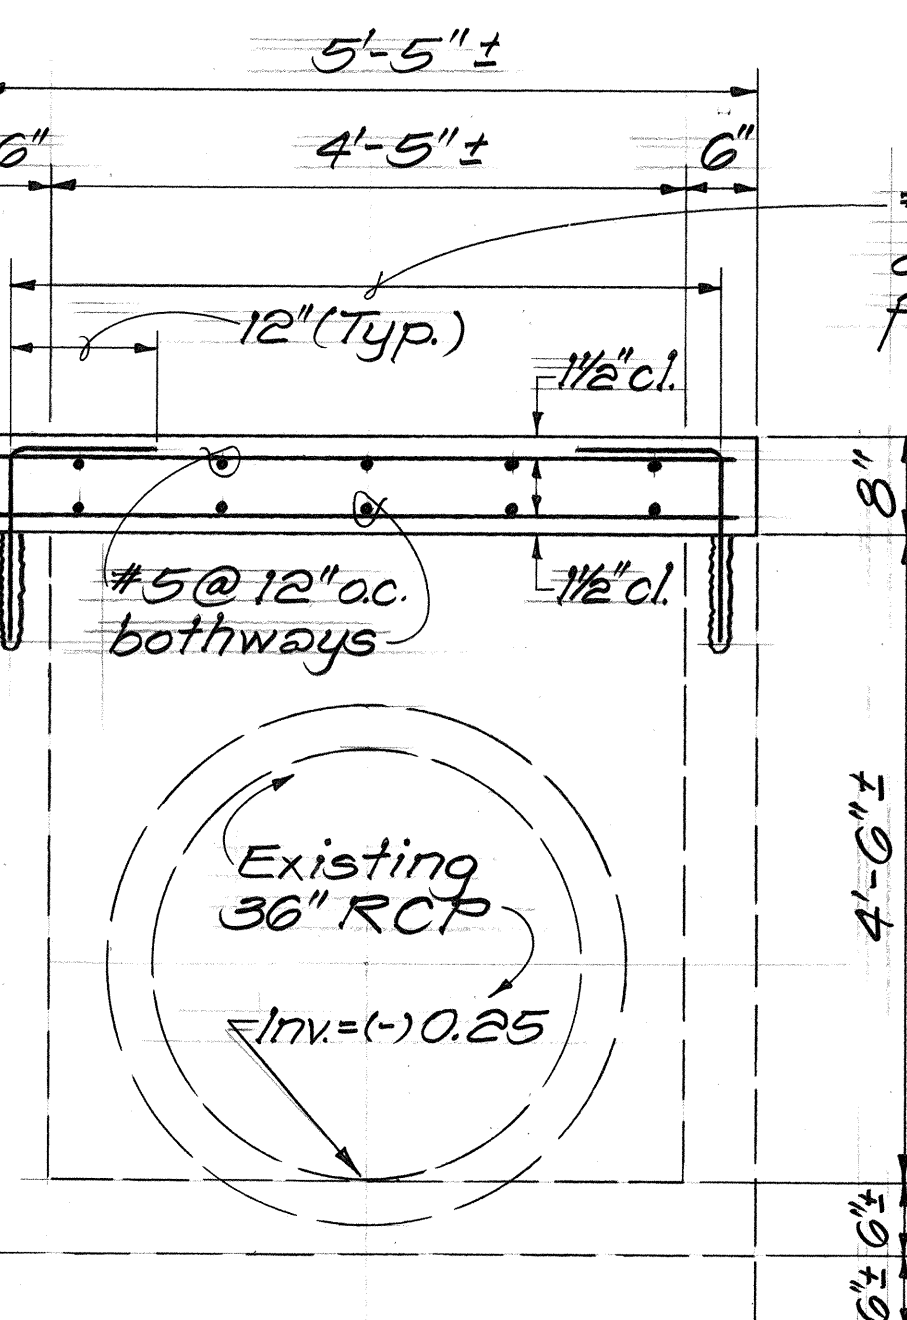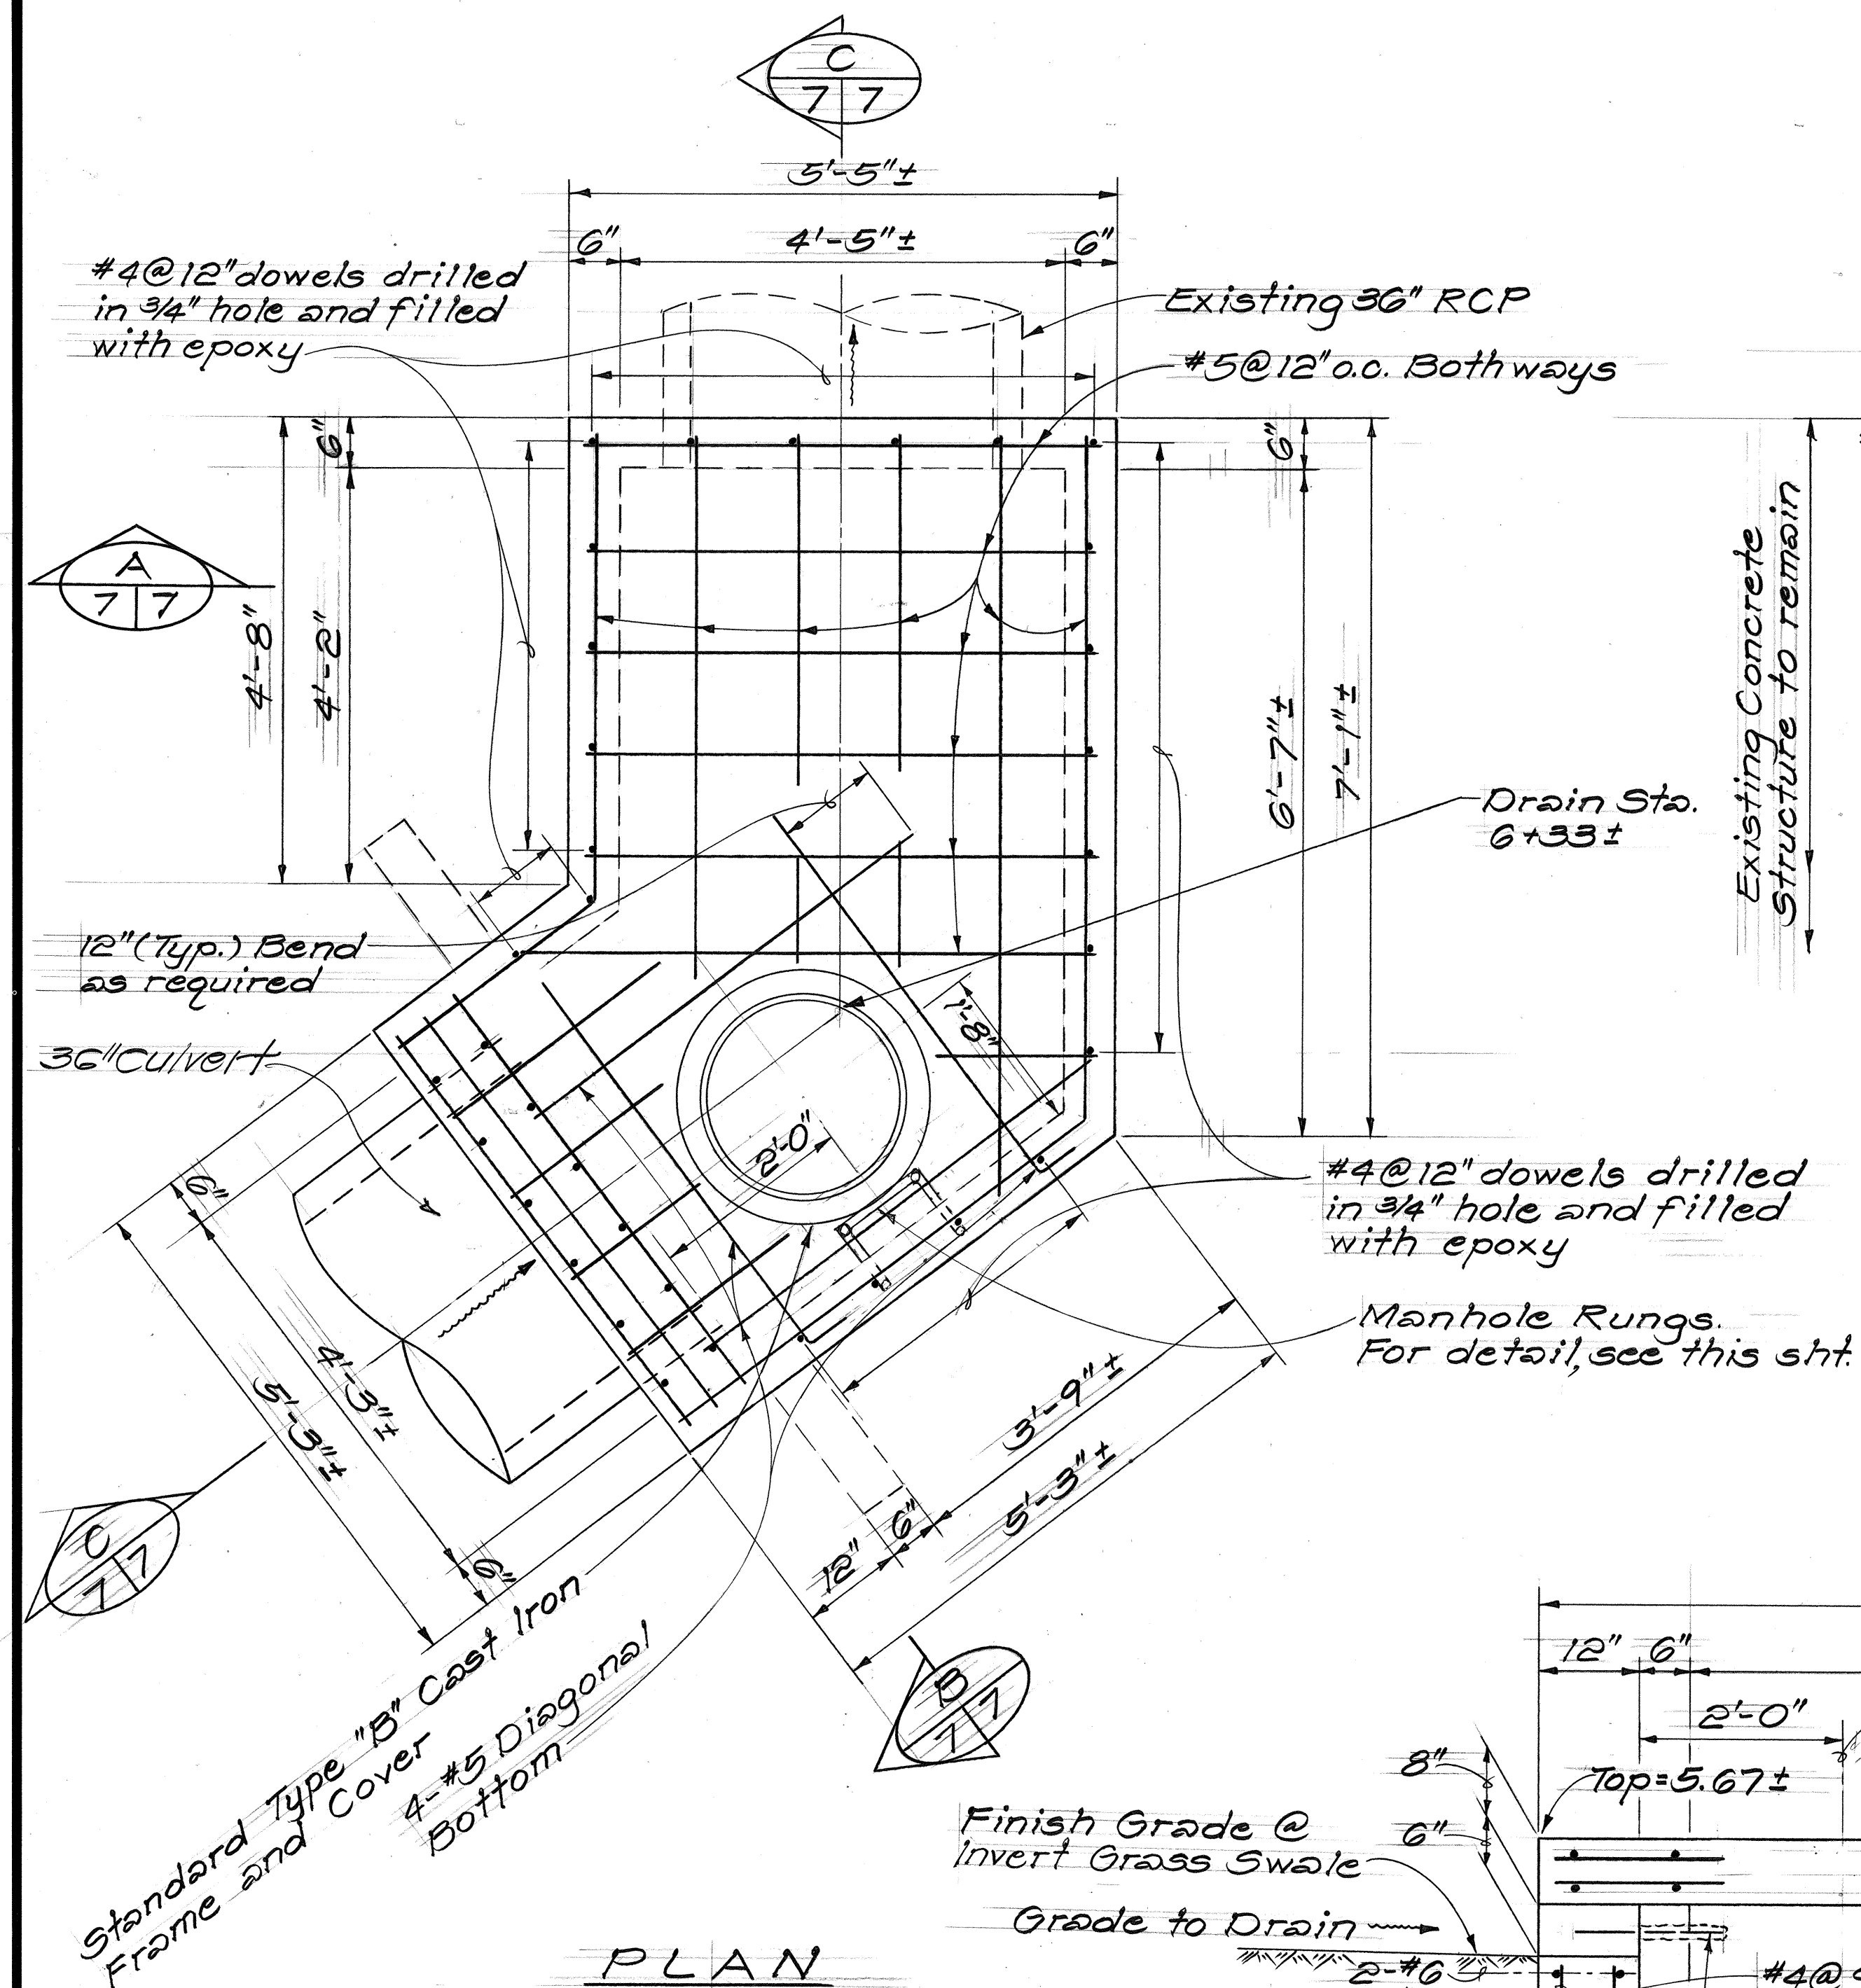

SECTION A
Scale: 3/4" = 1'-0"

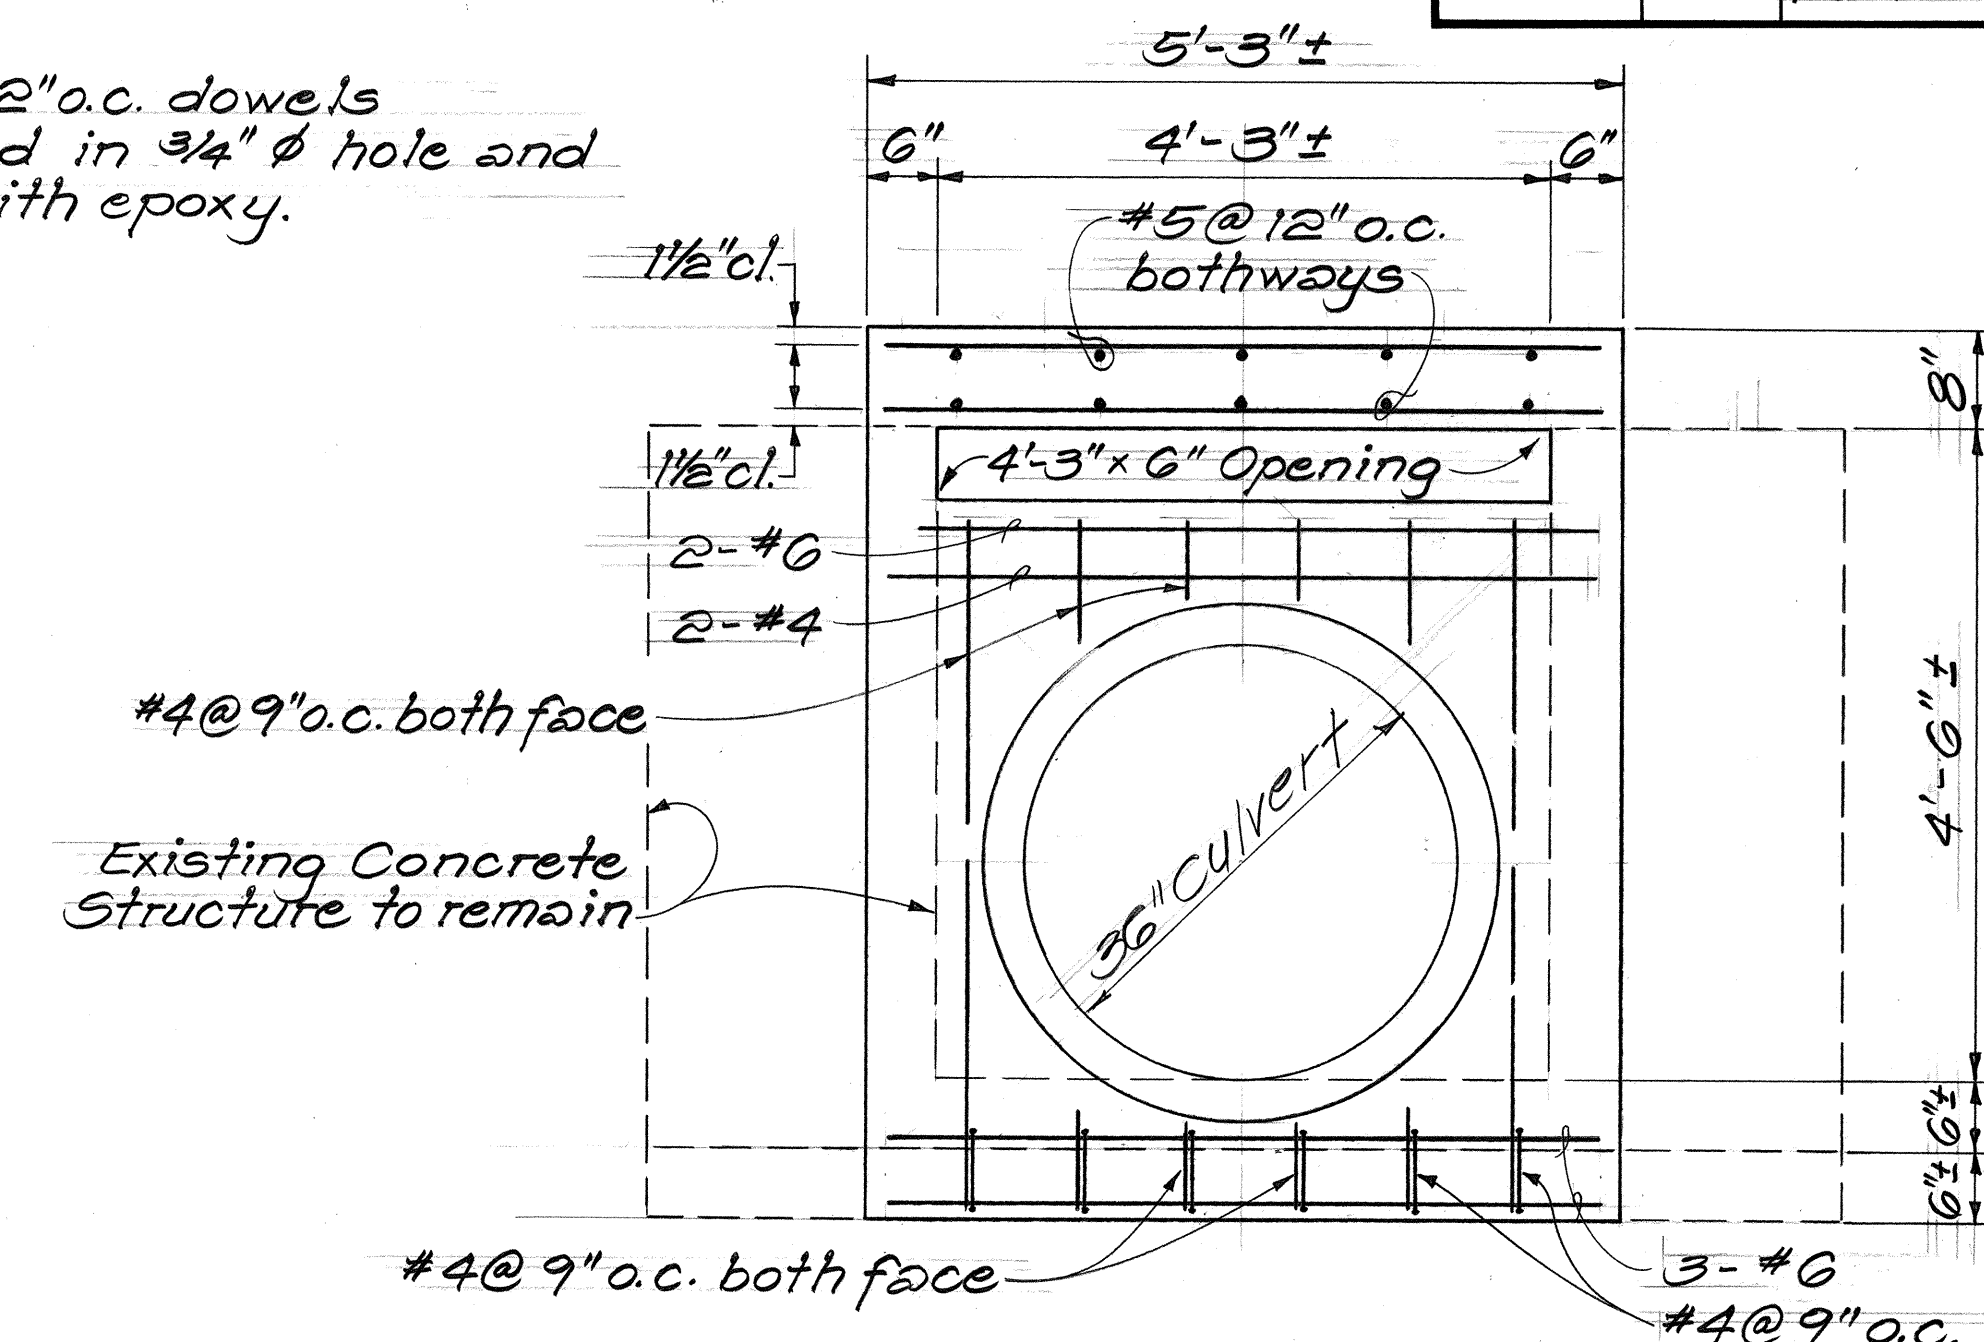


SECTION B
Scale: 3/4" = 1'-0"

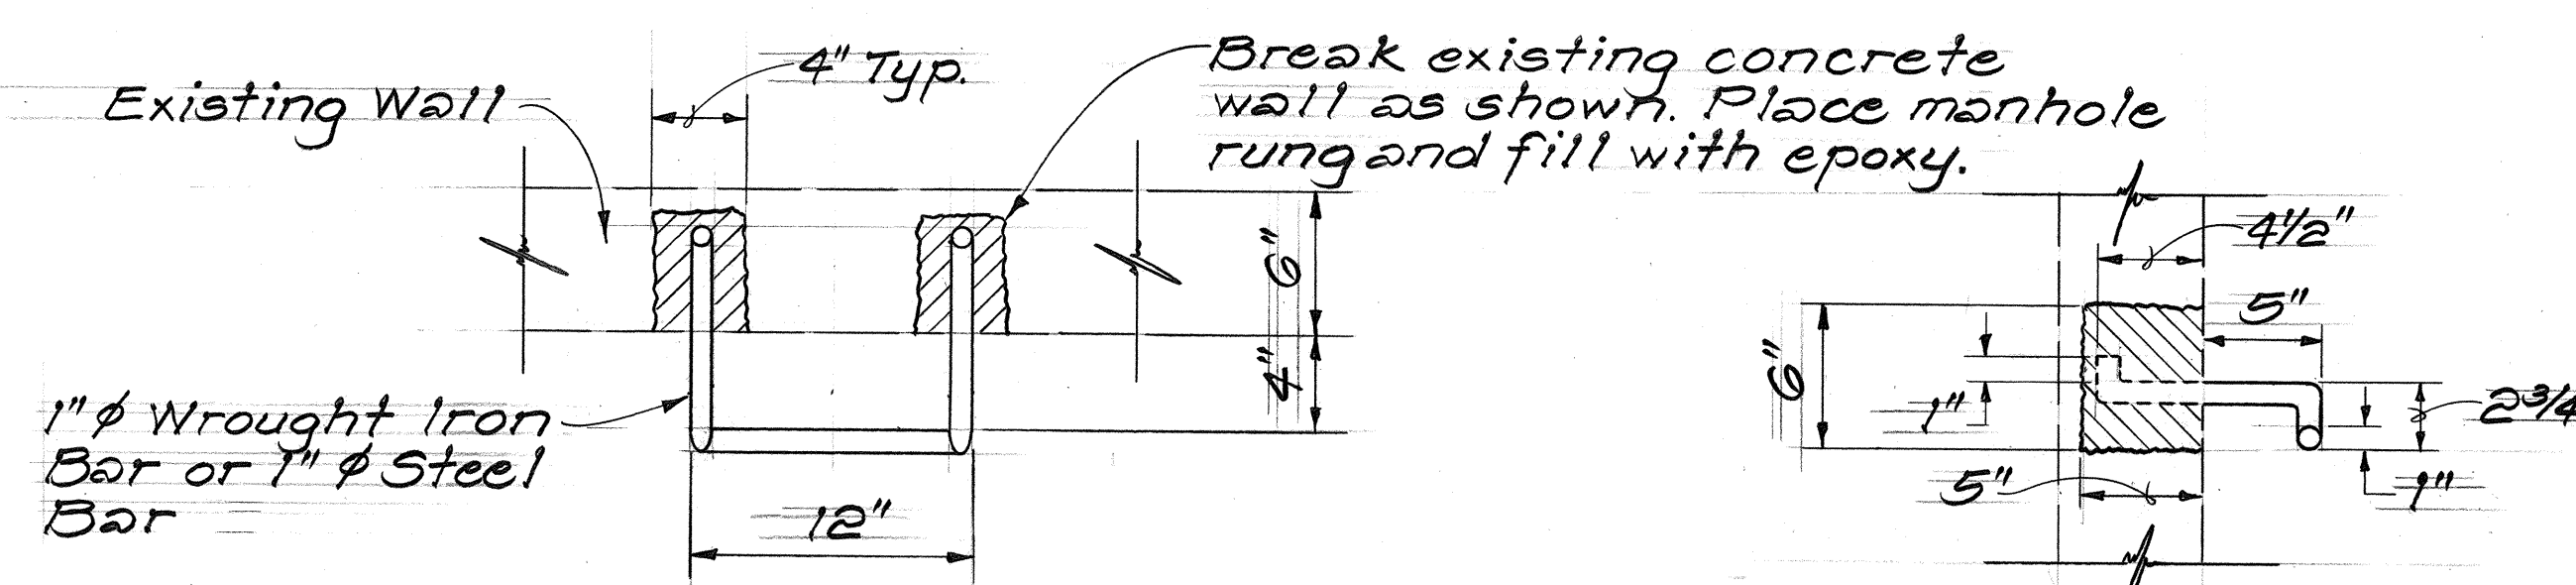

PLAN VIEW
Scale: 1 1/2" = 1'-0"

SIDE VIEW
Scale: 1 1/2" = 1'-0"

MANHOLE RUNG FOR TYPE "C" CATCH BASIN

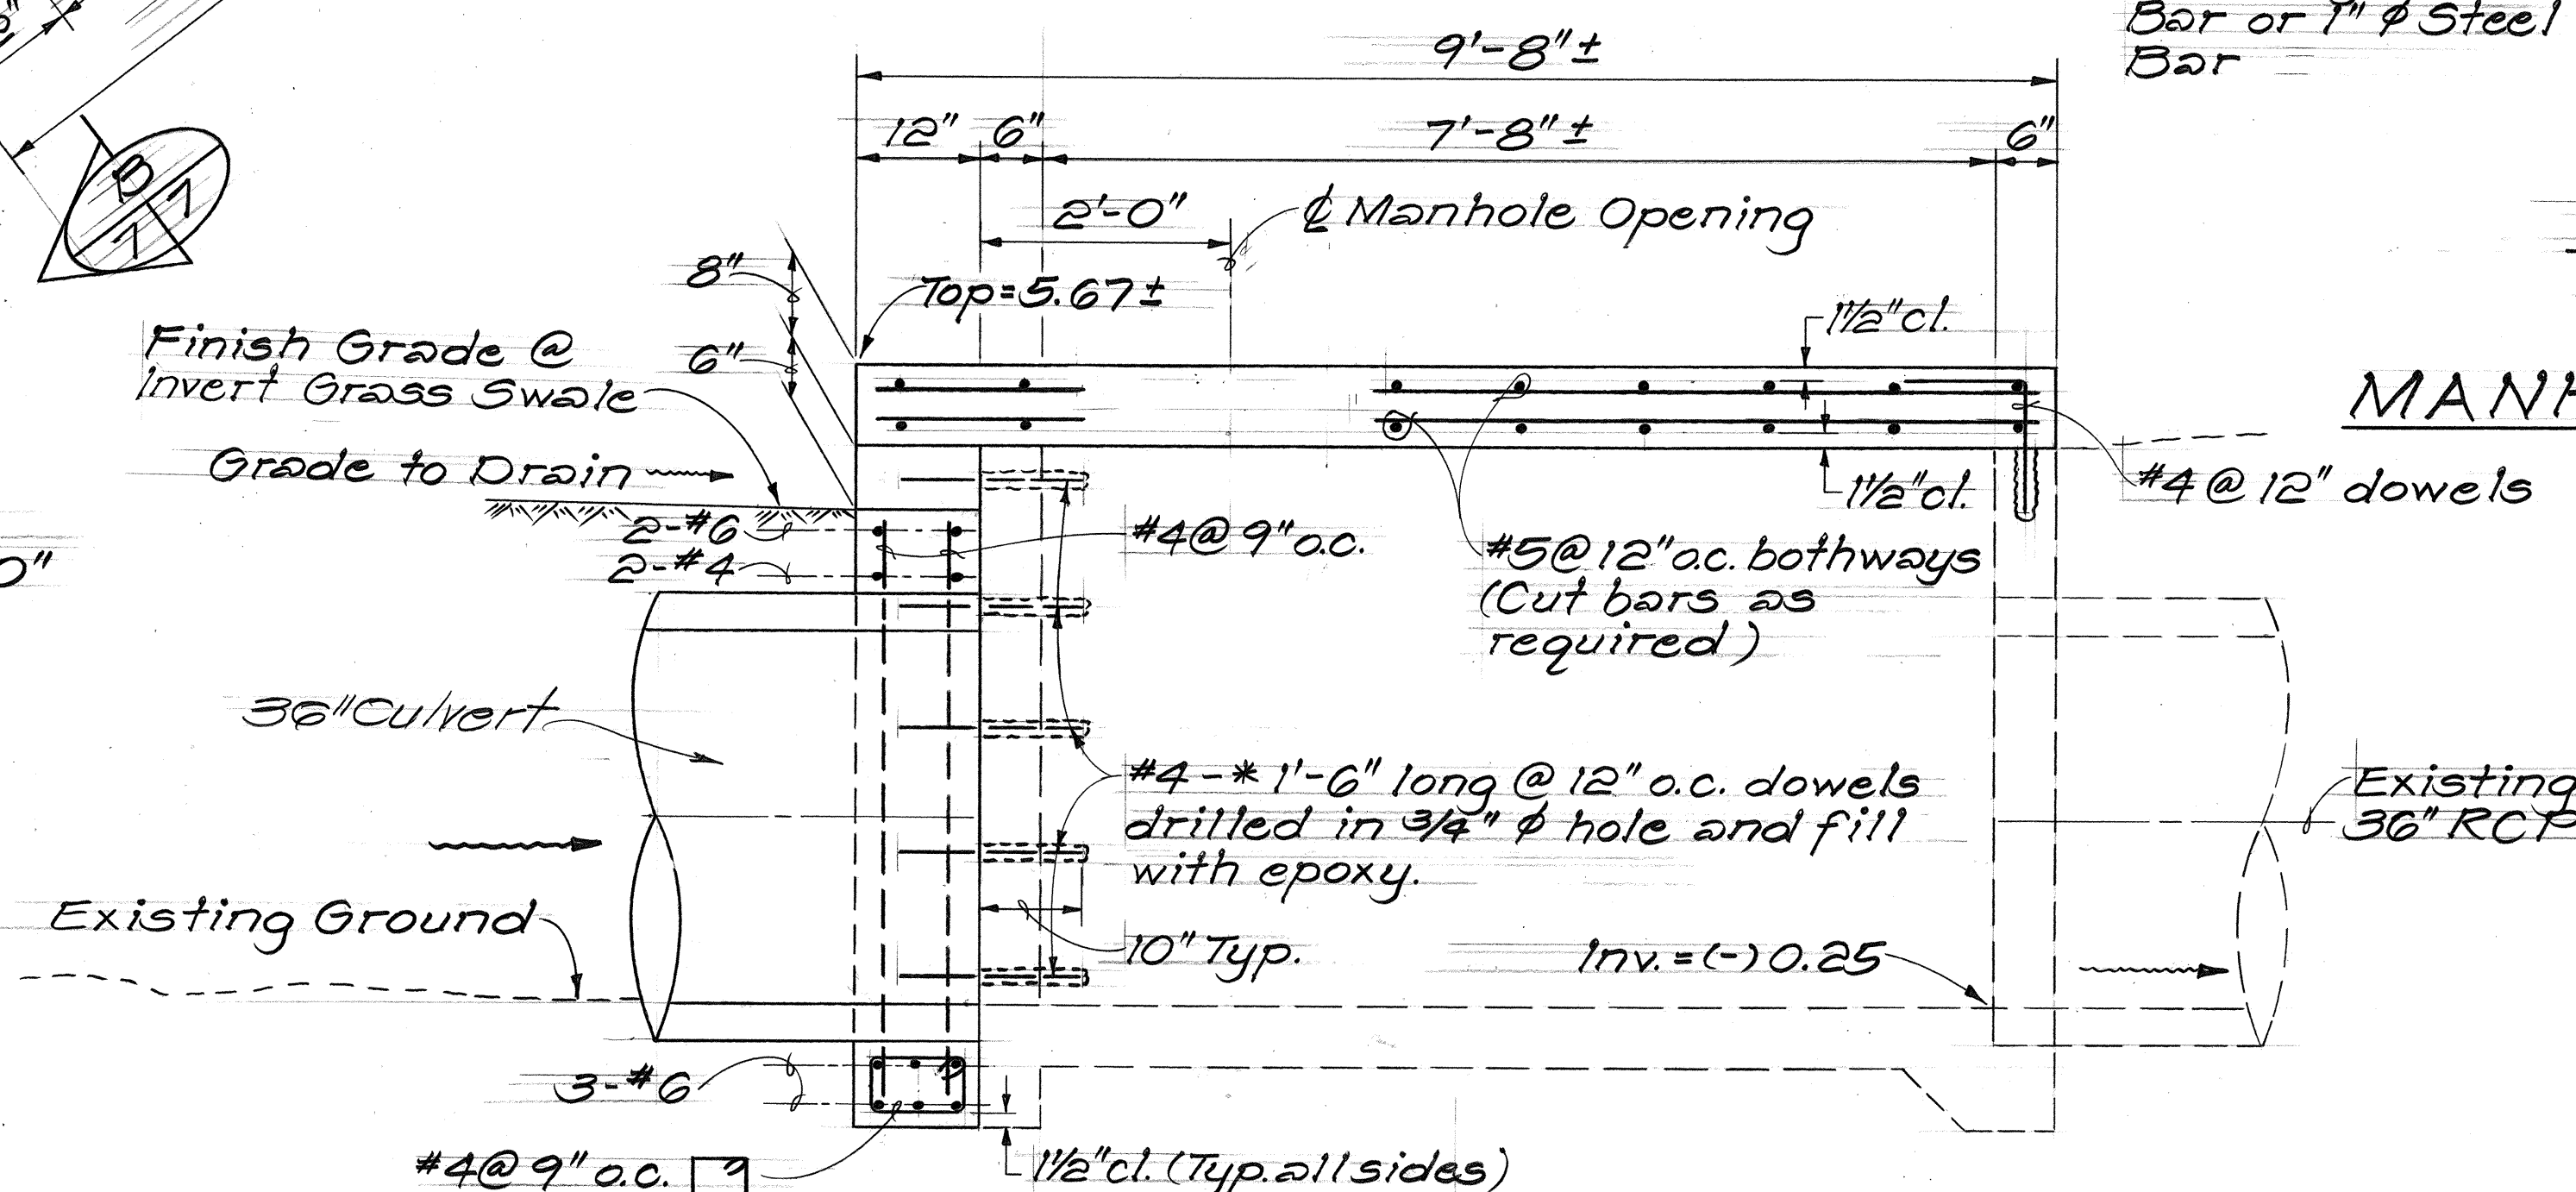


SECTION C
Scale: 3/4" = 1'-0"

DETAILS OF TYPE "C" CATCH BASIN
Scale: As Noted


STATE OF HAWAII DEPARTMENT OF TRANSPORTATION HIGHWAYS DIVISION
DRAINAGE DETAILS
HARRINGTON HIGHWAY
DRAINAGE IMPROVEMENTS
Vicinity of Kapakahi Stream
Project No. 7101A-02-87
Scale: As Noted Date: Oct. 1986
SHEET No. OF SHEETS

ORIGINAL PLAN	DATE
SURVEY PLOTTED BY	
DRAWN BY	
DESIGNED BY	
QUANTITIES BY	
CHECKED BY	

FED. ROAD DIST. NO.	STATE	FED. AID PROJ. NO.	FISCAL YEAR	SHEET NO.	TOTAL SHEETS
HAWAII	HAW.	7101A-02-87	1987	75-1	8

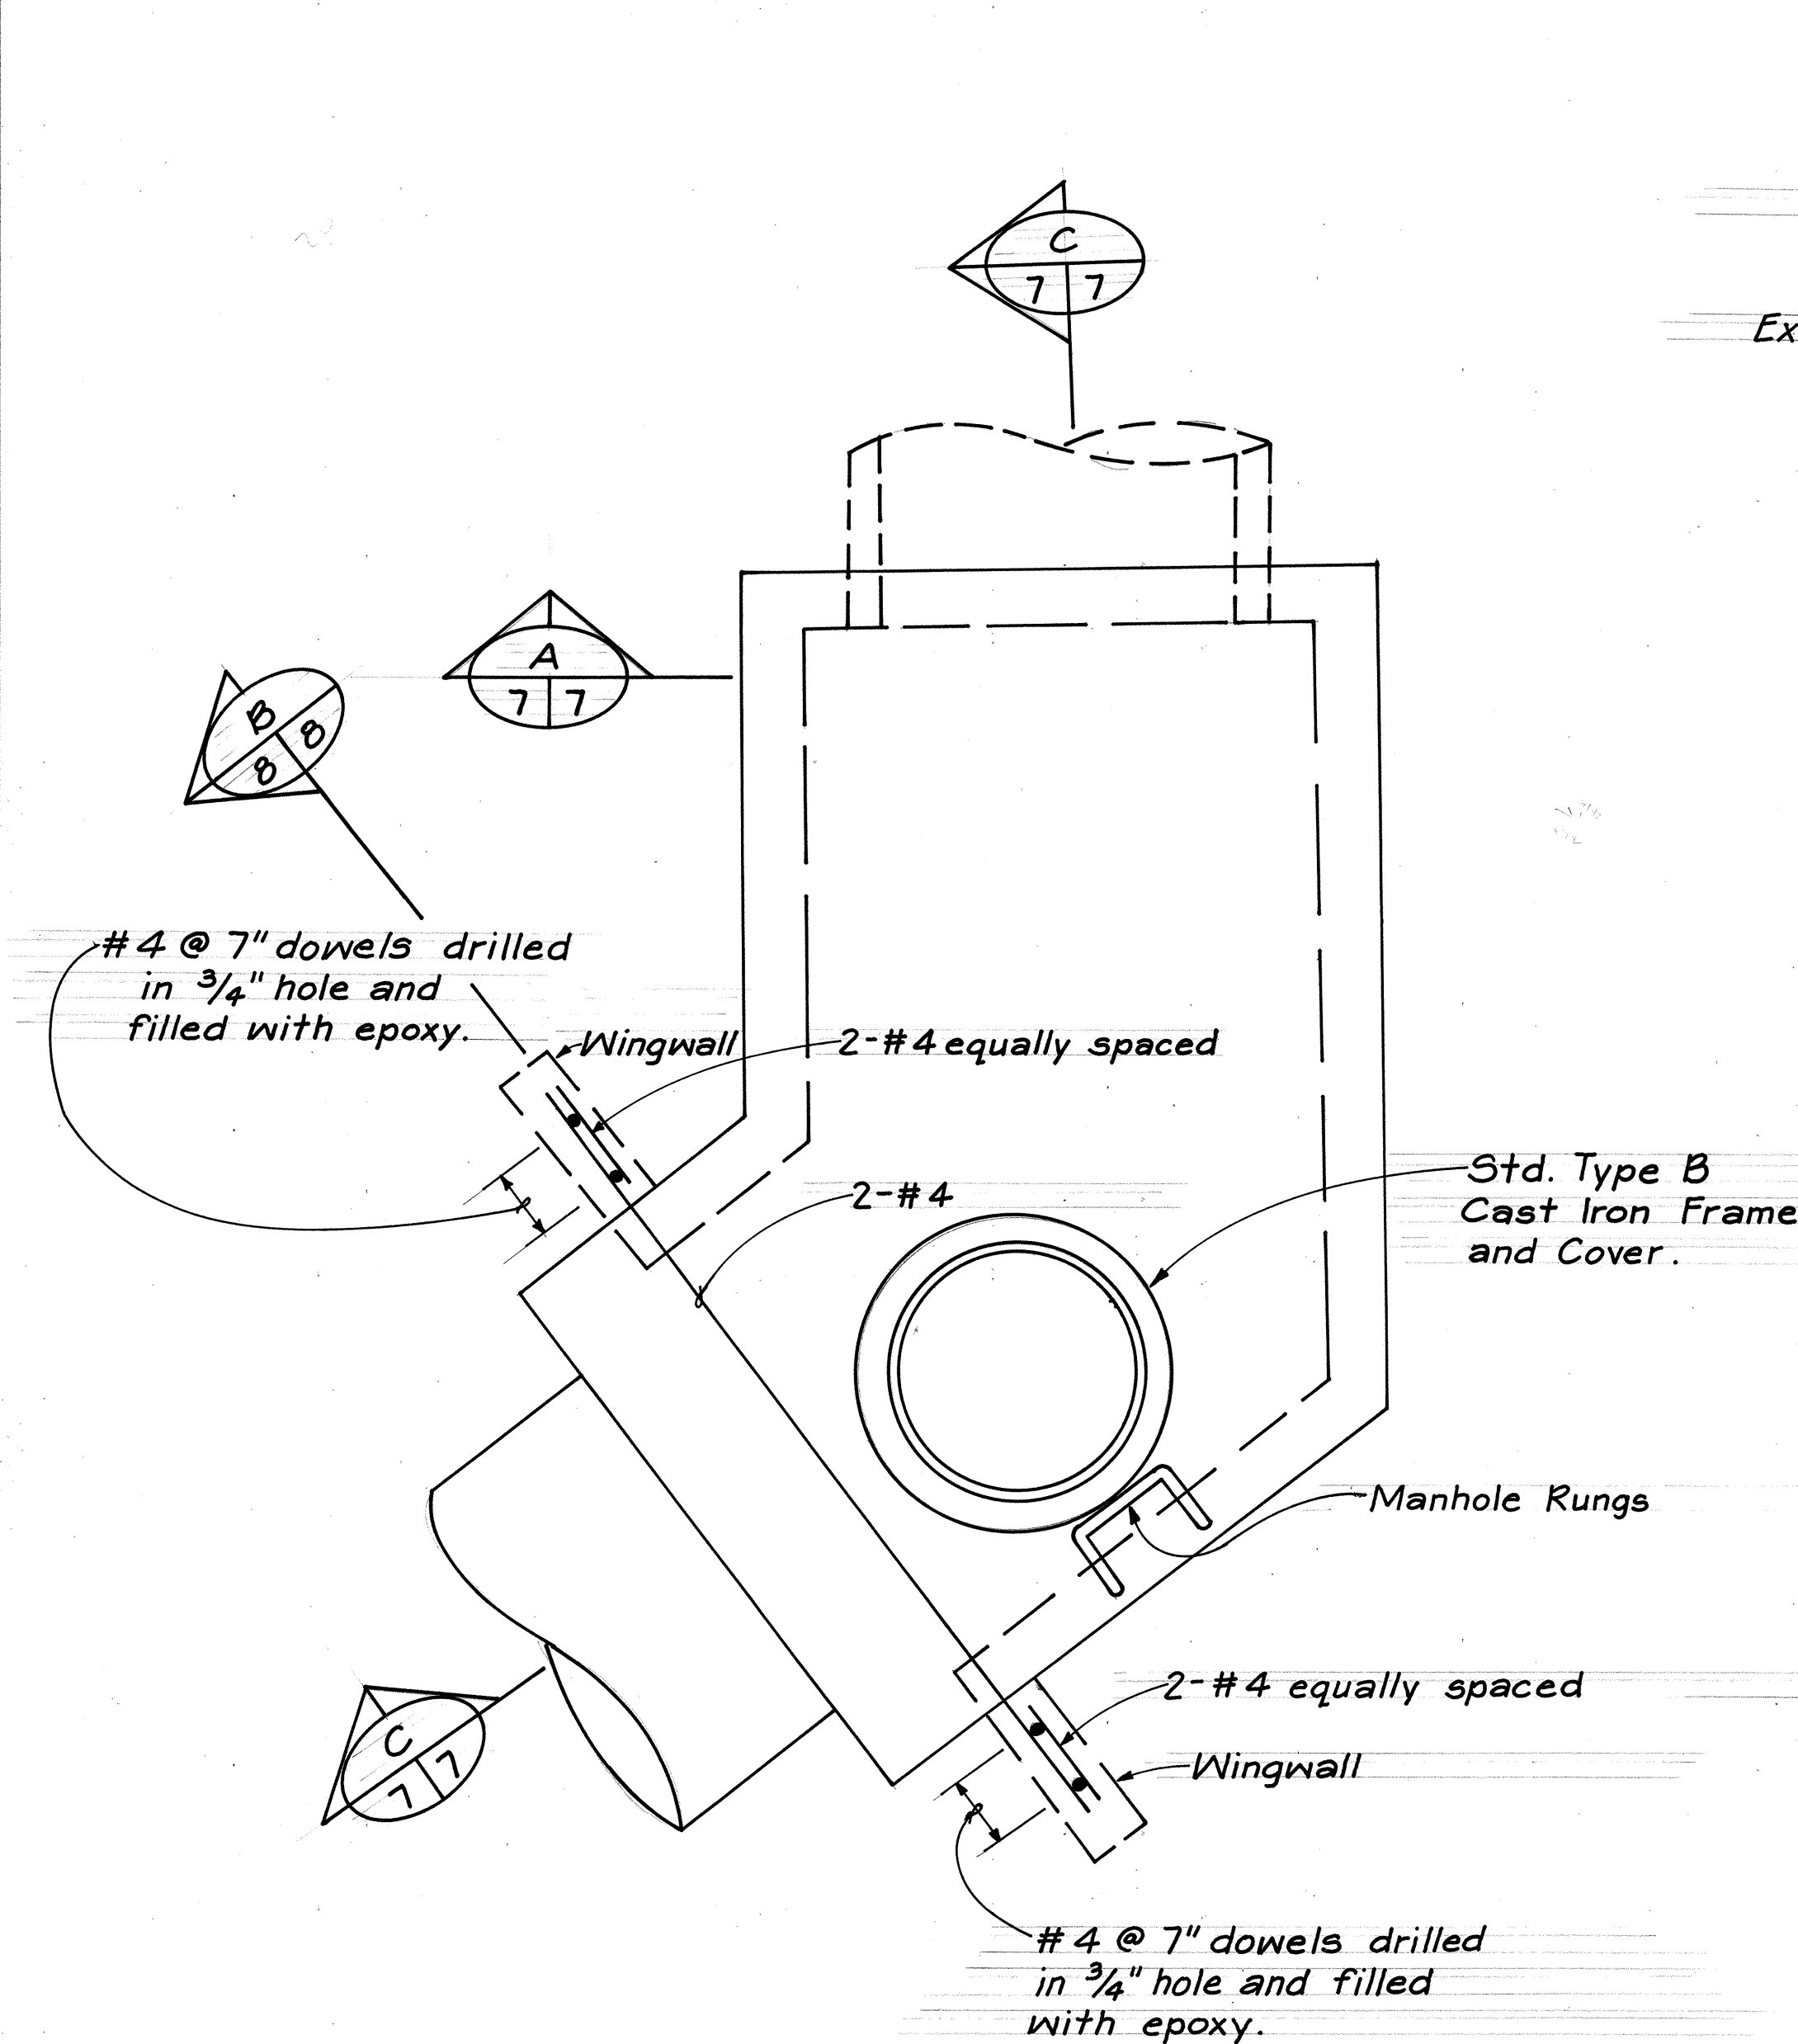


PLAN
Scale: $\frac{3}{4}$ " = 1'-0"

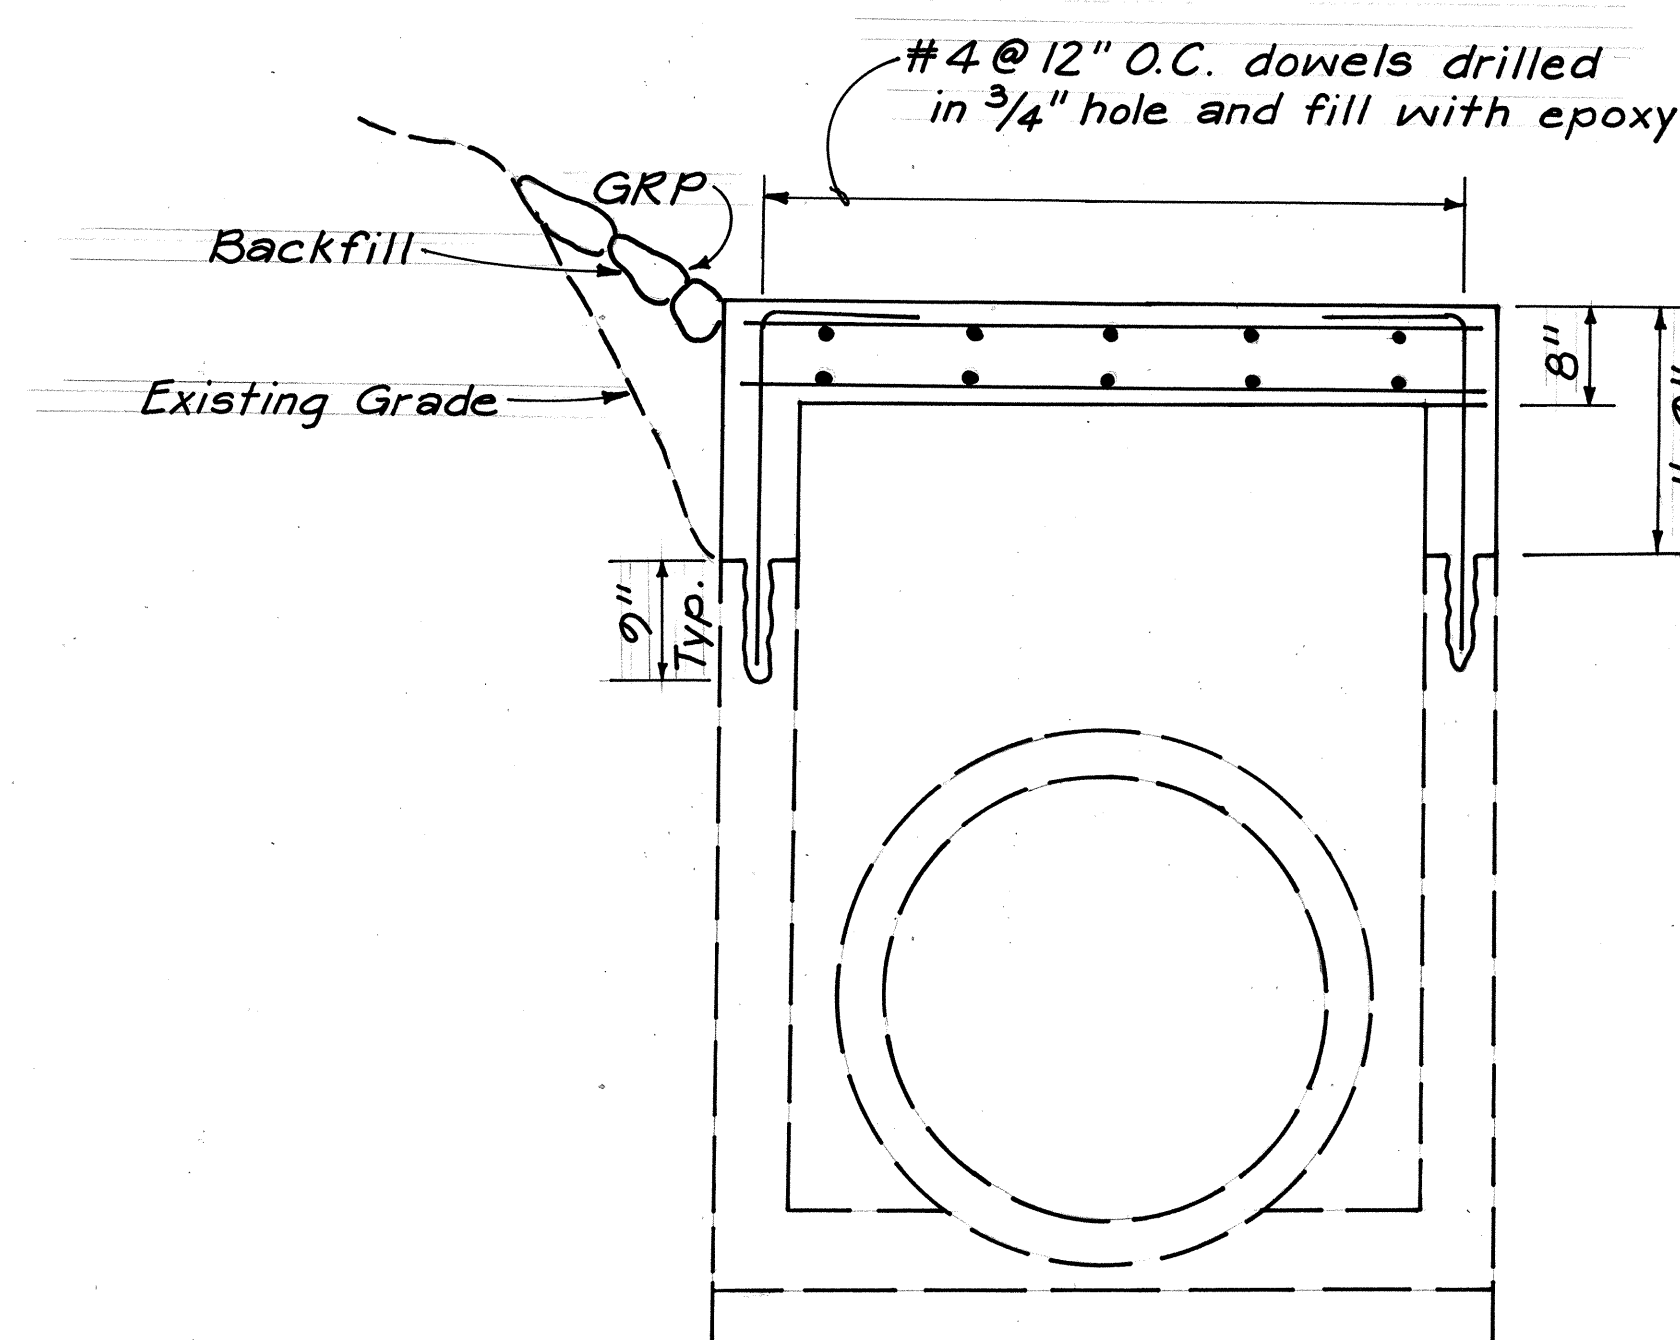


SECTION A-A

Scale: $\frac{3}{4}$ " = 1'-0"

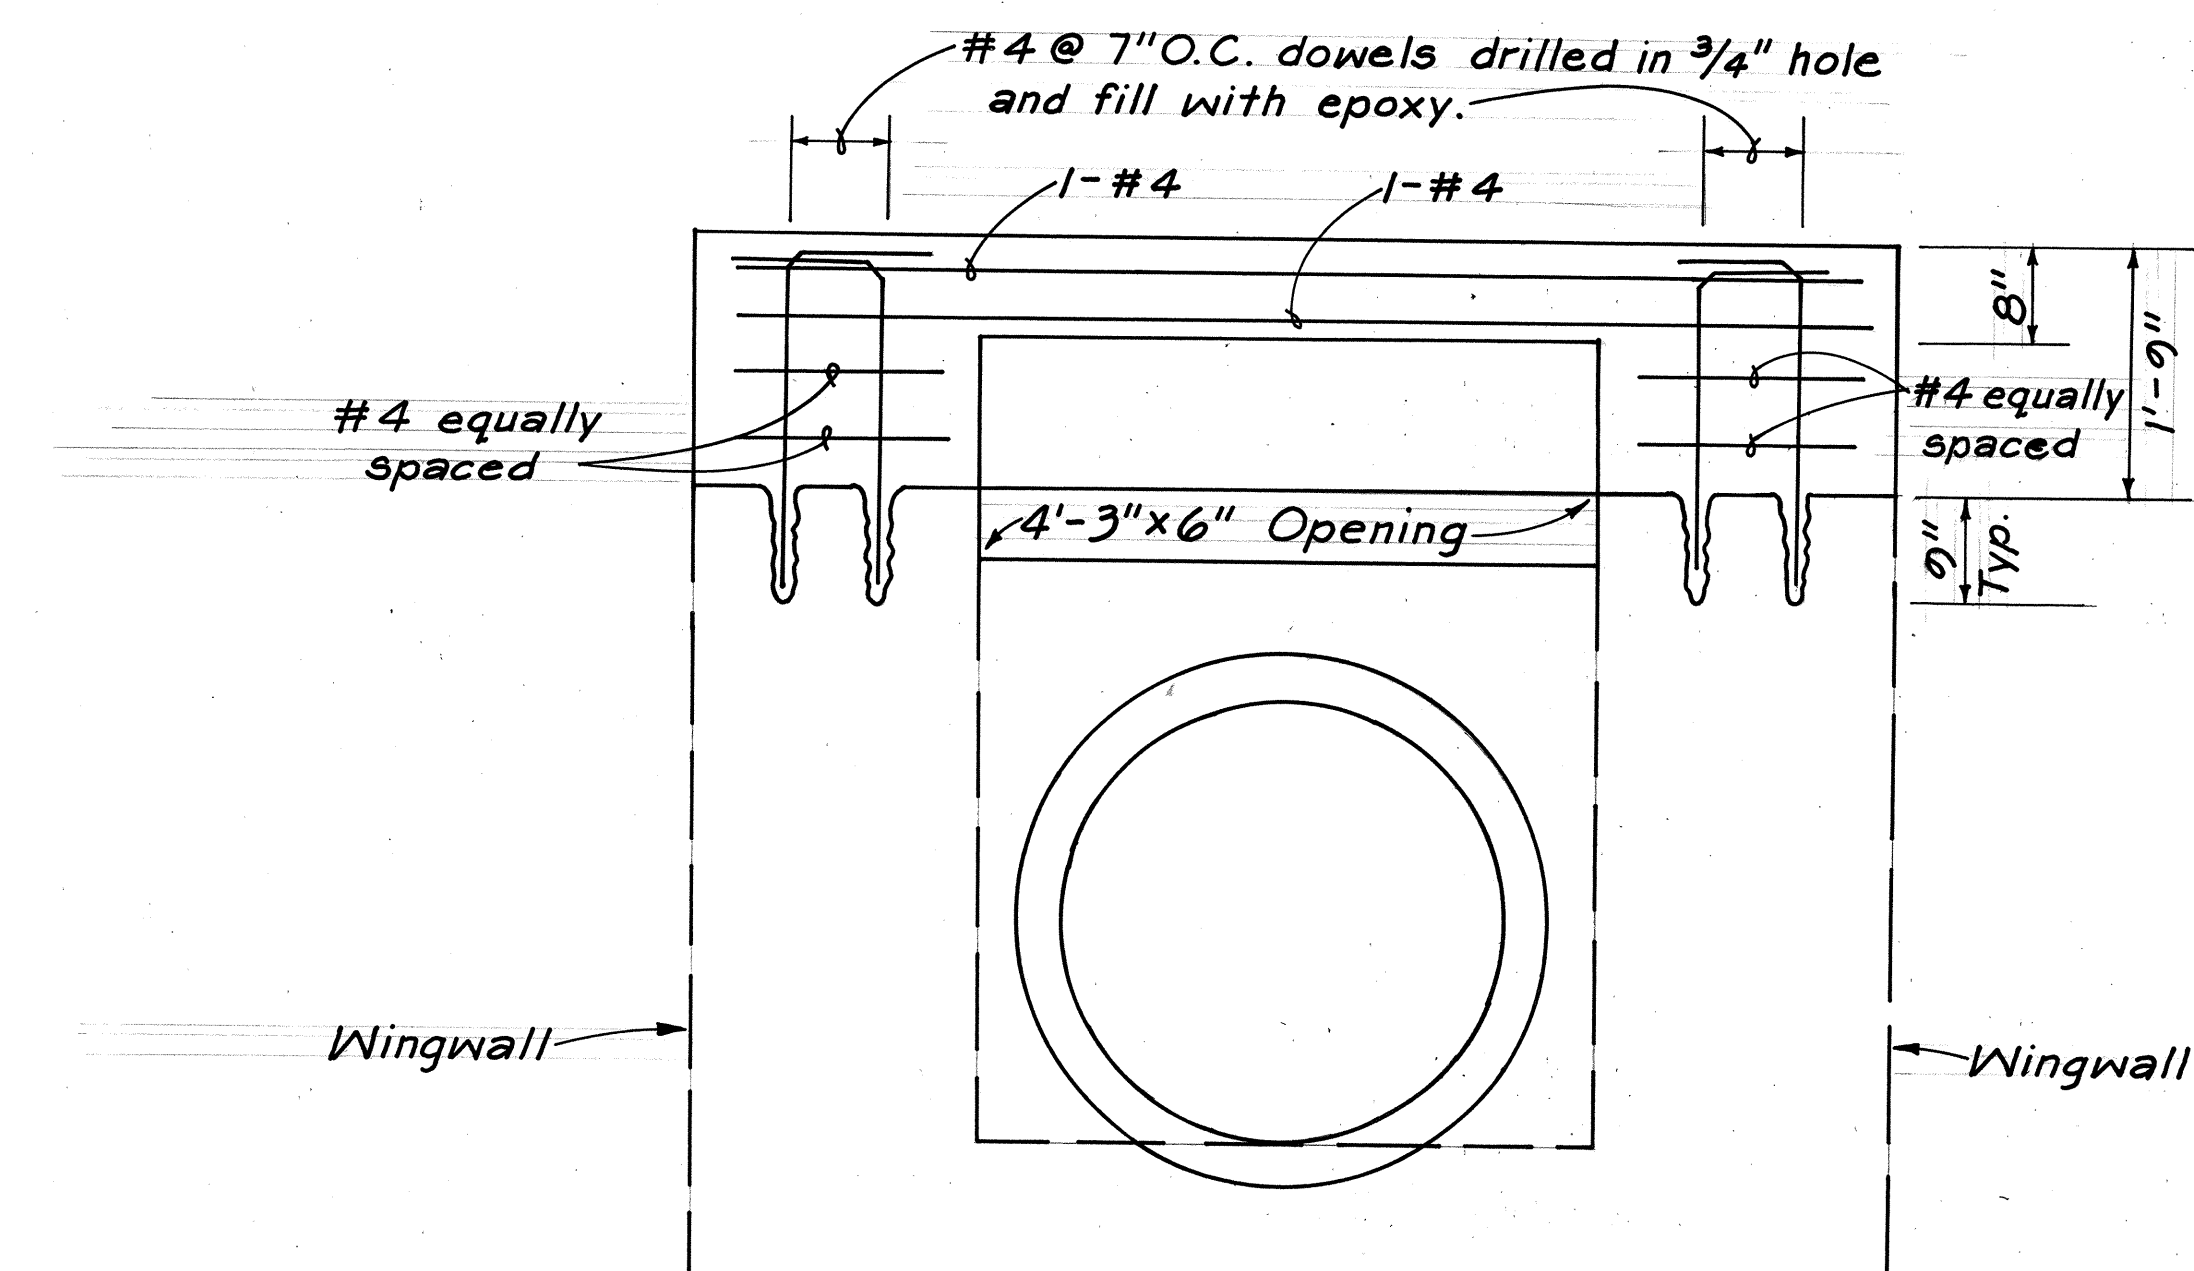

SECTION B-B

Scale: $\frac{3}{4}$ " = 1'-0"

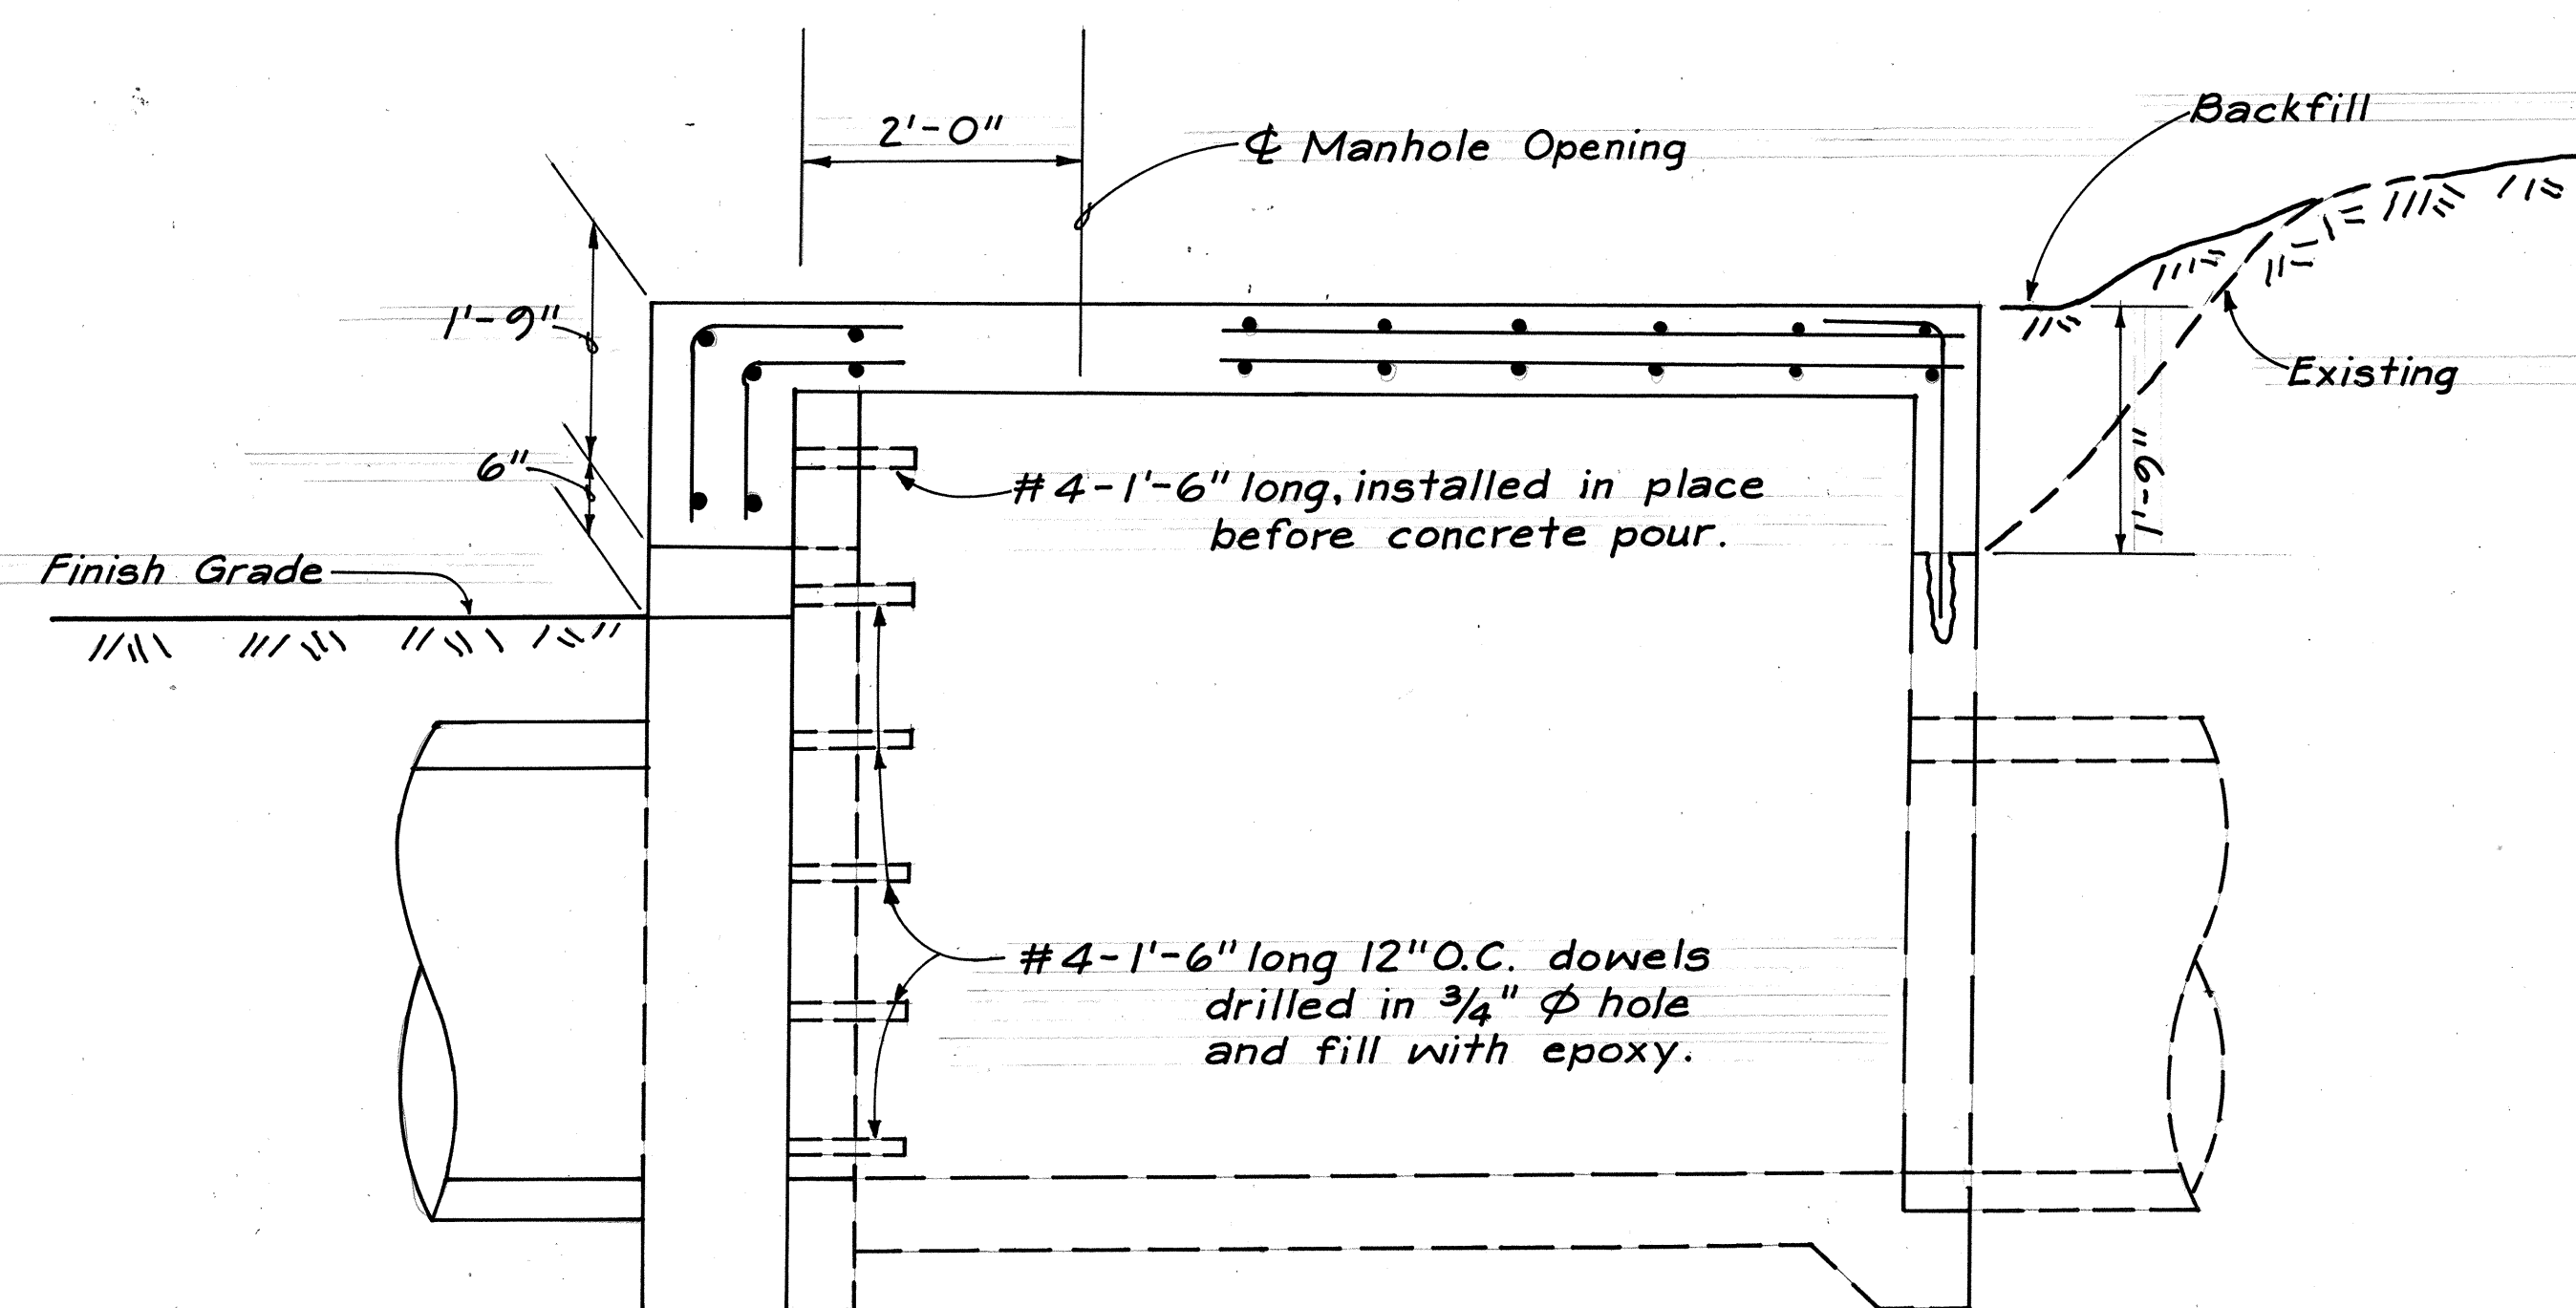

SECTION C-C

Scale: $\frac{3}{4}$ " = 1'-0"

Note: This tracing prepared during "As-Built" posting.


DETAILS OF REVISED TYPE 'C' CATCH BASIN
REVISION: RAISE WALLS 1'-9"

STATE OF HAWAII
DEPARTMENT OF TRANSPORTATION
HIGHWAYS DIVISION

REVISED TYPE 'C'
CATCH BASIN
FARRINGTON HIGHWAY
DRAINAGE IMPROVEMENTS
PROJECT NO. 7101A-02-87

Scale: As Shown Date: Oct., 1986
SHEET No. 1 OF 1 SHEETS

FED. ROAD DIST. NO.	STATE	PROJ. NO.	FISCAL YEAR	SHEET NO.	TOTAL SHEETS
HAWAII	HAW.	7101A-02-87	1987	8	8

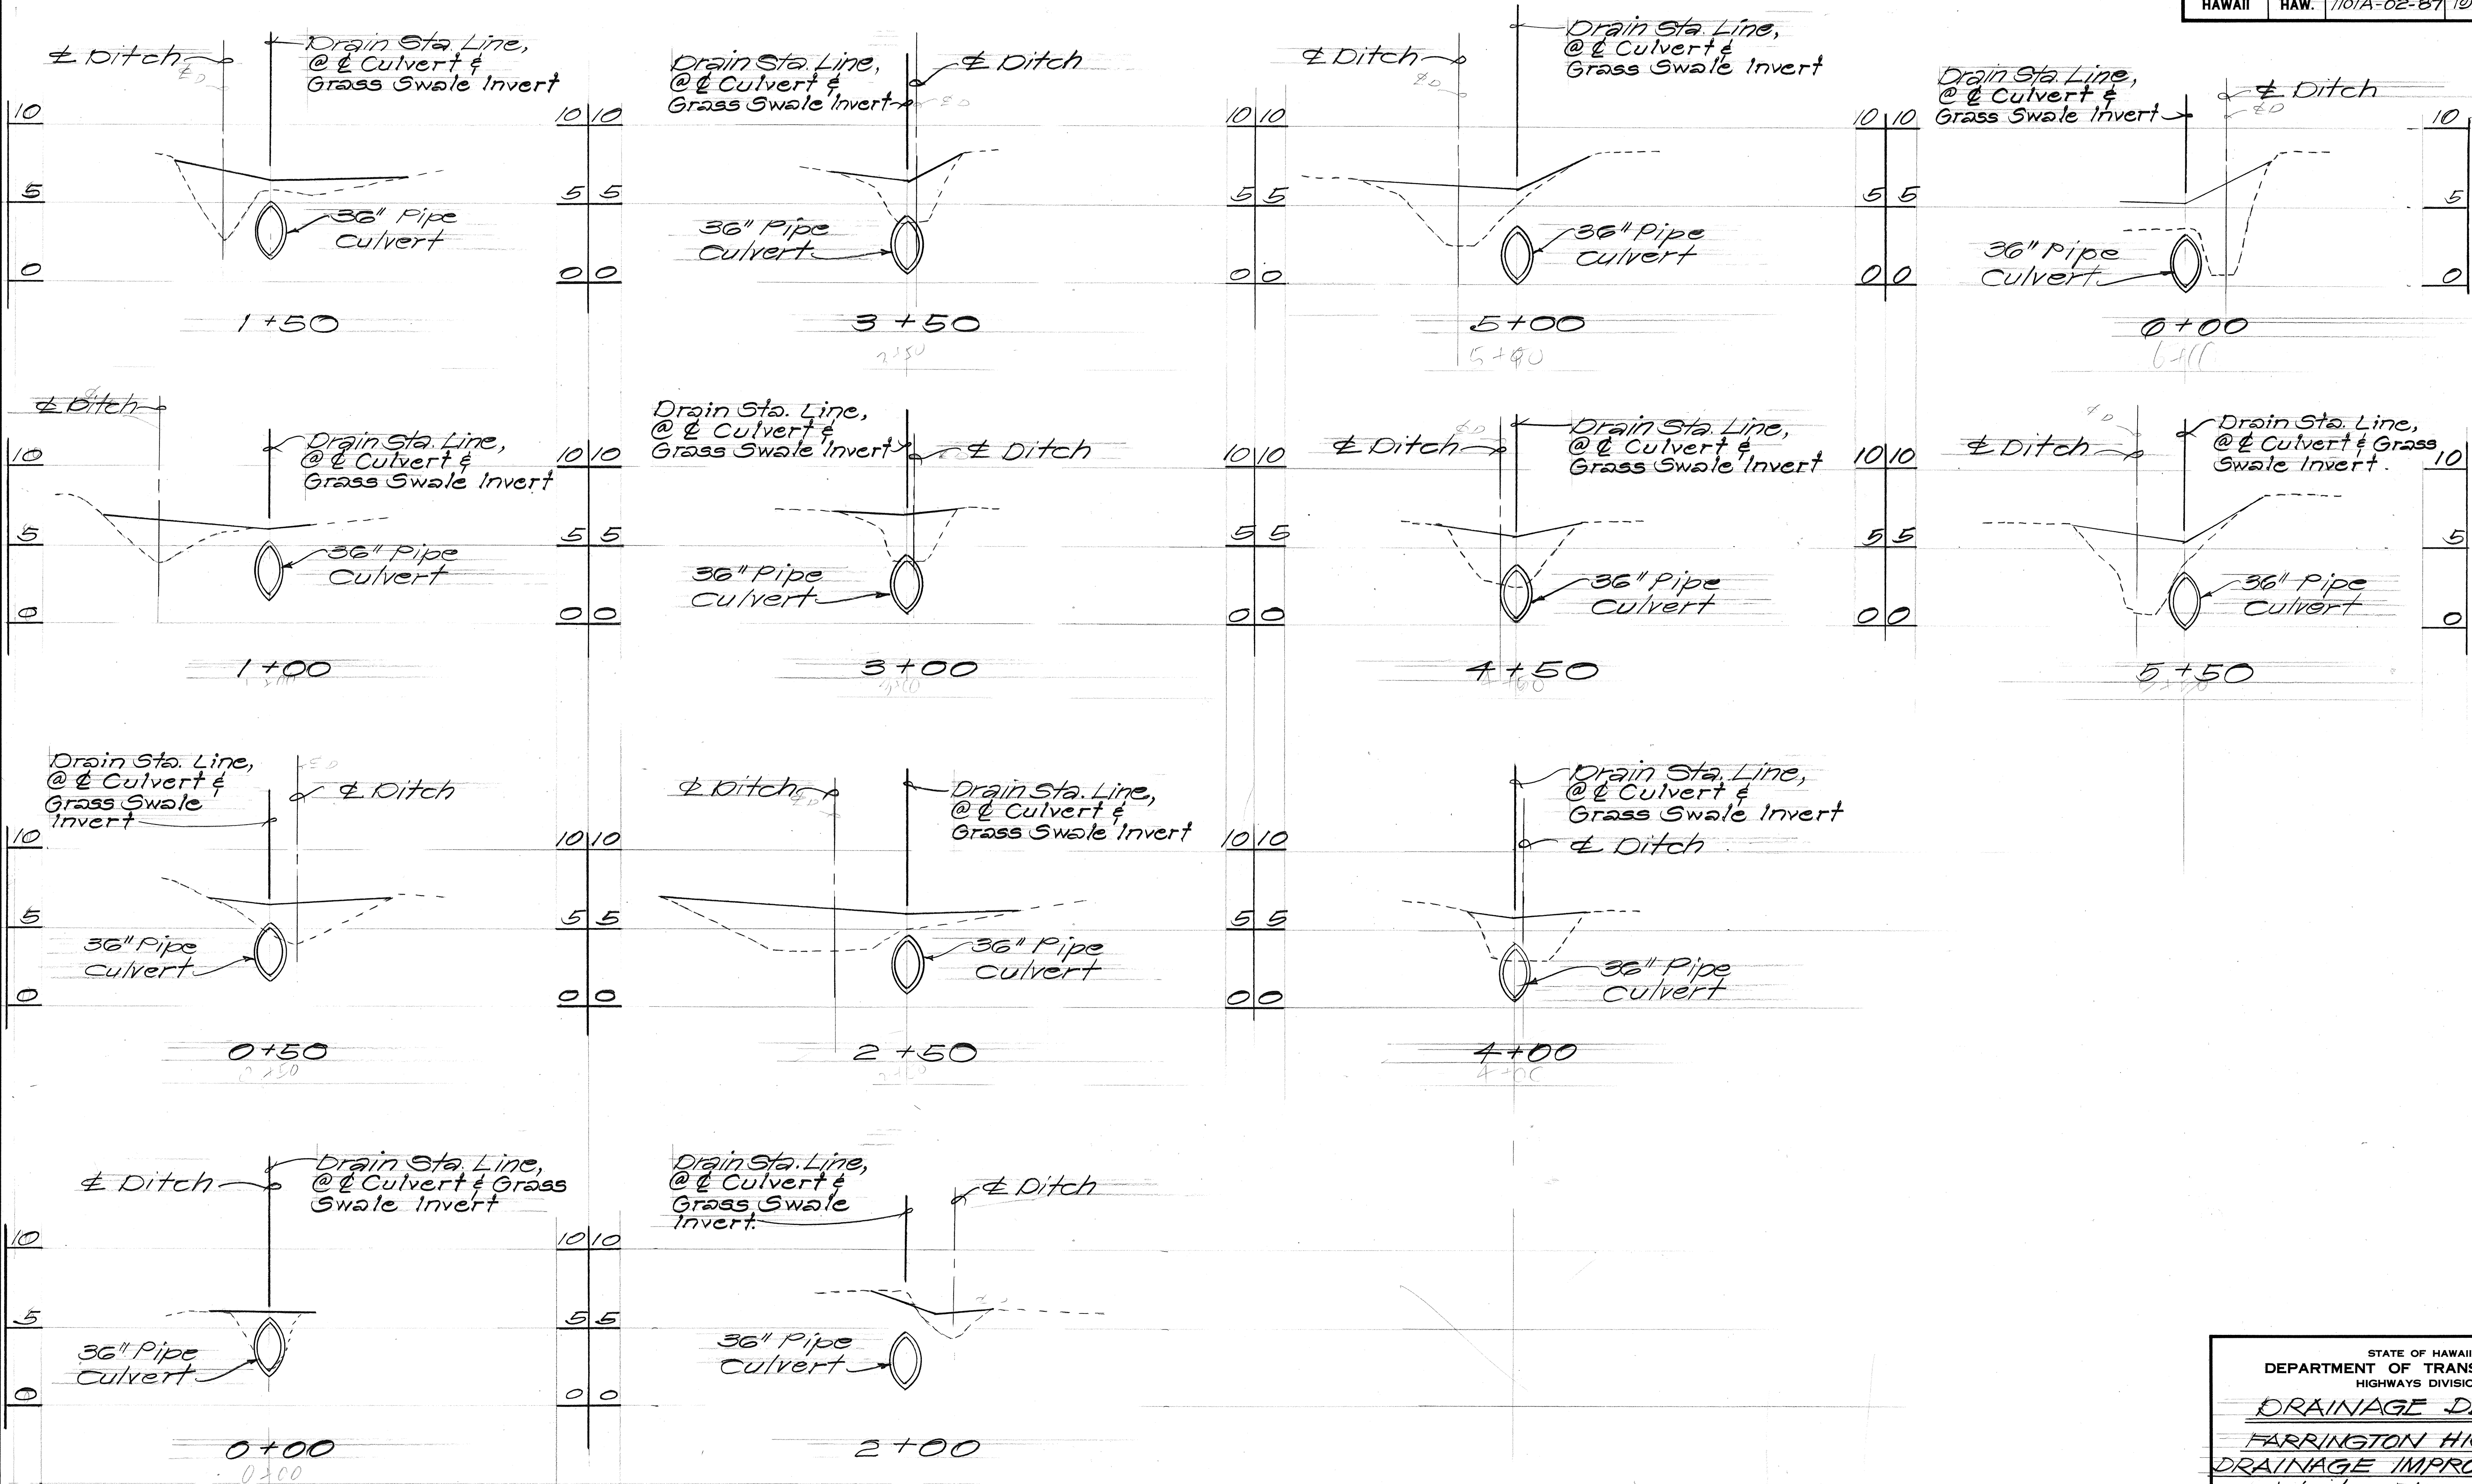

GROSS SECTIONS FOR 36 INCH CULVERT


Scale: Horiz. 1" = 10'
Vert. 1" = 5'

STATE OF HAWAII
DEPARTMENT OF TRANSPORTATION
HIGHWAYS DIVISION
DRAINAGE DETAILS
FARRINGTON HIGHWAY
DRAINAGE IMPROVEMENTS
Vicinity of Kapakahi Stream
Project No. 7101A-02-87
Scale: As Noted Date: Oct. 1986
SHEET NO. 8 OF 8 SHEETS

ORIGINAL PLAN	SURVEY PLOTTED BY	DATE
DESIGNED BY	DRAWN BY	
CHECKED BY	TRACED BY	
NO.	NOTE BOOK	

WATER NOTES

1. Unless otherwise specified, all materials and construction of water system facilities and appurtenances shall be in accordance with the Standard Specifications For Road And Bridge Construction, dated 1985, as amended, of the Hawaii Highway Division, Department of Transportation and the City and County of Honolulu Board of Water Supply's "Water System Standards", Volume 1, dated 1985, and the "Approved Material List and Standard Details For Water System Construction", Volume 2, dated 1985, and all subsequent amendments and additions.
2. Test pressure shall be prevailing line pressure, joints left exposed for 24 hours to check for leaks prior to backfill.
3. The contractor shall chlorinate the entire inside surface of each pipe and fitting with disinfection solution of 5 ounces of sodium hypochlorite mixed with 10 gallons of water.
4. The contractor shall notify B.W.S. Planning and Engineering Division, Construction Section one week prior commencing work on the water system.
5. The Contractor shall be responsible for the protection of all water lines during construction. The Contractor shall be especially careful when excavating behind water lines tees and bends wherever there is a possibility of water line movement due to removal of the supporting earth beyond the existing reaction blocks. The Contractor shall take whatever measure he deems necessary to protect the water lines, such as constructing special reaction blocks (with B.W.S. approval) and/or modifying his construction methods.
6. The existence and location of underground utilities and structures as shown on the plans are from the latest available data but is not guaranteed as to the accuracy or the encountering of other obstacles during the course of the work. The Contractor shall be responsible and shall pay for all damages to existing utilities.
7. Prior to installation, the contractor shall submit for approval by Board of Water Supply, the manufacturer's certification that all cast iron (gray or ductile) fittings for the project conform in all respects to the Water System Standards, dated 1985.
8. All plans approved by the Board of Water Supply are based solely on the adequacy of the water supply. All other features of the water system, such as lines, grades, fittings etc., and drainage and other features of improvements shall not be the responsibility of the Board of Water Supply.
9. Relocation of existing 8" W to be done after 5:00 p.m. with a maximum shutdown time of 6 hours.

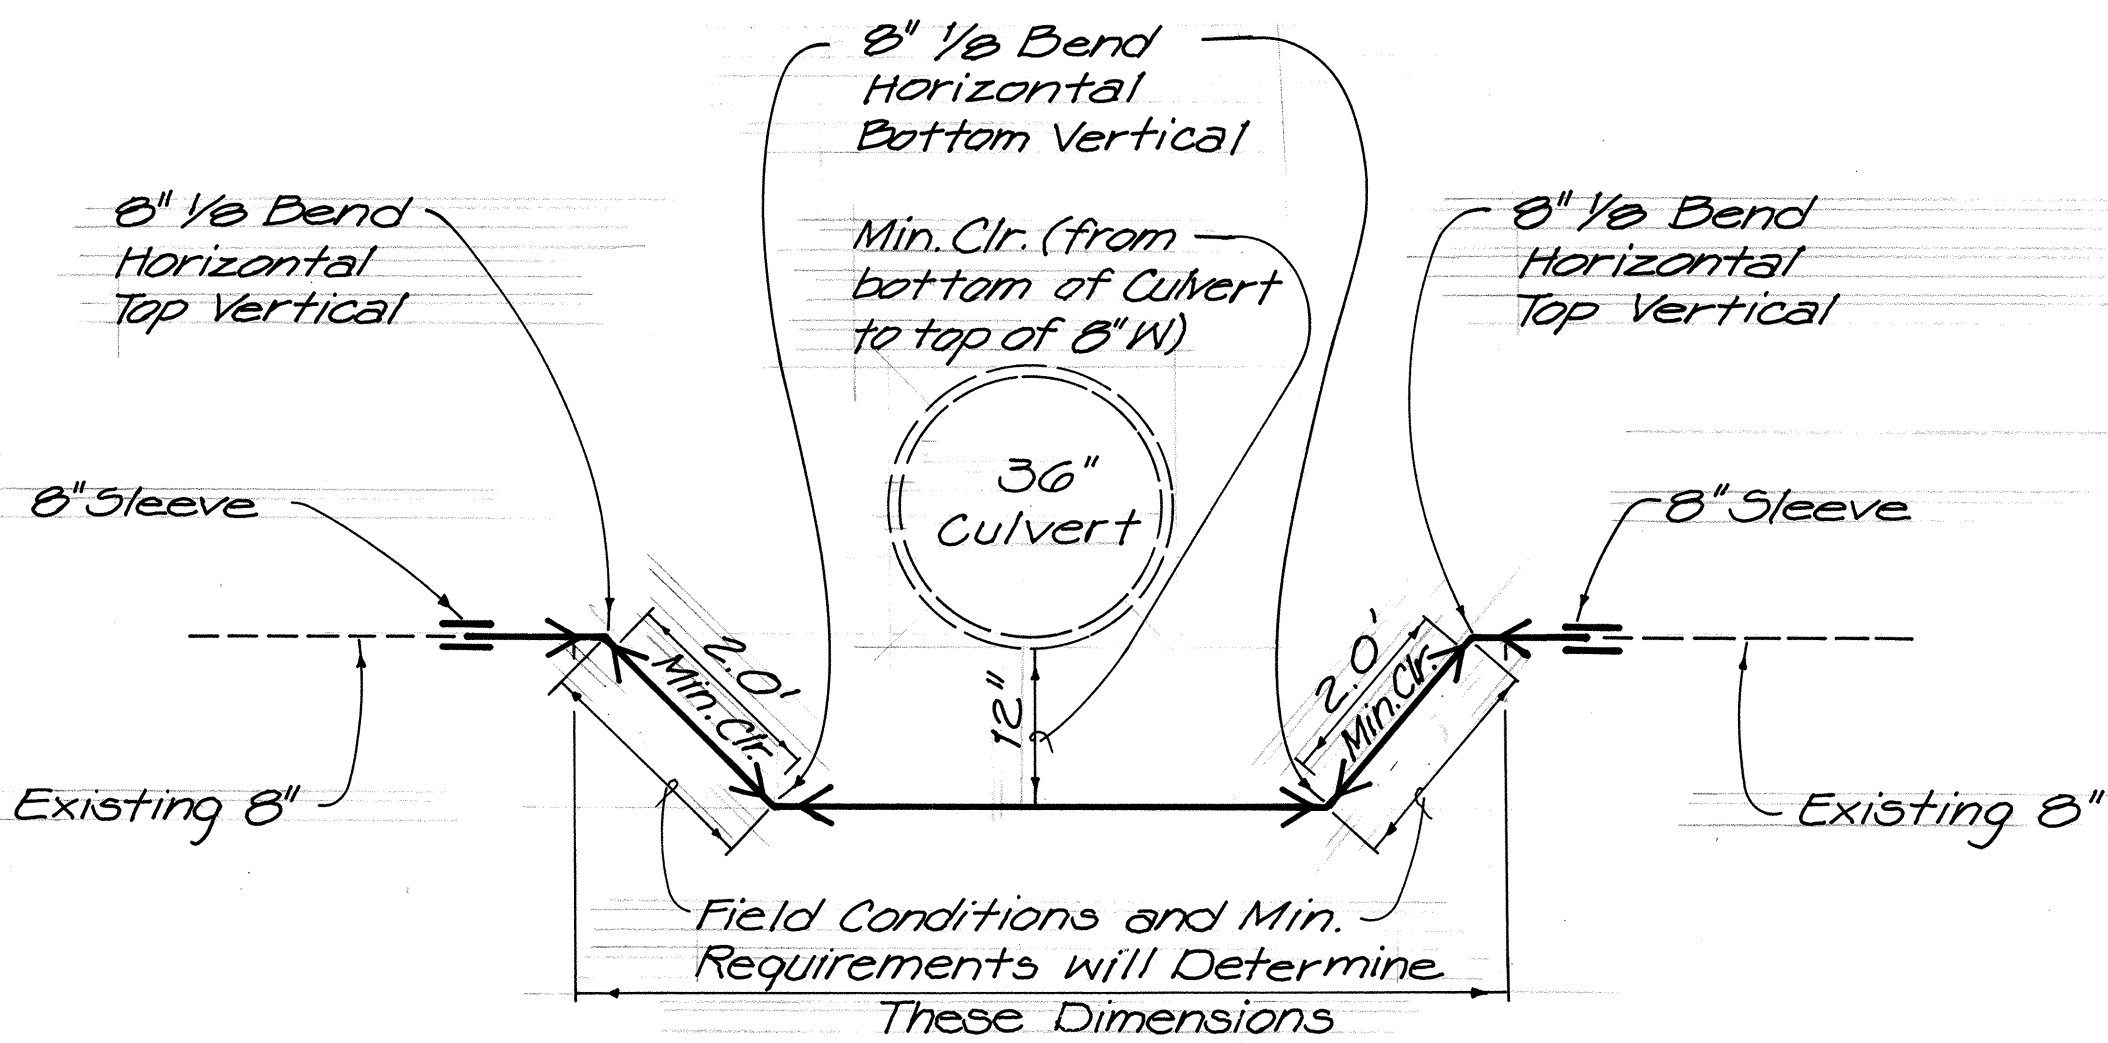

Sta. 124+13 ± Rt.
ADJUST EXISTING 8" WATER
2 - 8" 1/2 D.I. Bends (Horizontal
Bottom Vertical)
2 - Conc. Blks.
MATERIALS FOR CONNECTION
2 - 8" 1/2 D.I. Bends (Horizontal
Top Vertical)
16 - L.F. 8" D.I. PIPE, CL. 52
2 - 8" Sleeves, 12" Long
2 - Conc. Blks. w/ Structural Struts

SCHEMATIC PLAN VIEW

Not to Scale

FED. ROAD DIST. NO.	STATE	FED. AID PROJ. NO.	FISCAL YEAR	SHEET NO.	TOTAL SHEETS
HAWAII	HAW.	1101A-02-87	1987		

ORIGINAL PLAN	SURVEY PLOTTED BY	DATE
NOTE BOOK	DRAWN BY	
	TRACED BY	
	DESIGNED BY	
	QUANTITIES BY	
	CHECKED BY	

APPROVED: Date 12-1-87
R. Nagata
Chief, Planning & Engineering, BWS

STATE OF HAWAII DEPARTMENT OF TRANSPORTATION HIGHWAYS DIVISION	
WATER NOTES SCHEMATIC PLAN VIEW FARRINGTON HIGHWAY DRAINAGE IMPROVEMENTS Vicinity of Kapakahi Stream Project No. 7101A-02-87 Scale: As Noted Date: Nov. 1987	
SHEET No.	OF SHEETS