

*

INDEX TO DRAWINGS	
SHEET NO.	DESCRIPTION
1	TITLE SHEET
2	STANDARD PLANS SUMMARY
3	DRAINAGE PLAN
4 - 8	DRAINAGE DETAILS

* 75-1, C.O.85-1 are supplement sheets to the contract plans. New Total = 10 sheets

STATE OF HAWAII
DEPARTMENT OF TRANSPORTATION
HIGHWAYS DIVISION

HONOLULU, HAWAII



"AS-BUILT"
PLANS FOR

FARRINGTON HIGHWAY DRAINAGE IMPROVEMENT

VICINITY OF KAPAKAHI STREAM

PROJECT NO. 7101A-02-87

T.M.K.: 9-4:19 & 20
DISTRICT OF EWA
ISLAND OF OAHU

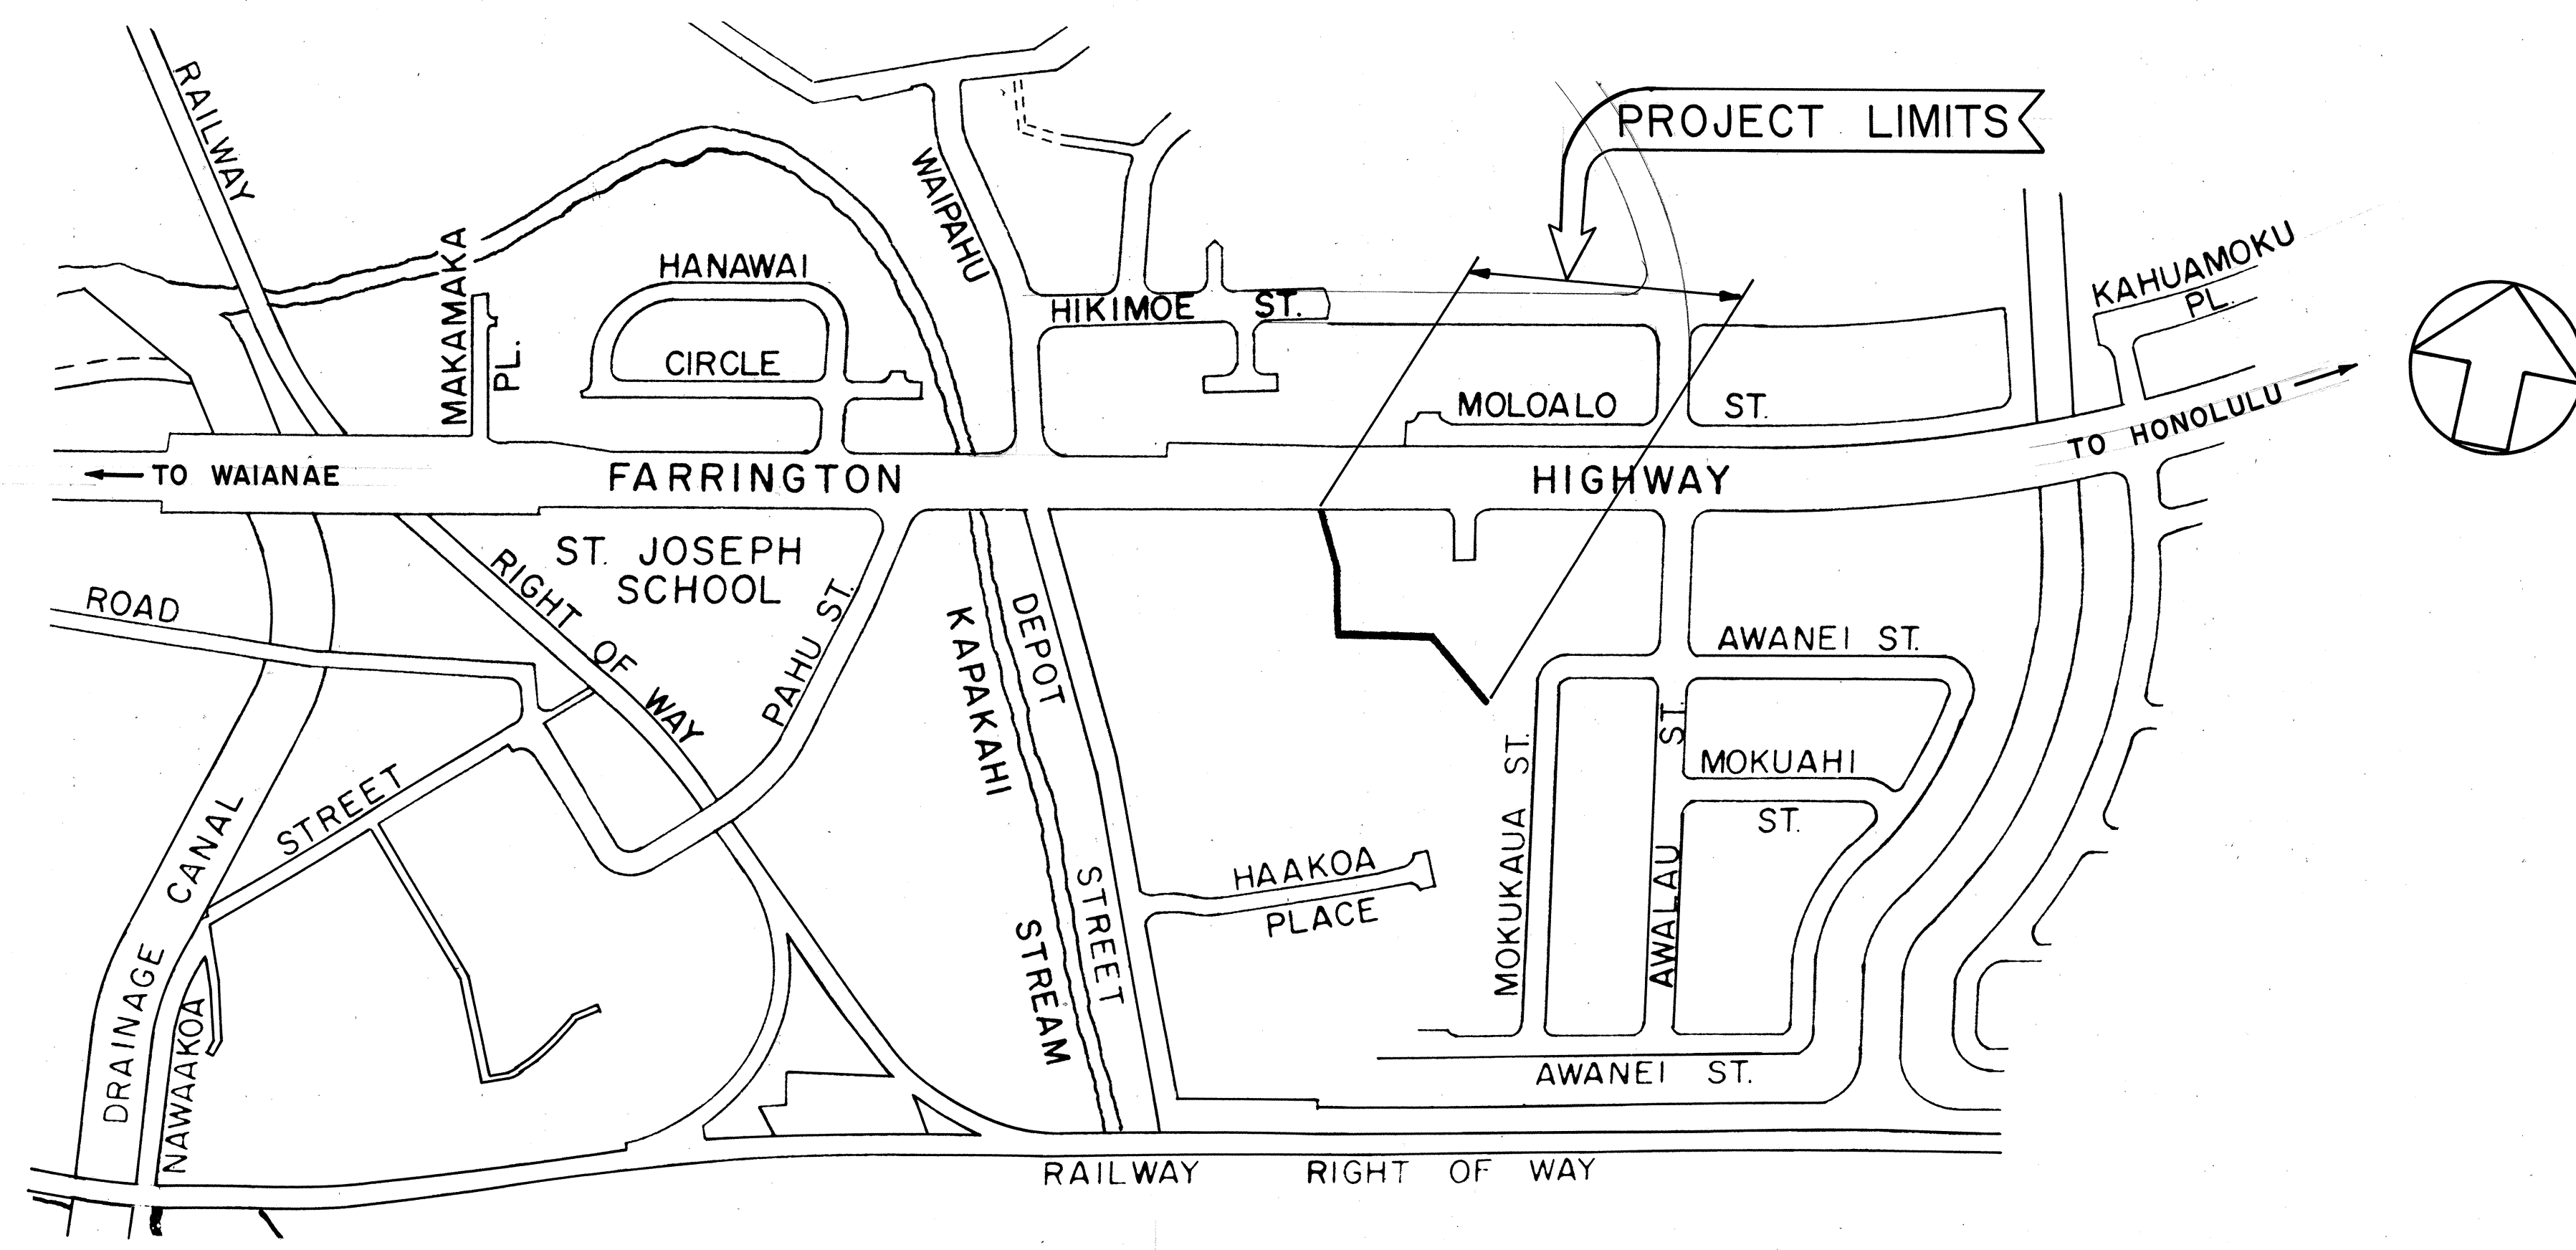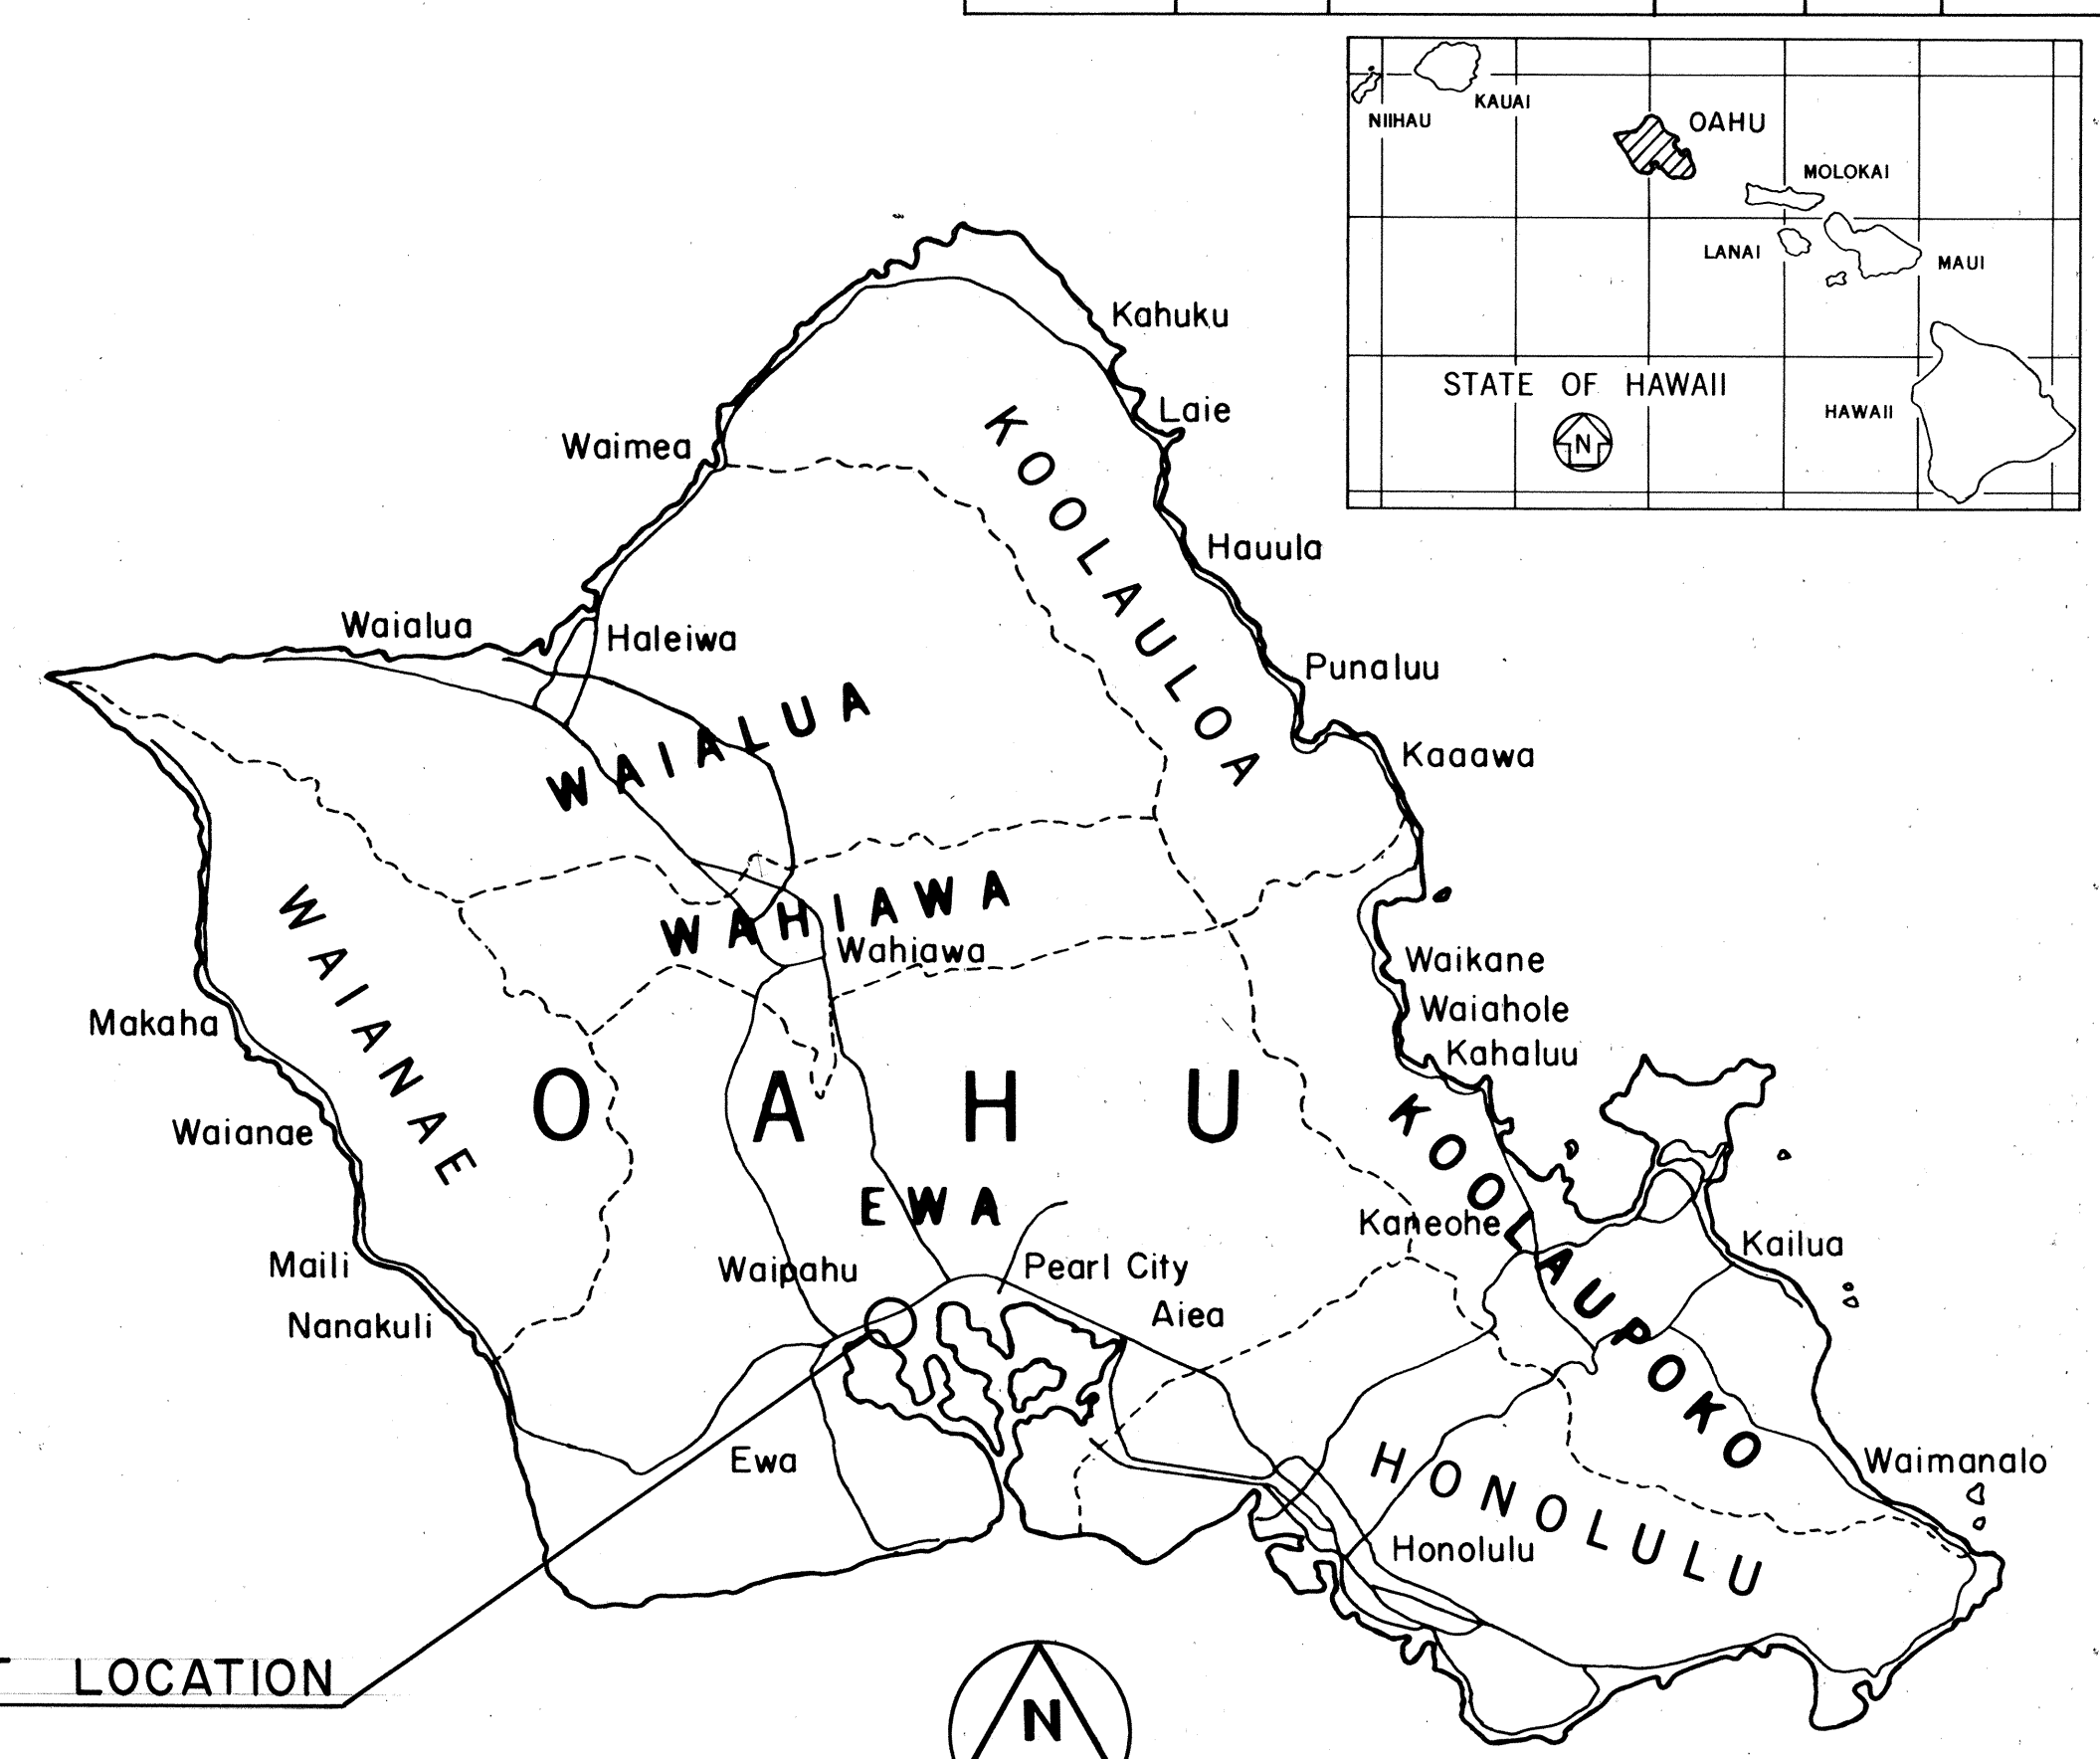

LAYOUT PLAN

CHANGES MADE DURING CONSTRUCTION HAVE BEEN INCORPORATED ON THESE PLANS EXCEPT CHANGES IN THE ORIGINAL THEORETICAL QUANTITIES. FOR ACTUAL QUANTITIES, REFER TO PROJECT LEDGER AND/OR COMPUTATION BOOK.

Michael Dineen
RESIDENT ENGINEER
2/10/89
DATE

DEPARTMENT OF TRANSPORTATION STATE OF HAWAII	
APPROVED:	
<i>[Signature]</i>	6/1/89
For DIR. OF TRANSPORTATION	DATE

HWY - DH
DESIGNED BY
A. YAMAGUCHI
P. S. & E. BY
548 - 4125
PHONE
OCT. 1986
DATE

DD-D-8-10

D-8-10