


FED. ROAD DIST. NO.	STATE	PROJ. NO.	FISCAL YEAR	SHEET NO.	TOTAL SHEETS
HAWAII	HAW.	7101A-03-89	1990	5	15

Note:
Payment for all signs shall be incidental to the various contract items.

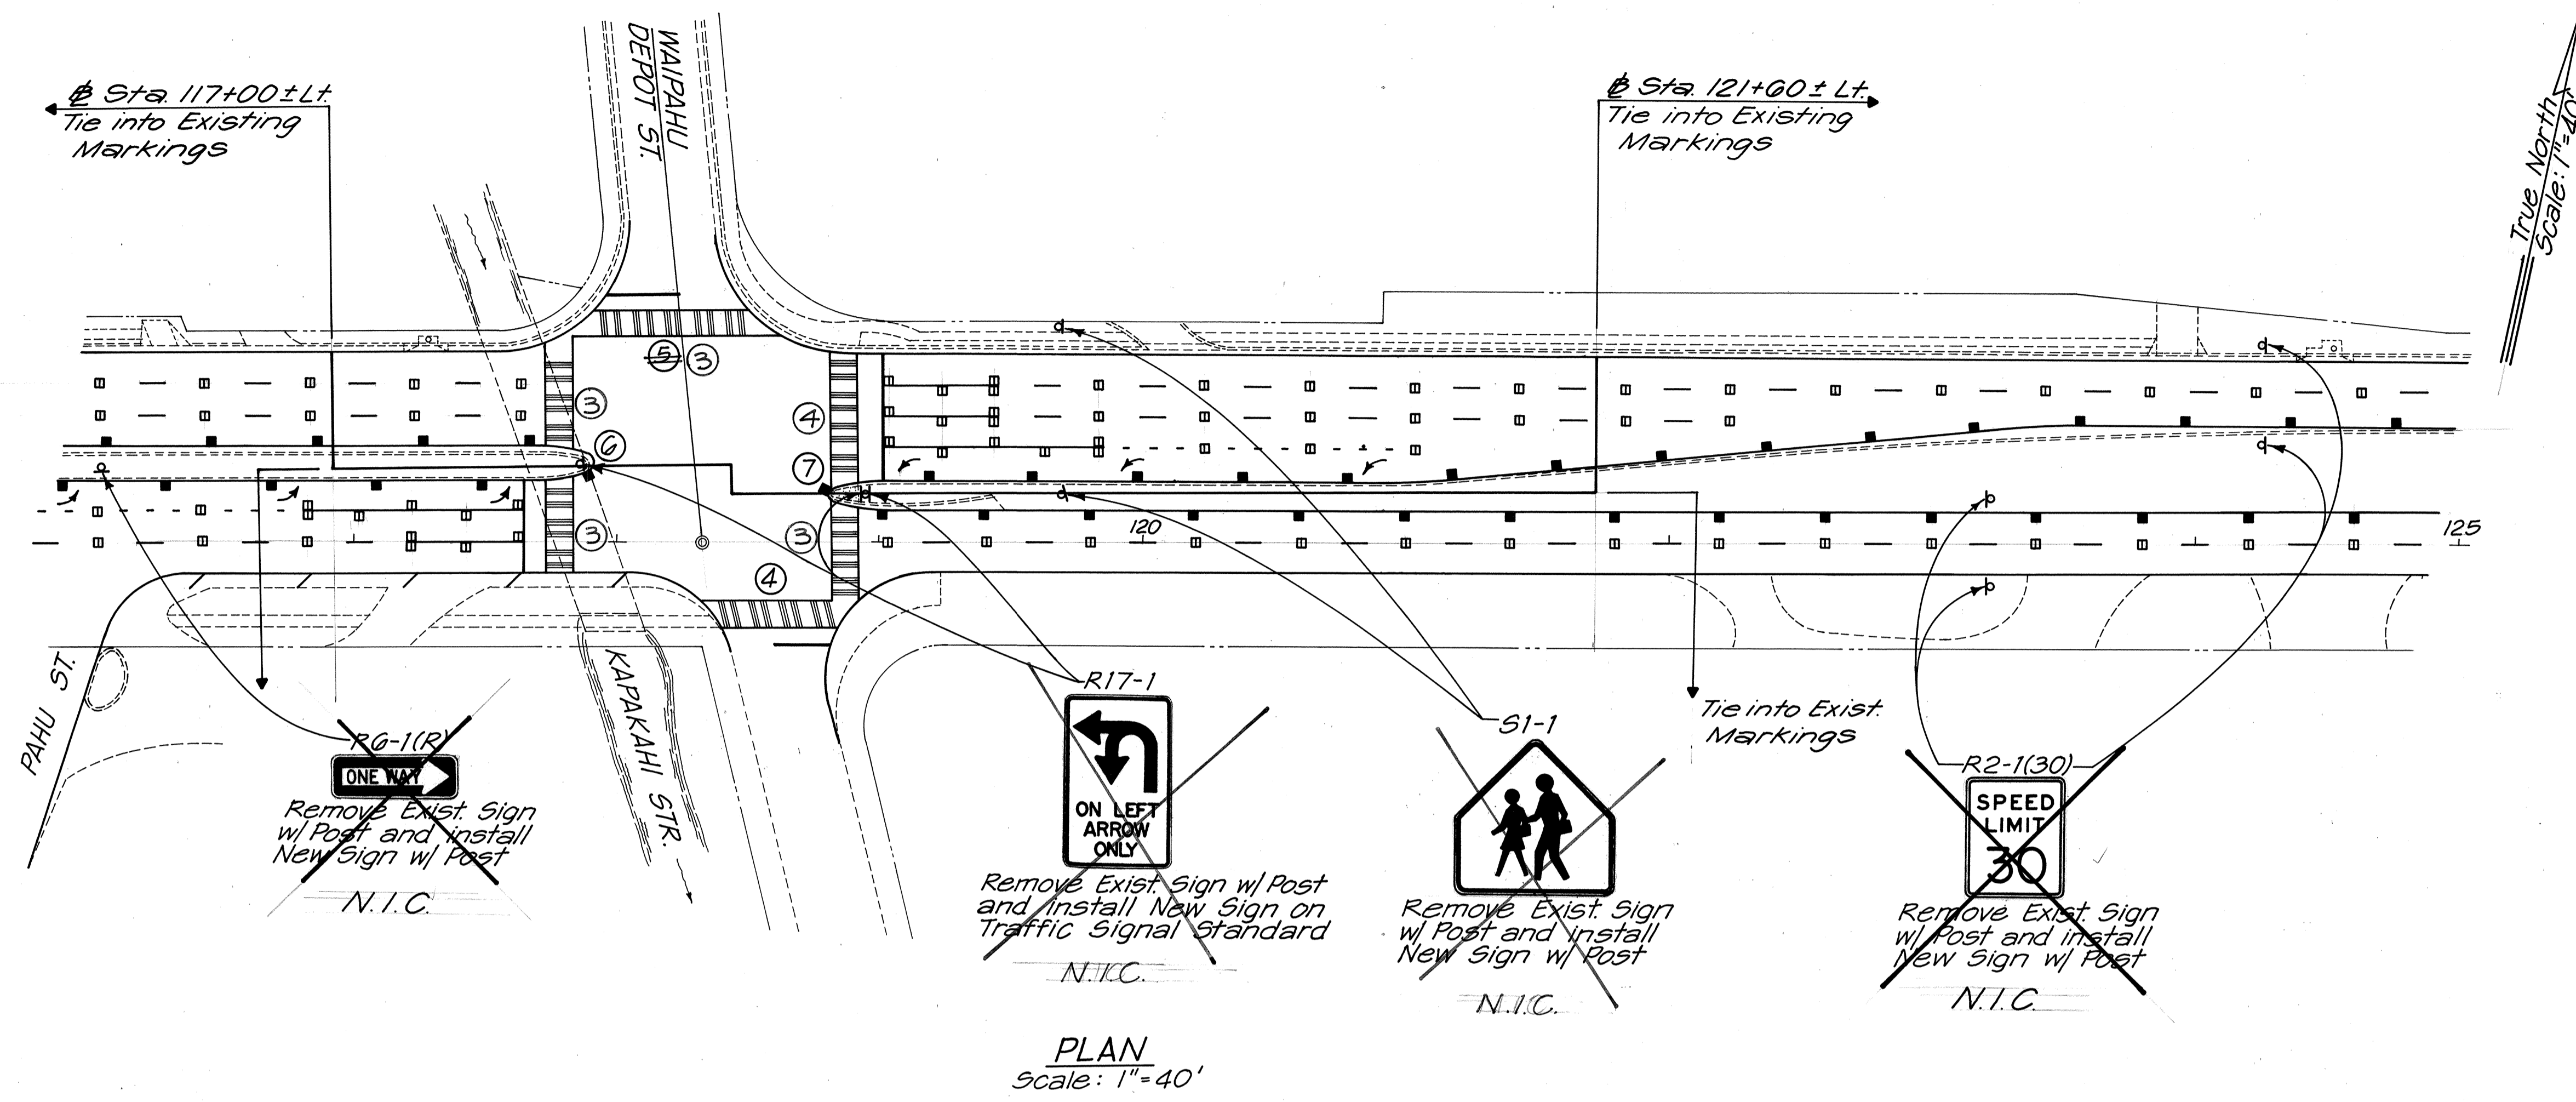

PLAN
Scale: 1"=40'

ORIGINAL PLAN	DATE
DRAWN BY	
DESIGNED BY	
QUANTITIES BY	
CHECKED BY	
NO.	

STATE OF HAWAII
DEPARTMENT OF TRANSPORTATION
HIGHWAYS DIVISION
**SIGNING & PAVEMENT
MARKING PLAN**

FARRINGTON HIGHWAY
DRAINAGE IMPROVEMENTS
Vicinity of Kapakahi Stream, Phase II
Proj. No. 7101A-03-89
Scale: As Shown Date: July 1989
SHEET No. 1 OF 1 SHEETS