	,
	INDEX TO DRAWINGS
SHEET NO.	DESCRIPTION
l	TITLE SHEET
2	STANDARD PLANS SUMMARY
3	PLAN, TYPICAL SECTION AND
·	GENERAL NOTES
4	TRAFFIC NOTES, LEGEND AND
	DETAIL
5	SIGNING AND PAVEMENT
	MARKING PLAN
6	DRAINAGE PLAN
7 - 15	DRAINAGE DETAILS
	·
	, '
	1
·	

PLAN SHEETS 12-15 DELETED FROM CONTRACT PER C.O. NO. I.

NEW PLAN SHT. TOTAL = II SHTS.

STATE OF HAWAII

DEPARTMENT OF TRANSPORTATION HIGHWAYS DIVISION

HONOLULU, HAWAII


"AS-BUILT"
PLANS FOR

FARRINGTON HIGHWAY DRAINAGE IMPROVEMENT


VICINITY OF KAPAKAHI STREAM, PHASE II

PROJECT NO. 7101A-03-89

T.M.K.: 9-4:14 DISTRICT OF EWA ISLAND OF OAHU

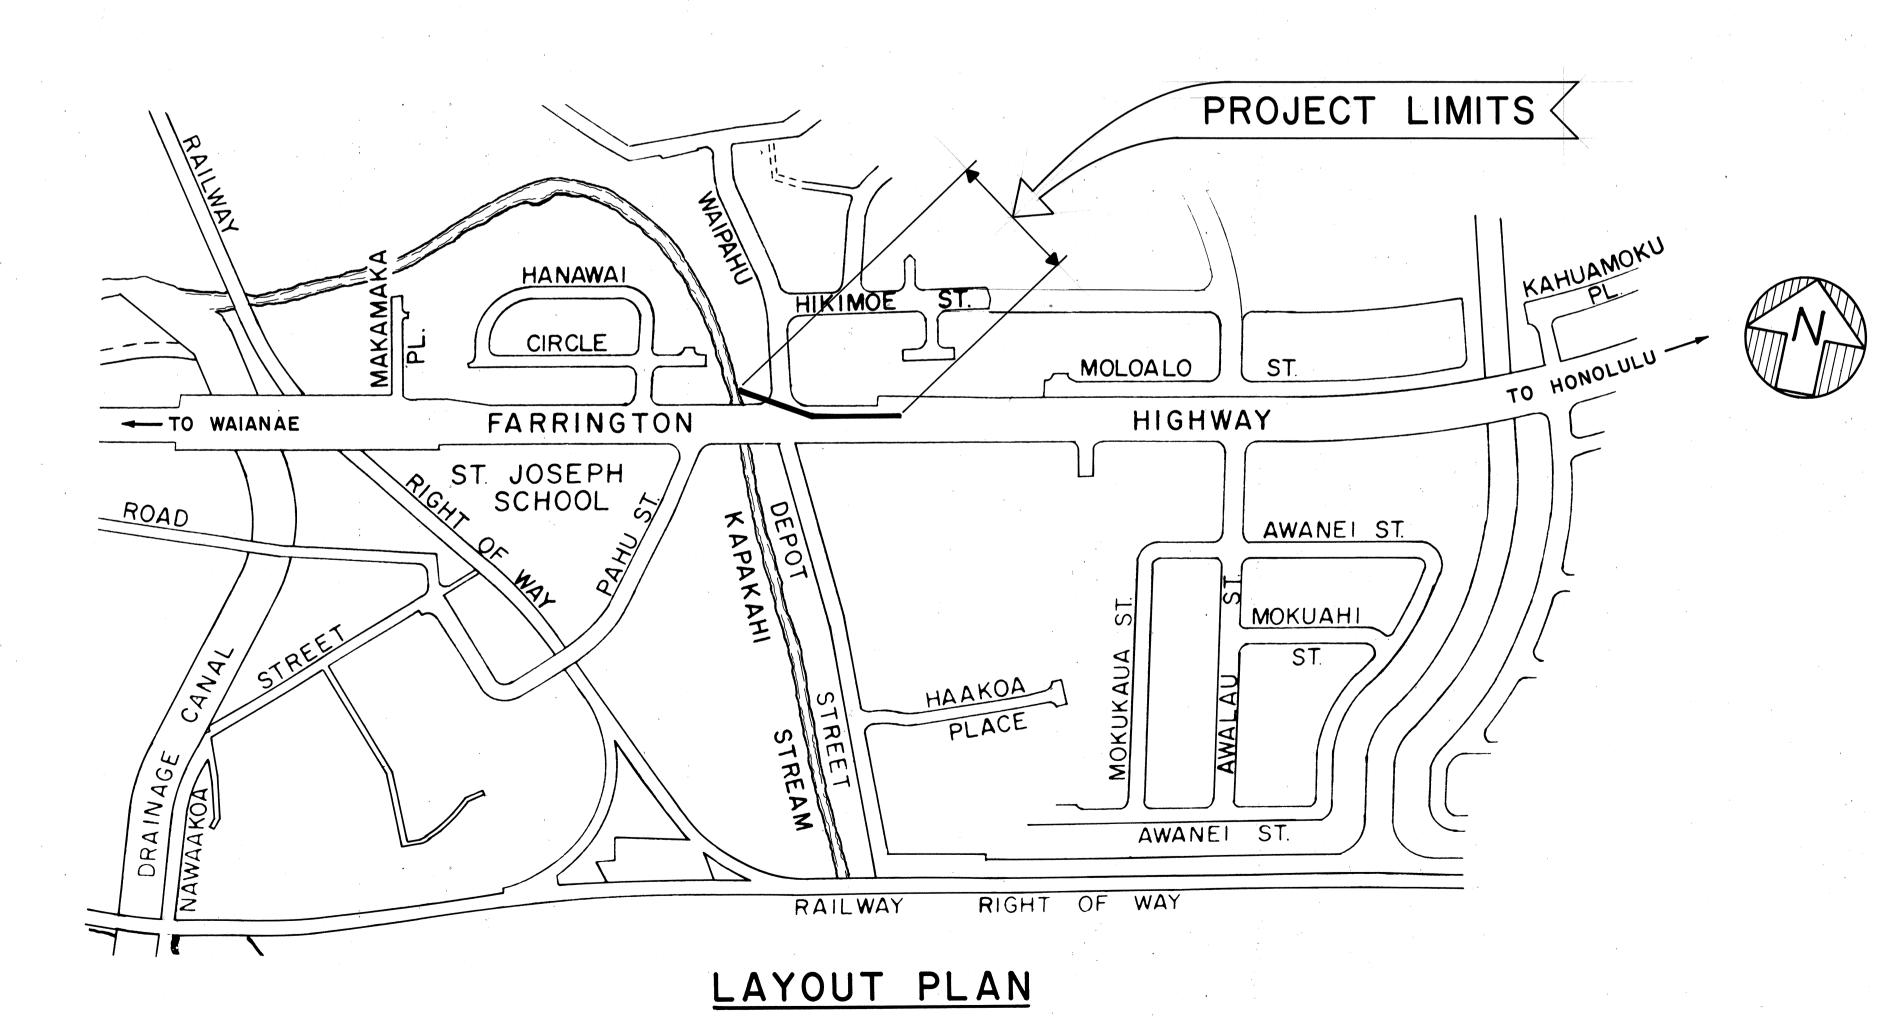

SCALE IN HUNDRED FEET

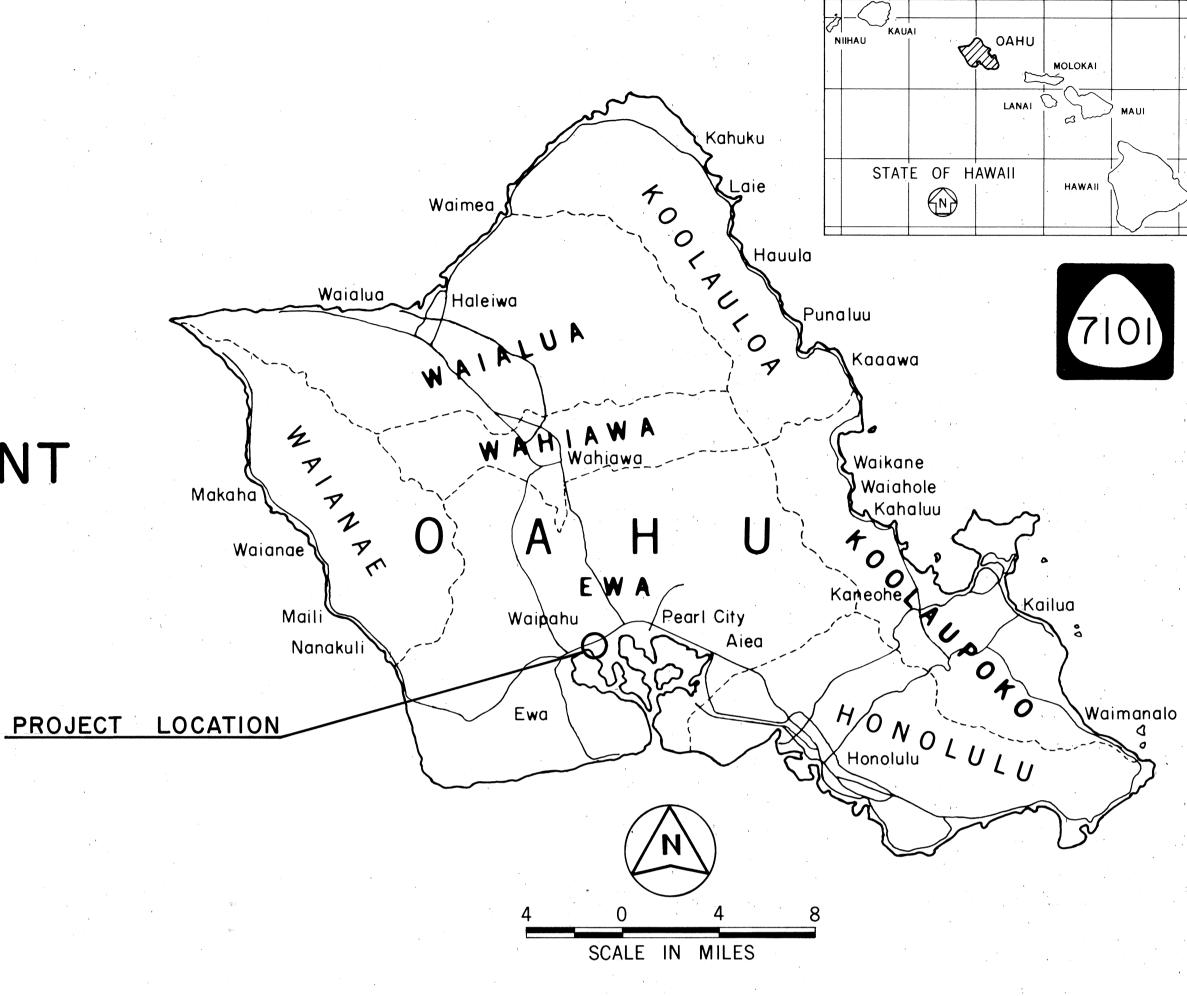

FED. ROAD DIST. NO.

STATE

HAW.

PROJ. NO.

71014-03-89

MILE POST 1.49 TO MILE POST 1.56

CHANGES MADE DURING CONSTRUCTION HAVE
BEEN INCORPORATED ON THESE PLANS EXCEPT
CHANGES IN THE ORIGINAL THEORETICAL
QUANTITIES. FOR ACTUAL QUANTITIES, REFER TO
PROJECT LEDGER AND/OR COMPUTATION BOOK.

Michael Diniegas RESIDENT ENGINEER

12/19/9/ DATE

DEPARTMENT OF TRANSPORTATION
STATE OF HAWAII

APPROVED:

Line 1/2/29
DIR. OF TRANSPORTATION DATE

FISCAL SHEET TOTAL YEAR NO. SHEETS

1990

01-8-0-00

548-7534 PHONE

YAMAGUCHI

HWY - DH DESIGNED BY