


FED. ROAD DIST. NO.	STATE	PROJ. NO.	FISCAL YEAR	SHEET NO.	TOTAL SHEETS
HAWAII	HAW.	7101A-01-88	1990	4	9

WHEELCHAIR RAMP SCHEDULE		
LOCATION	TYPE	QUANTITY
Sta. 149+40± Rt.	A	1
Sta. 150+05± Rt.	A	1
Sta. 162+60± Rt.	A	1
Sta. 162+72± Rt.	A	DELETED
Sta. 162+90± Rt.	A	DELETED
Sta. 163+00± Rt.	A	DELETED
Sta. 163+20± Rt.	C	(EXISTING)

CURVE DATA		
	①	②
Δ	74°00'00"	46°00'00"
R	50.00'	100.00'
T	37.68'	42.45'
L	74.58'	80.29'
C	60.18'	78.15'

True North
Scale: 1"=40'

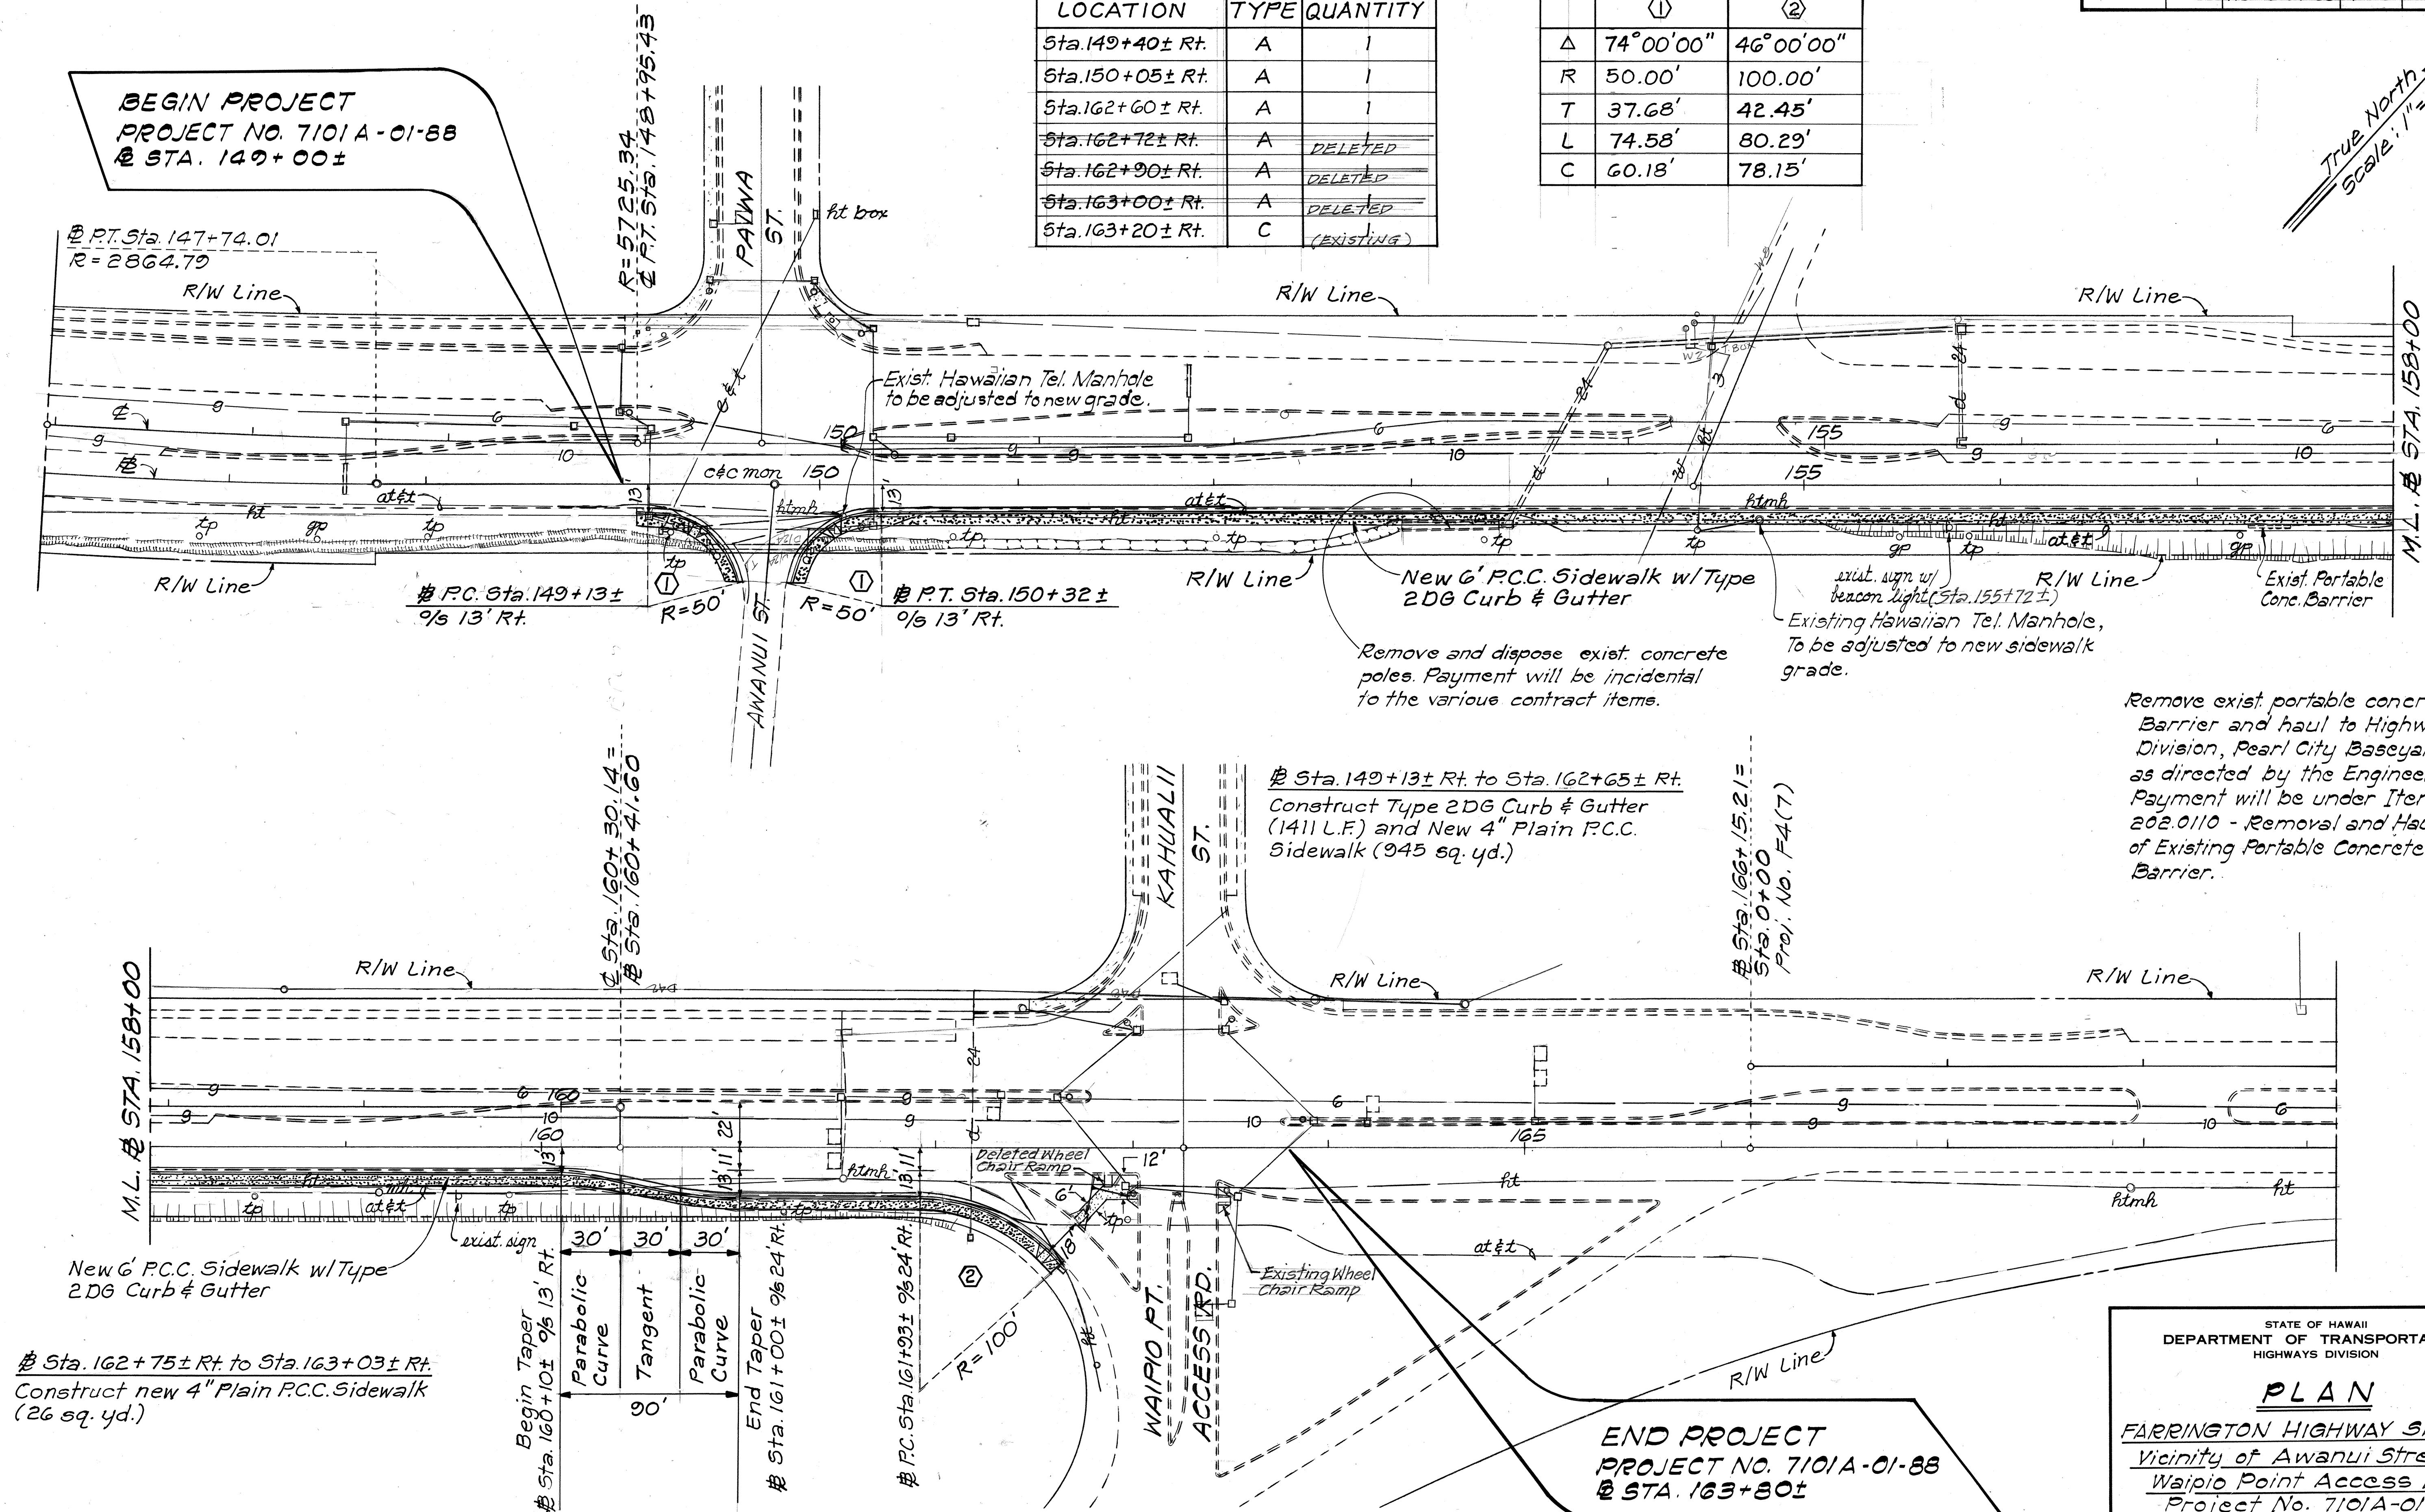

ORIGINAL PLAN	DATE
SURVEY PLOTTED BY	
DESIGNED BY	
QUANTITIES BY	
CHECKED BY	
NO.	

STATE OF HAWAII
DEPARTMENT OF TRANSPORTATION
HIGHWAYS DIVISION

PLAN

FARRINGTON HIGHWAY SIDEWALK
Vicinity of Awanui Street to
Waipio Point Access Road
Project No. 7101A-01-88
Scale: 1"=40' Date: Feb. 1989

SHEET NO. 1 OF 1 SHEETS