	INDEX TO DRAWINGS
SHEET NO.	DESCRIPTION
l	TITLE SHEET
2	STANDARD PLANS SUMMARY
3	TYPICAL SECTIONS & GEN. NOTES
4	PLAN
5-8	DRAINAGE PLAN AND DETAILS
9	TRAFFIC SIGNAL PLAN, LEGEND AND NOTES
	· · ·

DESIGN UNIT DESIGNED BY

STATE OF HAWAII

DEPARTMENT OF TRANSPORTATION


HIGHWAYS DIVISION HONOLULU, HAWAII


"AS BUILT"
PLANS FOR

FARRINGTON HIGHWAY SIDEWALK VICINITY OF AWANUI ST. TO WAIPIO POINT ACCESS RD.

PROJECT NO. 7101A - 01 - 88

DISTRICT OF EWA ISLAND OF OAHU

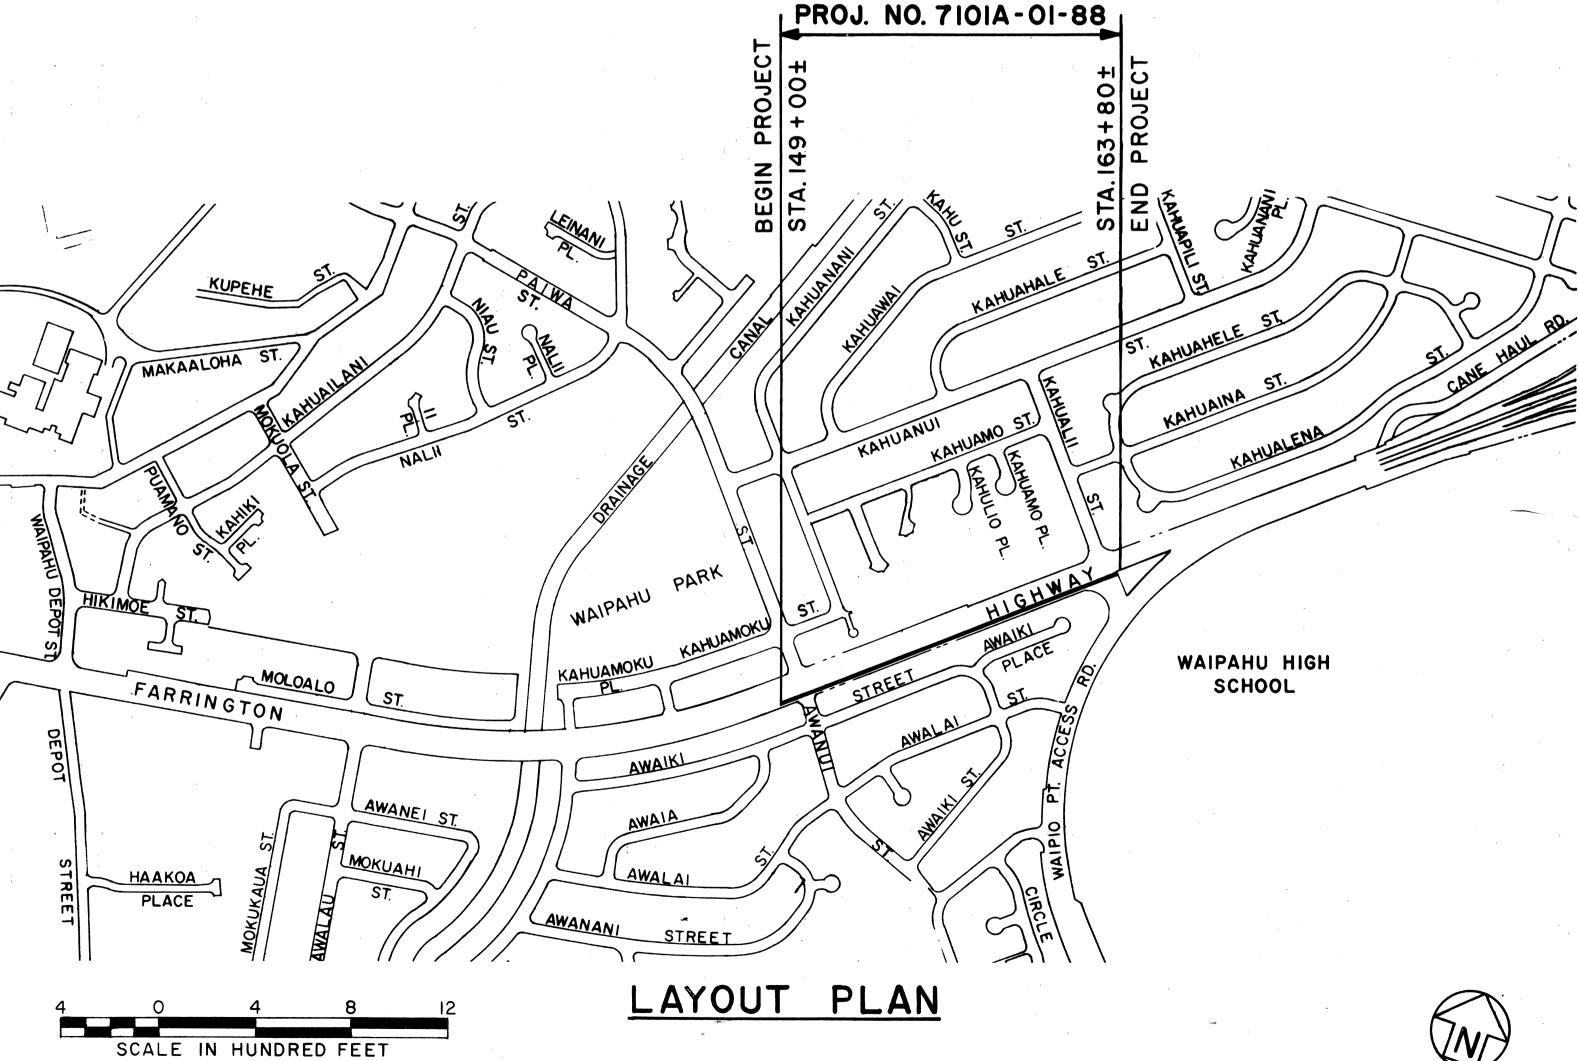

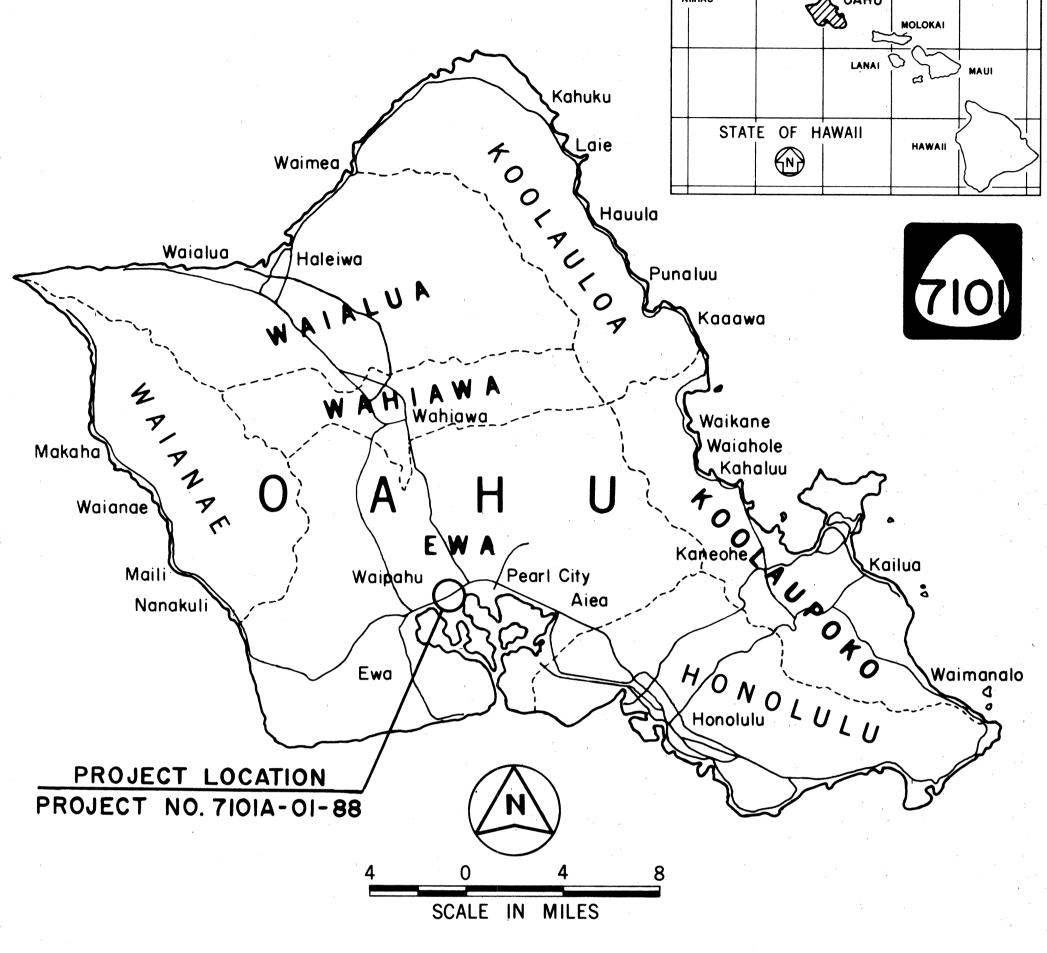

MILE POST 1.99 TO MILE POST 2.27

FED. ROAD DIST. NO.

STATE

PROJ. NO.

710IA-01-88

CHANGES MADE DURING CONSTRUCTION HAVE BEEN INCORPORATED ON THESE PLANS EXCEPT CHANGES IN THE ORIGINAL THEORETICAL QUANTITIES. FOR ACTUAL QUANTITIES, REFER TO PROJECT LEDGER AND/OR COMPUTATION BOOK.

Mohn Dinige RESIDENT ENGINEER

//3/92 DATE

FISCAL SHEET TOTAL YEAR NO. SHEETS

DEPARTMENT OF TRANSPORTATION
STATE OF HAWAII

APPROVED:

Line 1/9/90
DIR. OF TRANSPORTATION

DATE