


FED. ROAD DIST. NO.	STATE	PROJ. NO.	FISCAL YEAR	SHEET NO.	TOTAL SHEETS
HAWAII	HAW.	7101A-02-97	1998	19	102

BEGIN PROJECT
Project No. 7107A-02-97
Sta. 56+45±

Sta. 56+47± Rt. & Sta. 56+97± Rt.
Reconstruct two Traffic Islands.
For Details, see Plan Sht. No. ADD.10.

Sta. 63+00± Lt.
Relocate existing fire hydrant.
For details, see Plan Sheet No. C.O.18S-1.

Sta. 59+85± Lt. to Sta. 63+17± Lt.
Construct 6.0' wide Reinforced Concrete
Sidewalk and Curb & Gutter, Type 2DG.

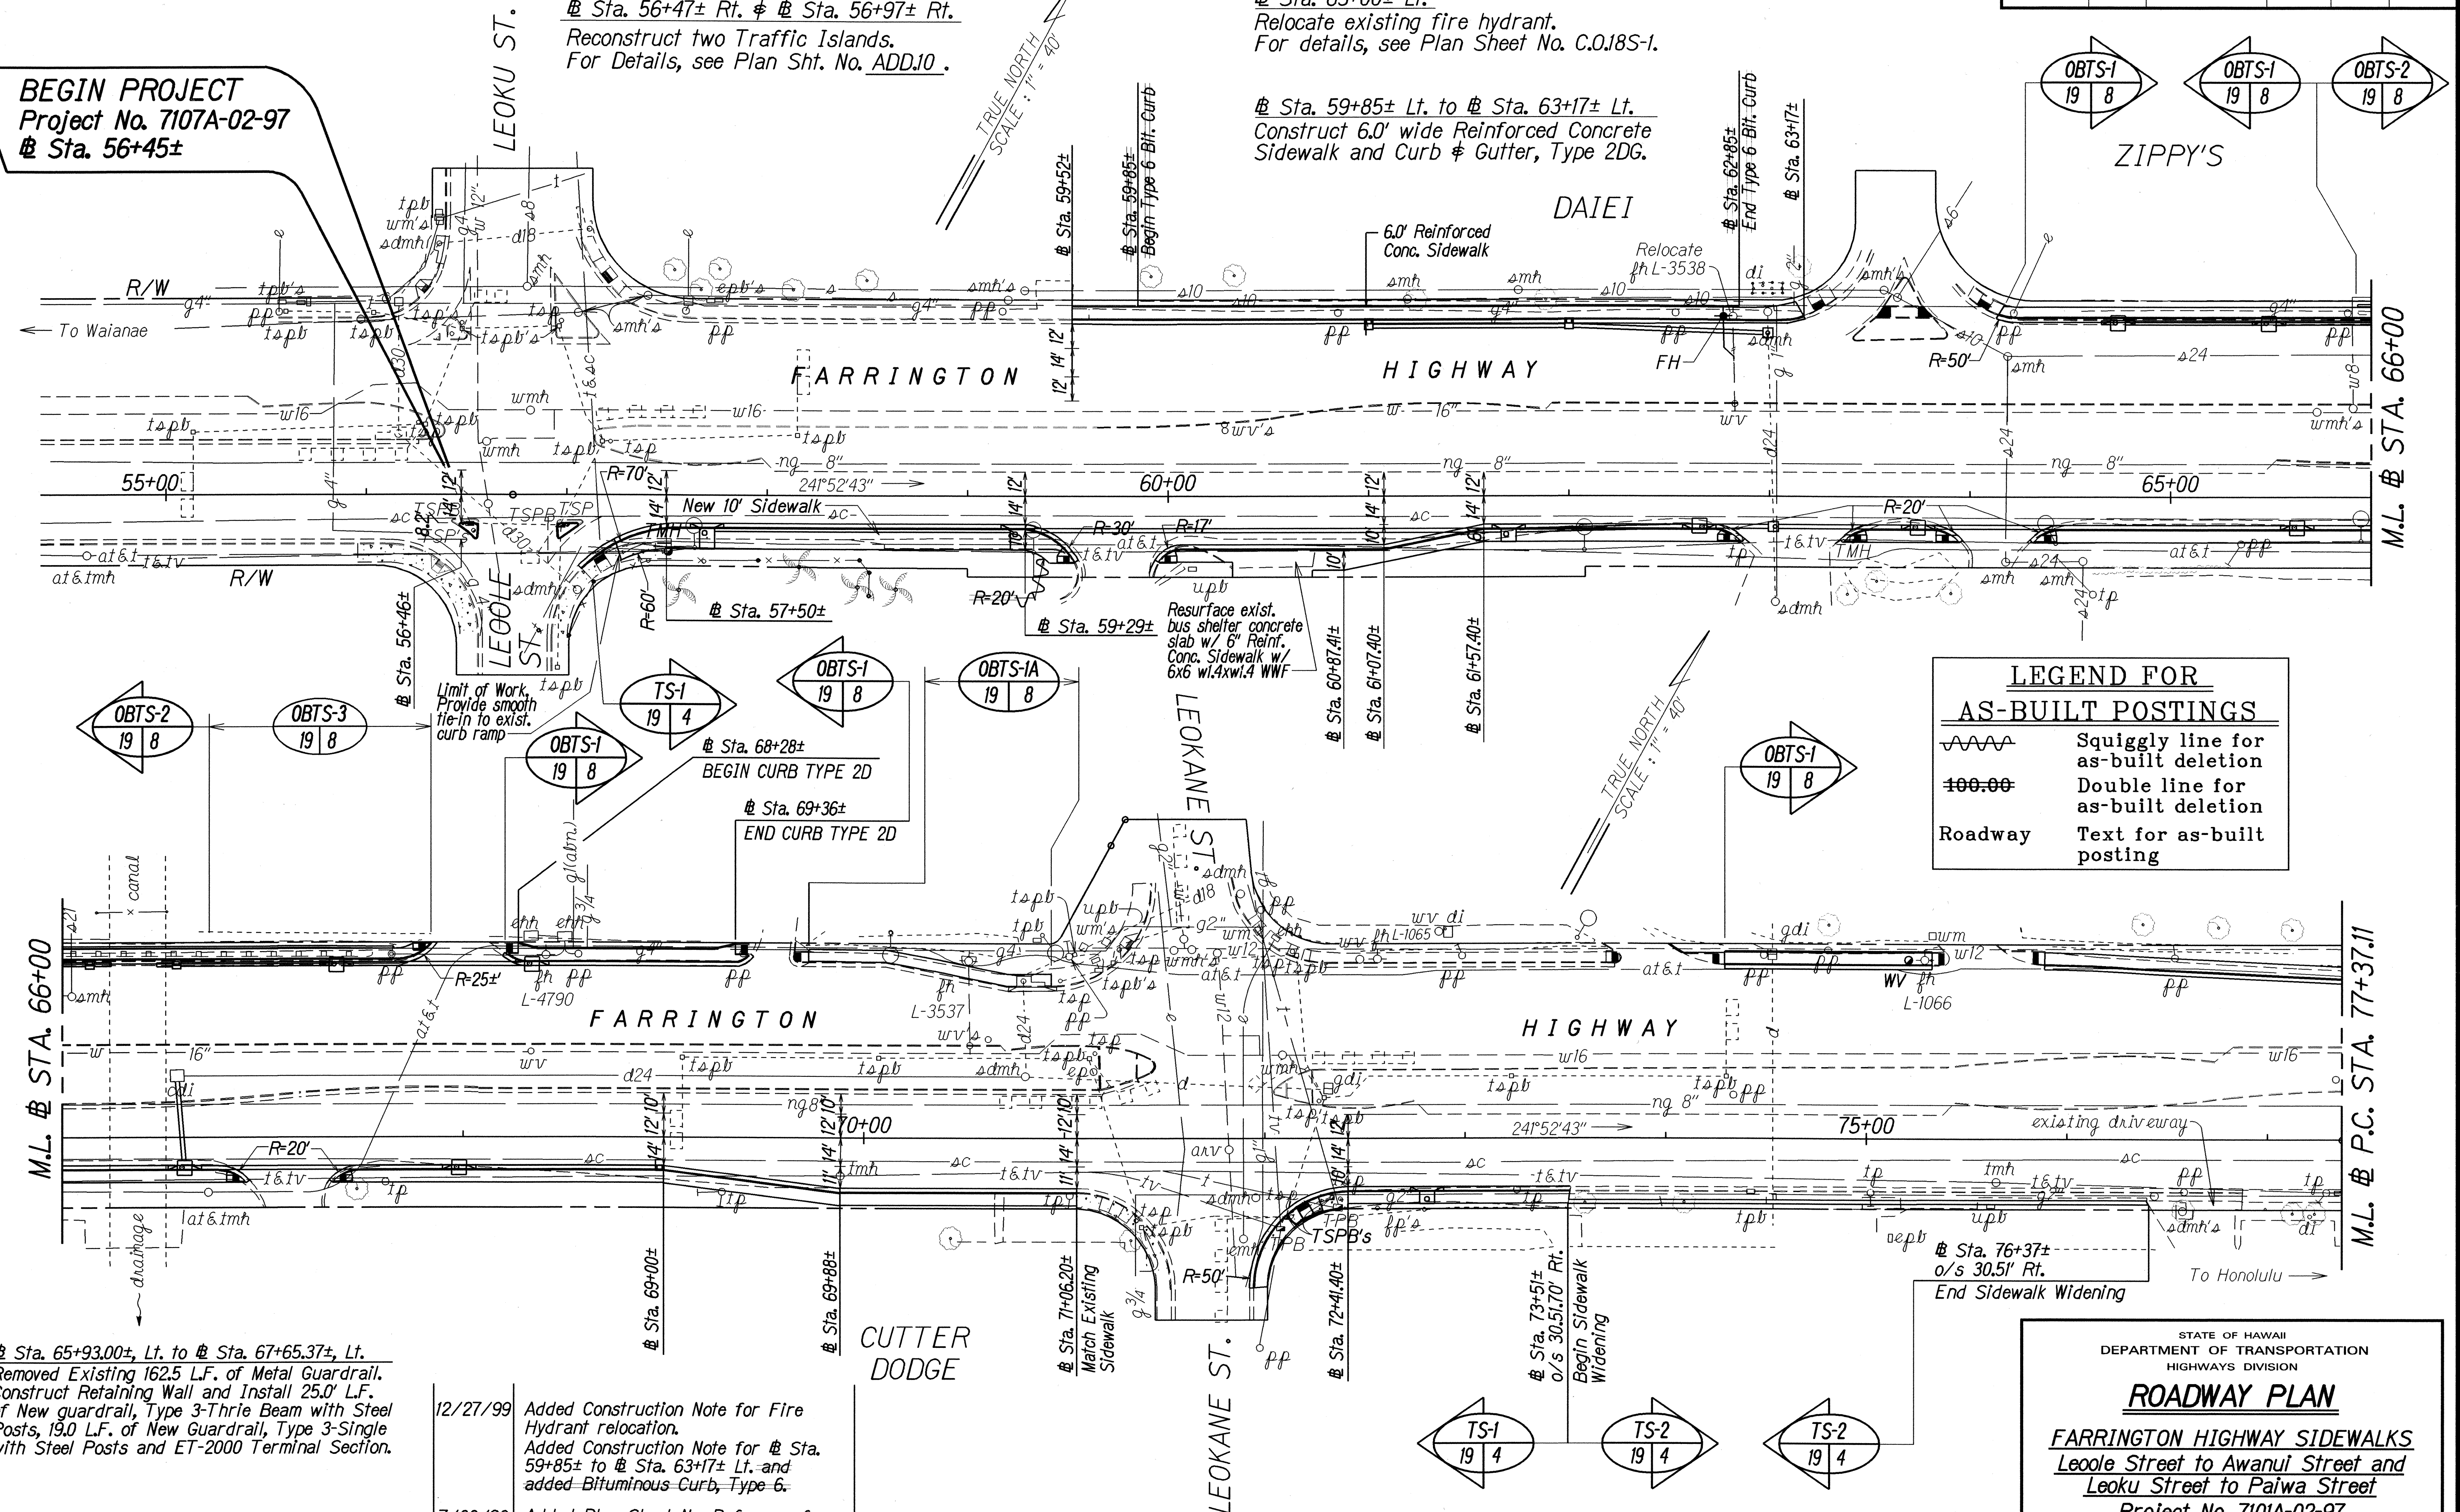

Sta. 65+93.00± Lt. to Sta. 67+65.37± Lt.
Removed Existing 1625 L.F. of Metal Guardrail.
Construct Retaining Wall and Install 25.0' L.F.
of New guardrail, Type 3-Thrie Beam with Steel
Posts, 19.0 L.F. of New Guardrail, Type 3-Single
with Steel Posts and ET-2000 Terminal Section.

Sta. 76+37±
o/s 30.51' Rt.
End Sidewalk Widening

STATE OF HAWAII
DEPARTMENT OF TRANSPORTATION
HIGHWAYS DIVISION
ROADWAY PLAN
FARRINGTON HIGHWAY SIDEWALKS
Leoke Street to Awanui Street and
Leoku Street to Paikua Street
Project No. 7101A-02-97
Scale: 1"=40.0' Date: May 1998
SHEET No. 1 OF 5 SHEETS

"AS-BUILT"

C.O. 19R

FED. ROAD DIST. NO.	STATE	PROJ. NO.	FISCAL YEAR	SHEET NO.	TOTAL SHEETS
HAWAII	HAW.	7101A-02-97	1998	20	102

LEGEND FOR AS-BUILT POSTINGS

~~~~~ Squiggly line for as-built deletion

== Double line for as-built deletion

Roadway Text for as-built posting

**CURVE DATA:**


$\Delta = 17^{\circ}30'00''$

$R = 6,875.50'$

$T = 1,058.24'$

$C = 2,091.85'$

$L_c = 2,100.00'$

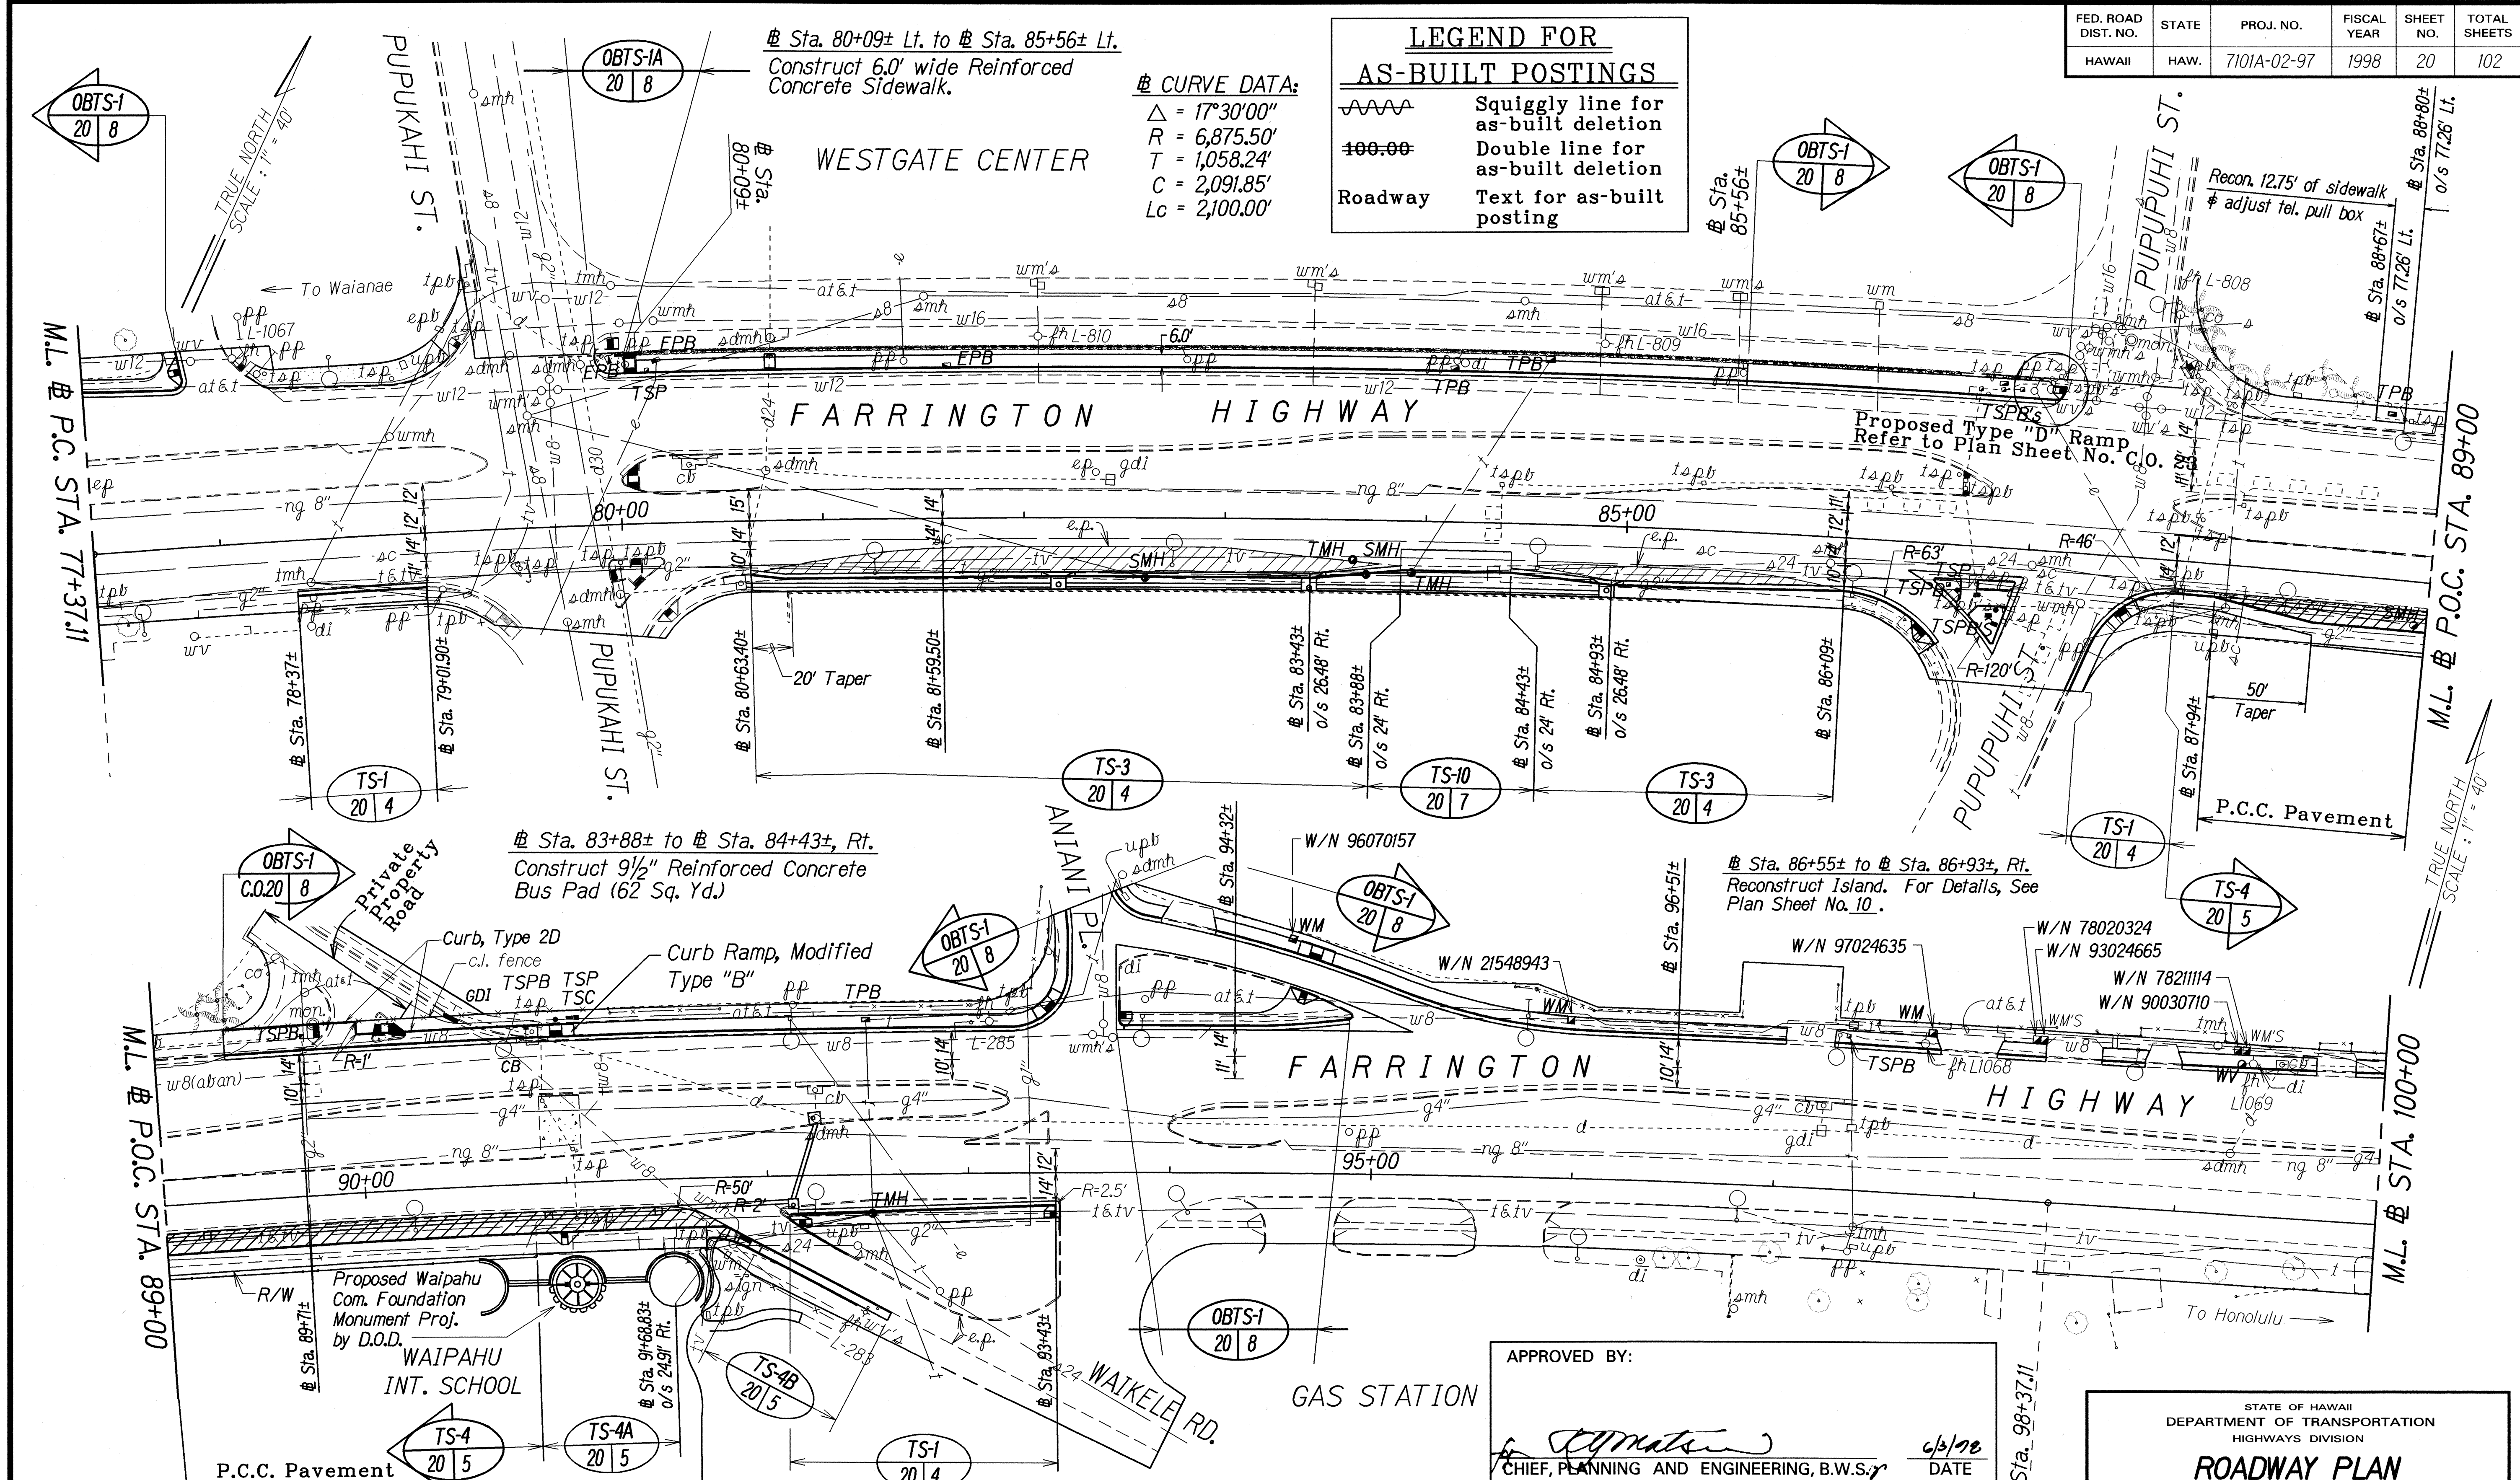

| DATE     | REVISION                                                                                                                                                                                       |
|----------|------------------------------------------------------------------------------------------------------------------------------------------------------------------------------------------------|
| 11/04/99 | Added Construction Note for Sta. 80+09± to Sta. 85+56± Lt.                                                                                                                                     |
| 4/29/99  | Constructed curb, curb & gutter, sidewalk, modified curb ramp and traffic signal appurtenances across Waikale Rd. Revised outbound lanes width. Added construction note at Sta. 89+34± o/s Lt. |

**Sta. 89+34± to Sta. 90+98± o/s Lt.**  
Construct Curb Ramp, Modified Type "B", Curb, Type 2D, Curb & Gutter, Type 2DG and Reinforced Concrete sidewalk.

**Sta. 91+61± Rt.**  
Relocate exist. 8" water line. For Details, see Plan Sht. No. 18.

**Sta. 90+00± to Sta. 93+41± Rt.**  
See additional Details on Plan Sht. No. 11.

APPROVED BY:

*[Signature]* CHIEF, PLANNING AND ENGINEERING, B.W.S.r  
CITY AND COUNTY OF HONOLULU

APPROVED FOR CONSTRUCTION WITHIN  
WAIPAHU INTERMEDIATE SCHOOL:

*[Signature]* CORINNE FUJIEDA  
VICE PRINCIPAL

STATE OF HAWAII  
DEPARTMENT OF TRANSPORTATION  
HIGHWAYS DIVISION

**ROADWAY PLAN**


**FARRINGTON HIGHWAY SIDEWALKS**  
Leole Street to Awanui Street and  
Leoku Street to Paikua Street  
Project No. 7101A-02-97

Scale: 1"=40.0' Date: May 1998

SHEET No. 2 OF 5 SHEETS

|                          |                |
|--------------------------|----------------|
| ORIGINAL PLAN            | DATE: 11/04/99 |
| DESIGNED BY: B. W. S. R. |                |
| CHECKED BY: B. W. S. R.  |                |
| NOTED BY: B. W. S. R.    |                |
| DATE: 11/04/99           |                |

| FED. ROAD DIST. NO. | STATE | PROJ. NO.   | FISCAL YEAR | SHEET NO. | TOTAL SHEETS |
|---------------------|-------|-------------|-------------|-----------|--------------|
| HAWAII              | HAW.  | 7101A-02-97 | 1998        | ADD.21    | 102          |

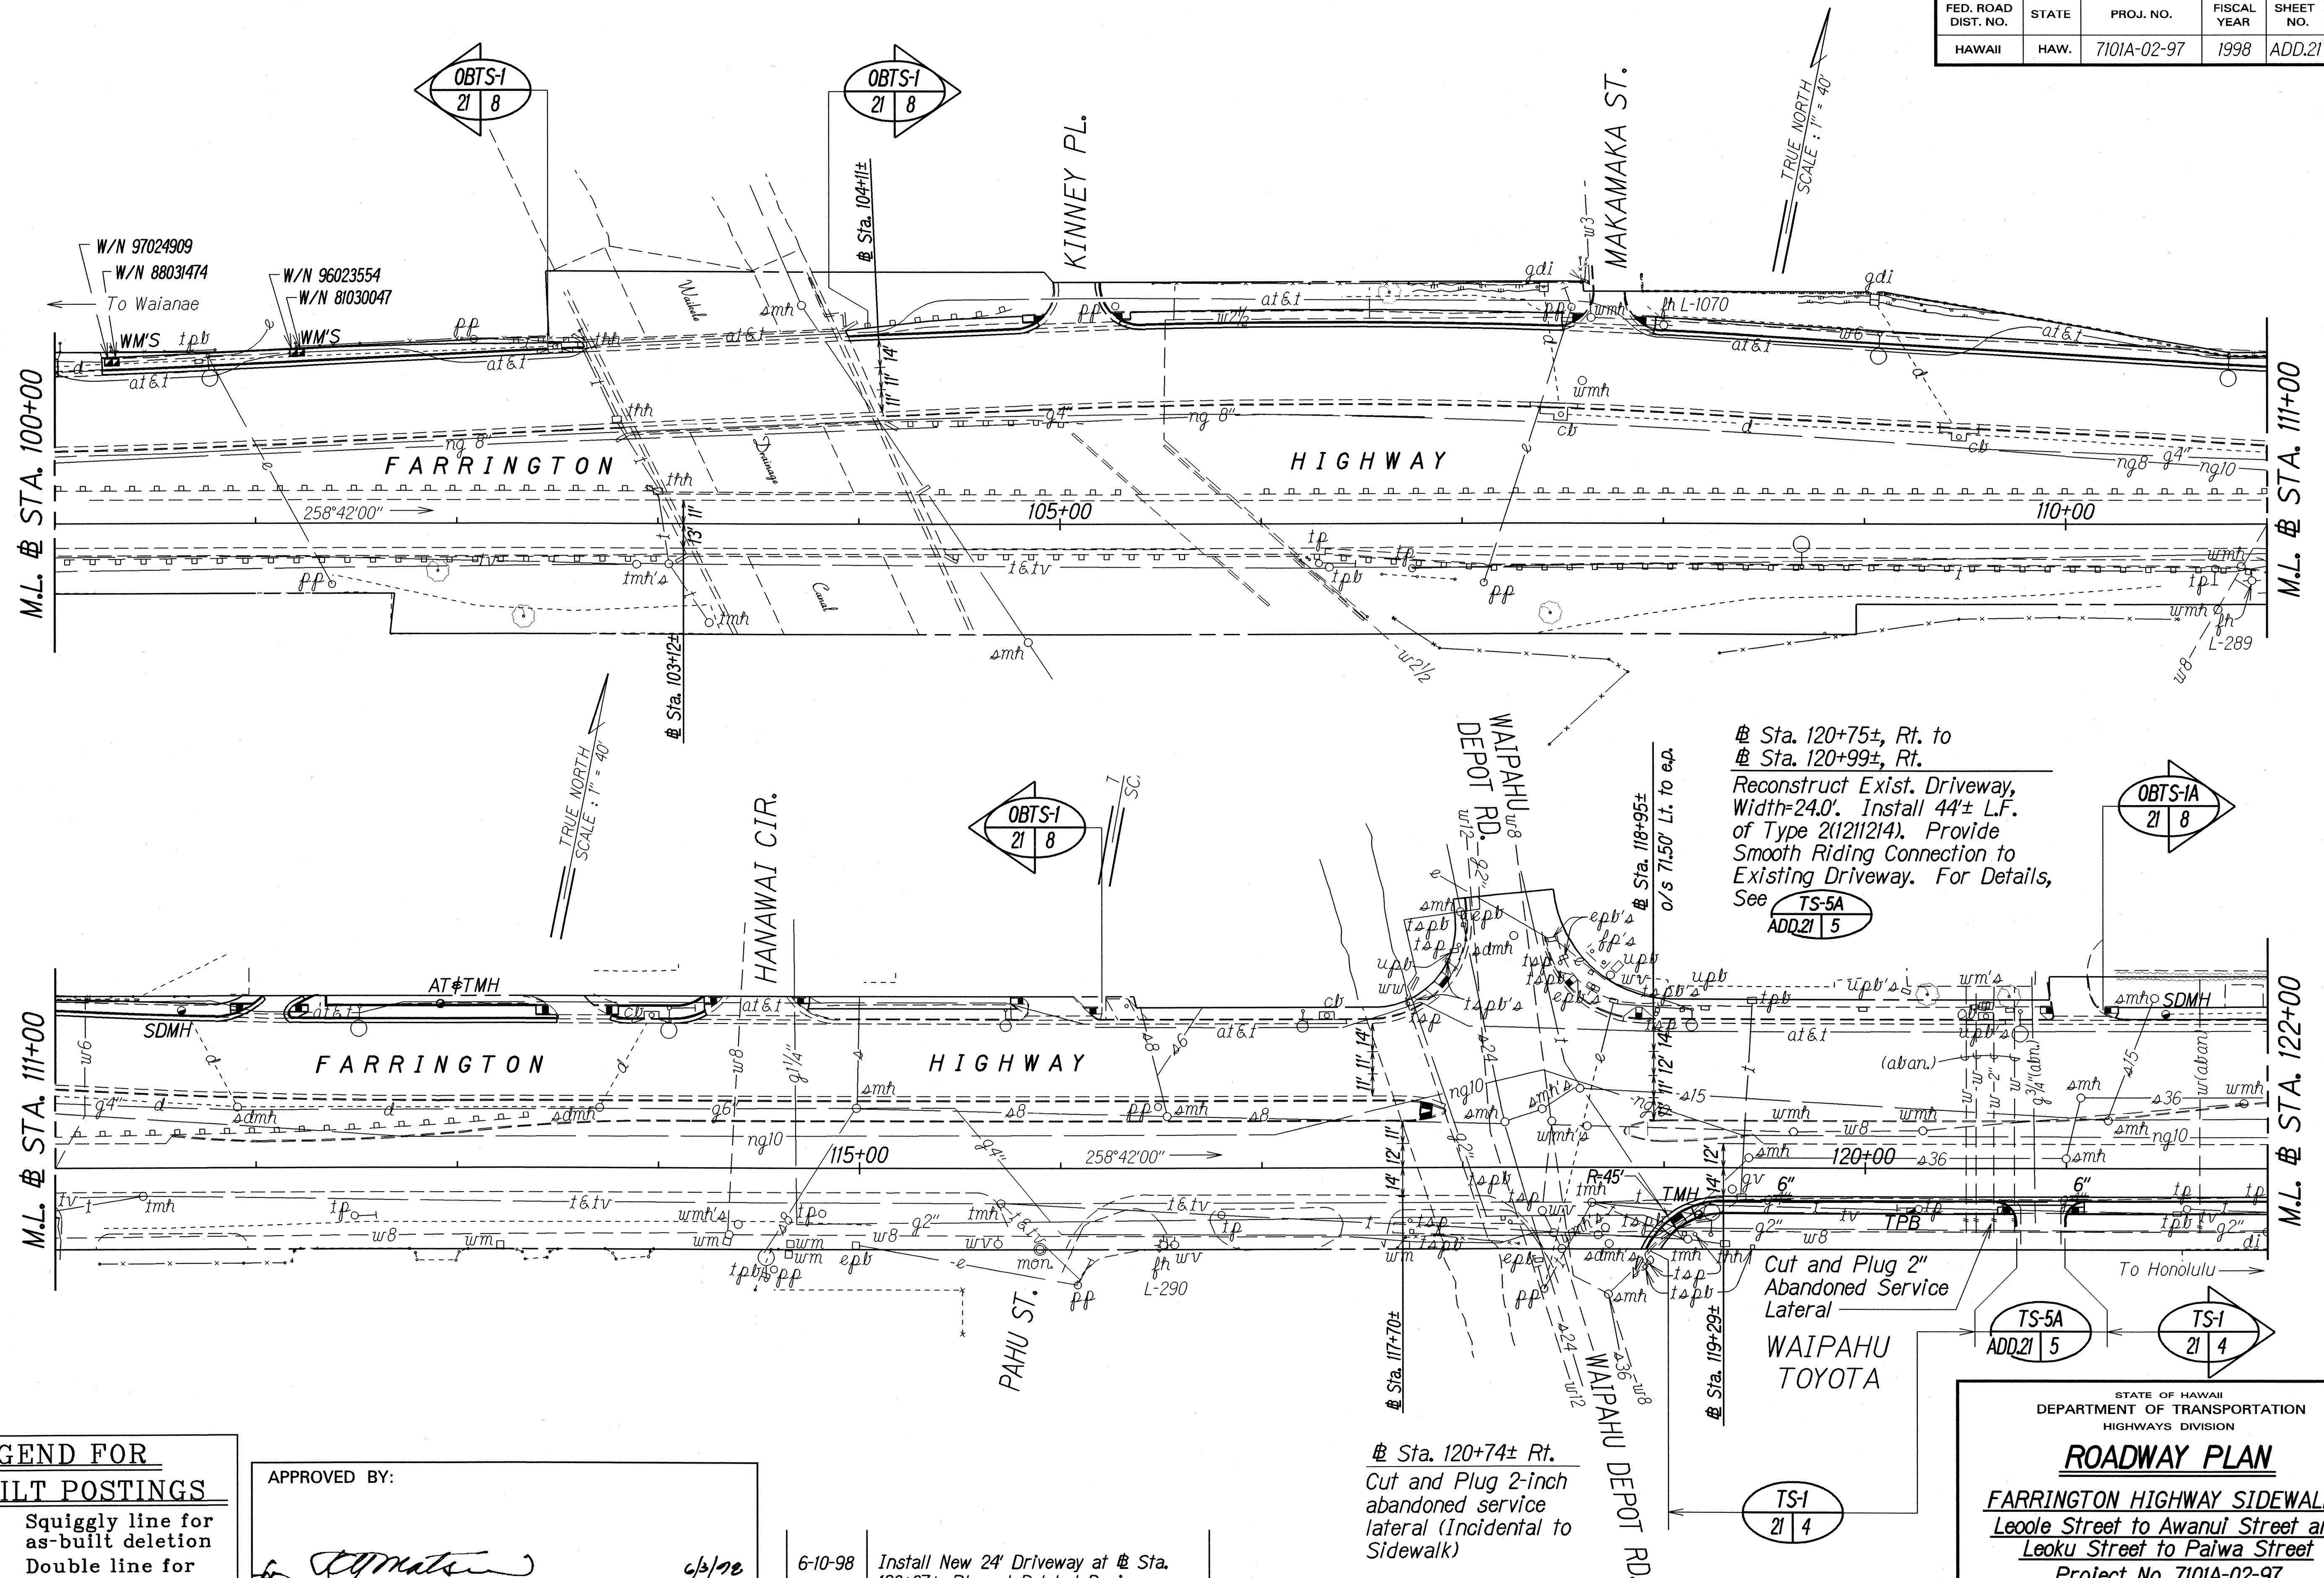

| LEGEND FOR AS-BUILT POSTINGS |                                     |
|------------------------------|-------------------------------------|
|                              | Squiggly line for as-built deletion |
|                              | Double line for as-built deletion   |
|                              | Text for as-built posting           |

|                                         |        |
|-----------------------------------------|--------|
| APPROVED BY:                            |        |
|                                         | 6/3/98 |
| CHIEF, PLANNING AND ENGINEERING, B.W.S. | DATE   |
| CITY AND COUNTY OF HONOLULU             |        |

| DATE    | REVISION                                                                                   |
|---------|--------------------------------------------------------------------------------------------|
| 6-10-98 | Install New 24' Driveway at Sta. 120+87±, Rt. and Deleted Drainage Structures for Clarity. |

STATE OF HAWAII  
DEPARTMENT OF TRANSPORTATION  
HIGHWAYS DIVISION

**ROADWAY PLAN**

**FARRINGTON HIGHWAY SIDEWALKS**  
**Leole Street to Awanui Street and**  
**Leoku Street to Paikua Street**  
**Project No. 7101A-02-97**

Scale: 1"=40.0' Date: May 1998

SHEET No. 3 OF 5 SHEETS

**LEGEND FOR  
AS-BUILT POSTINGS**


Squiggly line for as-built deletion

Double line for as-built deletion

Roadway Text for as-built posting

| DATE    | REVISION                                                                                                                                                          |
|---------|-------------------------------------------------------------------------------------------------------------------------------------------------------------------|
| 5-01-99 | Revised outbound lanes width. Constructed 6.0' Reinforced Concrete Sidewalk and repaired Catch Basin at Sta. 137+70± o/s Lt. Deleted Driveway at Sta. 139+15± Lt. |

| FED. ROAD DIST. NO. | STATE | PROJ. NO.   | FISCAL YEAR | SHEET NO. | TOTAL SHEETS |
|---------------------|-------|-------------|-------------|-----------|--------------|
| HAWAII              | HAW.  | 7101A-02-97 | 1998        | 22        | 102          |

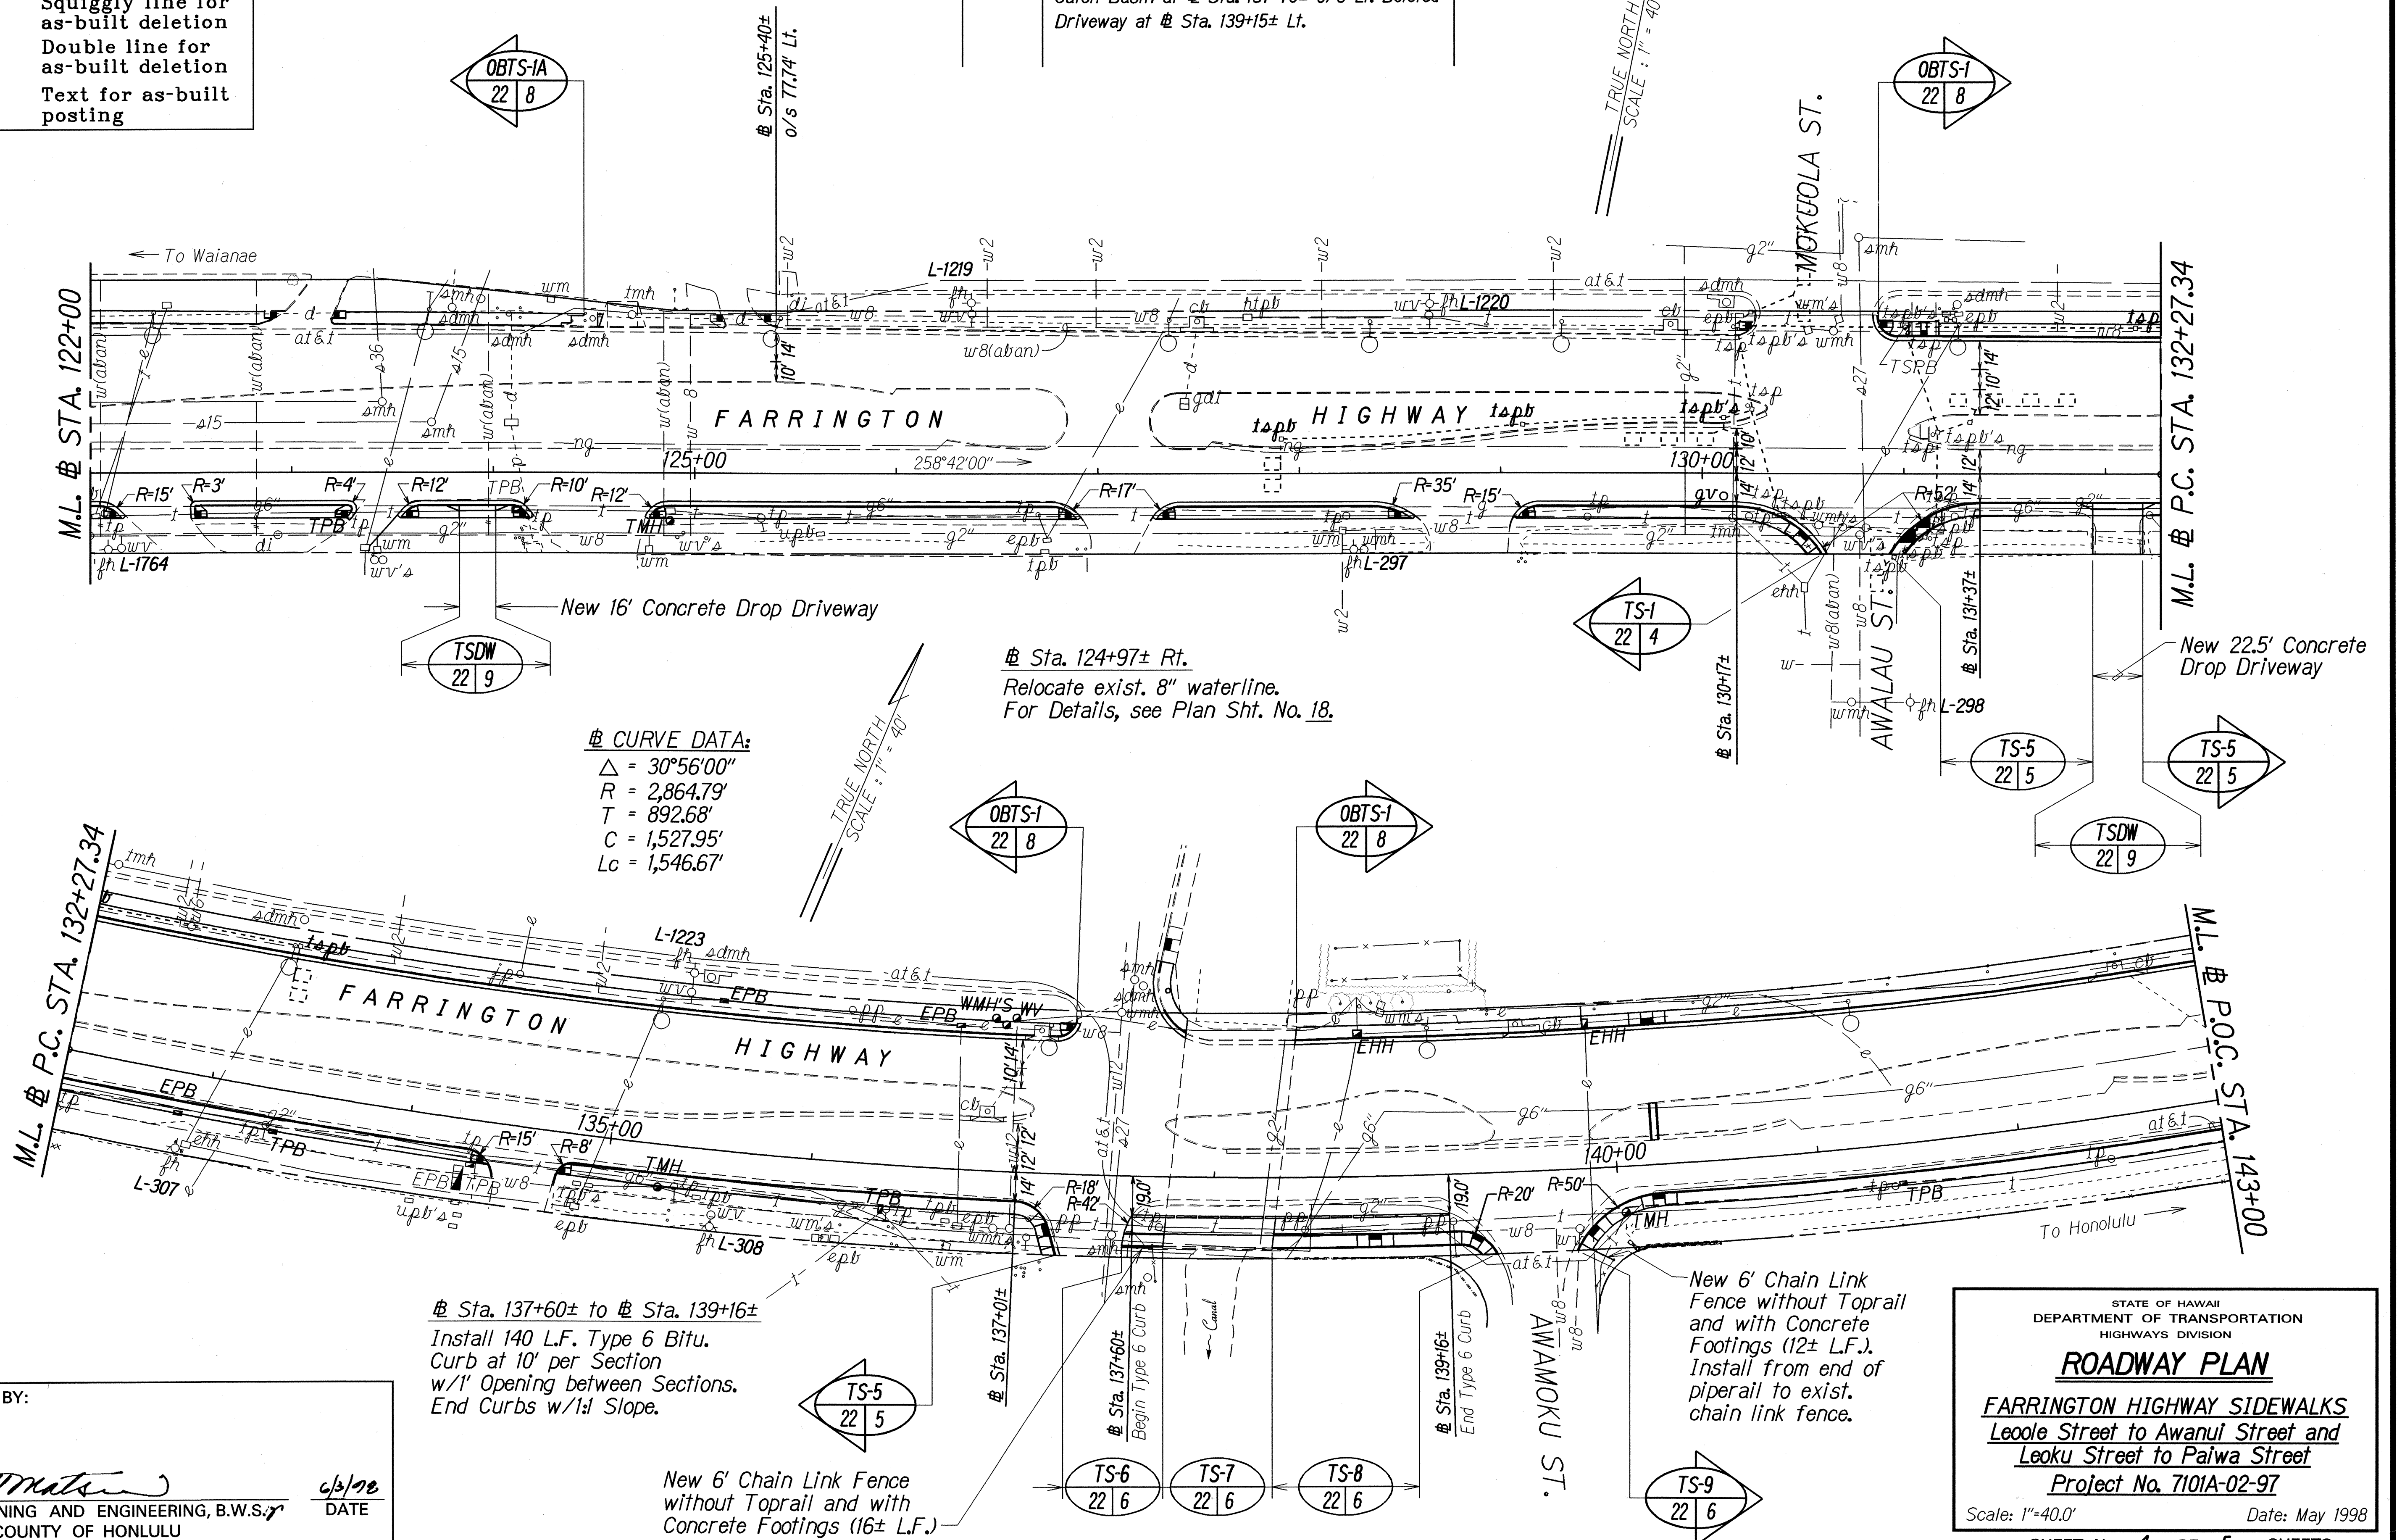

|                     |         |
|---------------------|---------|
| ORIGINAL PLANNED BY | DATE    |
| DESIGNED BY         | 5-03-99 |
| TRACED BY           |         |
| NOTED BY            |         |
| QUANTITIES BY       |         |
| CHECKED BY          |         |

APPROVED BY:

CHIEF, PLANNING AND ENGINEERING, B.W.S. CITY AND COUNTY OF HONOLULU

DATE: 5/1/99

STATE OF HAWAII  
DEPARTMENT OF TRANSPORTATION  
HIGHWAYS DIVISION

**ROADWAY PLAN**


**FARRINGTON HIGHWAY SIDEWALKS**  
Leole Street to Awanui Street and  
Leoku Street to Paiwa Street  
Project No. 7101A-02-97

Scale: 1"=40.0' Date: May 1998

SHEET No. 4 OF 5 SHEETS

| FED. ROAD DIST. NO. | STATE | PROJ. NO.   | FISCAL YEAR | SHEET NO. | TOTAL SHEETS |
|---------------------|-------|-------------|-------------|-----------|--------------|
| HAWAII              | HAW.  | 7101A-02-97 | 1998        | 23        | 102          |

@ Sta. 143+59± to @ Sta. 144+73± Lt.  
 Cold Plane 4-inch of exist. pav't. and  
 Resurf. with 4-inch Asphalt Conc.  
 Pav't. Mix No. IV (Hatched Area).  
 See Plan Sheet No. C.O. 16 S-1 for  
 Curb Ramp, Modified Type "B" detail.

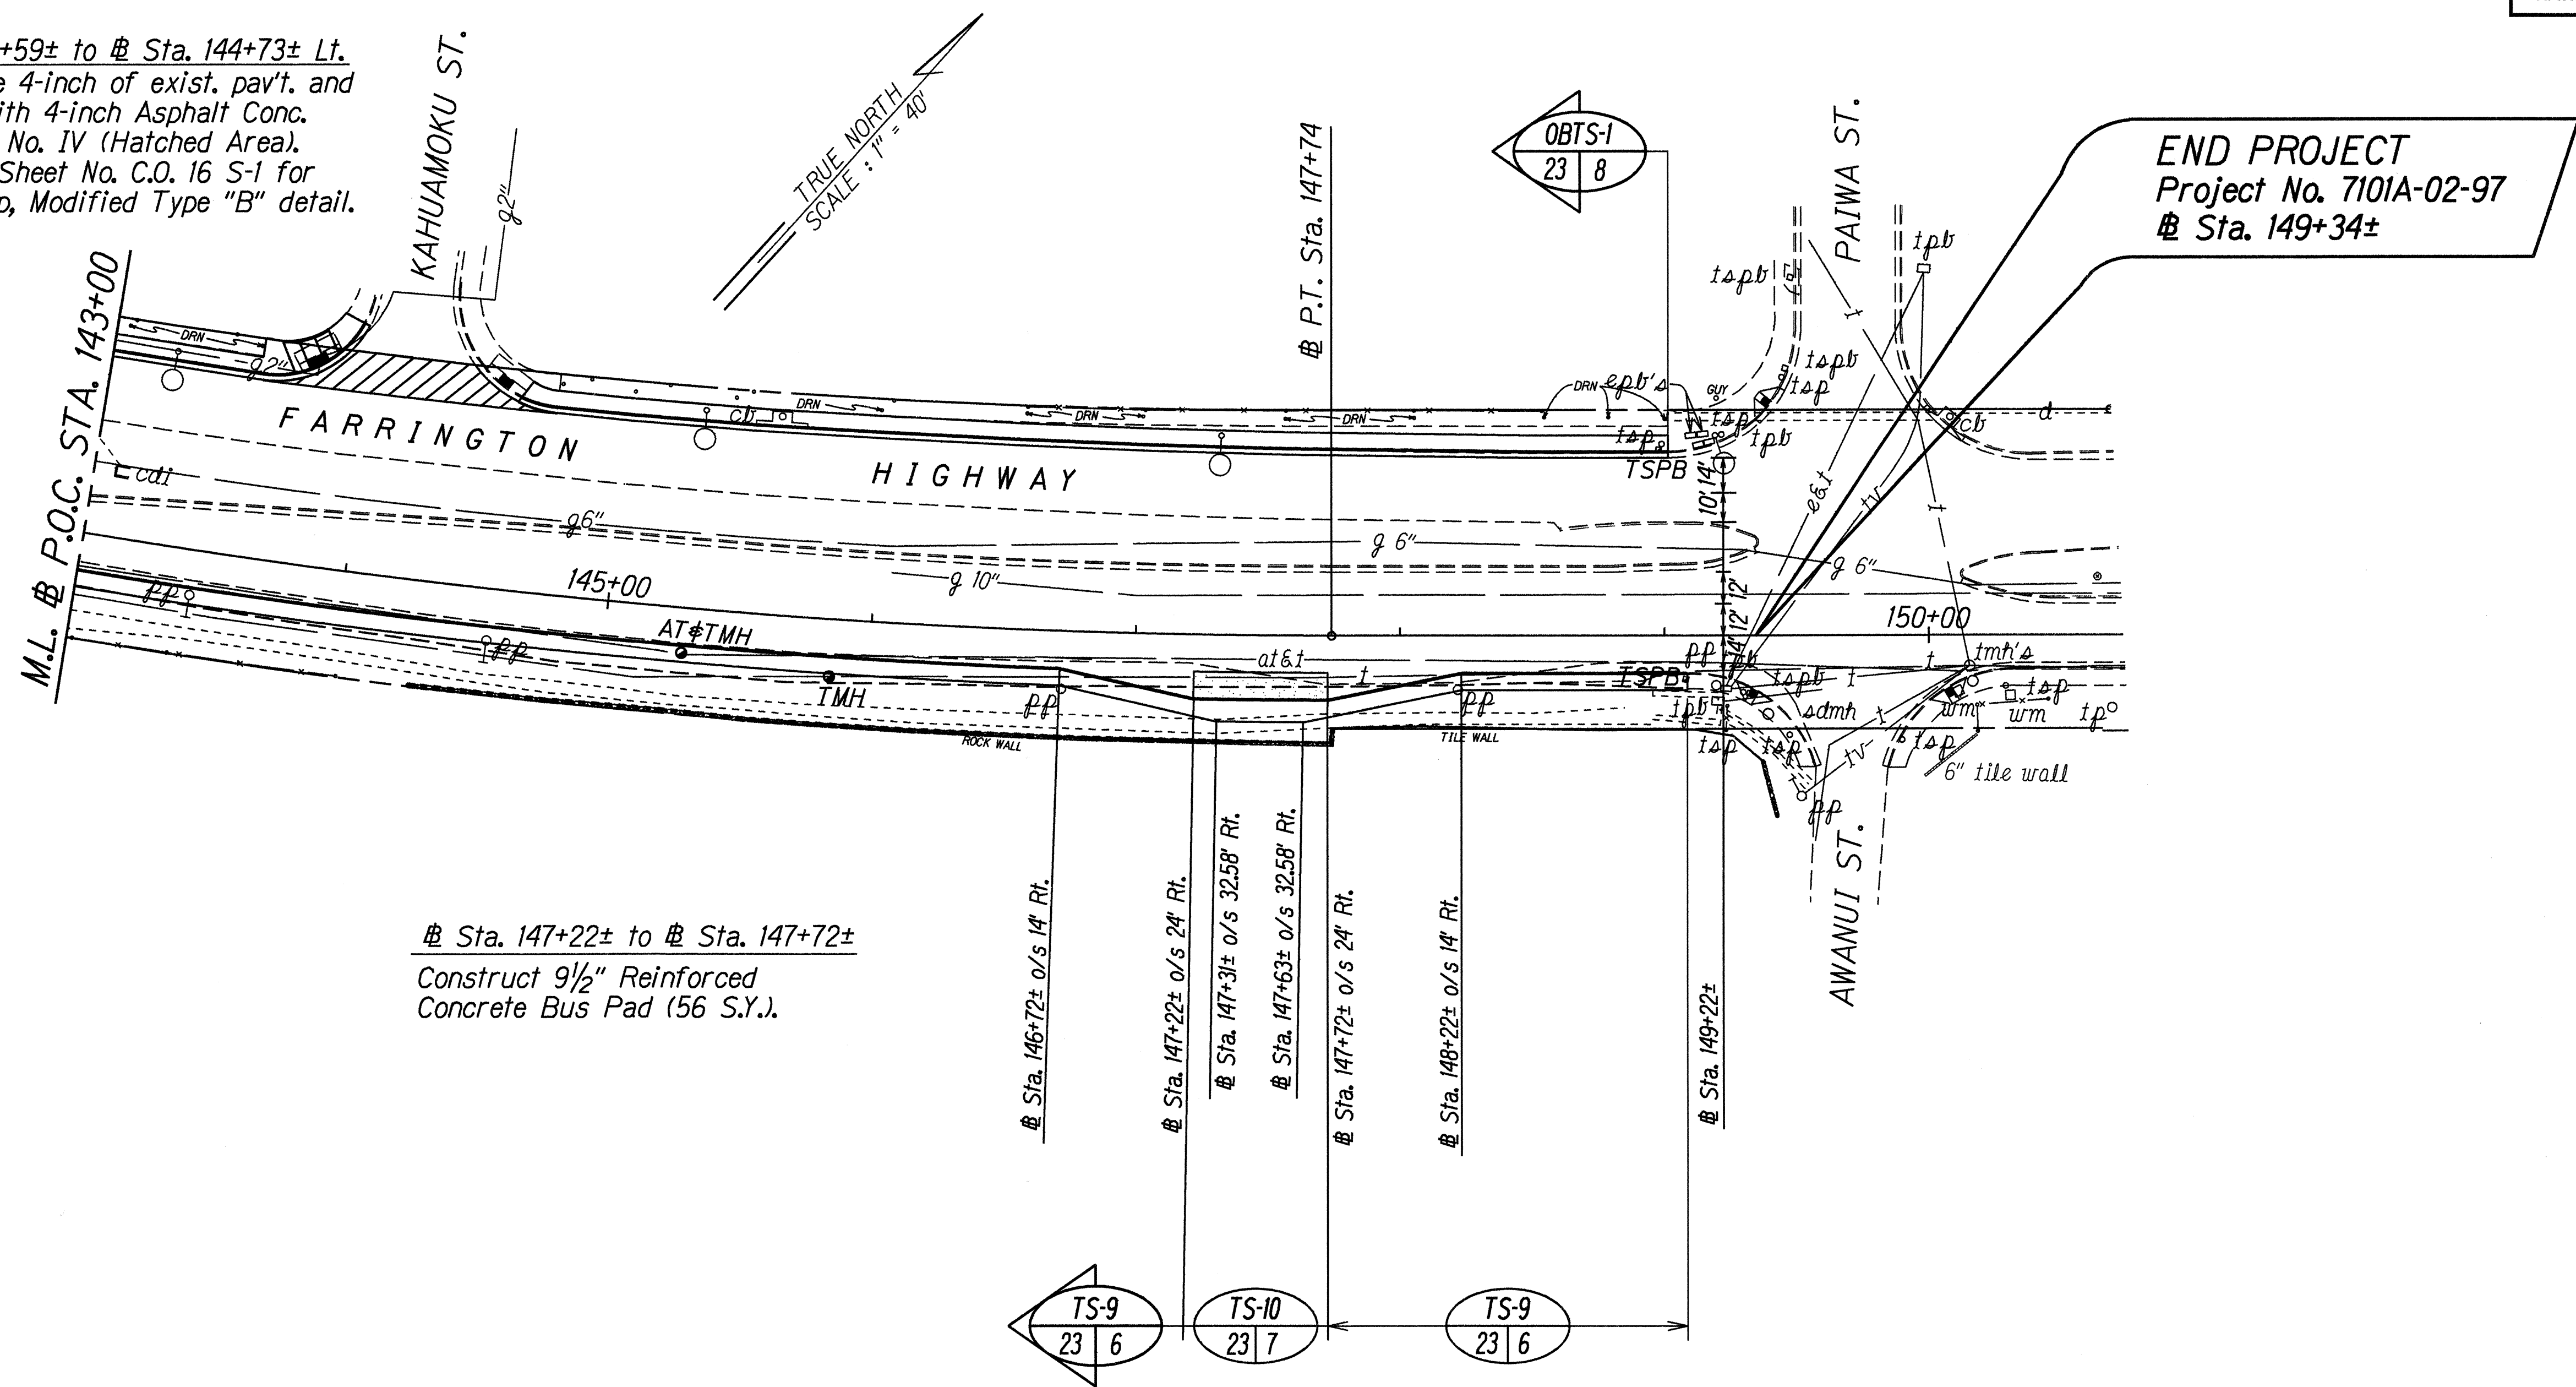

|              |         |
|--------------|---------|
| DESIGNED BY  | DATE    |
| DRAWN BY     | 5-04-99 |
| CHECKED BY   |         |
| NOTED BY     |         |
| APPROVED BY  |         |
| PROJECT NO.  |         |
| SHEET NO.    |         |
| TOTAL SHEETS |         |

| 5-04-99                                                                                                                                                                                                                                                                                   | Revised outbound lanes width.                                         |
|-------------------------------------------------------------------------------------------------------------------------------------------------------------------------------------------------------------------------------------------------------------------------------------------|-----------------------------------------------------------------------|
| 2-17-99                                                                                                                                                                                                                                                                                   | Reconstructed Curb & Gutter, Concrete Sidewalk and Resurfaced Roadway |
| DATE                                                                                                                                                                                                                                                                                      | REVISION                                                              |
| STATE OF HAWAII<br>DEPARTMENT OF TRANSPORTATION<br>HIGHWAYS DIVISION<br><b>ROADWAY PLAN</b><br><b>FARRINGTON HIGHWAY SIDEWALKS</b><br><b>Leolu Street to Awanui Street and</b><br><b>Leoku Street to Paiwa Street</b><br><b>Project No. 7101A-02-97</b><br>Scale: 1"=40.0' Date: May 1998 |                                                                       |
| SHEET No. 5 OF 5 SHEETS                                                                                                                                                                                                                                                                   |                                                                       |