	INDEX TO DRAWINGS
SHEET NO.	DESCRIPTION
1	TITLE SHEET
2	STANDARD PLANS SUMMARY
3 – 4	GENERAL NOTES LEGEND
5	TYPICAL SECTION
6 – 11	PLAN
12	PAVEMENT MARKING LEGEND, DETAILS
	AND NOTES
13 – 14	PAVEMENT MARKING PLAN
15	LOOP DETECTOR DETAILS
16	CROSS-SECTIONS

STATE OF HAWAII

DEPARTMENT OF TRANSPORTATION

HIGHWAYS DIVISION HONOLULU, HAWAII


"AS-BUILT"

PLANS FOR

FARRINGTON HIGHWAY IMPROVEMENTS

Fort Weaver Road Towards Waipahu High School FEDERAL AID PROJECT NO. DE-0200(801)

DISTRICT OF EWA ISLAND OF OAHU

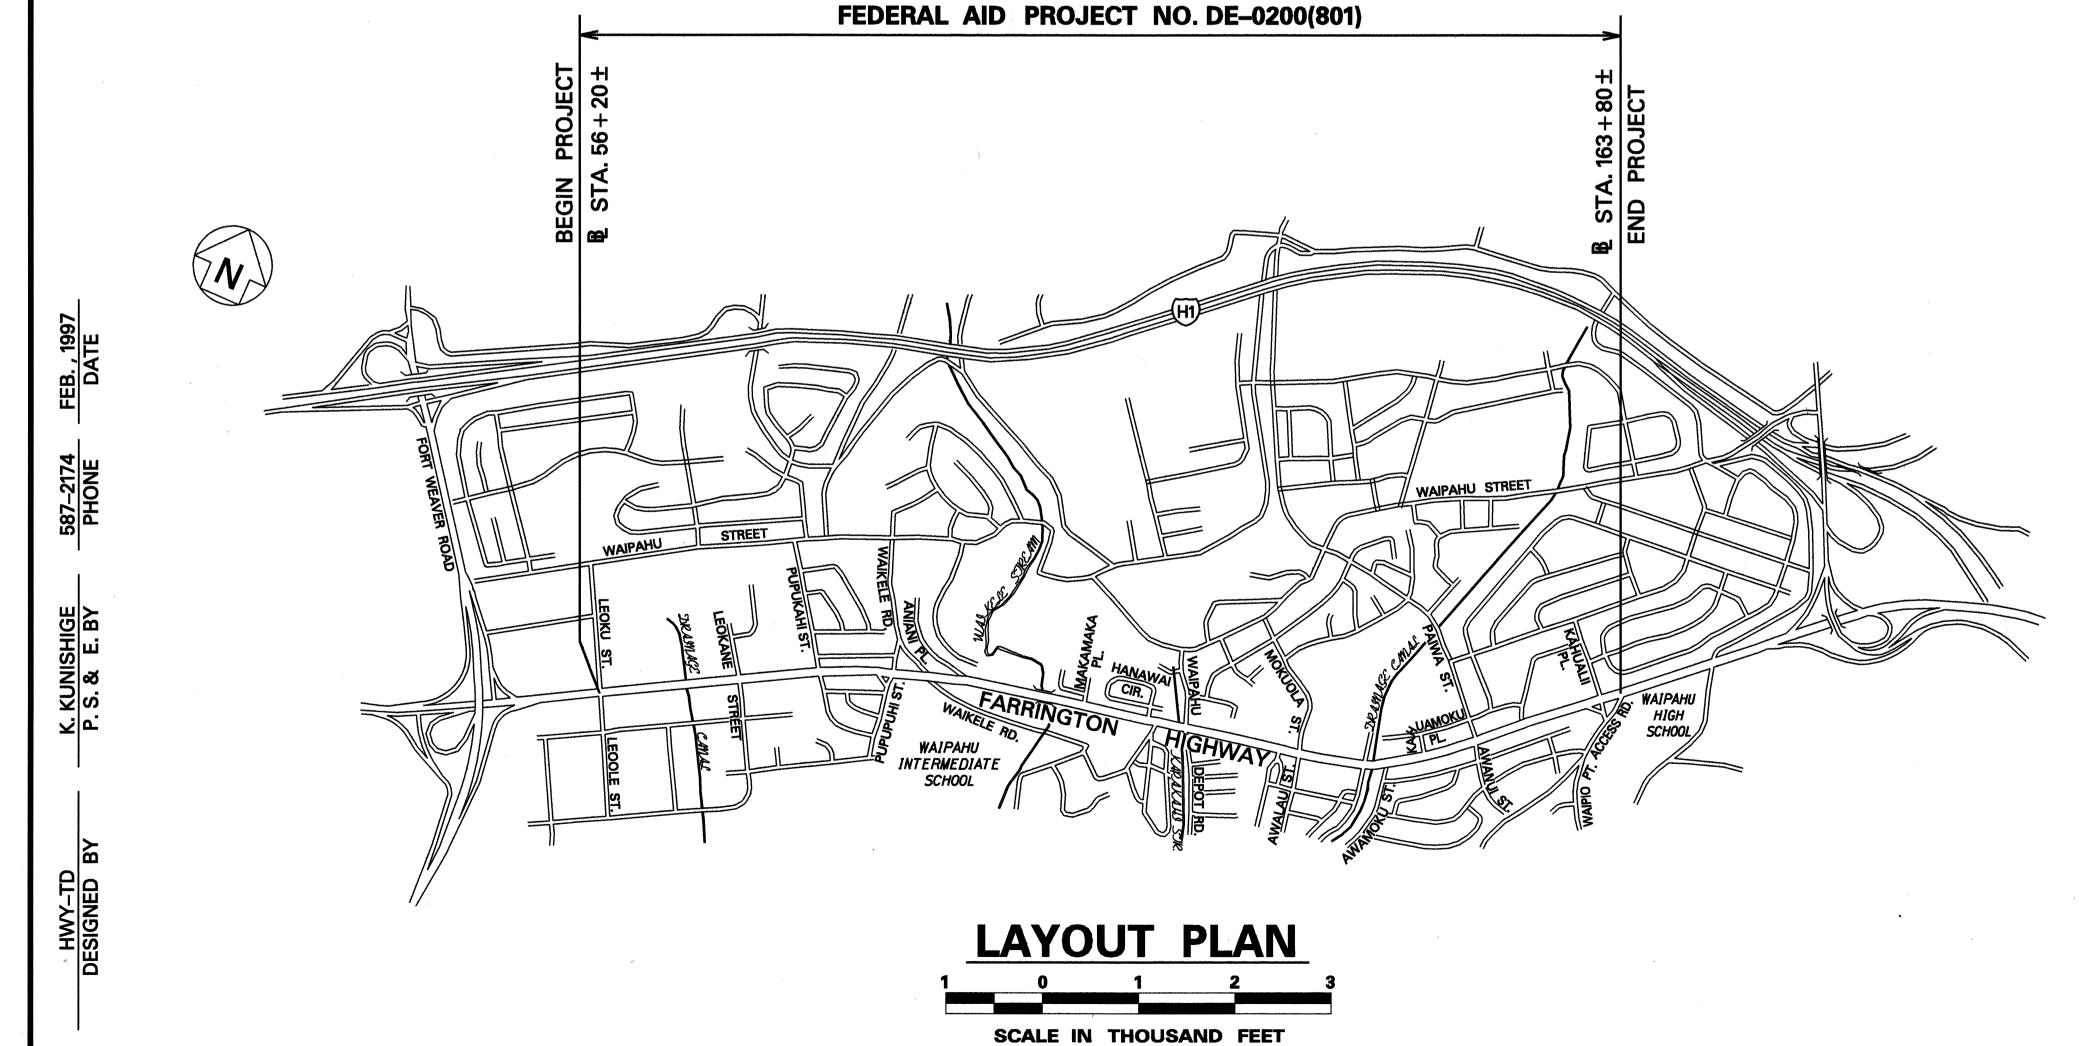

Walanse O A H U Walanse Walanse Walanse Walanse Walanse Walanse Walanse Walanse Walanse Koowa Walanse Walanse Koowa Walanse Walanse Koowa Walanse Walanse Walanse Walanse Walanse Walans

FED. ROAD DIST. NO. FED. AID PROJ. NO.

HAW. DE-0200(801) 1997

FEDERAL AID PROJECTS PREVIOUSLY CONSTRUCTED
OR UNDER CONSTRUCTION

MILE POST <u>0.24</u> TO MILE POST <u>2.26</u>

CHANGES MADE DURING CONSTRUCTION HAVE BEEN NOTED IN RED ON THESE TRACINGS AND CHECKED BY:

RESIDENT ENGINEER 1-11-99
DATE

DEPARTMENT OF TRANSPORTATION
STATE OF HAWAII

APPROVED:

Lazn Layarhida 3/5/97

DIR. OF TRANSPORTATION DATE