


FED. ROAD DIST. NO.	STATE	FED. AID PROJ. NO.	FISCAL YEAR	SHEET NO.	TOTAL SHEETS
HAWAII	HAW.	DE-0200-(801)	1997	C.O. 5	16

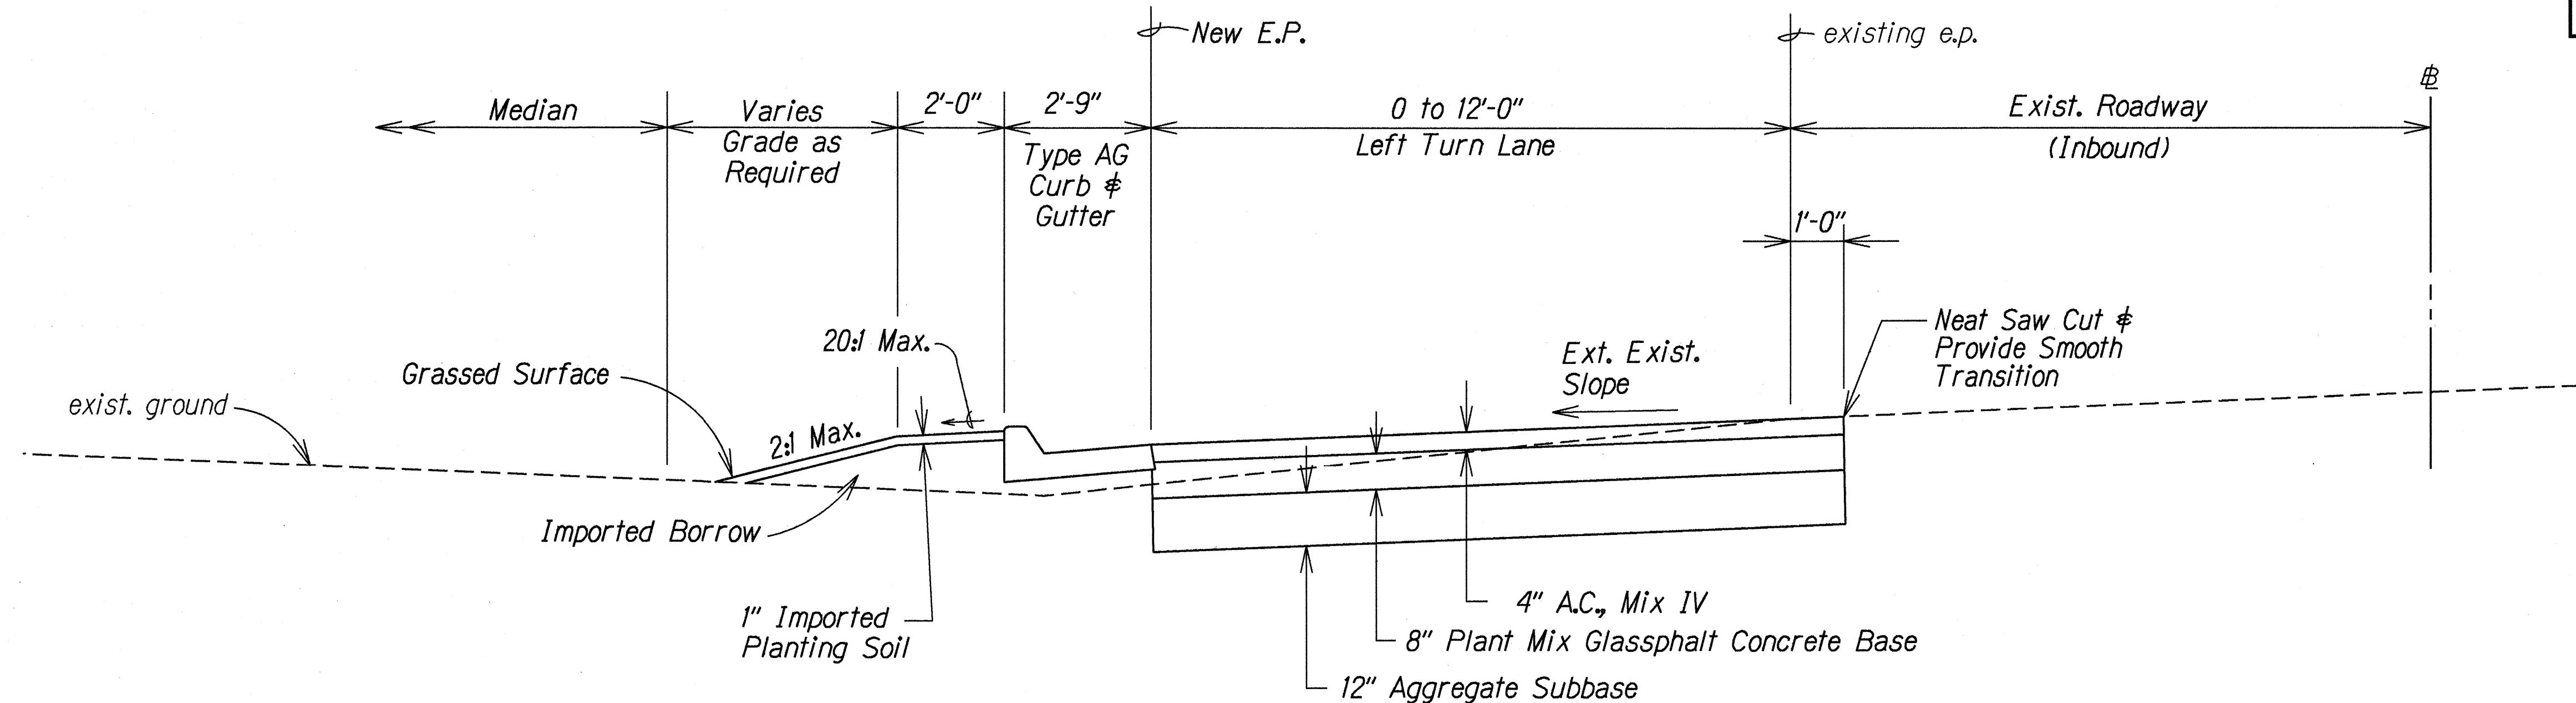


NOTE: Contractor shall maintain natural median drainage

TYPICAL SECTION - FARRINGTON HIGHWAY (Inbound)

± STA. 143+00± TO ± STA. 148+80±

Not to Scale

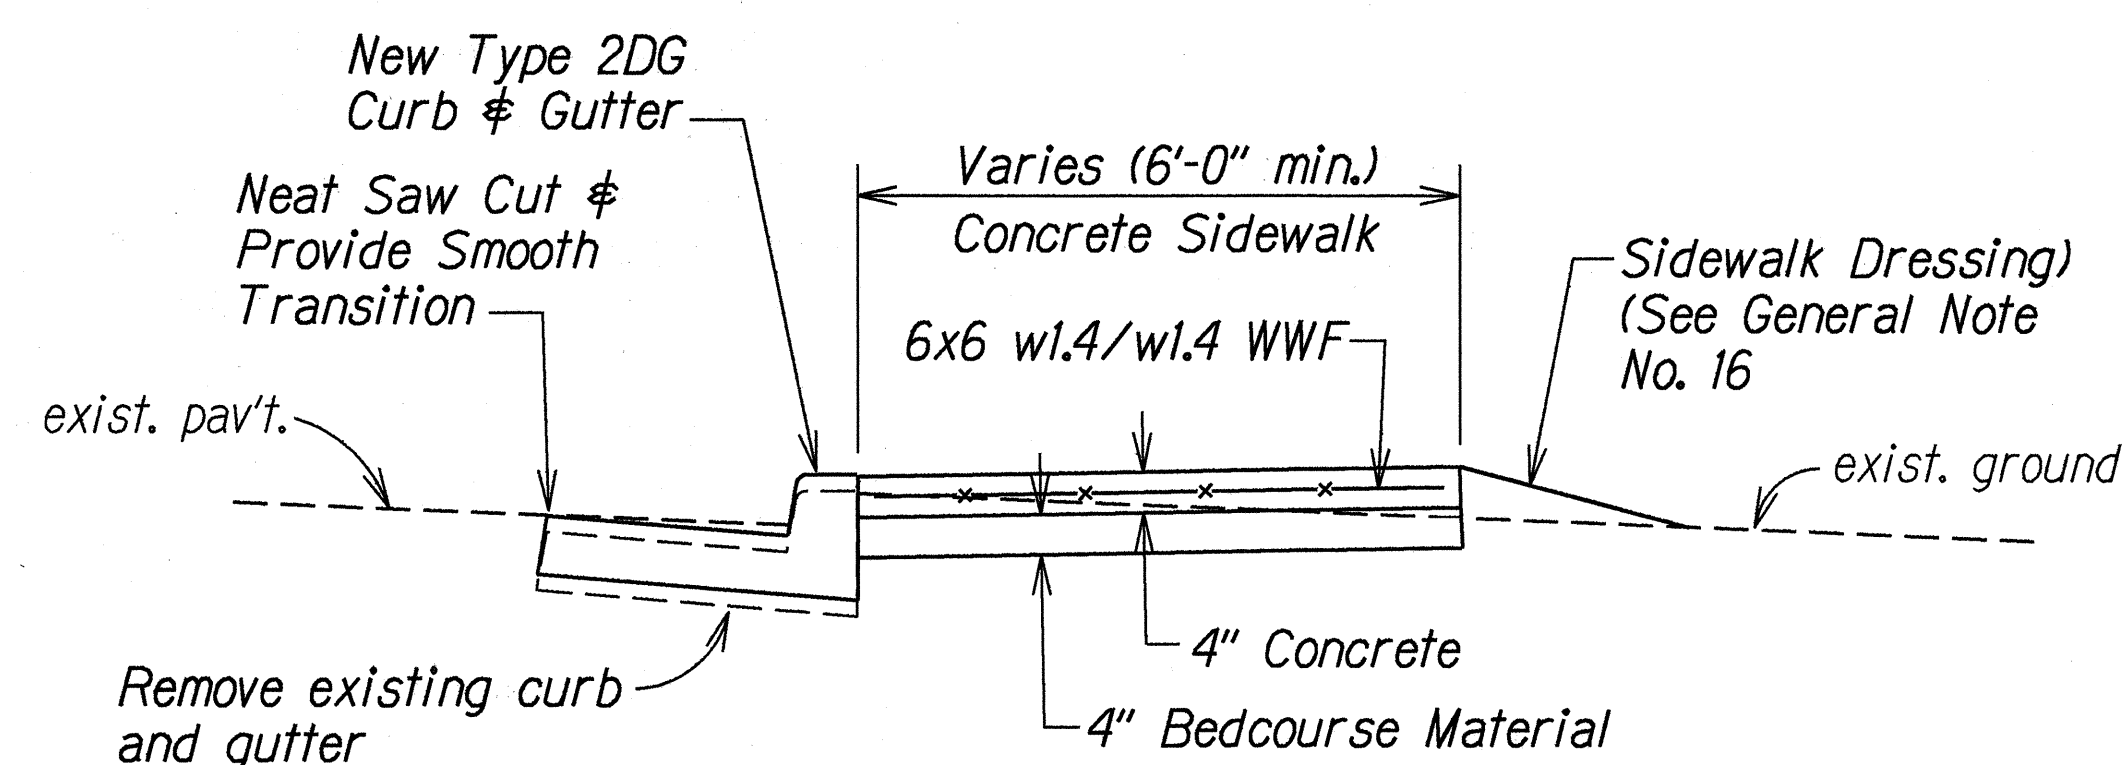

REINFORCED CONCRETE SIDEWALK

Not to Scale

8/26/97 Deleted Bituminous Sidewalk Detail.
Revised Conc. Sidewalk Detail.

DATE REVISION

STATE OF HAWAII
DEPARTMENT OF TRANSPORTATION
HIGHWAYS DIVISION

TYPICAL SECTION

FARRINGTON HIGHWAY IMPROVEMENTS
Fort Weaver Road Towards Waipahu High Sch.

Federal Aid Project No. DE-0200(801)

Scale: As Noted

Date: Feb., 1997

SHEET No. 1 OF 1 SHEETS

C.O. 5

ORIGINAL PLAN	DATE
SURVEY PLOTTED BY	
DRAWN BY	
TRACED BY	
NOTED BY	
DESIGNED BY	
QUANTITIES BY	
CHECKED BY	