

INDEX TO DRAWINGS	
SHEET NO.	DESCRIPTION
1	TITLE SHEET
2	STANDARD PLANS SUMMARY
3	GENERAL NOTES & LEGEND
4 - 11	DRAINAGE PLANS & DETAILS
① 12 - 20	RETAINING WALL PLAN & DETAILS
21 - 22	IRRIGATION PLAN & DETAILS

SHEET NOS. ① 20S-1 THROUGH 20S-8 ARE
SUPPLEMENTARY SHEETS TO THIS PROJECT.
TOTAL SHEET COUNT AFTER "AS-BUILT"
POSTING 30 SHTS

STATE OF HAWAII

DEPARTMENT OF TRANSPORTATION

HIGHWAYS DIVISION

HONOLULU, HAWAII

"AS-BUILT"

PLANS FOR

FARRINGTON HIGHWAY

RETAINING WALL, ABOVE WAIPAHU HIGH SCHOOL





ATHLETIC FIELD

PROJECT NO. 7101A-02-98

DISTRICT OF EWA

ISLAND OF OAHU

FED. ROAD DIST. NO.	STATE	PROJ. NO.	FISCAL YEAR	SHEET NO.	TOTAL SHEETS
HAWAII	HAW.	7101A-02-98	2000	1	22

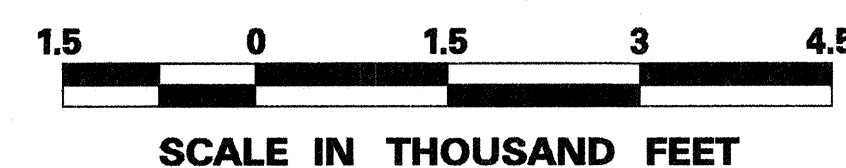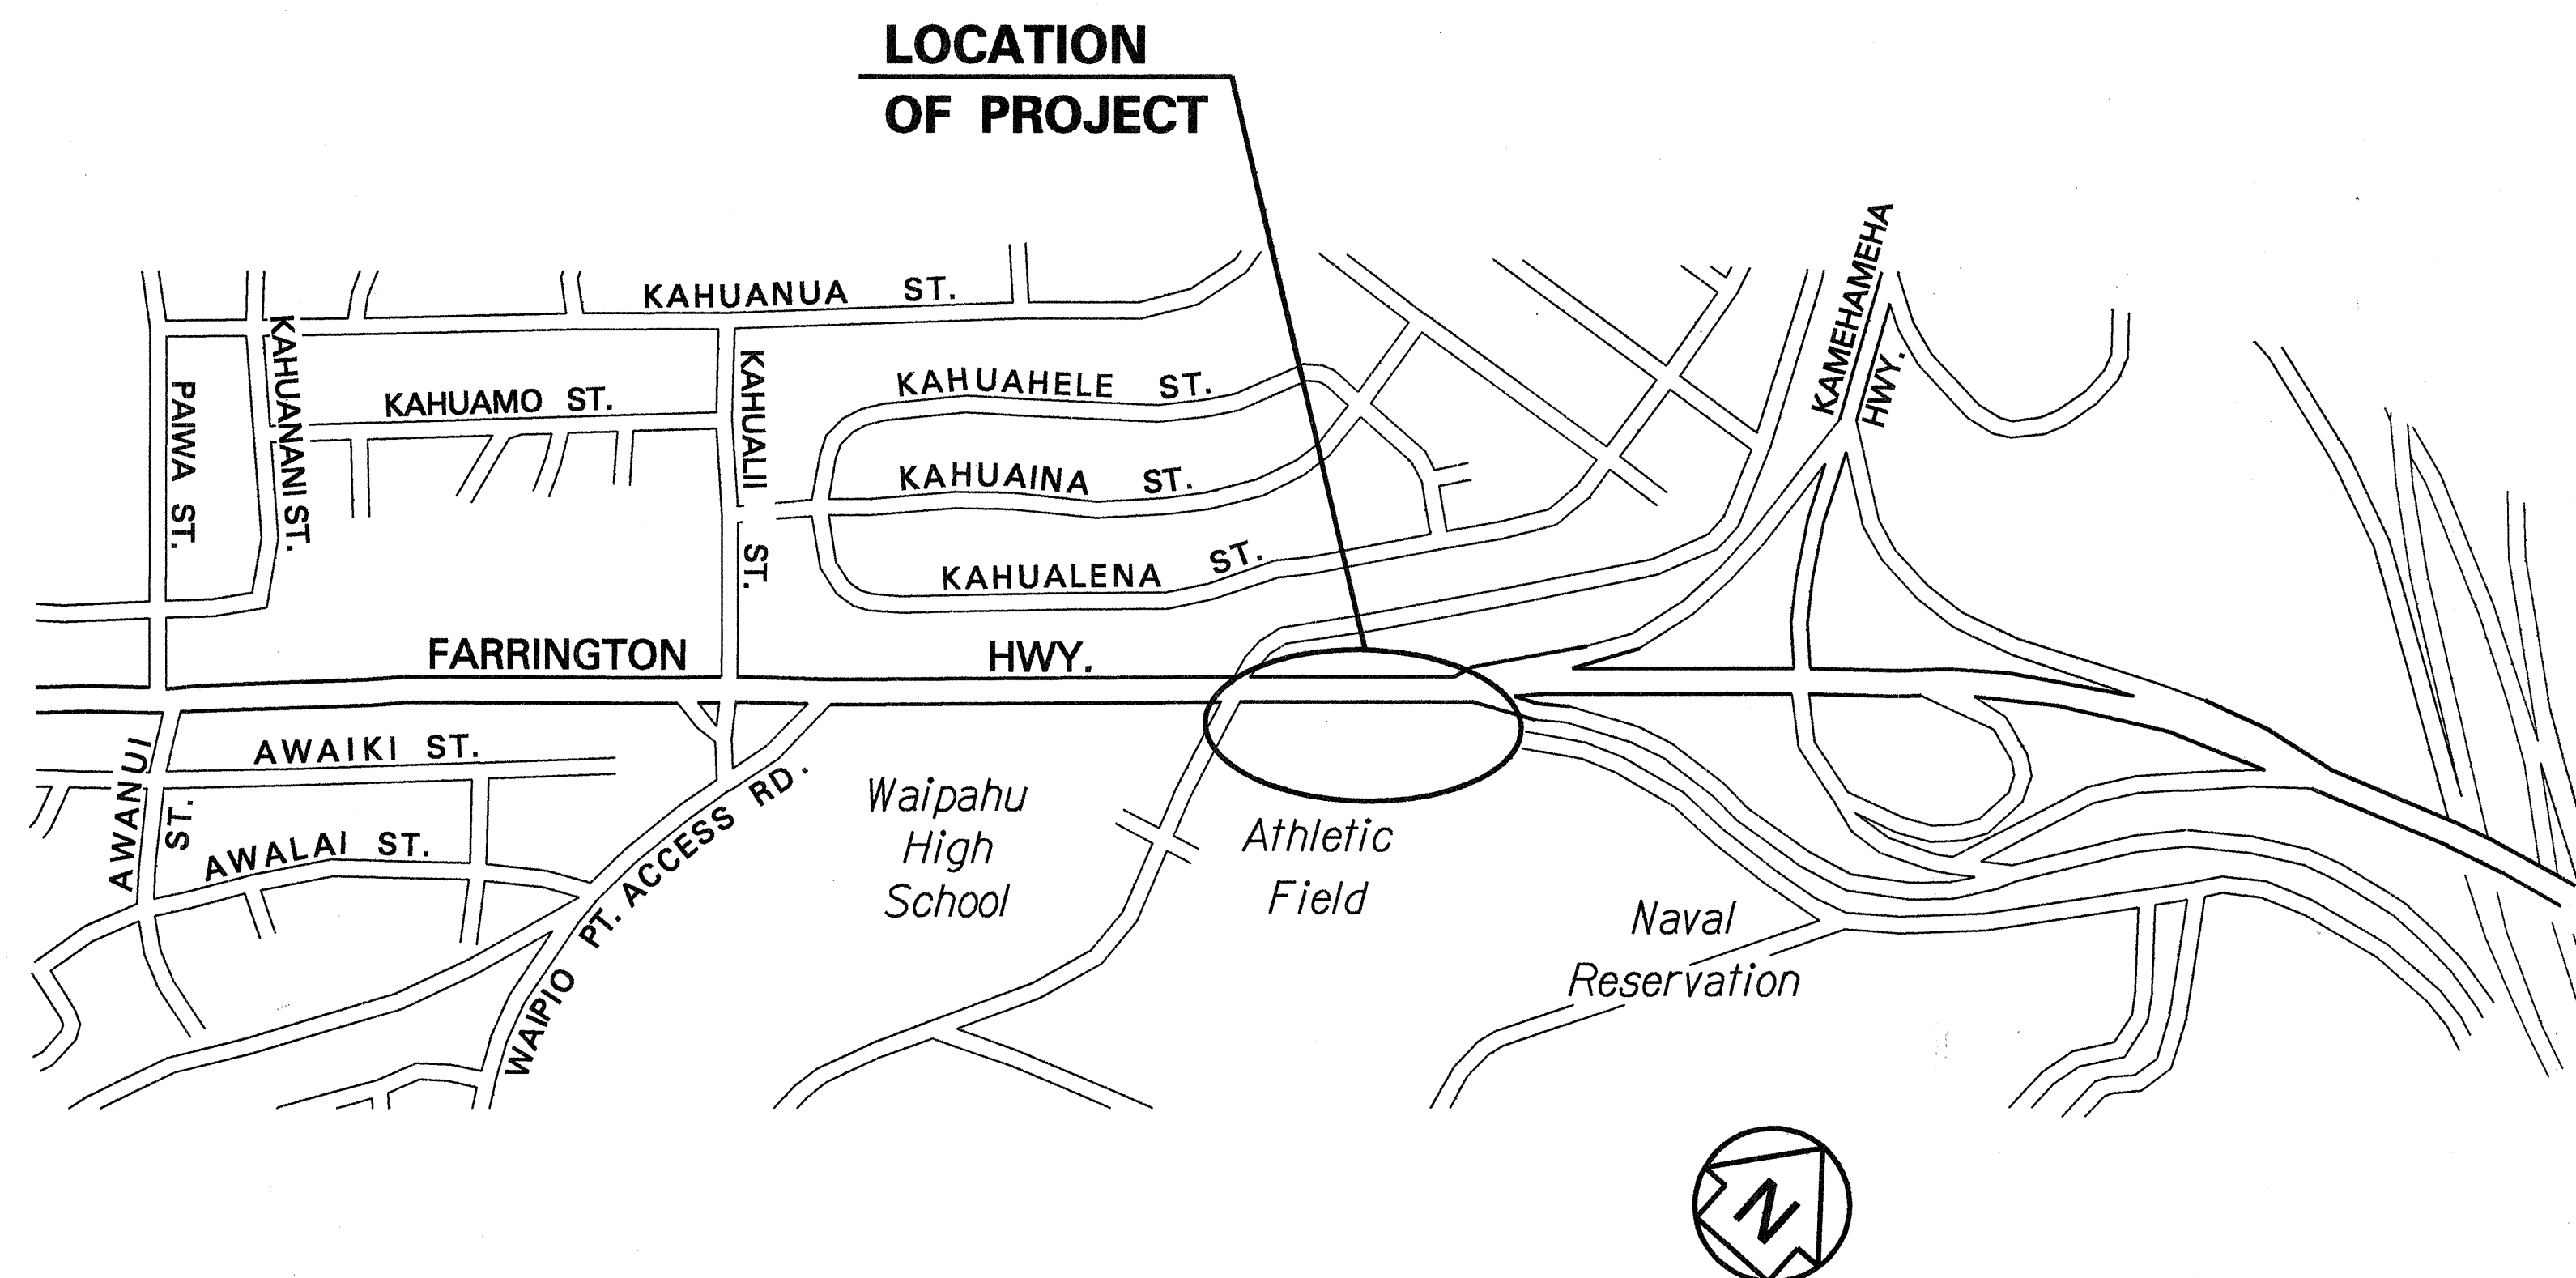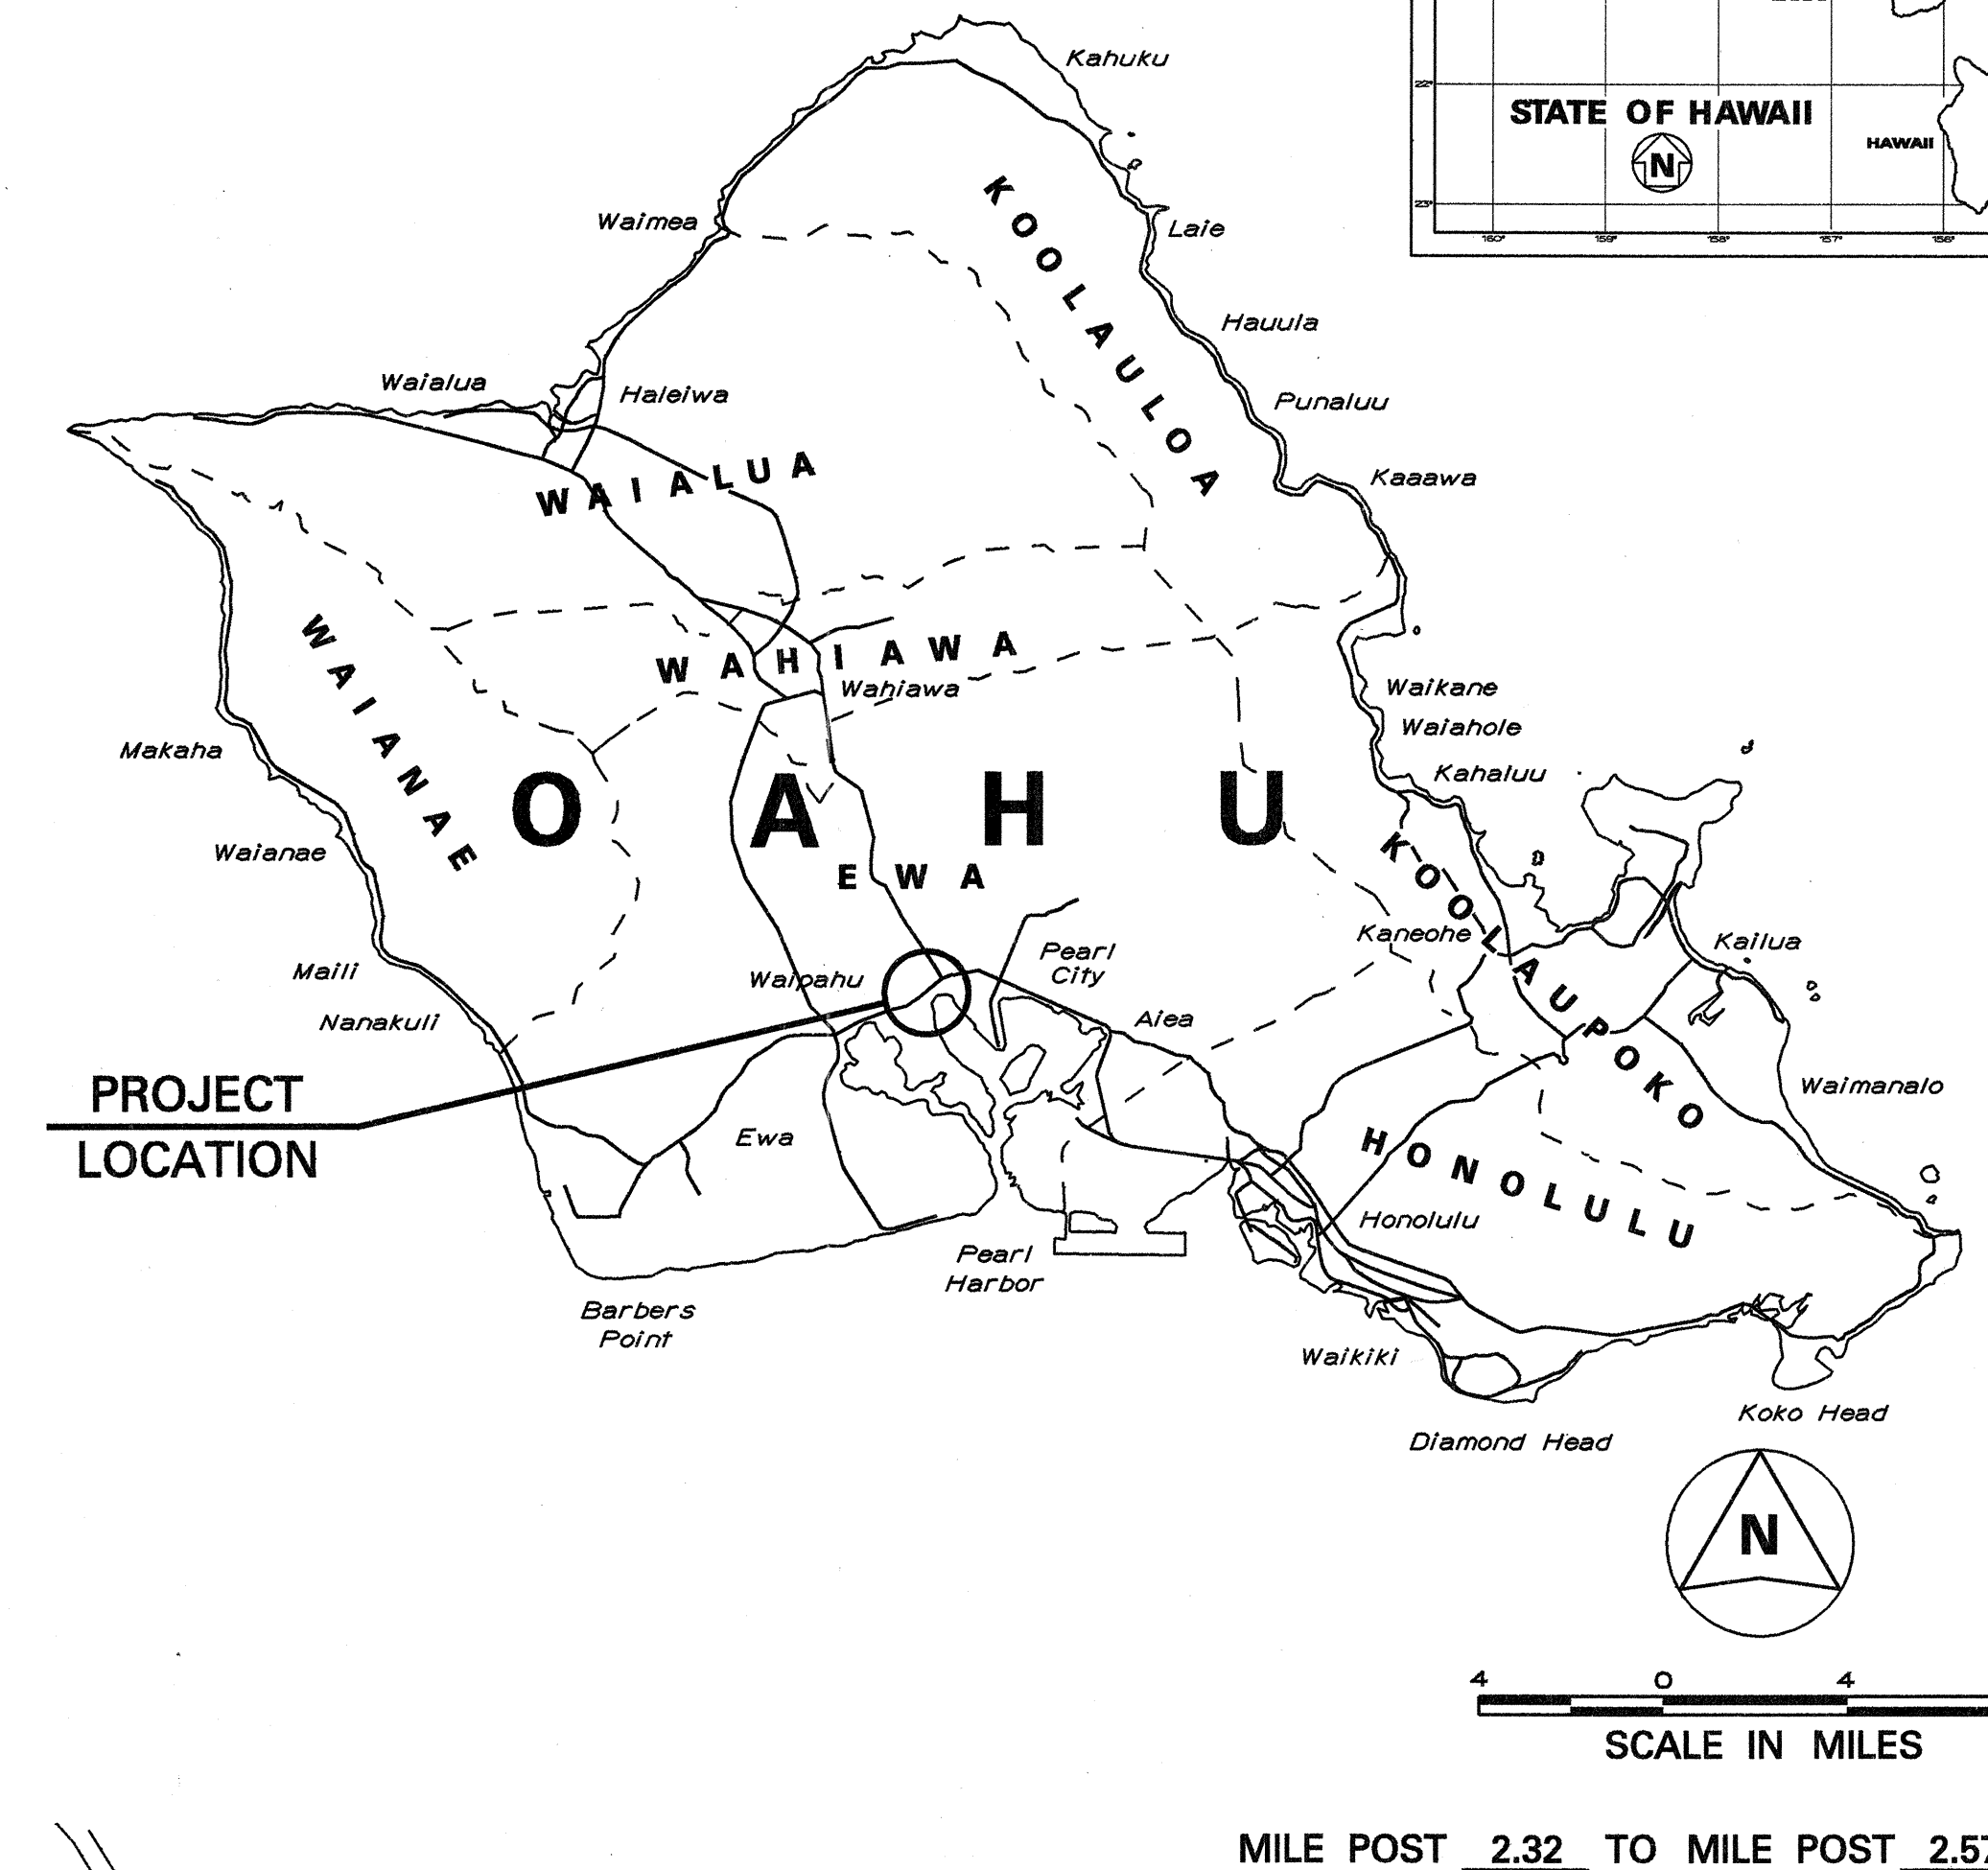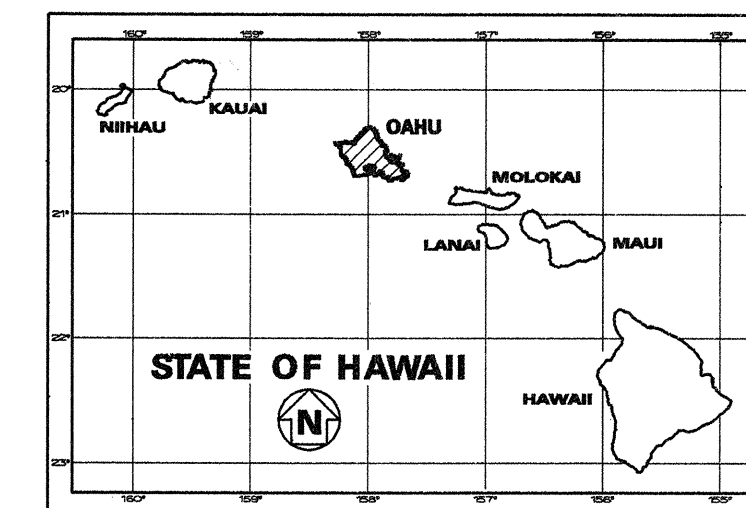

LAYOUT PLAN

GROSS LENGTH OF PROJECT... 0.25 MILES

NET LENGTH OF PROJECT... 0.25 MILES

APPROVED:

Patricia A. Robinson 4-5-7-00

PRINCIPAL OF DATE

WAIPAHU HIGH SCHOOL

DEPARTMENT OF TRANSPORTATION

STATE OF HAWAII

APPROVED:

Kayn Vayachik 4/10/00

DIR. OF TRANSPORTATION DATE

HWY-DD, UNIT "A" CHRISTINE YAMASAKI 692-7572 APRIL 2000

DESIGNED BY P.S. & E. BY PHONE DATE

CHANGES MADE DURING CONSTRUCTION HAVE BEEN
INCORPORATED INTO THESE PLANS EXCEPT CHANGES
IN THE ORIGINAL QUANTITIES. FOR
ACTUAL QUANTITIES, REFER TO PROJECT LEDGER
AND/OR CHANGES BOOK.