


N*TERMEDIATE* 

LAYOUT PLAN

GROSS LENGTH OF PROJECT - 2.14 MILES

SCALE IN THOUSAND FEET

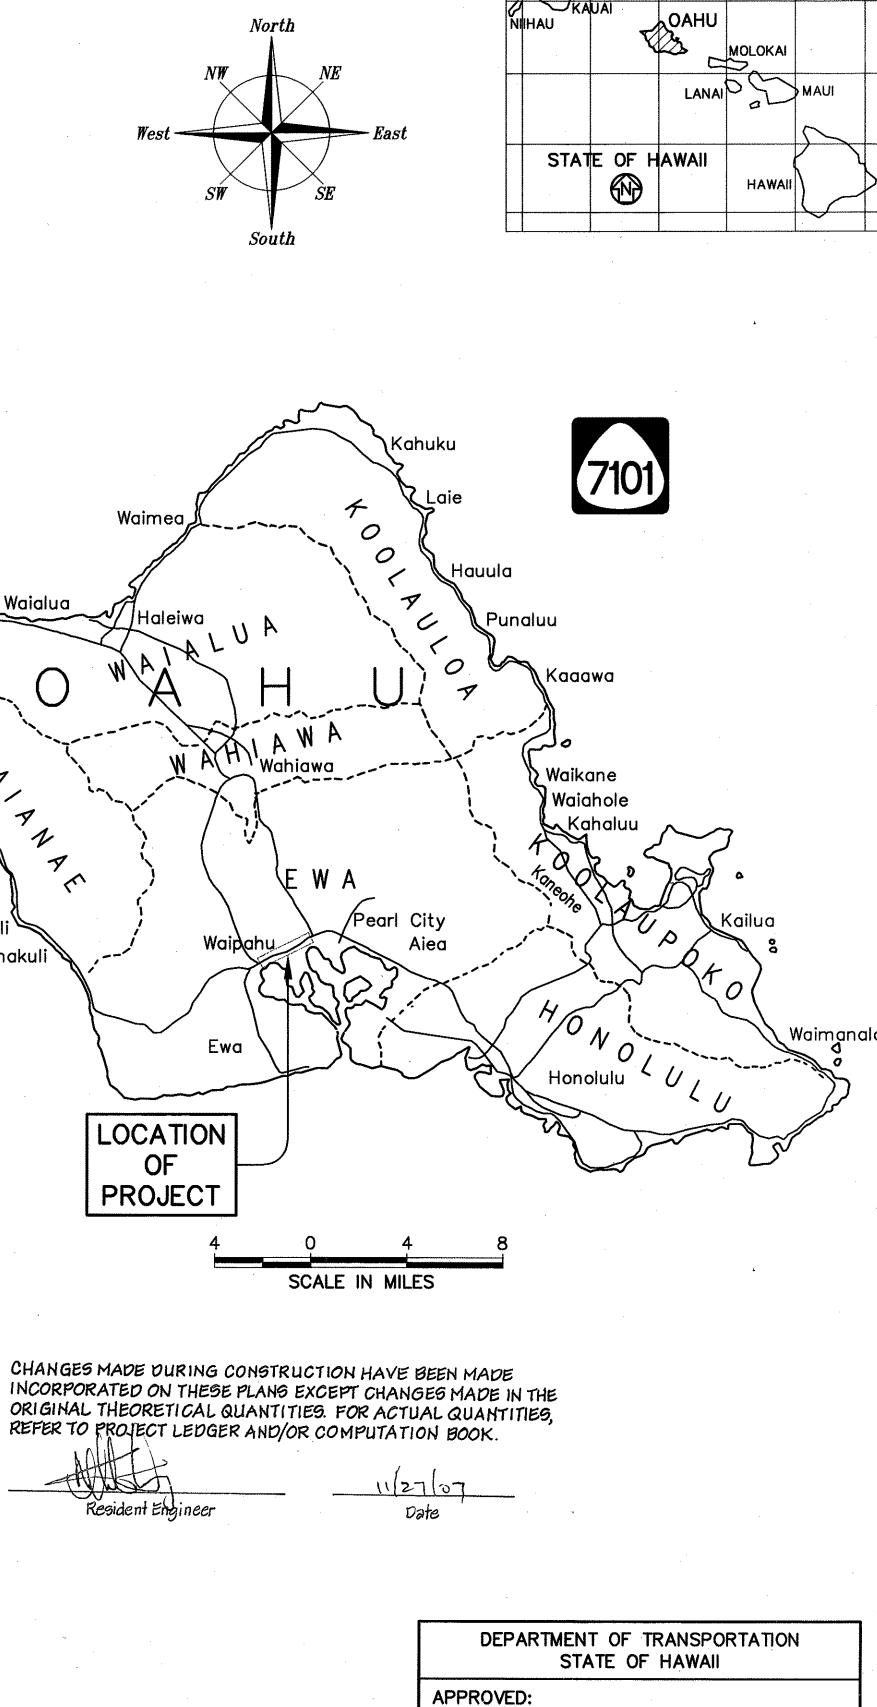

FED. ROAD

DIS. NO. STATE PROJ NO.

HAW. 7101A-01-98 2002

ORIGINAL PLAN NOTEBOOK

AS-BUILT

JDIR. OF TRANSPORTATION

1

5/2/02

FISCAL SHEET TOTAL

NO. SHEETS

YEAR