



FED. ROAD DIST. NO.	STATE	FED. AID PROJ. NO.	FISCAL YEAR	SHEET NO.	TOTAL SHEETS
HAWAII	HAW.	STP-710(1)	1998	15	16

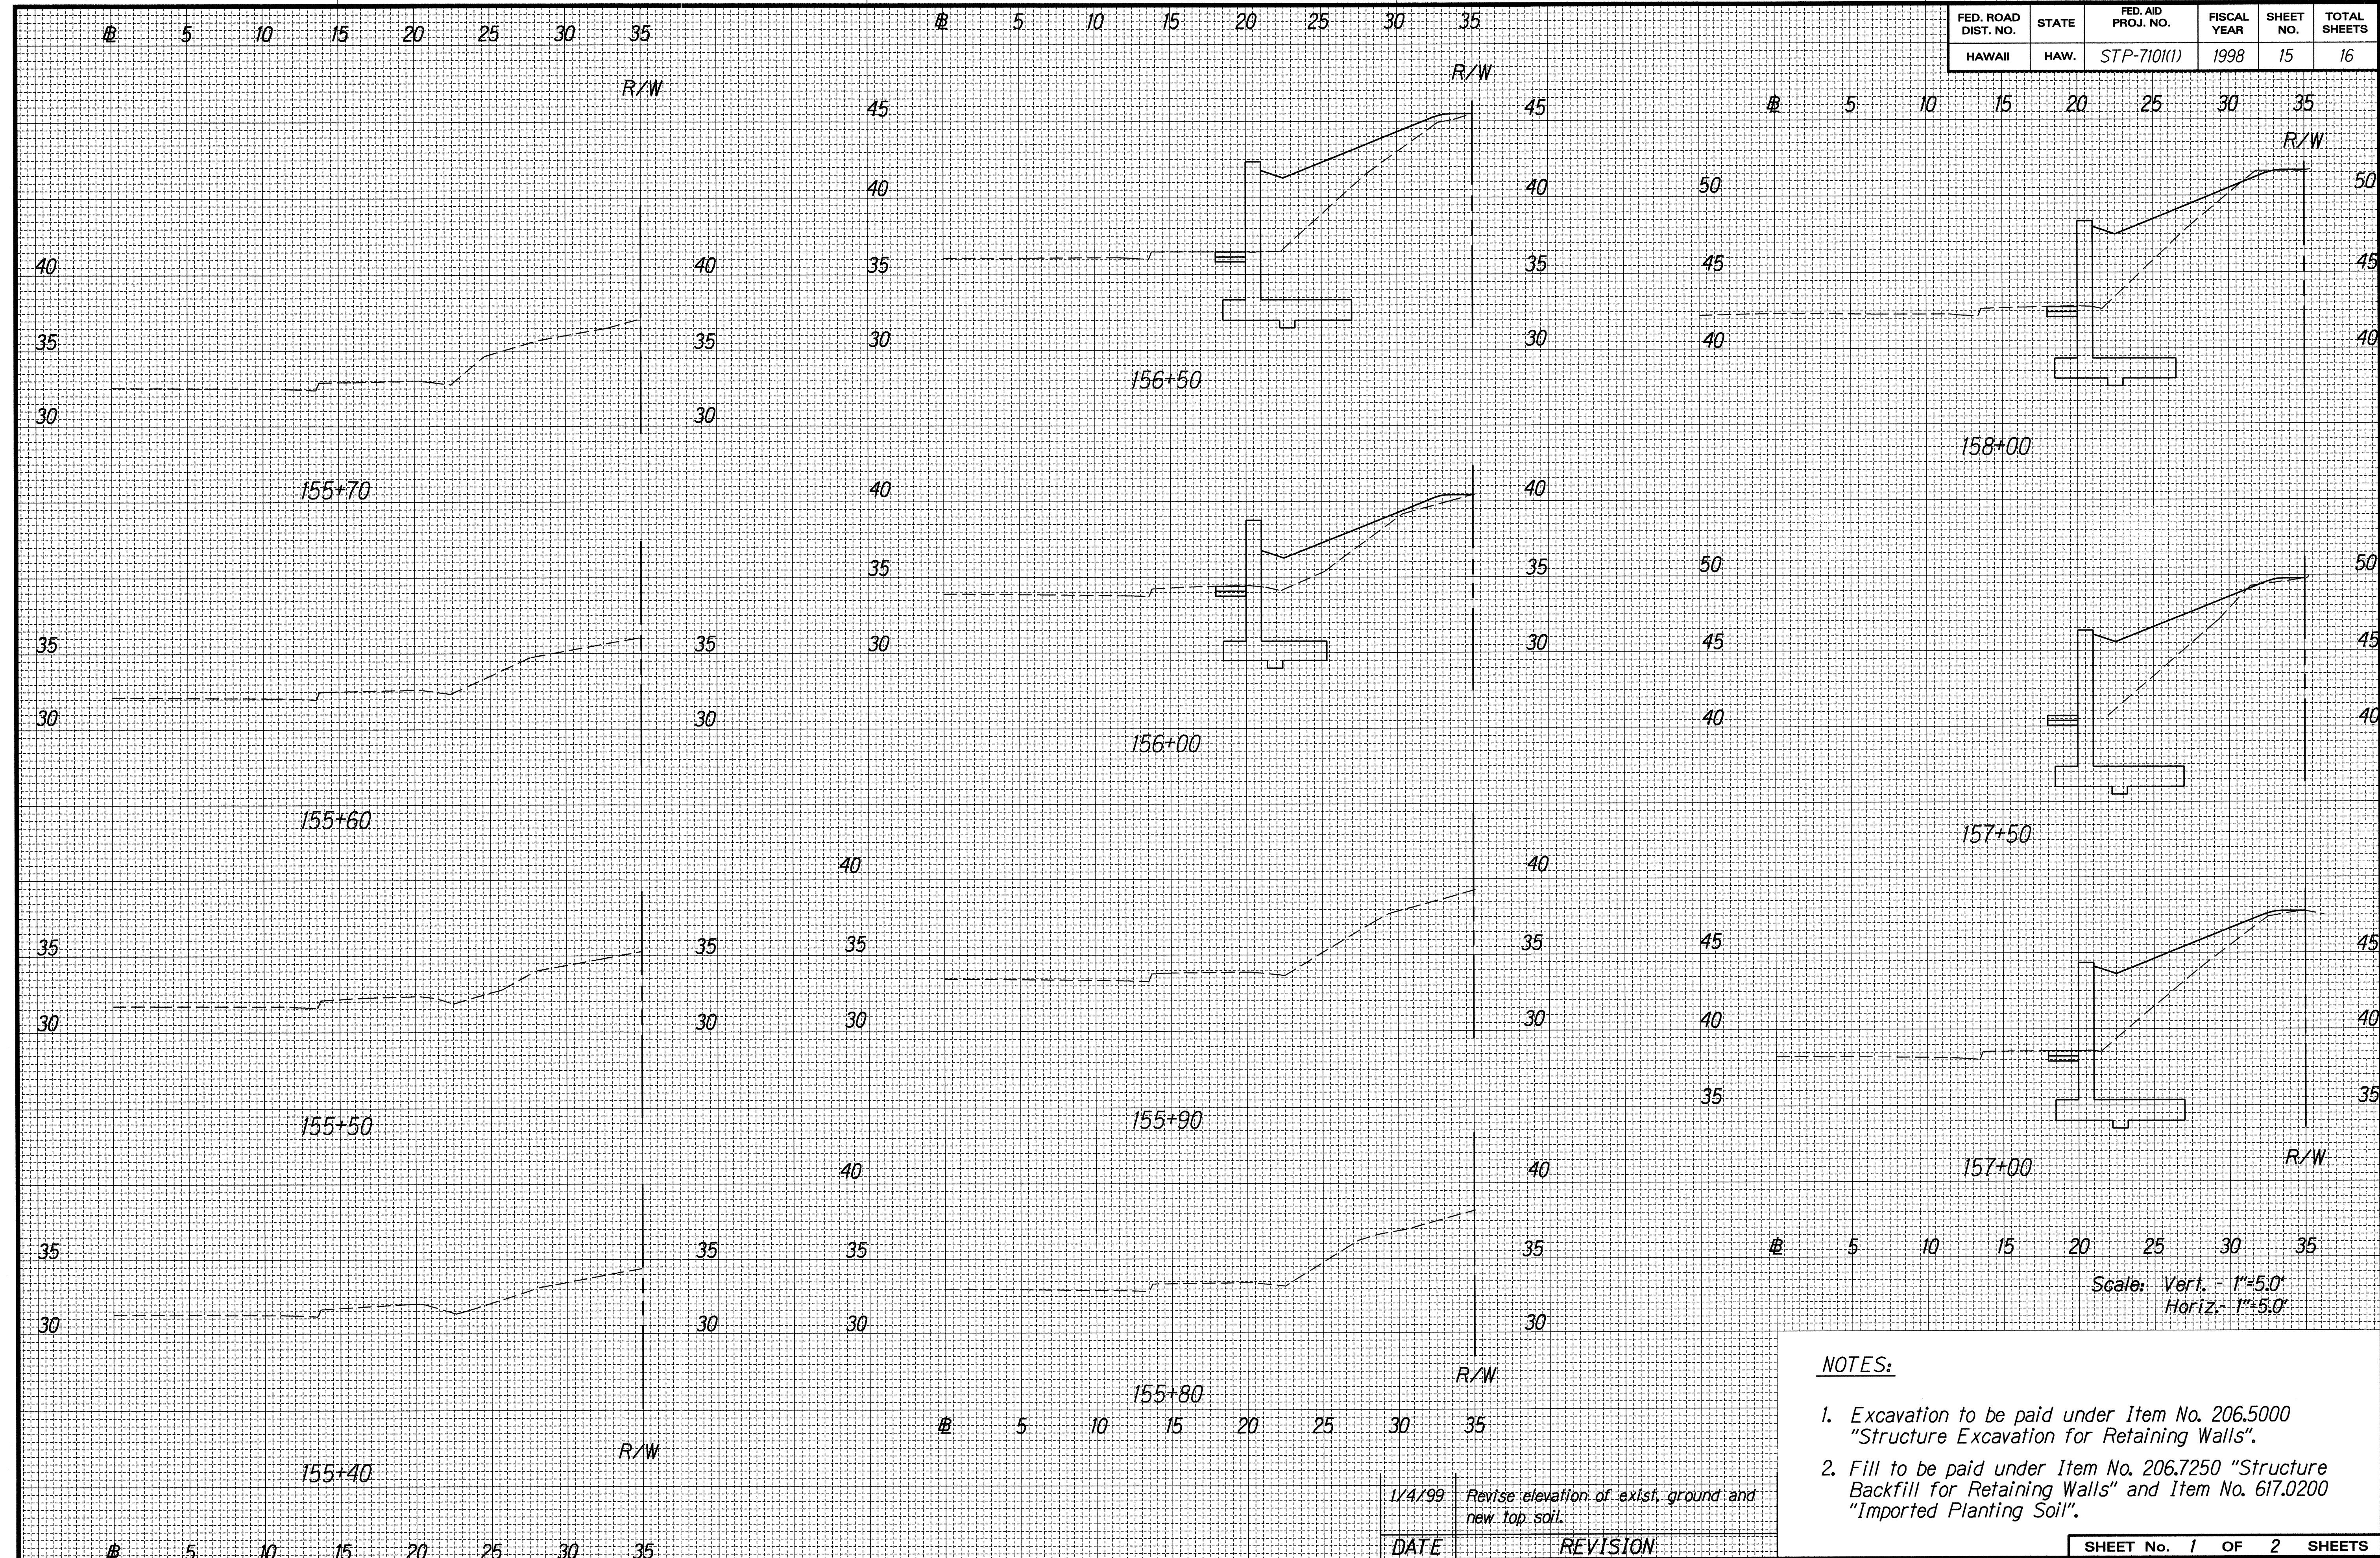

ORIGINAL PLAN	SURVEY PLOTTED BY	DATE
NOTE BOOK	DRAWN BY L. Miyoshi, MH	12/12/98
NOTES	TRACED BY B. Sauer	
QUANTITIES BY	CHECKED BY	

C.O. 15

FED. ROAD DIST. NO.	STATE	FED. AID PROJ. NO.	FISCAL YEAR	SHEET NO.	TOTAL SHEETS
HAWAII	HAW.	STP-710(1)	1998	16	16

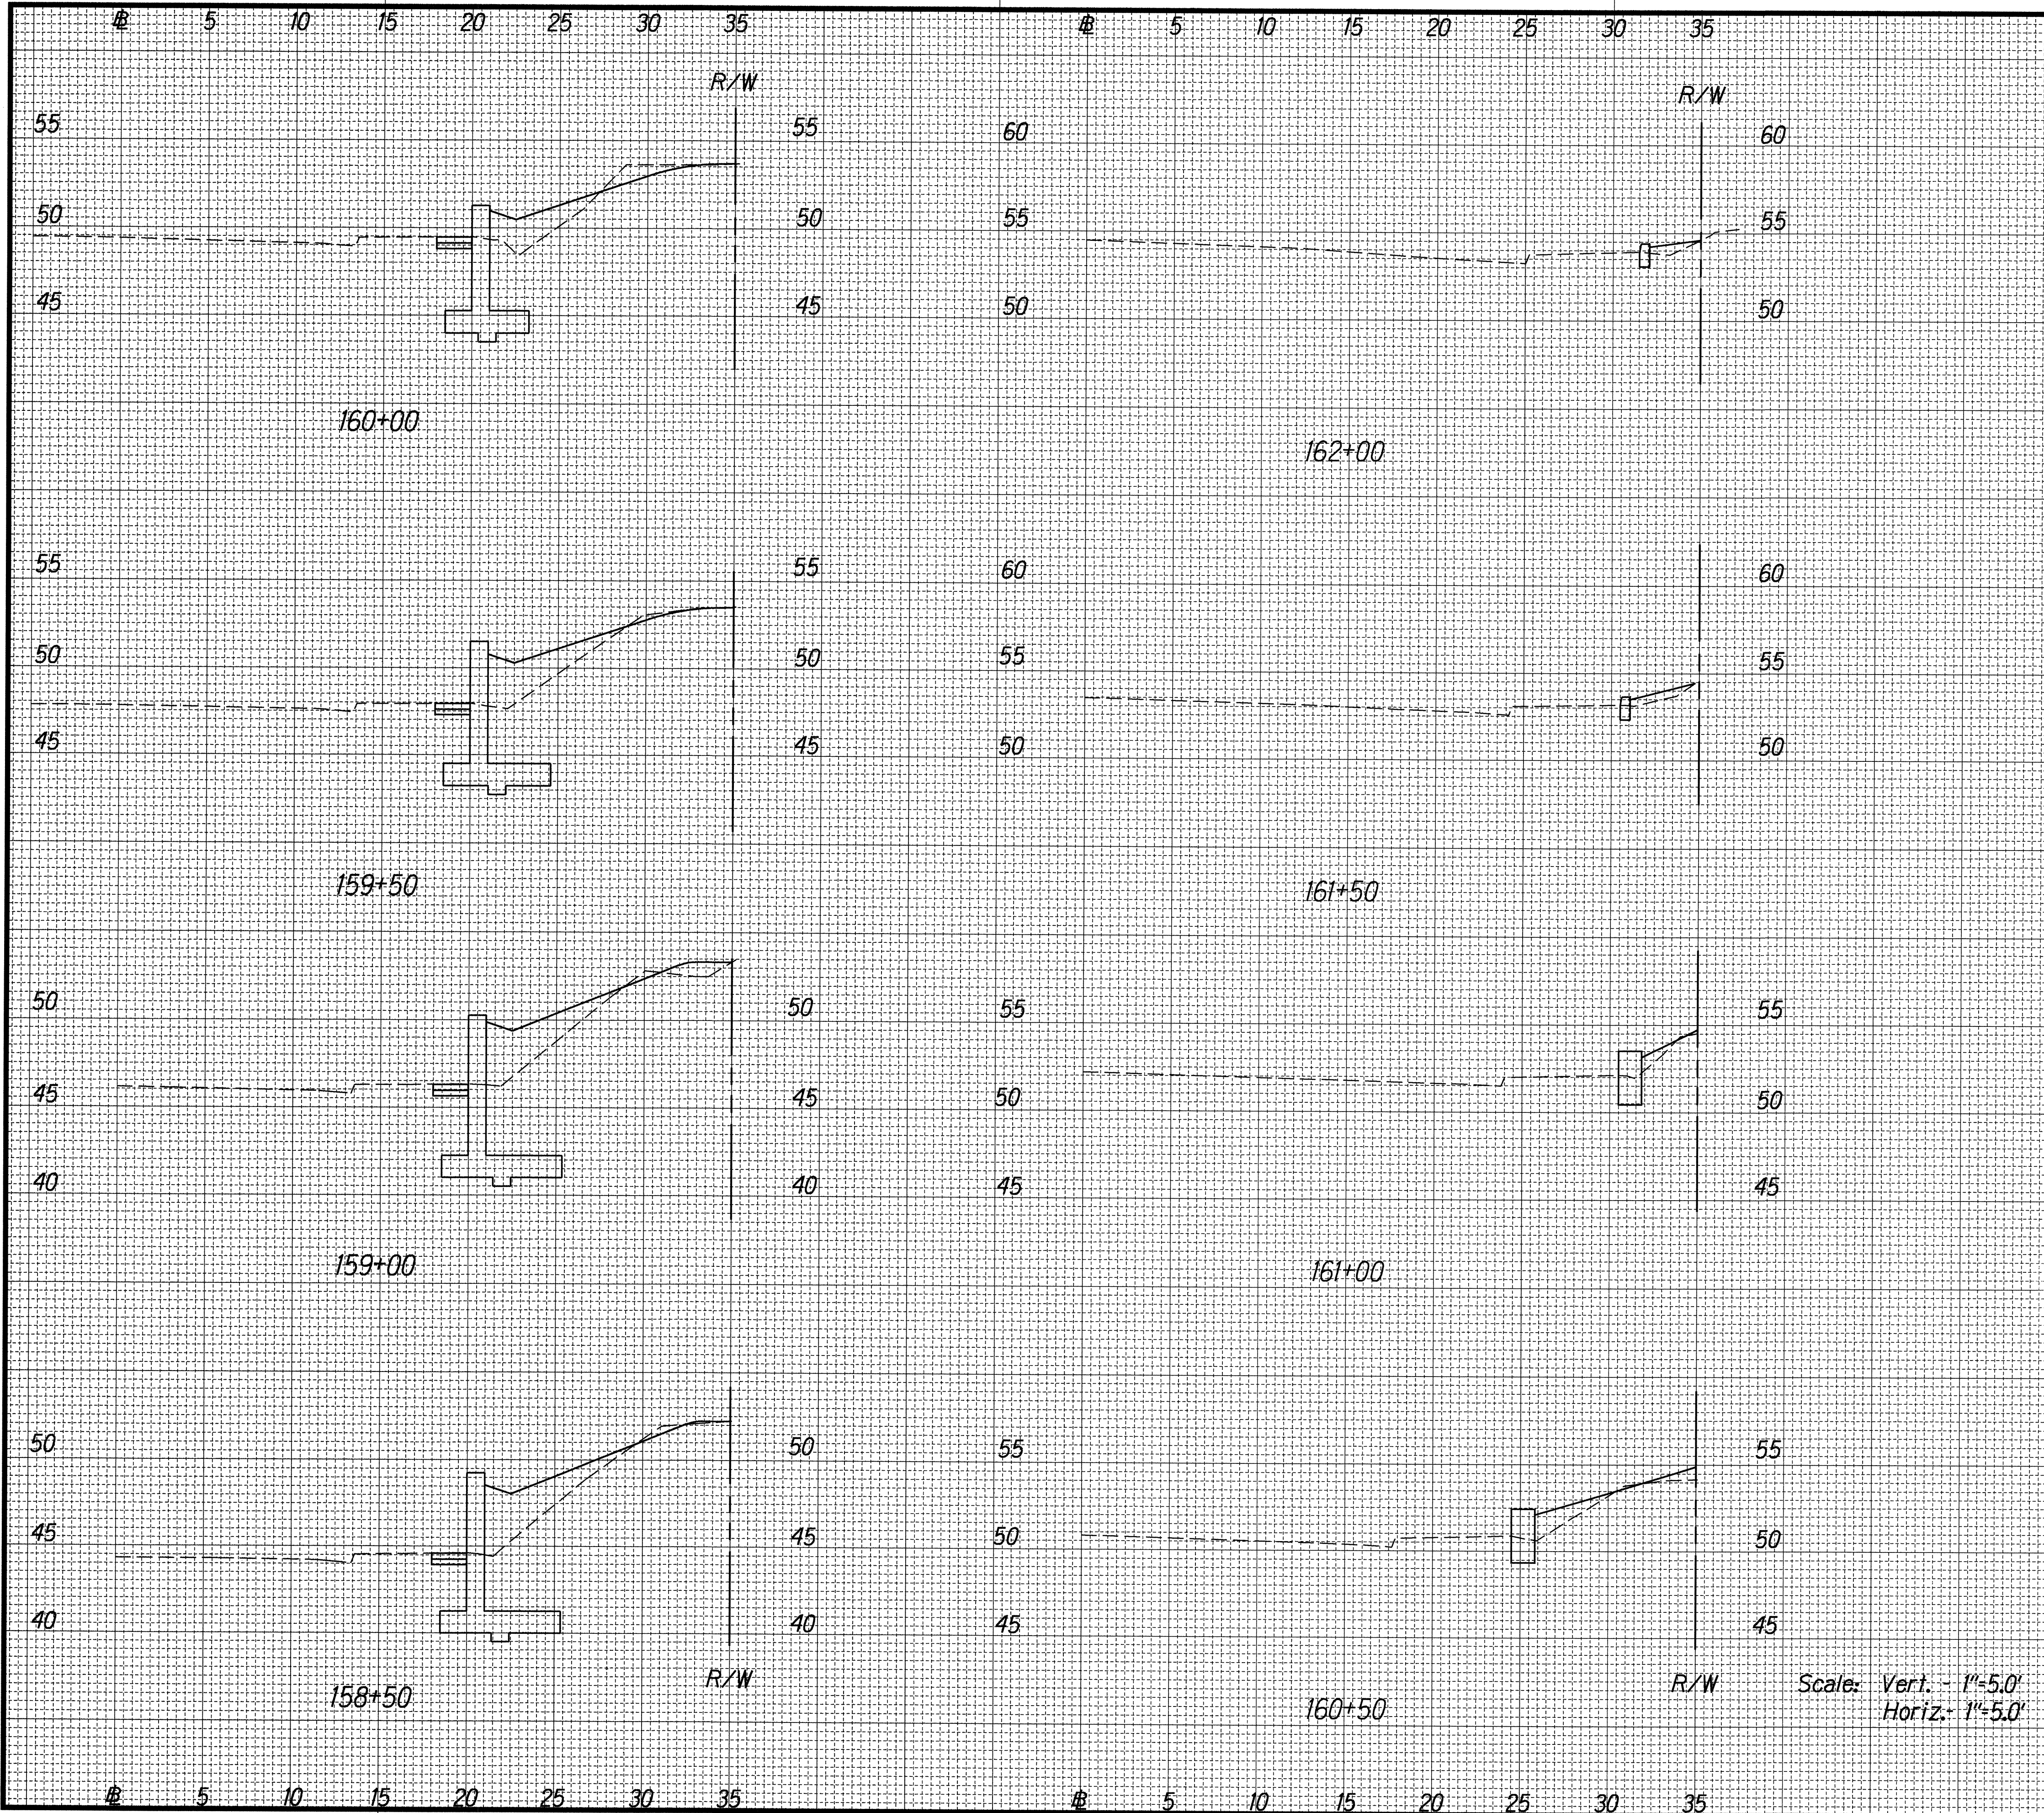

ORIGINAL PLAN	SURVEY PLOTTED BY	DATE
NOTE BOOK	DRAWN BY J. Miquel, M.E.	5/12/99
DESIGNED BY R. Sequeira		
QUANTITIES BY		
CHECKED BY		

1/4/99	Revise elevations of exist. ground and new top soil at Sta. 158+50 and Sta. 159+00.
DATE	REVISION

NOTES:

- Excavation to be paid under Item No. 206.5000 "Structure Excavation for Retaining Walls".
- Fill to be paid under Item No. 206.7250 "Structure Backfill for Retaining Walls" and Item No. 617.0200 "Imported Planting Soil".

Scale: Vert. - 1"=5.0'
Horiz. - 1"=5.0'