


INDEX TO DRAWINGS	
SHEET NO.	DESCRIPTION
1	TITLE SHEET
2	STANDARD PLANS SUMMARY
3	GENERAL NOTES AND LEGEND
4 - 6	CURB RAMPS DETAILS
7	TYPICAL SECTION
8	ROADWAY PLAN
9	PAVEMENT MARKING LEGEND, DETAILS & NOTES
10	PAVEMENT MARKING & SIGNING PLAN
11	SIGN MOUNTING DETAIL
12	TRAFFIC SUMMARIES
13	TRAFFIC SIGNAL LEGEND & NOTES
14	TRAFFIC SIGNAL PLAN
15	TRAFFIC SIGNAL DETAILS
16	METER PEDESTAL DETAIL
17	TRAFFIC SIGNAL DETAILS
18	PULL BOX AND COVER DETAILS
19	LOOP DETECTOR DETAILS


Sheet No. 03S-1 is a supplementary sheet to this project. Total sheet count after "As-Built" posting 20 shts.

UNIT "D" DESIGNED BY  
 K. TATSUGUCHI  
 P.S. & E. BY  
 692-7578  
 PHONE  
 DEC. 2000  
 DATE

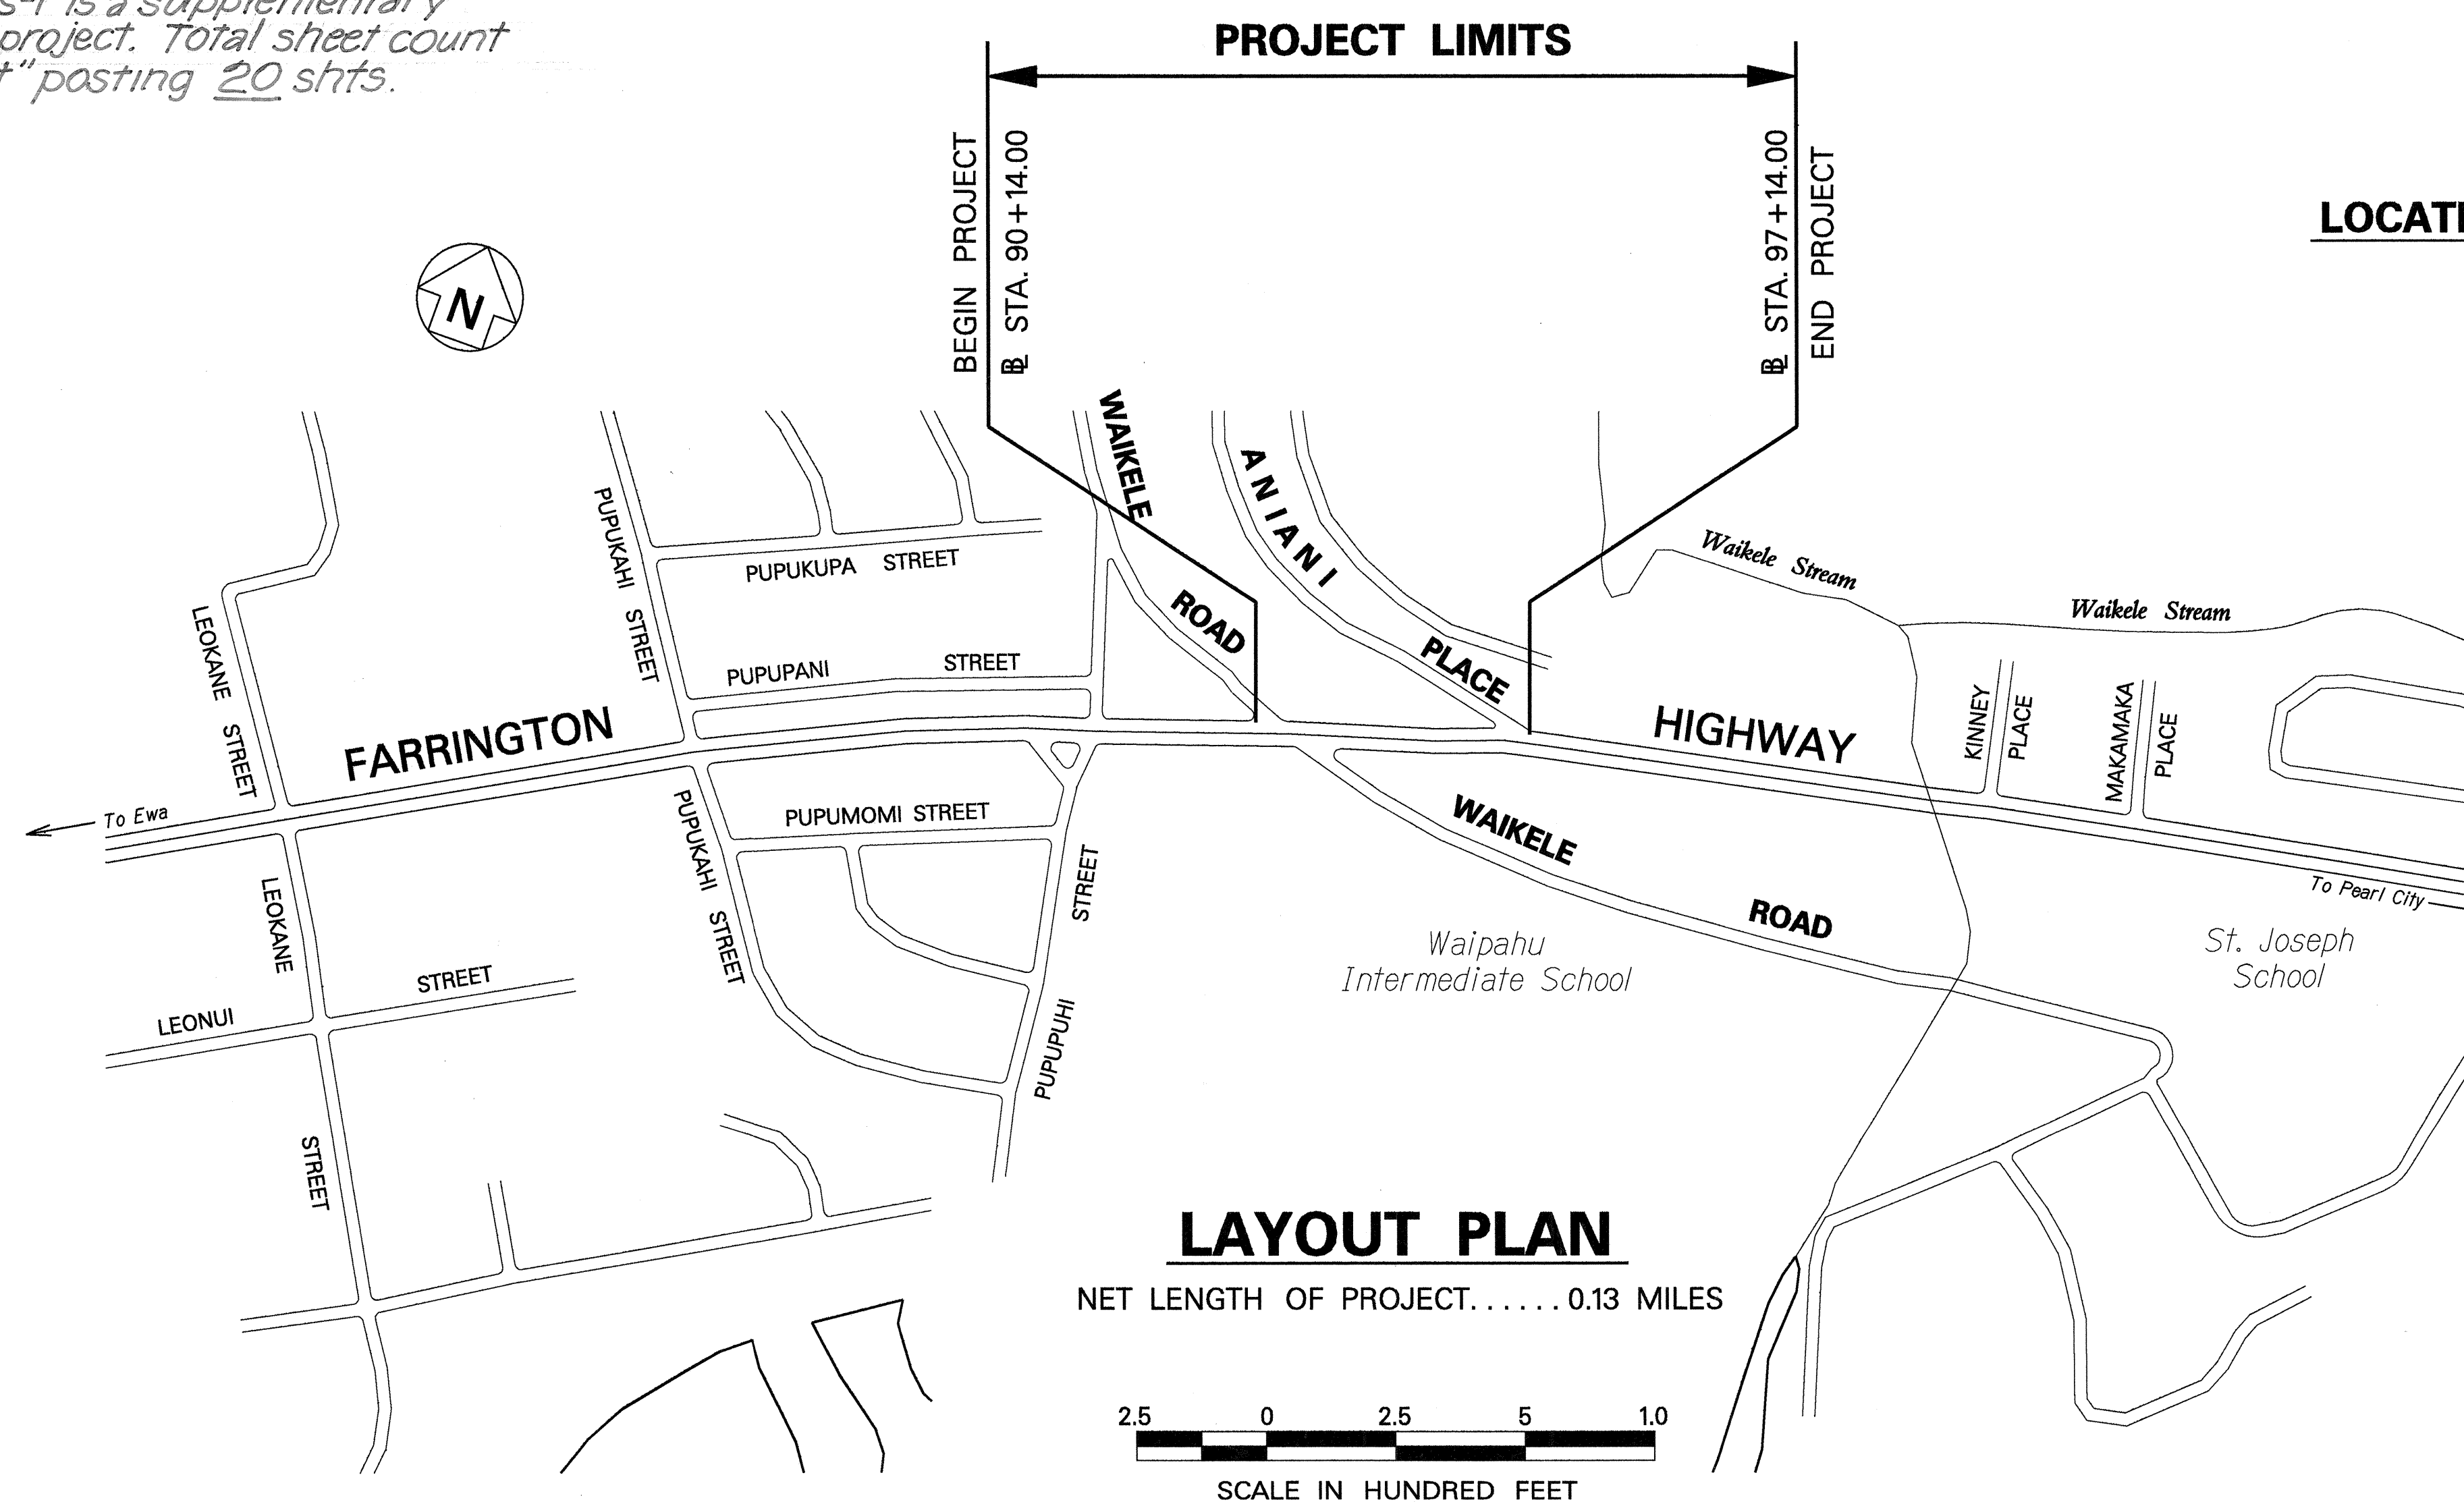

STATE OF HAWAII  
 DEPARTMENT OF TRANSPORTATION  
 HIGHWAYS DIVISION  
 HONOLULU, HAWAII  
 "AS-BUILT"  
 PLANS FOR  
**FARRINGTON HIGHWAY IMPROVEMENTS**  
 WAIKELE ROAD TO ANIANI PLACE  
**PROJECT NO. 7101A-01-00**

DISTRICT OF EWA  
 ISLAND OF OAHU

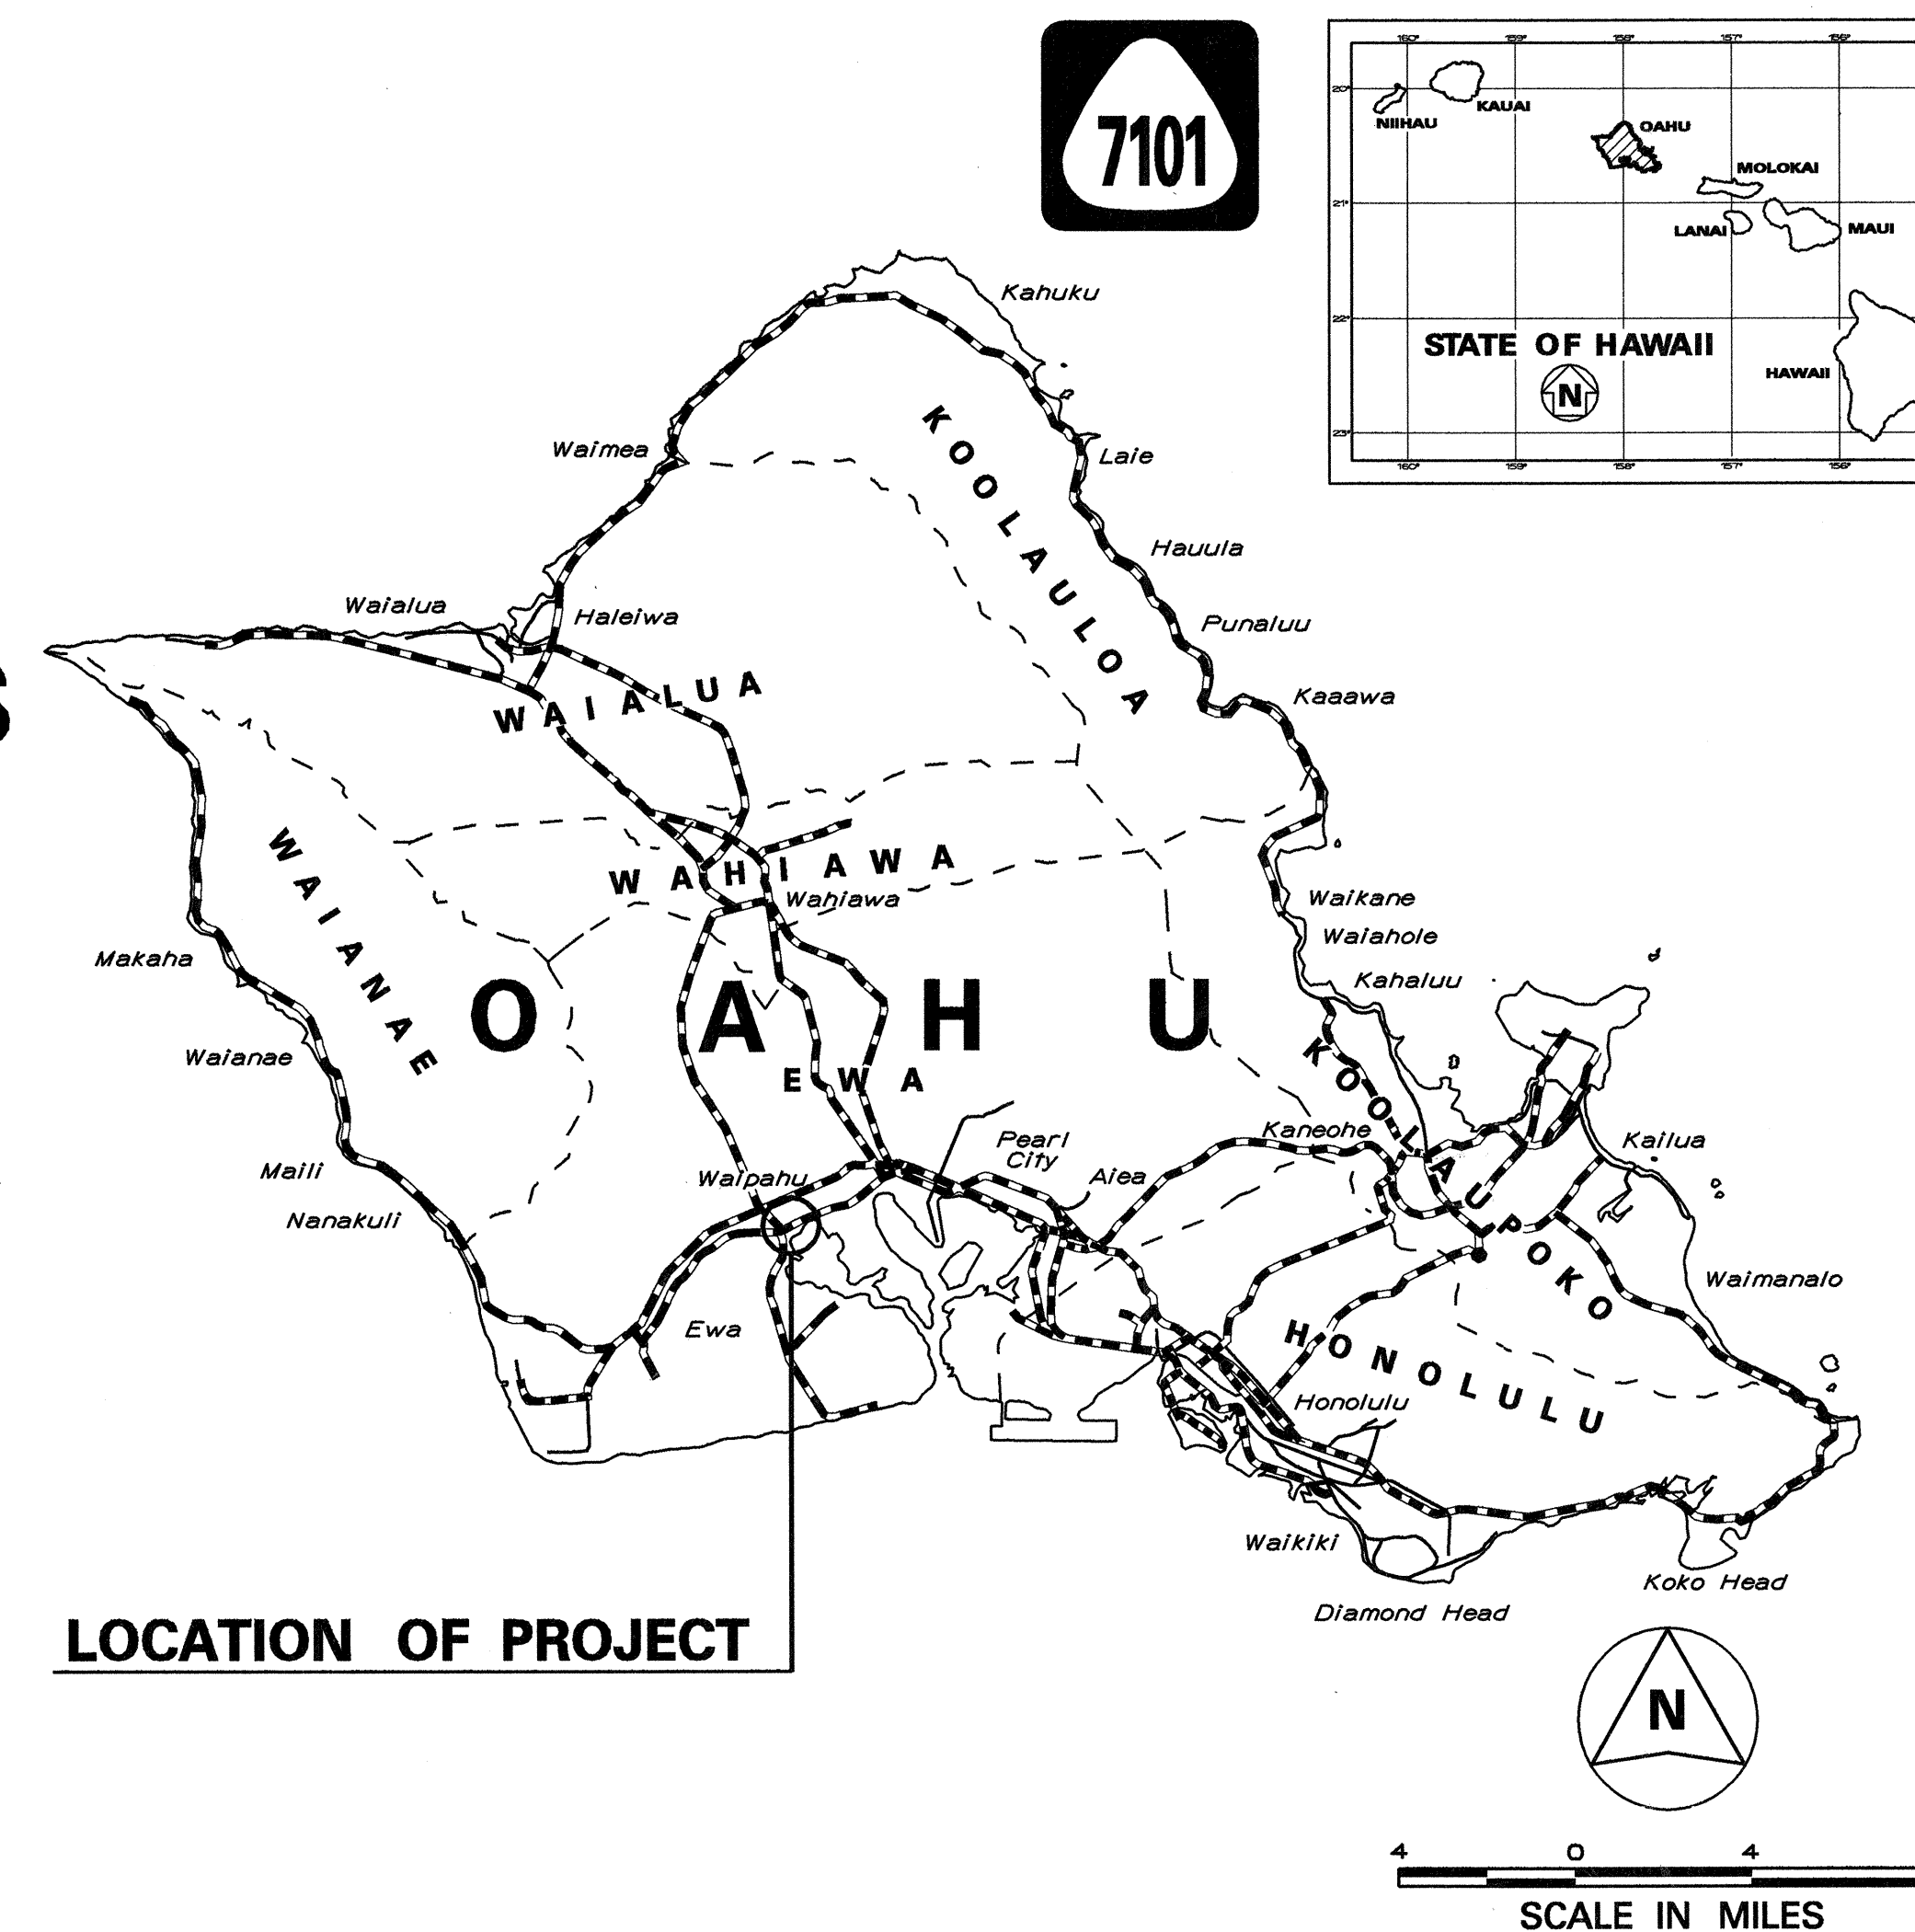

----- FEDERAL AID PROJECTS PREVIOUSLY CONSTRUCTED OR UNDER CONSTRUCTION

MILE POST 0.89 TO MILE POST 0.94

CHANGES MADE DURING CONSTRUCTION HAVE BEEN INCORPORATED IN THESE PLANS EXCEPT CHANGES IN THE ORIGINAL THEORETICAL QUANTITIES. FOR ACTUAL QUANTITIES, REFER TO PROJECT LEDGER AND/OR COMPUTATIONS.

DEPARTMENT OF TRANSPORTATION  
 STATE OF HAWAII  
 APPROVED:  
 [Signature]  
 DIR. OF TRANSPORTATION  
 DATE 3-12-01