

TRAFFIC SIGNAL NOTES

1. The locations of the Traffic Signal Standards, Traffic Signal Standards w/Mast Arms, Pedestrian Push Buttons, Traffic Controller, Pullboxes, Conduits and Loop Detectors shall be staked out in the field by the Contractor and approval of the locations shall be obtained from the Engineer prior to construction and installation.
2. All splicing shall be done in the pullboxes.
3. Furnishing and installing the conduit stubouts (pullboxes to edge of pavement) will not be paid for separately but shall be considered incidental to the various contract items.
4. A solid #8 bare copper wire shall be pulled with the traffic signal control cable for equipment ground. Cost shall be incidental to the installation of the control cable.
5. All Traffic signal controller equipment shall be completely wired in the cabinet and shall control the traffic signals as called for in the plans.
6. The loop amplifier units furnished for this project shall be capable of operating the loop detector configurations shown on the plans. Cost for the loop amplifier shall be incidental to the installation of the loop detector.
7. Should any defect be encountered during the warranty period, the manufacturer will be notified and he shall promptly correct such defect. Service call (by factory qualified representative) during the warranty period for repairs or other maintenance shall be answered within 24 hours and shall be done at no expense to the State. All repairs shall be done as soon as possible.
8. All traffic signal work shall conform to the requirements of the "Manual On Uniform Traffic Control Devices For Streets And Highways", Federal Highway Administration (1988) and Amendments.
9. Locations of traffic markings and markers (lane lines, Stop lines, crosswalk, etc.) shown on the plans shall be verified with the Engineer prior to the installation of the traffic signal system.
10. All Conduits between pullboxes and Traffic Signal/Highway Lighting Standards shall not be paid for separately but shall be considered incidental to the various contract items.
11. All Signal-Drop Cables (Type 5 Cables) from the various Types of Traffic Signal Head on the traffic signal standards and mast arms to the pullboxes shall not be paid for separately but considered incidental to the Traffic Signal Head.
12. After installing all the traffic signal cables, the Contractor shall duct seal all conduits in the pullboxes, traffic signal standards and traffic signal controller cabinet concrete base. The duct seal material shall be approved by the Traffic Signal Inspector/Engineer and shall not be paid for separately but considered incidental to the direct buried and/or concrete encased conduits.
13. After installing the Traffic Signal System, the Contractor shall apply grease to all parts of the Traffic Signal System (i.e. fittings, brackets, nipples, elbows, screws, signal head assemblies, bolts, hinges, etc.) as directed by the Traffic Signal Inspector, to prevent rust and corrosion. The grease material shall be approved by the Signal Inspector.
14. Connecting into existing traffic signal system and making all necessary adjustments shall not be paid for separately, but considered incidental to the various traffic signal contract items.
15. The Contractor shall notify the Traffic Signal Branch, Department of Transportation Services, City & County of Honolulu, (phone no. 527-5007) two weeks prior to commencing any work on the traffic signal system.

TRAFFIC SIGNAL NOTES (CONTINUED)

16. The Department of Transportation Services, City & County of Honolulu, will assist the Engineer in construction inspection for the traffic signal system. The Contractor shall notify the Electrical and Maintenance Services Division, Department of Transportation Services, ten (10) working days prior to commencing work on the traffic signal system (phone no. 527-5007).

TRAFFIC SIGNAL LEGEND

NEW	EXISTING	
		Traffic Signal Conduit
		Conduit Run Numbers
		Equipment description, installation or item no.
		Traffic Signal Master Controller Door Indicates Front of Cabinet
		Traffic Signal Controller Door Indicates Front of Cabinet
		Meter Pedestal
		12" RYG Traffic Signal Head
		12" RY↑ Traffic Signal Head
		12" RY← Traffic Signal Head
		12" RY← Traffic Signal Head (Programmed Visibility)
		12" RYG ← ^G / _Y Fiber Optic Traffic Signal Head
		Type I Standard and Attached Signals
		Type II Standard with Signal Mast Arm and Attached Signals (Nos. indicates mast arm length & distance between signal heads as specified on plans)
		Type III Standard with Luminaire and Signal Mast Arm and Attached Signals (Nos. indicates mast arm lengths & distance between signal heads as specified on plans)
		Flashing Beacon, One Signal Section, "Y" indicates 12" Yellow Lens
		Opticom Receiver (Arrow indicates direction detector faces)
		Pipe Guard
		Pedestrian Signal Head
		Type A Pullbox
		Type B Pullbox
		Type C Pullbox

HIGHWAY LIGHTING LEGEND

NEW	EXISTING	
		Highway Lighting Conduit
		Type A Pullbox (Hwy. Ltg.)
		Highway Lighting Standard

ORIGINAL PLAN	SURVEY PLOTTED BY	DATE
NOTE BOOK	DESIGNED BY	
Field Notes	QUANTITIES BY	
Revisions	CHECKED BY	

STATE OF HAWAII
DEPARTMENT OF TRANSPORTATION
HIGHWAYS DIVISION
**TRAFFIC SIGNAL LEGEND
AND NOTES**
FARRINGTON HIGHWAY IMPROVEMENT
Waialeale Road to Aniani Place
Project No. 7101A-01-00
Date: Sept., 2000
SHEET No. T5 OF 11 SHEETS

ADDITIONAL TRAFFIC SIGNAL NOTES:

- Existing Traffic Signal Pullboxes and Conduits shall remain in place unless noted on the Plans.
- All Existing Traffic Signal Cables not part of the new Traffic Signal System shall be removed and disposed of.
- All Removal, Disposal, and/or Salvaging of Existing Traffic Signal Controller, Cabinet, Standards, Mast Arms, Signal & Pedestrian Heads, Pullboxes, Conduits, and Cables shall not be paid for separately but shall be considered incidental to the various Contracts Items.
- All Existing Foundations to be removed shall be demolished 12" below Existing Grade and matched to existing. This work shall be considered incidental to the various Contract Items.


- Contractor shall deliver all salvagable Traffic Signal materials/equipment to the City and County of Honolulu Baseyard as directed by the Engineer.
- See Sheet T7 for List of Materials to install, remove, dispose and/or salvage.
- Removal of Existing Traffic Signal System and Median Concrete Slab at Sta. 91+00 to be done after the New Traffic Signal System is operational.

- Contractor shall coordinate with HECO for connection between Power source and Meter. The cost of this work shall be considered incidental to the various Contract Items.


FED. ROAD DIST. NO.	STATE	FED. AID PROJ. NO.	FISCAL YEAR	SHEET NO.	TOTAL SHEETS
HAWAII	HAW.	7101A-01-00	2001	14	19

LEGEND FOR AS-BUILT POSTINGS

	Squiggly line for as-built deletion
	Double line for as-built deletion
Roadway	Text for as-built posting

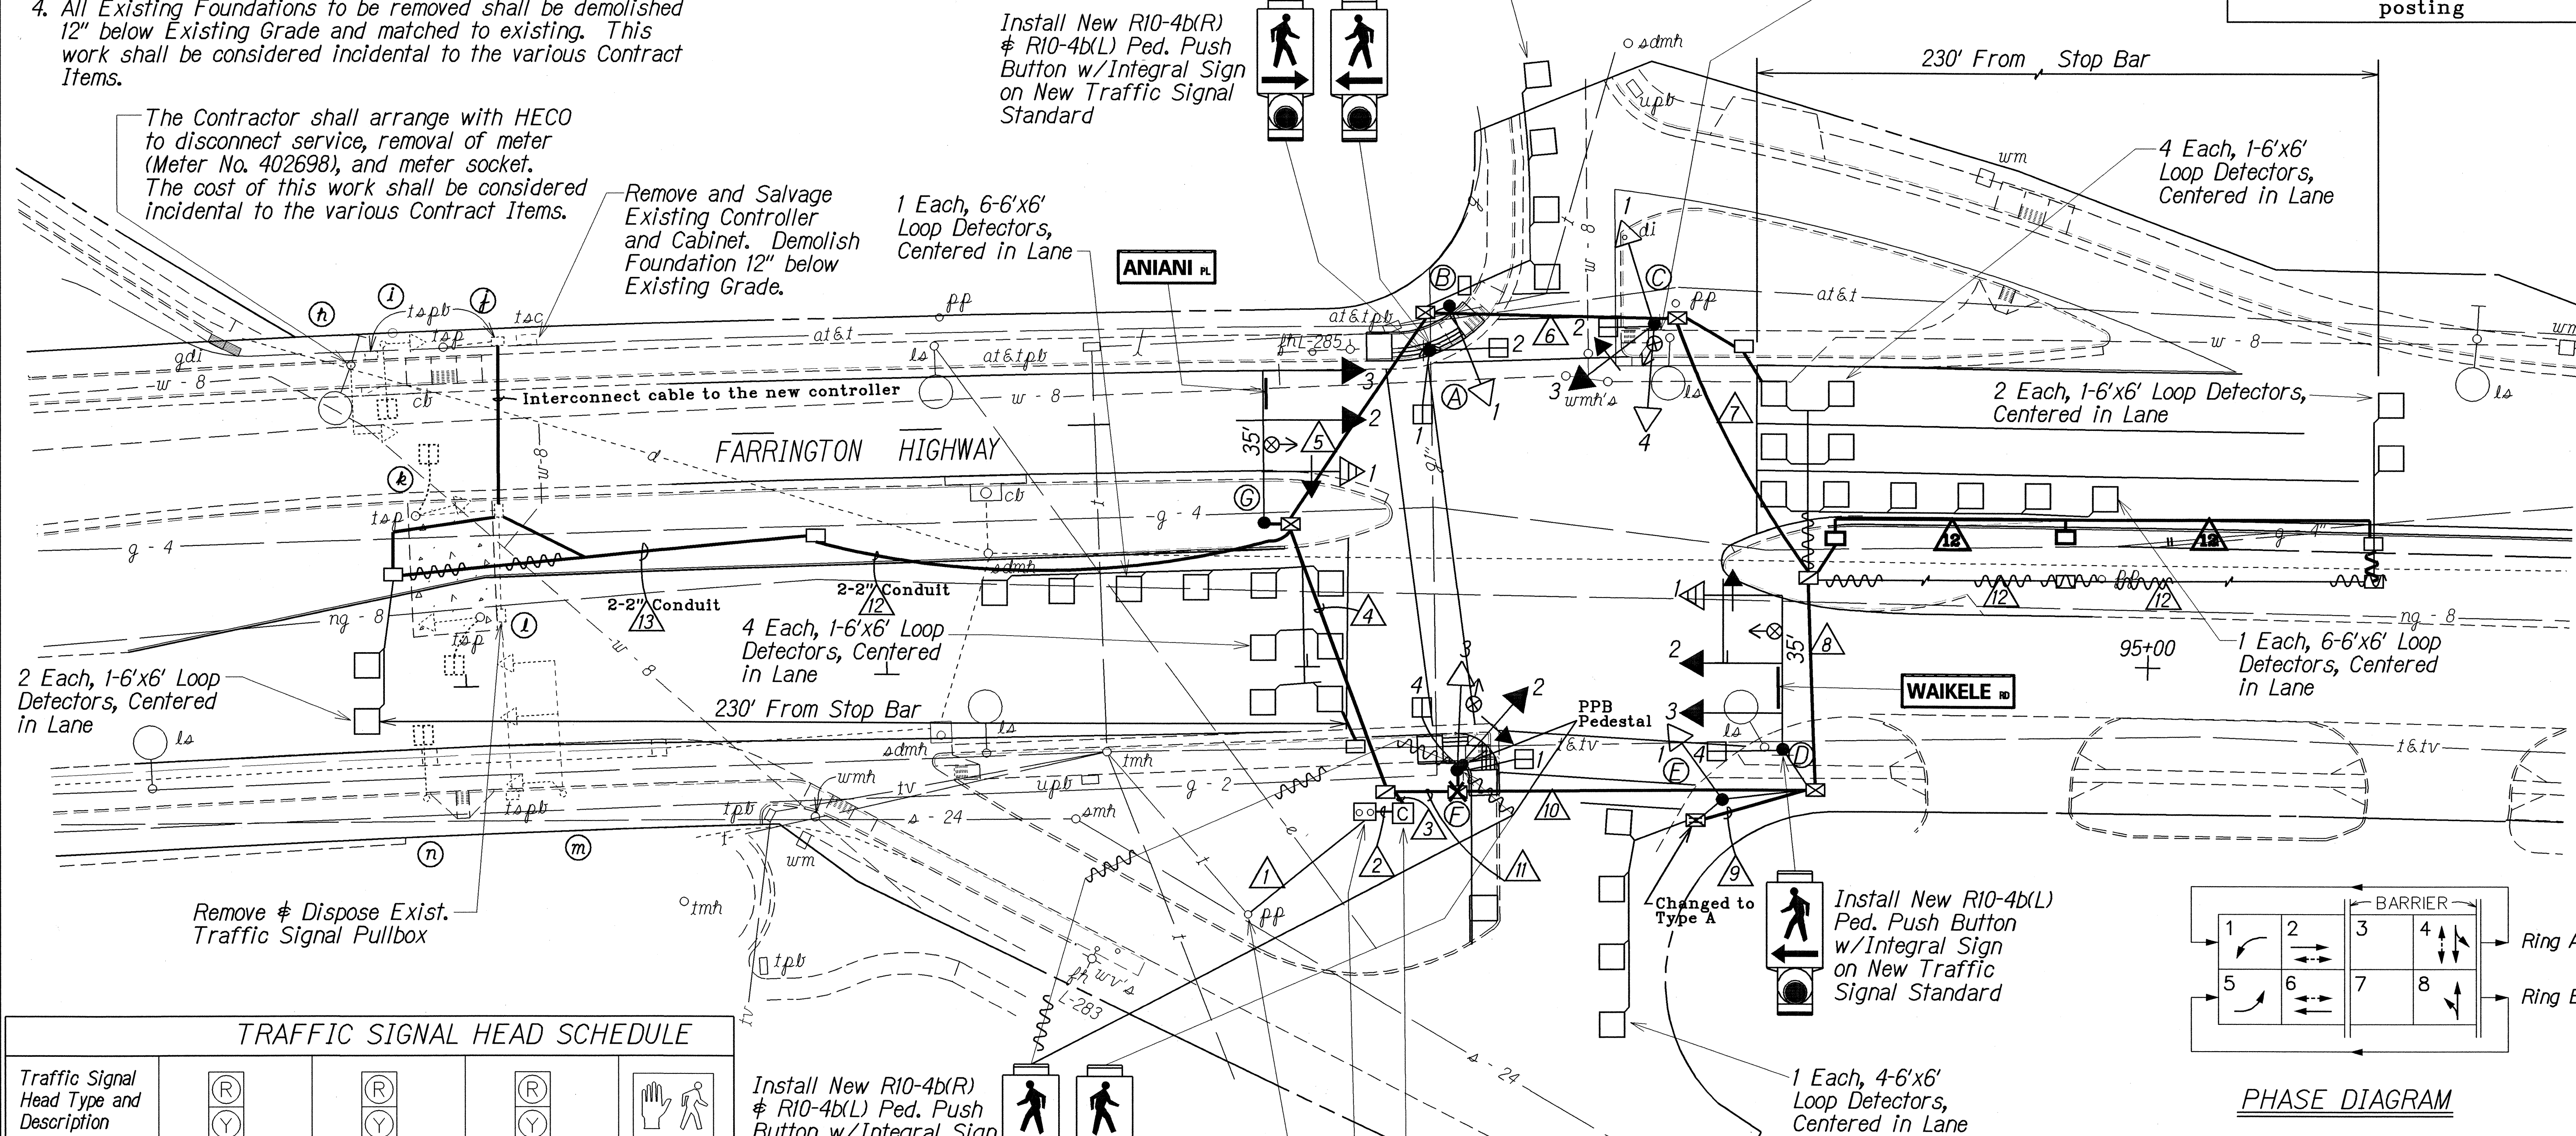

TRAFFIC SIGNAL HEAD SCHEDULE				
Traffic Signal Head Type and Description				
	12" RYG Traffic Signal Head	12" RYG Traffic Signal Head	12" RYG Traffic Signal Head	Pedestrian Signal Head
Pole Letter	B-1	D-2	C-3	A-1
Signal Head	C-1	D-3	*D-1	A-2
Number	C-4	G-2	F-2	C-2
	E-1	G-3	*G-1	D-4
	F-3			F-1
				F-4

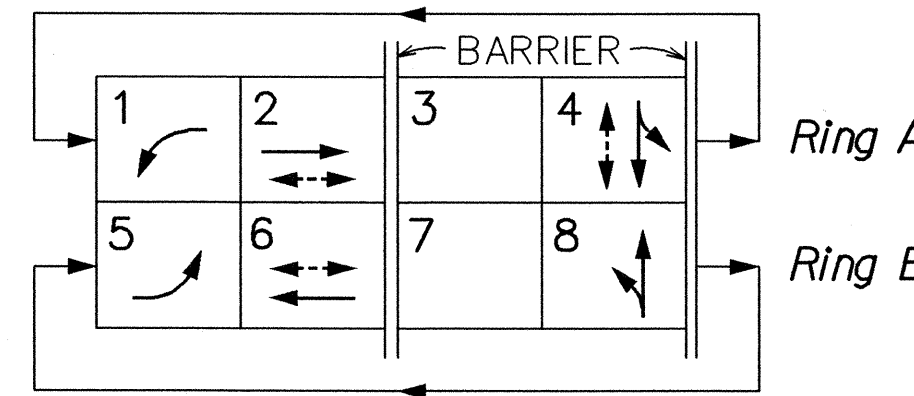

PHASE DIAGRAM

STATE OF HAWAII
DEPARTMENT OF TRANSPORTATION
HIGHWAYS DIVISION

TRAFFIC SIGNAL PLAN

*Farrington Highway Improvements
Waikale Road to Aniani Place
Project No. 7101A-01-00*

Scale: 1"=20' Date: Sept., 2001

SHEET No. T6 OF 11 SHEETS


DATE	
SURVEY PLOTTED BY	
DRAWN BY	
DESIGNED BY	
CHECKED BY	
NOTE BOOK	
10/2/01	
10/2/01	
10/2/01	

9/24/01	Revise pole D & G and Add pole E. Revise schedule and note title.
DATE	REVISION

FED. ROAD DIST. NO.	STATE	PROJ. NO.	FISCAL YEAR	SHEET NO.	TOTAL SHEETS
HAWAII	HAW.	7101A-01-00	2001	15	19

STATE RIGHT-OF-WAY BACKFILL NOTES

*Trench Backfill Material "A"
Beach Sand, Earth, or Earth
and Gravel. If Earth and Gravel
used, the maximum shall contain
not more than 50% by volume of
rock particles. Maximum 8" loose
fill per lift. Obtain 95% compaction
for each lift.*




Concrete
3000 psi compressive strength
@ 3 days.

NOTE: Base Course & Sub-Base Course per
1994 State Standard Specifications
for Highway Construction.


GENERAL NOTES

1. If trench is located on unpaved area, the Contractor shall replace 10" A.C. Base Course and 4" A.C. Pavement with Type "A" backfill material.
2. The Metal Detectable Red Plastic Warning Tape shall be a minimum 5 mils thick and 4" wide with a continuous metallic backing and corrosion resistant 1± mil thick foil core. The message on the tape shall read, "CAUTION - STATE TRAFFIC SIGNAL AND/OR HWY LIGHTING BURIED BELOW," utilizing 1½ inches series "C" black lettering. The message will be repeated with a 4¼" spacing between top line of message and start of next repeat.
3. The Contractor may begin backfilling the conduit trench when the concrete reaches 3000 psi compressive strength after 3 days.
4. Maximum four (4) Conduits per row for multiple conduit duct section.
5. For direct buried duct sections, the concrete jacket required at the conduit by-pass for various utilities, shall not be paid for separately but considered incidental to the direct buried conduits.
6. After installing all the traffic signal cables, the Contractor shall duct seal all conduits in the pullboxes, traffic signal standards and traffic signal controller cabinet concrete base. The duct seal material shall be approved by the Traffic Signal Inspector/Engineer and shall not be paid for separately but considered incidental to the direct buried and/or concrete encased conduits.

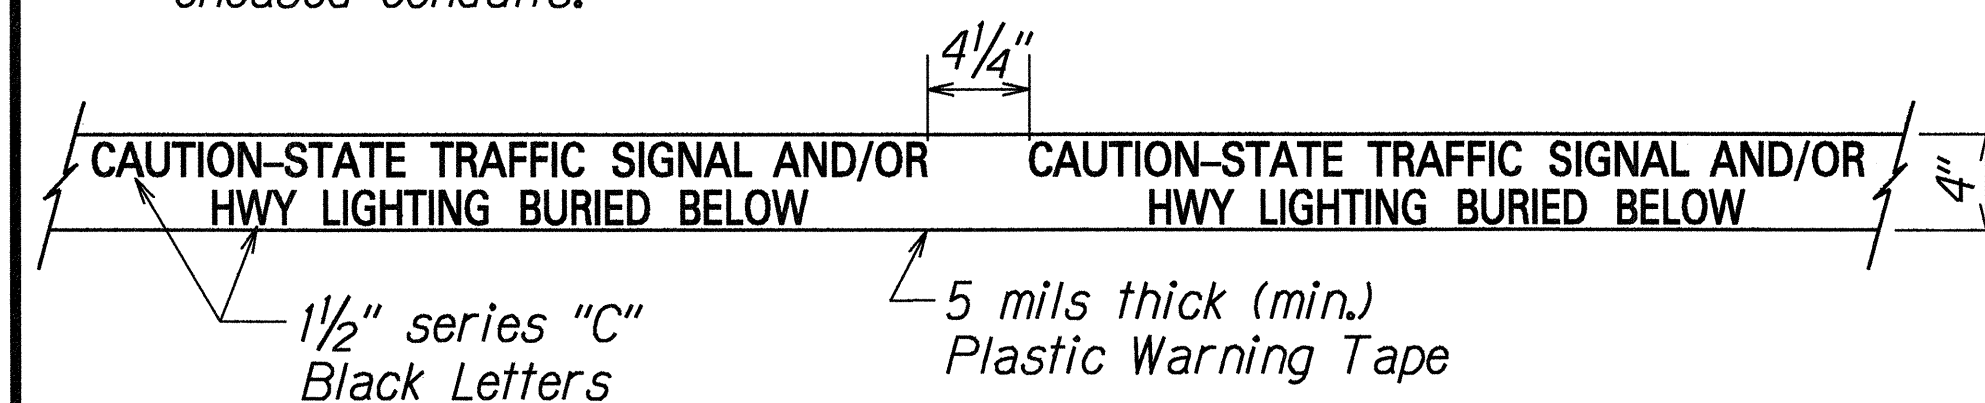


For additional information see note no. 2.

METAL DETECTABLE RED PLASTIC WARNING TAPE

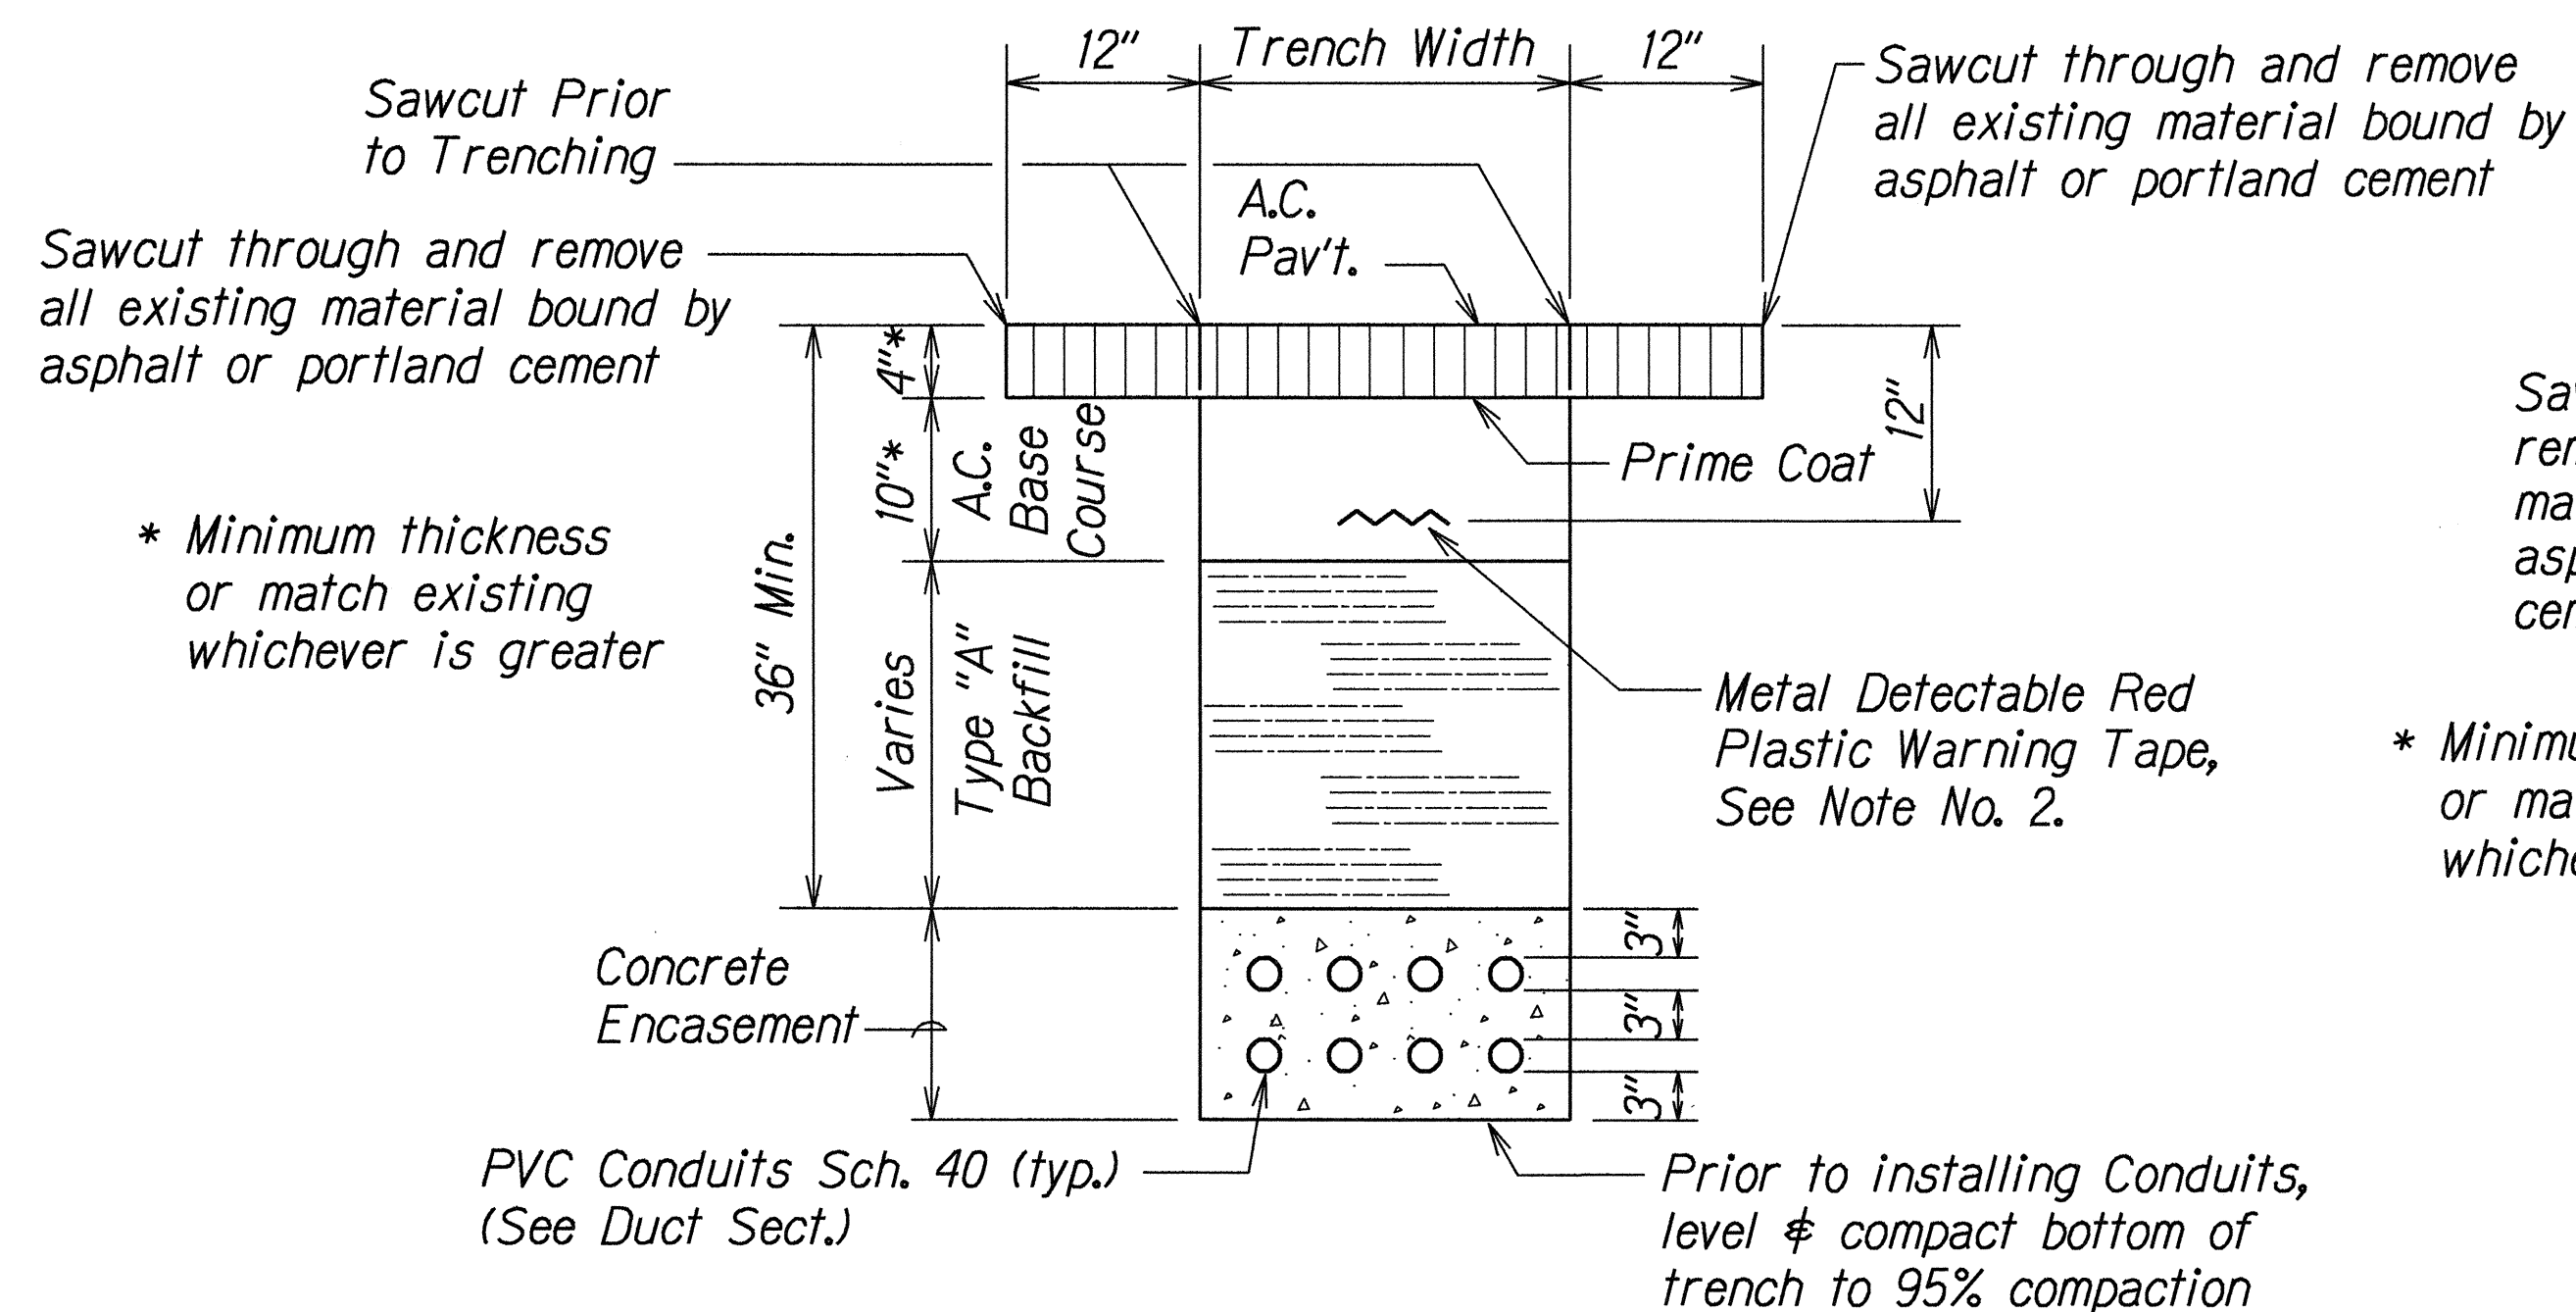


① TYPICAL BACKFILL SECTION
WITH CONCRETE ENCASED DUCTS

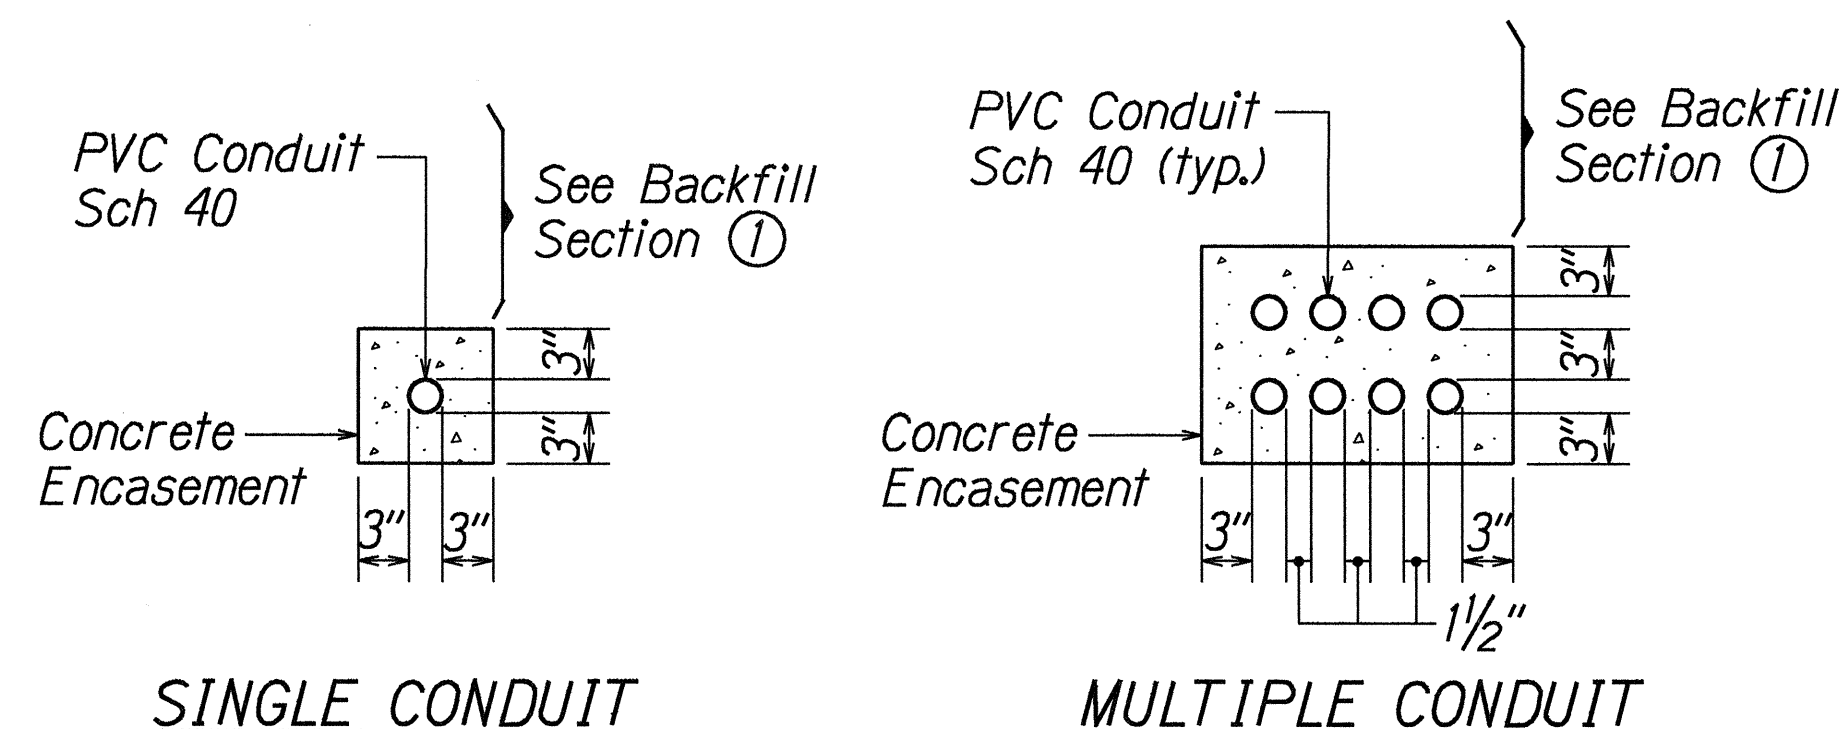


SINGLE CONDUIT

MULTIPLE CONDUIT

DUCT SECTIONS - CONC. ENCASED

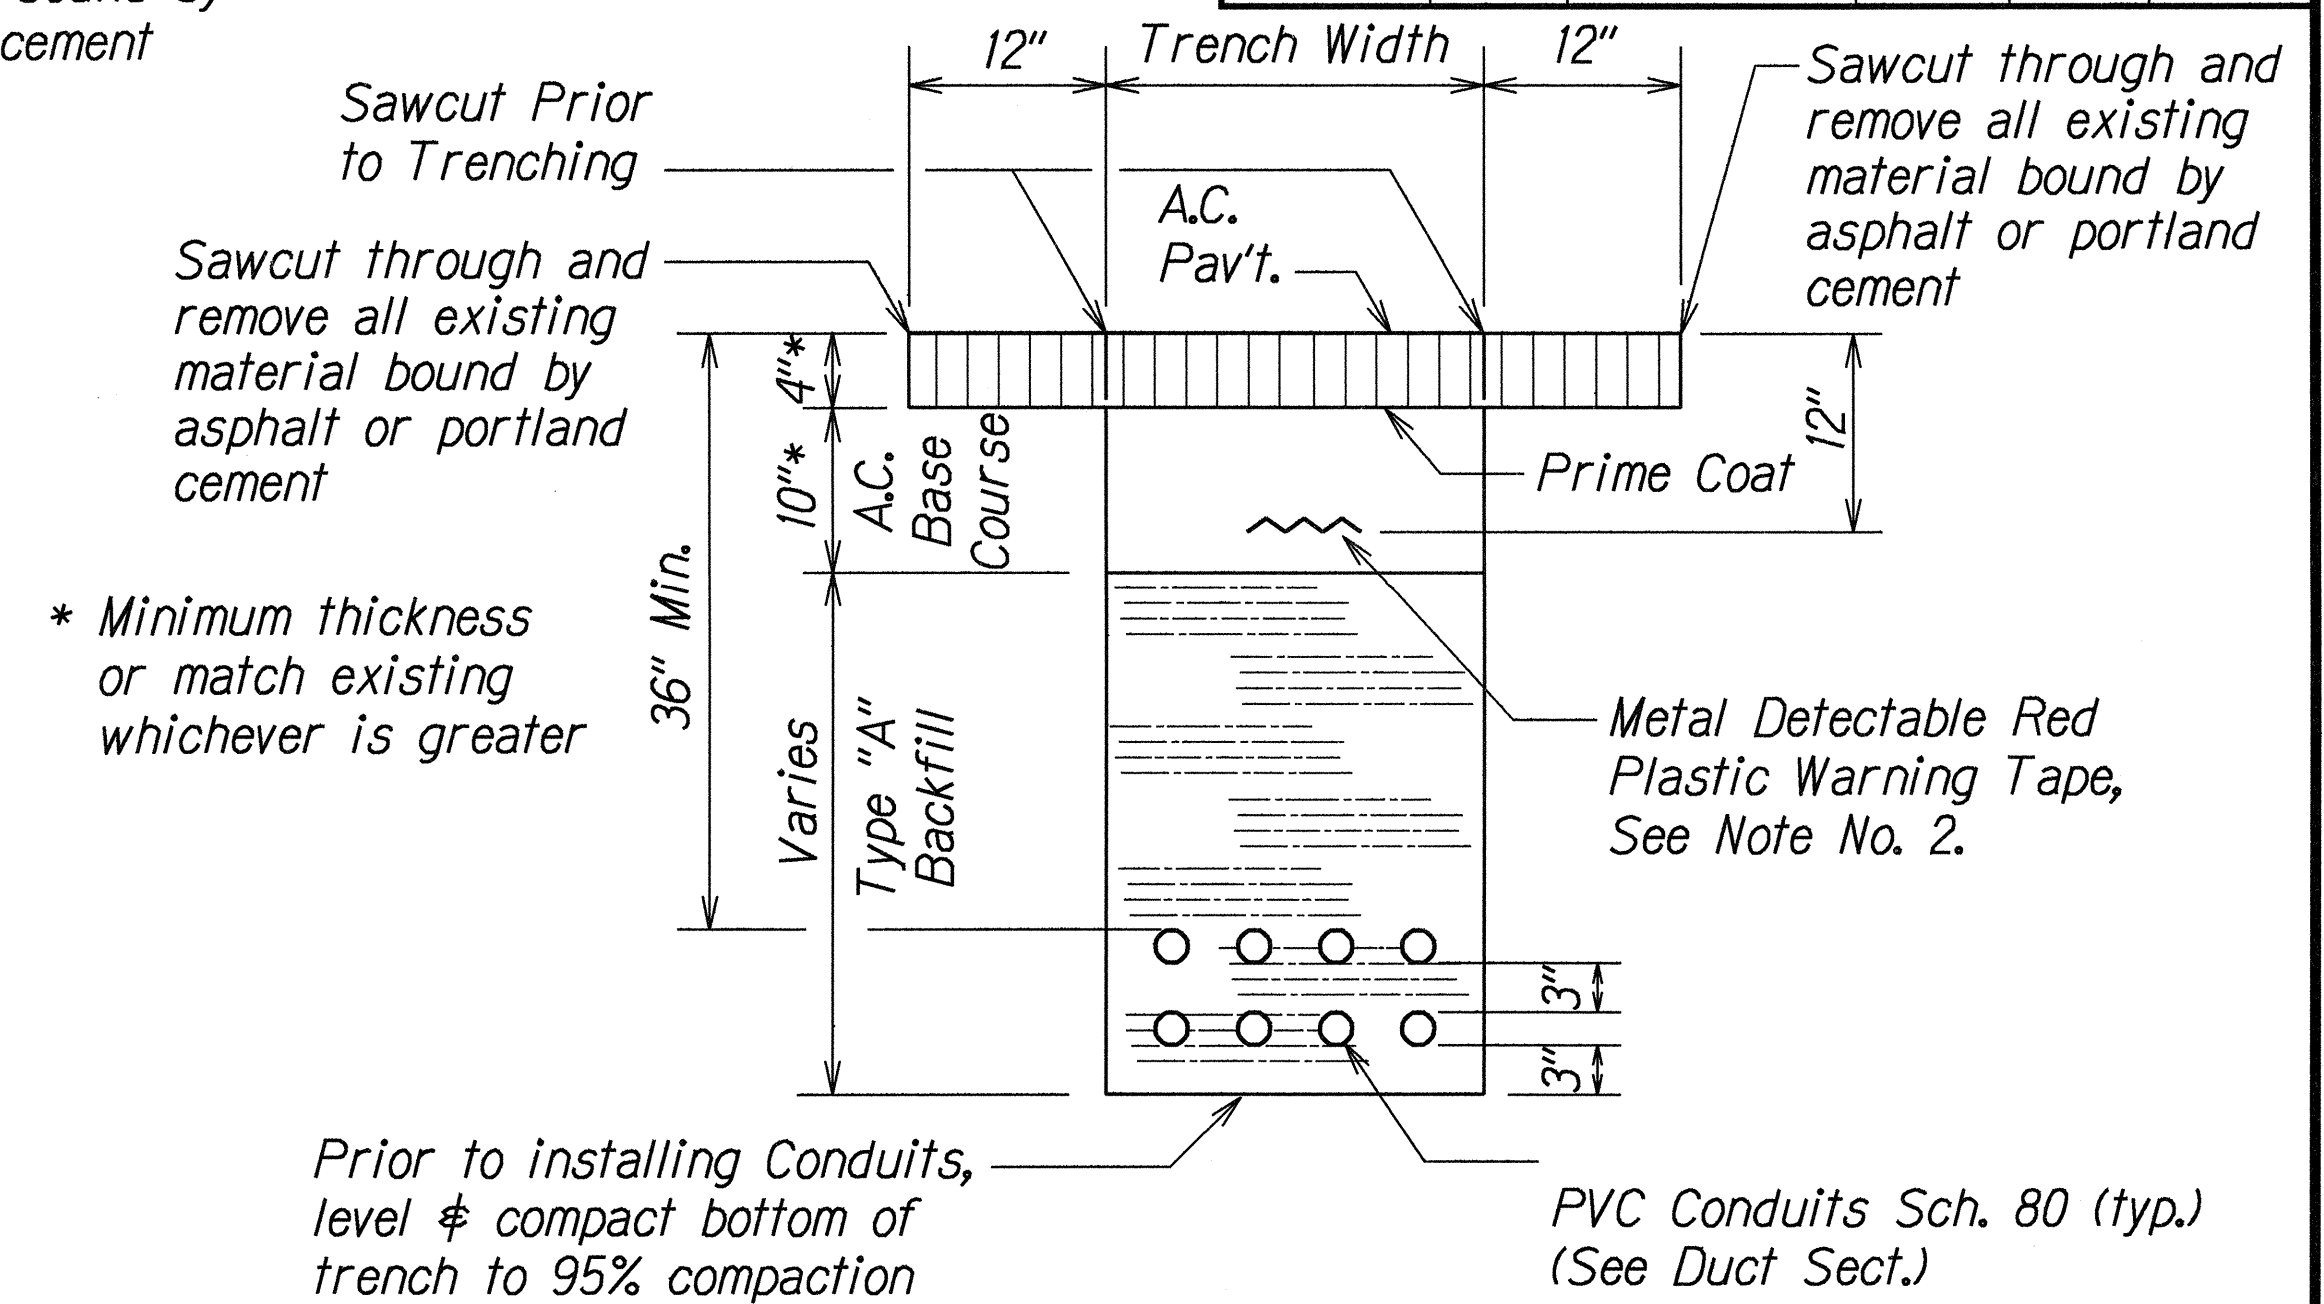


② TYPICAL BACKFILL SECTION
DIRECT BURIED DUCTS

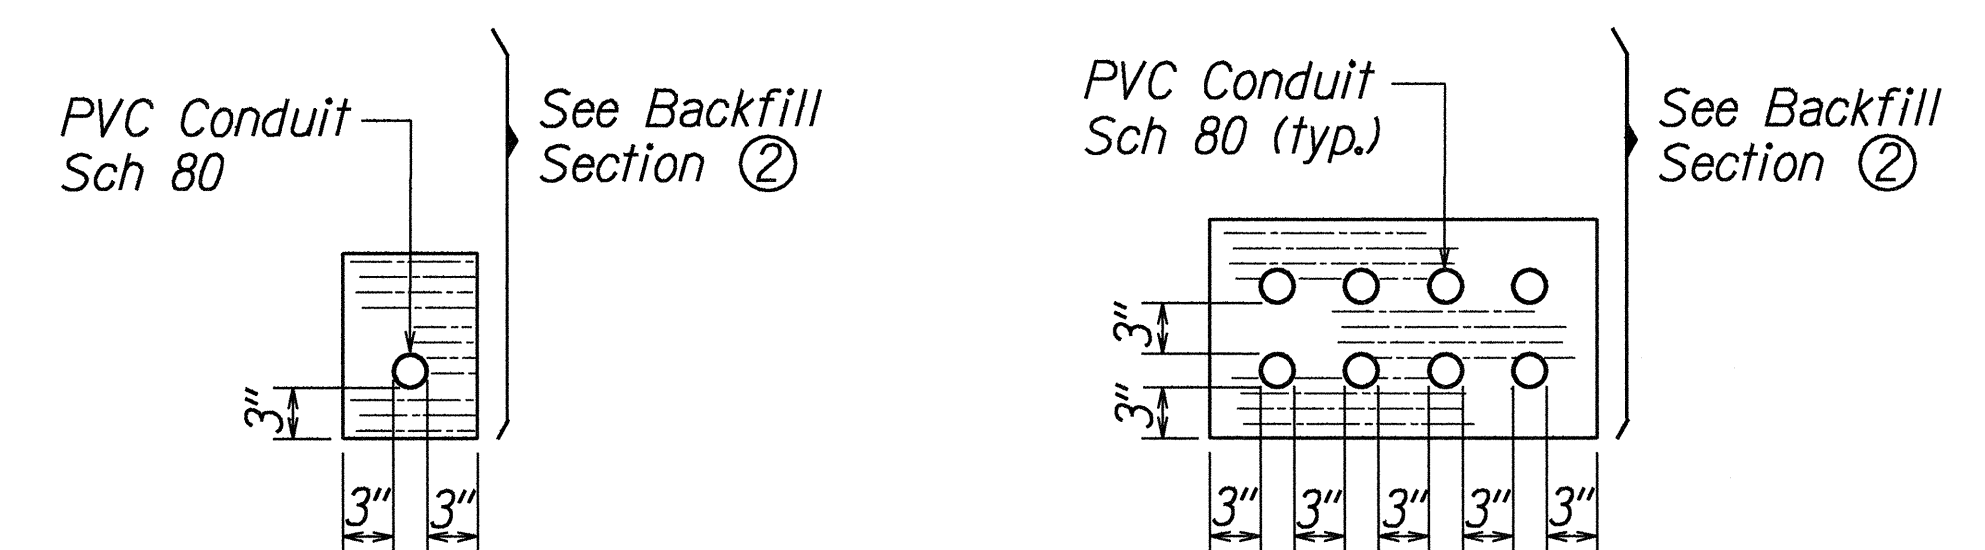

SINGLE CONDUIT

MULTIPLE CONDUIT

DUCT SECTIONS - DIRECT BURIED

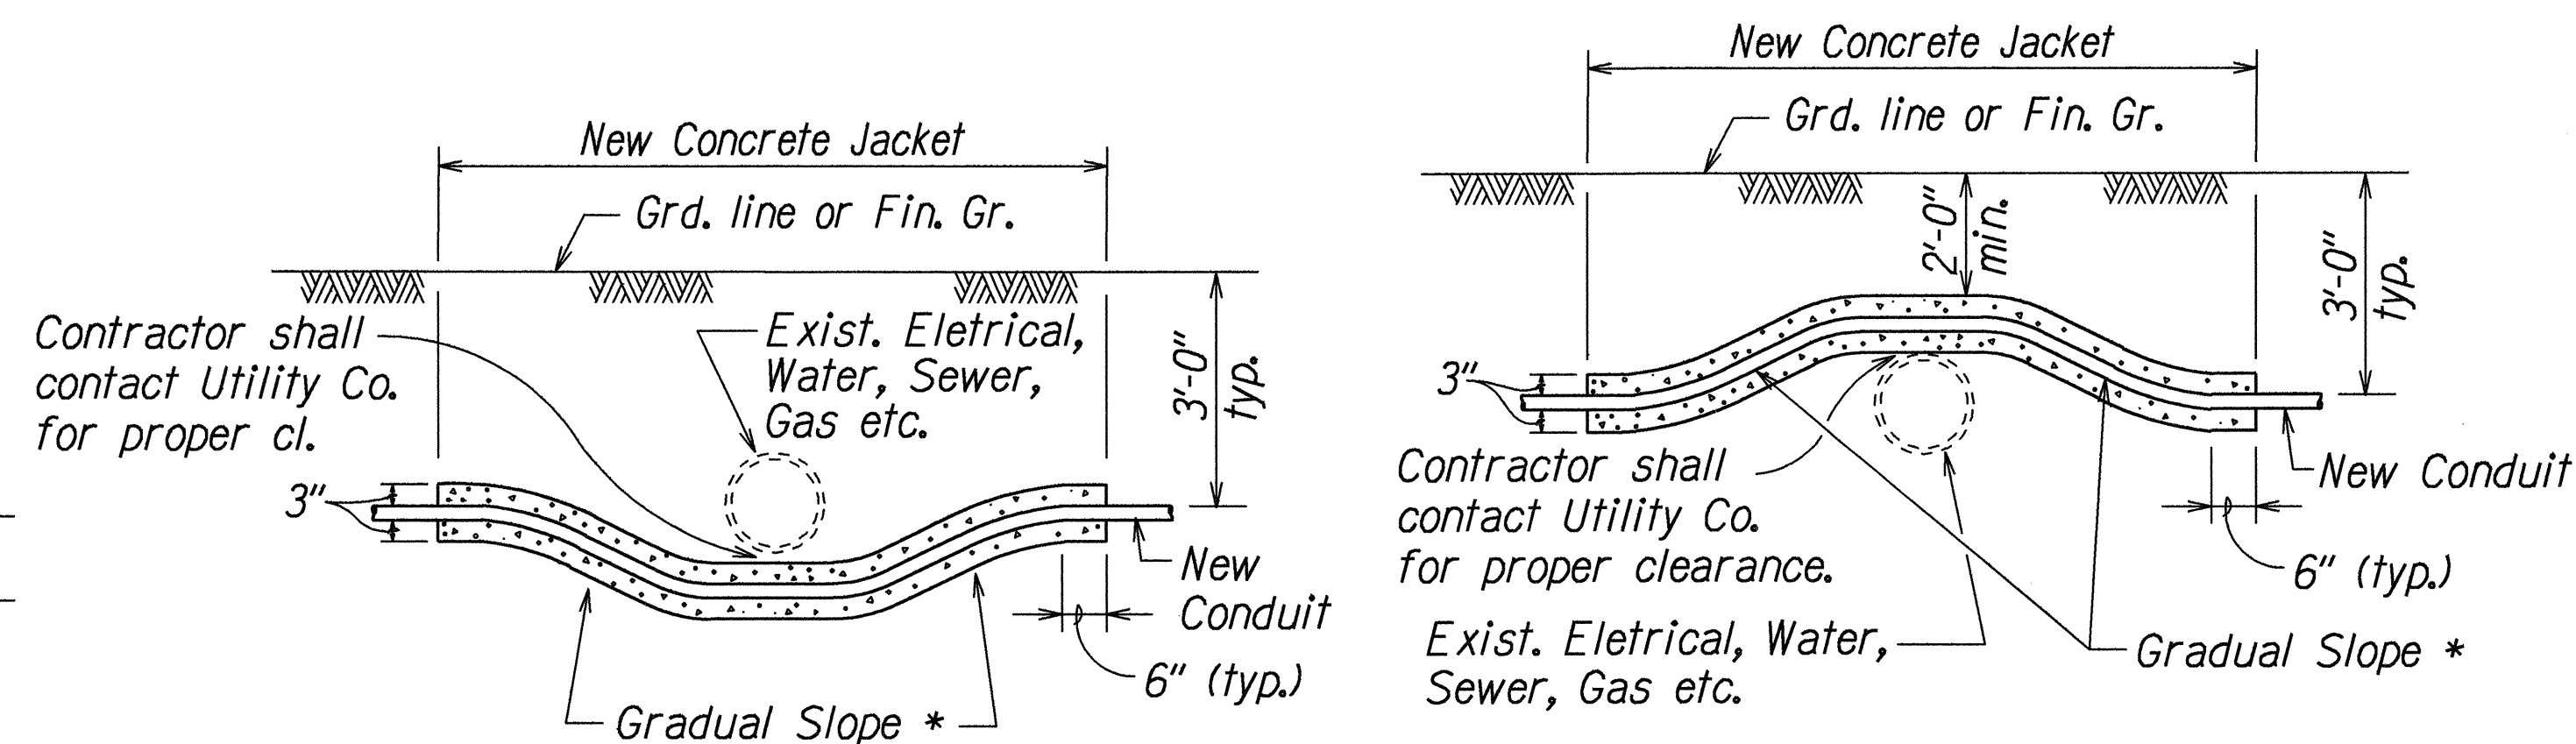

* To be determined by County Electrical Inspector/Engineer

CONDUIT BY-PASS DETAIL AT VARIOUS UTILITIES

Not to Scale

STATE OF HAWAII DEPARTMENT OF TRANSPORTATION HIGHWAYS DIVISION	
<u>TRAFFIC SIGNAL DETAILS</u>	
<u>FARRINGTON HIGHWAY IMPROVEMENTS</u>	
<u>Waikale Road to Aniani Place</u>	
<u>Project No. 7101A-01-00</u>	
<i>Not to Scale</i>	<i>Date: Sept., 2000</i>
SHEET No. T9 OF 11 SHEETS	

FED. ROAD DIST. NO.	STATE	PROJ. NO.	FISCAL YEAR	SHEET NO.	TOTAL SHEETS
HAWAII	HAW.	7101A-01-00	2000	17	19

LIST OF MATERIALS							
POLE NO.	STANDARD TYPE	COMMENTS	MOUNTING TYPE	SIGNAL FACES & OPTICOM RECEIVERS		PPB ASSEMBLY	
				NEW	EXISTING	NEW	EXISTING
A	I - 8	NEW	TOP OF POLE - TWO WAY	H-M, H-M		2 (L & R)	
B	I - 10	NEW	TOP OF POLE - ONE WAY	R-Y-G			
C	I - 10	NEW	TOP OF POLE - THREE WAY CANTILEVER - ONE WAY TOP OF POLE - ONE WAY	R-Y-G, R-Y-G← , R-Y-G H-M OPTICOM		1 (L)	
D	II - 35	NEW	MAST ARM - ONE WAY MAST ARM - HOR MAST ARM - ONE WAY MAST ARM - ONE WAY BRACKET - ONE WAY	R-Y-G← (PV) OPTICOM R-Y-G↑ R-Y-G↑ H-M		1 (L)	
E	I - 10	NEW	TOP OF POLE - ONE WAY	R-Y-G			
F	I - 10	NEW	TOP OF POLE - TWO WAY CANTILEVER - TWO WAY TOP OF POLE - ONE WAY	R-Y-G← , R-Y-G H-M, H-M OPTICOM		2 (L & R)	
G	II - 35	NEW	MAST ARM - ONE WAY MAST ARM - HOR MAST ARM - ONE WAY MAST ARM - ONE WAY	R-Y-G← (PV) OPTICOM R-Y-G↑ R-Y-G↑			
h	WOOD POLE	EXISTING	BRACKET ARM (DISPOSE)		R-Y-G (SALVAGE)		
i	I - 10 (SALVAGE)	EXISTING	TOP OF POLE		R-Y-G (SALVAGE) H-M (SALVAGE)		
j	PEDESTAL (SALVAGE)	EXISTING	BRACKET - ONE WAY				1 (SALVAGE)
k	I - 10 (SALVAGE)	EXISTING	TOP OF POLE CANTILEVER		R-Y-G (SALVAGE) H-M (SALVAGE)		1 (SALVAGE)
l	I - 10 (SALVAGE)	EXISTING	TOP OF POLE CANTILEVER		R-Y-G (SALVAGE) H-M (SALVAGE)		1 (SALVAGE)
m	II-30 (SALVAGE)	EXISTING	MAST ARM MAST ARM BRACKET		R-Y-G, (SALVAGE) R-Y-G, (SALVAGE) R-Y-G, (SALVAGE)		
n	I-10 (SALVAGE)	EXISTING	TOP OF POLE		H-M (SALVAGE)		1 (SALVAGE)

△6	CONDUIT (Conc. encased)	CABLE
	2"	1-26c#14
	2"	1-26c#14
	2"	1-2c#14
	2"	1-3c#20
	2"	Spare

△11	CONDUIT	CABLE
	2"	1-26c#14
	2"	1-26c#14
	2"	4-2c#14
	2"	2-2c#14
	2"	2-3c#20
	2"	Spare

△7	CONDUIT (Conc. encased)	CABLE
	2"	1-26c#14
	2"	1-26c#14
	2"	Spare
	2" Added per C&C	

△12	CONDUIT (Conc. encased)	CABLE
	2"	1-2c#14



△8	CONDUIT (Conc. encased)	CABLE
	2"	1-26c#14
	2"	1-26c#14
	2"	3-2c#14
	2"	Spare

△13	CONDUIT	CABLE
	2"	1-2c#14

△9	CONDUIT	CABLE
	2"	1-2c#14 1-4c#14*

*Note
4-c#14 (Type 5 Cable) Signal-Drop
Cable shall not be paid for separately
but considered incidental to Traffic
Signal Heads (See Note 11 on Sheet T5)

△10	CONDUIT (Conc. encased)	CABLE
	2"	1-26c#14
	2"	1-26c#14
	2"	4-2c#14
	2"	1-2c#14
	2"	1-3c#20
	2"	Spare

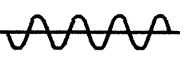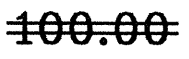LEGEND FOR AS-BUILT POSTINGS	
	Squiggly line for as-built deletion
	Double line for as-built deletion
Roadway	Text for as-built posting

△1	CONDUIT (Conc. encased)	CABLE
	3"	1-3c#6

△2	CONDUIT	CABLE
	2"	1-3c#6

△3	CONDUIT	CABLE
	2"	1-26c#14
	2"	1-26c#14
	2"	1-26c#14
	2"	1-26c#14
	2"	4-2c#14
	2"	4-2c#14
	2"	3-2c#14
	2"	4-3c#20
	2"	Spare

△4	CONDUIT (Conc. encased)	CABLE
	2"	1-26c#14
	2"	1-26c#14
	2"	4-2c#14
	2"	2-2c#14
	2"	2-3c#20
	2"	Spare

△5	CONDUIT (Conc. encased)	CABLE
	2"	1-26c#14
	2"	1-26c#14
	2"	3-2c#14
	2"	1-3c#20
	2"	Spare

9/24/01	Revise pole D#G and Add pole E.
DATE	REVISION

STATE OF HAWAII DEPARTMENT OF TRANSPORTATION HIGHWAYS DIVISION	
TRAFFIC SIGNAL DETAILS	
FARRINGTON HIGHWAY IMPROVEMENT Waialeale Road to Aniani Place Project No. 7101A-01-00	
Date: Sept., 2001	
SHEET No. T7 OF 11 SHEETS	

AS-BUILT


ADD. 17

SURVEY PLOTTED BY	DATE
DRAWN BY M. Takafuji	
TRACED BY	
NOTED BY Gary Kashi	
DESIGNED BY	
CHECKED BY	
ORIGINAL PLAN	
NOTE BOOK	
10/2/01	
10/2/01	

FED. ROAD DIST. NO.	STATE	PROJ. NO.	FISCAL YEAR	SHEET NO.	TOTAL SHEETS
HAWAII	HAW.	7101A-01-00	2001	18	19

GENERAL NOTES

1. Provide a minimum of one 16 Ø x 2.5m Copperweld Ground Rod in each pullbox. When directed by the Traffic Signal Inspector/Engineer, install additional Ground Rods. Cost of Ground Rods shall be incidental to the pullboxes.
2. All pre-cast concrete pullboxes shall be manufactured in two pieces.
3. The pullbox with cover shall be capable of supporting an MS 18 Loading.
4. The maximum weight of the pullbox cover shall not exceed 27 kilograms.
5. The openings for the conduits on all pullboxes shall be pre-cast concrete knockouts.
6. After installing the conduits in the openings of the pullboxes, the Contractor shall fill the excess opening in the pre-cast knockouts with concrete mortar.
7. Prior to installing the pullboxes, the Contractor shall level the bottom of the trench and achieve a minimum of 95% relative compaction of the bottom of the trench.
8. All concrete shall be Class A (21 MPa (3,000 psi), min.)
9. Rebars shall be Grade 300 and all lapped splices shall be 360mm minimum.
10. The #57 or #67 size aggregate shall conform to latest version of AASHTO M43 (ASTM D 448).
11. Type "C" Pullbox shall be installed in a location protected from vehicular traffic (i.e. raised sidewalk, behind A.C. curbs, traffic signal standard or pipe guards).

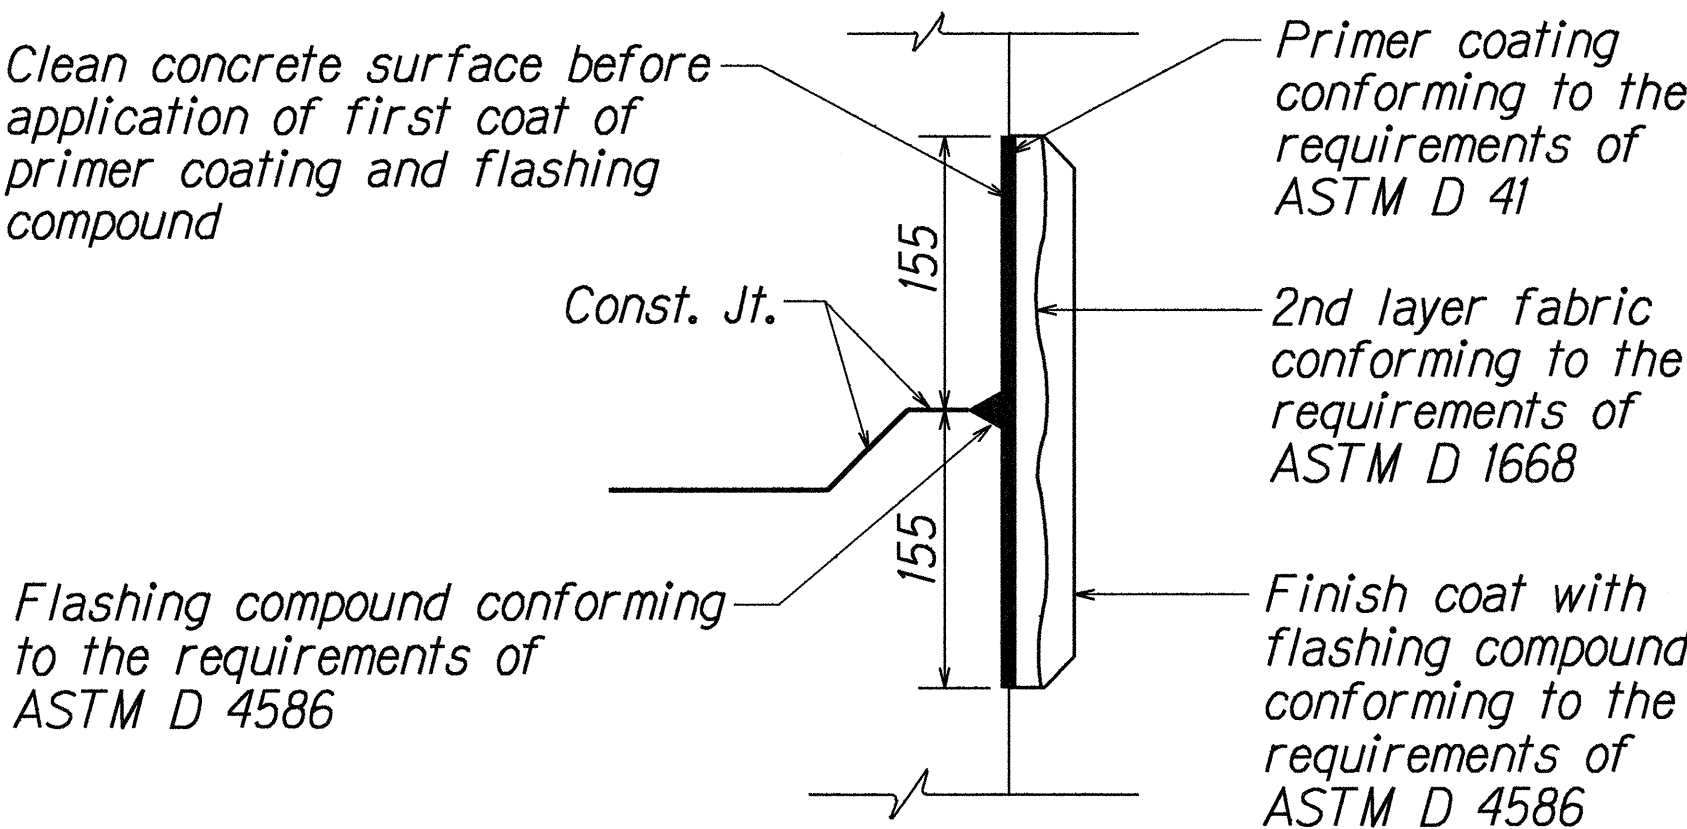

TYPICAL FLASHING COMPOUND
WATERPROOFING DETAILS

Not to Scale

ALL DIMENSIONS ARE IN MILLIMETERS
UNLESS OTHERWISE SHOWN

STATE OF HAWAII
DEPARTMENT OF TRANSPORTATION
HIGHWAYS DIVISION

PULLBOX & COVER DETAILS




FARRINGTON HIGHWAY IMPROVEMENTS

Waialeale Road to Aniani Place




Project No. 7101A-01-00

Scale: As Shown Date: Sept., 2000




SHEET No. 110 OF 11 SHEETS

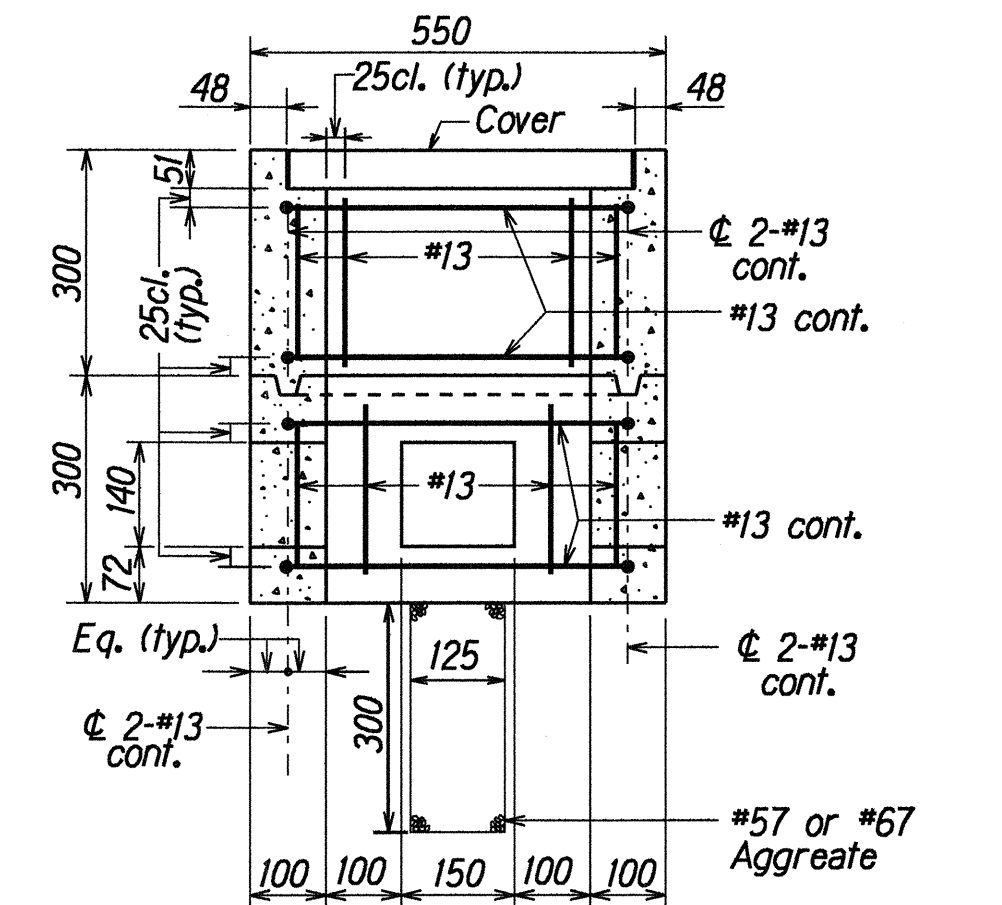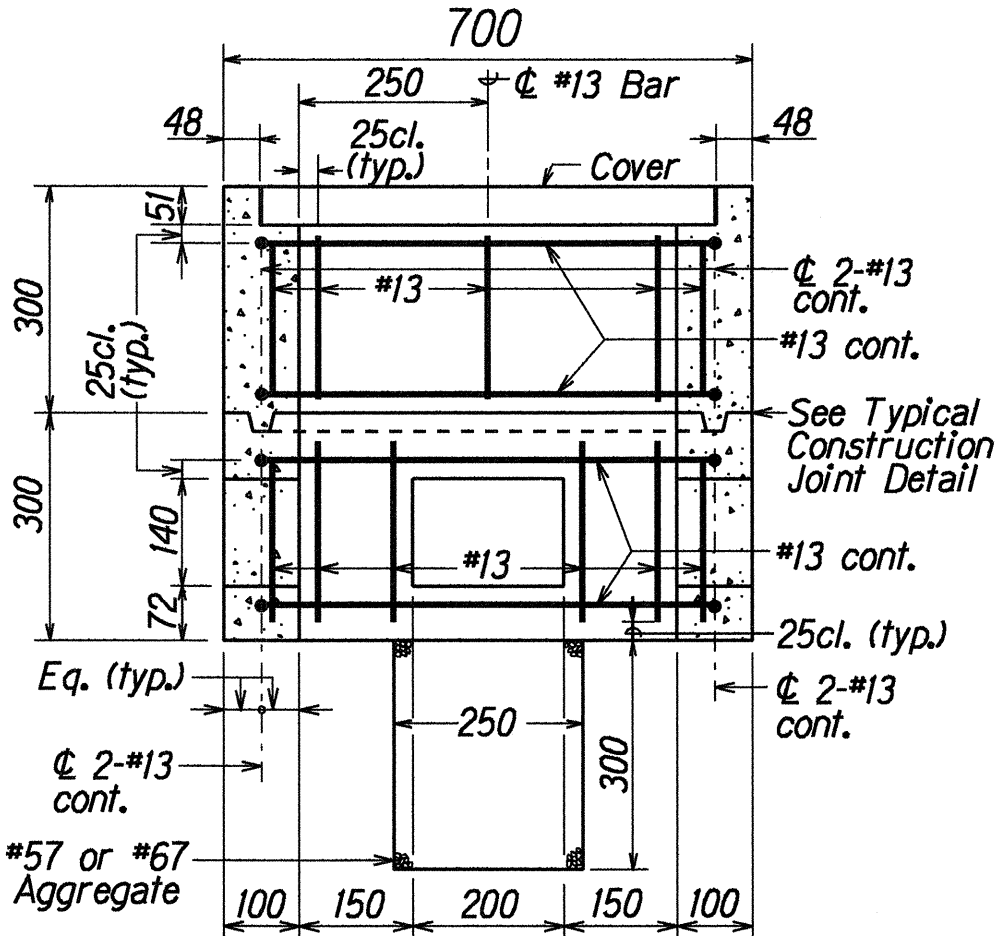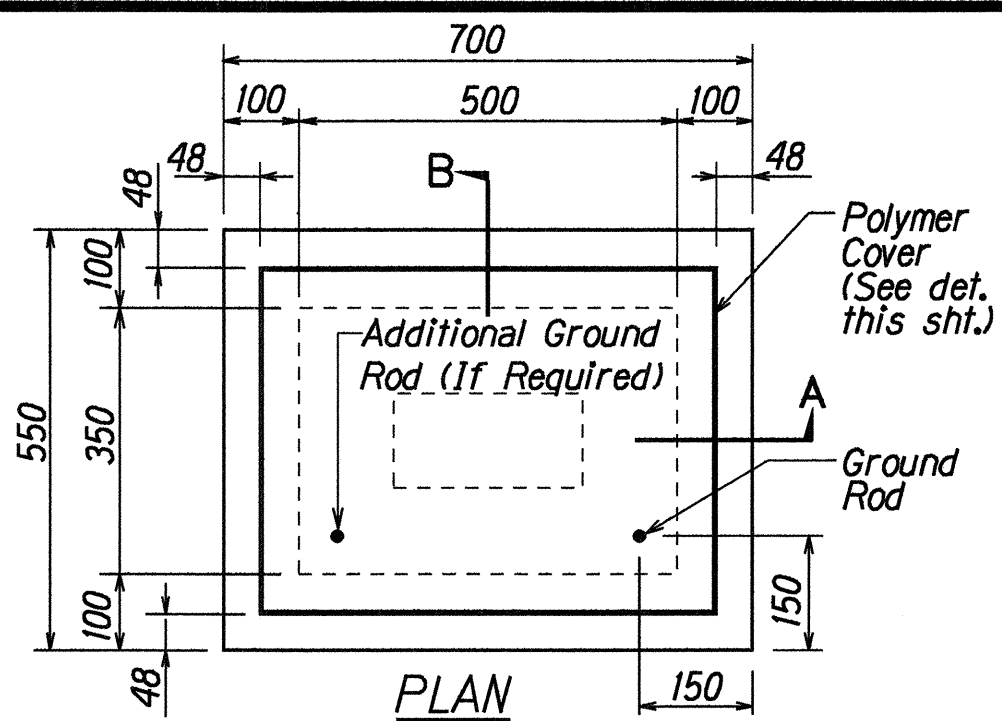


TYPE "A" PULLBOX
(Old Type "B")
Scale: 1:10

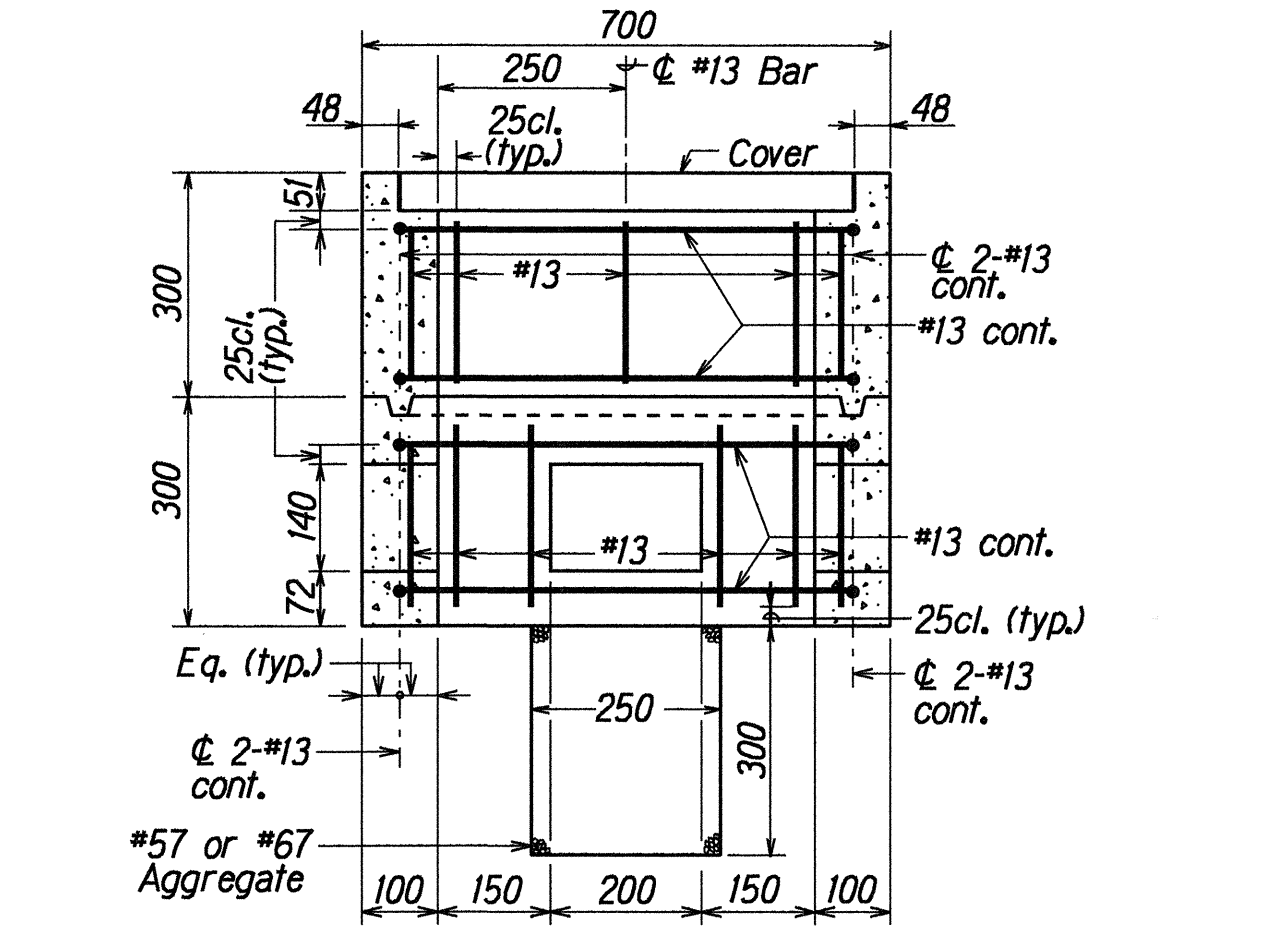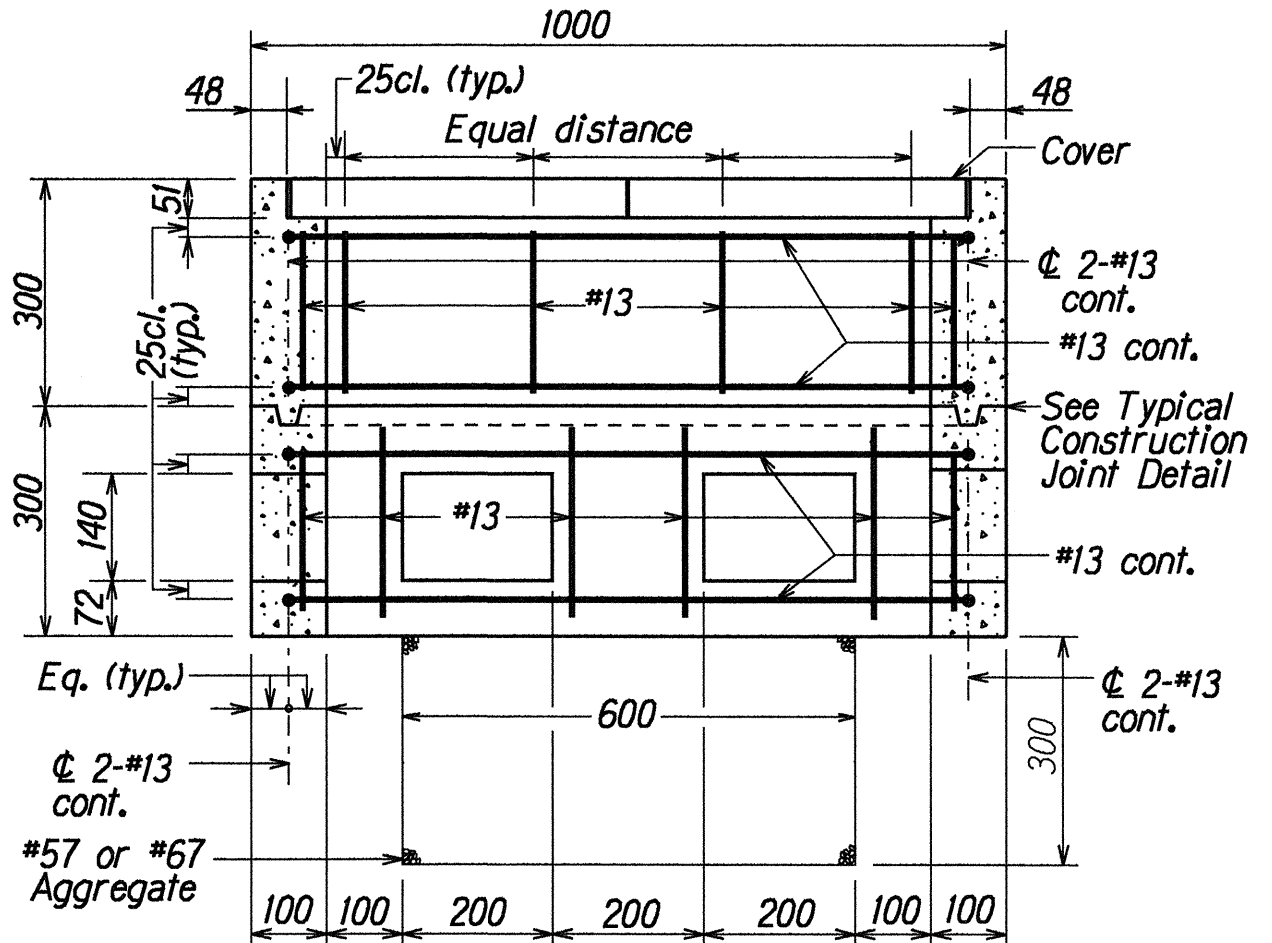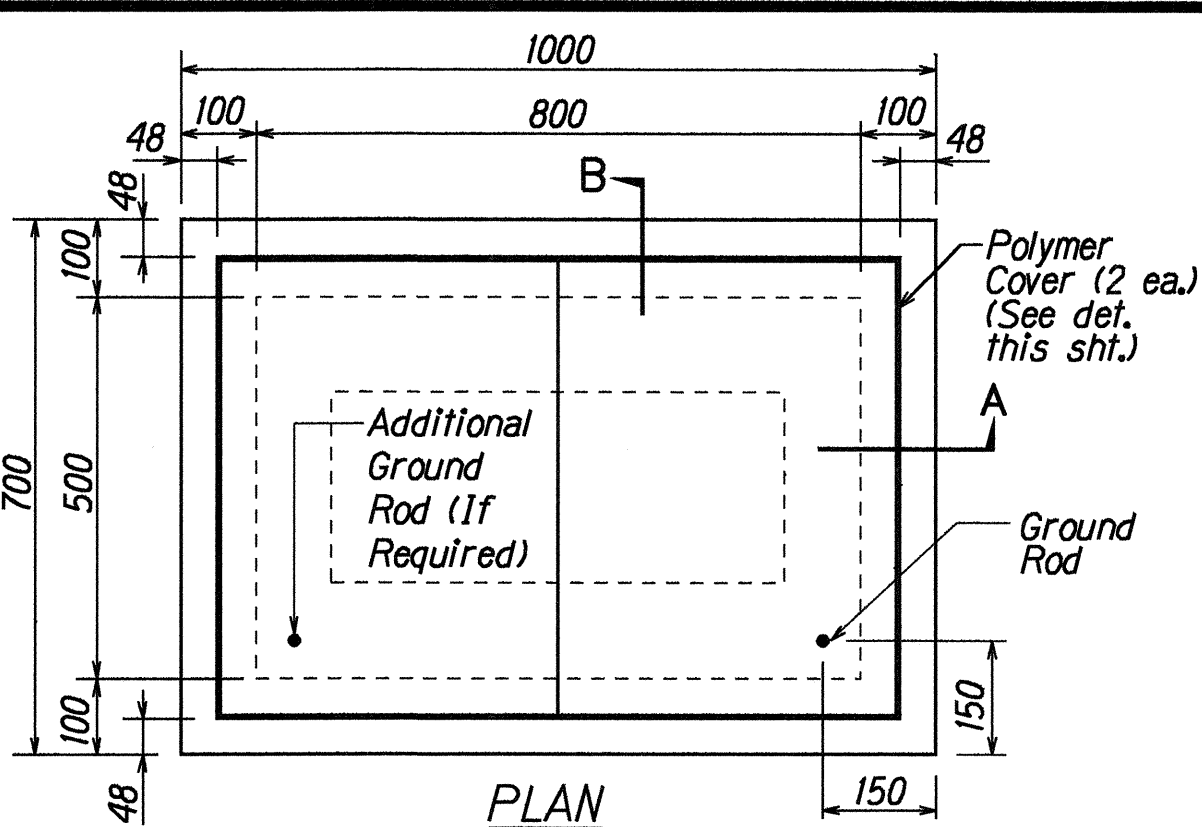



TYPE "B" PULLBOX (Old Type "C")
Scale: 1:10

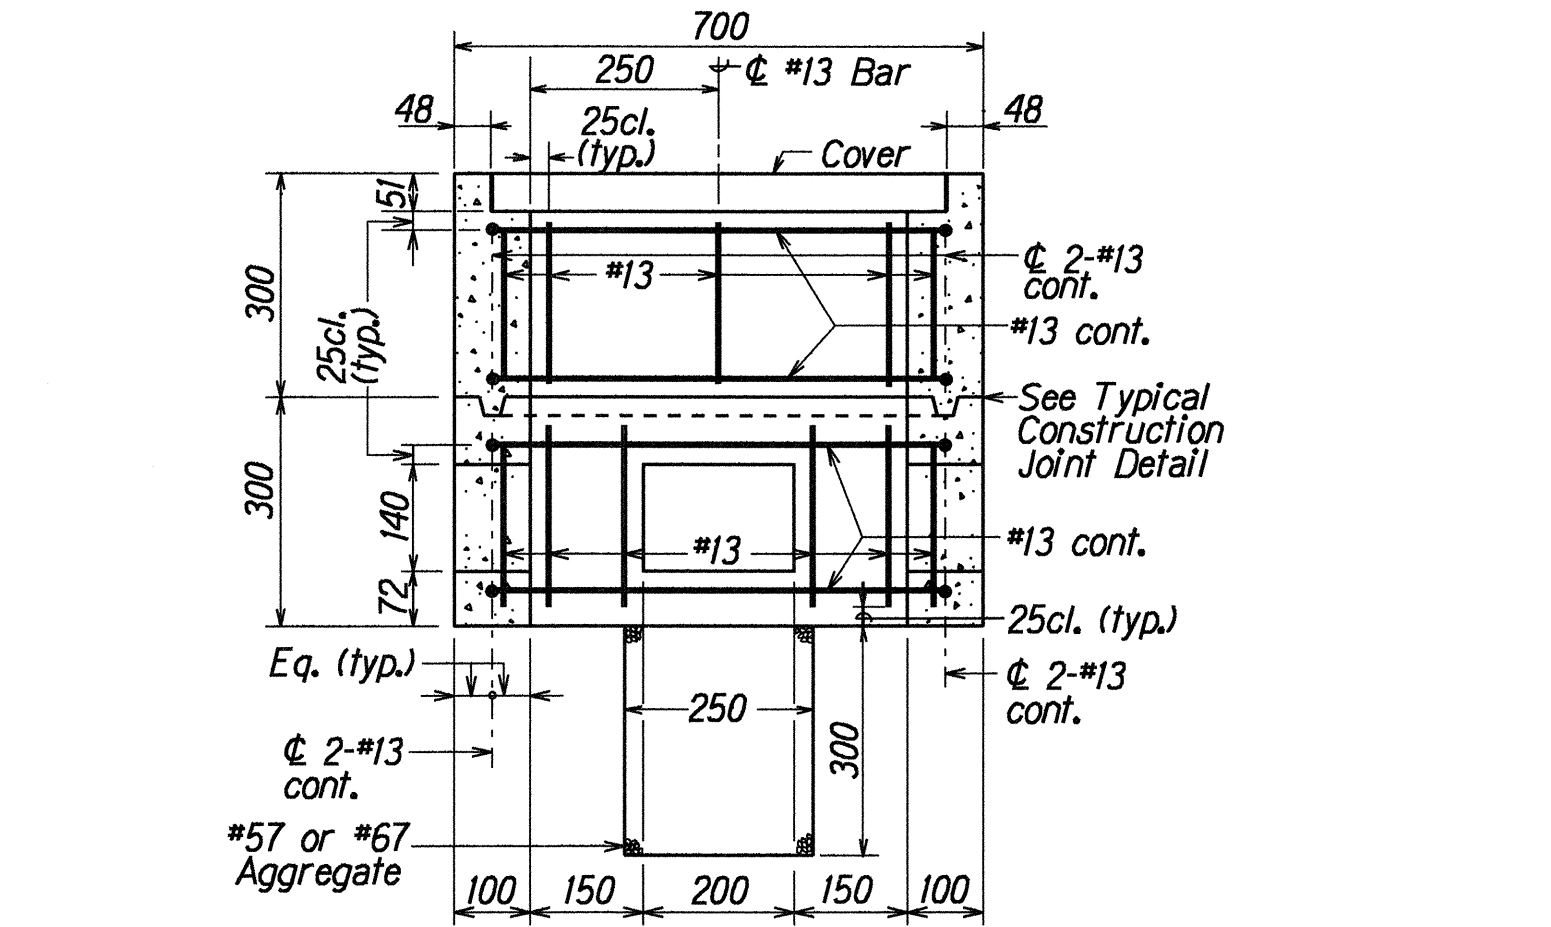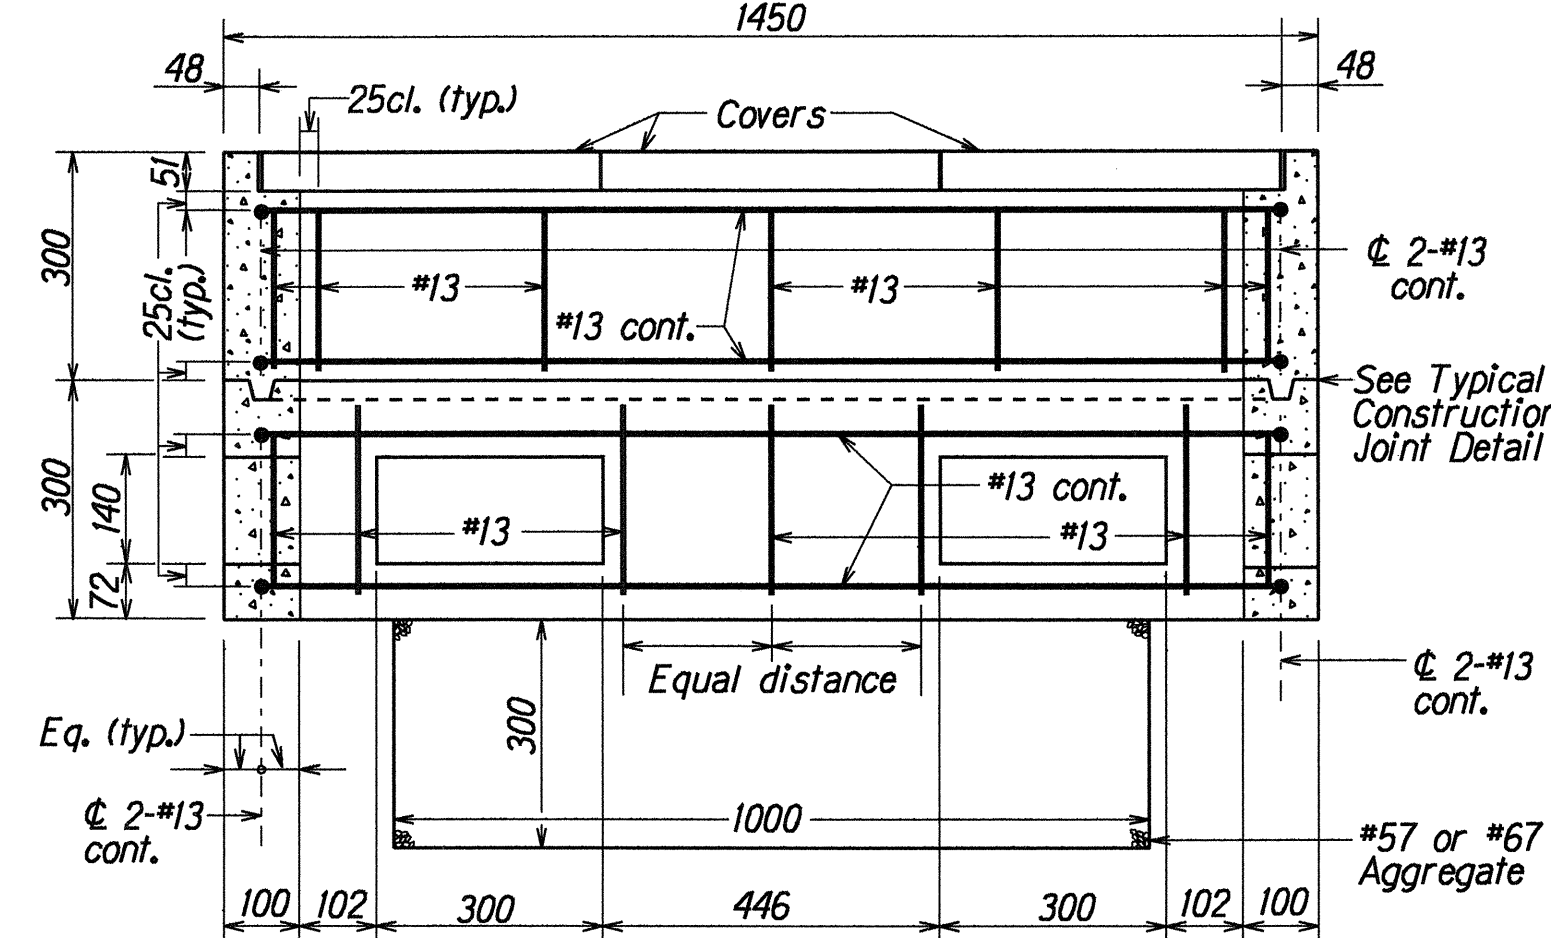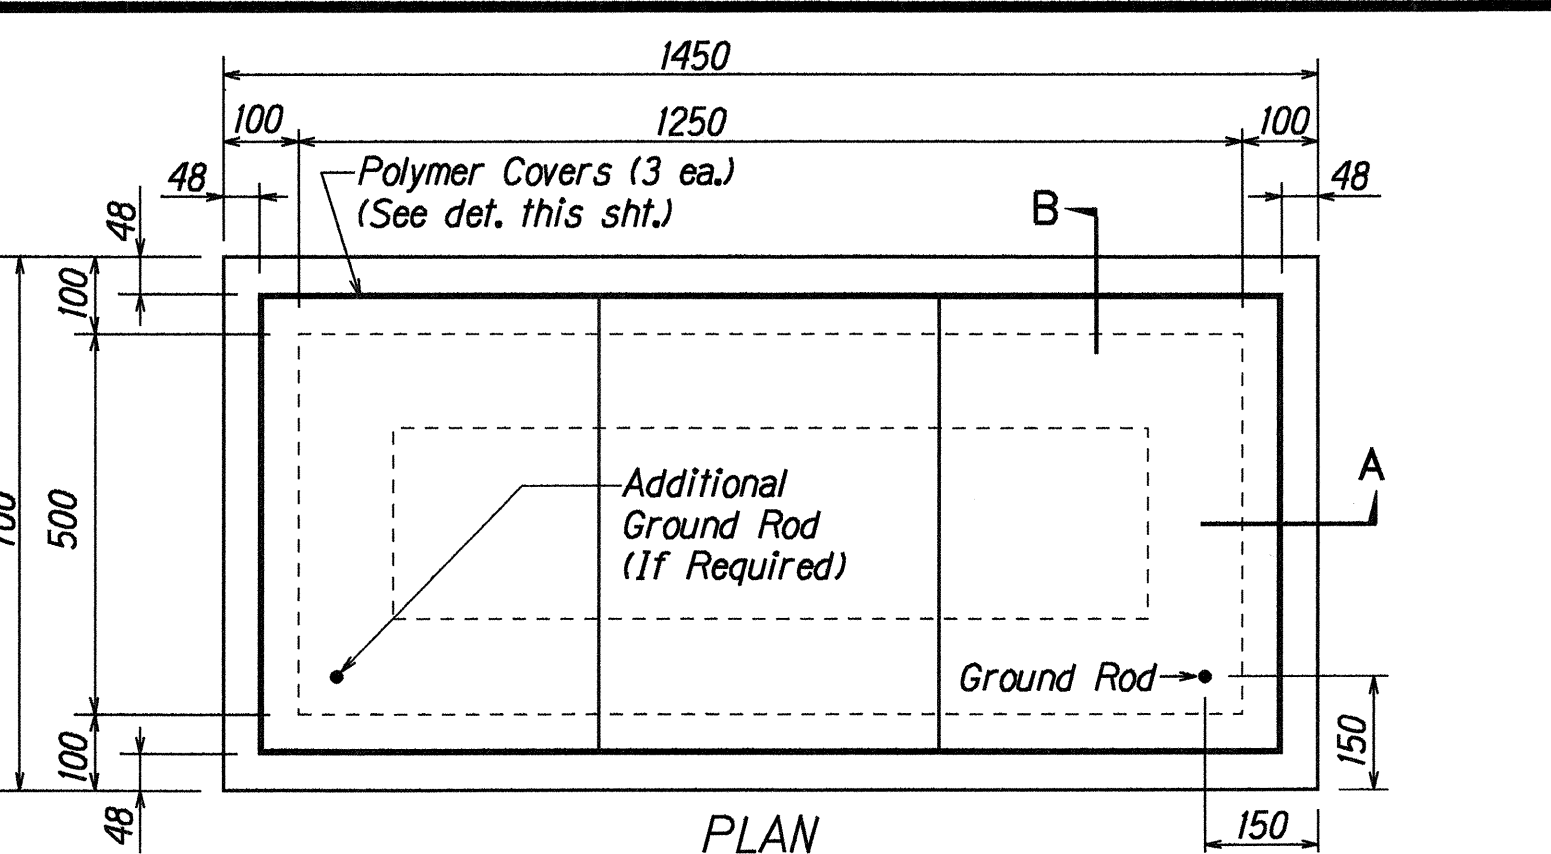

TYPE "C" PULLBOX (Old Type "D")
Scale: 1:10

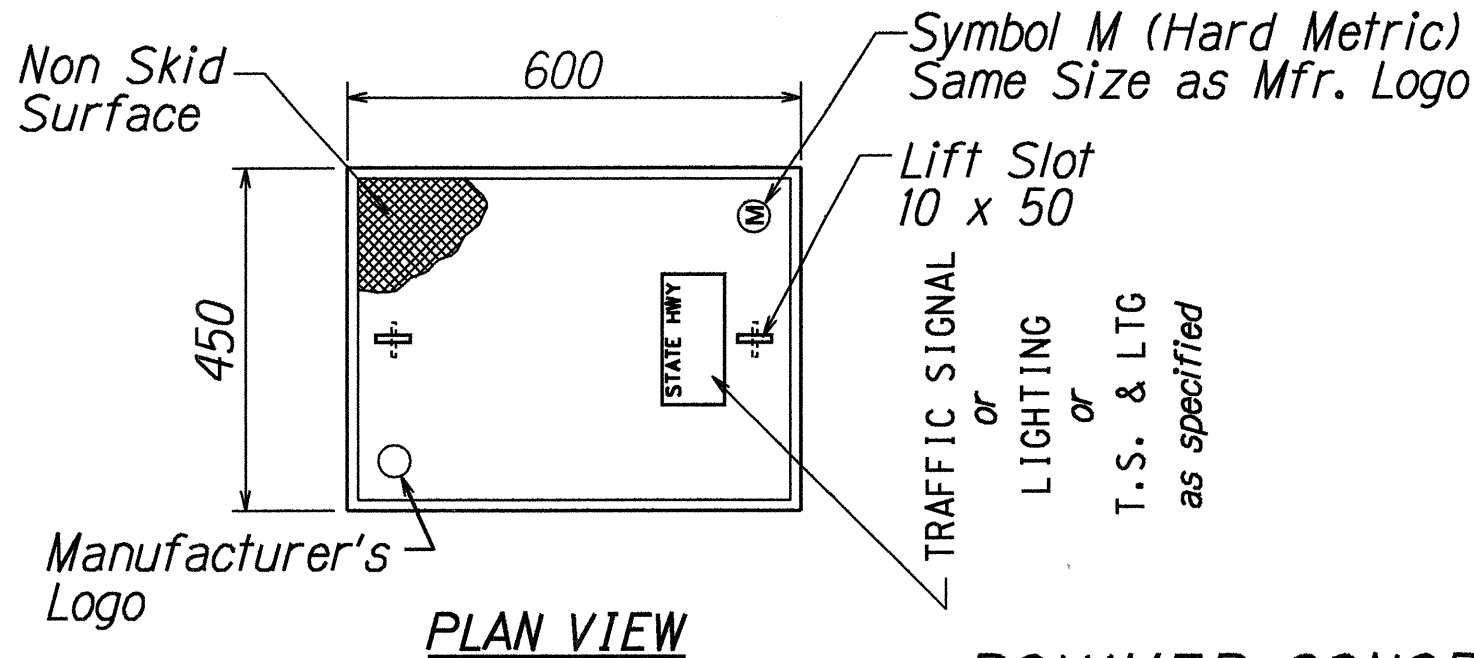


POLYMER CONCRETE COVER
Not to Scale

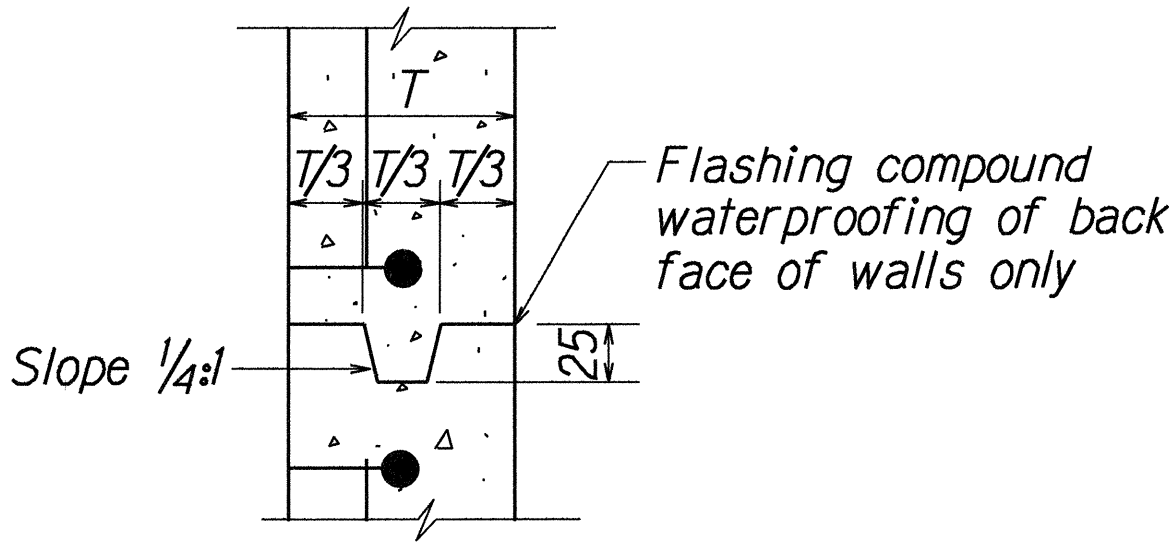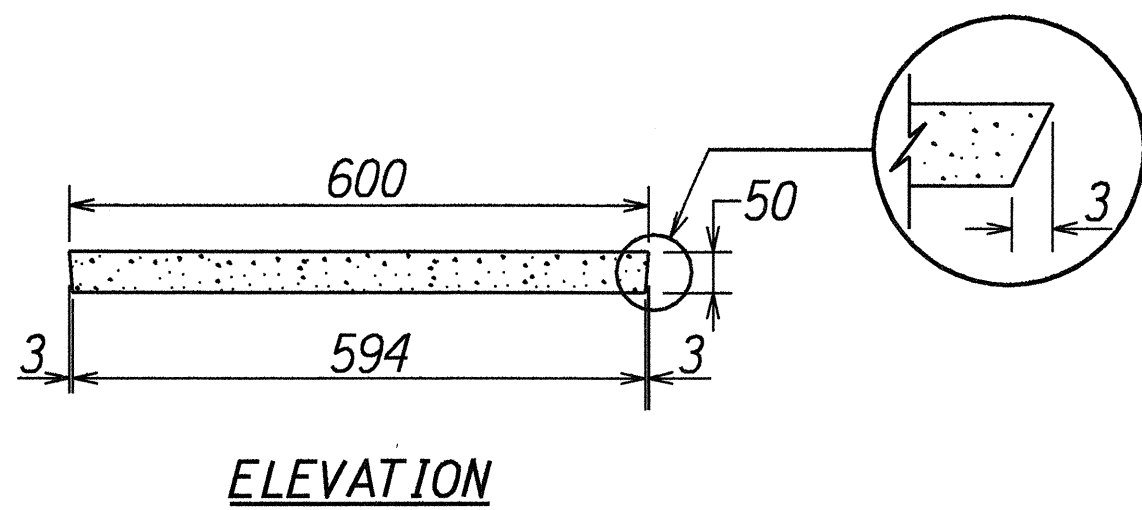

TYPICAL CONSTRUCTION
JOINT DETAIL
Not to Scale


ORIGINAL PLAN	DATE
SURVEY PROVIDED BY	DATE
DRAWN BY	DATE
DESIGNED BY	DATE
QUANTITIES BY	DATE
CHECKED BY	DATE

FED. ROAD DIST. NO.	STATE	PROJ. NO.	FISCAL YEAR	SHEET NO.	TOTAL SHEETS
HAWAII	HAW.	7101A-01-00	2001	19	19

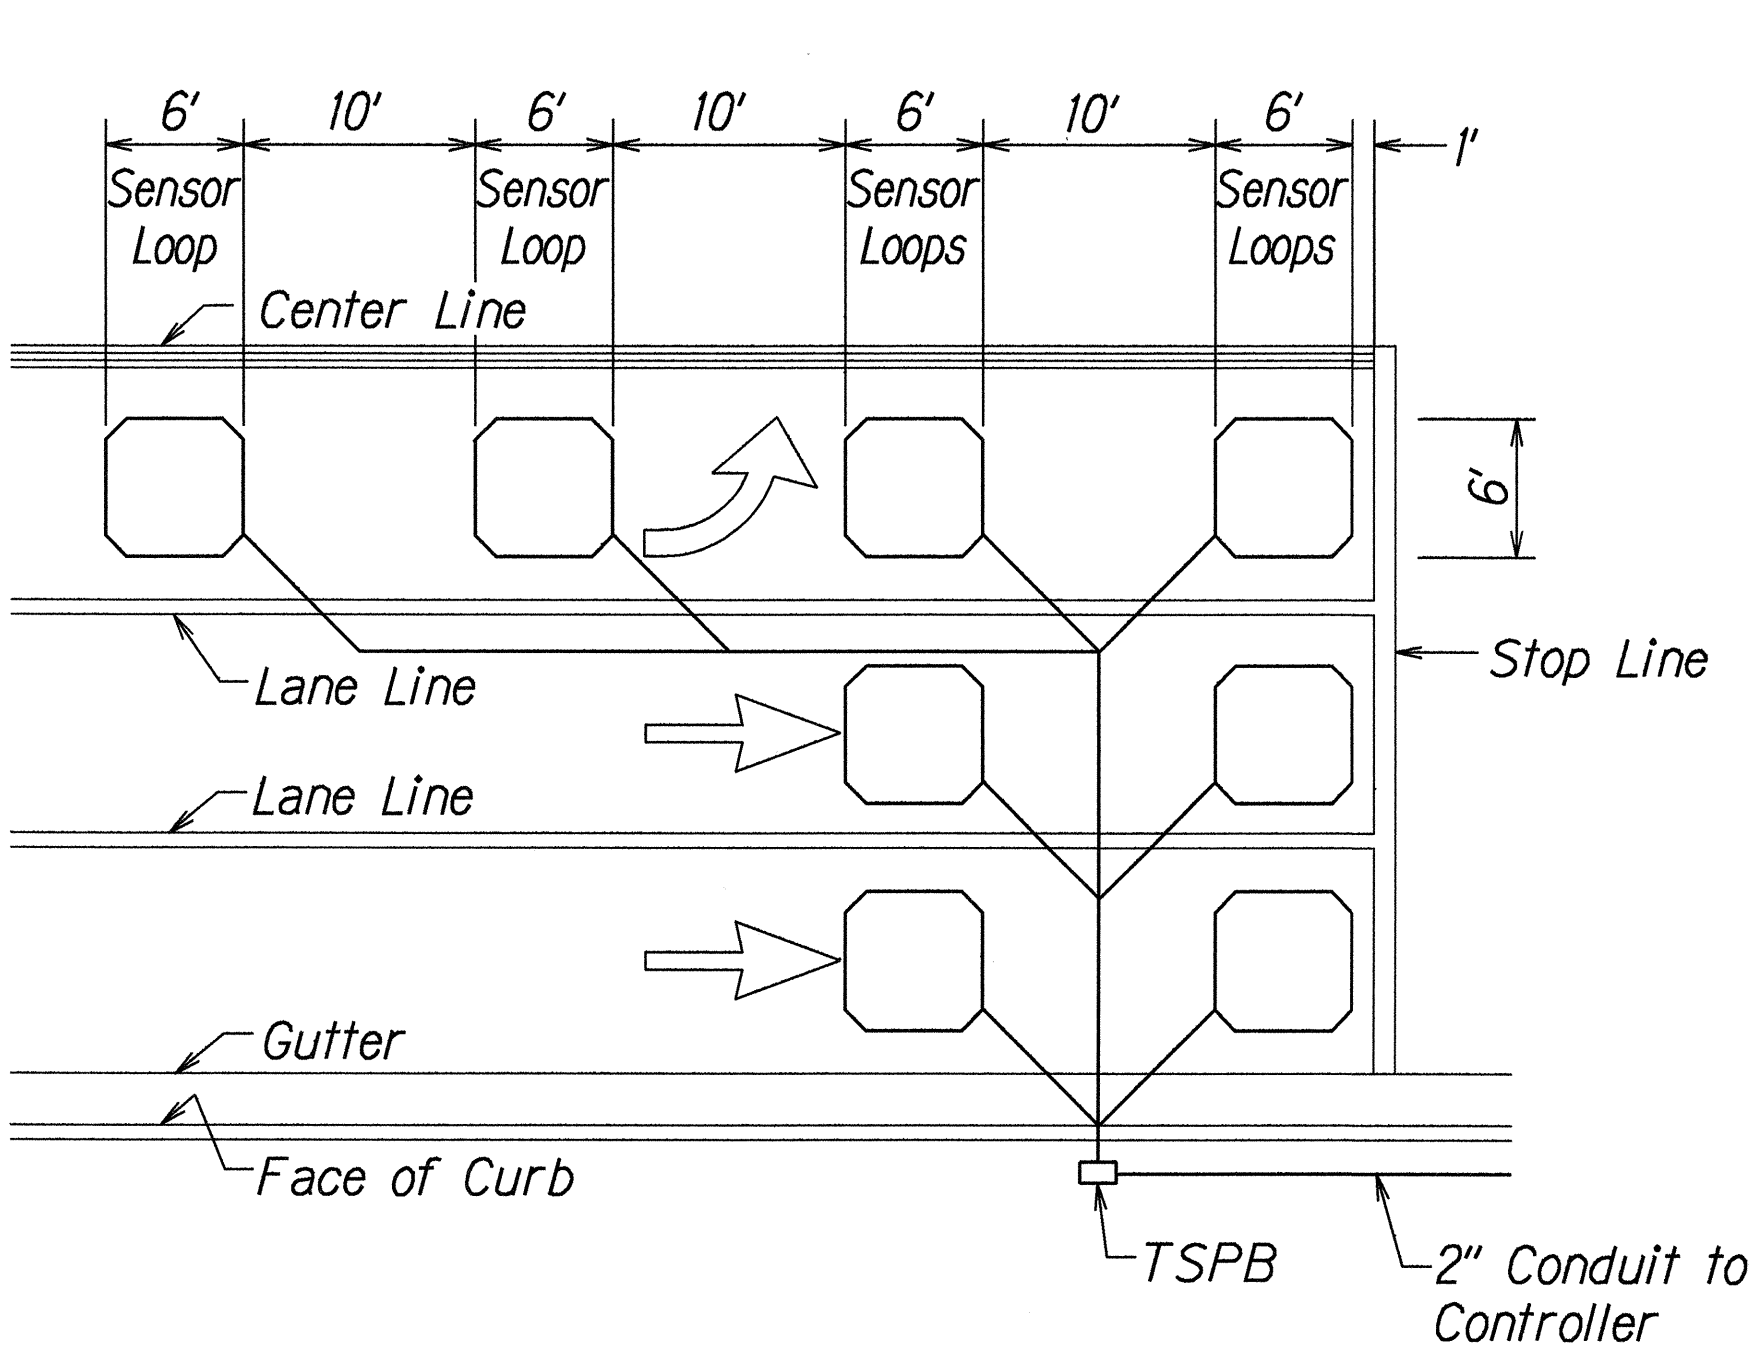


- NOTES:
- Center sensor loops in lanes.
 - Collector cables shall be twisted 2 turns per foot.
 - Number of loops and locations vary. See project plans.
 - Number and locations of collector sawcuts may be varied in the field to suit.


TYPICAL SENSOR LOOP LAYOUT

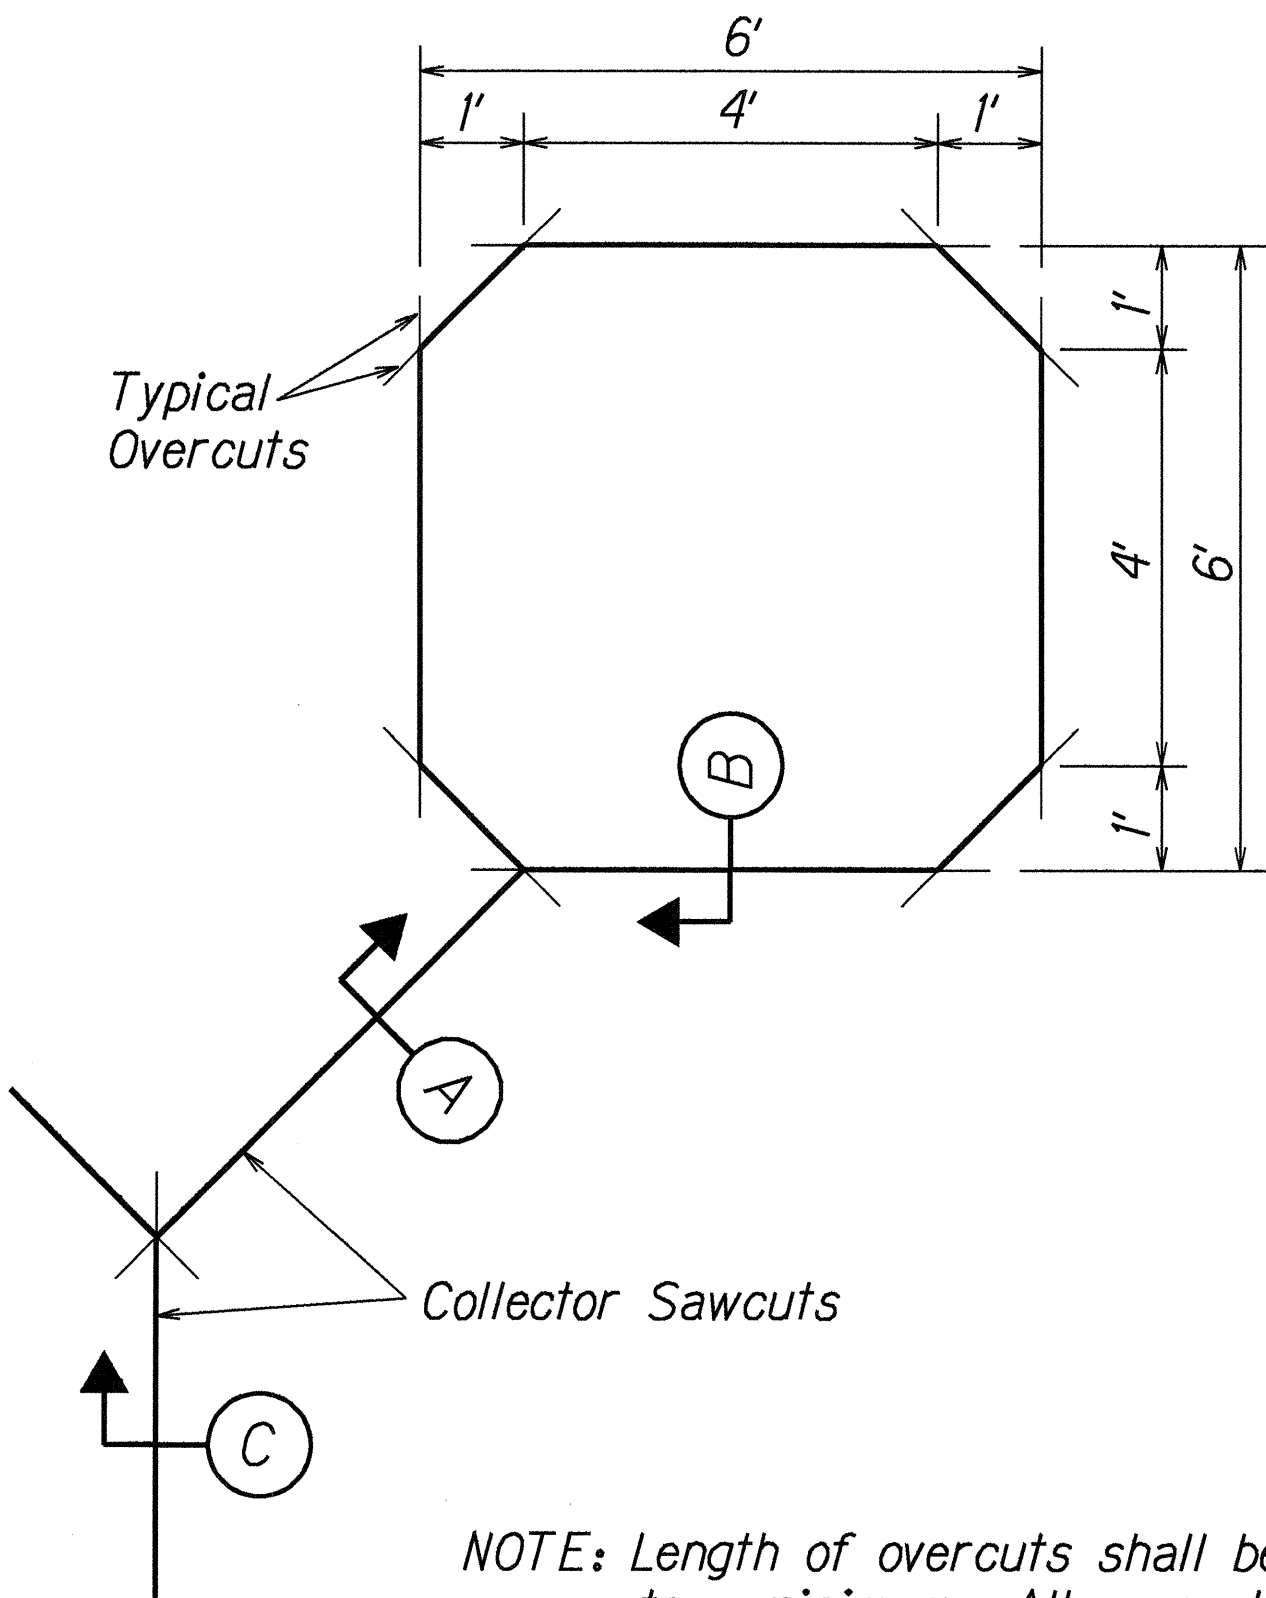

TYPICAL SENSOR LOOP SAWCUT DETAIL

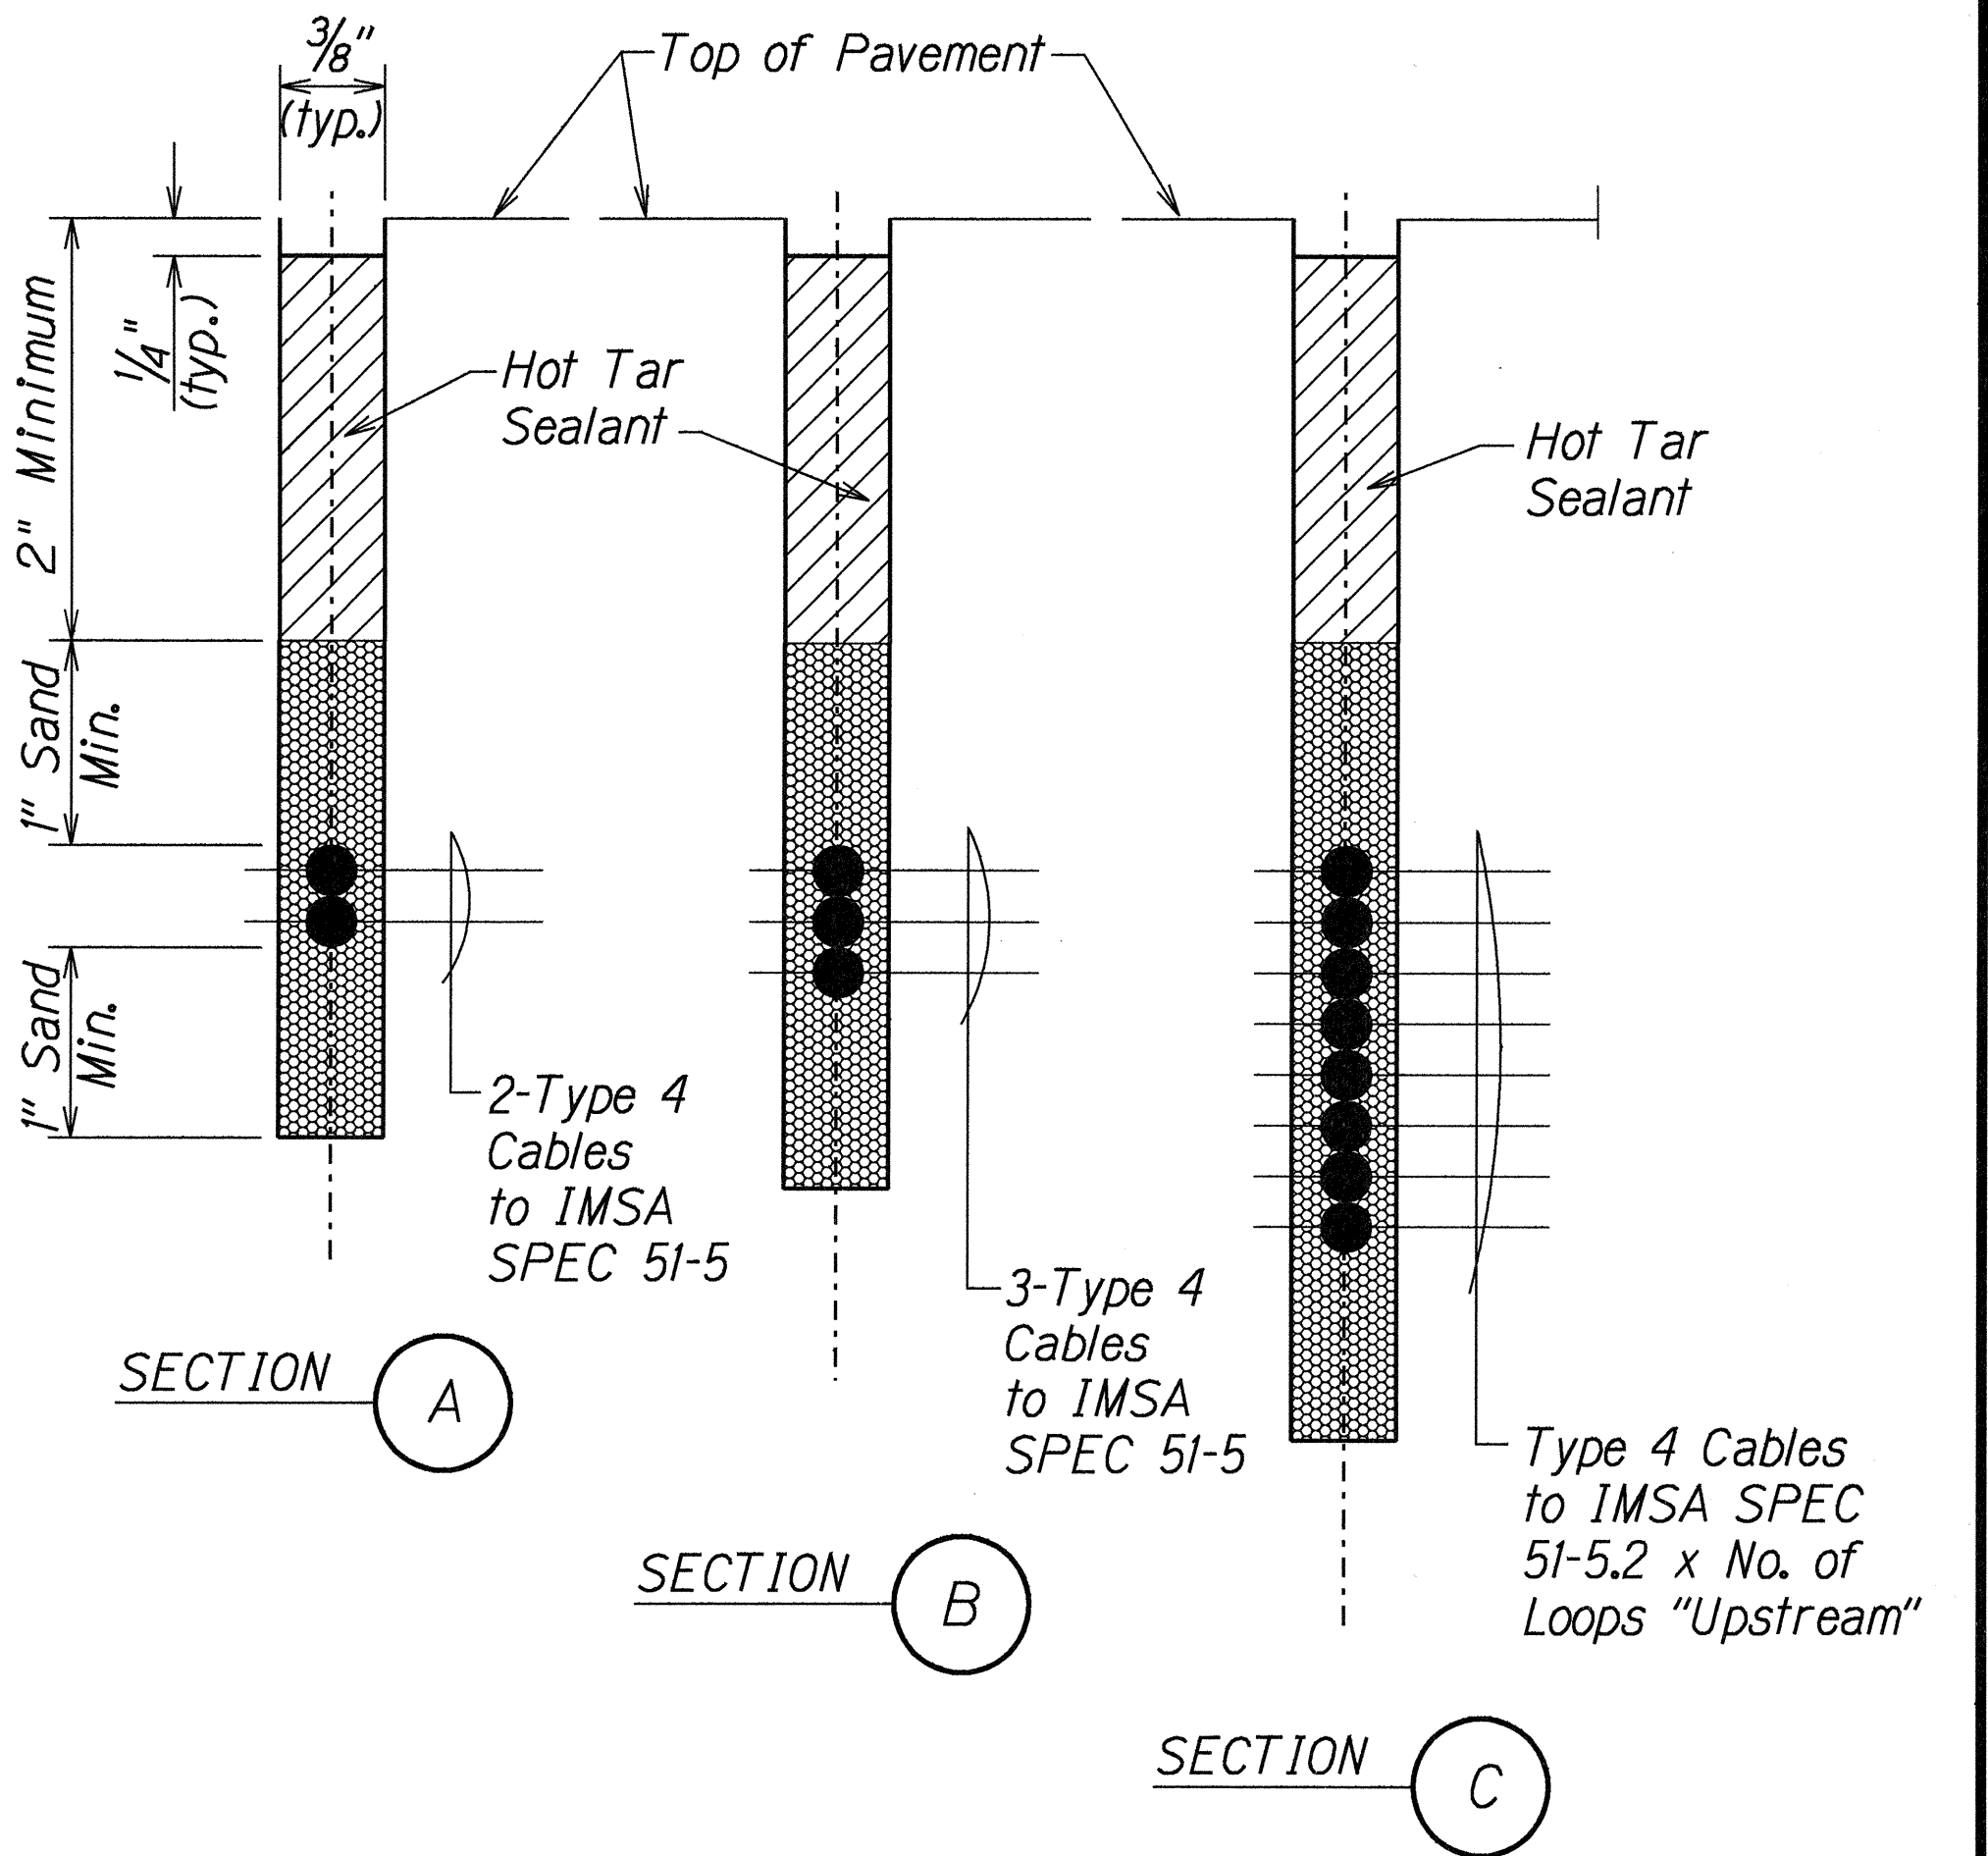


TYPICAL SECTION THROUGH SENSOR LOOP

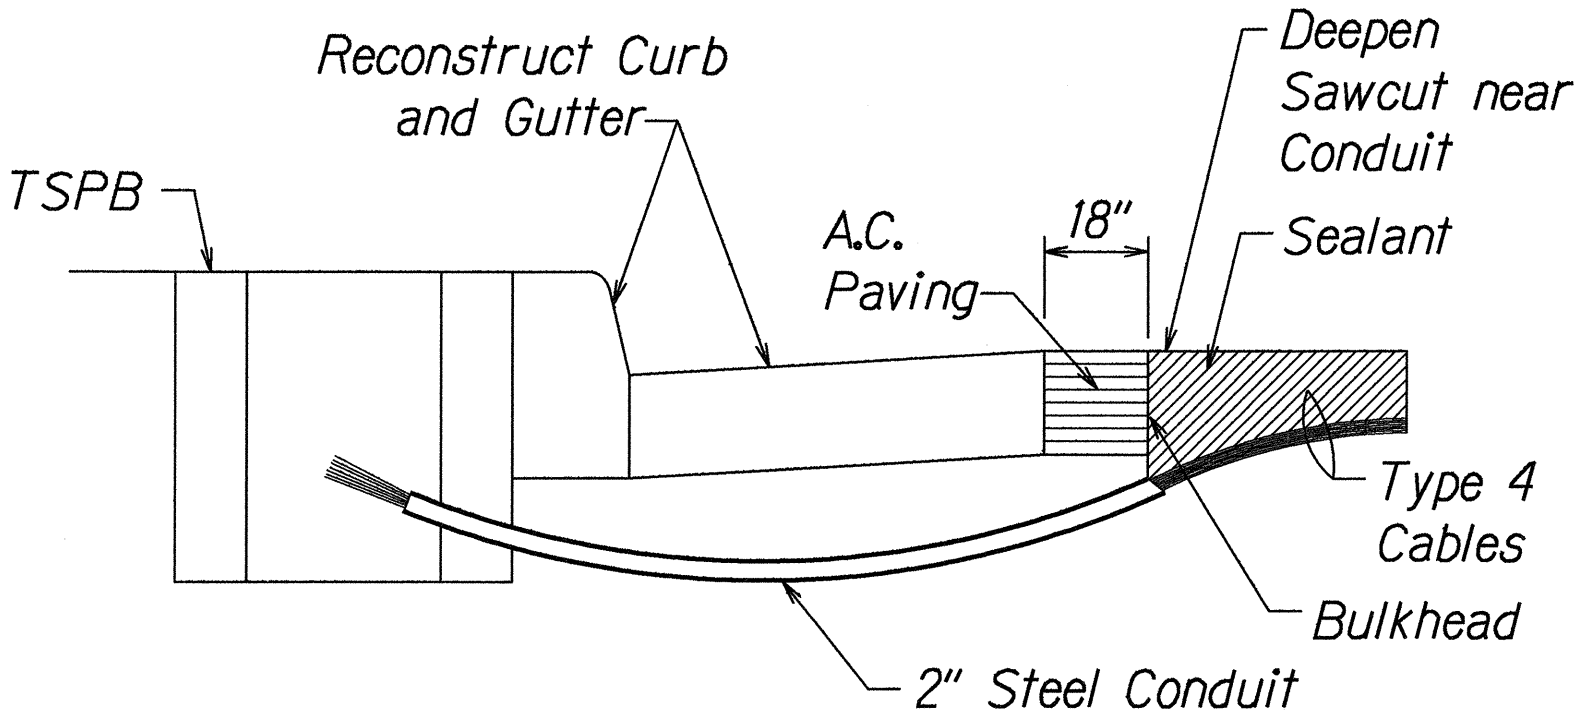

- NOTES ON CONSTRUCTION AT END OF SAWCUT
- Seal roadway end of conduit after installation of conductors.
 - Install bulkhead across conduit trench.
 - Place hot tar in sawcut.
 - Backfill over conduit with new A.C.
 - Reconstruct curb and gutter as required.

DETAIL OF SENSOR LOOP INSTALLATION AT EDGE OF ROADWAY

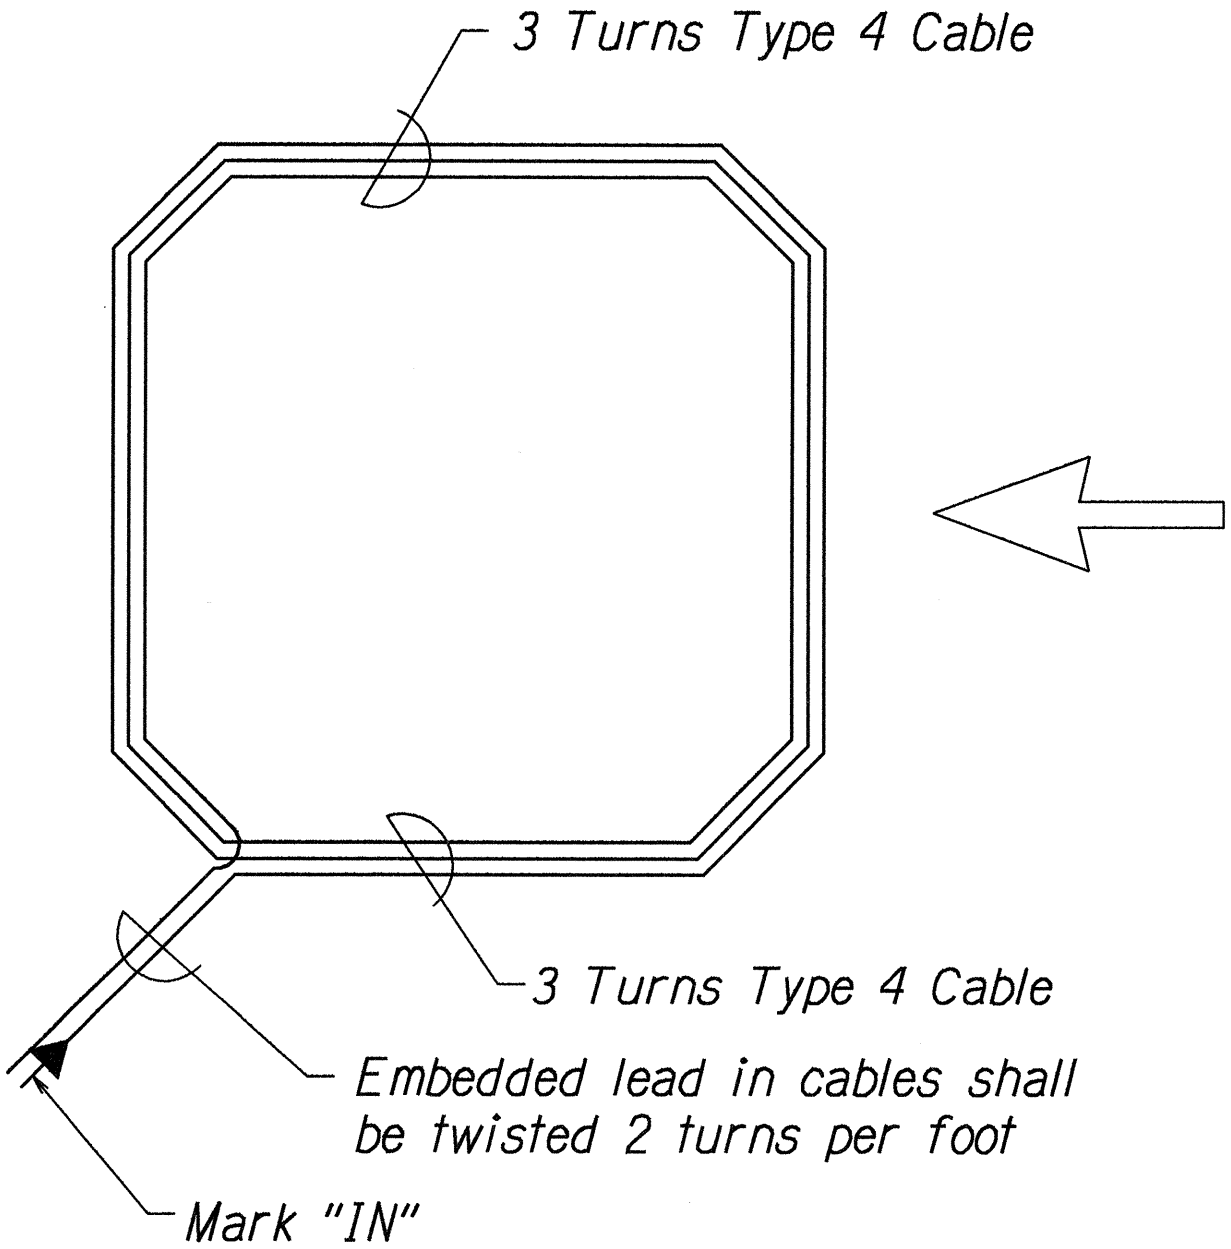

TYPICAL SENSOR LOOP WIRING DIAGRAM

ORIGINAL PLAN	DATE	10
NOTED BY	DATE	
DESIGNED BY	DATE	
CHECKED BY	DATE	

STATE OF HAWAII
DEPARTMENT OF TRANSPORTATION
HIGHWAYS DIVISION

LOOP DETECTOR DETAILS
FARRINGTON HIGHWAY IMPROVEMENTS
Waialeale Road to Aniani Place
Project No. 7101A-01-00
Not to Scale
Date: Sept., 2000

SHEET No. 711 OF 11 SHEETS