


FED. ROAD DIST. NO.	STATE	PROJ. NO.	FISCAL YEAR	SHEET NO.	TOTAL SHEETS
HAWAII	HAW.	7101A-01-04M	2006	36	74

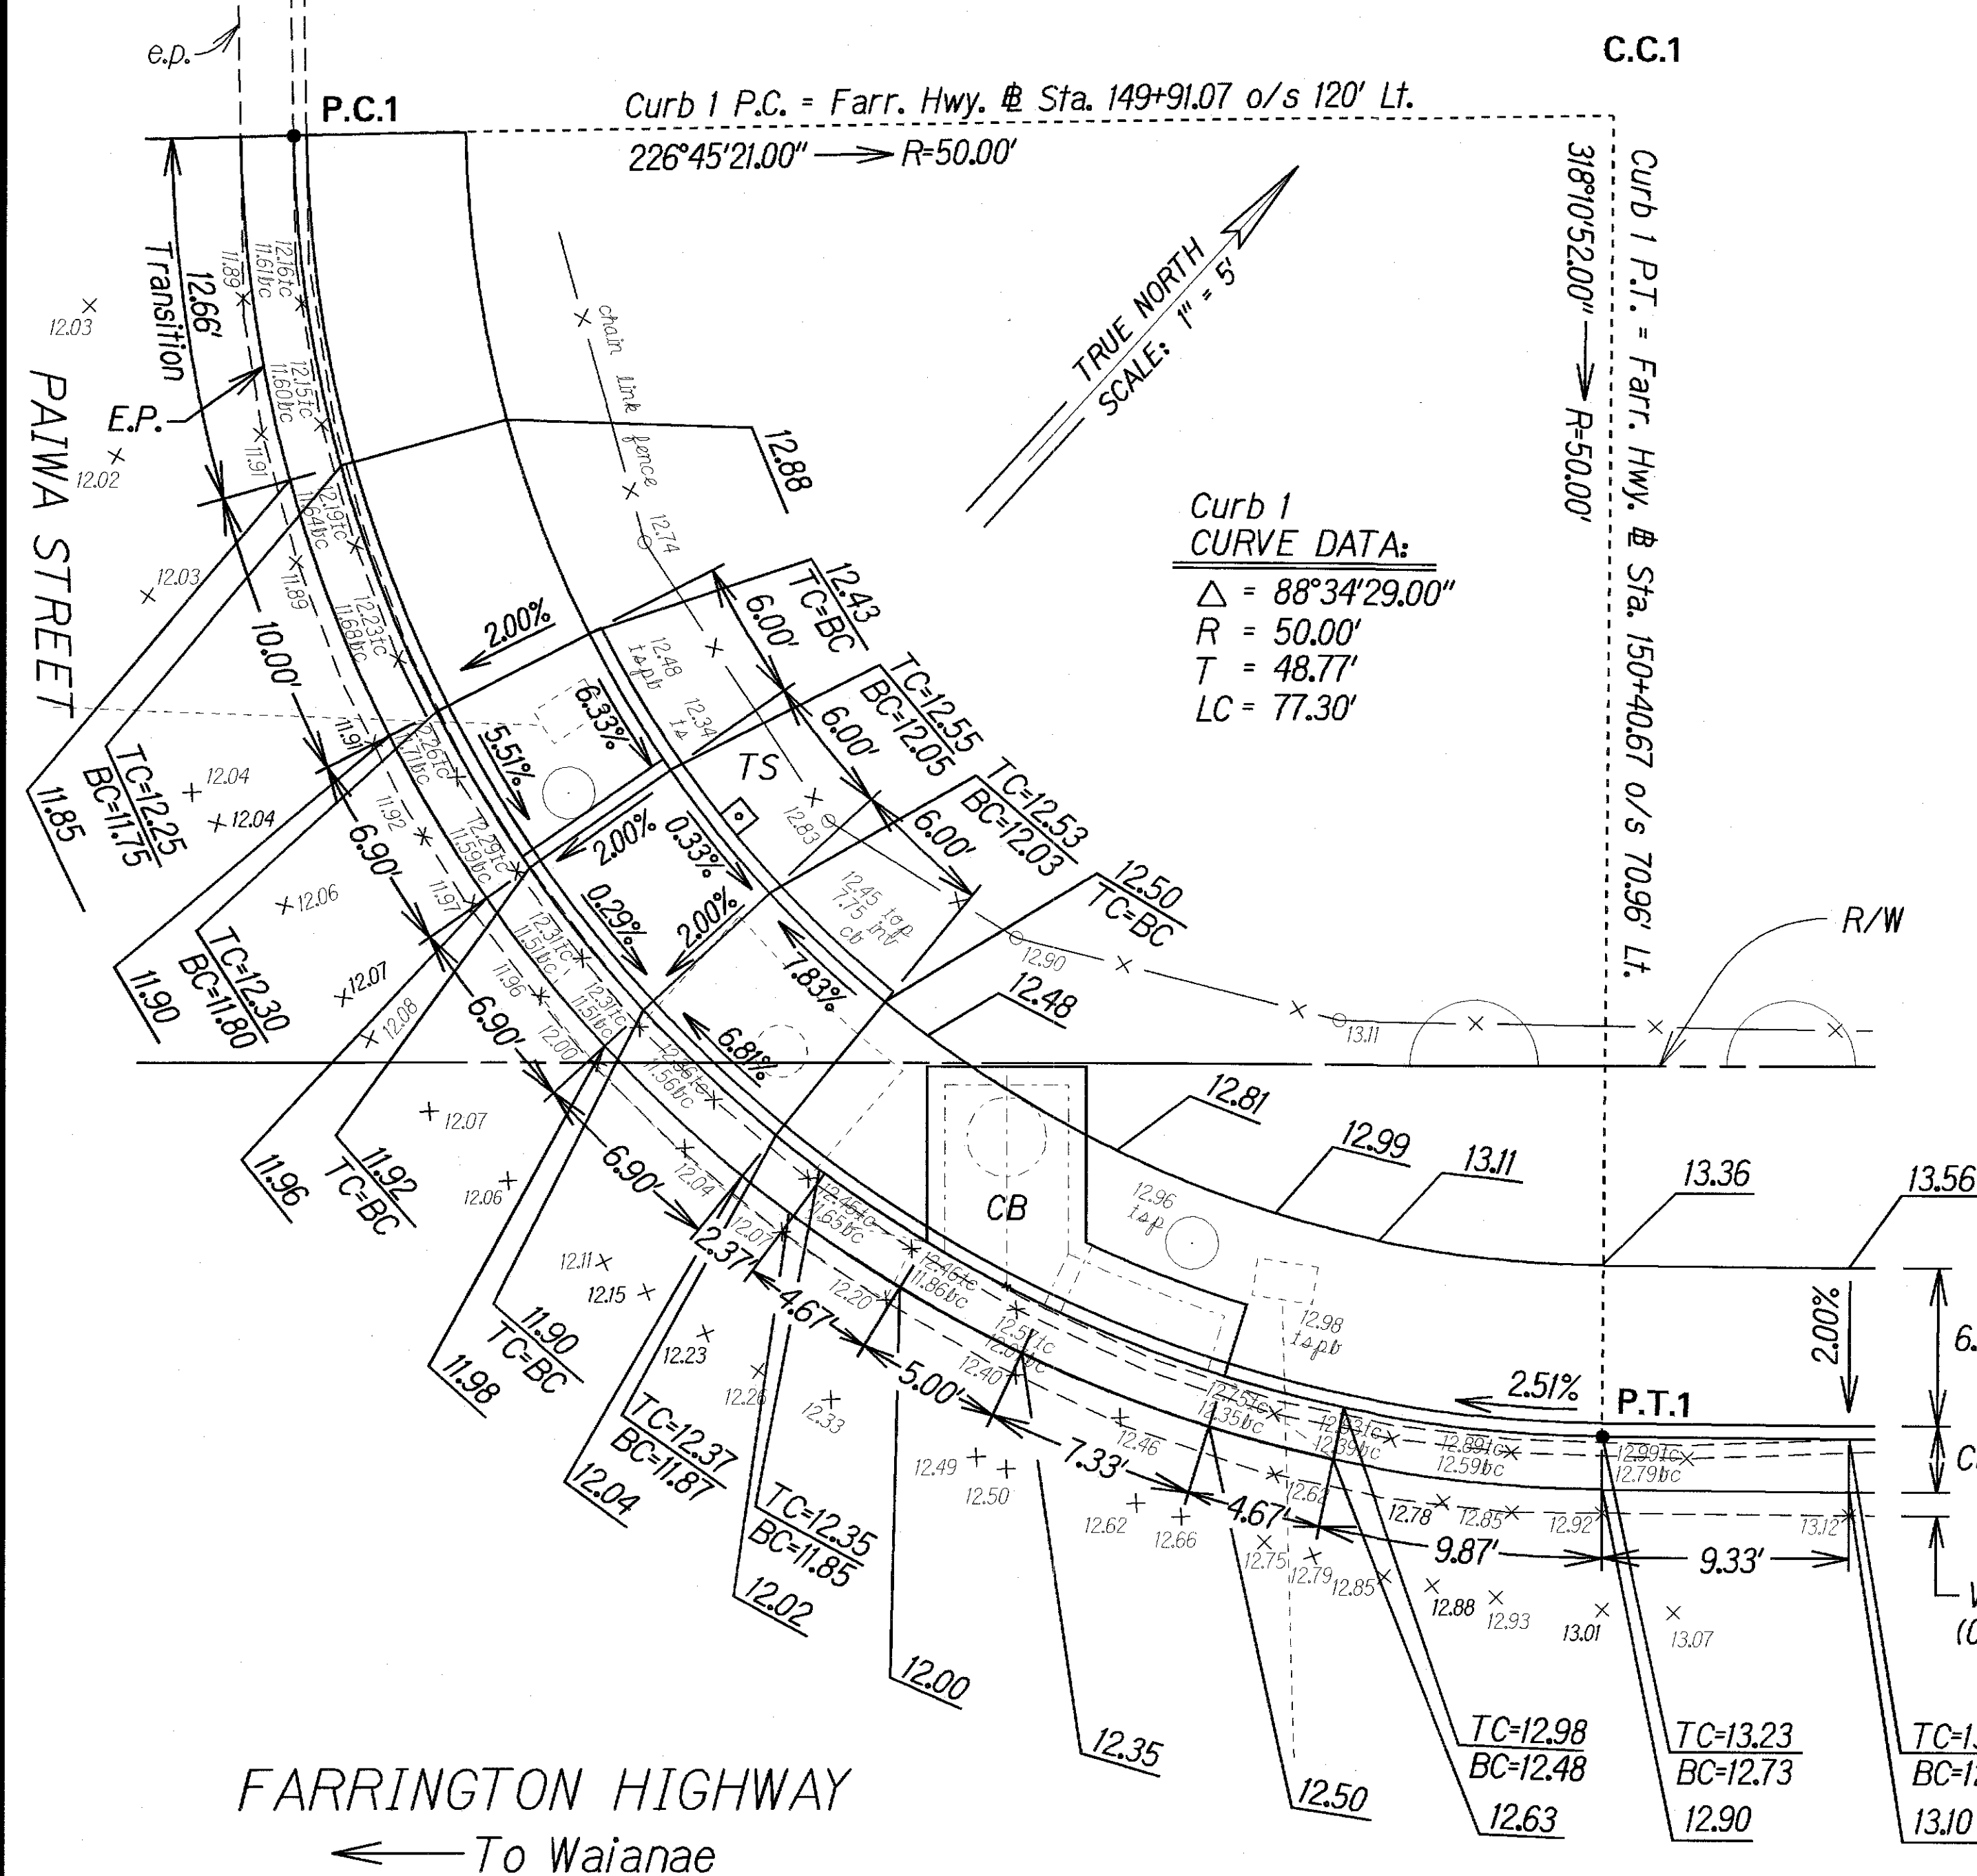


DATE	07/20/04
SURVEY PLOTTED BY	me
DRAWN BY	me
DESIGNED BY	me
CHECKED BY	me
NOTES	See notes on drawing

STATE OF HAWAII
 DEPARTMENT OF TRANSPORTATION
 HIGHWAYS DIVISION

INTERSECTION GRADING PLAN
 FARRINGTON HIGHWAY REHABILITATION,
 VICINITY OF OLD FORT WEAVER ROAD
 TO KAMEHAMEHA HIGHWAY
 PROJECT NO.: 7101A-01-04M
 Scale: 1" = 5' Date: July, 2005

SHEET No. 1 OF 2 SHEETS

FED. ROAD DIST. NO.	STATE	PROJ. NO.	FISCAL YEAR	SHEET NO.	TOTAL SHEETS
HAWAII	HAW.	7101A-01-04M	2006	C.O.36S-1	74

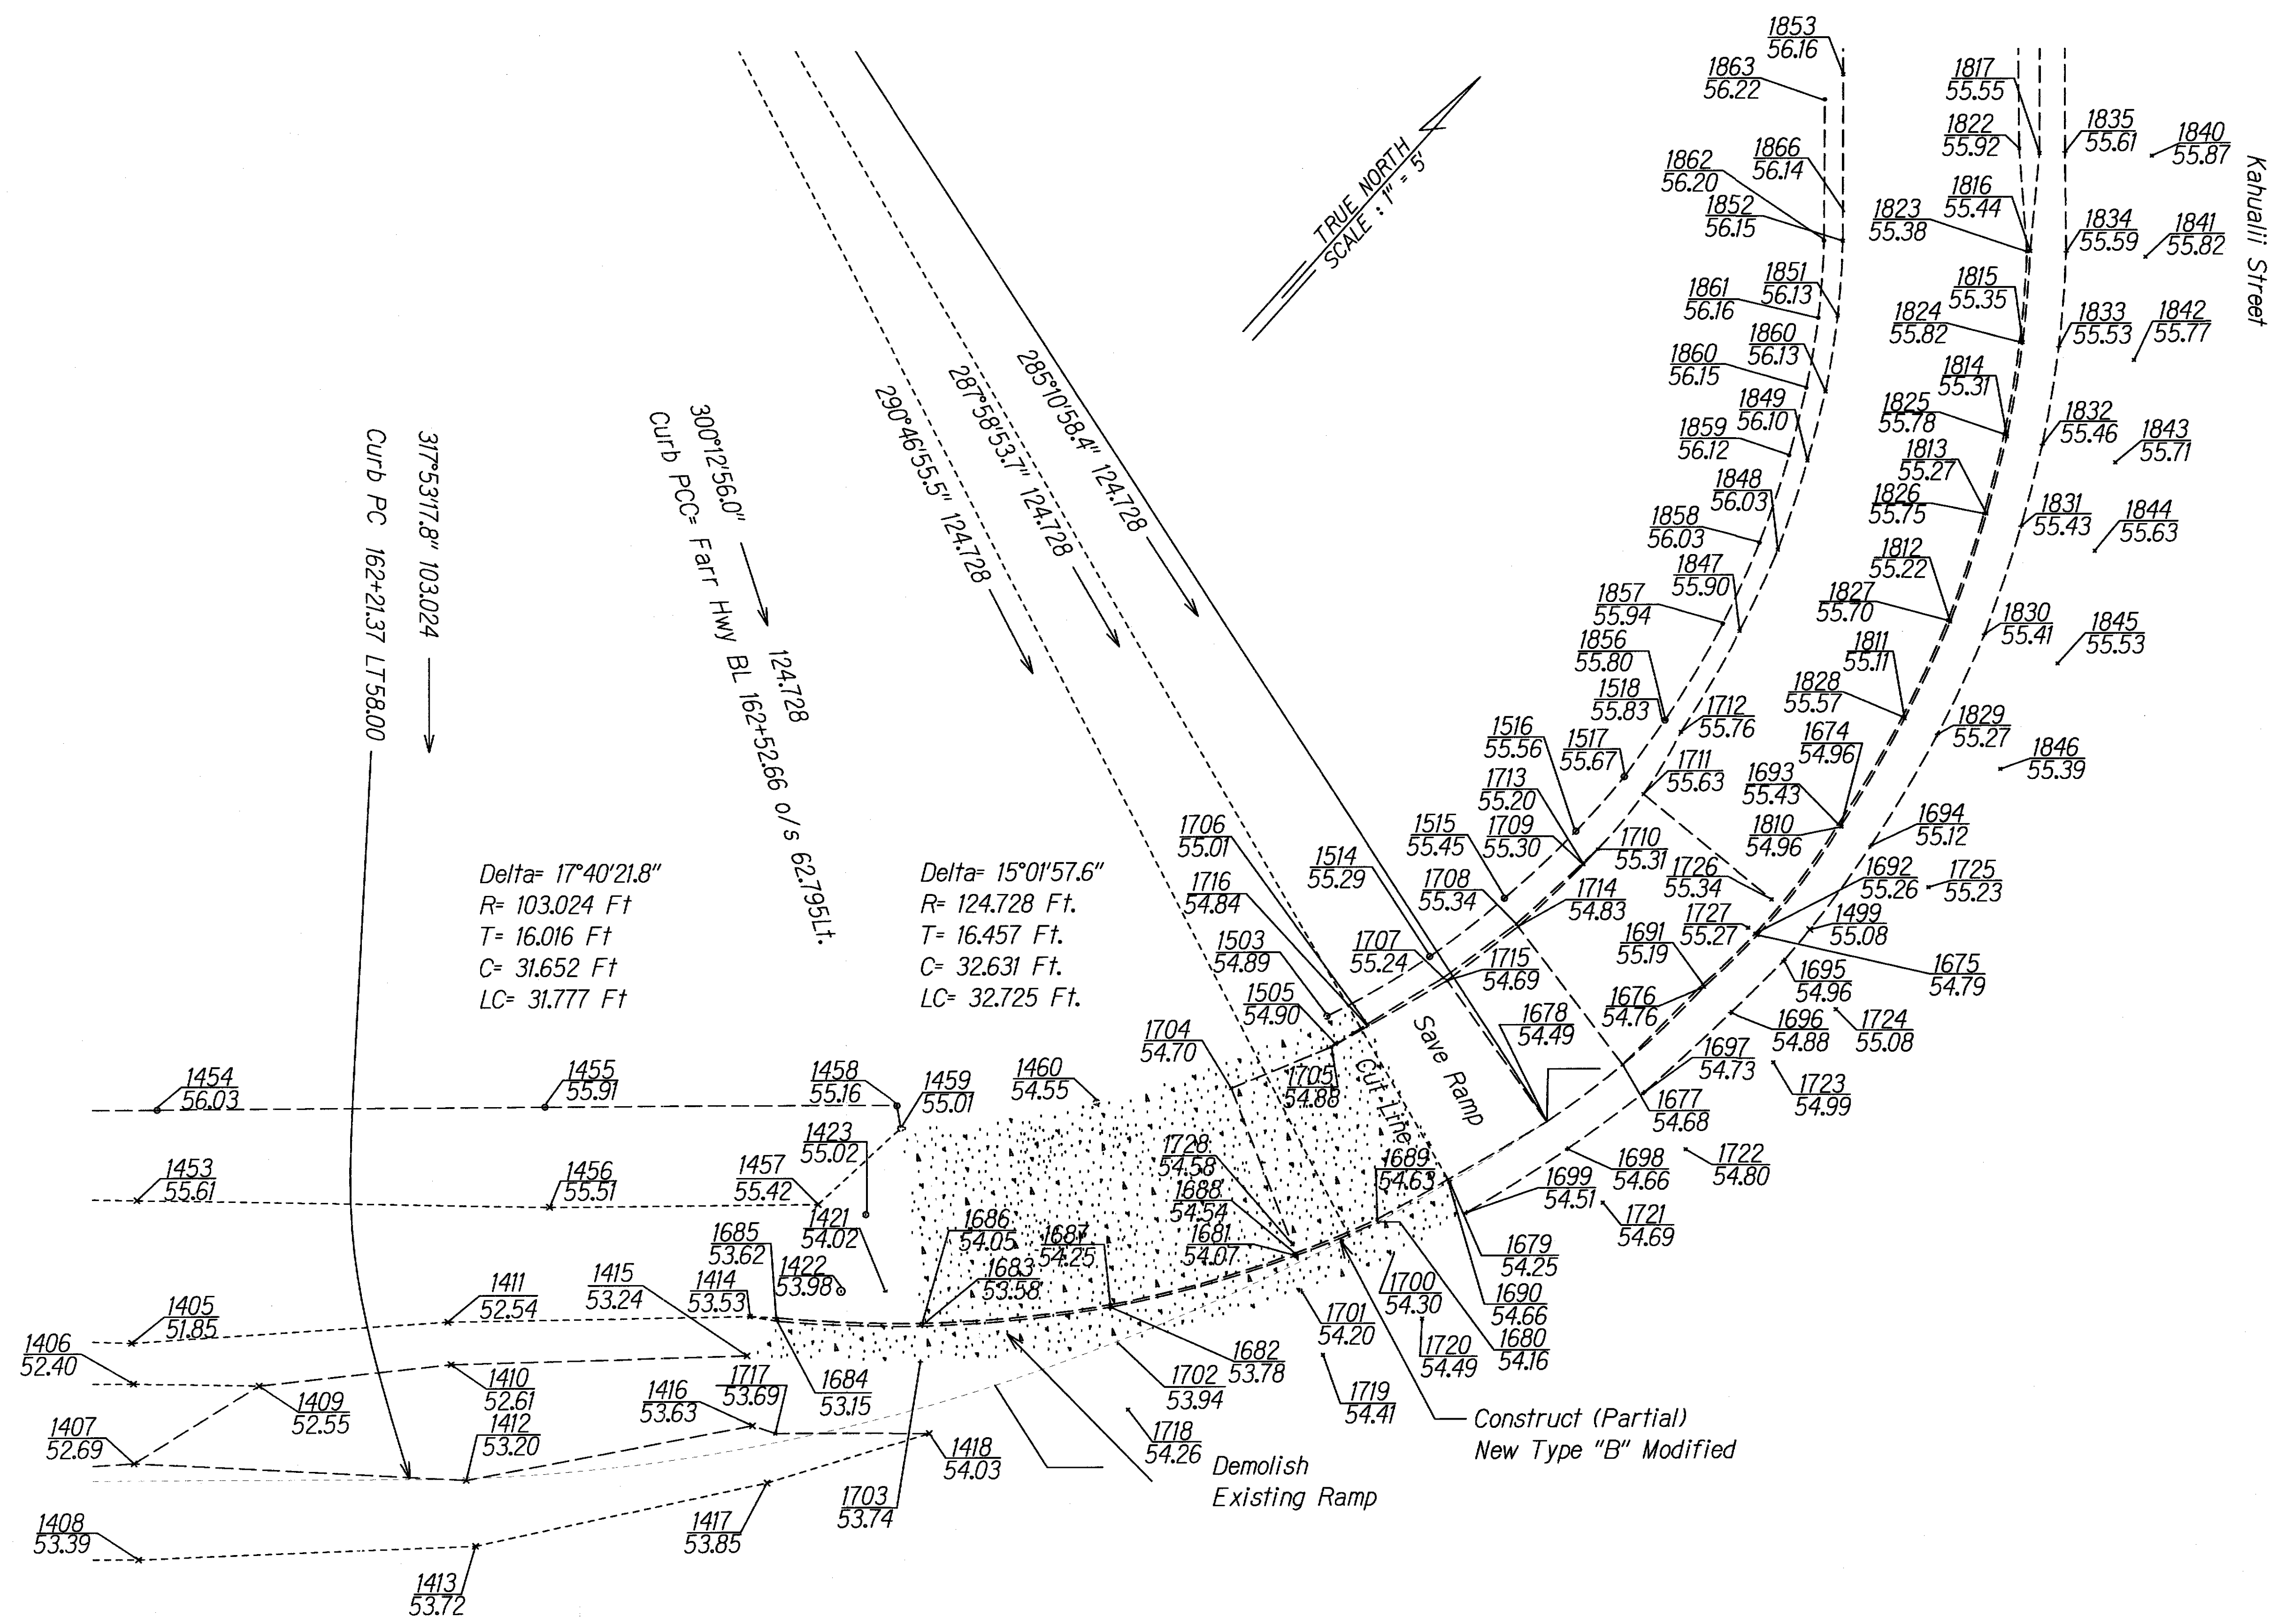


DESIGNED BY	DATE
DRAWN BY	10/20/04
CHECKED BY	07/16/04
NOTED BY	
QUANTITIES BY	
CHECKED BY	


05-14-10	C.O. Sheet created at time of As-Built Posting.
DATE	REVISION
STATE OF HAWAII DEPARTMENT OF TRANSPORTATION HIGHWAYS DIVISION INTERSECTION GRADING PLAN FARRINGTON HIGHWAY REHABILITATION, VICINITY OF OLD FORT WEAVER ROAD TO KAMEHAMEHA HIGHWAY PROJECT NO.: 7101A-01-04M Scale: 1" = 5' Date: July, 2005	
SHEET No. 1 OF 2 SHEETS	

FARRINGTON HIGHWAY AND KAHUALII STREET

FED. ROAD DIST. NO.	STATE	PROJ. NO.	FISCAL YEAR	SHEET NO.	TOTAL SHEETS
HAWAII	HAW.	7101A-01-04M	2006	C.036S-2	74

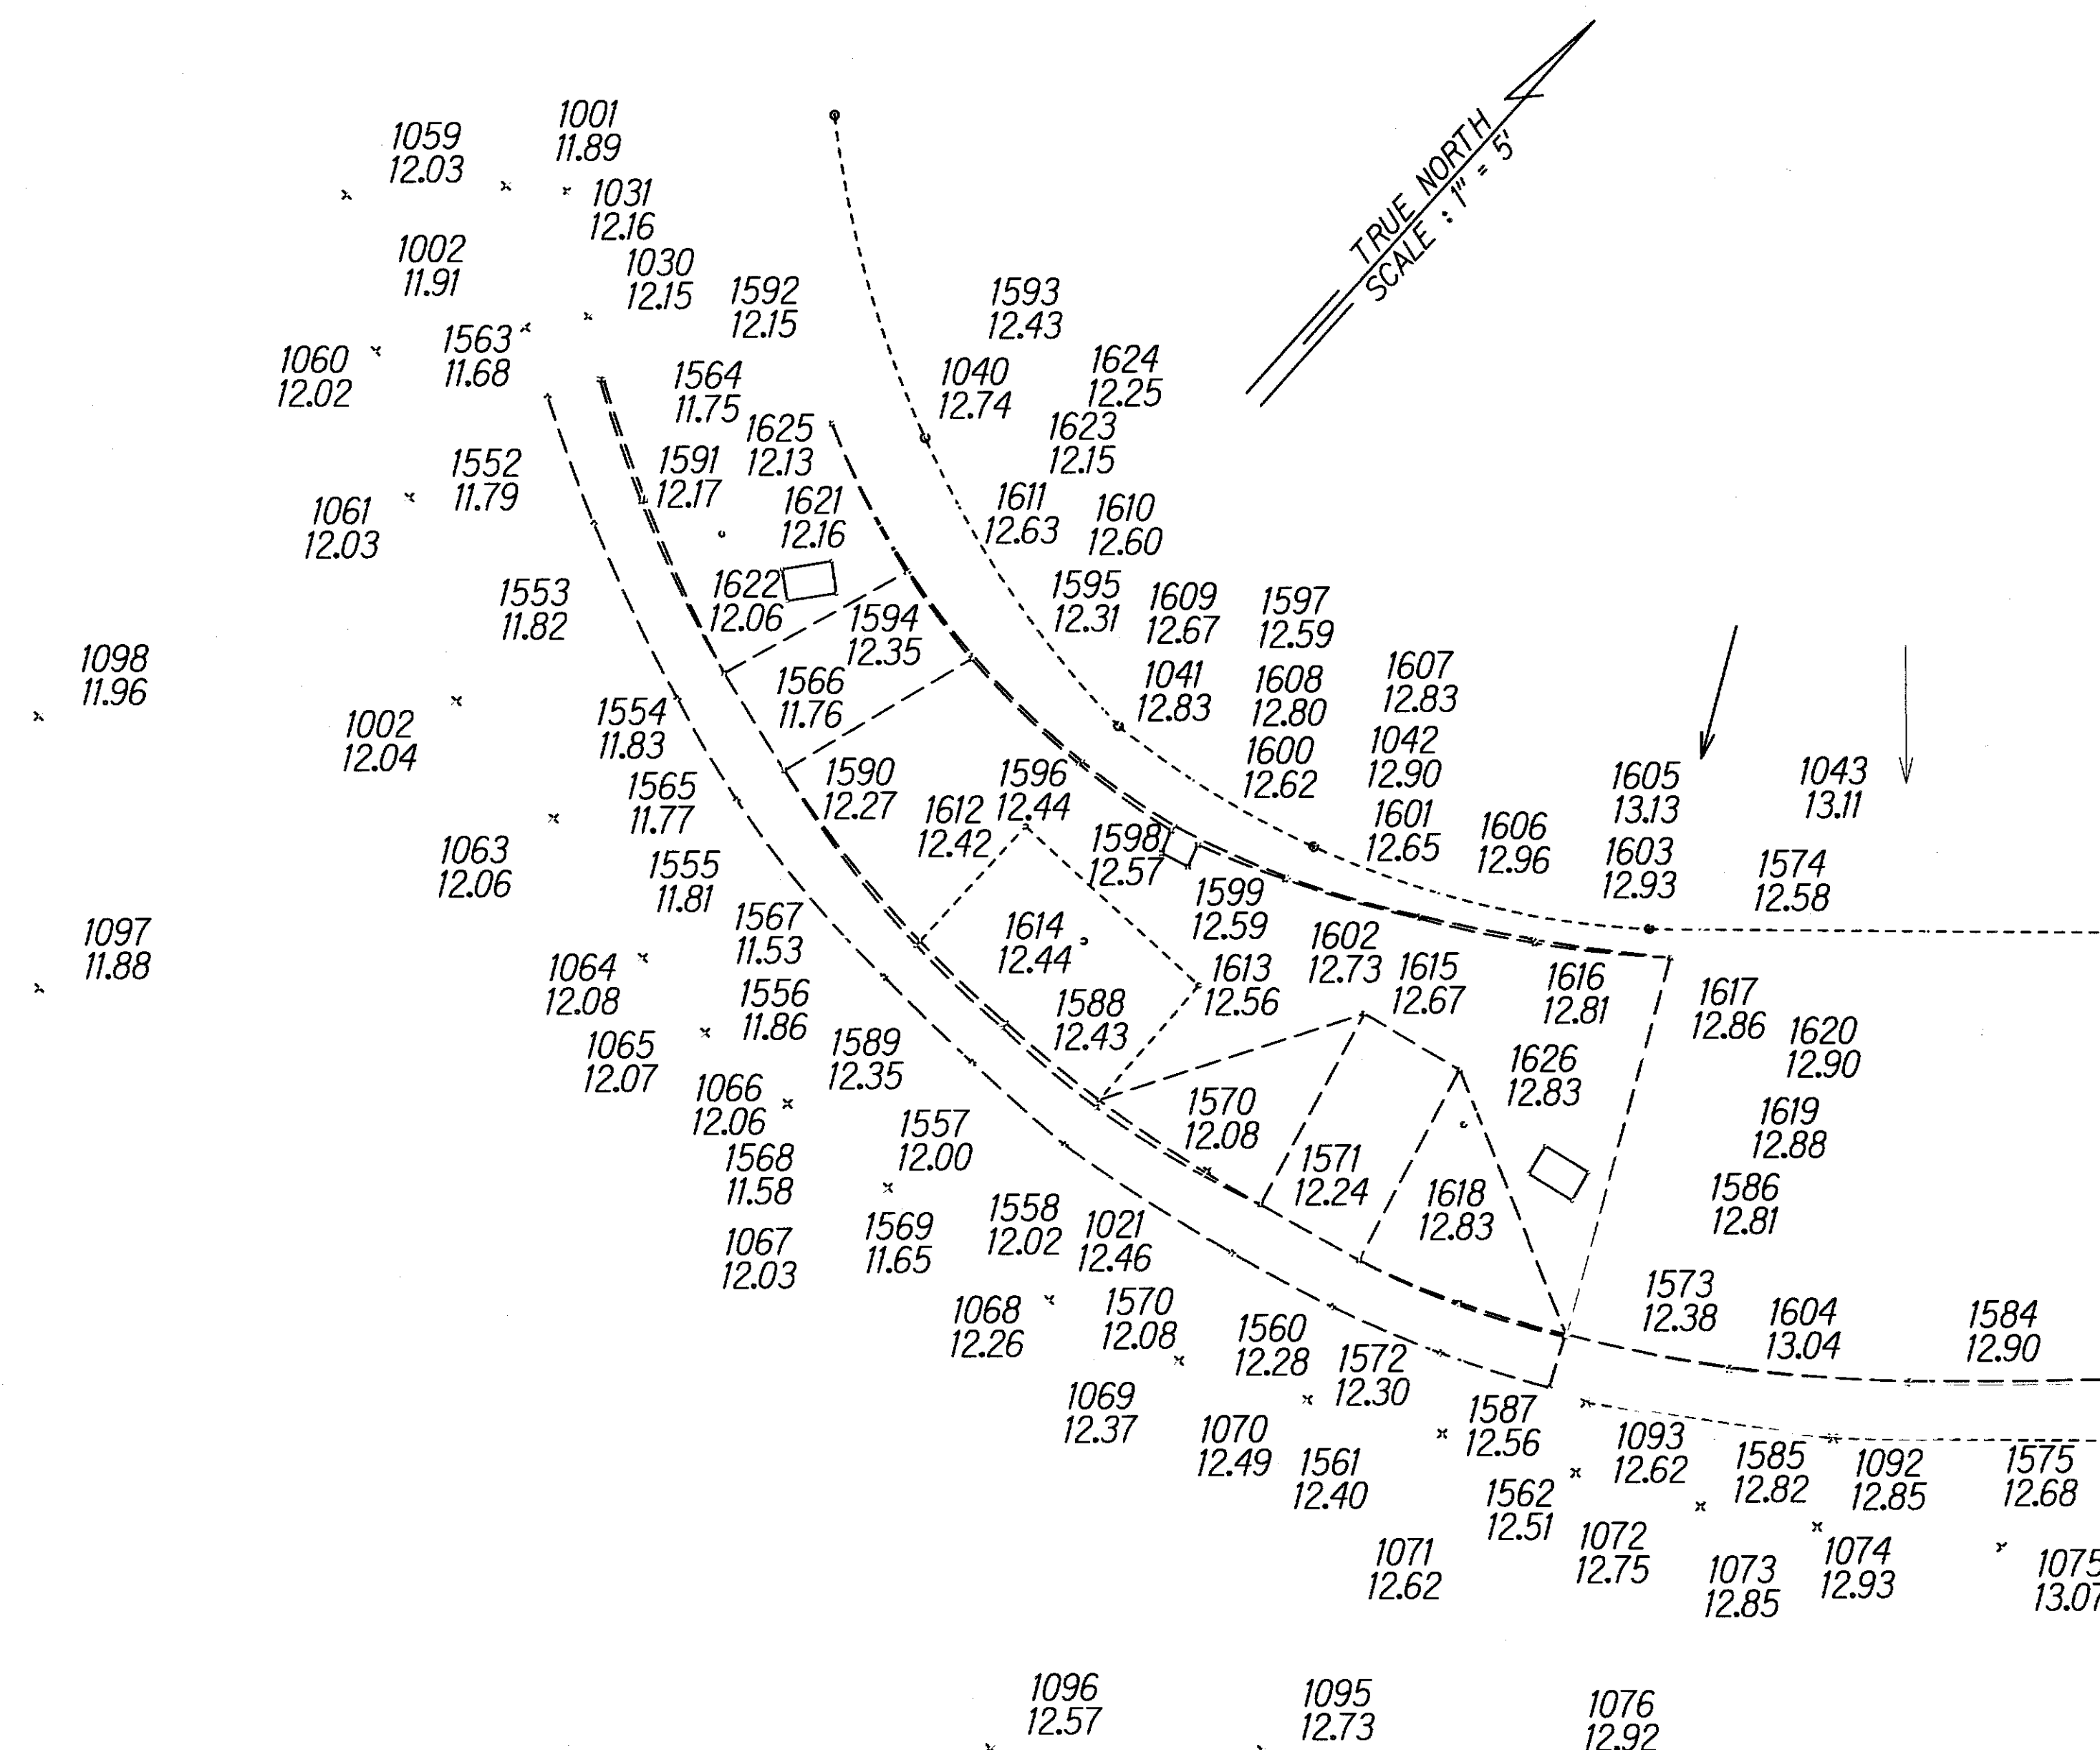

FARRINGTON HIGHWAY
← To Waianae

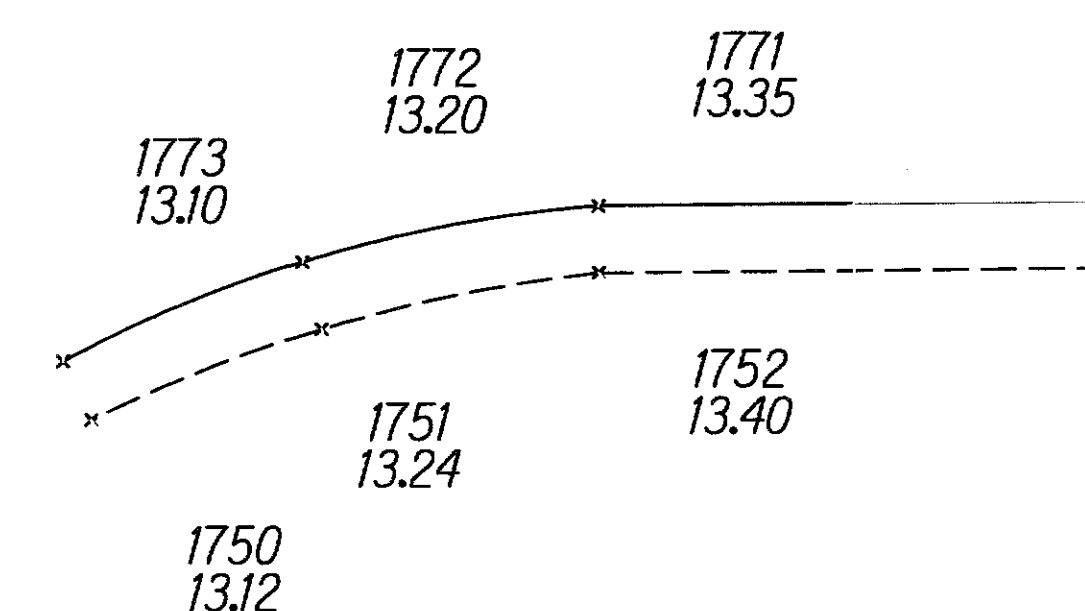

FARRINGTON HIGHWAY AND PAIWA STREET

05-14-10 C.O. Sheet created at time of As-Built Posting.

DATE	REVISION
------	----------

STATE OF HAWAII
DEPARTMENT OF TRANSPORTATION
HIGHWAYS DIVISION

INTERSECTION GRADING PLAN

FARRINGTON HIGHWAY REHABILITATION.

VICINITY OF OLD FORT WEAVER ROAD

TO KAMEHAMEHA HIGHWAY

PROJECT NO.: 7101A-01-04M

Scale: 1" = 5' Date: July, 2005


SHEET No. 1 OF 2 SHEETS

C O 36S-2

C.O.36S-2

ORIGINAL PLAN	SURVEY PLOTTED BY <u>mq</u>	DATE <u>10/20/04</u>
NOTE BOOK	TRACED BY _____	DESIGNED BY <u>mq</u>
<u>0051827.mq</u>	QUANTITIES BY _____	<u>07/18/04</u>
<u>Bas and dipol.dgn</u>	CHECKED BY _____	

FED. ROAD DIST. NO.	STATE	PROJ. NO.	FISCAL YEAR	SHEET NO.	TOTAL SHEETS
HAWAII	HAW.	7101A-01-04M	2006	37	74

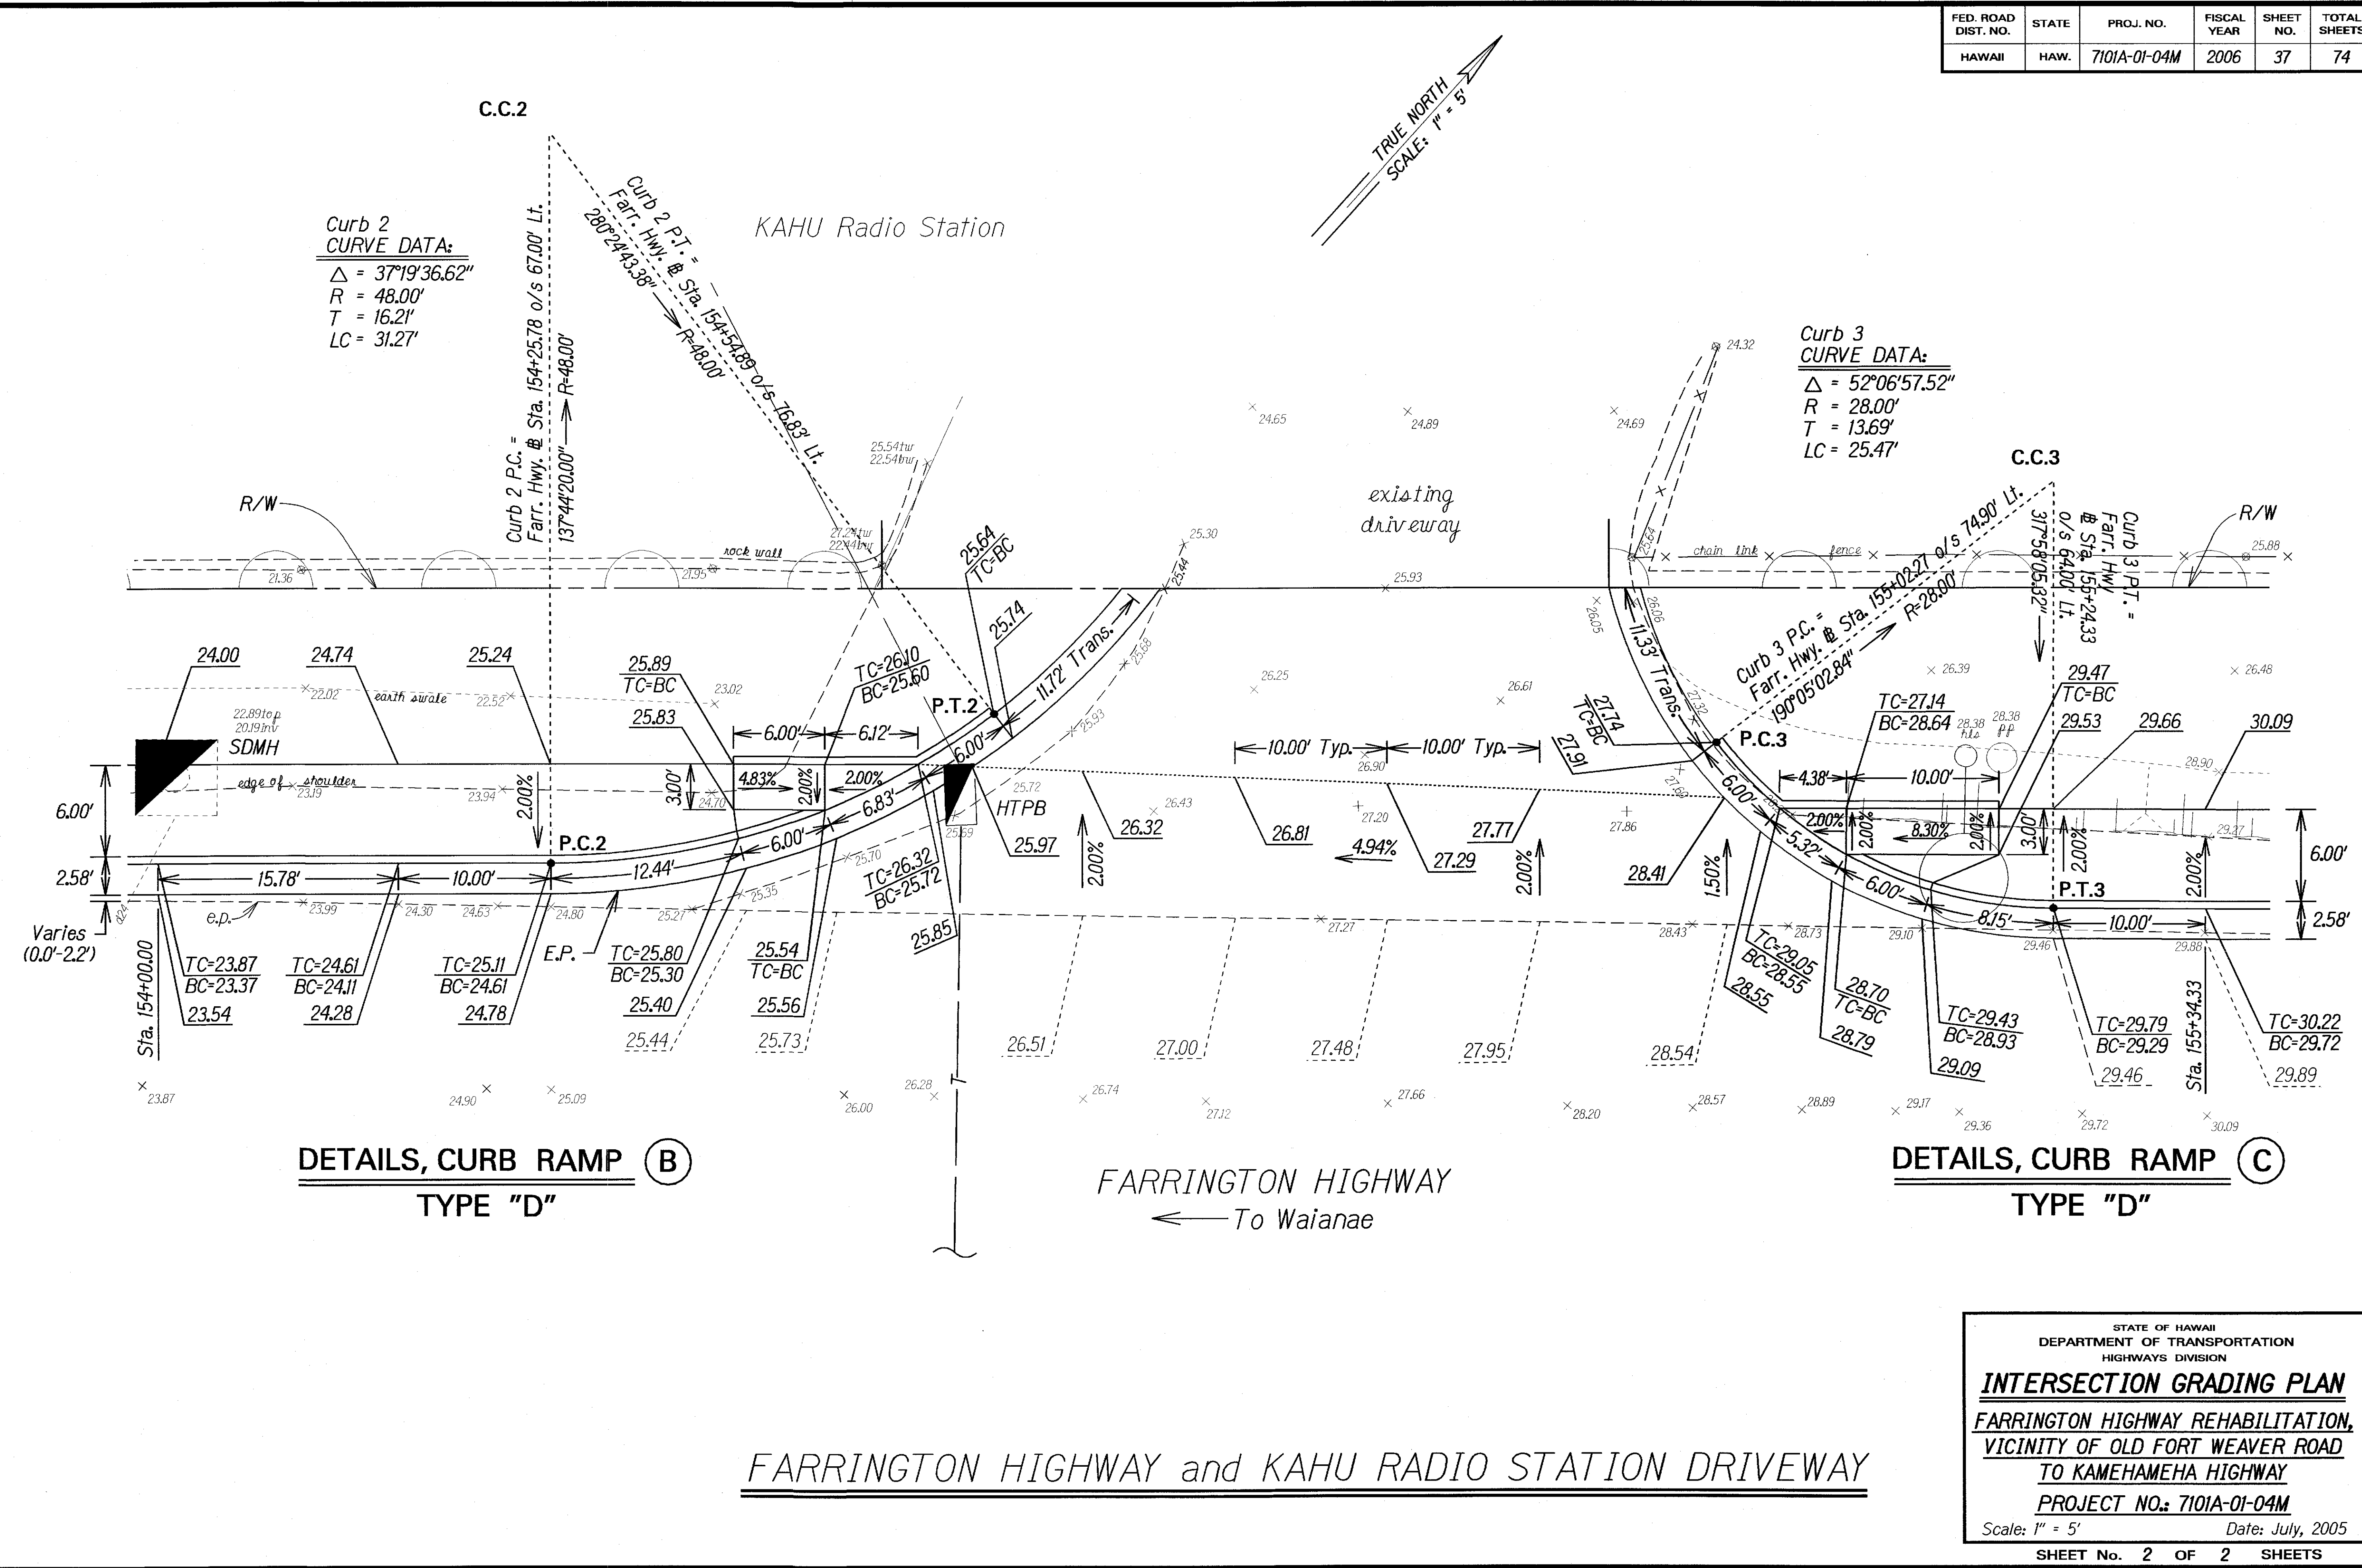

DATE	07/20/04
PLAN	
TRACED BY	MQ
QUANTITIES BY	
CHECKED BY	
ORIGINAL	
PLAN	
TRACED BY	MQ
QUANTITIES BY	
CHECKED BY	