



FED. ROAD DIST. NO.	STATE	PROJ. NO.	FISCAL YEAR	SHEET NO.	TOTAL SHEETS
HAWAII	HAW.	7101A-01-04M	2006	9	74

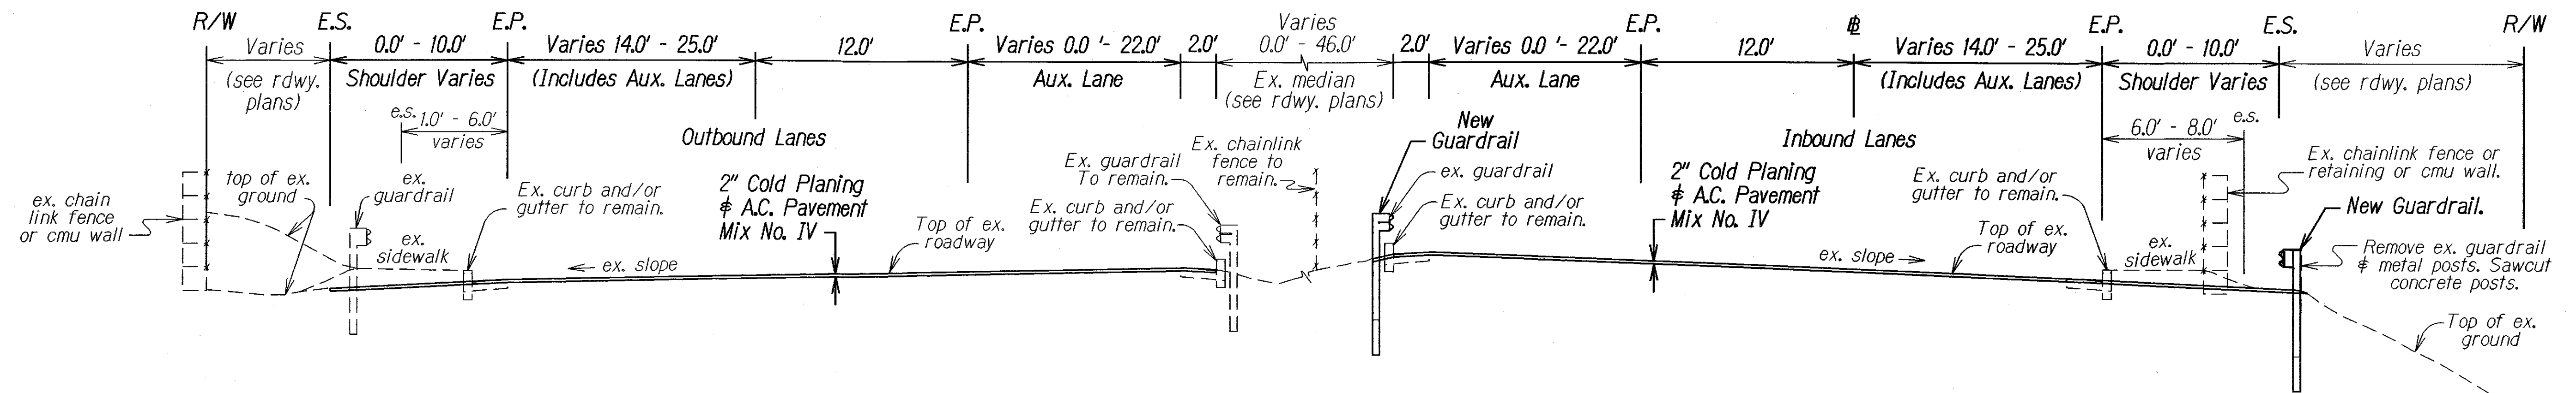


TYPICAL TANGENT SECTION

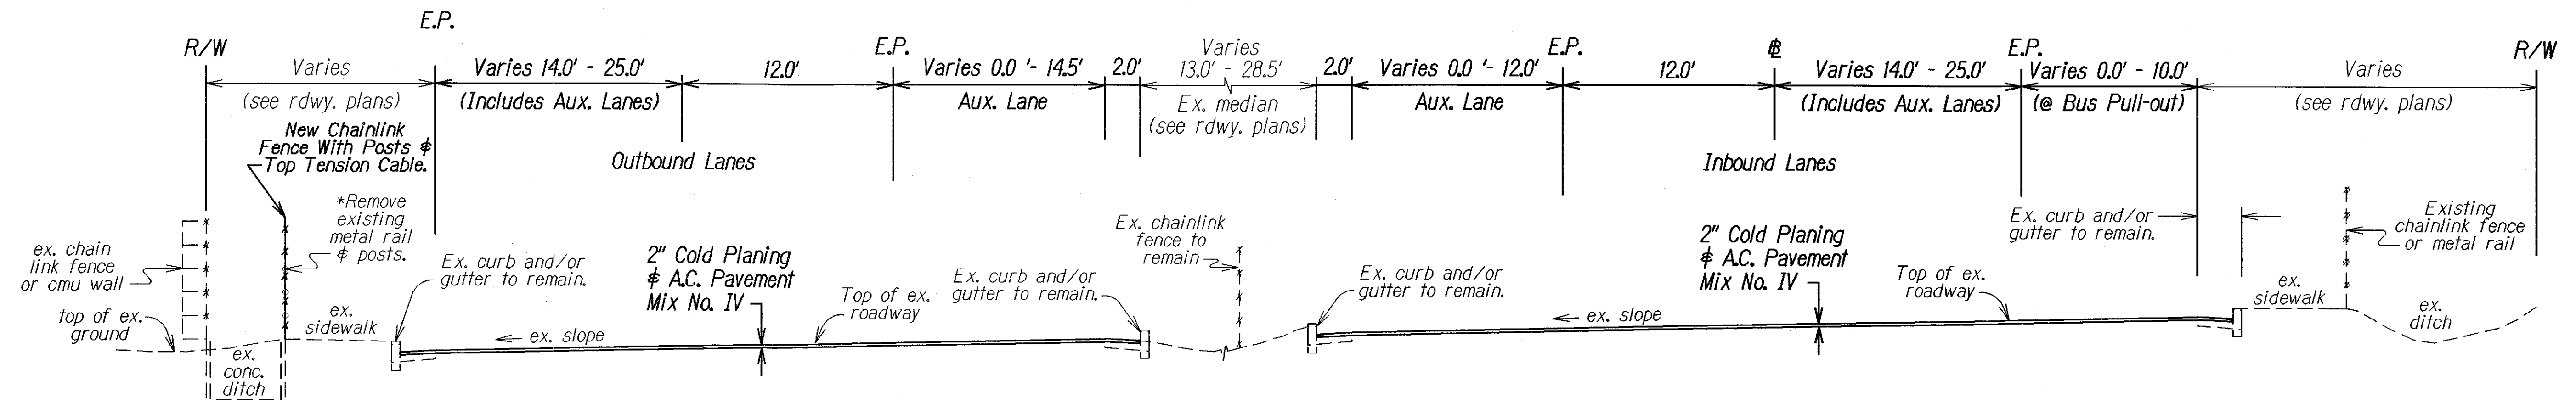

TYPICAL SUPERELEVATED SECTION

* Farrington Highway
 @ Sta. 139+35± to @ Sta. 148+90± Lt.

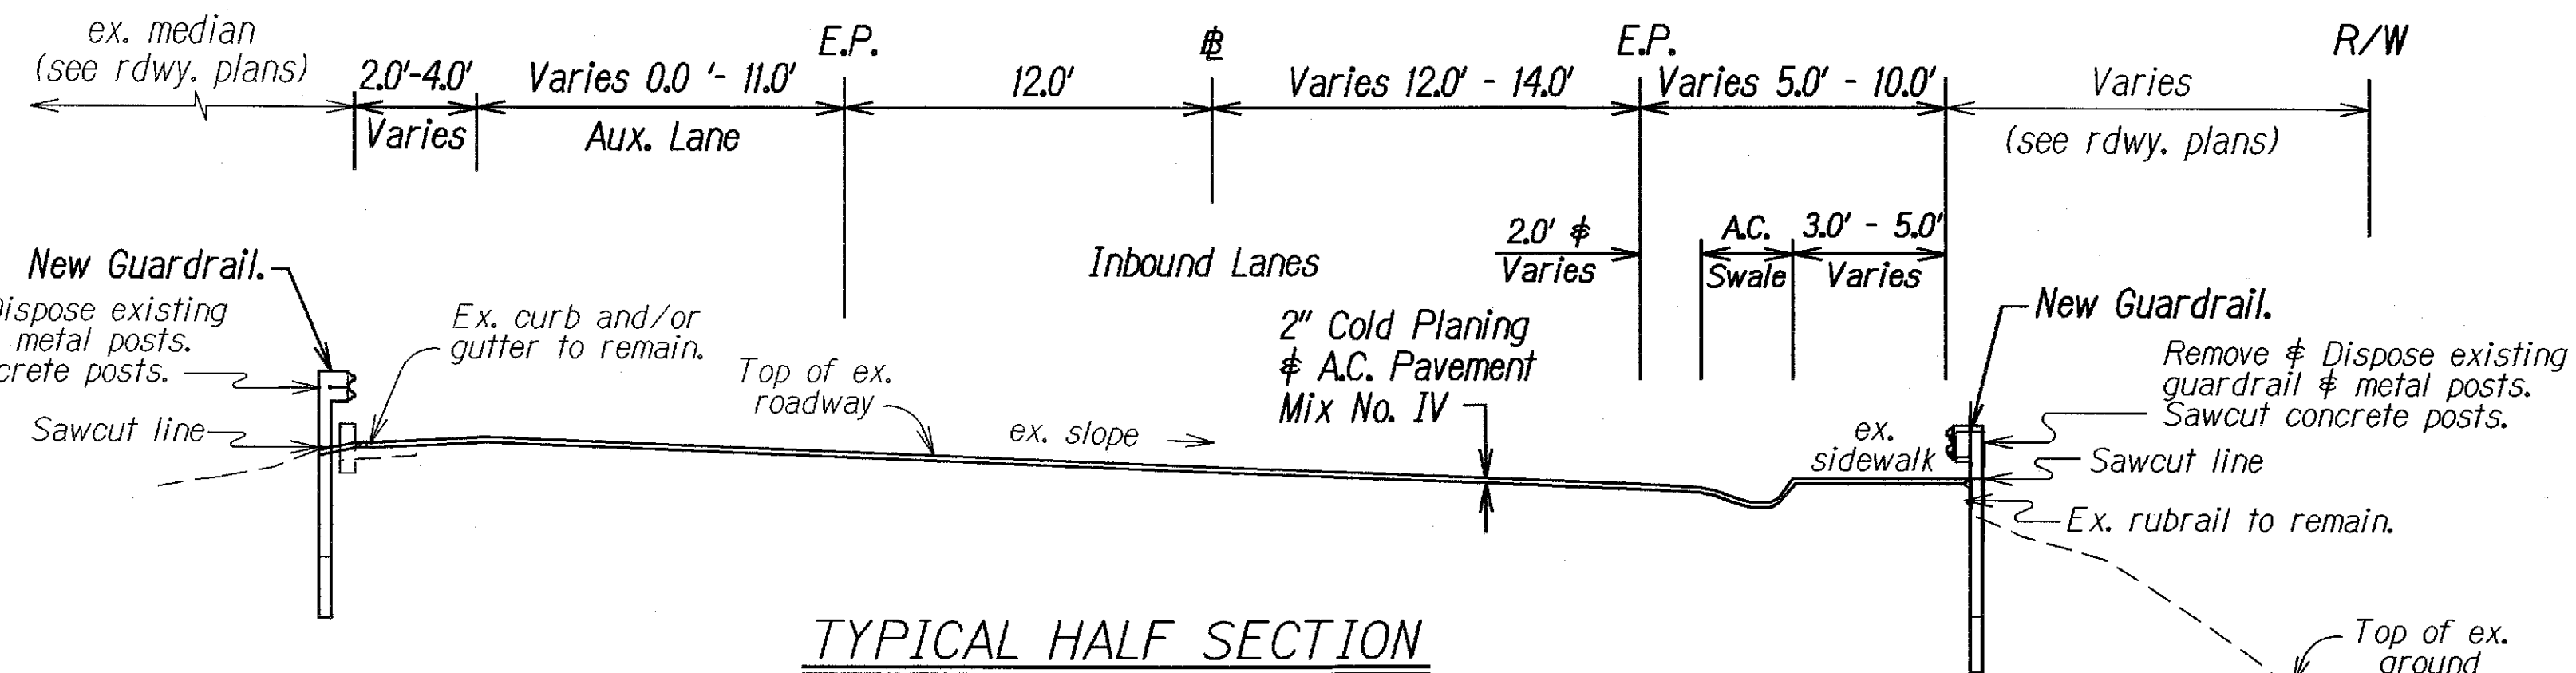

TYPICAL HALF SECTION

FARRINGTON HIGHWAY
 @ STA. 107+00± to @ STA. 110+95±

Notes:

1. For Guardrails, Auxiliary Lanes, Shoulder, Sidewalk, Chain Link Fence and Metal Rail Locations, See Roadway Plans.
2. For Right Through Lane Widths: 14.0' At Gutter Line
 14.0' At Curb Face
3. Concrete Bus Pad To Remain. Resurface Only The Tapers.
4. All New Guardrail Posts Shall Be 8.00' Long Except Where Specified.

STATE OF HAWAII
 DEPARTMENT OF TRANSPORTATION
 HIGHWAYS DIVISION

TYPICAL SECTION

**FARRINGTON HIGHWAY REHABILITATION,
 VICINITY OF OLD FORT WEAVER ROAD
 TO KAMEHAMEHA HIGHWAY**

PROJECT NO.: 7101A-01-04M

Not to Scale Date: July, 2005

SHEET No. 1 OF 1 SHEETS

