

INDEX TO DRAWINGS	
SHEET NO.	DESCRIPTION
1	Title Sheet
2	Typical Road Section
3-4	Plan & Profile
5-6	Regulatory & Warning Signs
7-12	Cross Sections
13-17	Standard Details

STATE OF HAWAII
DEPARTMENT OF TRANSPORTATION
BUREAU OF HIGHWAYS
HONOLULU, HAWAII
"AS BUILT"
PLANS OF


IMPROVEMENTS
TO
FARRINGTON HIGHWAY
EWA-WAIANAE JUNCTION TO KUNIA JUNCTION
PROJECT NO. A-90-02-60
AND
KUNIA ROAD
AT
FARRINGTON HIGHWAY
PROJECT NO. A-75-01-60
DISTRICT OF EWA
ISLAND OF OAHU

SCALES

PLAN		1"= 50'
PROFILE	HORIZ.	1"= 50'
PROFILE	VERT.	1"= 10'
X SECTION	HORIZ.	1"= 10'
X SECTION	VERT.	1"= 5'

LENGTH OF PROJECTS

PROJECT NO. A-90-02-60 0.473 Mi.
PROJECT NO. A-75-01-60 0.076 Mi.

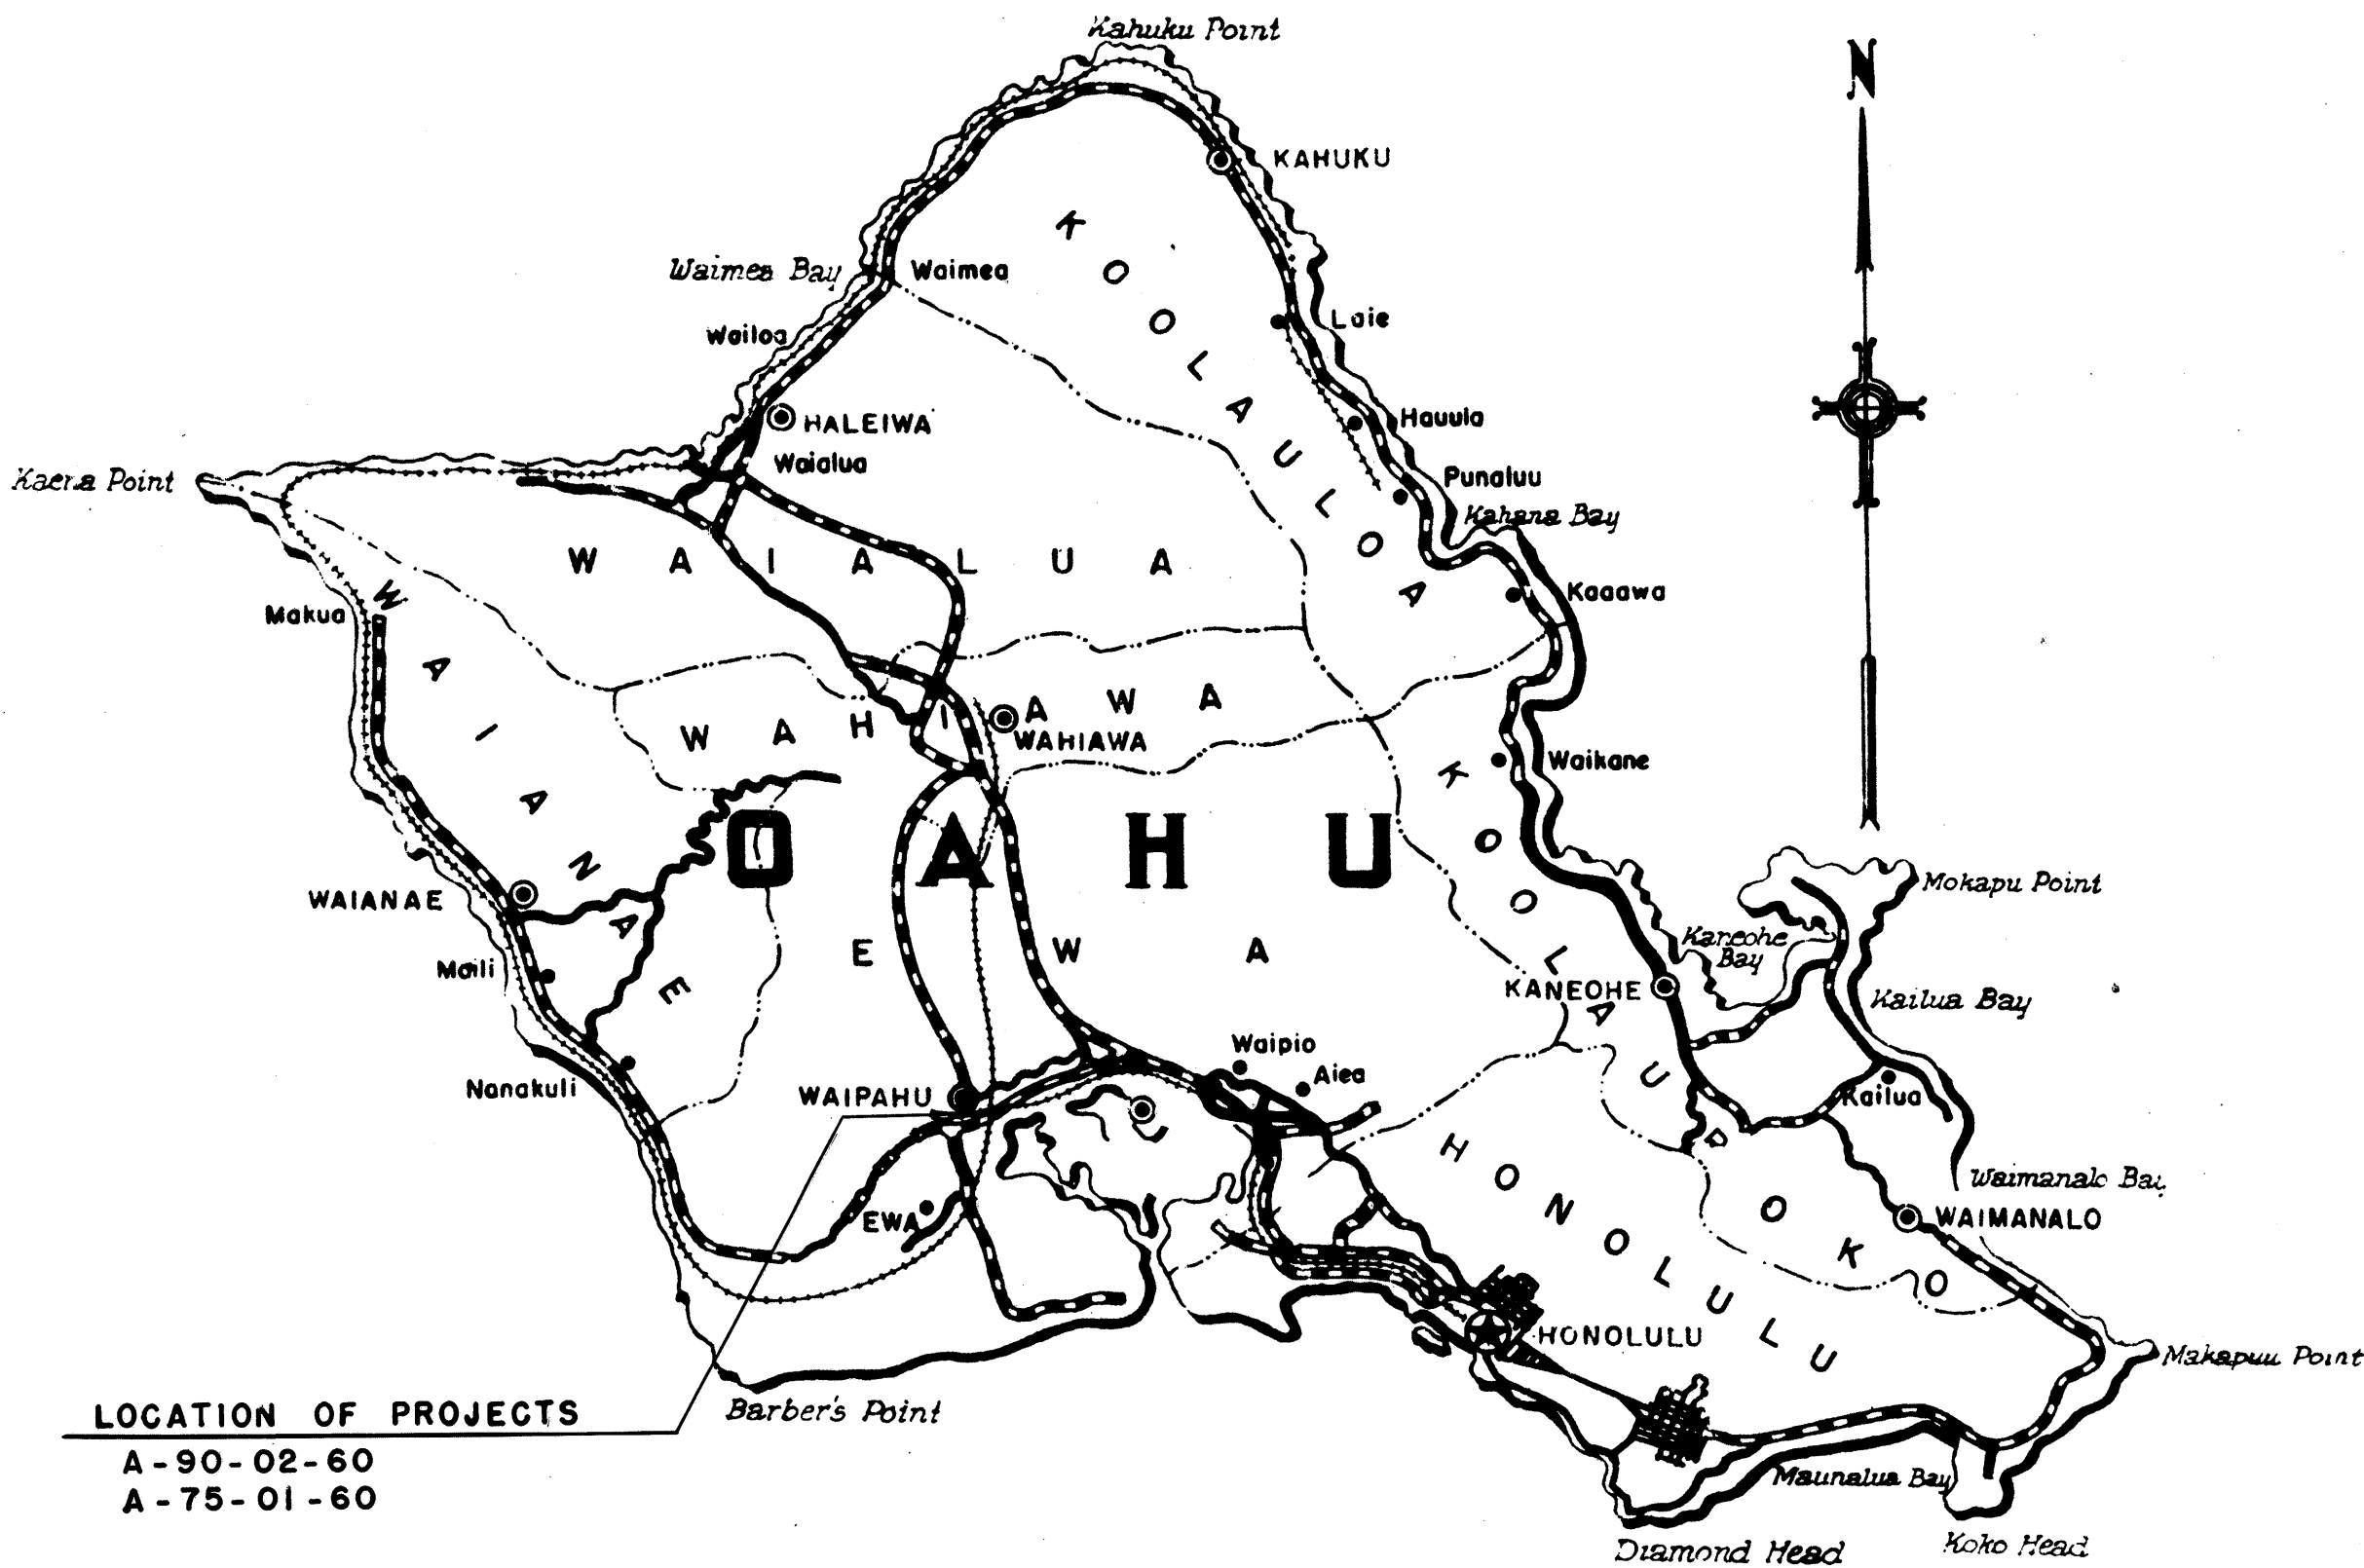

NOTE:
 PLAN SHEETS IN THIS SET WHICH HAVE
 BEEN CHANGED INCLUDE NO.'S 2, 2A, 4,
 6, 12.

NOTE:
ALL CHANGES MADE DURING CONSTRUCTION
HAVE BEEN NOTED IN RED IN THESE TRACINGS
AND CHECKED BY:

DISTRICT ENGINEER
DATE: Jan 5, 1961

APPROVED:

DIRECTOR OF TRANSPORTATION

DATE 4/5/60

SURVEY PLOTTED BY	DATE
ORIGINAL PLAN	
TRACED BY	
NOTE BOOK	
QUANTITIES CHECKED BY	
CHECKED BY	