

GENERAL NOTES

FED. ROAD DIST. NO.	STATE	FED. AID PROJ. NO.	FISCAL YEAR	SHEET NO.	TOTAL SHEETS
HAWAII	HAW.	M-7600(1)	1978	132	198

1. **GENERAL SPECIFICATIONS:** HAWAII DEPARTMENT OF TRANSPORTATION, STANDARD SPECIFICATIONS FOR ROAD AND BRIDGE CONSTRUCTION, 1976, TOGETHER WITH SPECIAL PROVISIONS PREPARED FOR THIS CONTRACT.
2. **DESIGN SPECIFICATIONS:** THE LATEST EDITION OF A.A.S.H.T.O. STANDARD SPECIFICATIONS FOR HIGHWAY BRIDGES.
3. **LOADS:**
- (A) **DEAD LOAD:** AN ALLOWANCE OF 18 P.S.F. FOR FUTURE WEARING SURFACE OF ASPHALT CONCRETE HAS BEEN PROVIDED FOR IN THE DESIGN.
- (B) **LIVE LOAD:** HS20-44 OR INTERSTATE LOADING.
4. **MATERIALS:**
- (A) ALL CONCRETE SHALL BE CLASS A UNLESS OTHERWISE NOTED.
- (B) CONCRETE FOR COUNTER WEIGHT SHALL BE CLASS B.
- (C) CONCRETE FOR PIERS COLUMN, BOX GIRDER CAP AND WINGWALLS (EXCLUDING PARAPETS) SHALL BE CLASS E. CONCRETE FOR DECK OF SUSPENDED SPANS SHALL BE CLASS BD.
- (D) ALL REINFORCING STEEL SHALL BE A.S.T.M. A615, GRADE 40 UNLESS OTHERWISE NOTED.
- (E) ALL PIER COLUMN REINFORCEMENT SHALL BE A.S.T.M. A615, GRADE 60.
- (F) ALL STRUCTURAL STEEL SHALL BE A.S.T.M. A-36 HOT DIP GALVANIZED, UNLESS OTHERWISE NOTED.
- (G) ALL ANCHOR BOLTS WASHERS AND NUTS SHALL BE A.S.T.M. A-307, HOT DIP GALVANIZED, UNLESS OTHERWISE SPECIFIED.
- (H) FOR MATERIALS OF PRESTRESSED CONCRETE BEAM SEE PRESTRESSED CONCRETE NOTES.
5. **DESIGN STRESSES:** SHALL FOLLOW A.A.S.H.T.O. STANDARD SPECIFICATIONS FOR HIGHWAY BRIDGES IN ADDITION TO THOSE LISTED BELOW.
- | | | |
|----------|---------------------|--|
| CONCRETE | CLASS A OR CLASS BD | CLASS E
(EXCEPT PRESTRESSED CONCRETE BEAMS) |
| f'c | 3000 P.S.I. | 4500 P.S.I. |
| fc | 1200 P.S.I. | 1800 P.S.I. |
| n | 9 | 7 |
- FOR PRESTRESSED CONCRETE BEAMS, SEE PRESTRESSED CONCRETE NOTES.
6. **REINFORCEMENT:**
- (A) THE MINIMUM COVERING MEASURED FROM THE SURFACE OF THE CONCRETE TO THE FACE OF ANY FACE OF ANY REINFORCING SHALL BE AS FOLLOWS UNLESS OTHERWISE SPECIFIED ON THE PLANS:
- A.1 DECK SLABS (FOR BOX GIRDERS, PRESTRESSED BEAMS)
- A. TOP BARS = 1 1/2"
- B. BOTTOM BARS = 1 1/4"
- A.2 BOX GIRDERS
- A. 1 1/4" TO STIRRUP FROM OUTSIDE FACES.
- B. 1" TO STIRRUP FROM INSIDE FACES.
- A.3 FOR PRESTRESSED CONCRETE BEAMS SEE PRESTRESSED CONCRETE BEAM DETAILS.
- A.4 PIERS AND RETAINING WALLS = 2"
- A.5 COLUMNS = 2" TO TIES
- A.6 CONCRETE CAST AGAINST AND PERMANENTLY EXPOSED TO EARTH = 3".
- (B) REINFORCING BARS SHALL BE DETAILED IN ACCORDANCE WITH A.C.I. MANUAL OF STANDARD PRACTISE FOR DETAILING REINFORCED CONCRETE HIGHWAY STRUCTURES UNLESS OTHERWISE NOTED.
- (C) MINIMUM CLEAR SPACING BETWEEN PARALLEL BARS SHALL BE 1 1/2 TIMES THE DIAMETER OF BARS (FOR NON BUNDLED BARS), BUT IN NO CASE SHALL THE CLEAR DISTANCE BETWEEN THE BARS BE LESS THAN 1 1/2 TIMES THE MAXIMUM SIZE OF THE COARSE AGGREGATE.
- (D) ALL DIMENSIONS RELATING TO REINFORCING BARS (EG. SPACING OF BARS, ETC.,) ARE TO CENTERS OF BARS UNLESS OTHERWISE NOTED.
- (E) REINFORCING BARS SHALL BE SECURELY TIED AT ALL INTERSECTIONS AND LAP SPLICES AND SHALL BE HELD IN PLACE DURING POURING TO MAINTAIN THEIR PROPER LOCATIONS AS SHOWN ON THE PLANS.
- (F) VERTICAL COLUMN BAR SHALL BE ARRANGED IN SUCH A MANNER AS TO AVOID INTERFERENCE WITH PIER CAP BARS ABOVE AS DIRECTED BY THE ENGINEER.


7. **ELASTOMERIC PADS:** BOTTOM OF BRIDGE BEARING PADS SHALL BE SECURED TO THE CONCRETE SEATS, TO PREVENT DISPLACEMENT, WITH ADHESIVES APPROVED BY THE ENGINEER.
8. **CONSTRUCTION METHODS.**
- (A) SEE STANDARD SPECIFICATIONS AND SPECIAL PROVISIONS.
- (B) IN GENERAL TOP OF CONCRETE DECK SLAB SHALL BE CONSTRUCTED TO FOLLOW THE ROADWAY VERTICAL AND HORIZONTAL CURVES.
- (C) FOR CONCRETE FINISH SEE STANDARD SPECIFICATIONS AND FOR ARCHITECTURAL TREATMENT SEE DETAILS.
- (D) GIRDER CONCRETE SEATS RECEIVING ELASTOMERIC PADS SHALL BE POURED MONOLITHICALLY WITH SUPPORTING STRUCTURE. TOP OF CONCRETE SEATS SHALL BE FINISHED WITH A STEEL TROWEL TO A SMOOTH LEVEL SURFACE TO THE ELEVATION SHOWN ON THE PLANS.
- (E) IN THE INSTALLATION OF DOWELS FOR BRIDGE BEARING, THE CONTRACTOR SHALL PROVIDE RIGID TEMPLATE TO MAINTAIN THE PROPER LOCATION AND SHALL PROTECT THEM AT ALL TIMES DURING THE CONSTRUCTION PERIOD METHODS SHALL BE APPROVED BY THE ENGINEER.
- (F) EXCEPT AS OTHERWISE NOTED, ALL VERTICAL DIMENSIONS ARE MEASURED PLUMB.
9. **GENERAL**
- (A) ALL ITEMS NOTED INCIDENTAL WILL NOT BE PAID FOR SEPARATELY.
- (B) THE CONTRACTOR SHALL VERIFY THE LOCATION OF ALL UTILITY LINES AND NOTIFY THE RESPECTIVE OWNERS BEFORE COMMENCING THE WORK OF EXCAVATION OR THE DRIVING OF PILES, INCLUDING ANY TEMPORARY PILING OR SHEETING.
- (C) CONSTRUCTION JOINTS MAY BE RELOCATED OR ADDITIONAL ONES ADDED SUBJECT TO THE APPROVAL OF THE ENGINEER.
- (D) UNLESS OTHERWISE NOTED, ALL EXPOSED CONCRETE EDGES SHALL BE CHAMFERED 3/4" x 3/4".
- (E) FOR ELECTRICAL CONDUIT LOCATION DETAILS SEE ELECTRICAL DRAWINGS.

10. **FOUNDATION NOTES:**
- (A) DESIGN LOAD FOR ALL PILES = 100 TONS (AASHTO GROUP I).
- (B) PILE TIP ELEVATION = 26.5 AND PILE CUT-OFF ELEVATION = 57.0 FOR ALL PILES.
- (C) LOAD TEST PILES INDICATED IN FOUNDATION PLAN SHALL BE FURNISHED 12 FEET LONGER THAN REGULAR PILES.
- (D) TEST PILES INDICATED IN FOUNDATION PLAN SHALL BE FURNISHED 5' LONGER THAN REGULAR PILES.
- (E) IN DRIVING EACH GROUP OF PILES, THE CONTRACTOR SHALL START FROM CENTER OF THE GROUP AND PROCEED OUTWARD.
- (F) CONCRETE IN TYPE I (16 1/2" OCTAGONAL) PRESTRESSED CONCRETE PILES SHALL HAVE A MINIMUM 28-DAY COMPRESSIVE STRENGTH OF 5000 PSI.


11. **REFERENCES:**
- (A) FOR PRESTRESSED CONCRETE NOTES, SEE DRAWINGS FOR PRESTRESSED BEAM DETAILS.
12. **SYMBOLS AND ABBREVIATIONS**
- | | | | |
|---------------|----------------------|------------|-------------------------|
| (E) OR (EXP.) | - EXPANSION | JT. | - JOINT |
| (H) | - HINGE | N.T.S. | - NOT TO SCALE |
| ALT. | - ALTERNATE | O.C. | - ON CENTERS |
| AZ. | - AXIMUTH | O/S | - OFFSET |
| ℄ | - CENTERLINE | STR. | - STRAIGHT OR STRINGER |
| ℄ | - BASELINE | STIRR. | - STIRRUP |
| E.F. | - EACH FACE | TYP. | - TYPICAL |
| B.F. | - BOTH FACES | (T) OR T. | - TOP |
| F.F. | - FAR FACE | (B) OR B. | - BOTTOM |
| N.F. | - NEAR FACE | BRG. | - BEARING |
| C.J. | - CONSTRUCTION JOINT | B.H. ELEV. | - BUSH HAMMER ELEVATION |
| CL. | - CLEAR | T.O.D. | - TOP OF DECK |
| EL., ELEV. | - ELEVATION | W.P. | - WORKING POINT |
| E.P. | - EDGE OF PAVEMENT | ø | - AT |
| EB | - EAST BOUND | ø OR DIA. | - DIAMETER |
| FIN. GR. | - FINISHED GRADE | ℄ | - PLATE |
| WB | - WEST BOUND | G.R.P. | - GROUTED RUBBLE PAVING |

INDEX TO BRIDGE DRAWINGS

SHEET NO.	DESCRIPTION
S-1	GENERAL NOTES
S-2	GENERAL PLAN AND LONGITUDINAL SECTION
S-3	DECK ELEVATIONS AND FOUNDATION PLAN
S-4	BOX PIER-SHEET 1 OF 4 FRAMING PLAN
S-5	BOX PIER-SHEET 2 OF 4 SECTIONS AND DETAILS
S-6	BOX PIER-SHEET 3 OF 4 SLAB REINFORCEMENT AND SECTIONS
S-7	BOX PIER-SHEET 4 OF 4 GEOMETRY, BEARINGS AND CONSTRUCTION SEQUENCE
S-8	MISCELLANEOUS DETAILS
S-9	PRESTRESSED BEAM DETAILS
S-10	DECK REINFORCEMENT AND PARAPET DETAILS
S-11	DECK EXPANSION JOINT
S-12	TYPICAL END POST DETAIL
S-13	CUSHION BARRIER DETAILS
S-14	PRESTRESSED CONCRETE PILES DETAILS
S-15	STANDARD DETAILS PRESTRESSED CONCRETE PILES
S-16	STANDARD DETAILS GUARD RAIL TYPE 4 (RIGID BARRIER)

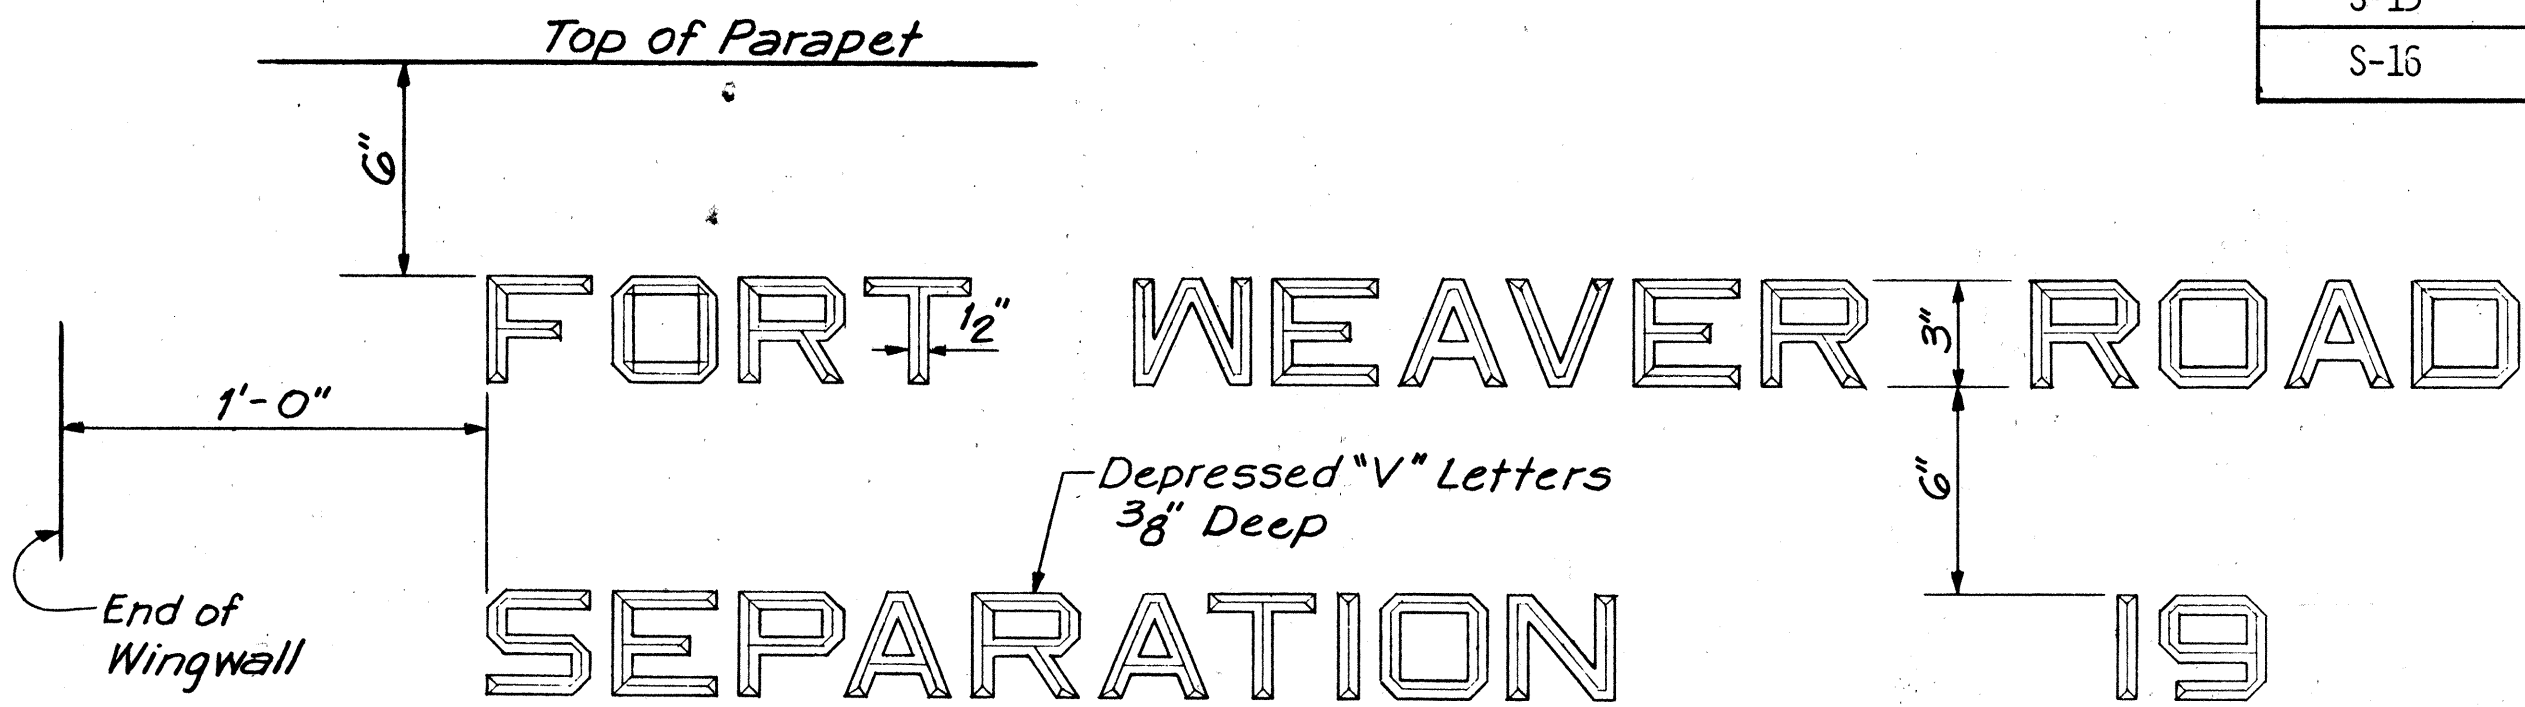

NAME & DATE OF STRUCTURE

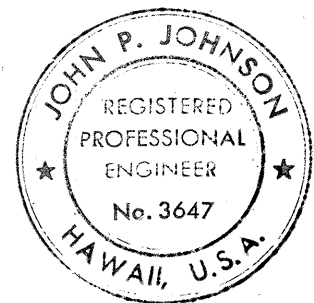

THIS WORK WAS PREPARED BY ME OR UNDER MY SUPERVISION.

John P. Johnson


STATE OF HAWAII
DEPARTMENT OF TRANSPORTATION
HIGHWAYS DIVISION

GENERAL NOTES

FORT WEAVER ROAD
ROUTE H-1 TO SOUTH OF
FARRINGTON HIGHWAY
PROJECT NO. M-7600(1)

SCALE: NONE DATE: AUG. 1978

SHEET No. S-1 OF S-16 SHEETS


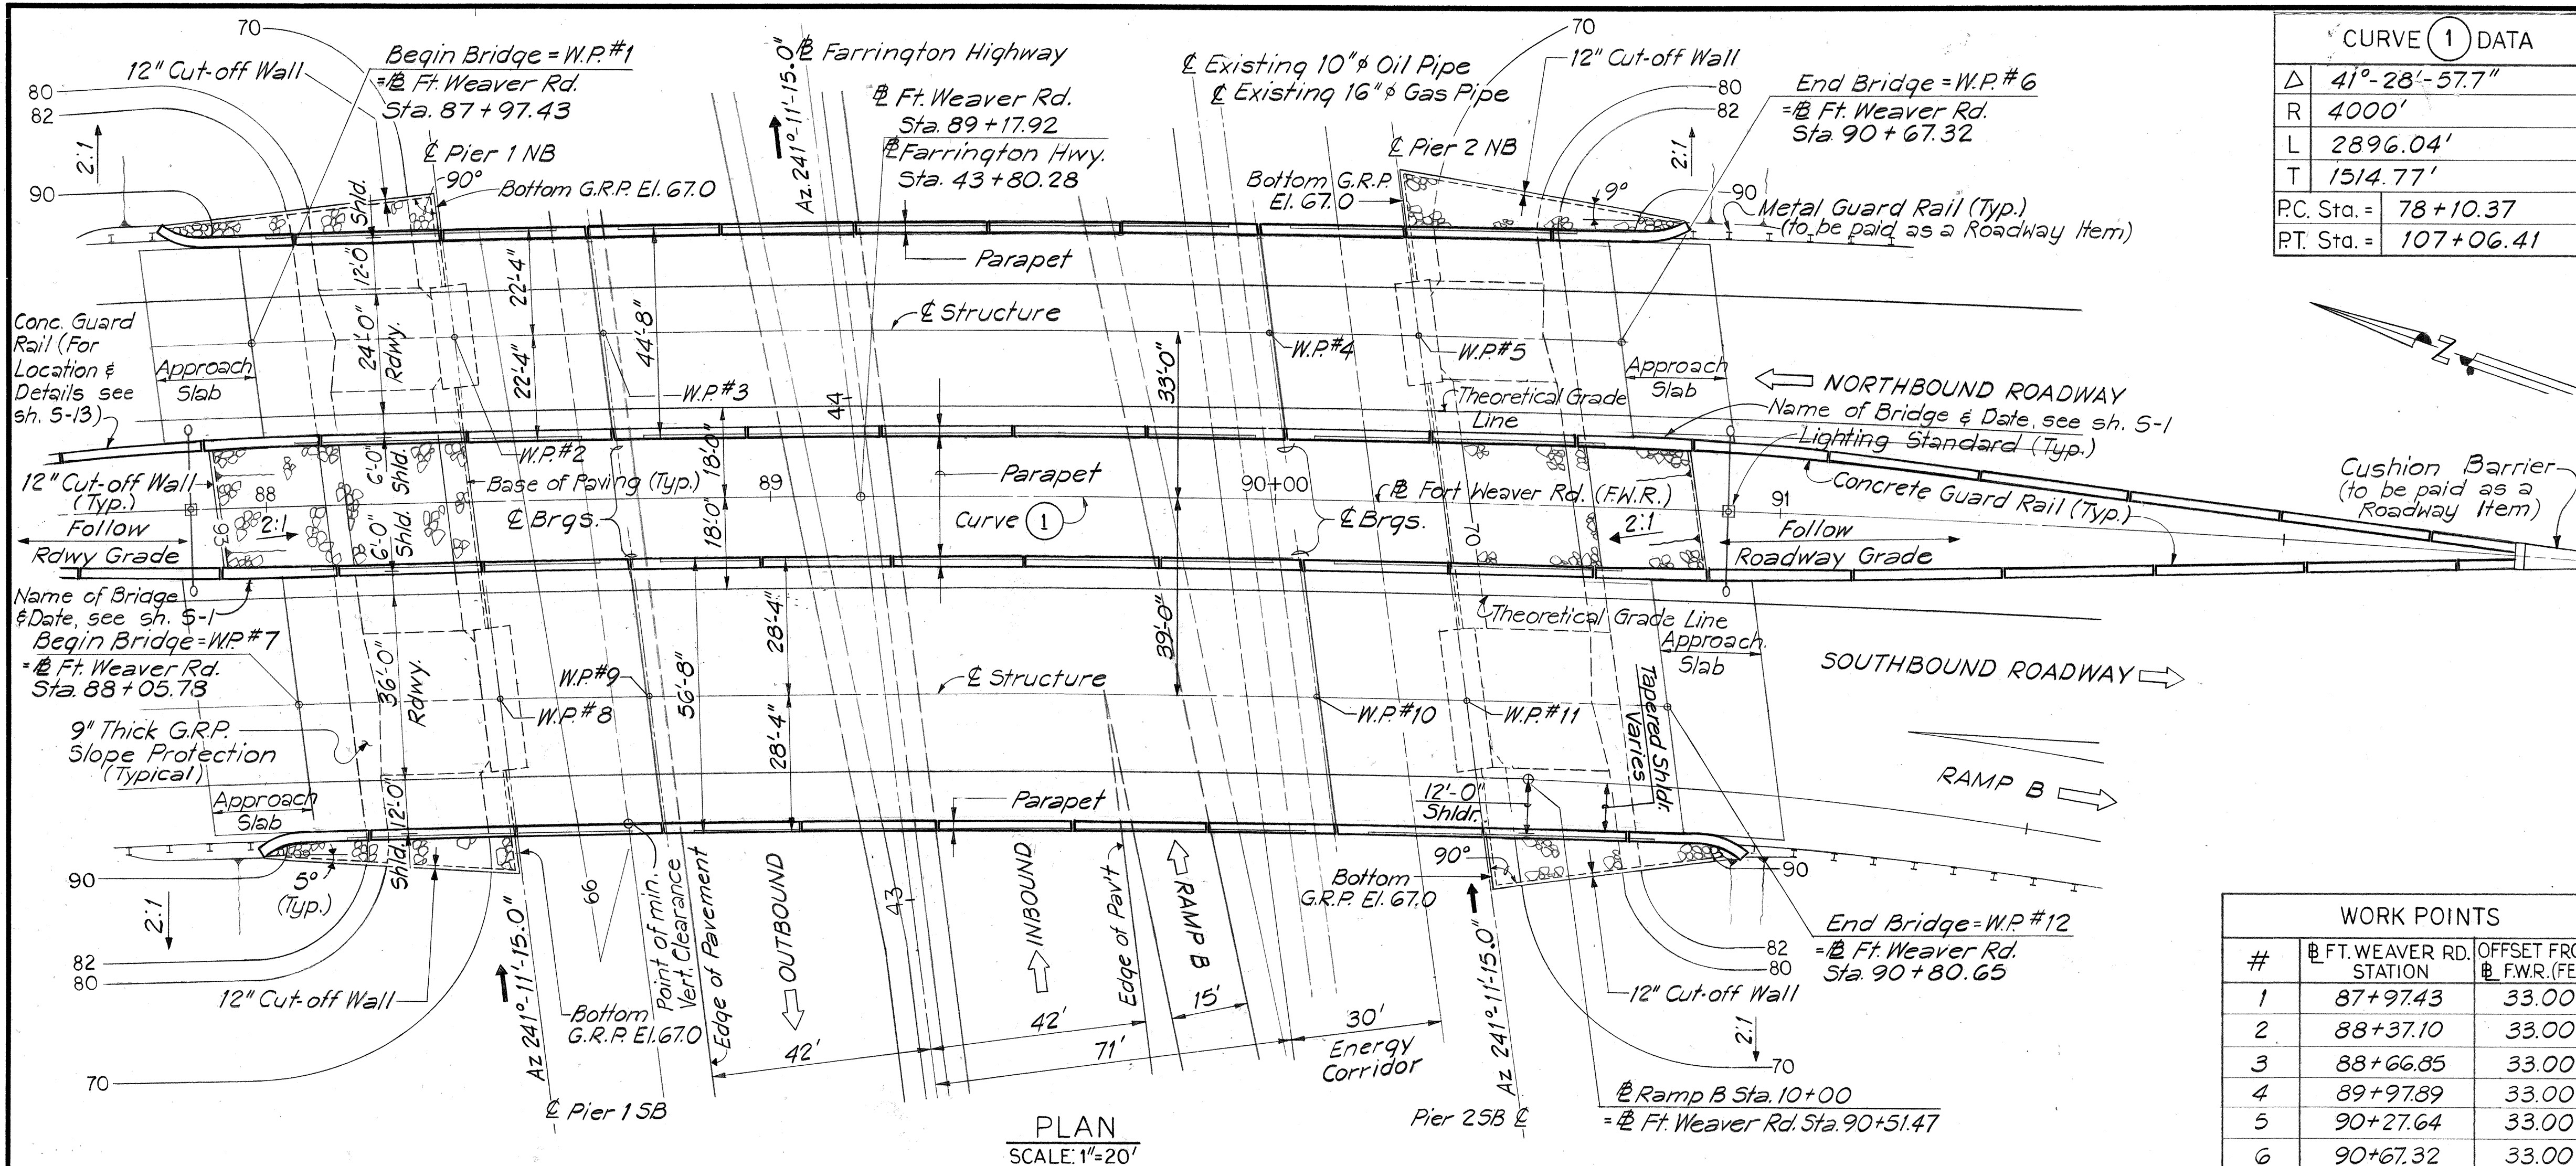


CURVE (1) DATA	
Δ	41°-28'-57.7"
R	4000'
L	2896.04'
T	1514.77'
PC Sta.	78+10.37
PT Sta.	107+06.41

- NOTES:**
- For Details of Concrete Guard Rail & Cushion Barrier see sheet No. S-13.
 - For Location and Details of Lighting Standards and Conduits see Civil and Electrical Plans.

WORK POINTS		
#	FT. WEAVER RD. STATION	OFFSET FROM F.W.R. (FEET)
1	87+97.43	33.00
2	88+37.10	33.00
3	88+66.85	33.00
4	89+97.89	33.00
5	90+27.64	33.00
6	90+67.32	33.00
7	88+05.78	39.00
8	88+46.17	39.00
9	88+76.47	39.00
10	90+09.97	39.00
11	90+40.26	39.00
12	90+80.65	39.00

ESTIMATED QUANTITIES			
NO.	ITEM	UNIT	QUANTITY
206.6000	Structure Excavation for Bridges	Cu. Yd.	1,090
206.7000	Structure Backfill	Cu. Yd.	380
206.8000	Filter Material	Cu. Yd.	222
411.1300	Concrete in Approach Slab	Cu. Yd.	110
503.1092	Concrete in Bridges (Except Footings & Counterweights)	L.S.	(2,560 C.Y.)
503.1093	Concrete in Bridge Footings (Includes pedestals)	L.S.	(720 C.Y.)
503.2150	Concrete in Counterweight	L.S.	(1,080 C.Y.)
504.6300	Kechi Type III Prestressed Conc. Girder	Lin. Ft.	2,140
505.0010	Pile Load Tests	Each	2
505.0020	Test Piles, Driven	Lin. Ft.	210
505.0410	Type I Prestressed Conc. Piles, Furnished	Lin. Ft.	5,370
505.4100	Type I Prestressed Concrete Piles, Driven	Lin. Ft.	5,430
505.9000	Extensions or Build-ups of Piles	F.A.	
507.7000	Conc. Bridge Parapet, Including End Post	Lin. Ft.	1,185
511.0100	Deck Expansion Joints	Lin. Ft.	200
602.0051	Reinforcing Steel in Bridges	L.S.	909,000 #
612.0100	Grouted Rubble Paving	Cu. Yd.	325

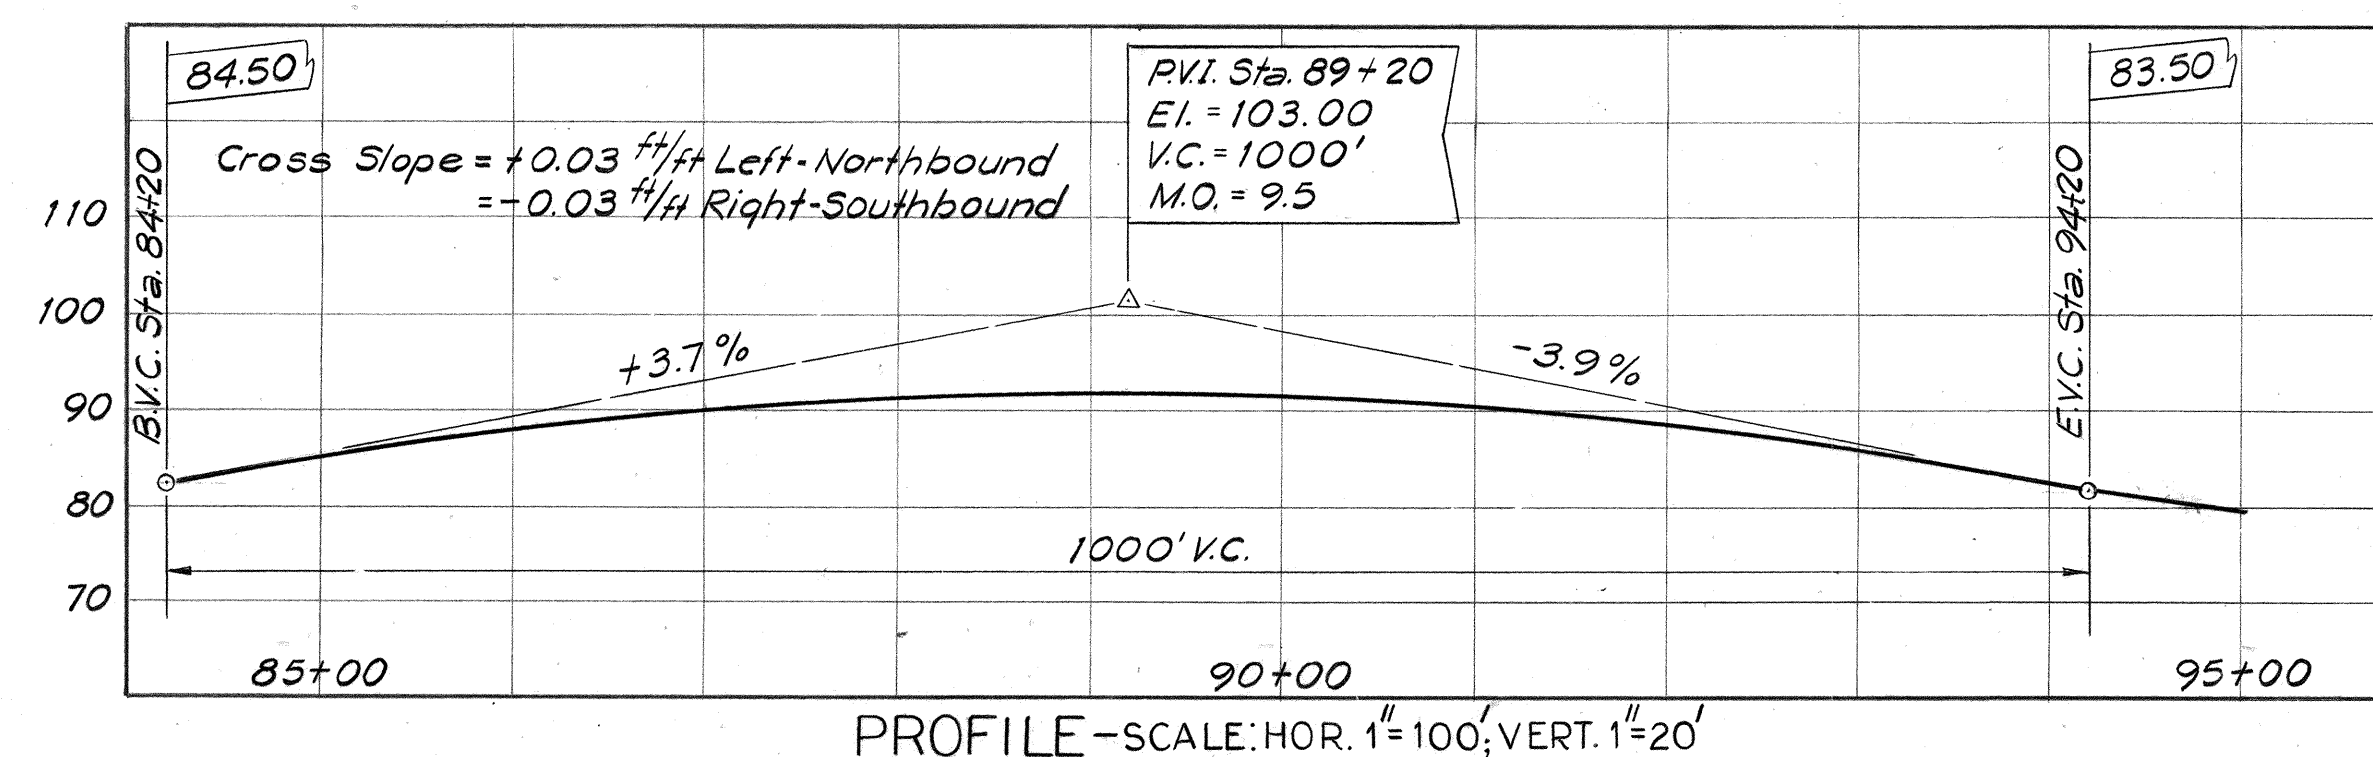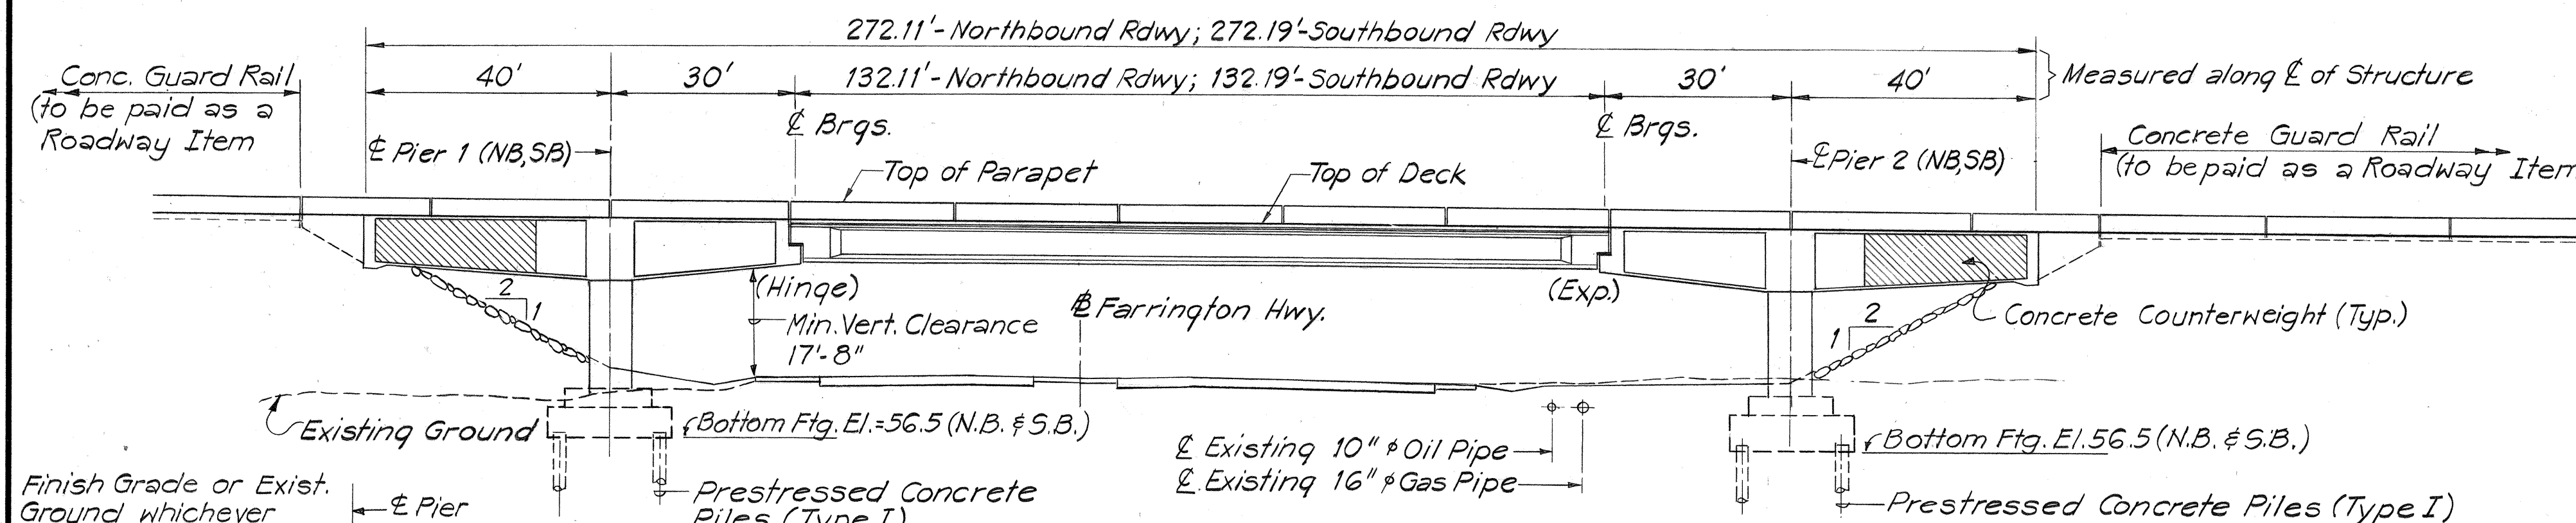

NOTE: Hatched areas denote limits of structure excavation pay line. All other excavation shall be roadway excavation except as noted. For additional payment limit see Detail "Z" on sht. No. S-6

PAYMENT LIMIT
N.T.S.

JOHN P. JOHNSON
REGISTERED PROFESSIONAL ENGINEER
No. 3647
HAWAII, U.S.A.

THIS WORK WAS PREPARED BY ME OR UNDER MY SUPERVISION.
John P. Johnson


STATE OF HAWAII
DEPARTMENT OF TRANSPORTATION
HIGHWAYS DIVISION

GENERAL PLAN AND LONGITUDINAL SECTION


FORT WEAVER ROAD
ROUTE H-1 TO SOUTH OF
FARRINGTON HIGHWAY
PROJECT NO. M-7600(1)

SCALE: AS SHOWN
DATE: AUG. 1978
SHEET NO. S-2 OF S-16 SHEETS


FED. ROAD DIST. NO.	STATE	FED. AID PROJ. NO.	FISCAL YEAR	SHEET NO.	TOTAL SHEETS
HAWAII	HAW.	M-7600(1)	1978	134	198

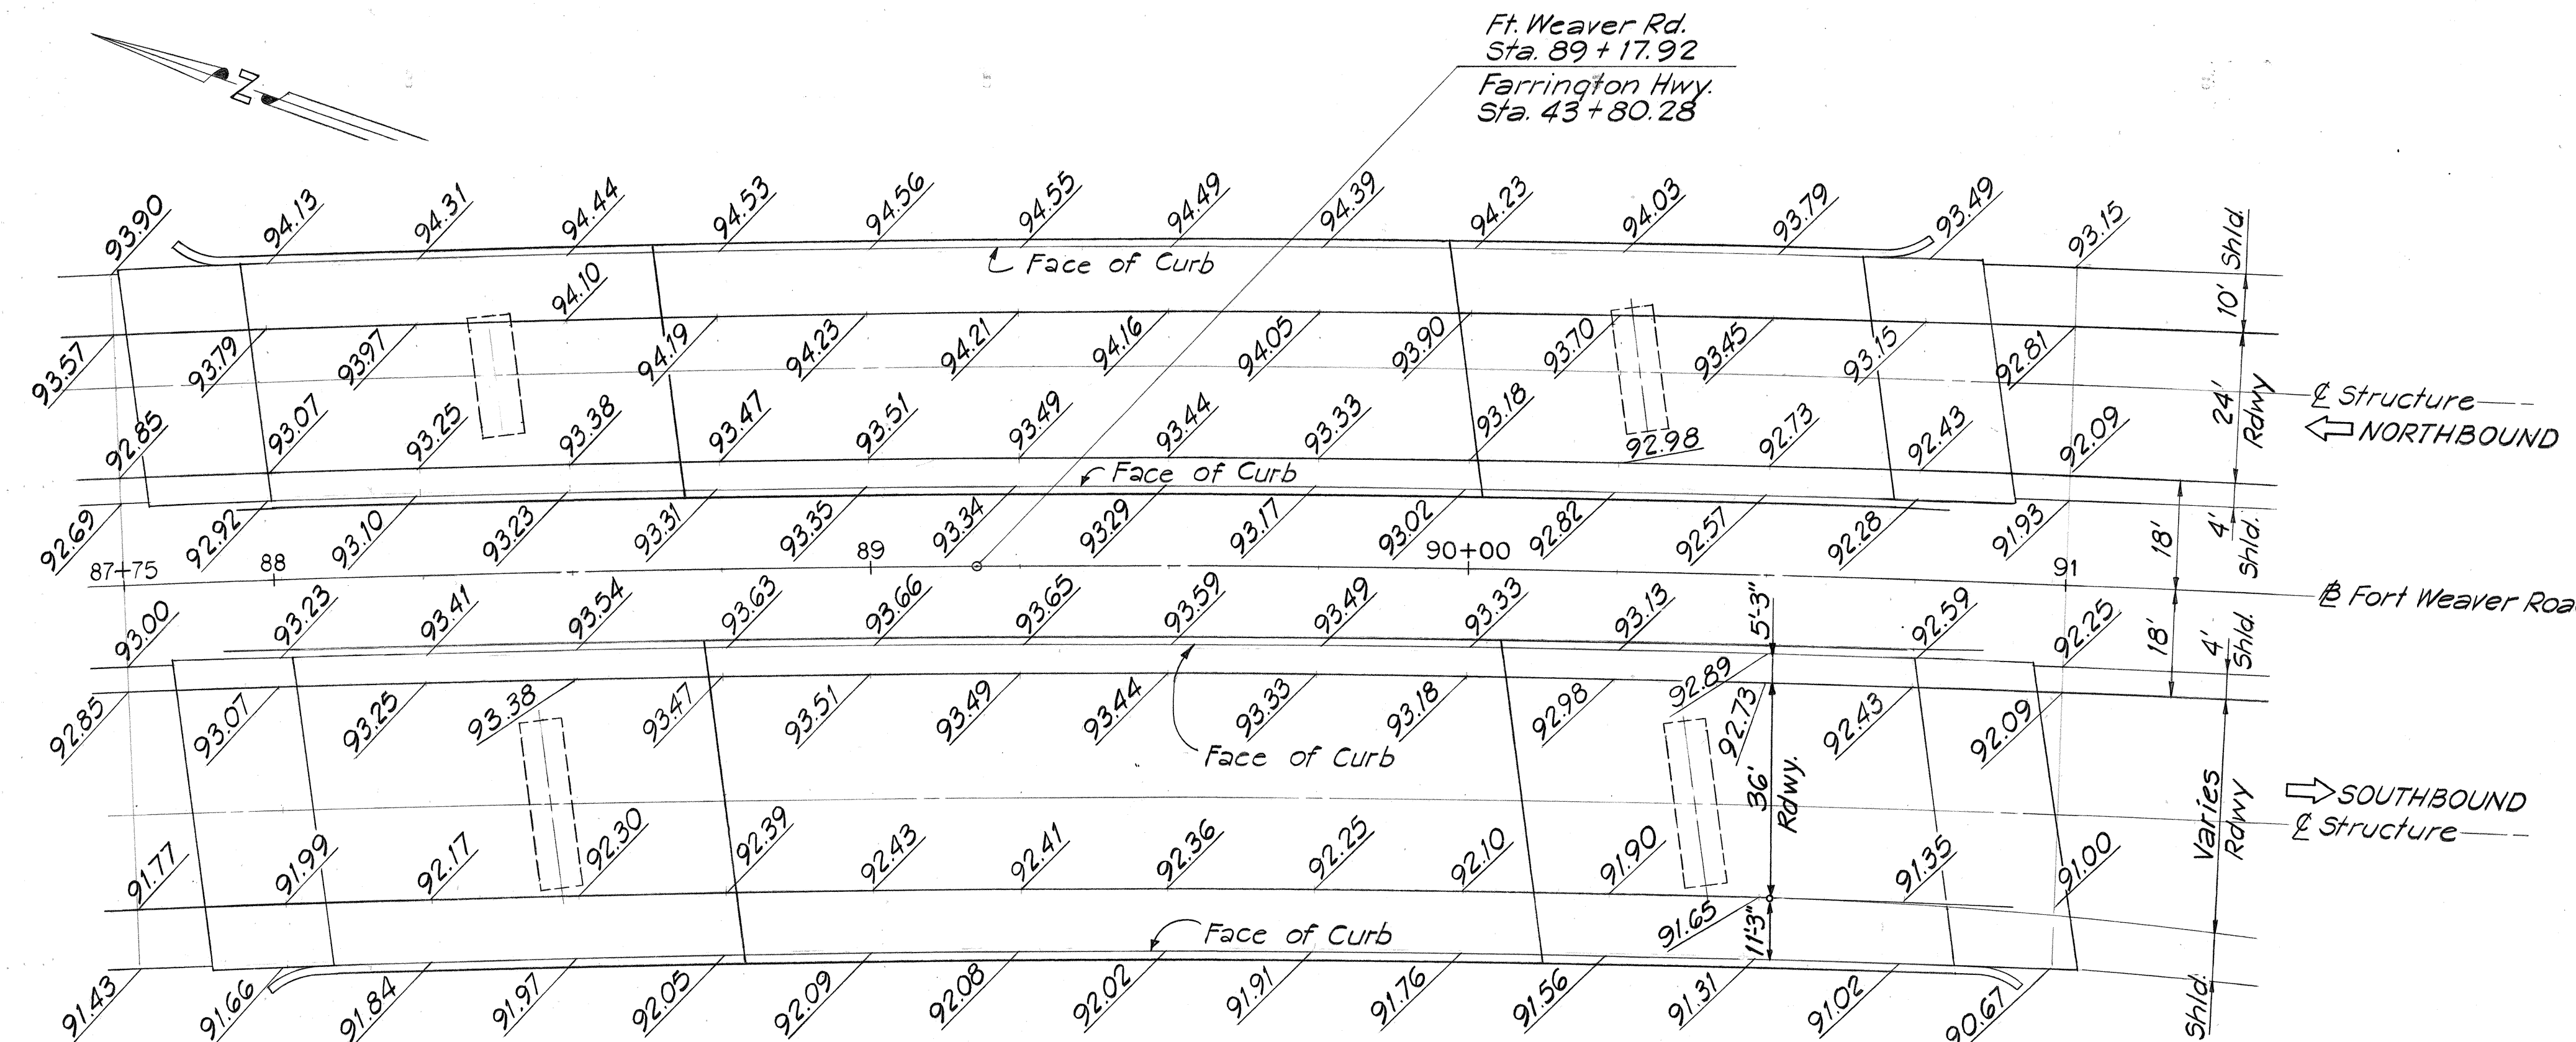


FINISHED DECK ELEVATIONS (After Immediate & long term deflection)
SCALE: 1" = 20'

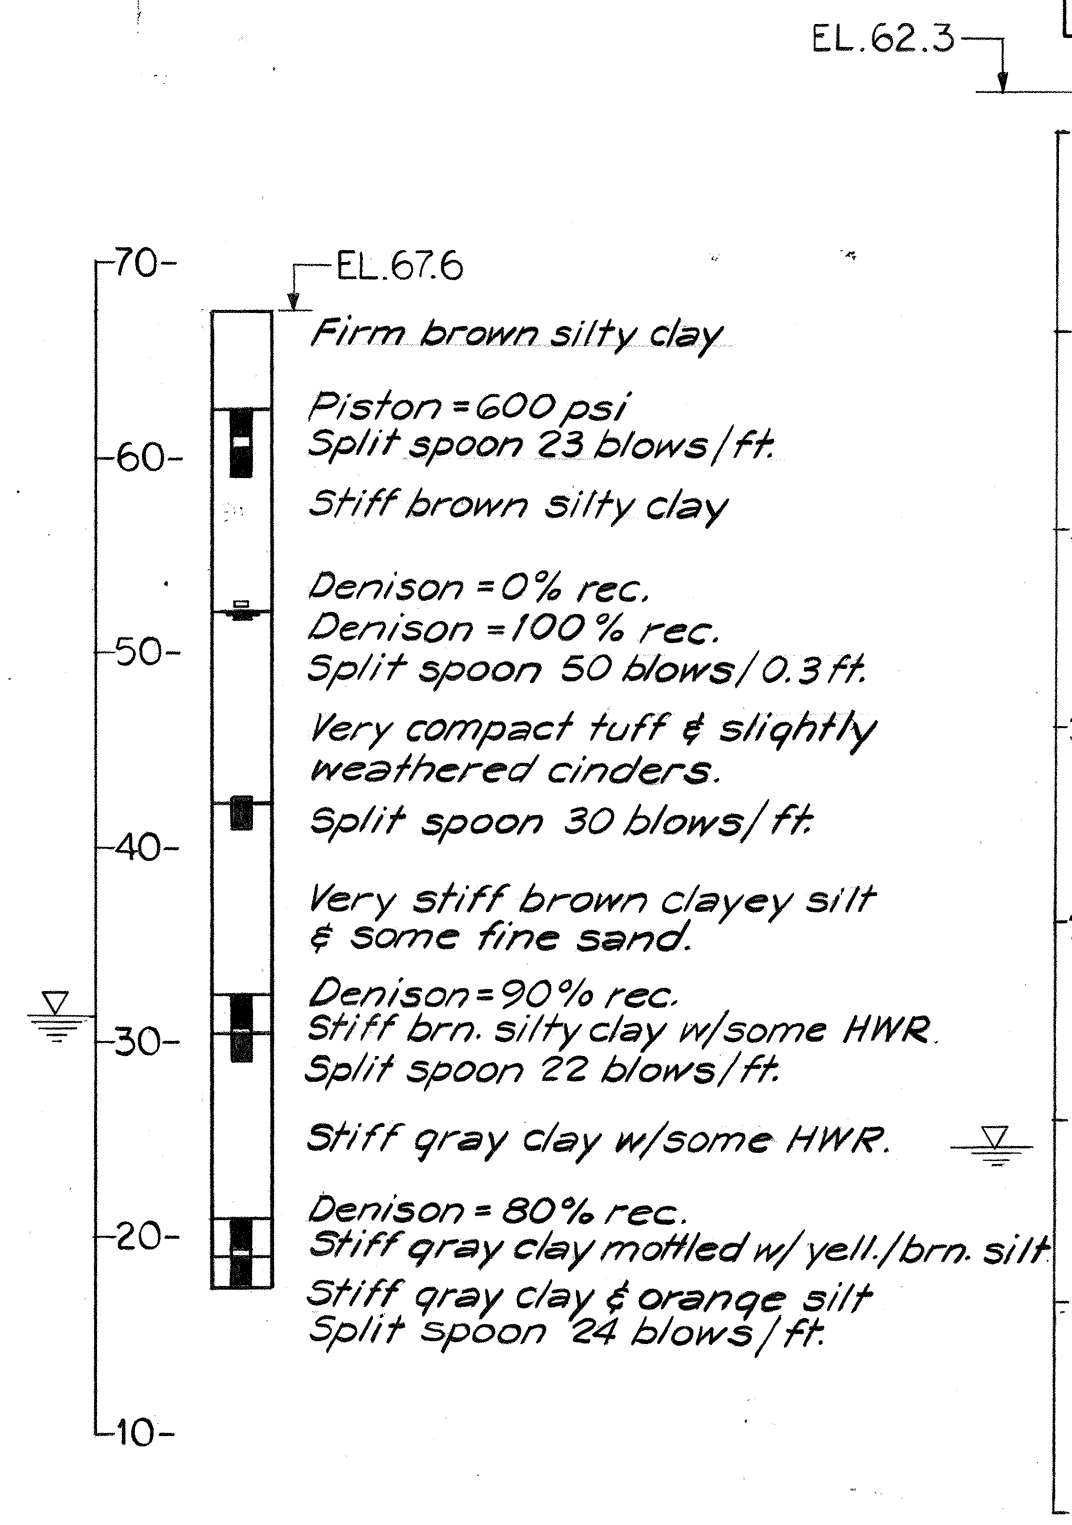


BORING B-1

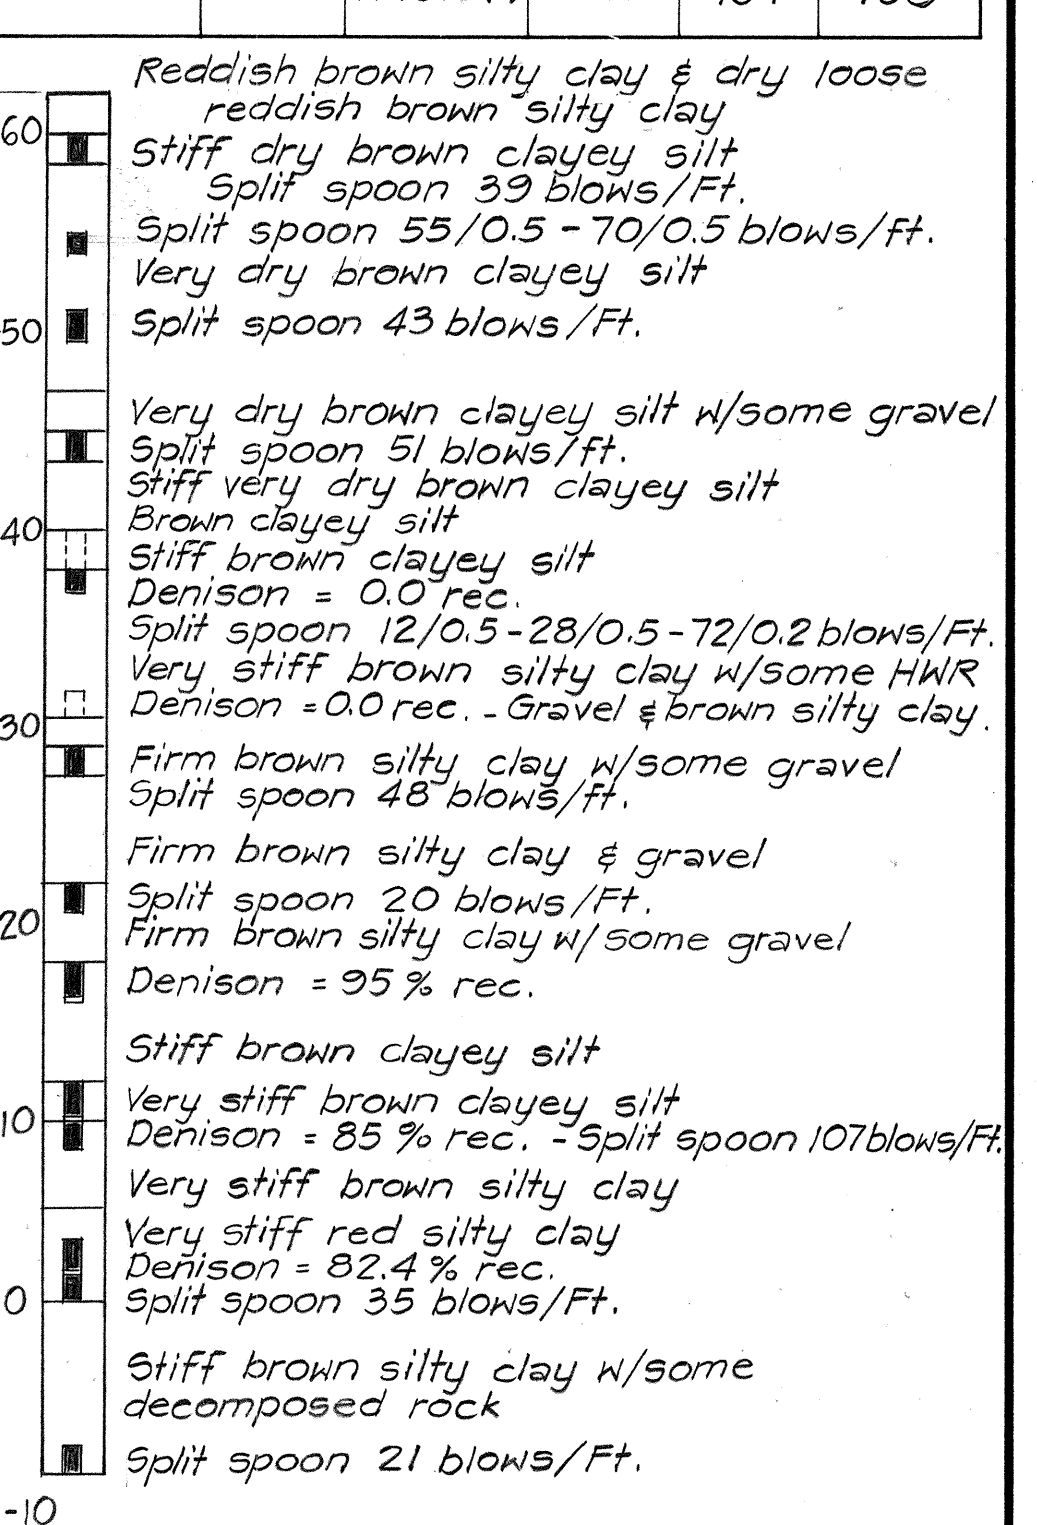


BORING FW-1

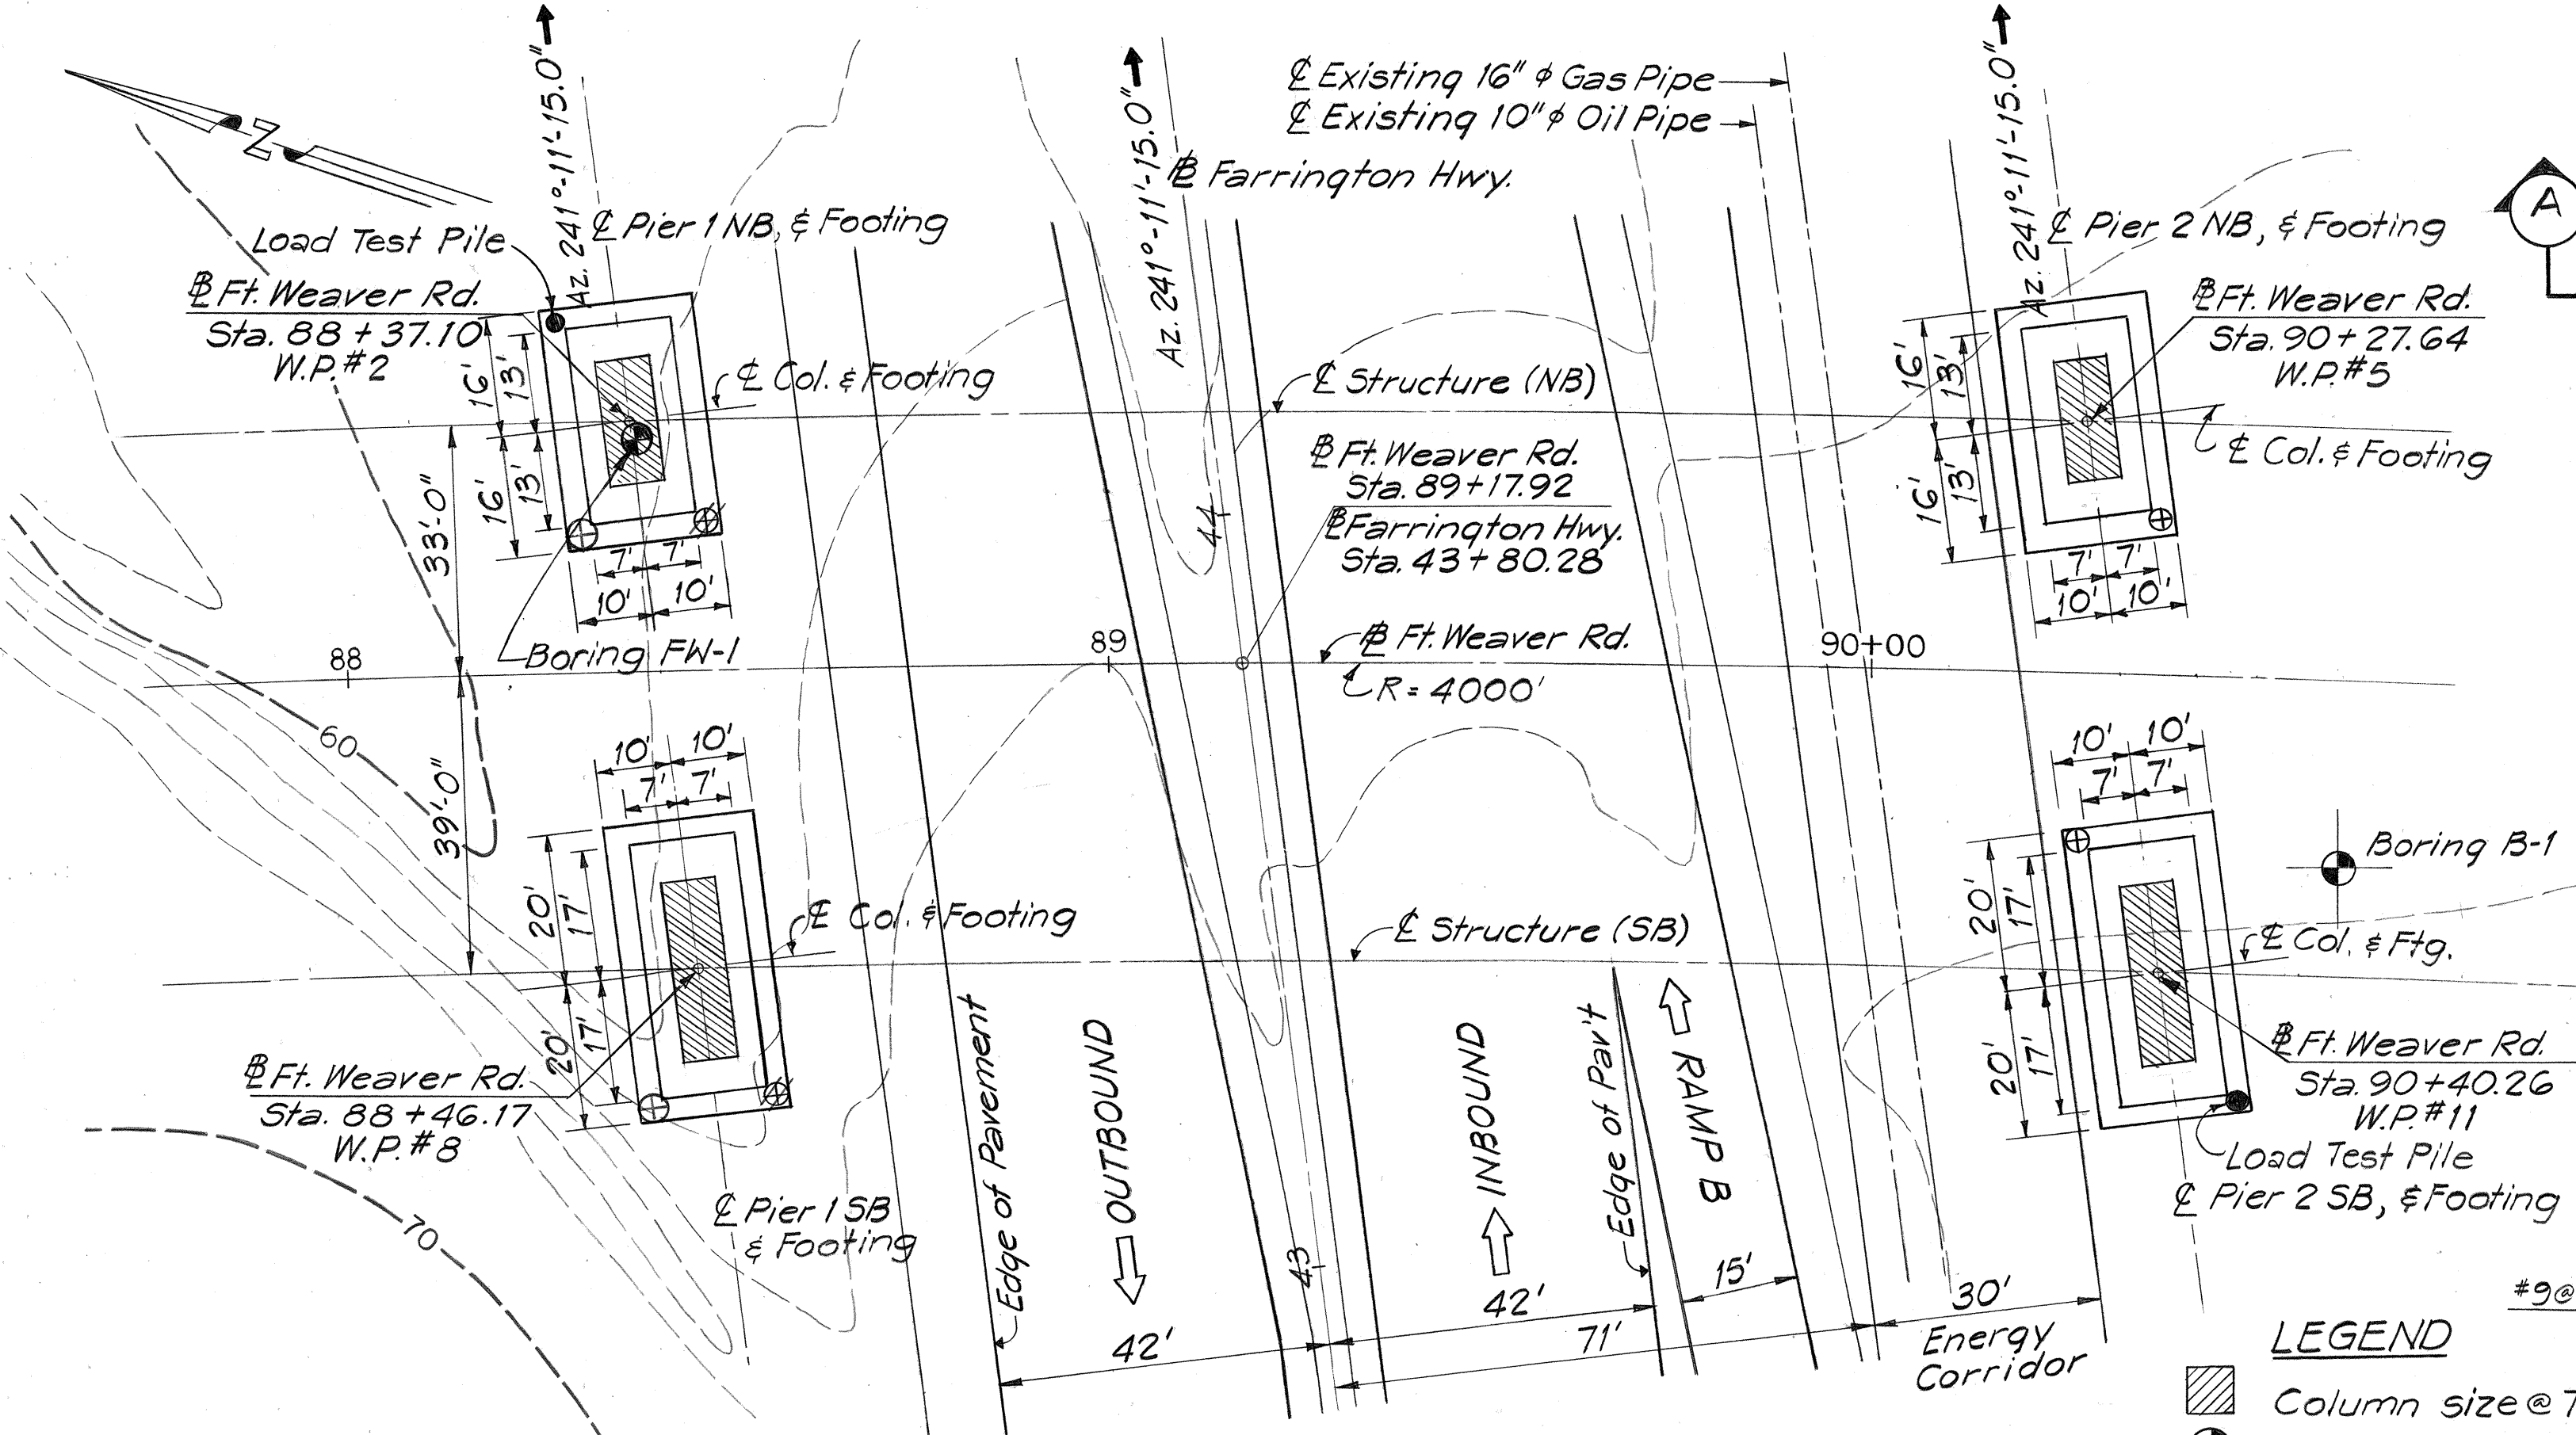

FOUNDATION PLAN
SCALE: 1" = 20'

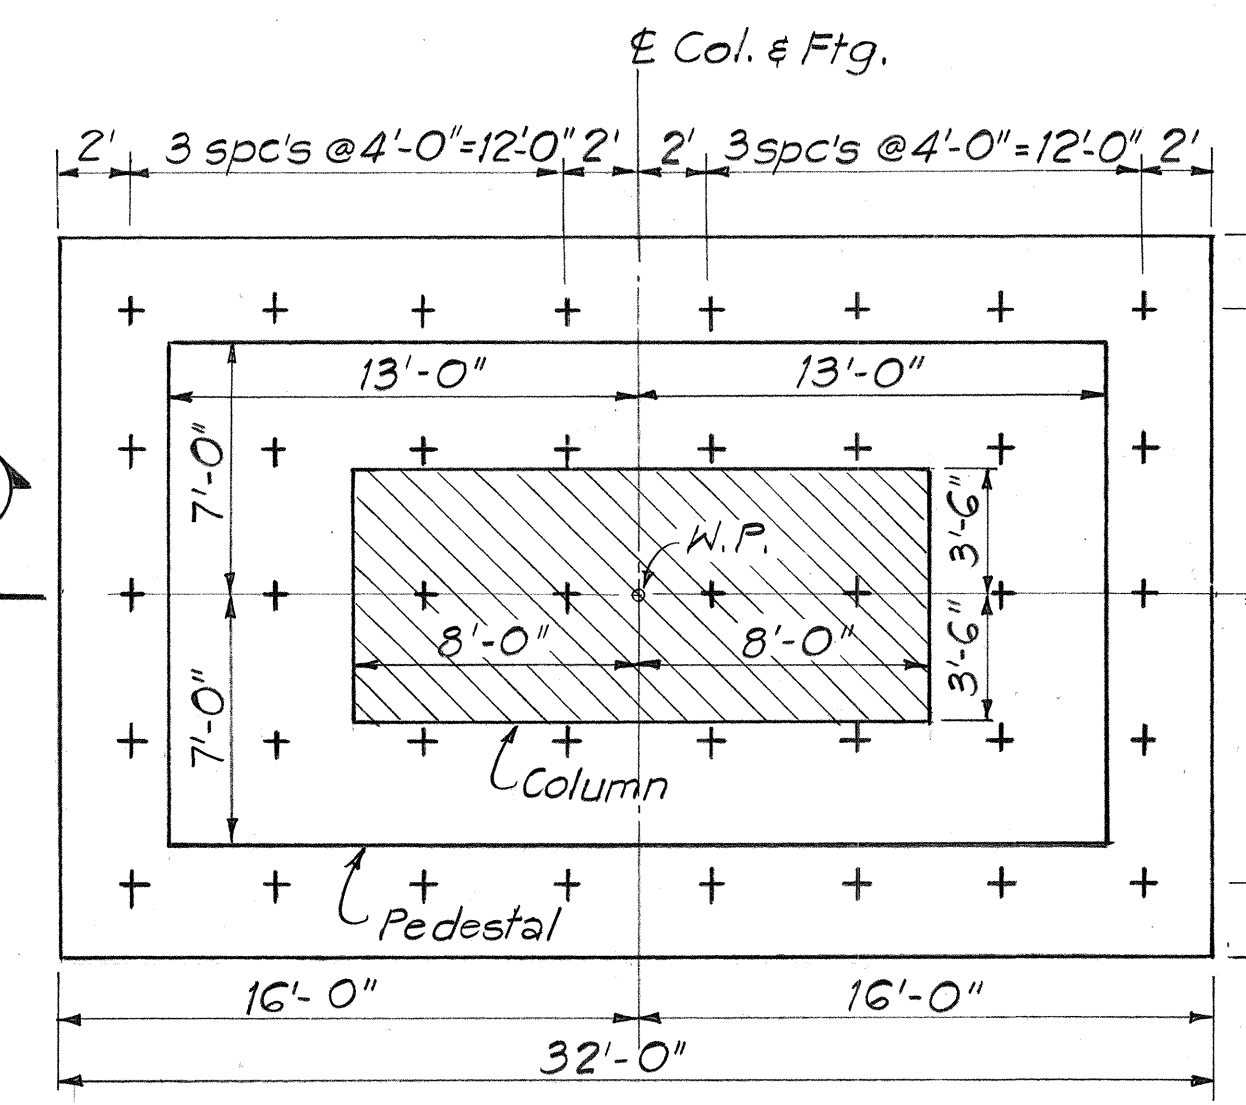


PILE FOOTING PLAN - NORTH BOUND
SCALE: 3/16" = 1'-0"

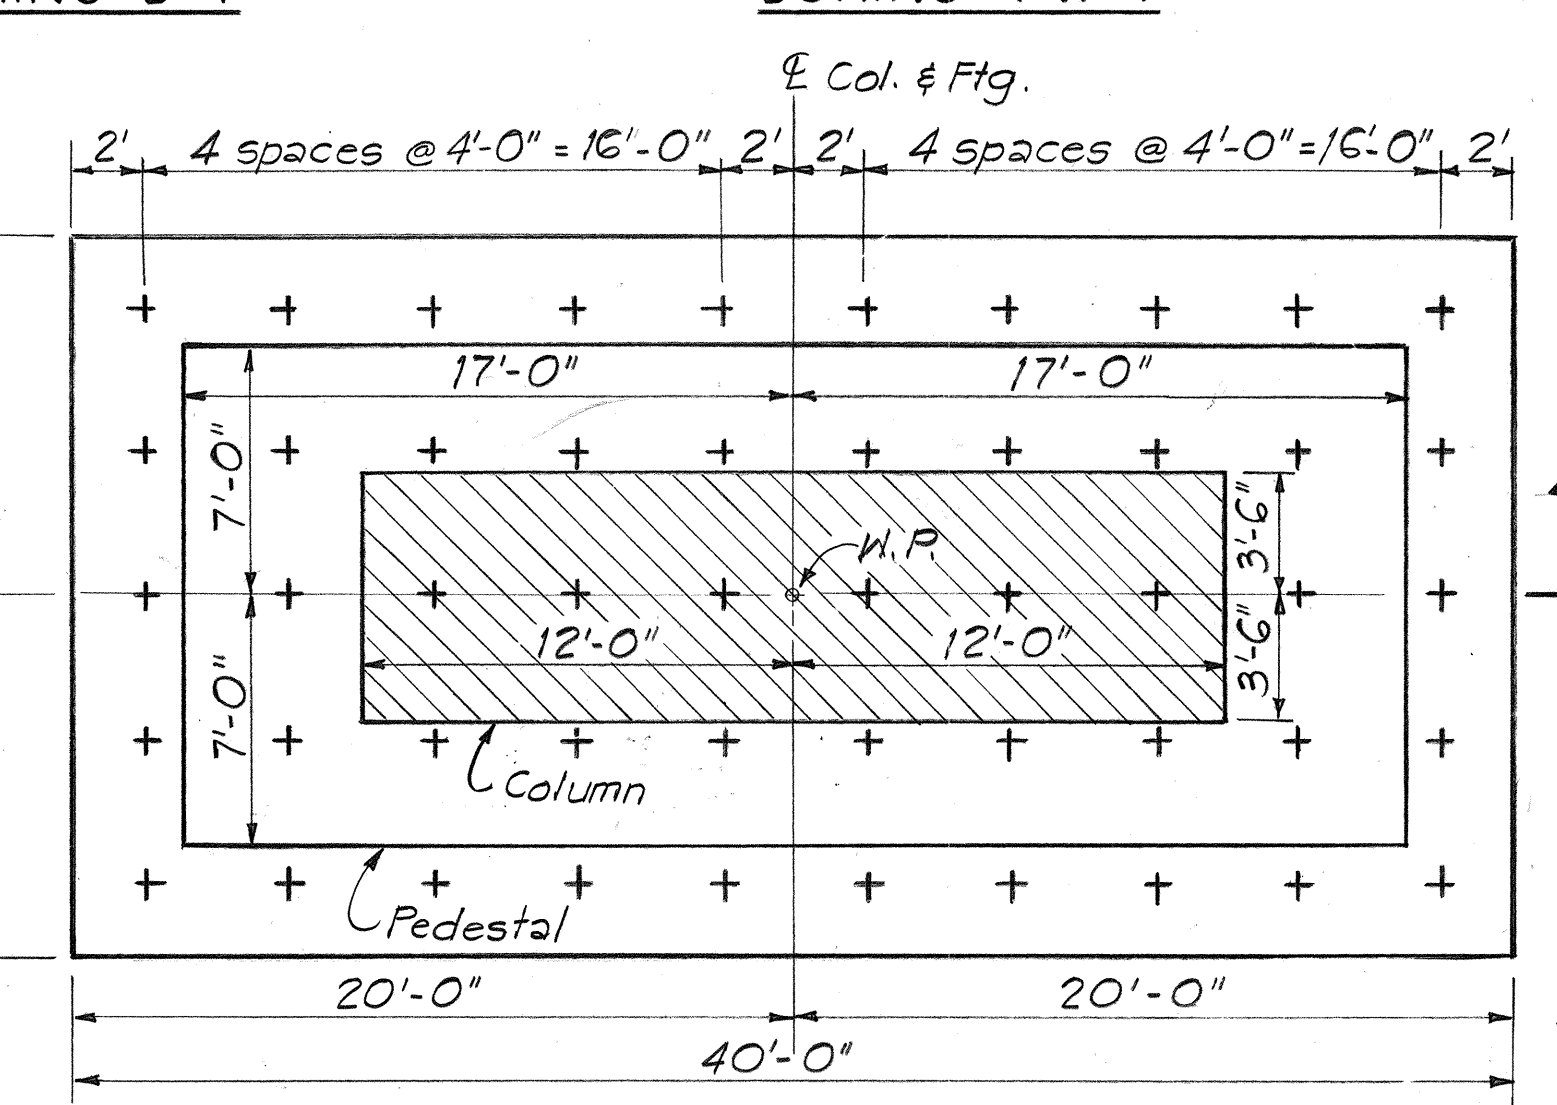


PILE FOOTING PLAN - SOUTH BOUND
SCALE: 3/16" = 1'-0"

NOTE: Footing pedestals shall be poured monolithic with Footing

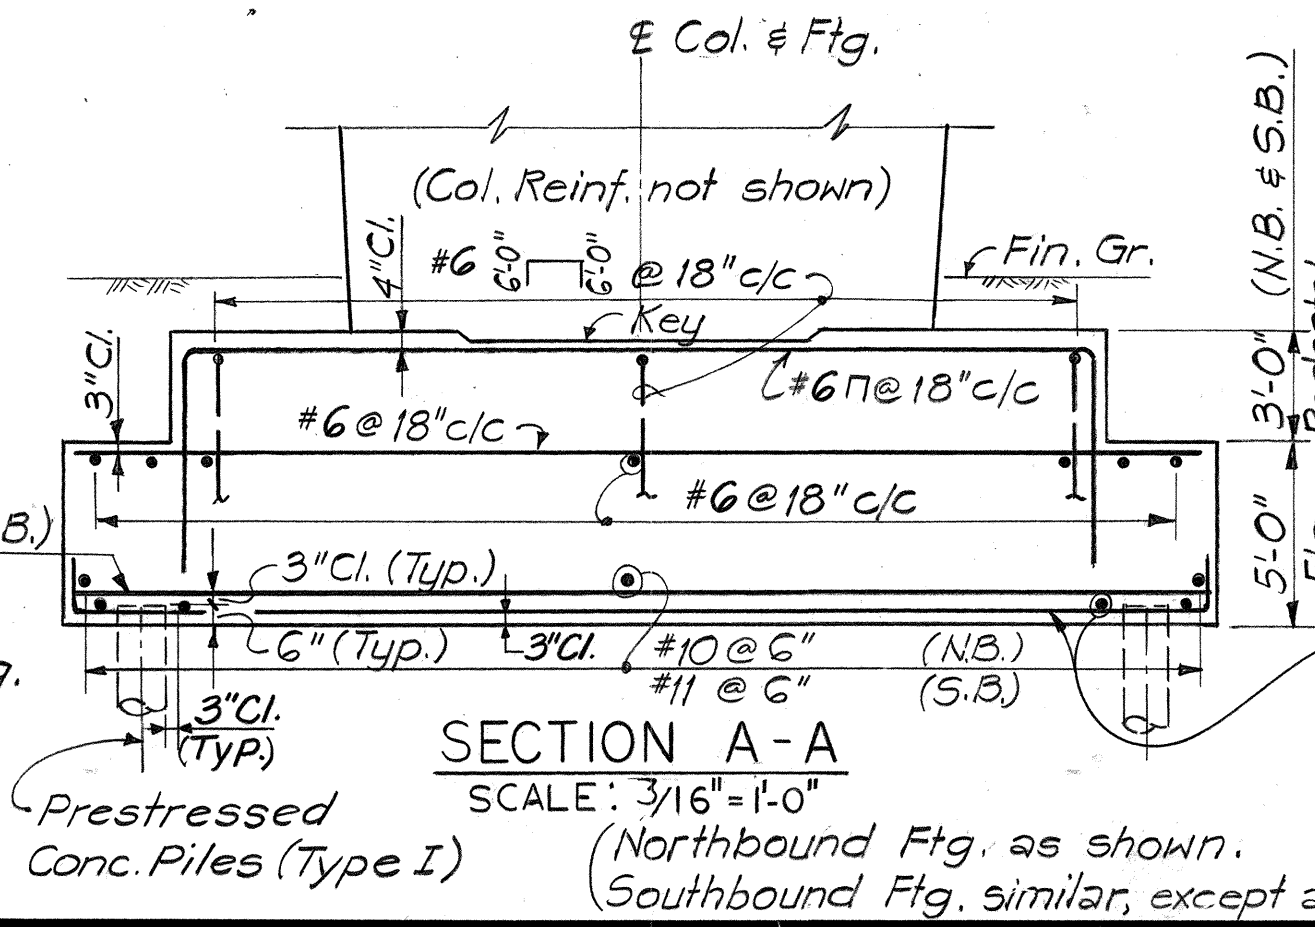

SECTION A-A
SCALE: 3/16" = 1'-0"

- LEGEND
- Column size @ Top of Ftg.
 - Existing boring
 - Test Pile
 - Load Test Pile

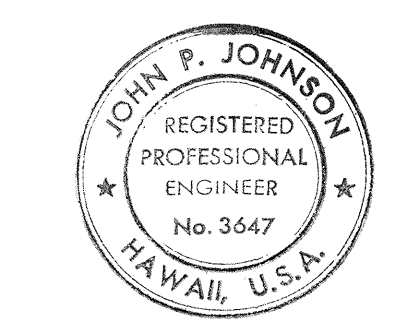

THIS WORK WAS PREPARED BY ME OR UNDER MY SUPERVISION.
John P. Johnson
1-#4 Cont. ea. Side of each row of Piles thruout. (Typ.)


STATE OF HAWAII
DEPARTMENT OF TRANSPORTATION
HIGHWAYS DIVISION

DECK ELEVATIONS AND FOUNDATION PLAN

FORT WEAVER ROAD
ROUTE H-1 TO SOUTH OF
FARRINGTON HIGHWAY
PROJECT NO. M-7600(1)

SCALE: AS SHOWN DATE: AUG. 1978
SHEET NO. S-3 OF S-16 SHEETS

FED. ROAD DIST. NO.	STATE	FED. AID PROJ. NO.	FISCAL YEAR	SHEET NO.	TOTAL SHEETS
HAWAII	HAW.	M-7600(1)	1978	135	198

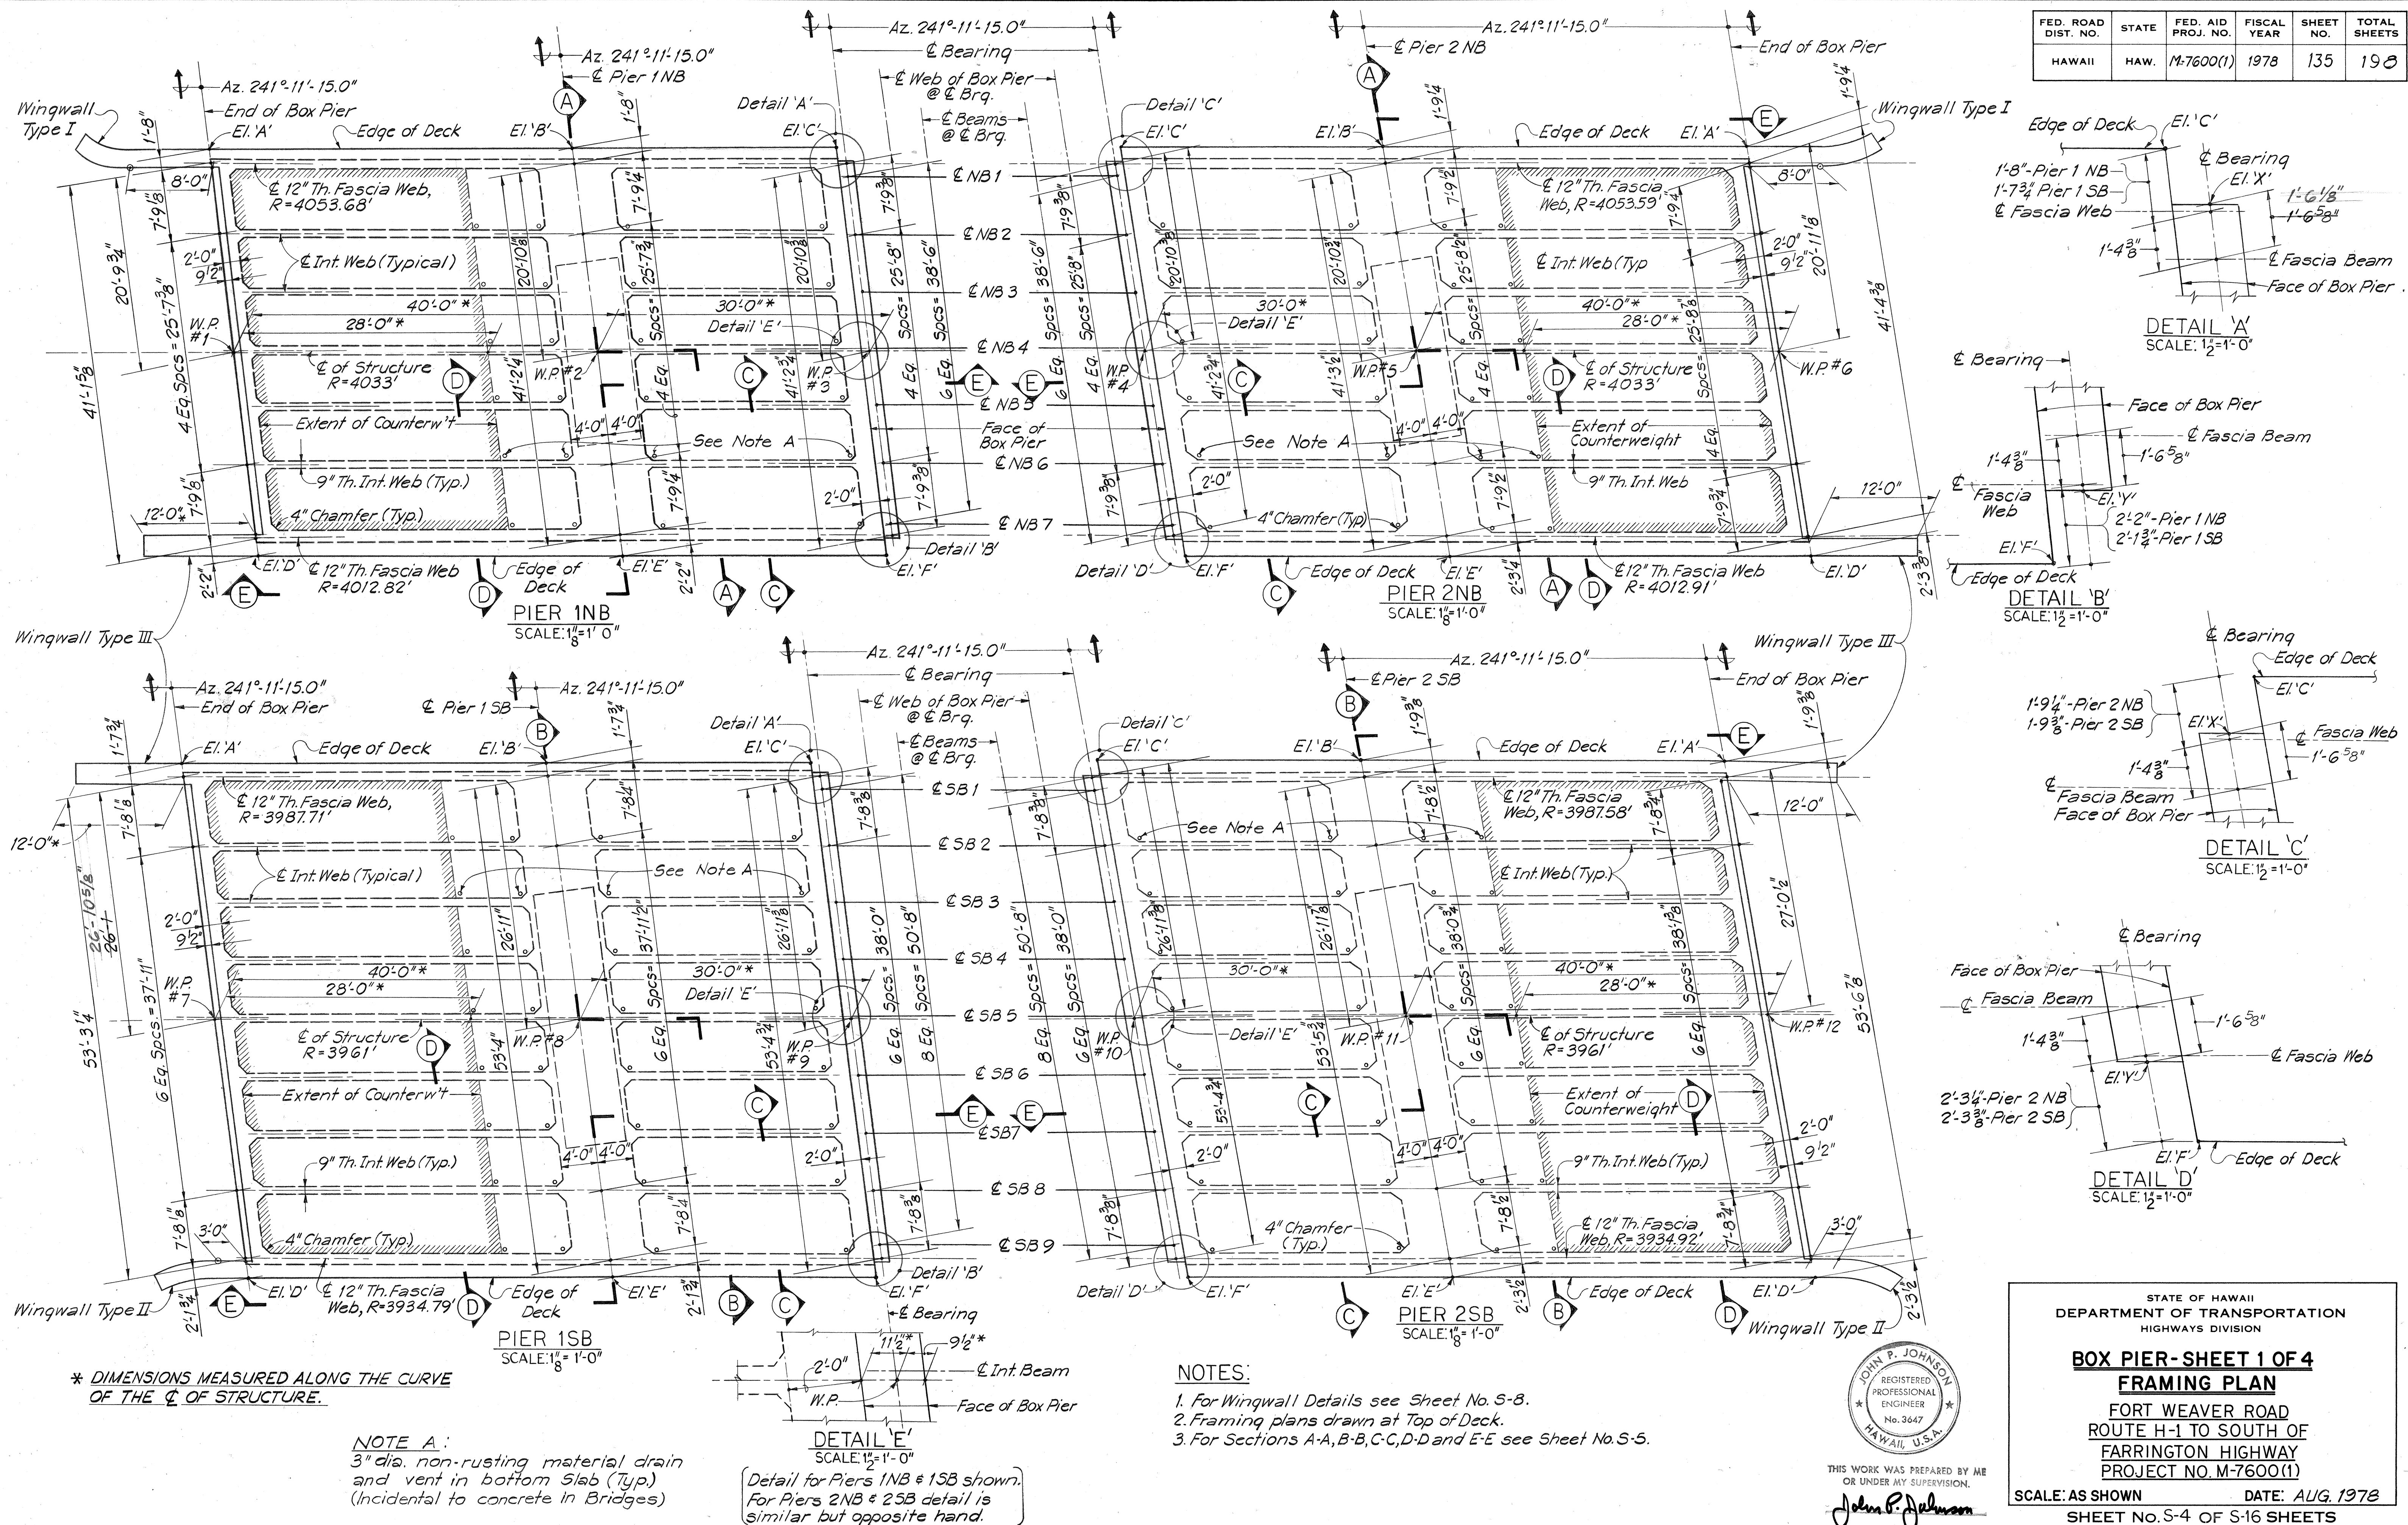

* DIMENSIONS MEASURED ALONG THE CURVE OF THE ϵ OF STRUCTURE.

NOTE A:
3" dia. non-rusting material drain and vent in bottom slab (Typ.) (Incidental to concrete in Bridges)




DETAIL 'E'
SCALE: 1/2" = 1'-0"
(Detail for Piers 1NB & 1SB shown. For Piers 2NB & 2SB detail is similar but opposite hand.)

- NOTES:
1. For Wingwall Details see Sheet No. S-8.
 2. Framing plans drawn at Top of Deck.
 3. For Sections A-A, B-B, C-C, D-D and E-E see Sheet No. S-5.





JOHN P. JOHNSON
REGISTERED PROFESSIONAL ENGINEER
No. 3647
HAWAII, U.S.A.
THIS WORK WAS PREPARED BY ME OR UNDER MY SUPERVISION.
John P. Johnson

STATE OF HAWAII
DEPARTMENT OF TRANSPORTATION
HIGHWAYS DIVISION
BOX PIER-SHEET 1 OF 4
FRAMING PLAN
FORT WEAVER ROAD
ROUTE H-1 TO SOUTH OF
FARRINGTON HIGHWAY
PROJECT NO. M-7600(1)
SCALE: AS SHOWN DATE: AUG. 1978
SHEET NO. S-4 OF S-16 SHEETS

FED. ROAD DIST. NO.	STATE	FED. AID PROJ. NO.	FISCAL YEAR	SHEET NO.	TOTAL SHEETS
HAWAII	HAW.	M-7600(1)	1978	136	198

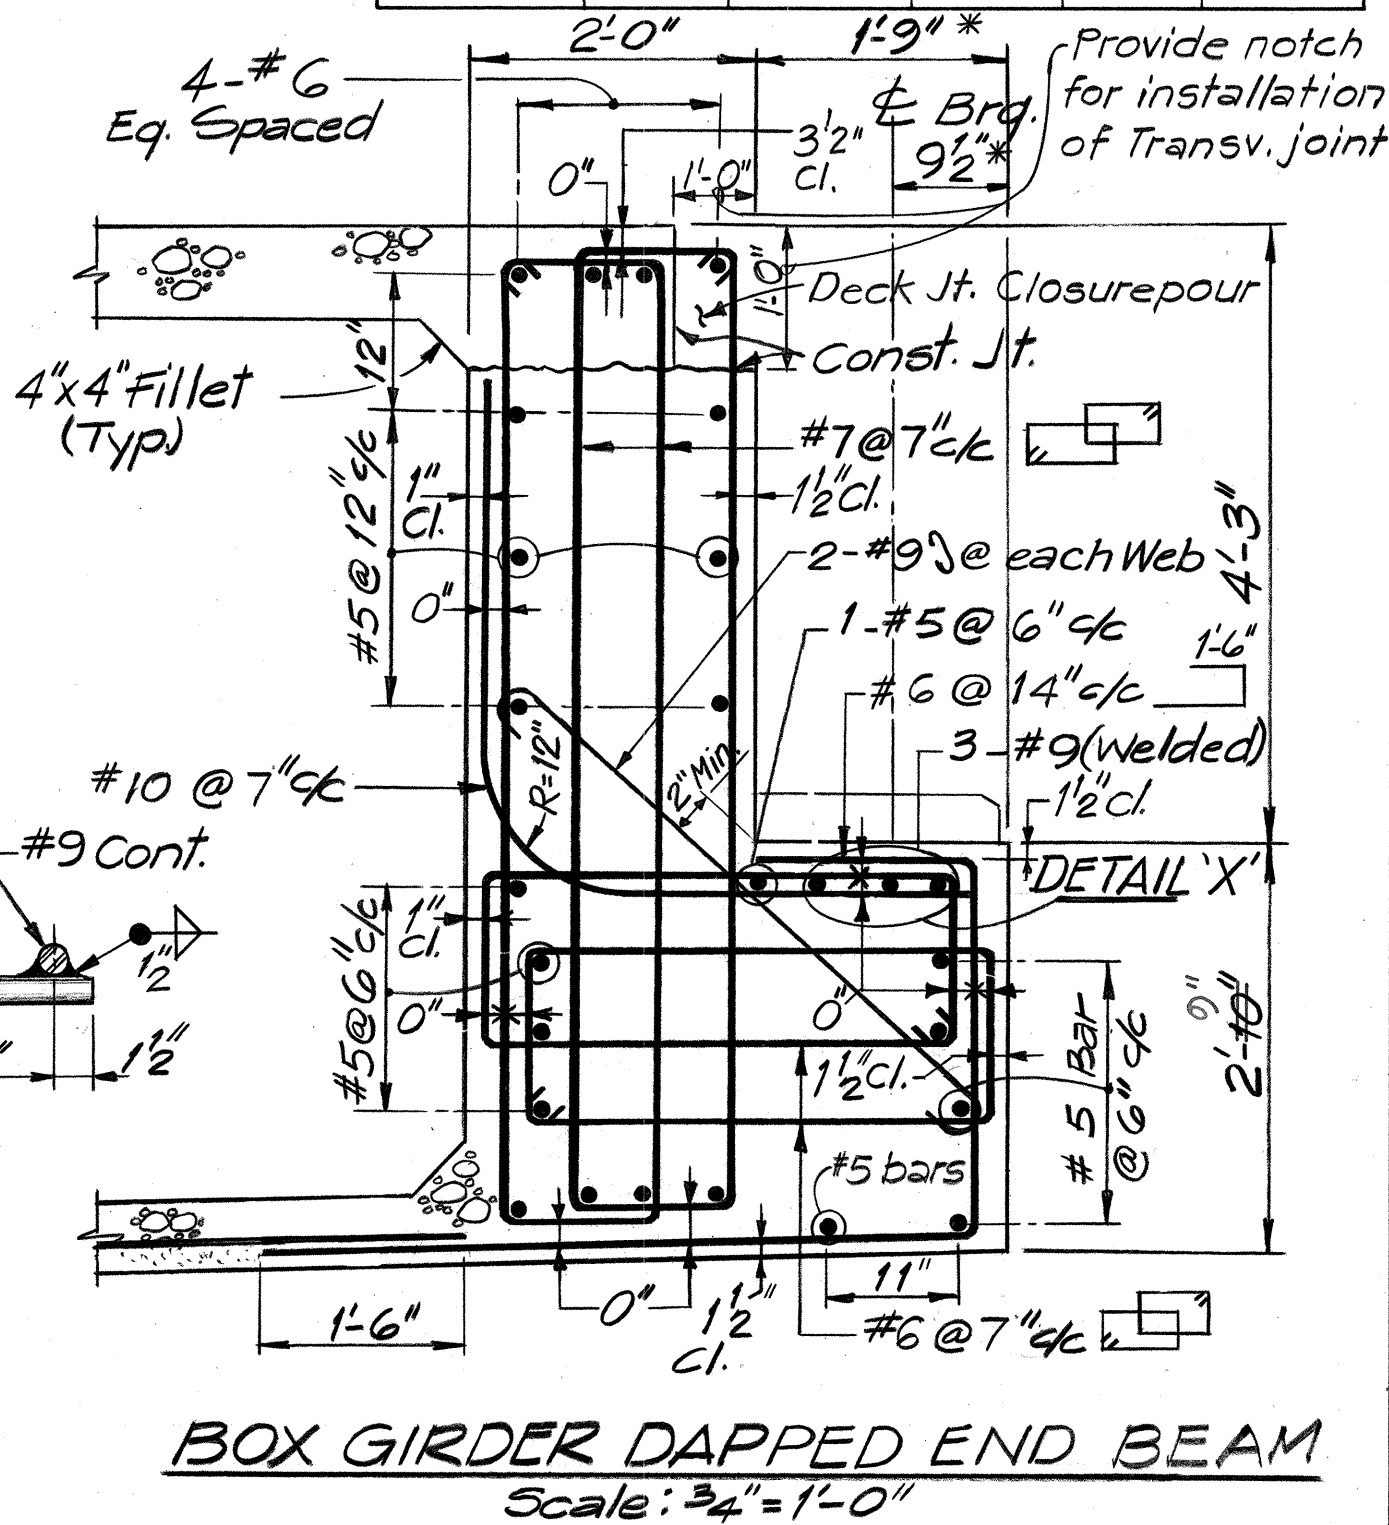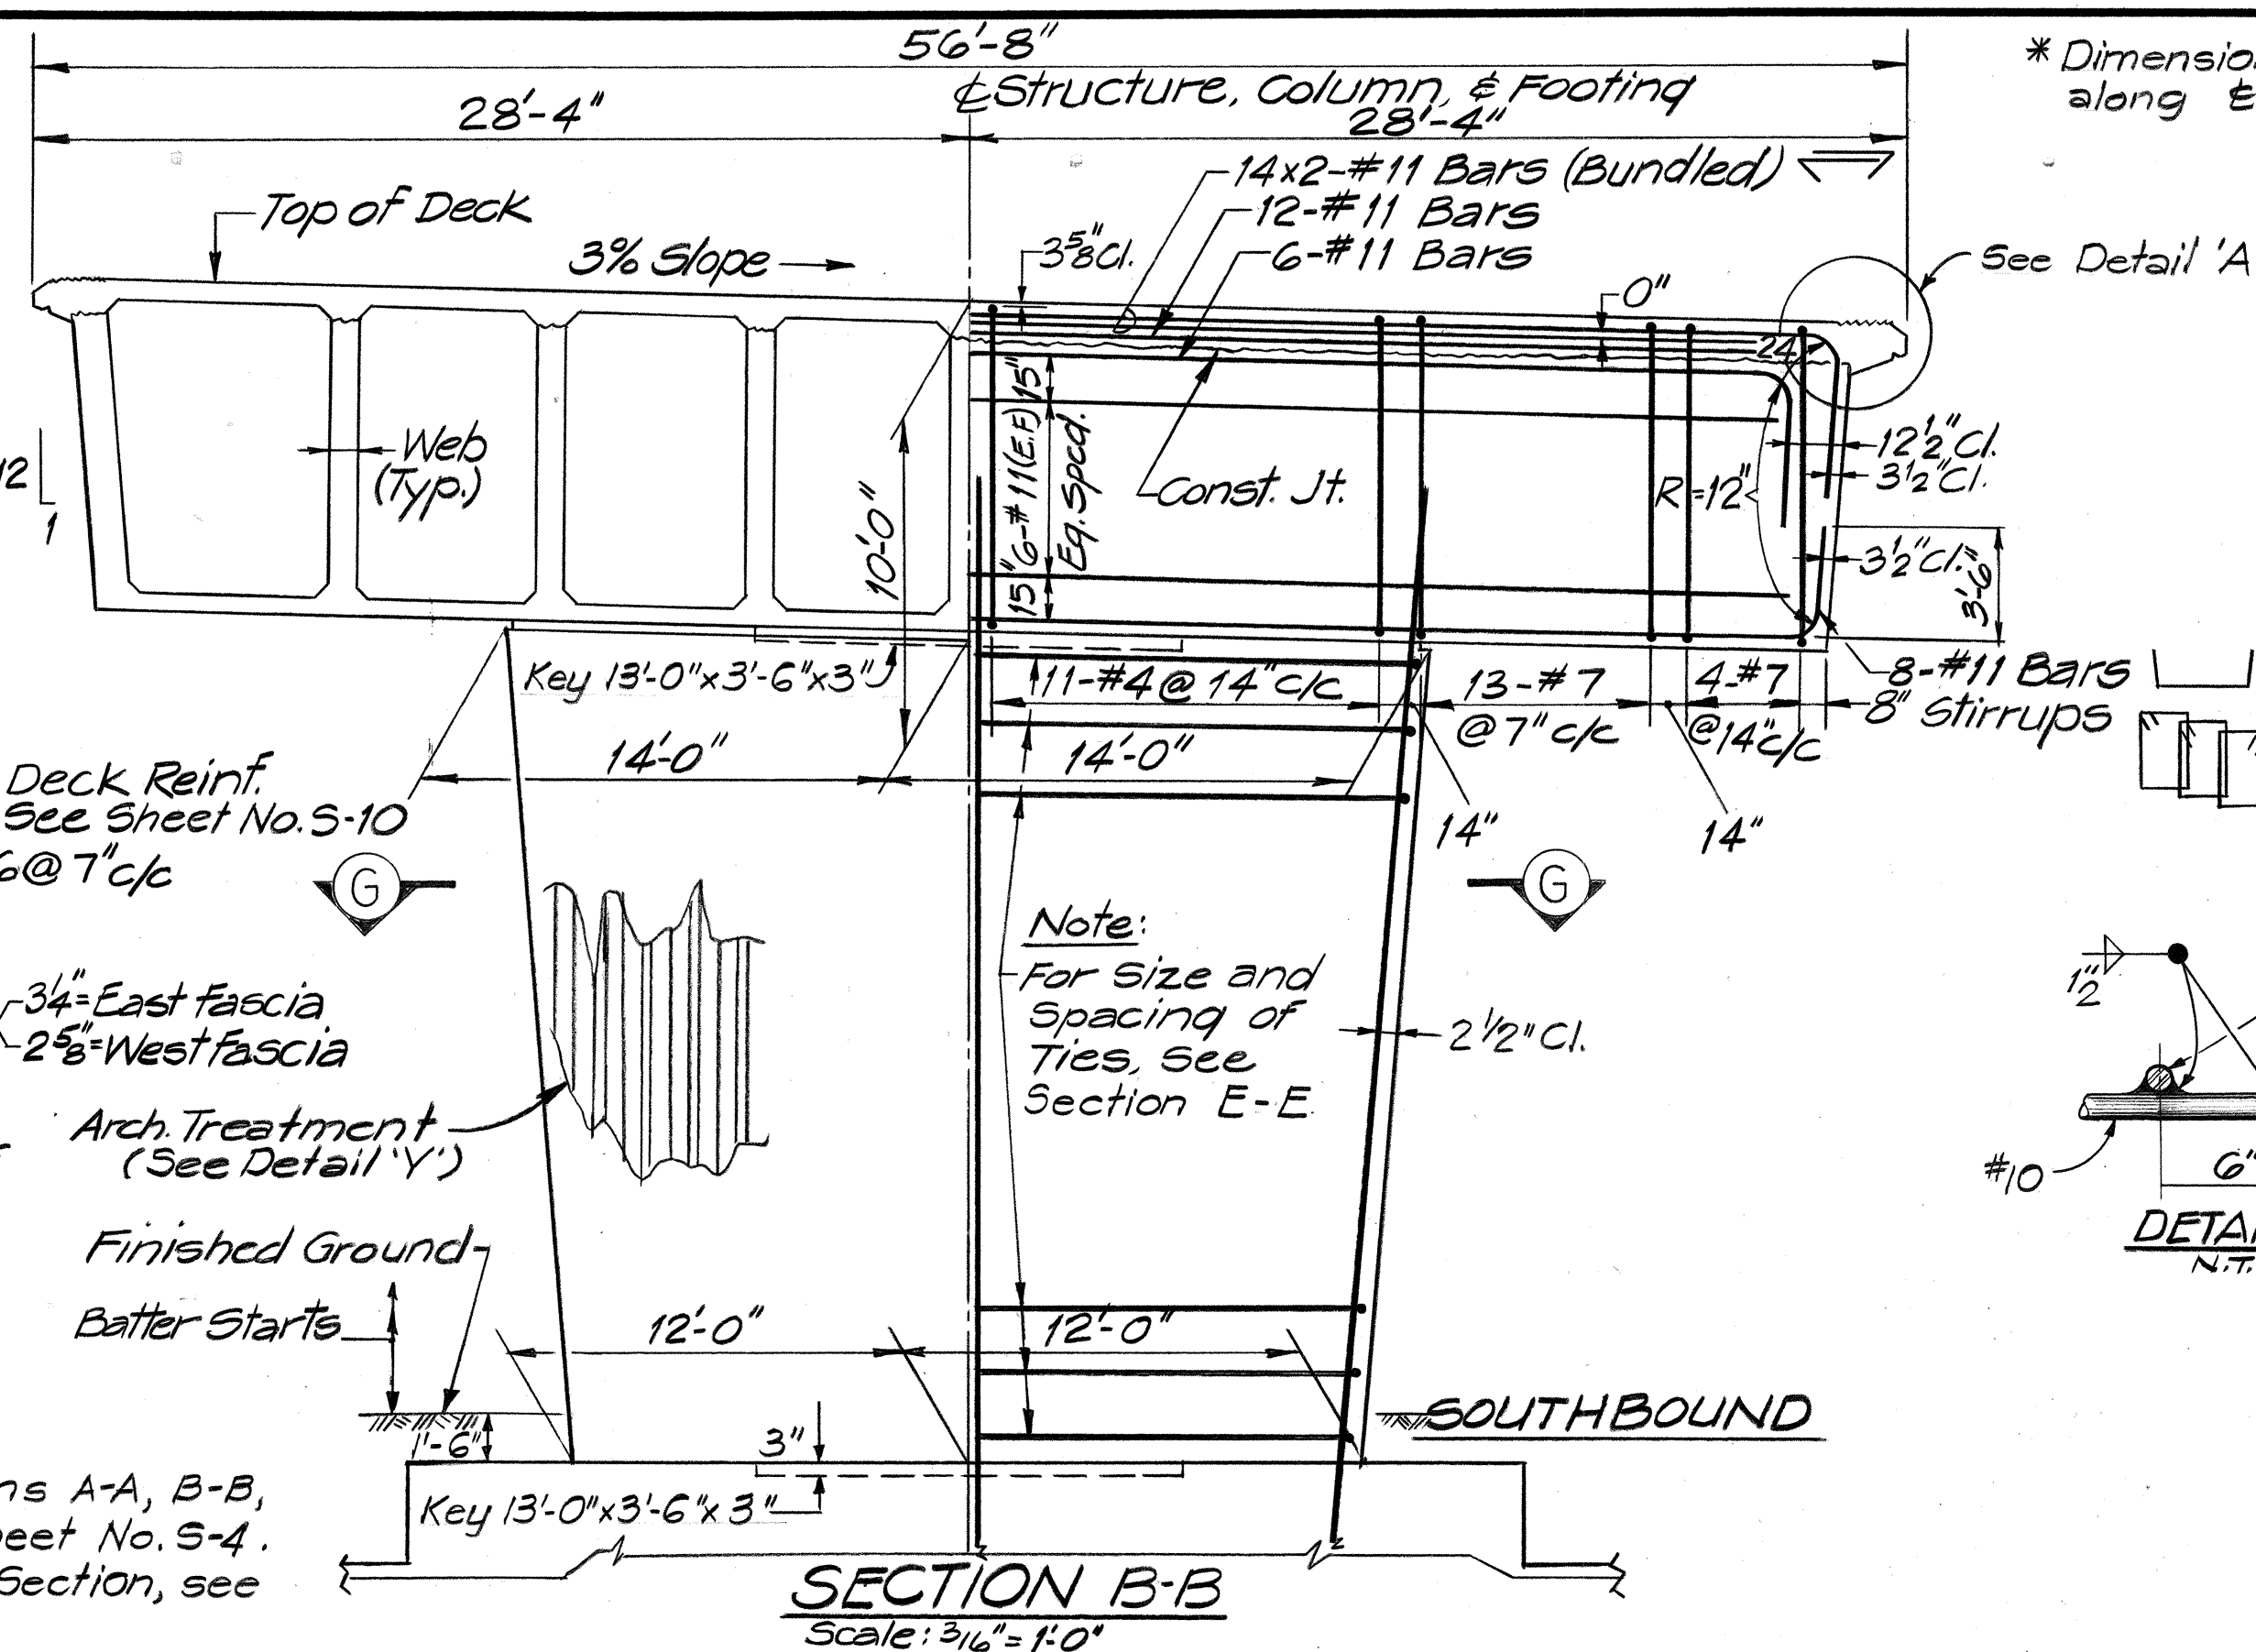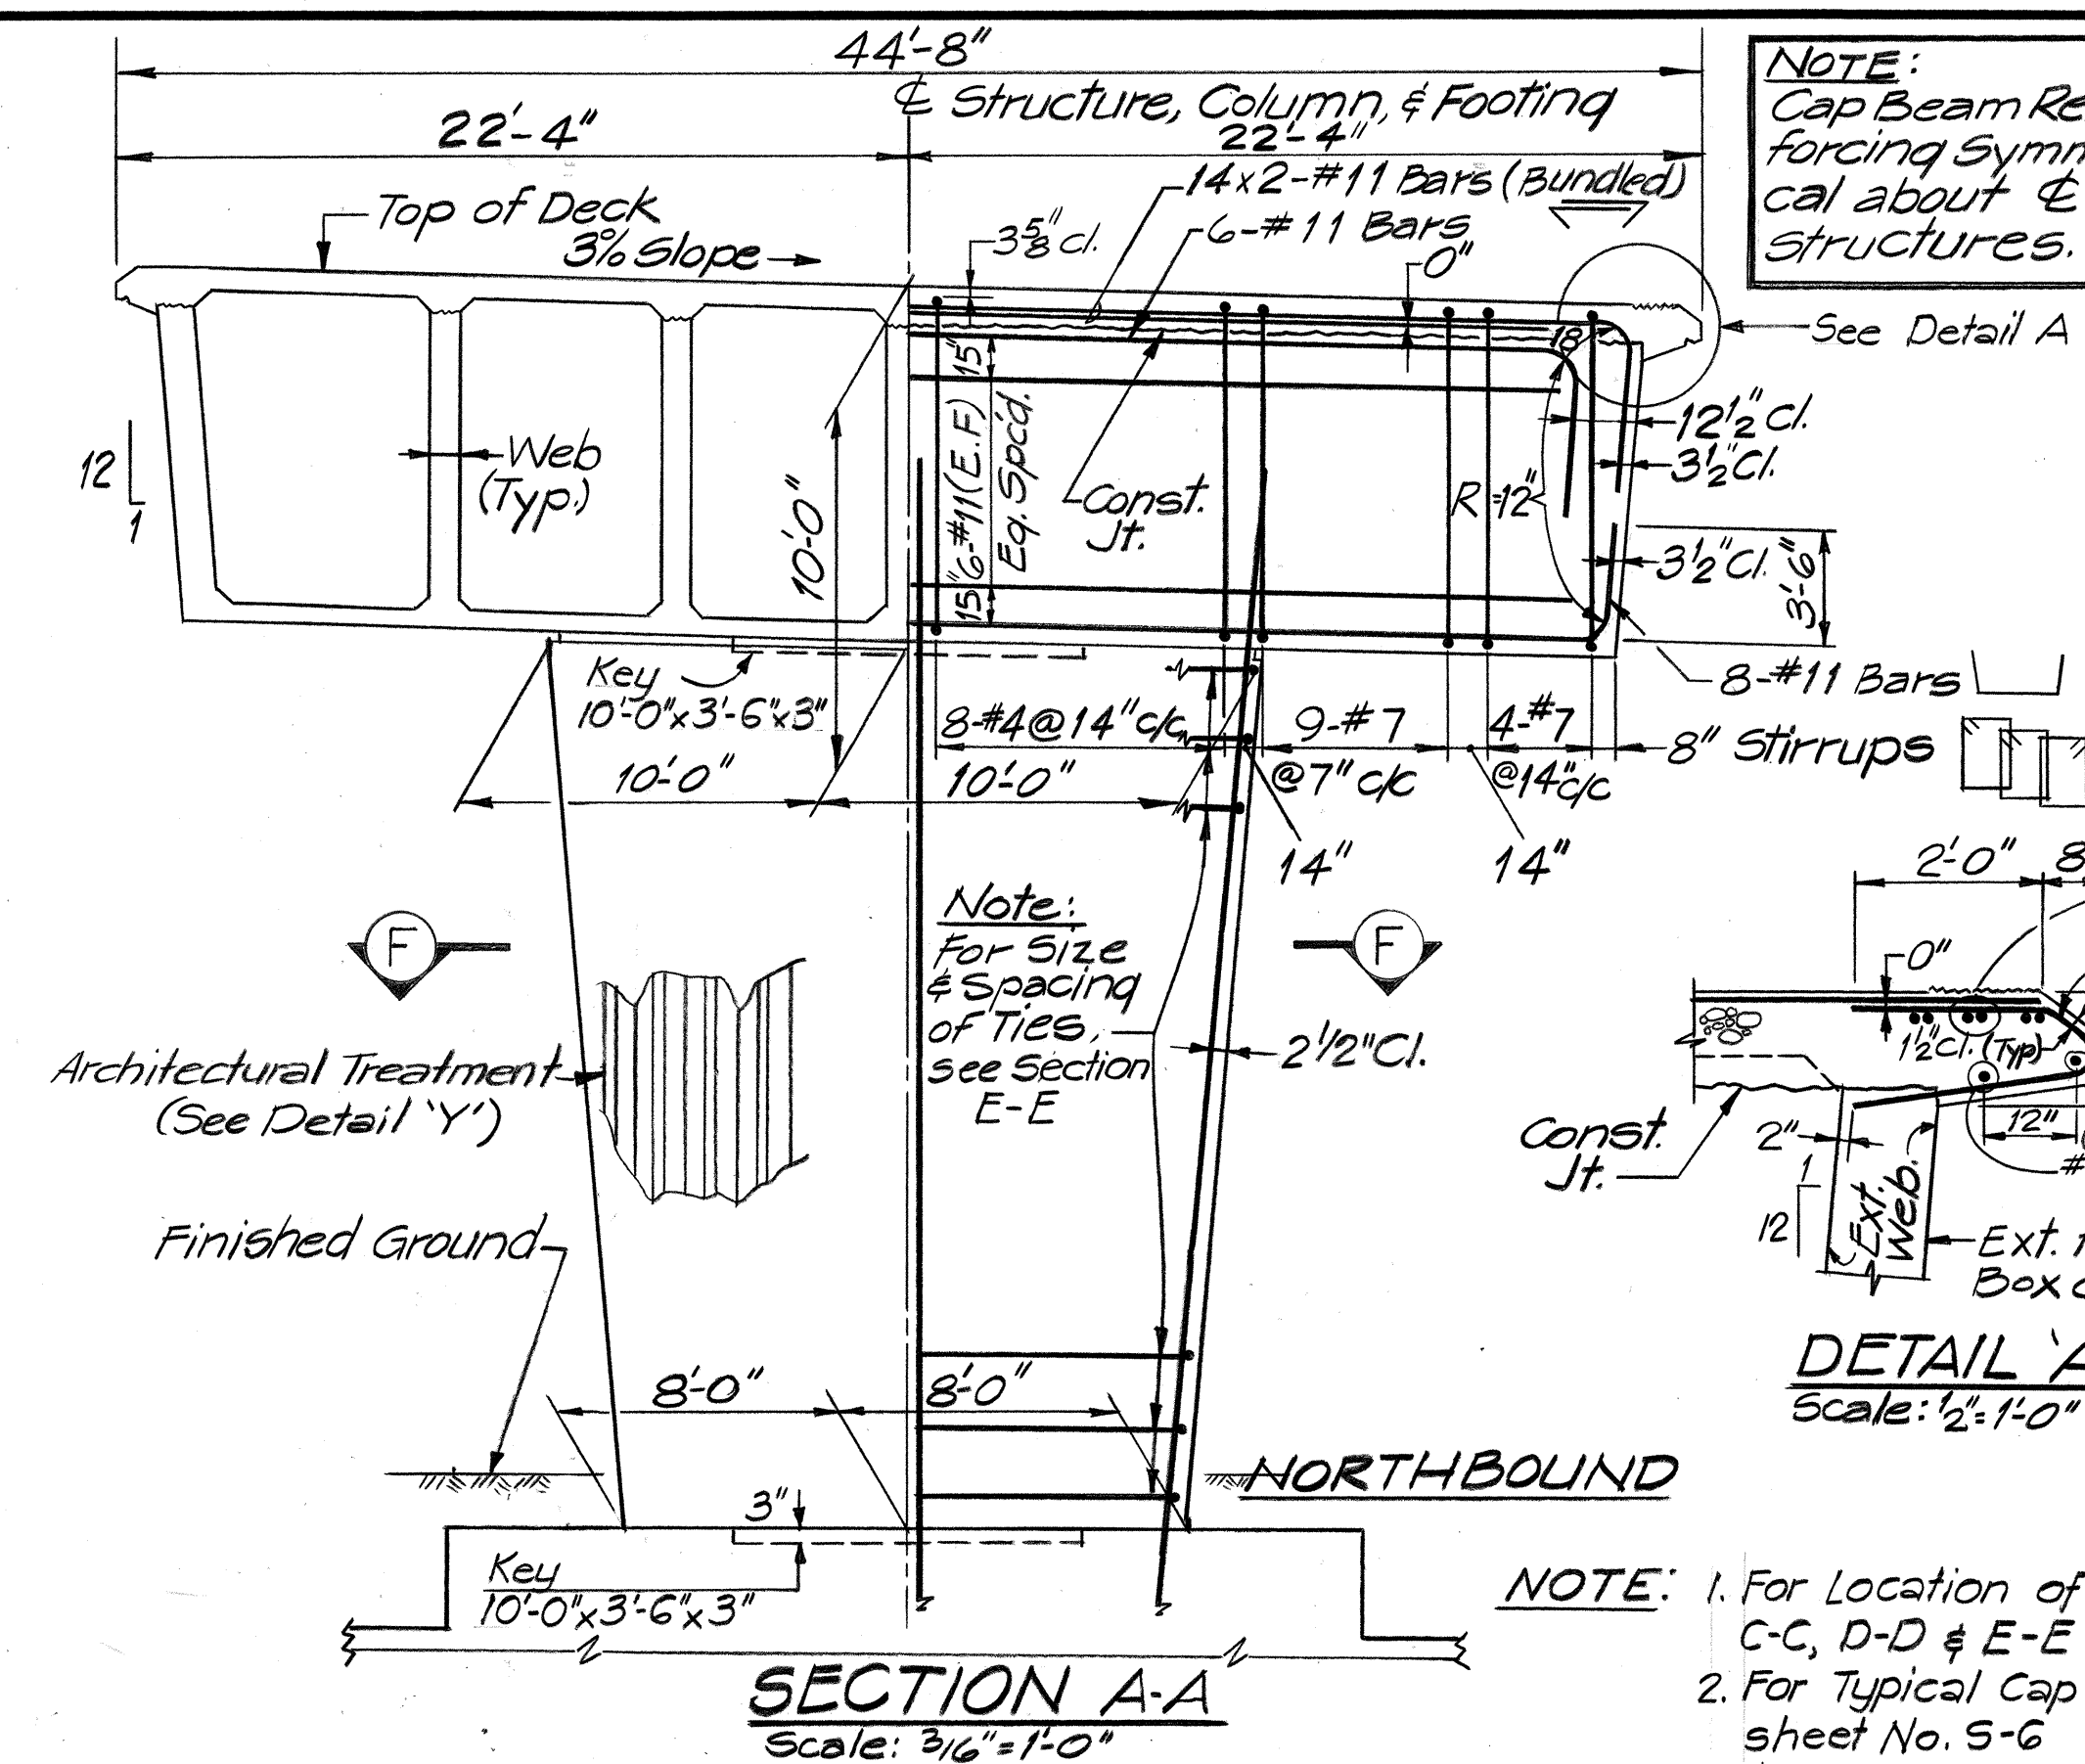

- NOTE:
1. For Location of Sections A-A, B-B, C-C, D-D & E-E see sheet No. S-4.
 2. For Typical Cap Beam Section, see sheet No. S-6
 3. #11 bars, over 60' long in Cap Beam shall have mechanical splices.
 4. For reinforcements in conc. parapets, see Sections E-E & F-F on sheet No. S-10.
 5. For Typical Dapped End Beam View see sht. No. S-7
 6. Bottom Fillets of Box Pier are optional.
-

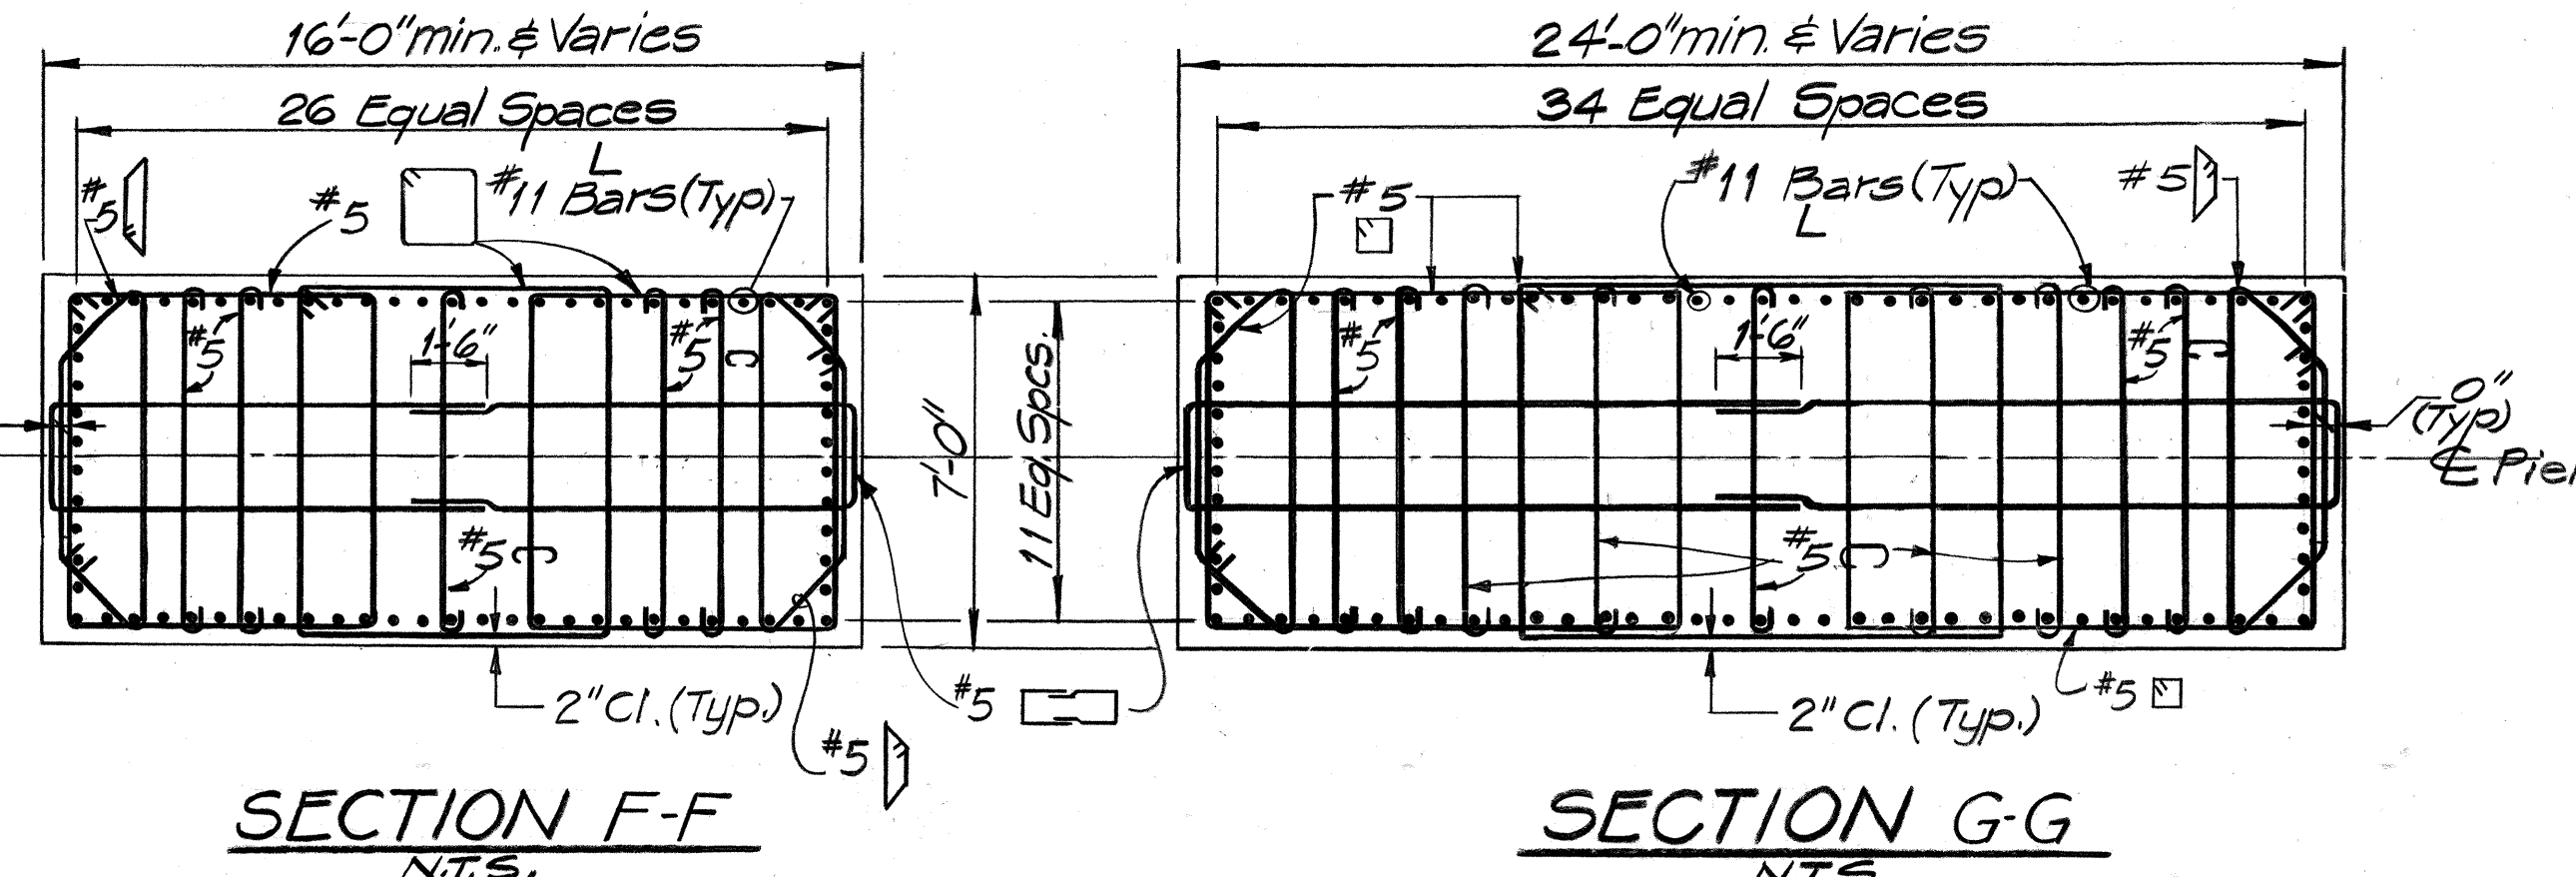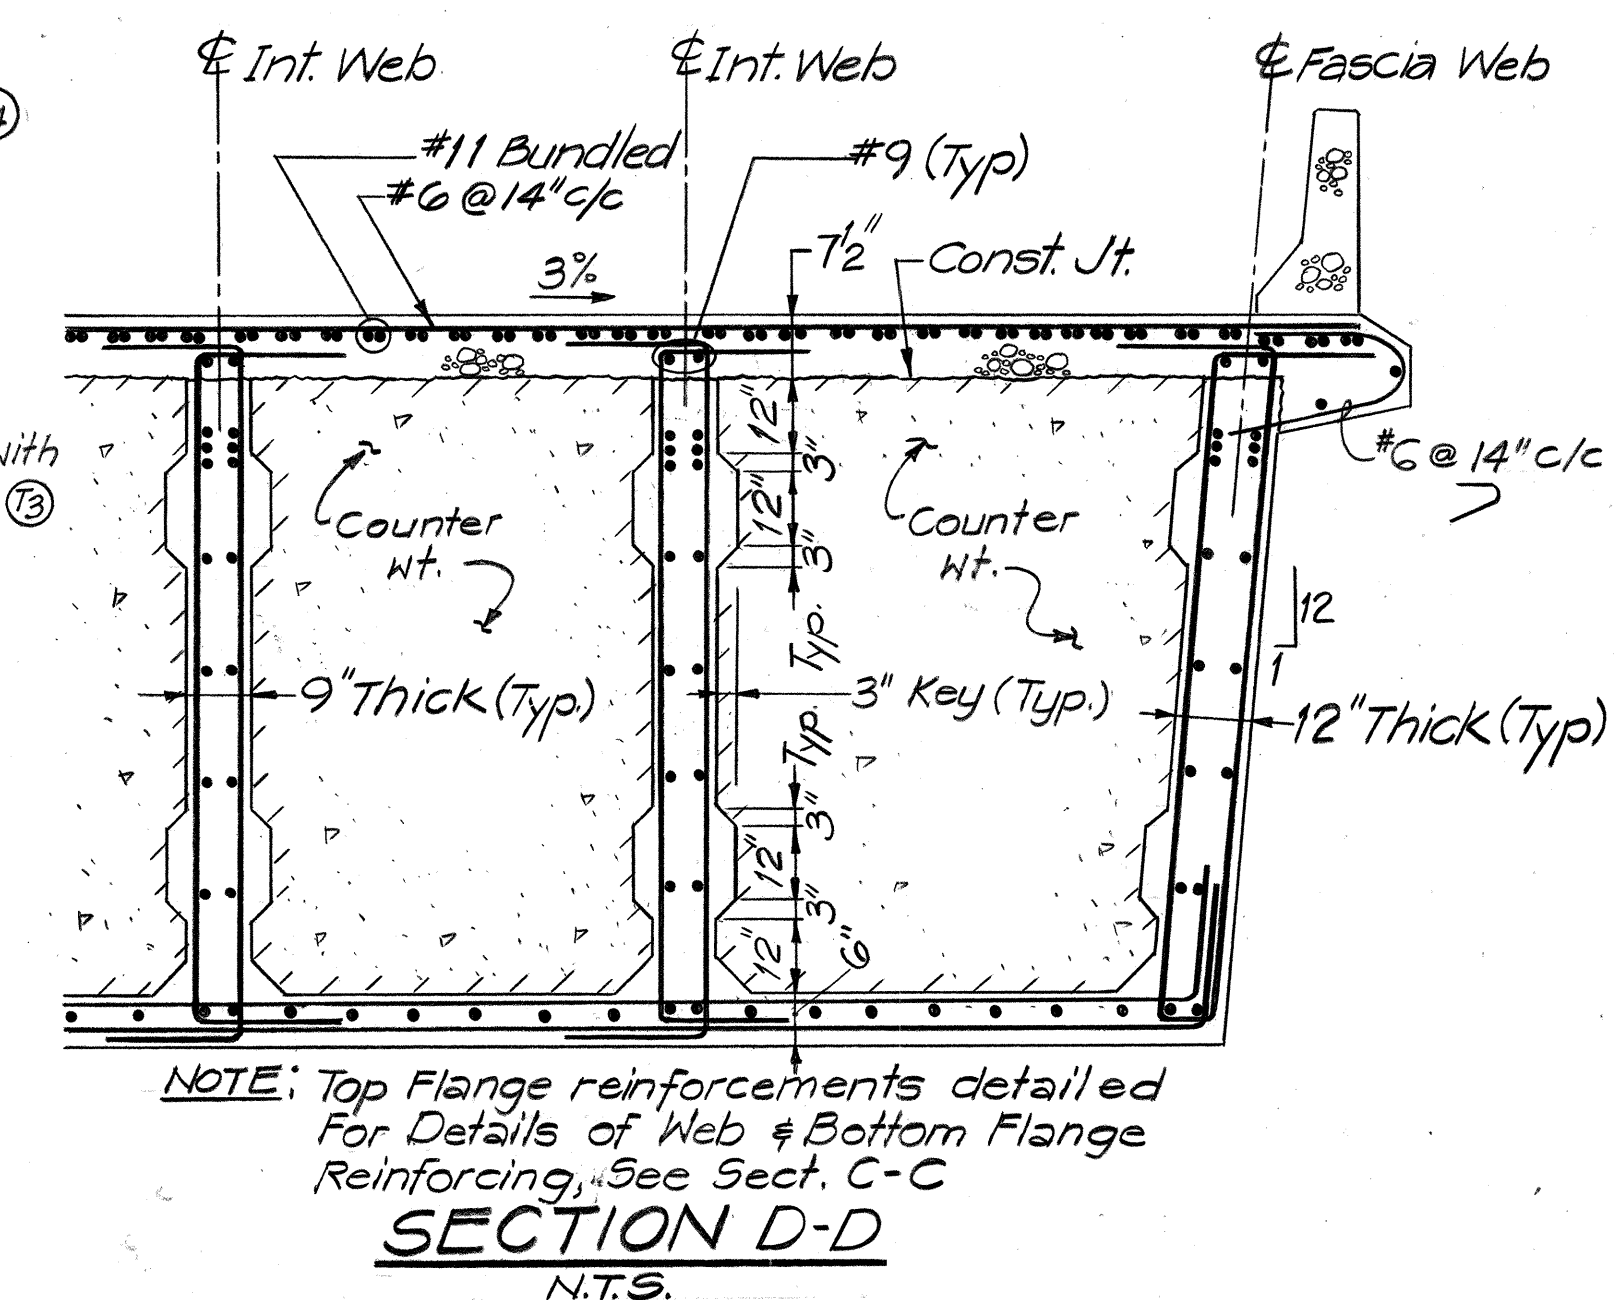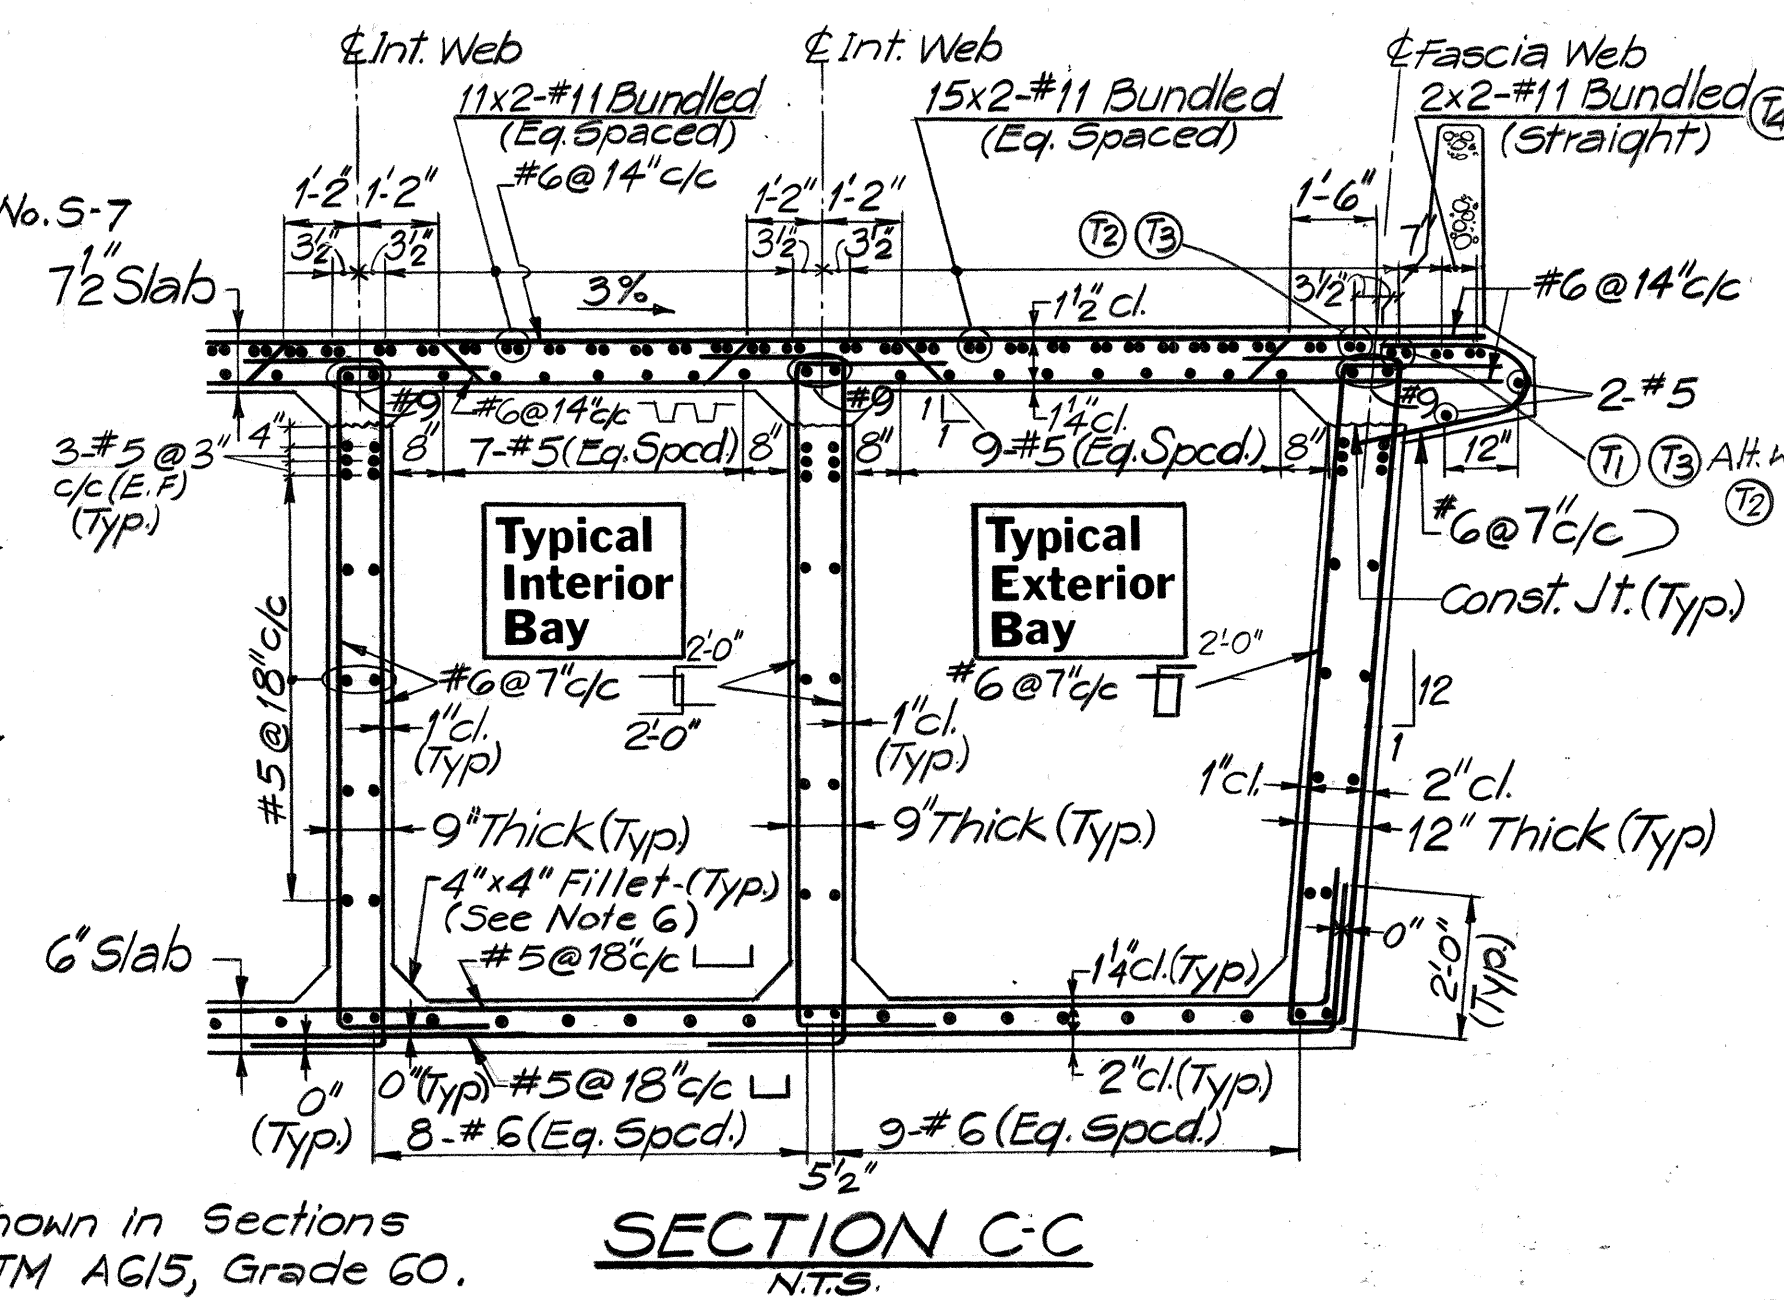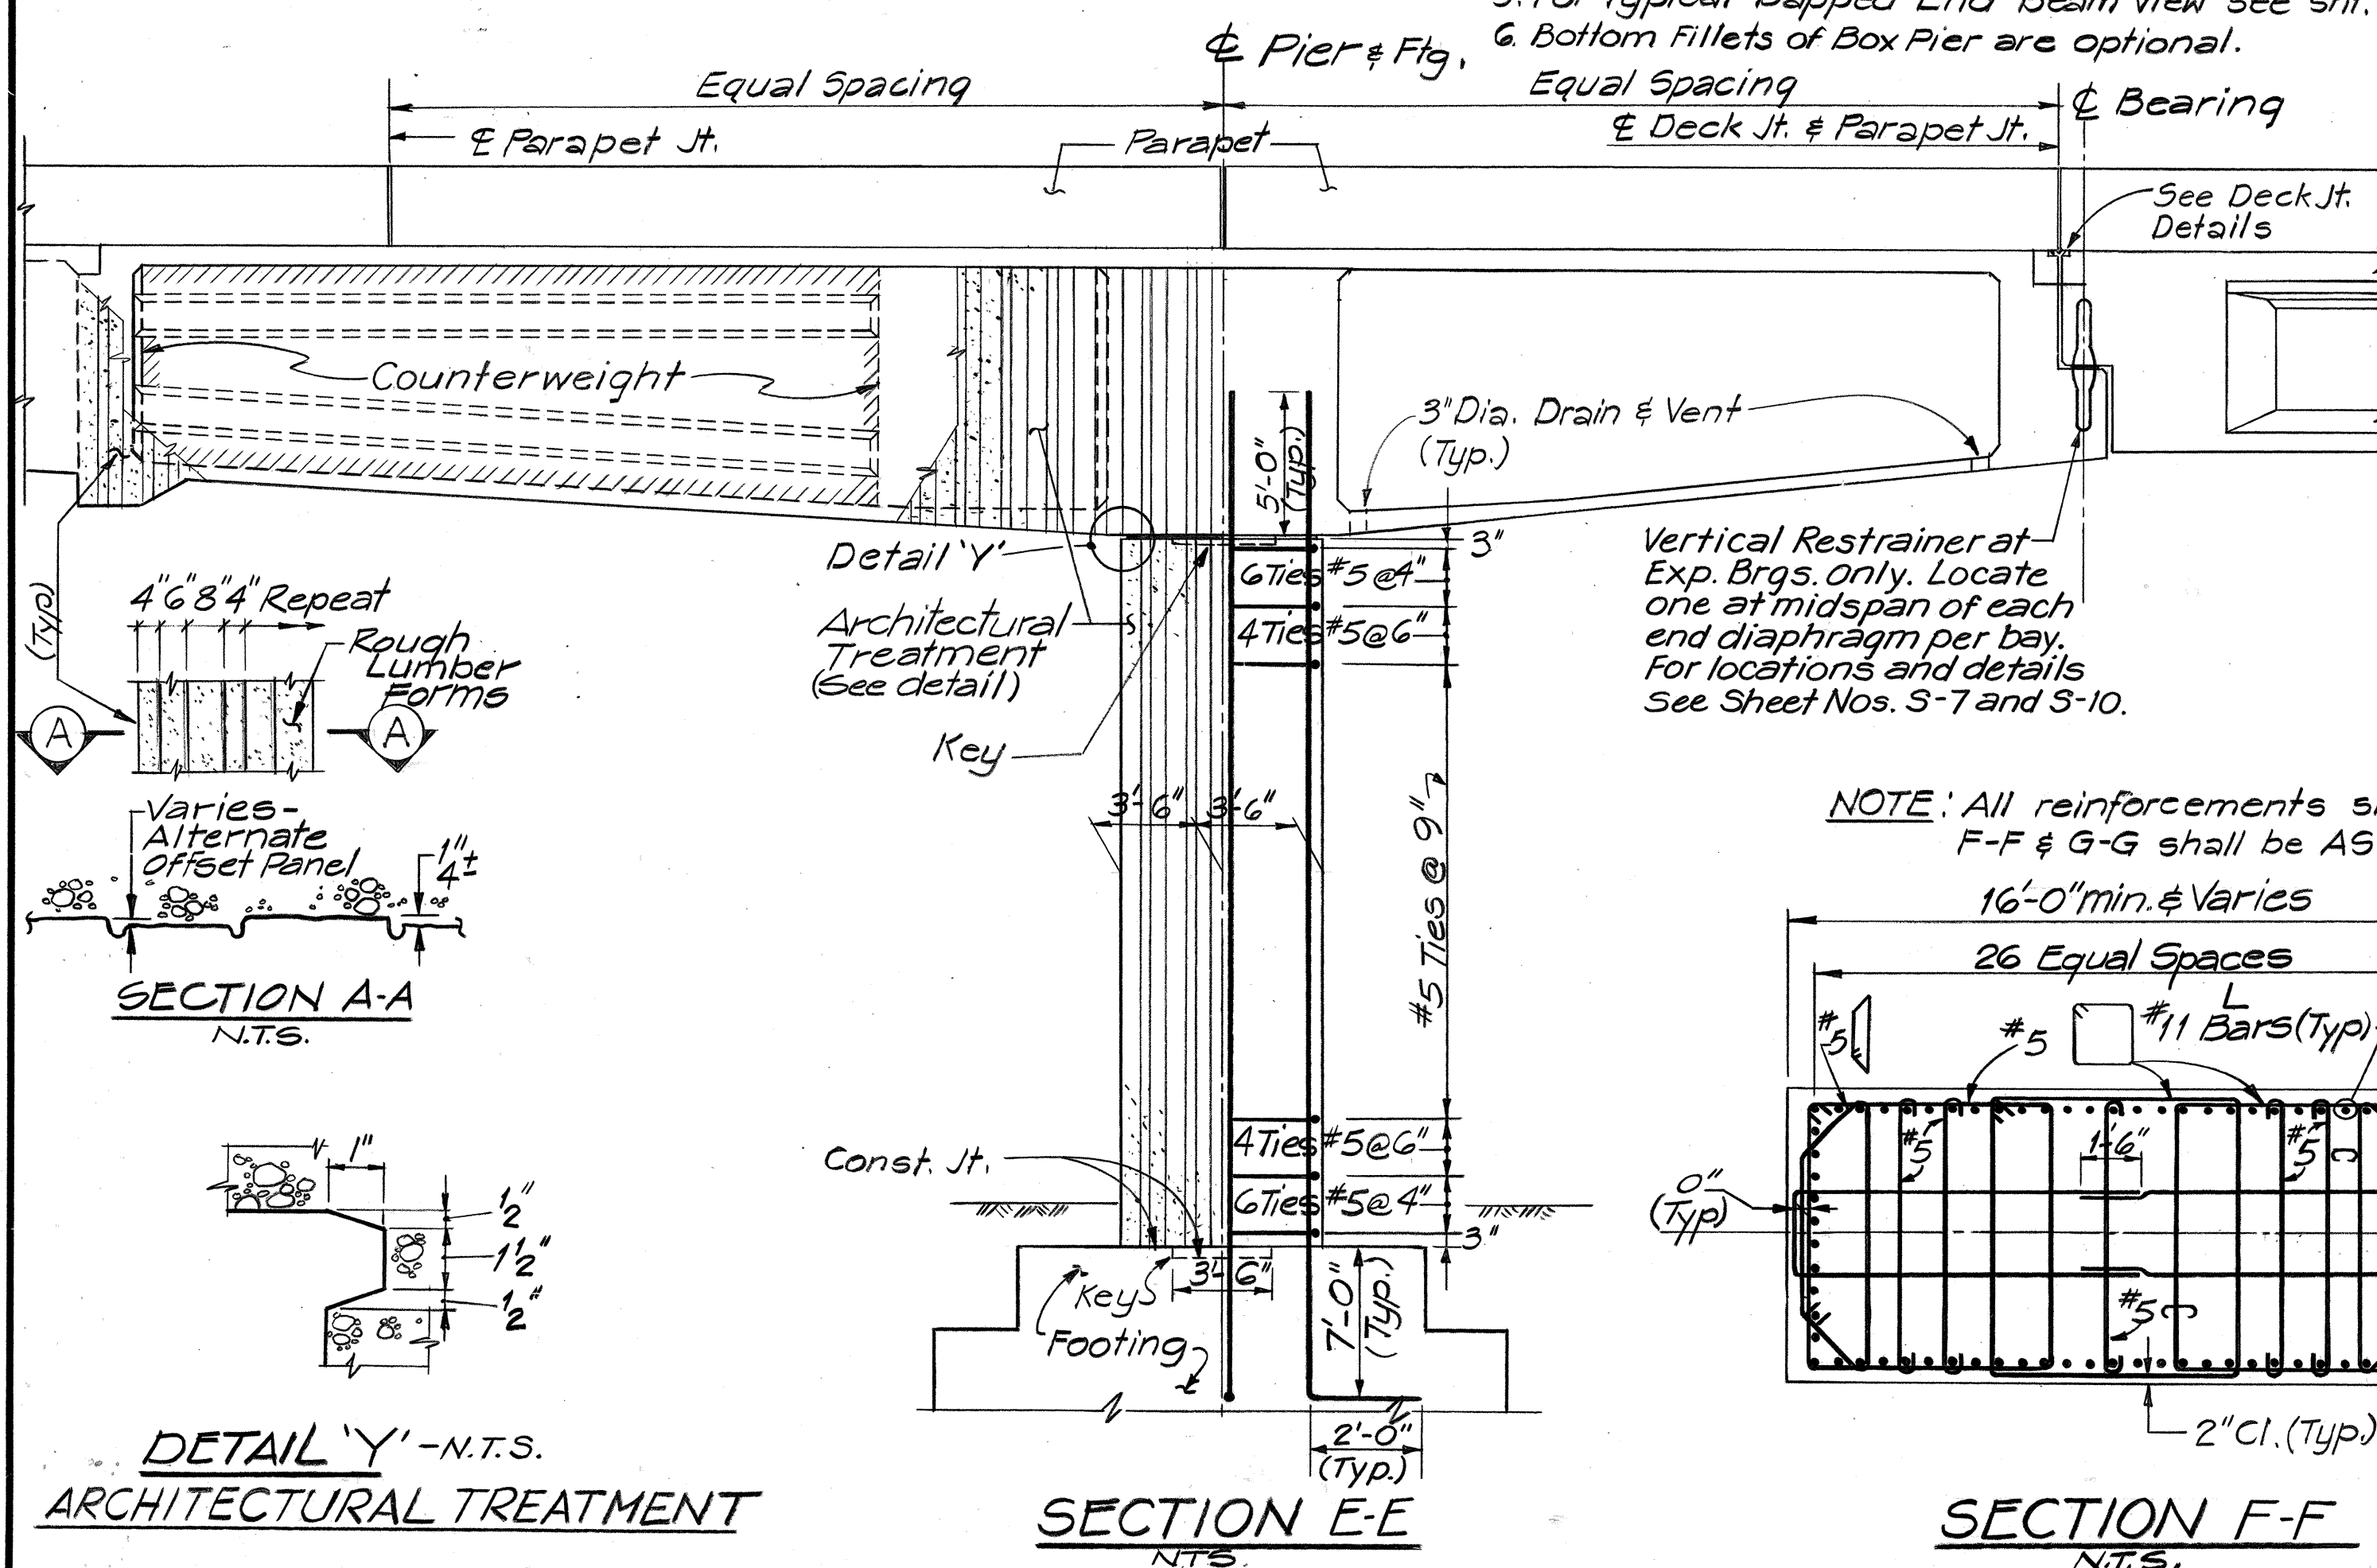

JOHN P. JOHNSON
REGISTERED
PROFESSIONAL
ENGINEER
No. 3647
HAWAII, U.S.A.

THIS WORK WAS PREPARED
OR UNDER MY SUPERVISION

John P. Johnson

STATE OF HAWAII
DEPARTMENT OF TRANSPORTATION
HIGHWAYS DIVISION





BOX PIER - SHEET 2 OF 4
SECTIONS AND DETAILS

FORT WEAVER ROAD
ROUTE H-1 TO SOUTH OF
FARRINGTON HIGHWAY
PROJECT NO. M-7600(1)

SCALE: AS SHOWN DATE: *AUG. 1978*

SHEET NO. S-5 OF S-16 SHEETS

FED. ROAD DIST. NO.	STATE	FED. AID PROJ. NO.	FISCAL YEAR	SHEET NO.	TOTAL SHEETS
HAWAII	HAW.	14-7600(1)	1978	137	198

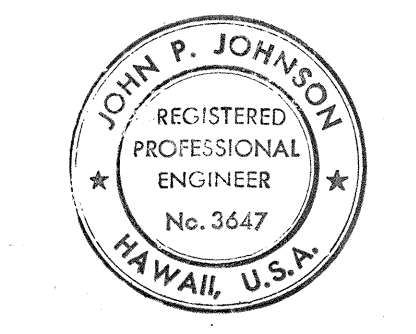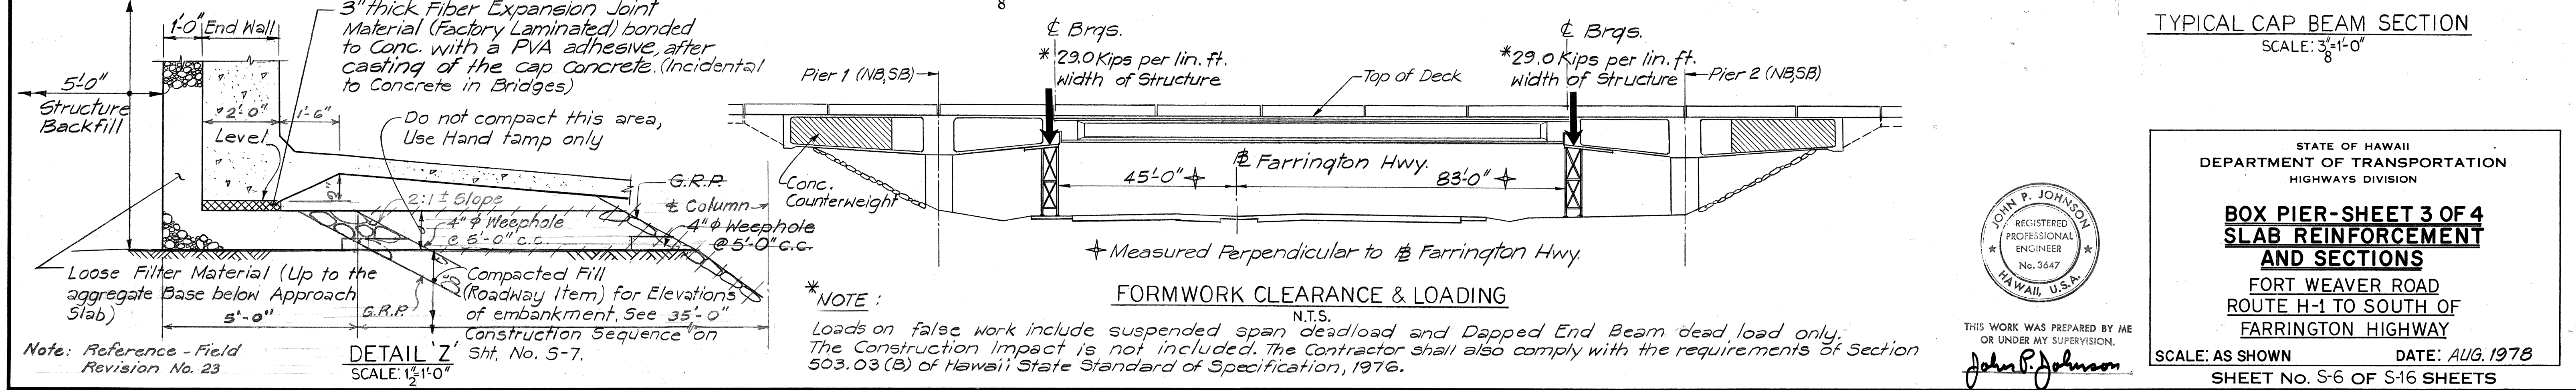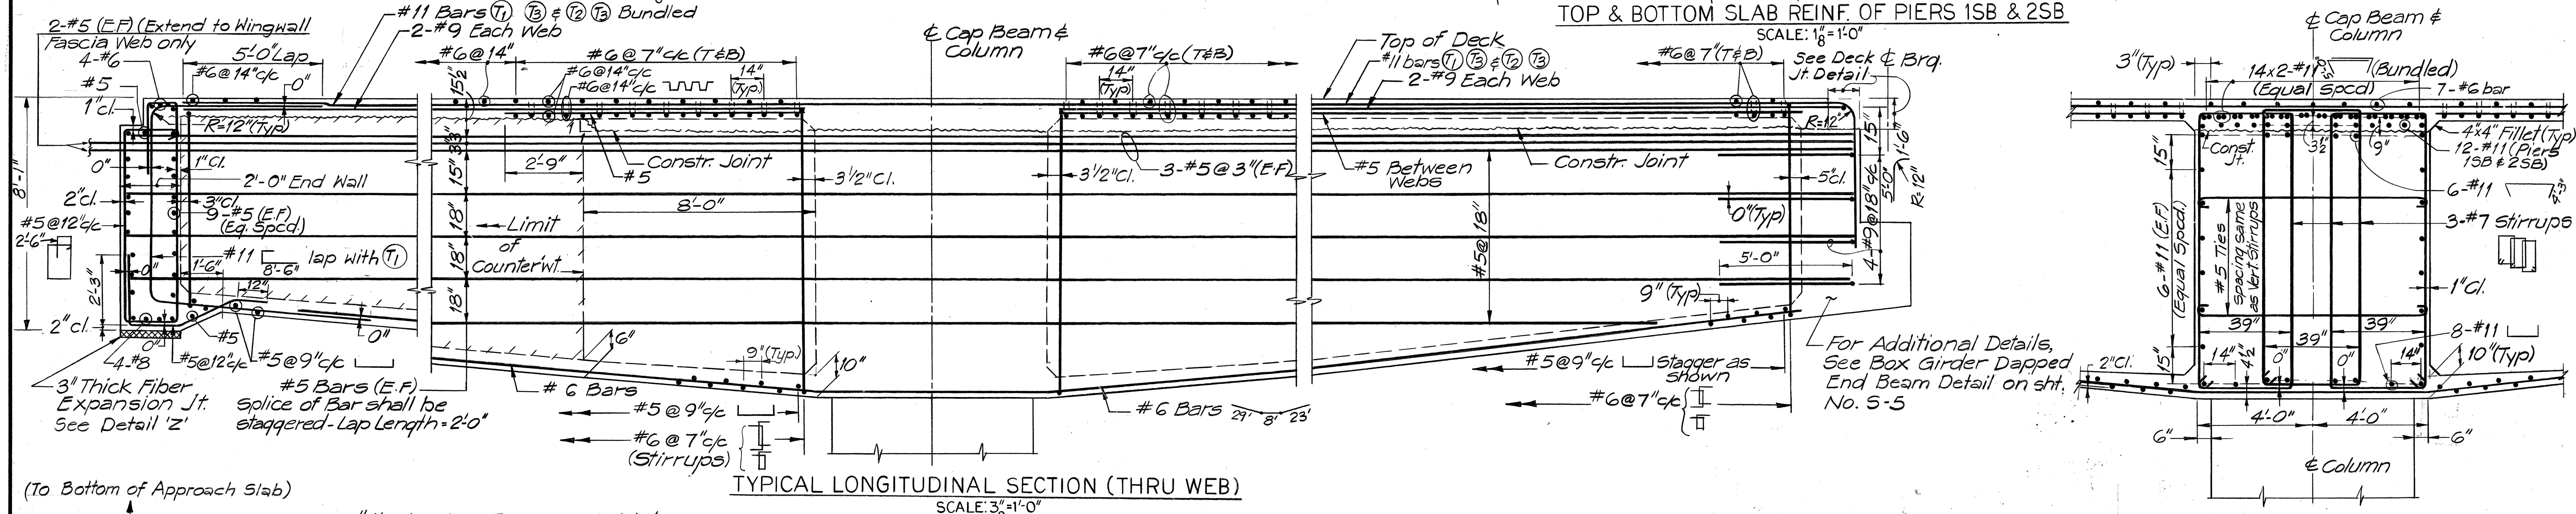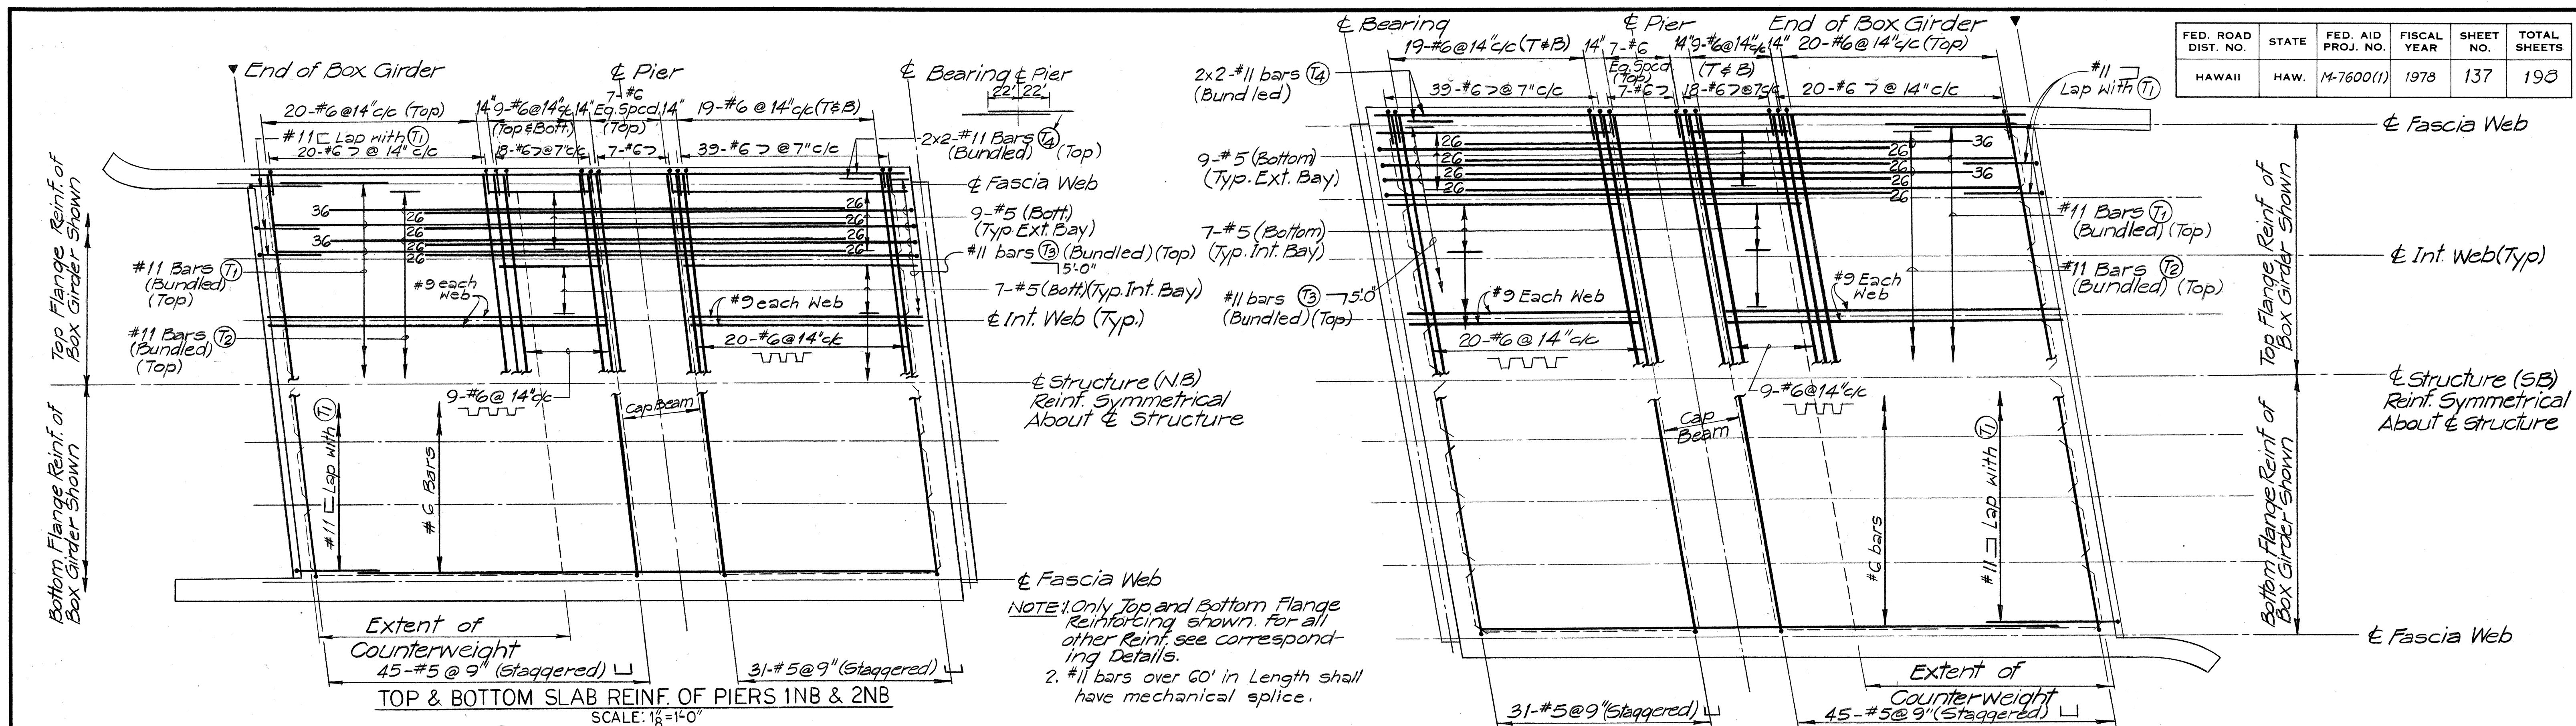


STATE OF HAWAII
DEPARTMENT OF TRANSPORTATION
HIGHWAYS DIVISION

**BOX PIER-SHEET 3 OF 4
SLAB REINFORCEMENT
AND SECTIONS**


FORT WEAVER ROAD
ROUTE H-1 TO SOUTH OF
FARRINGTON HIGHWAY

SCALE: AS SHOWN DATE: AUG. 1978
SHEET No. S-6 OF S-16 SHEETS


FED. ROAD DIST. NO.	STATE	FED. AID PROJ. NO.	FISCAL YEAR	SHEET NO.	TOTAL SHEETS
HAWAII	HAW.	M-7600(1)	1978	139	198

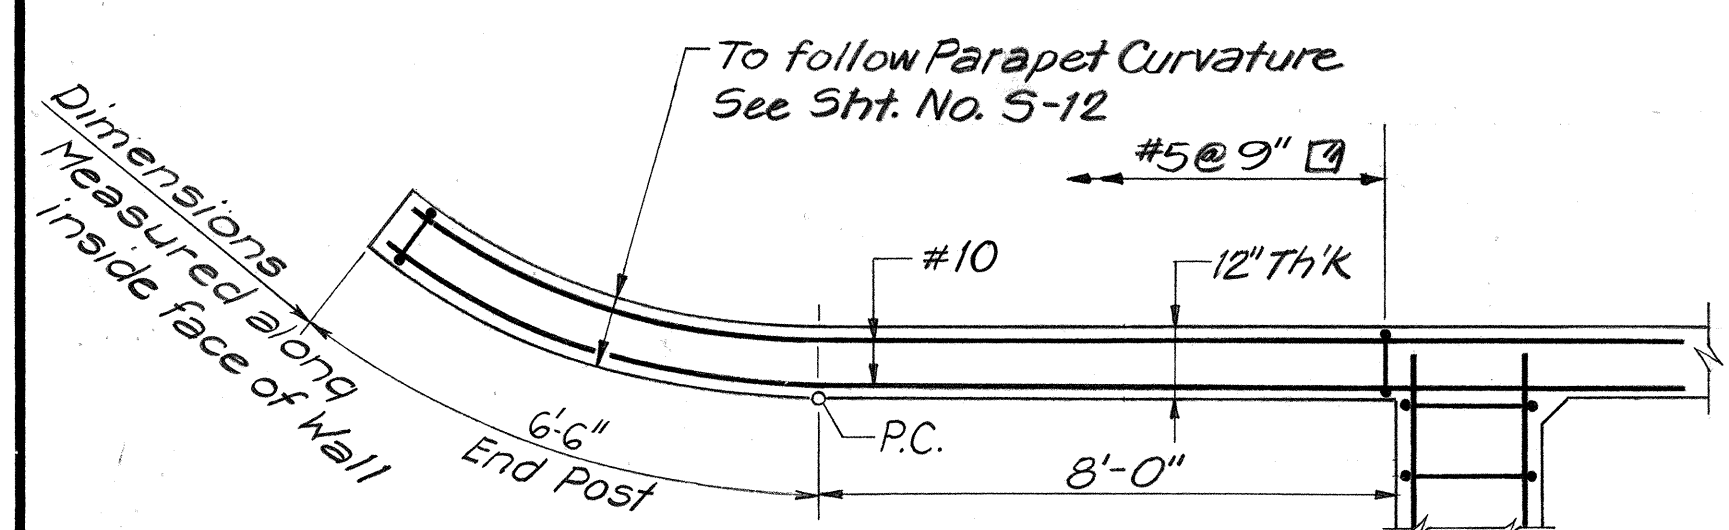


SECTION A-A
SCALE: $\frac{3}{8}$ " = 1'-0"

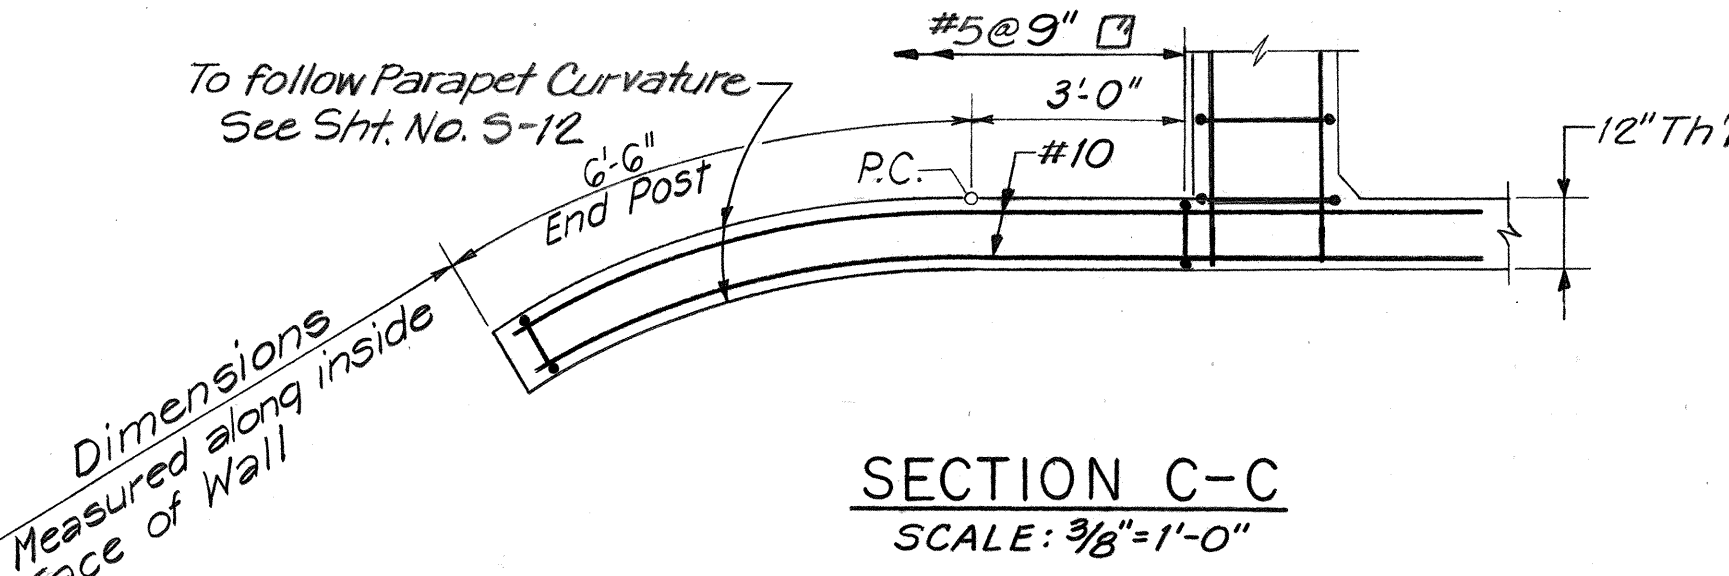


SECTION C-C
SCALE: $\frac{3}{8}$ " = 1'-0"

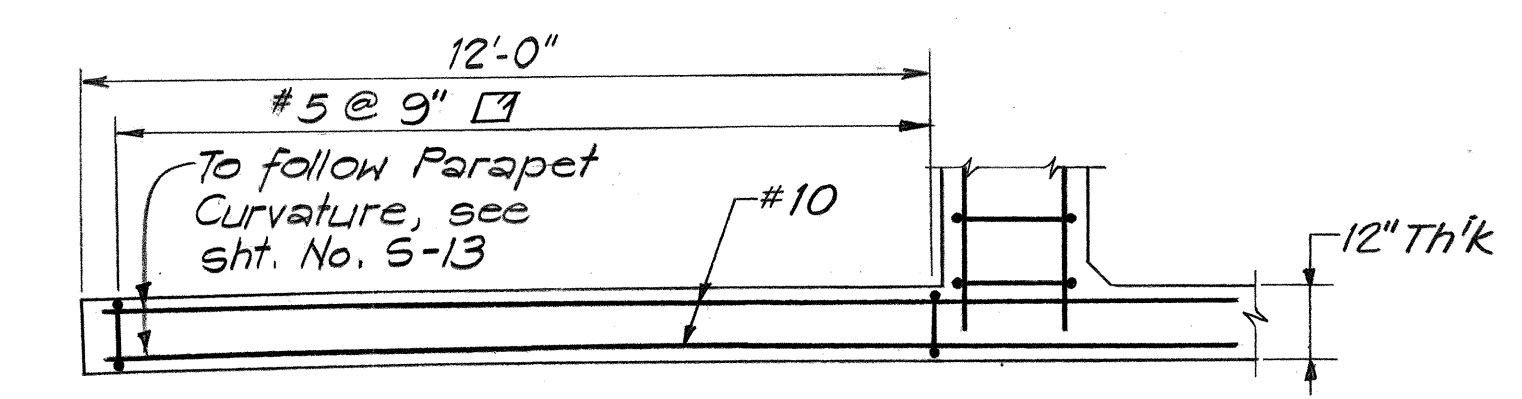


SECTION D-D
SCALE: $\frac{3}{8}$ " = 1'-0"

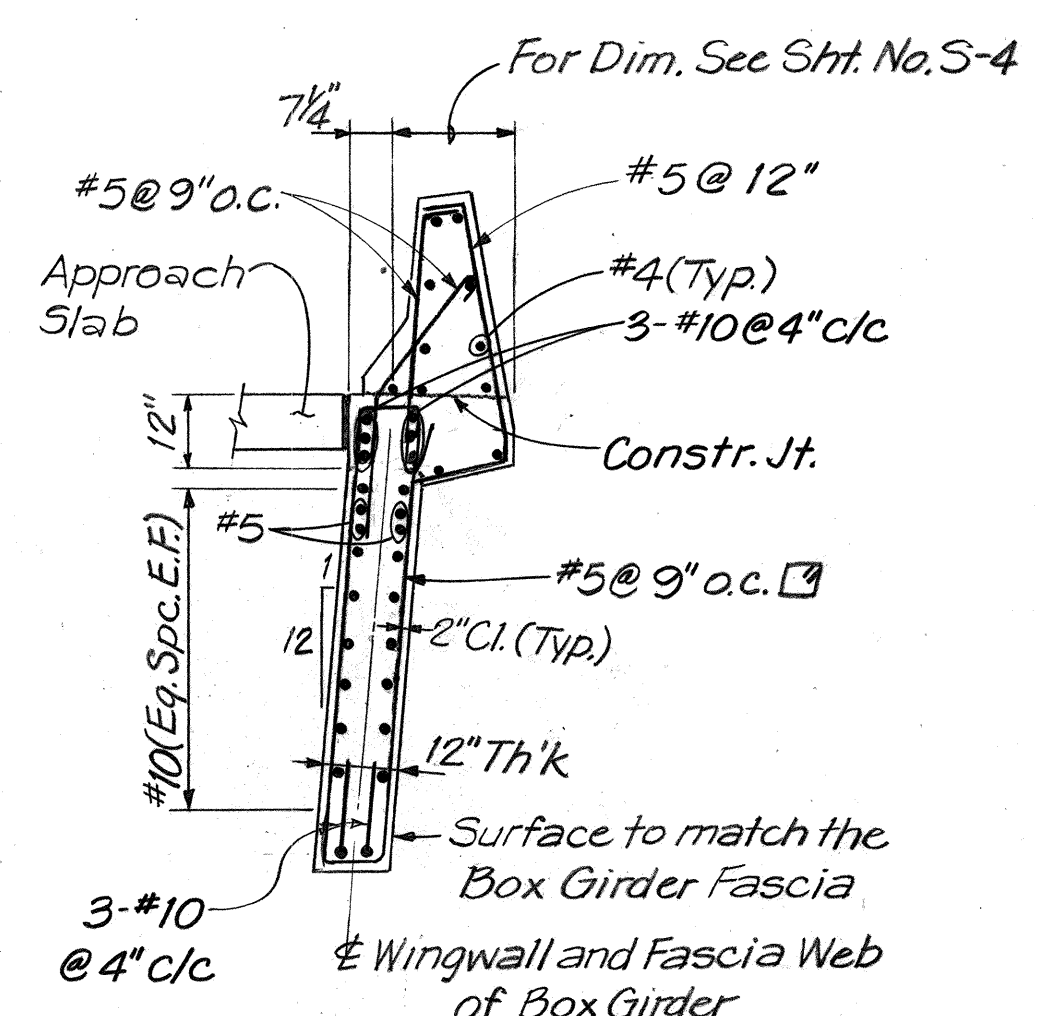


SECTION B-B
SCALE: $\frac{3}{8}$ " = 1'-0"

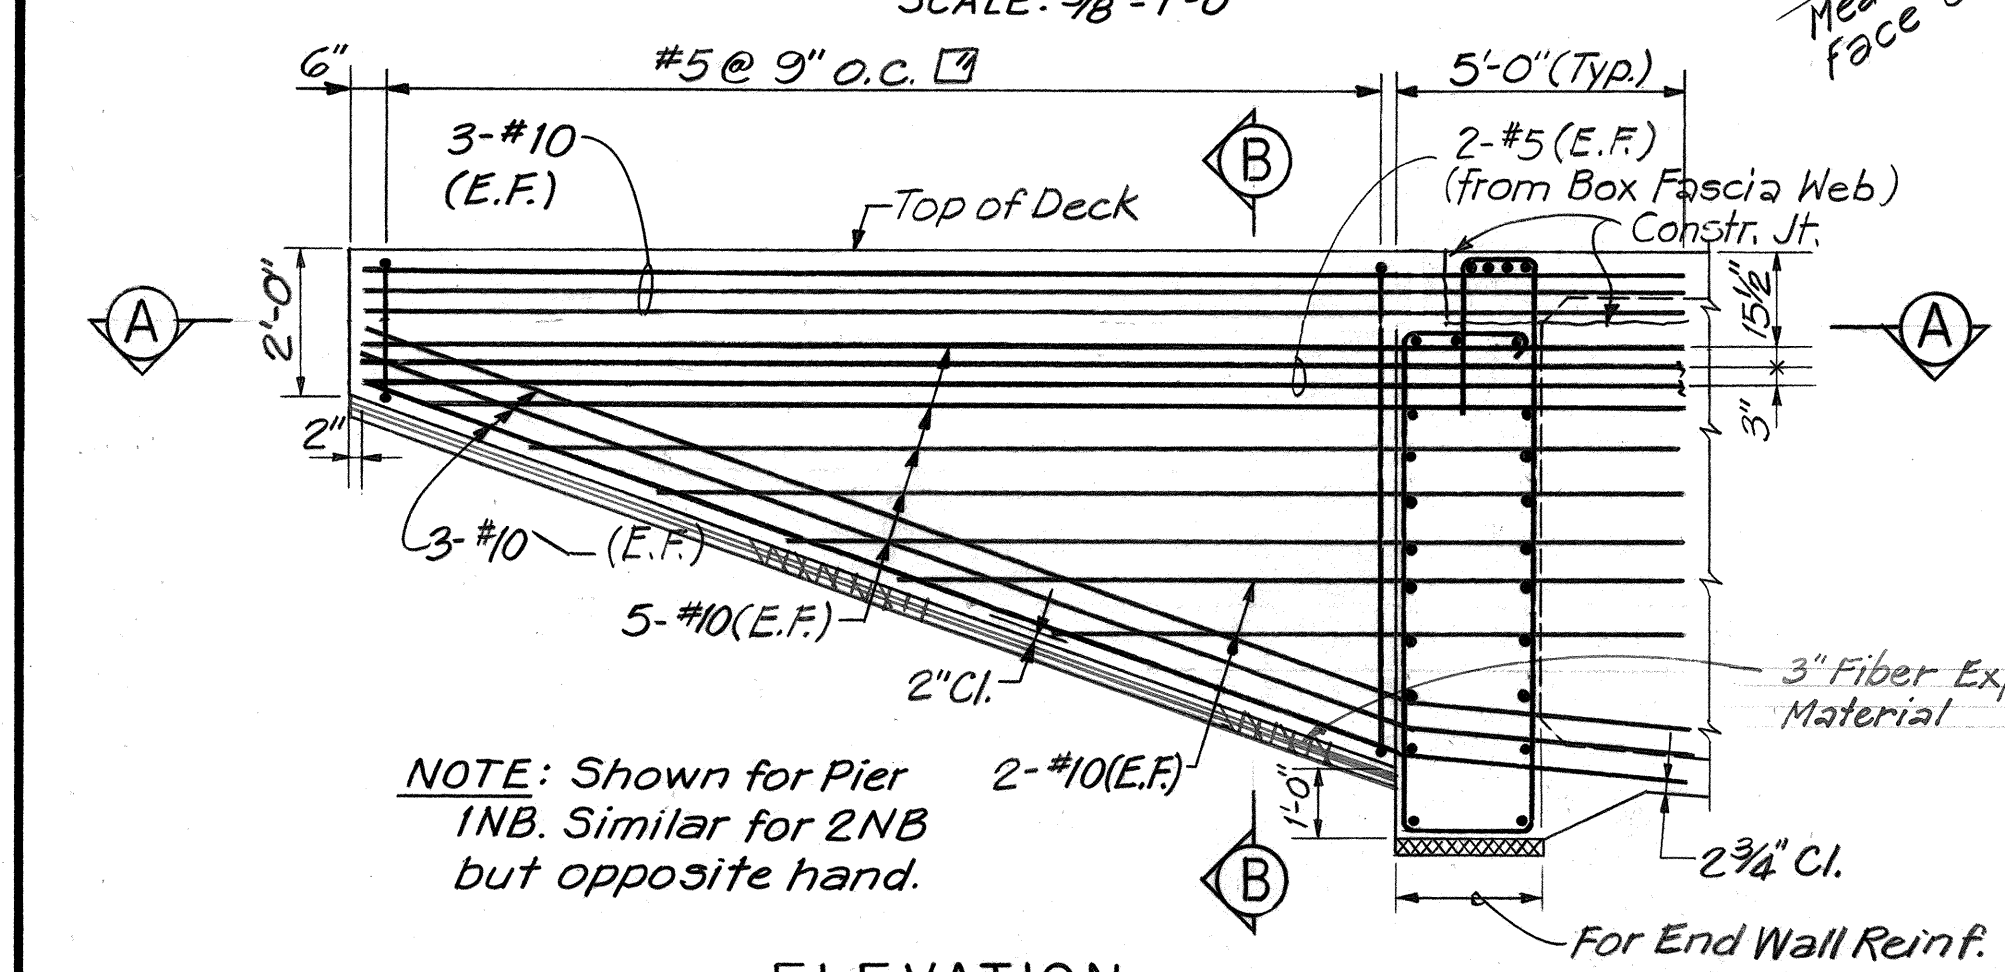


ELEVATION WINGWALL TYPE I
SCALE: $\frac{3}{8}$ " = 1'-0"

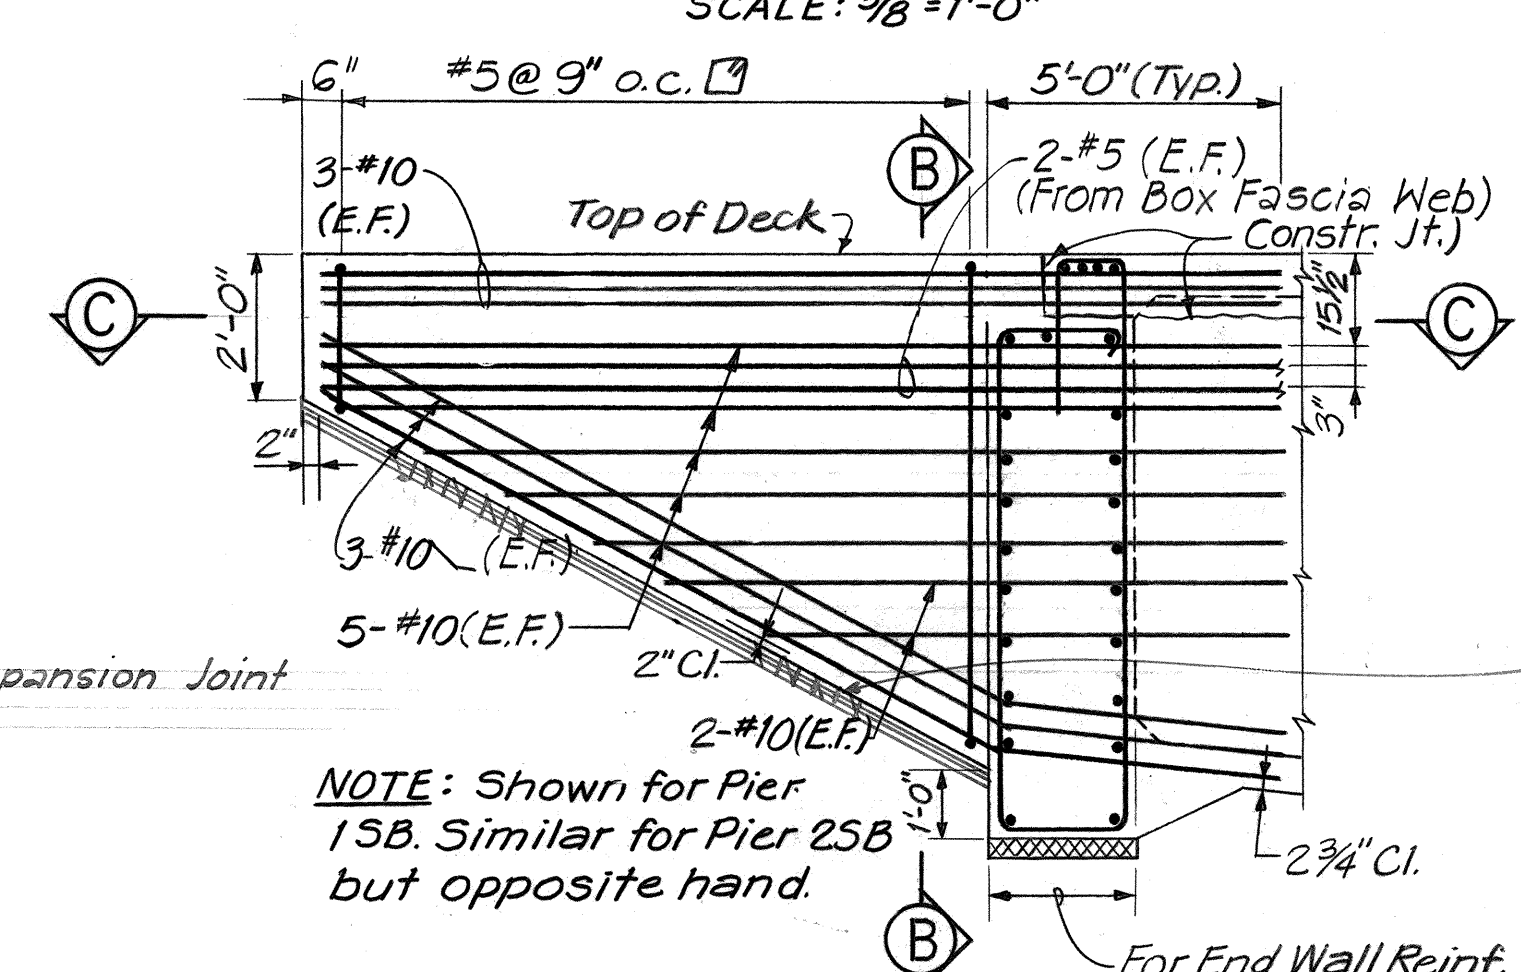


ELEVATION WINGWALL TYPE II
SCALE: $\frac{3}{8}$ " = 1'-0"

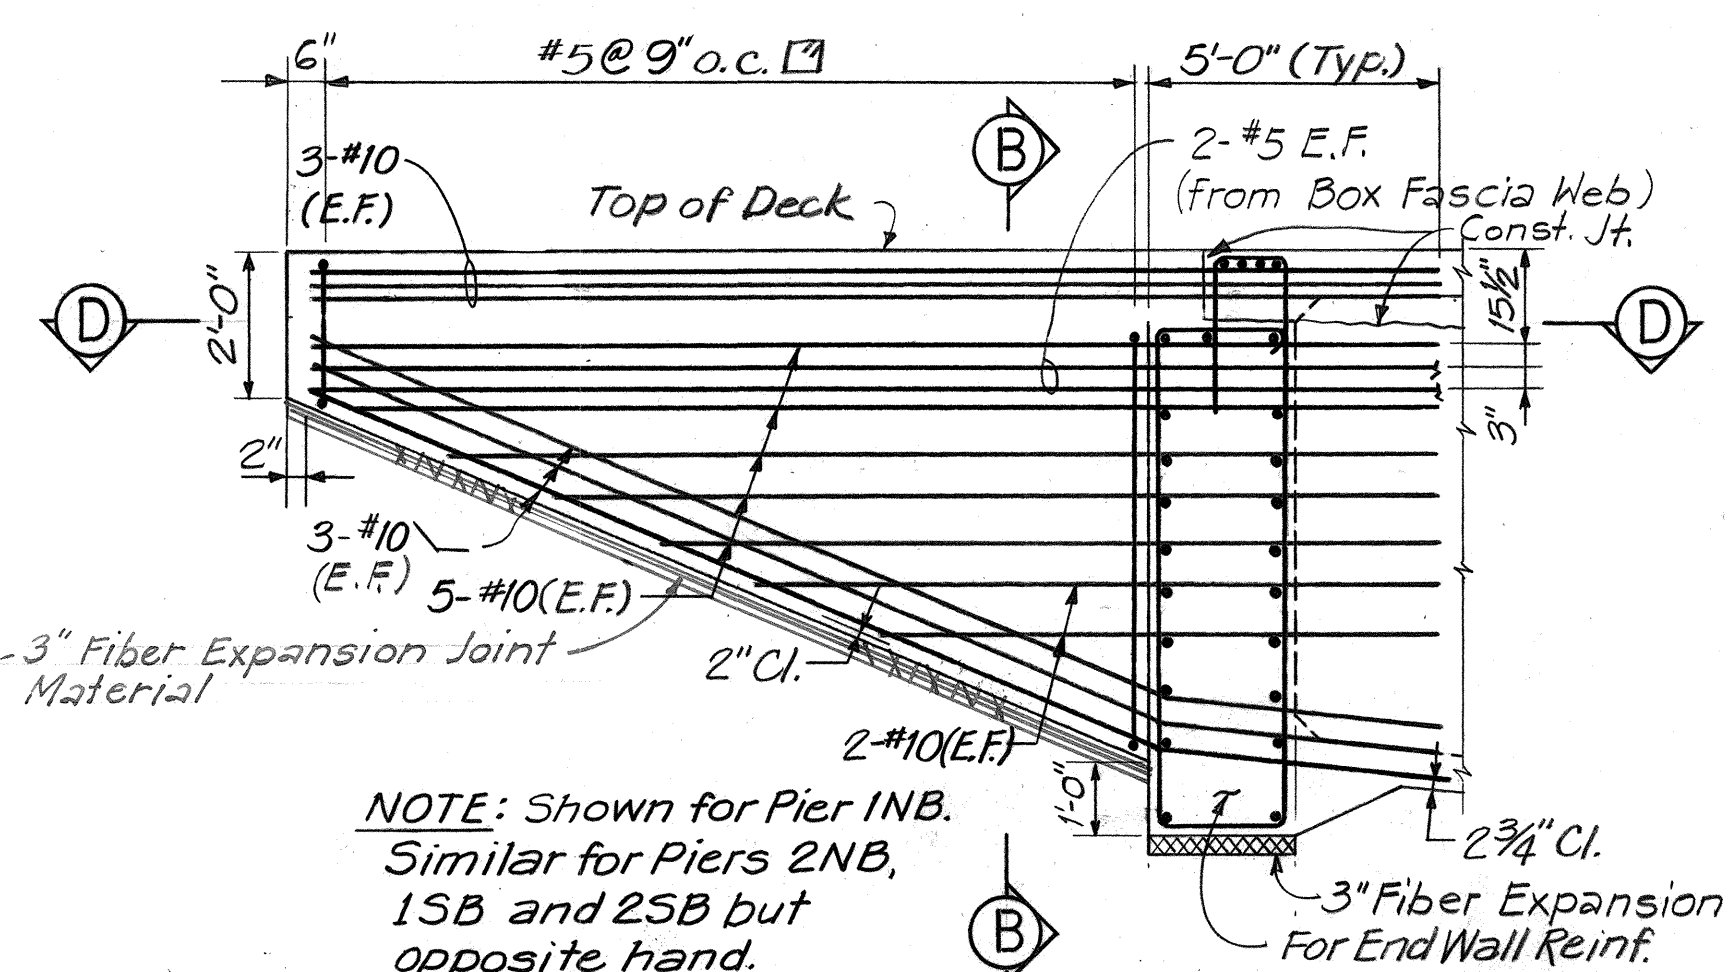


ELEVATION WINGWALL TYPE III
SCALE: $\frac{3}{8}$ " = 1'-0"

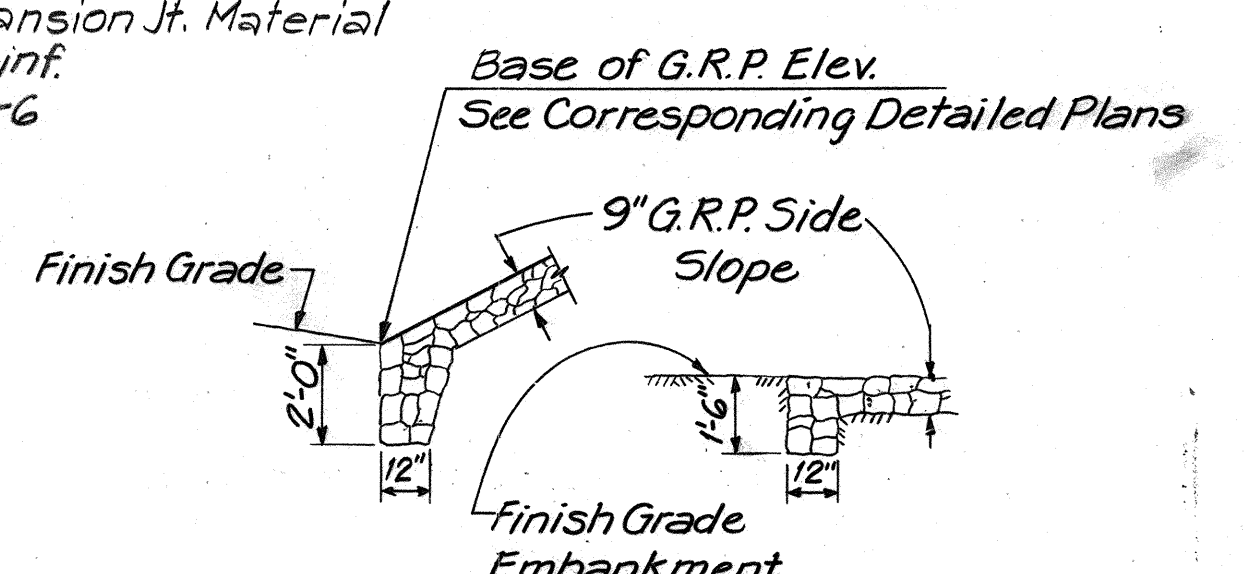


BASE OF PAVING CUT OFF-WALL
TYPICAL G.R.P. DETAILS
SCALE: $\frac{1}{4}$ " = 1'-0"

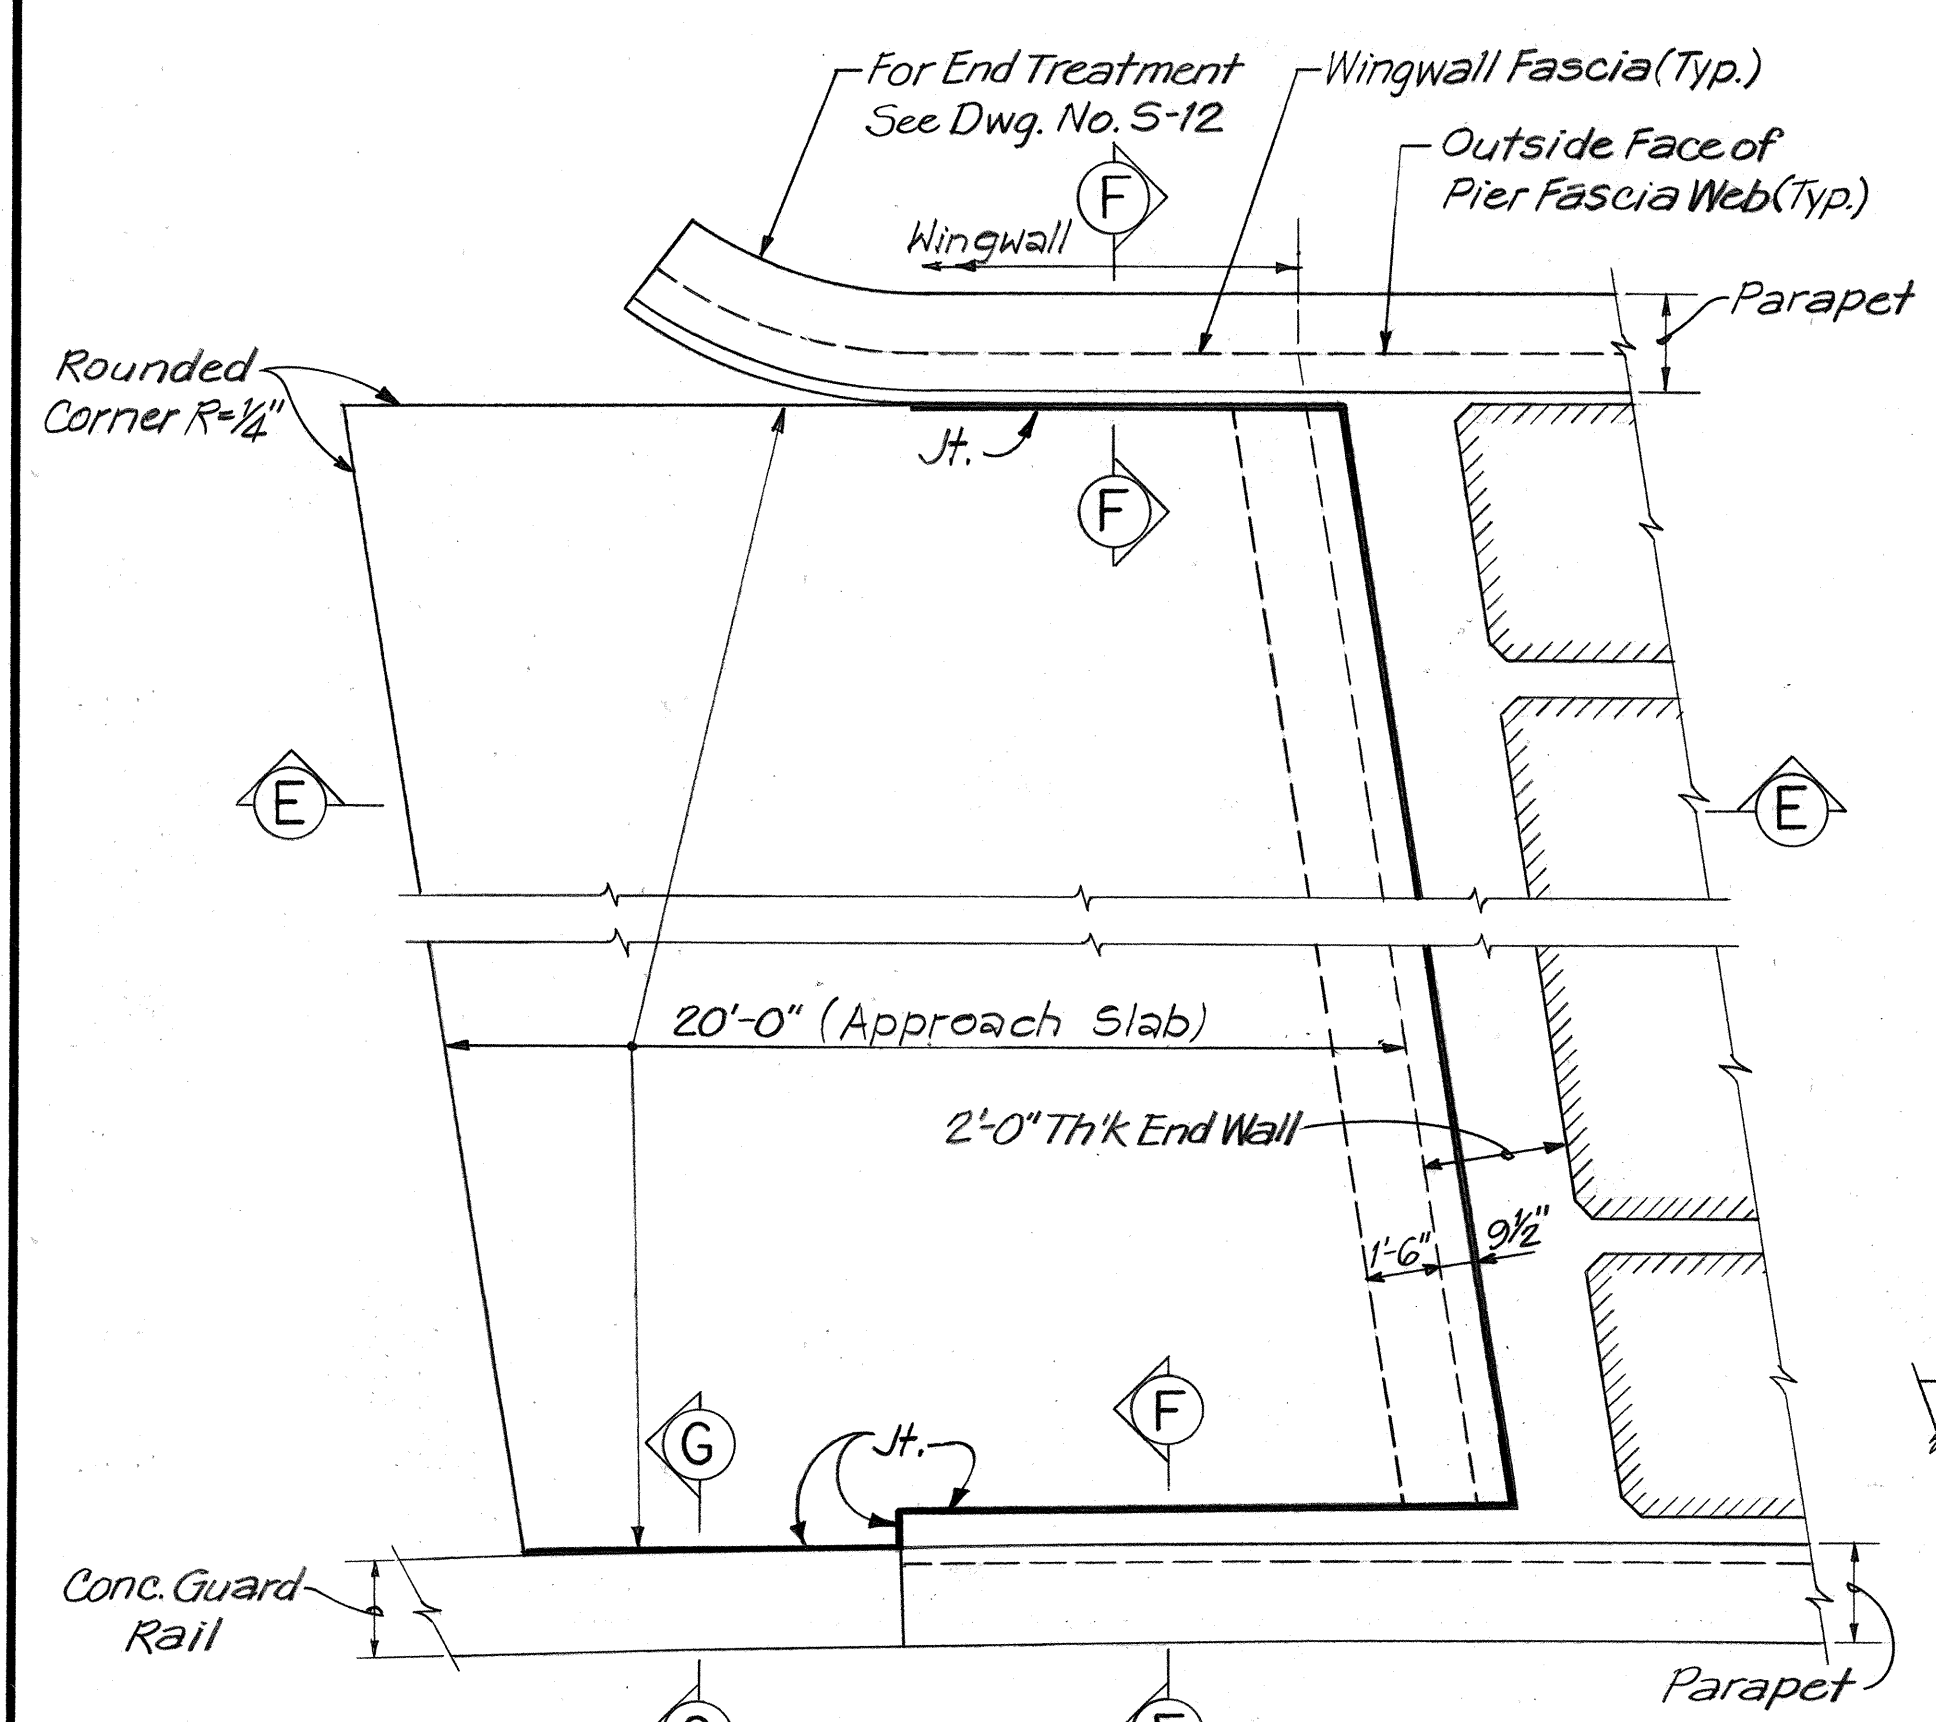


TYPICAL APPROACH SLAB
SCALE: $\frac{1}{4}$ " = 1'-0"

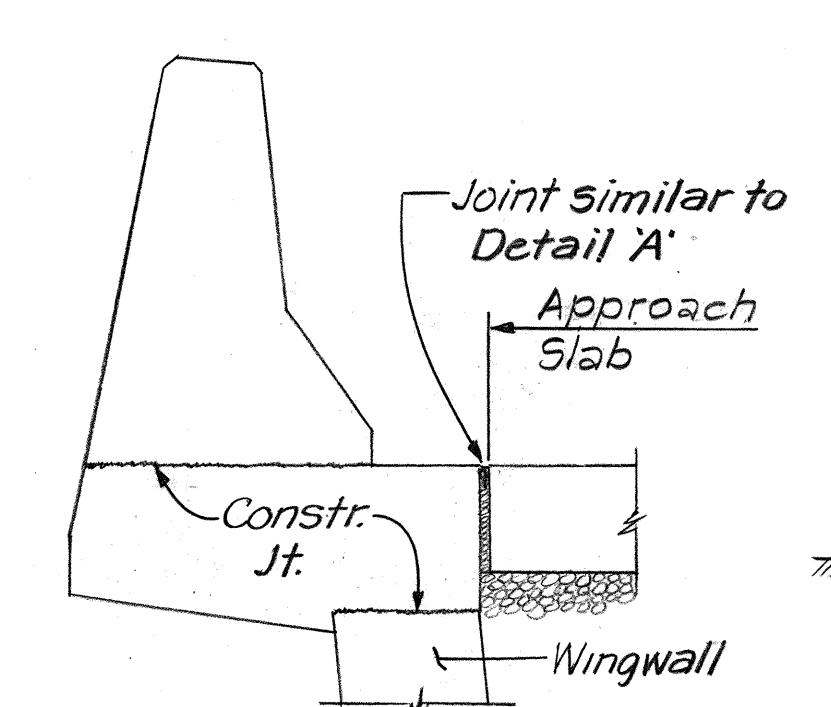


SECTION F-F
SCALE: $\frac{3}{4}$ " = 1'-0"

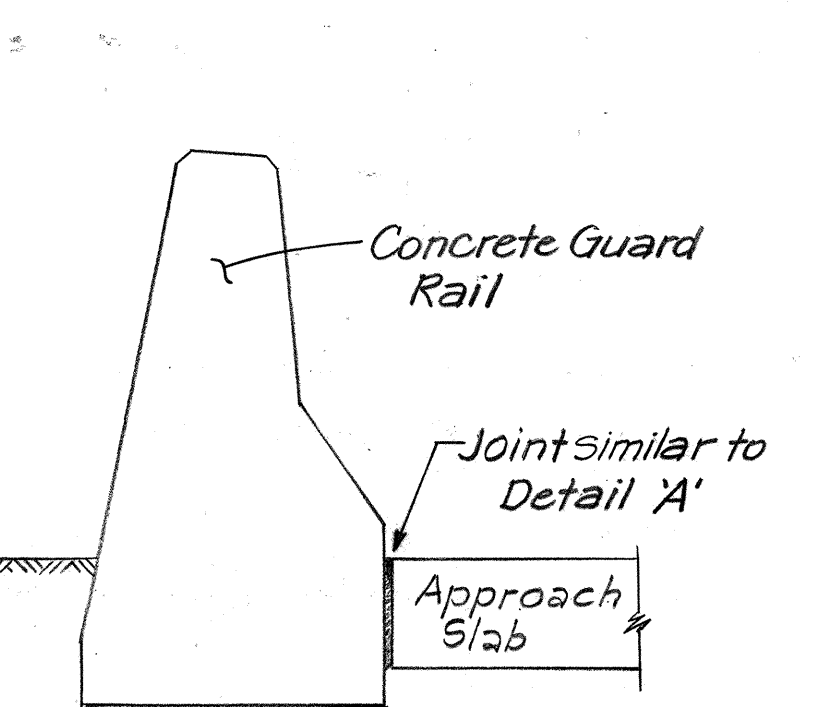


SECTION G-G
SCALE: $\frac{3}{4}$ " = 1'-0"

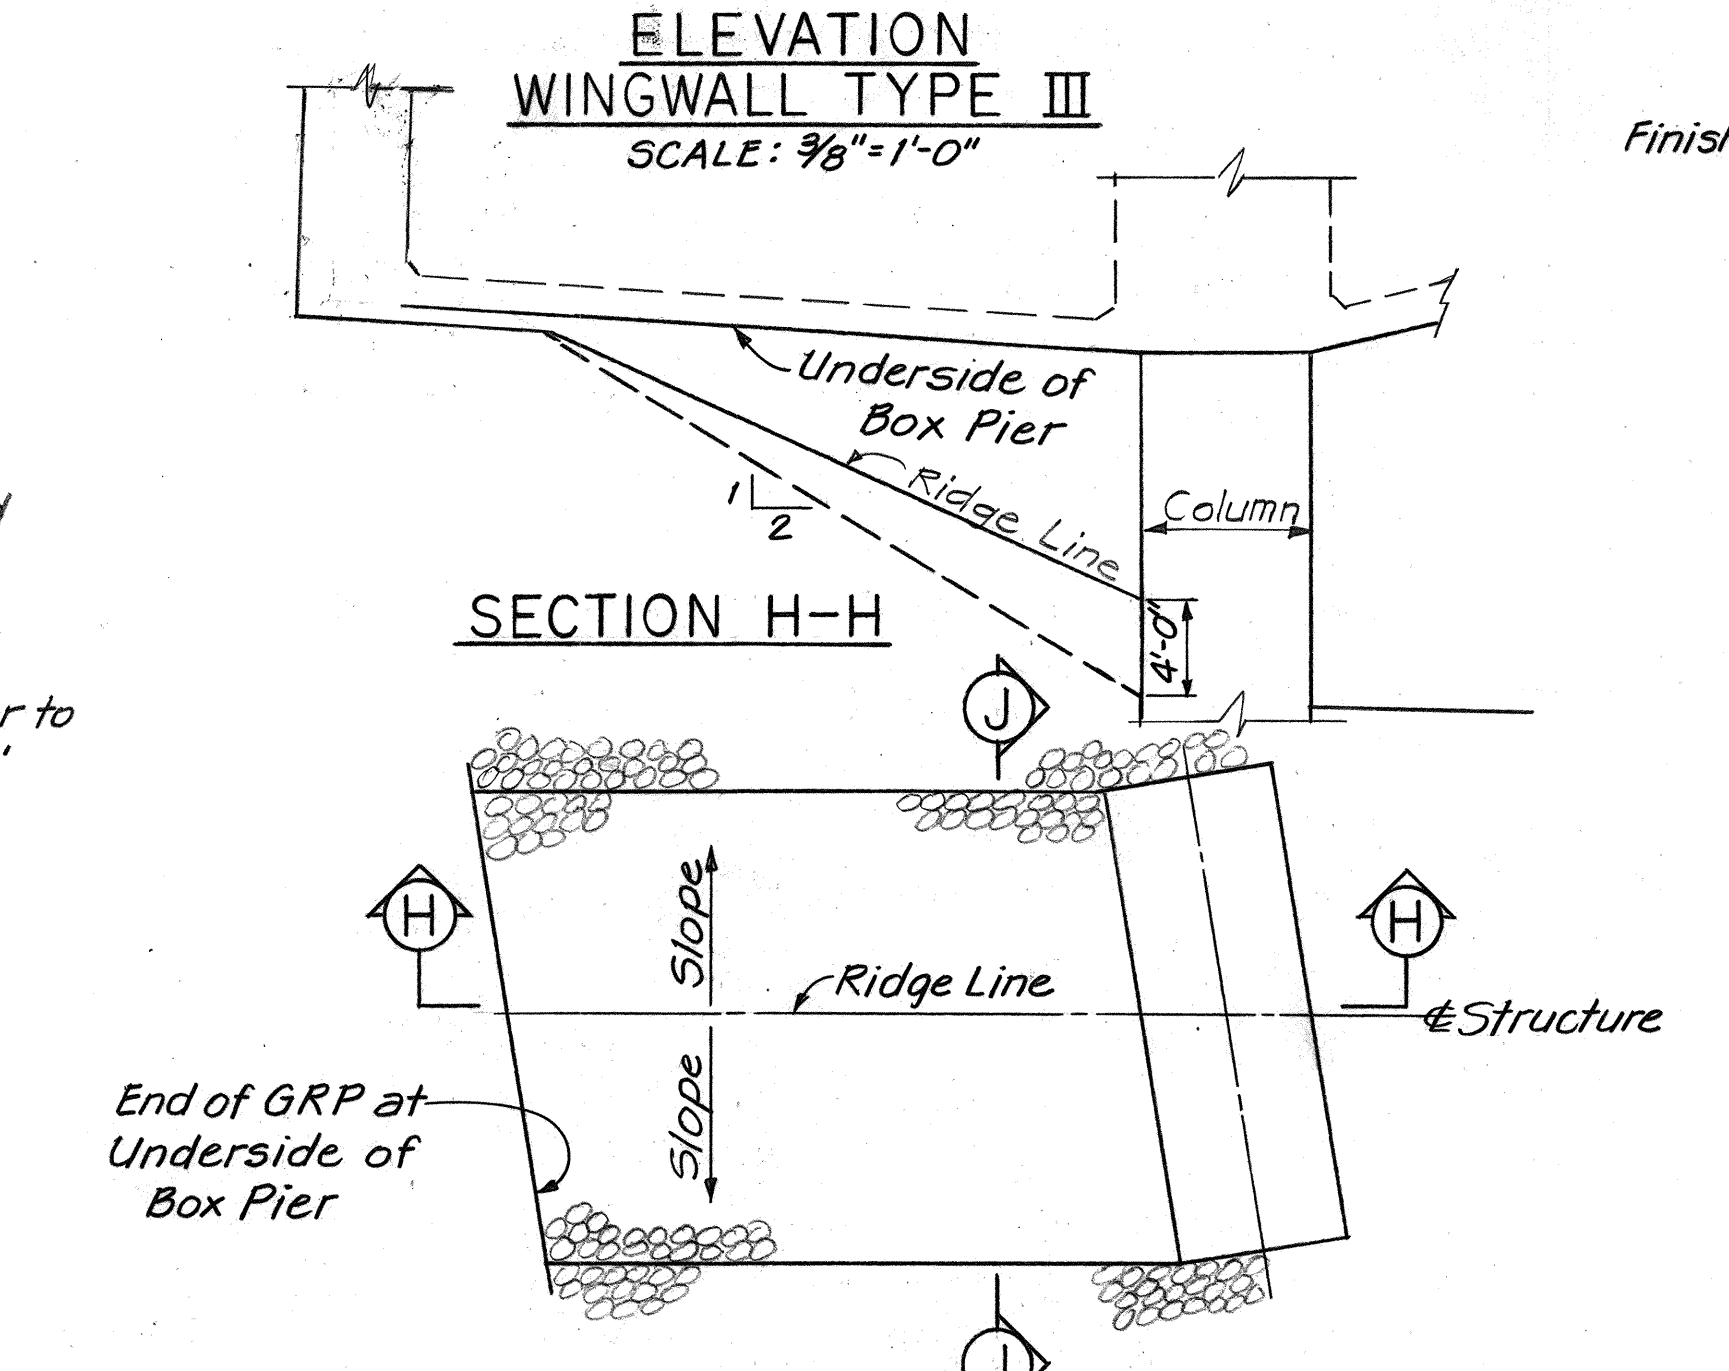


TREATMENT OF G.R.P. AT PIERS
N.T.S.

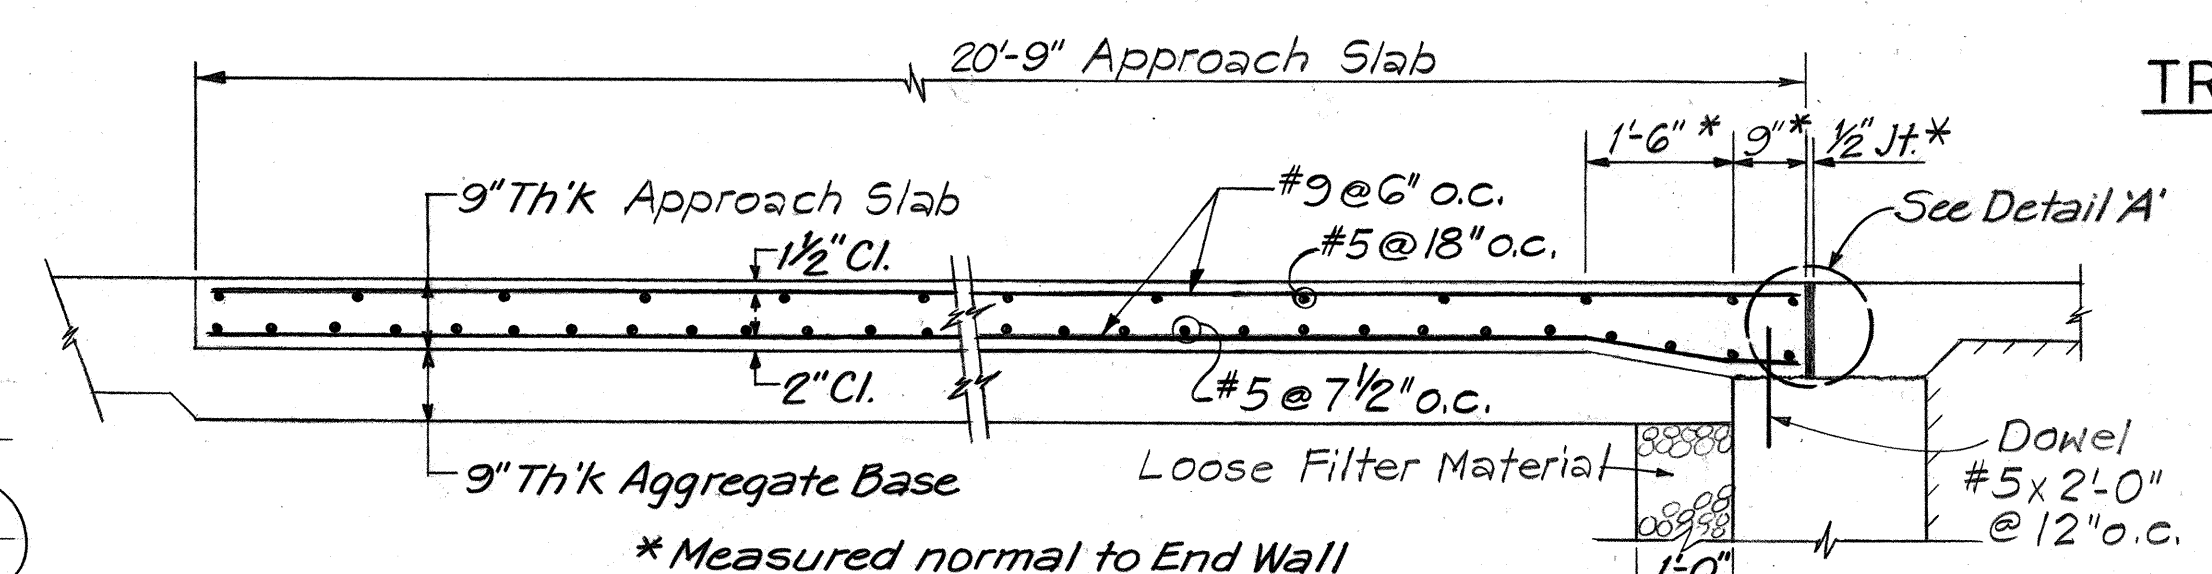


SECTION E-E
SCALE: $\frac{1}{2}$ " = 1'-0"

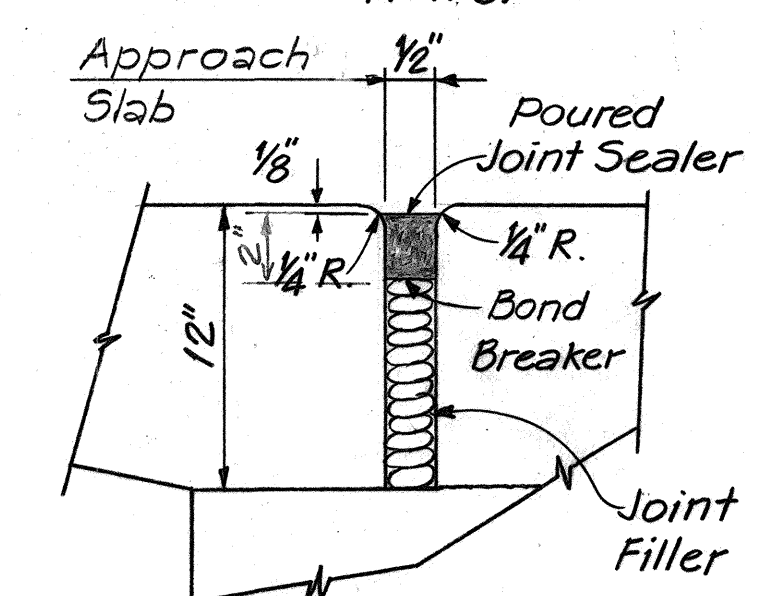

DETAIL A
N.T.S.

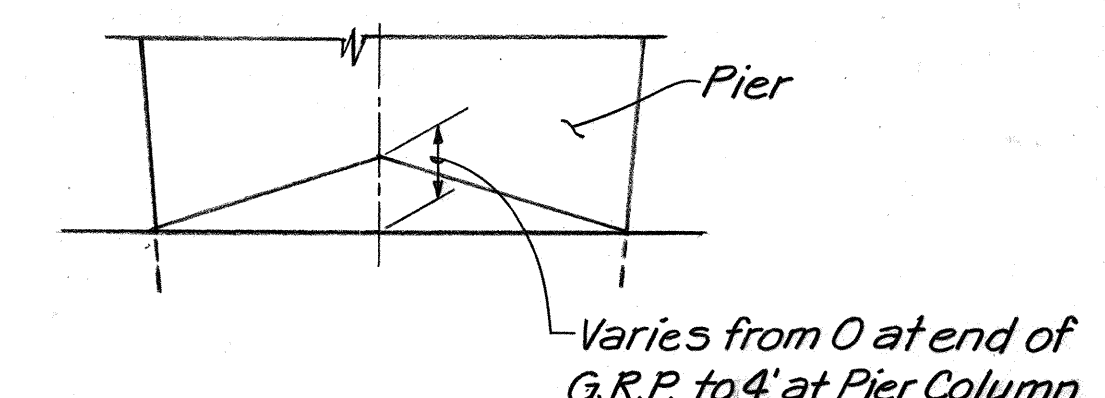

SECTION J-J
N.T.S.

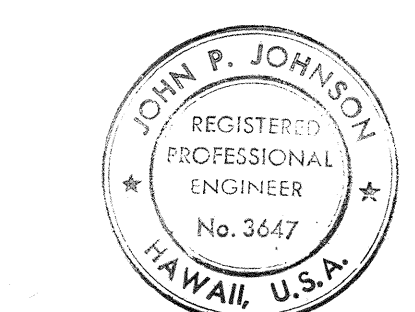

THIS WORK WAS PREPARED BY ME
OR UNDER MY SUPERVISION.
John P. Johnson

STATE OF HAWAII
DEPARTMENT OF TRANSPORTATION
HIGHWAYS DIVISION

MISCELLANEOUS DETAILS


FORT WEAVER ROAD
ROUTE H-1 TO SOUTH OF
FARRINGTON HIGHWAY
PROJECT NO. M-7600(1)

SCALE: AS SHOWN DATE: AUG. 1978
SHEET NO. S8 OF S16 SHEETS

NOTES FOR PRESTRESSED BEAMS:

1. Concrete shall have a minimum ultimate 28 day cylinder strength of 6,000 psi.
2. Prestensioned strands shall be 7 wire $\frac{1}{2}$ " ϕ stress-relieved steel strands (area = 0.153 in²) with an ultimate strength of 270 ksi. For properties see State Standard Specifications.
Initial strand stress (before any losses): 200 ksi.; Initial loss = 20,000 psi.
Total loss due to creep, shrinkage, elastic shortening and relaxation of steel = 45,000 psi.
Minimum Ultimate Concrete Strength before release of strands f_{ci} = 4,500 psi.
3. Non-prestressed reinforcing steel shall be Grade 40 unless otherwise noted.
4. The calculated camber includes the effect of the initial prestress force and the weight of the beam after removal from bed. Negative values shown for calculated camber indicate a net upward deflection. Calculated camber values shown do not account for any camber growth of the beam. The actual camber shall not exceed the calculated camber shown on the plans by more than 100%.
5. The dead load deflection includes the combined effects of the weight of slab, haunch and diaphragm.
6. Strand pattern shall be symmetrical about the longitudinal $\pm$ of the beam.
7. Strand release sequence shall not induce any lateral deflection of the beam.
8. Contractor shall submit his proposed strand pattern and releasing sequence to the Engineer for approval.
9. During curing care shall be taken to avoid any lateral deflection of the beam due to improper orientation.
10. Lifting devices shall be placed as close as possible to the center line of bearings of the beam. Details and locations of lifting devices shall be submitted to the Engineer for approval. Such approval does not relieve the Contractor of his responsibilities if beam is damaged due to failure of the lifting device.
11. In lieu of the 7 wire $\frac{1}{2}$ " dia. stress-relieved steel strands (area 0.153 in²) with an ultimate strength of 270 ksi, the Contractor at his option may use 7 wire 0.6" dia. stress-relieved steel strands (area 0.217 in²) with an ultimate strength of 270 ksi. For properties of 0.6" dia. strand see special provisions. However the final prestress force and its center of gravity, as stated, shall not be revised.
12. End block is required for both pretensioned or post-tensioned beams.

- a. The ultimate 28-day cylinder strength of concrete shall be a minimum of 6,000 psi.
- b. Post-tensioning steel shall consist of either 1/2" Φ , 270 ksi S/R multistrand tendons or high strength alloy steel bars. Sheathing shall be galvanized rigid duct (coef. of friction $\mu = 0.25$ and wobble coef. $K = 0.0002$) for strands and galvanized metal sheathing ($\mu = 0.15$ and $k = 0.0002$) for bars. Friction losses shall be verified by friction test as per State Standard Specs.
- c. Loss due to creep, shrinkage, elastic shortening and relaxation of steel to be assumed = 35,000 psi.
- d. Contractor shall submit the post-tensioned beam design including elongation, jacking and deflection computation to Engineer for approval. Estimate of losses (apart from that listed above) peculiar to post-tensioning shall be part of the calculations.
- e. Contractor shall submit the tendon pattern and profile, sequence of stressing and anchorage details to Engineer for approval. Tendons location and post-tensioning shall be symmetrical about the longitudinal Φ of the beam.
- f. Pretensioning notes 3, 9 and 10 also apply to post-tensioning.

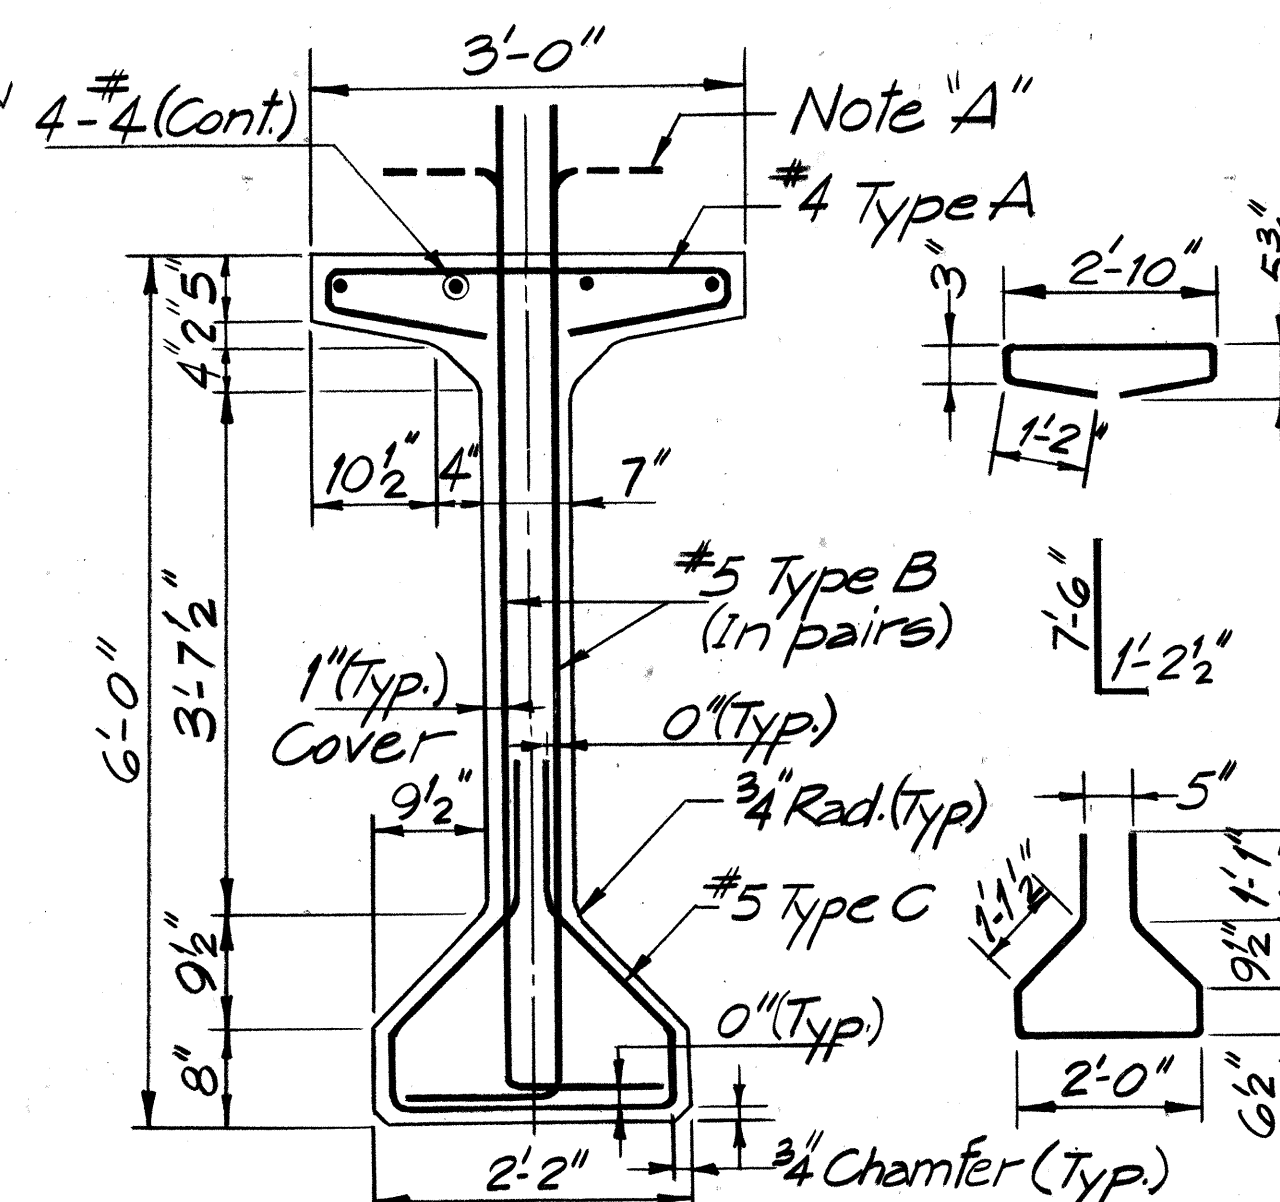

SECTION A-A

Scale: 1/8" = 1'-0"

The drawing shows a cross-section of a concrete wall and floor assembly. The wall has a total height of 3'-0". At the base, there are two types of footing: one with a 2' x 2' square section and another with a 2' x 2' rectangular section. Reinforcement bars (#8) extend from the footings up through the wall. The top of the wall is finished with a 2' x 8" slab. The drawing includes various dimensions and labels for materials and construction details.


Item	Description / Dimension
Top of Beam	3'-0"
Reinforcing Bar	#8
Diaphragm	2' x 2'
Footing	2' x 2'
Slab	2' x 8"
Chamber	3' x 4'
Clearance	1' Clear (Typ)
Reinforcing Bar	#6
Reinforcing Bar	#5
Reinforcing Bar	#3
Reinforcing Bar	#2
Reinforcing Bar	#1
Reinforcing Bar	#4
Reinforcing Bar	#7
Reinforcing Bar	#9
Reinforcing Bar	#10
Reinforcing Bar	#11
Reinforcing Bar	#100

SECTION A-A
Scale: 1/2" = 1'-0"

[illegible]

END DIAPHRAGM
(TYPICAL)
Scale: 1/2" = 1'-0"


SECTION BE

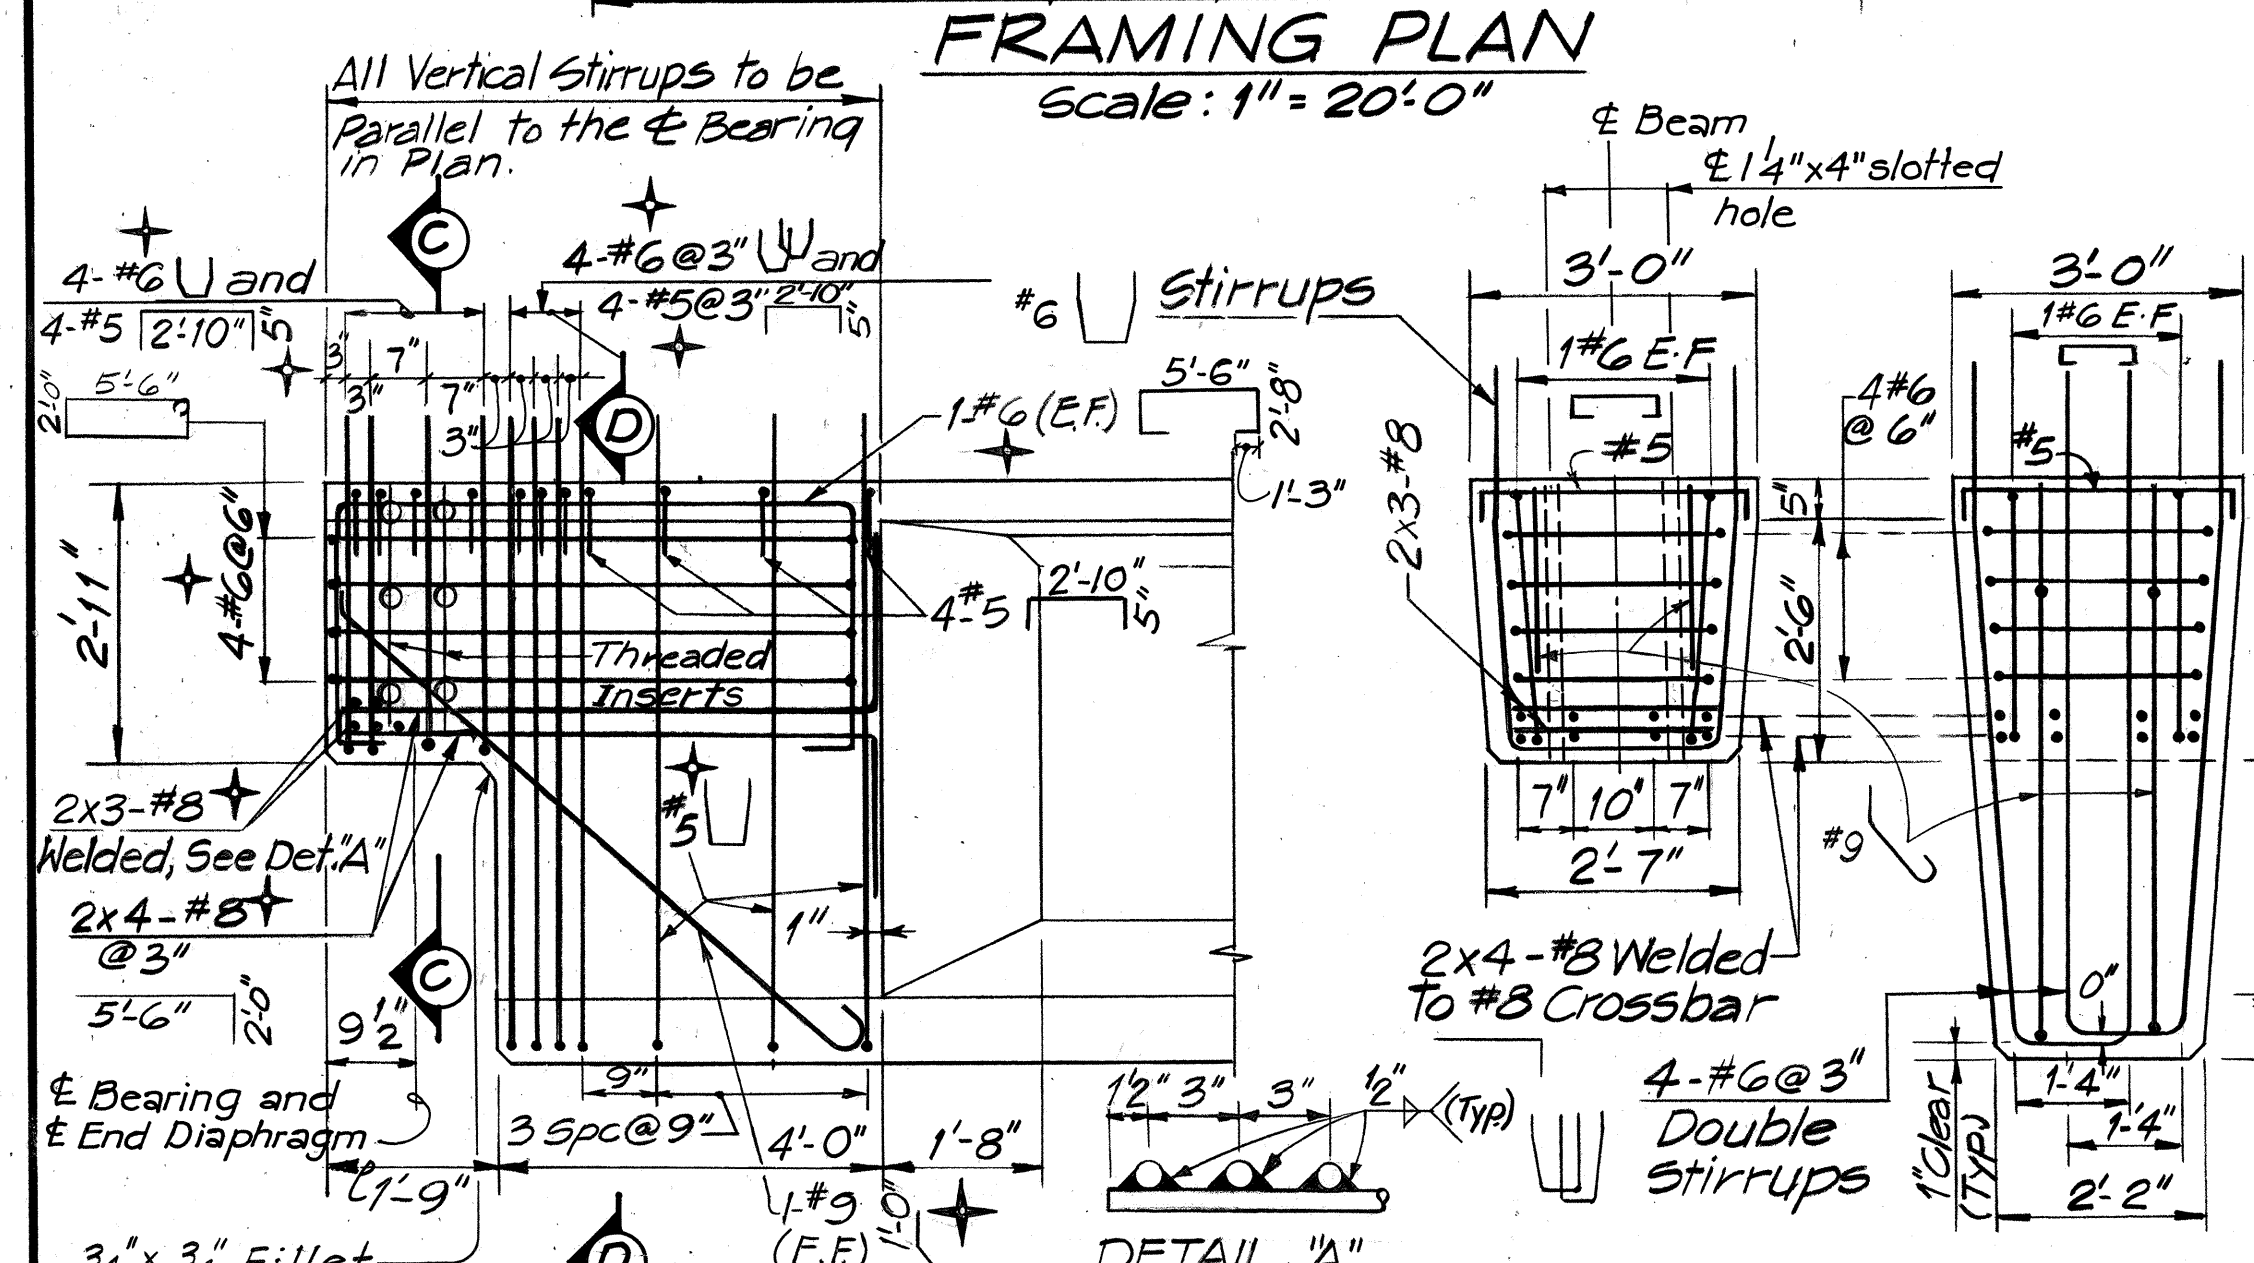


BEAM DAPPED END DETAIL
Scale: 1/2" = 1'-0"

SECTION C-C SECTION D-D


✦ = Grade 60 Reinforcing

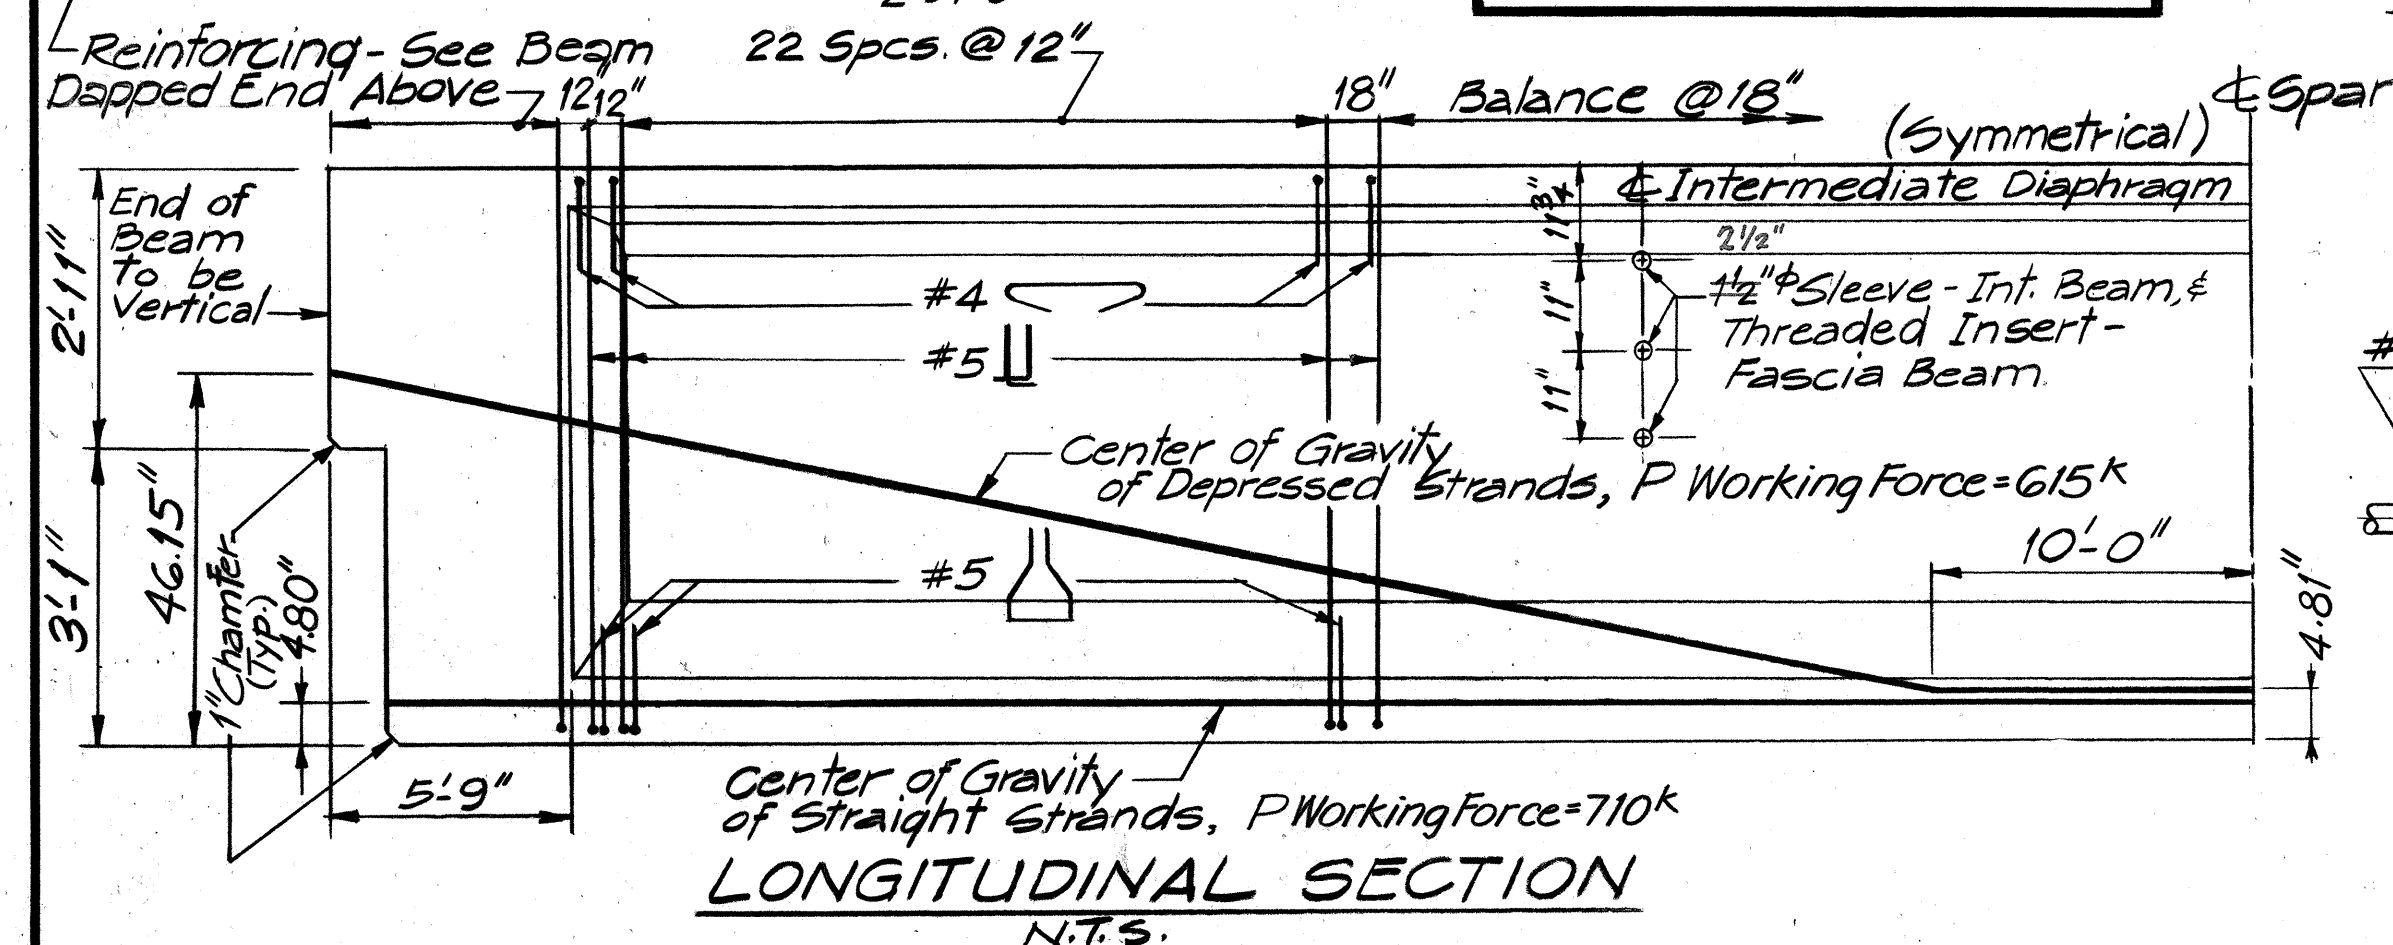


LONGITUDINAL SECTION
N.T.S.

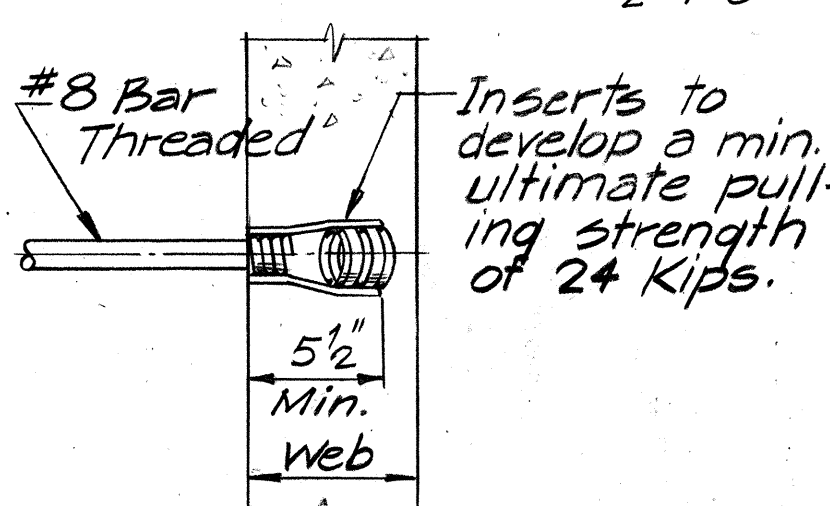

INSERT DETAIL
Scale: 1" = 1'-0"

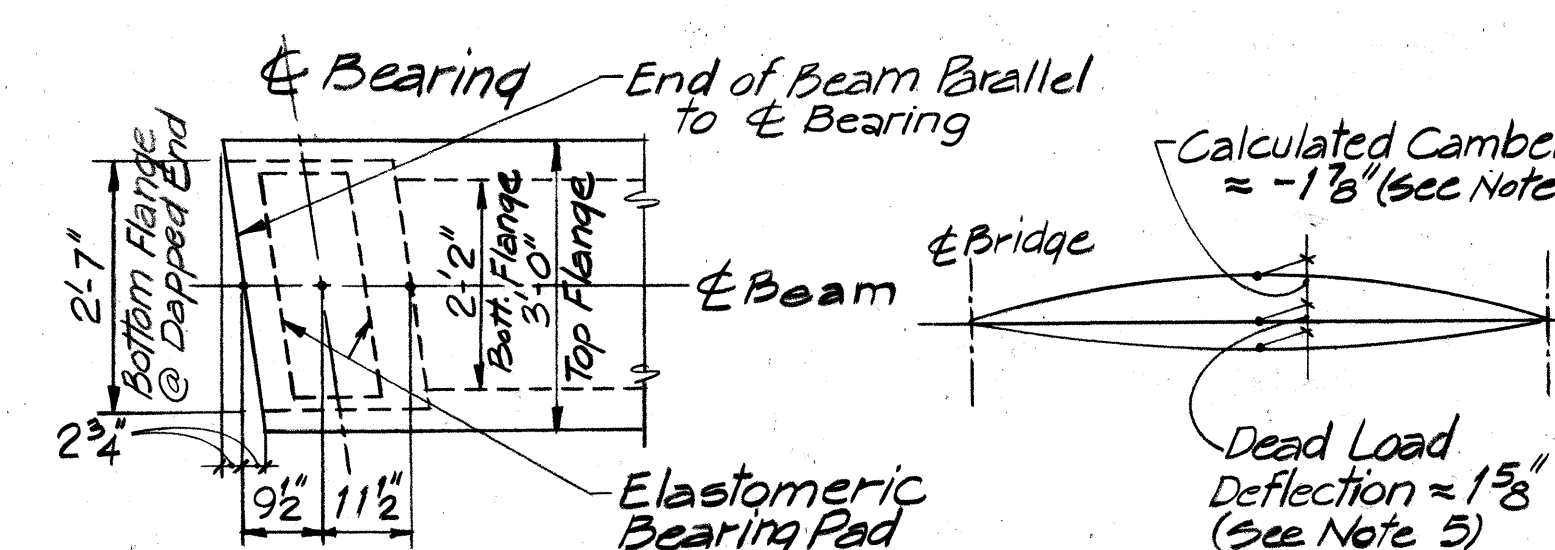

TYPICAL PLAN AT END OF BEAM
Scale: $\frac{1}{2}'' = 1'-0''$

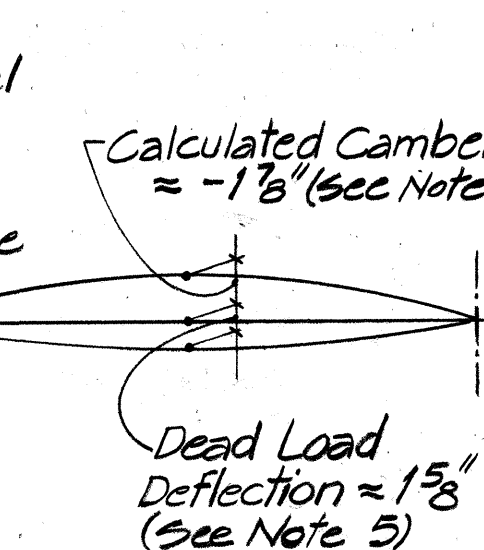

CAMBER DIAGRAM
N.T.S.



THIS WORK WAS PREPARED BY ME
OR UNDER MY SUPERVISION,
John B. Johnson




STATE OF HAWAII
DEPARTMENT OF TRANSPORTATION
HIGHWAYS DIVISION

PRESTRESSED BEAM DETAILS


FORT WEAVER ROAD
ROUTE H-1 TO SOUTH OF
FARRINGTON HIGHWAY
PROJECT NO. M-7600(1)

SCALE: AS SHOWN DATE: *AUG. 1978*
SHEET No S-9 OF S-16 SHEETS

FED. ROAD DIST. NO.	STATE	FED. AID PROJ. NO.	FISCAL YEAR	SHEET NO.	TOTAL SHEETS
HAWAII	HAW.	M-7600(1)	1978	141	198

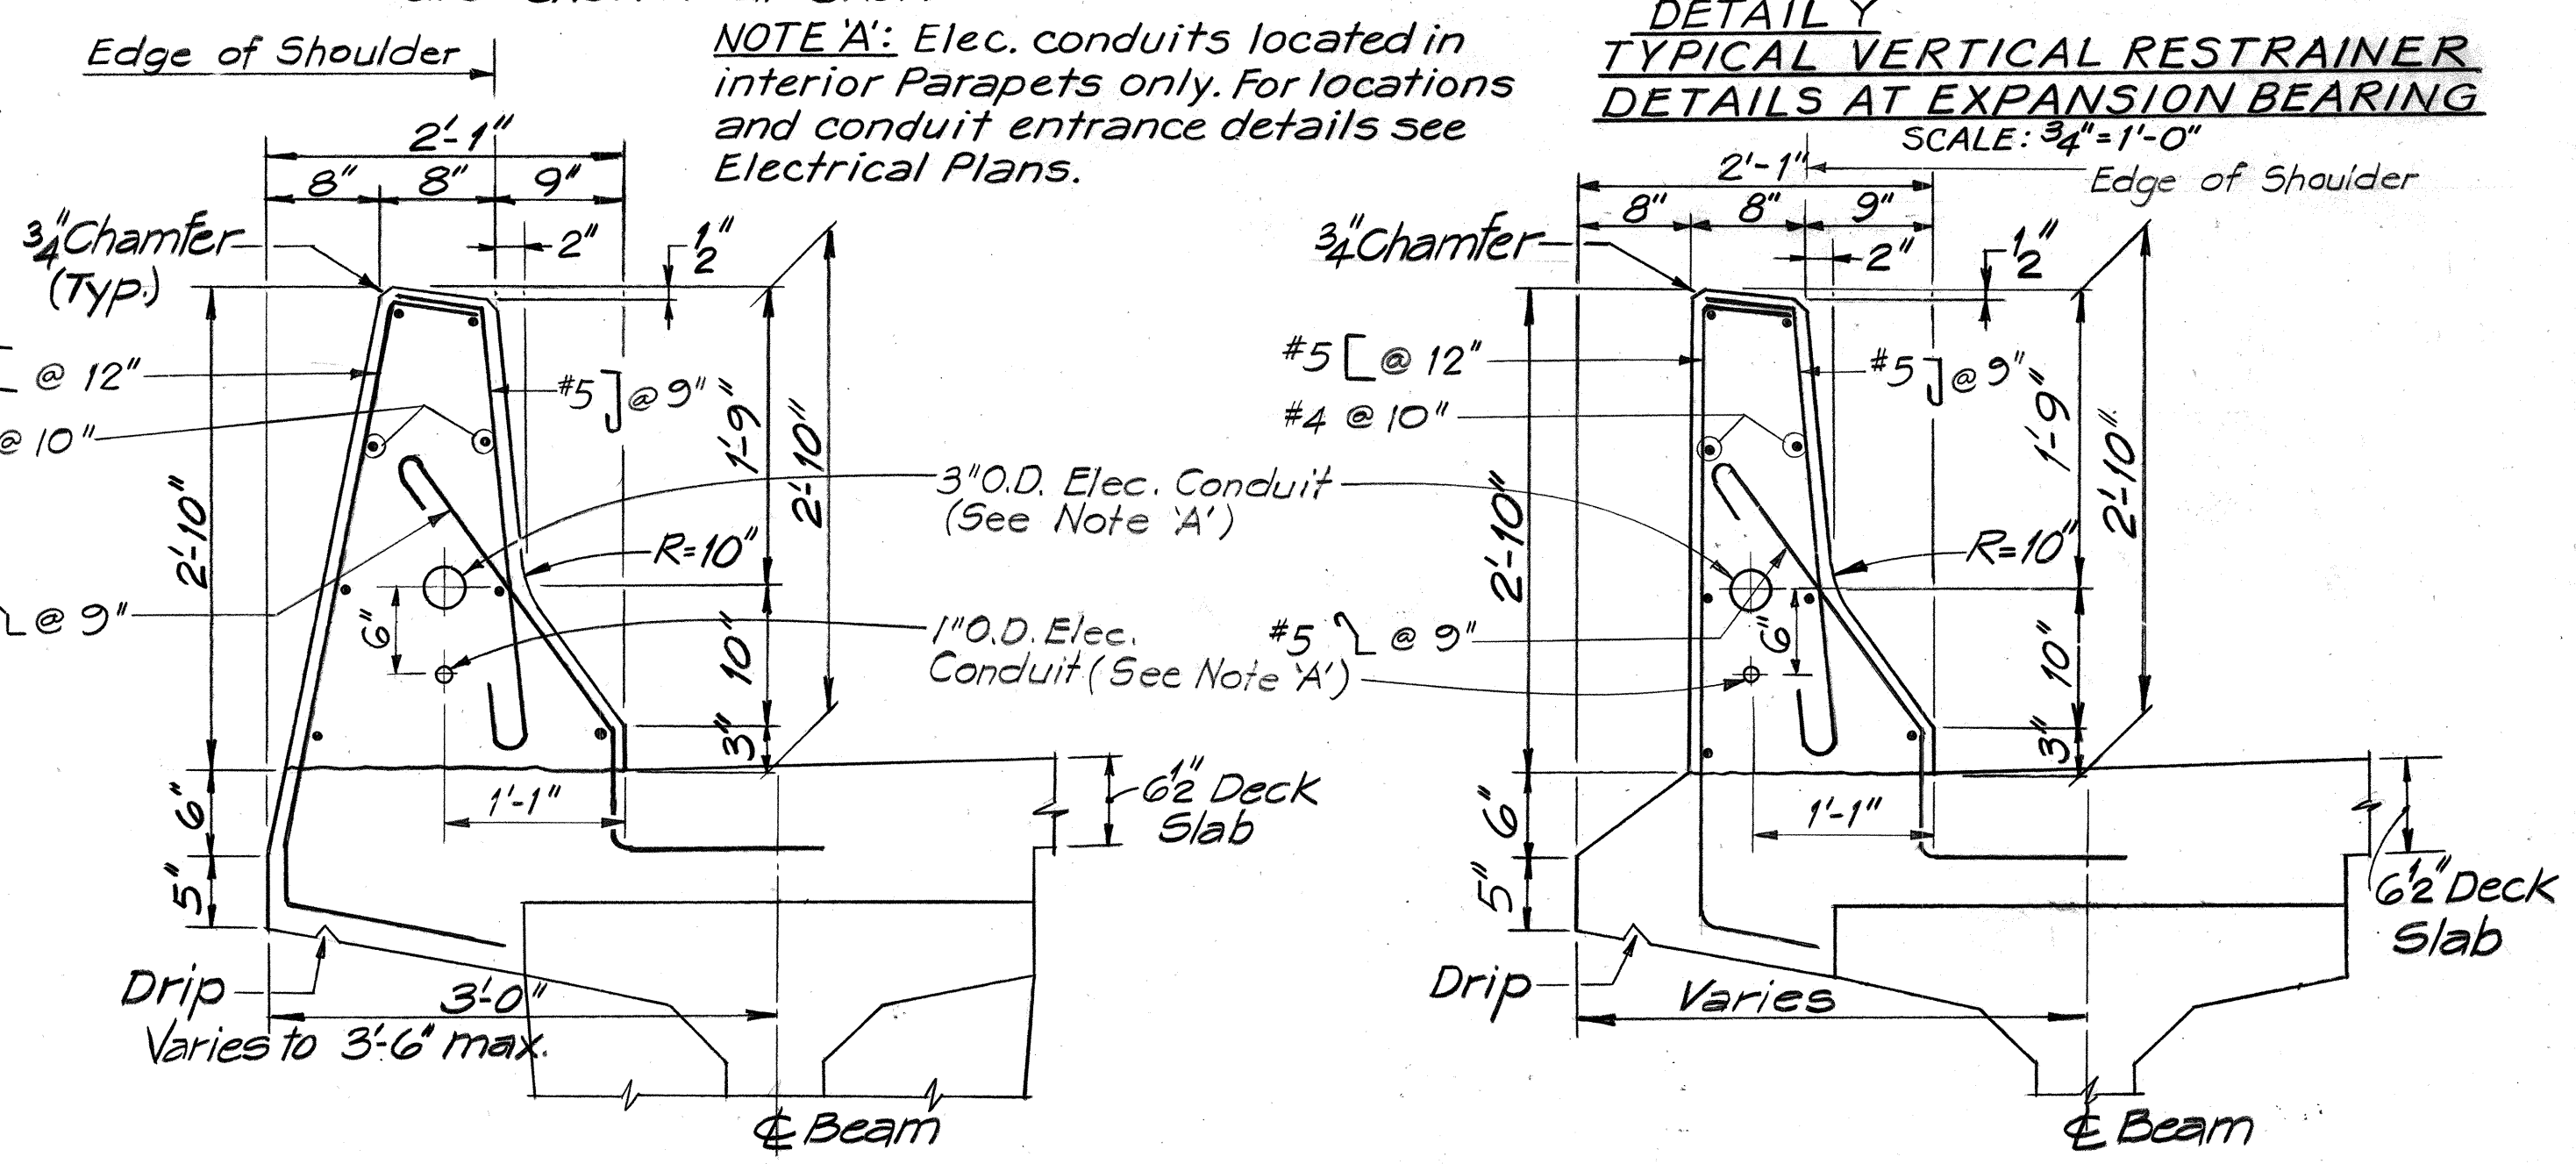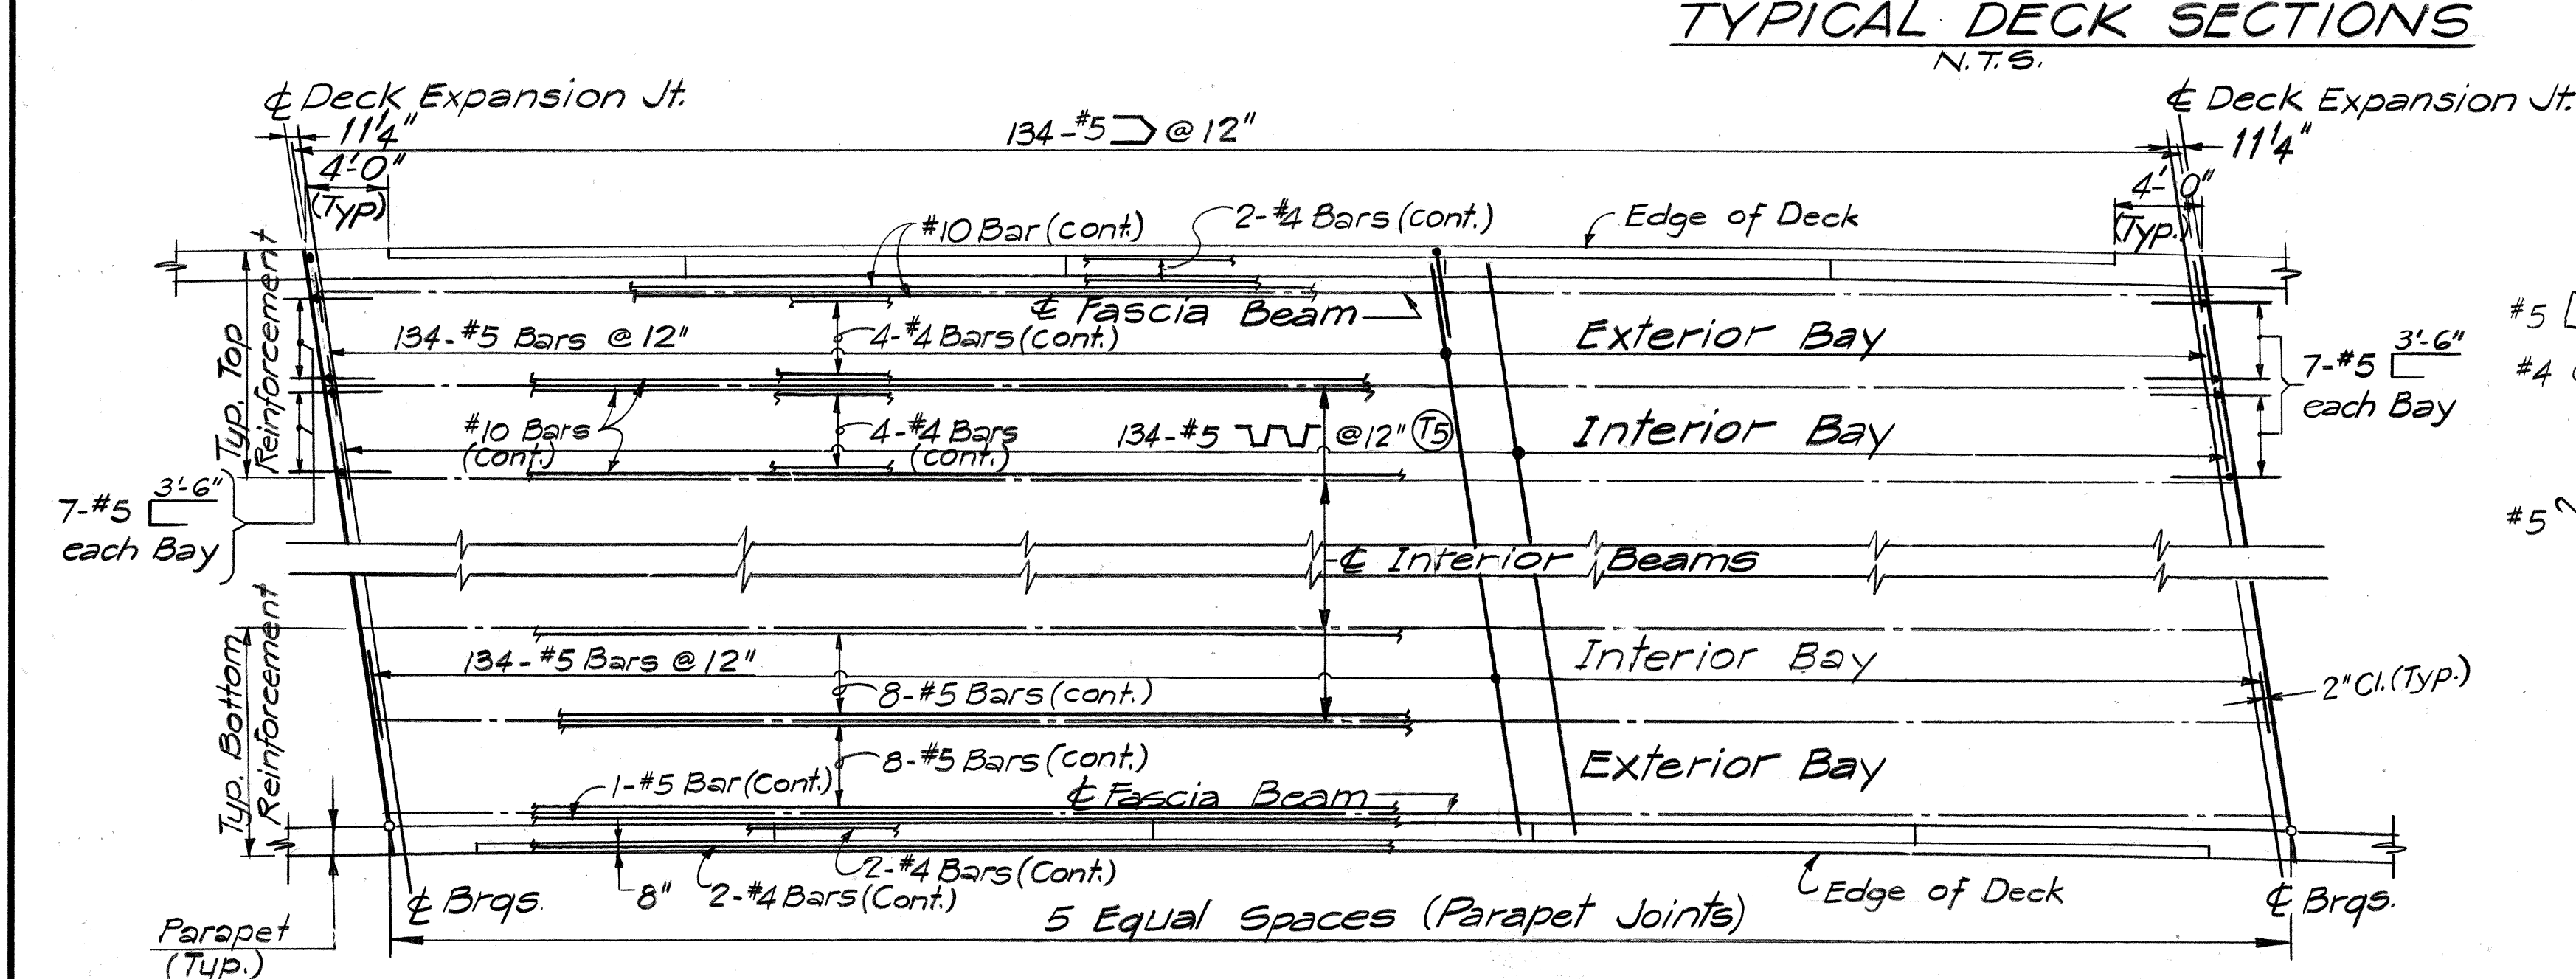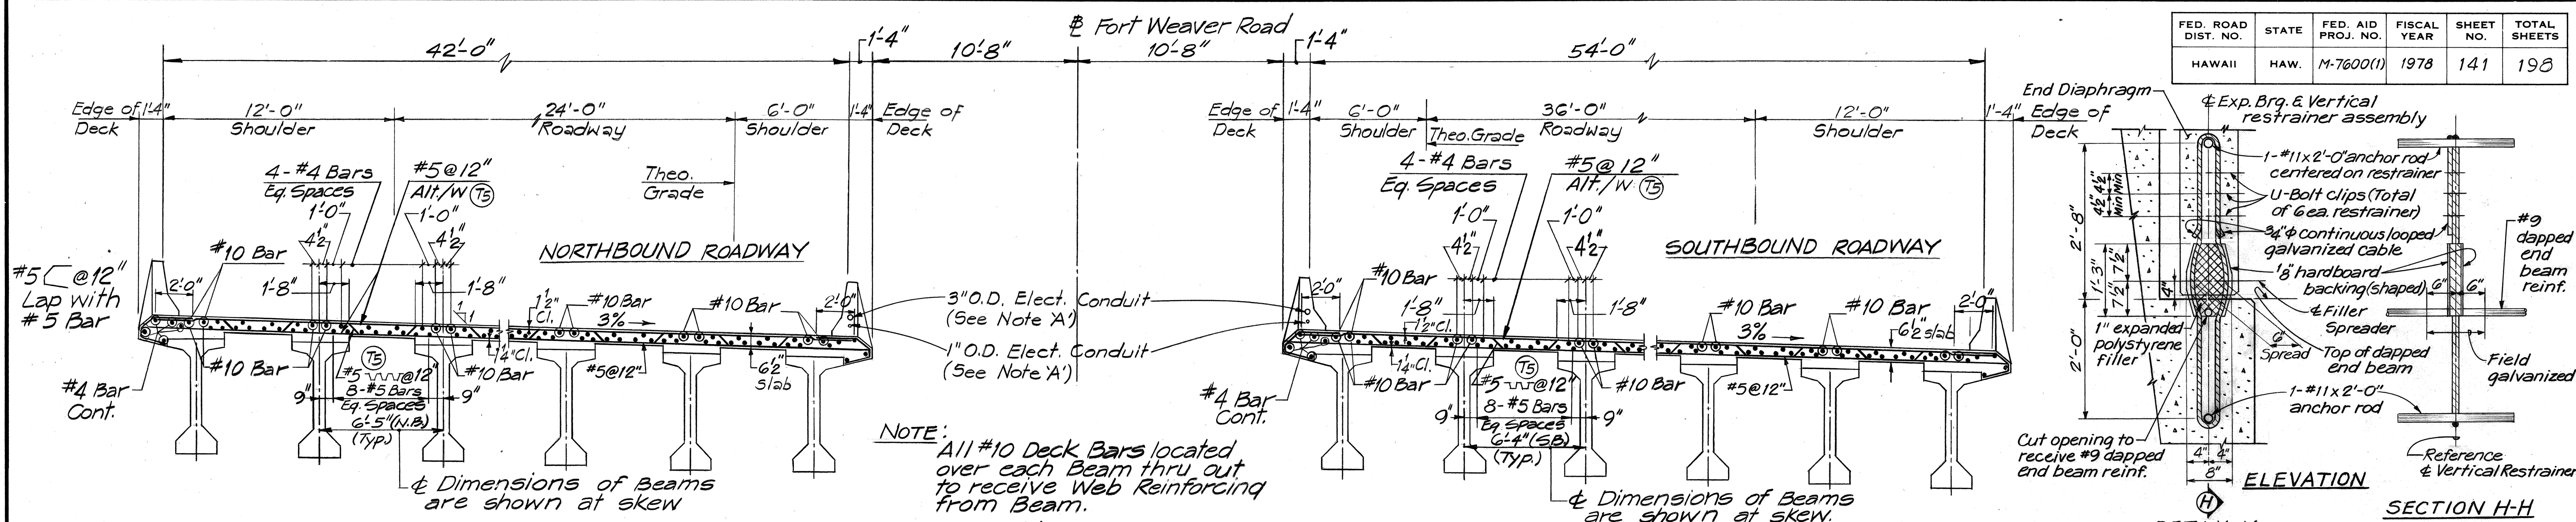

- NOTES:**
1. Restrainer assemblage incidental to concrete & will not be paid for separately.
 2. Restrainer assemblage shall be securely held in place while placing concrete.
 3. Concrete in suspended deck slab (excluding diaphragms and parapets) shall be Class BD.

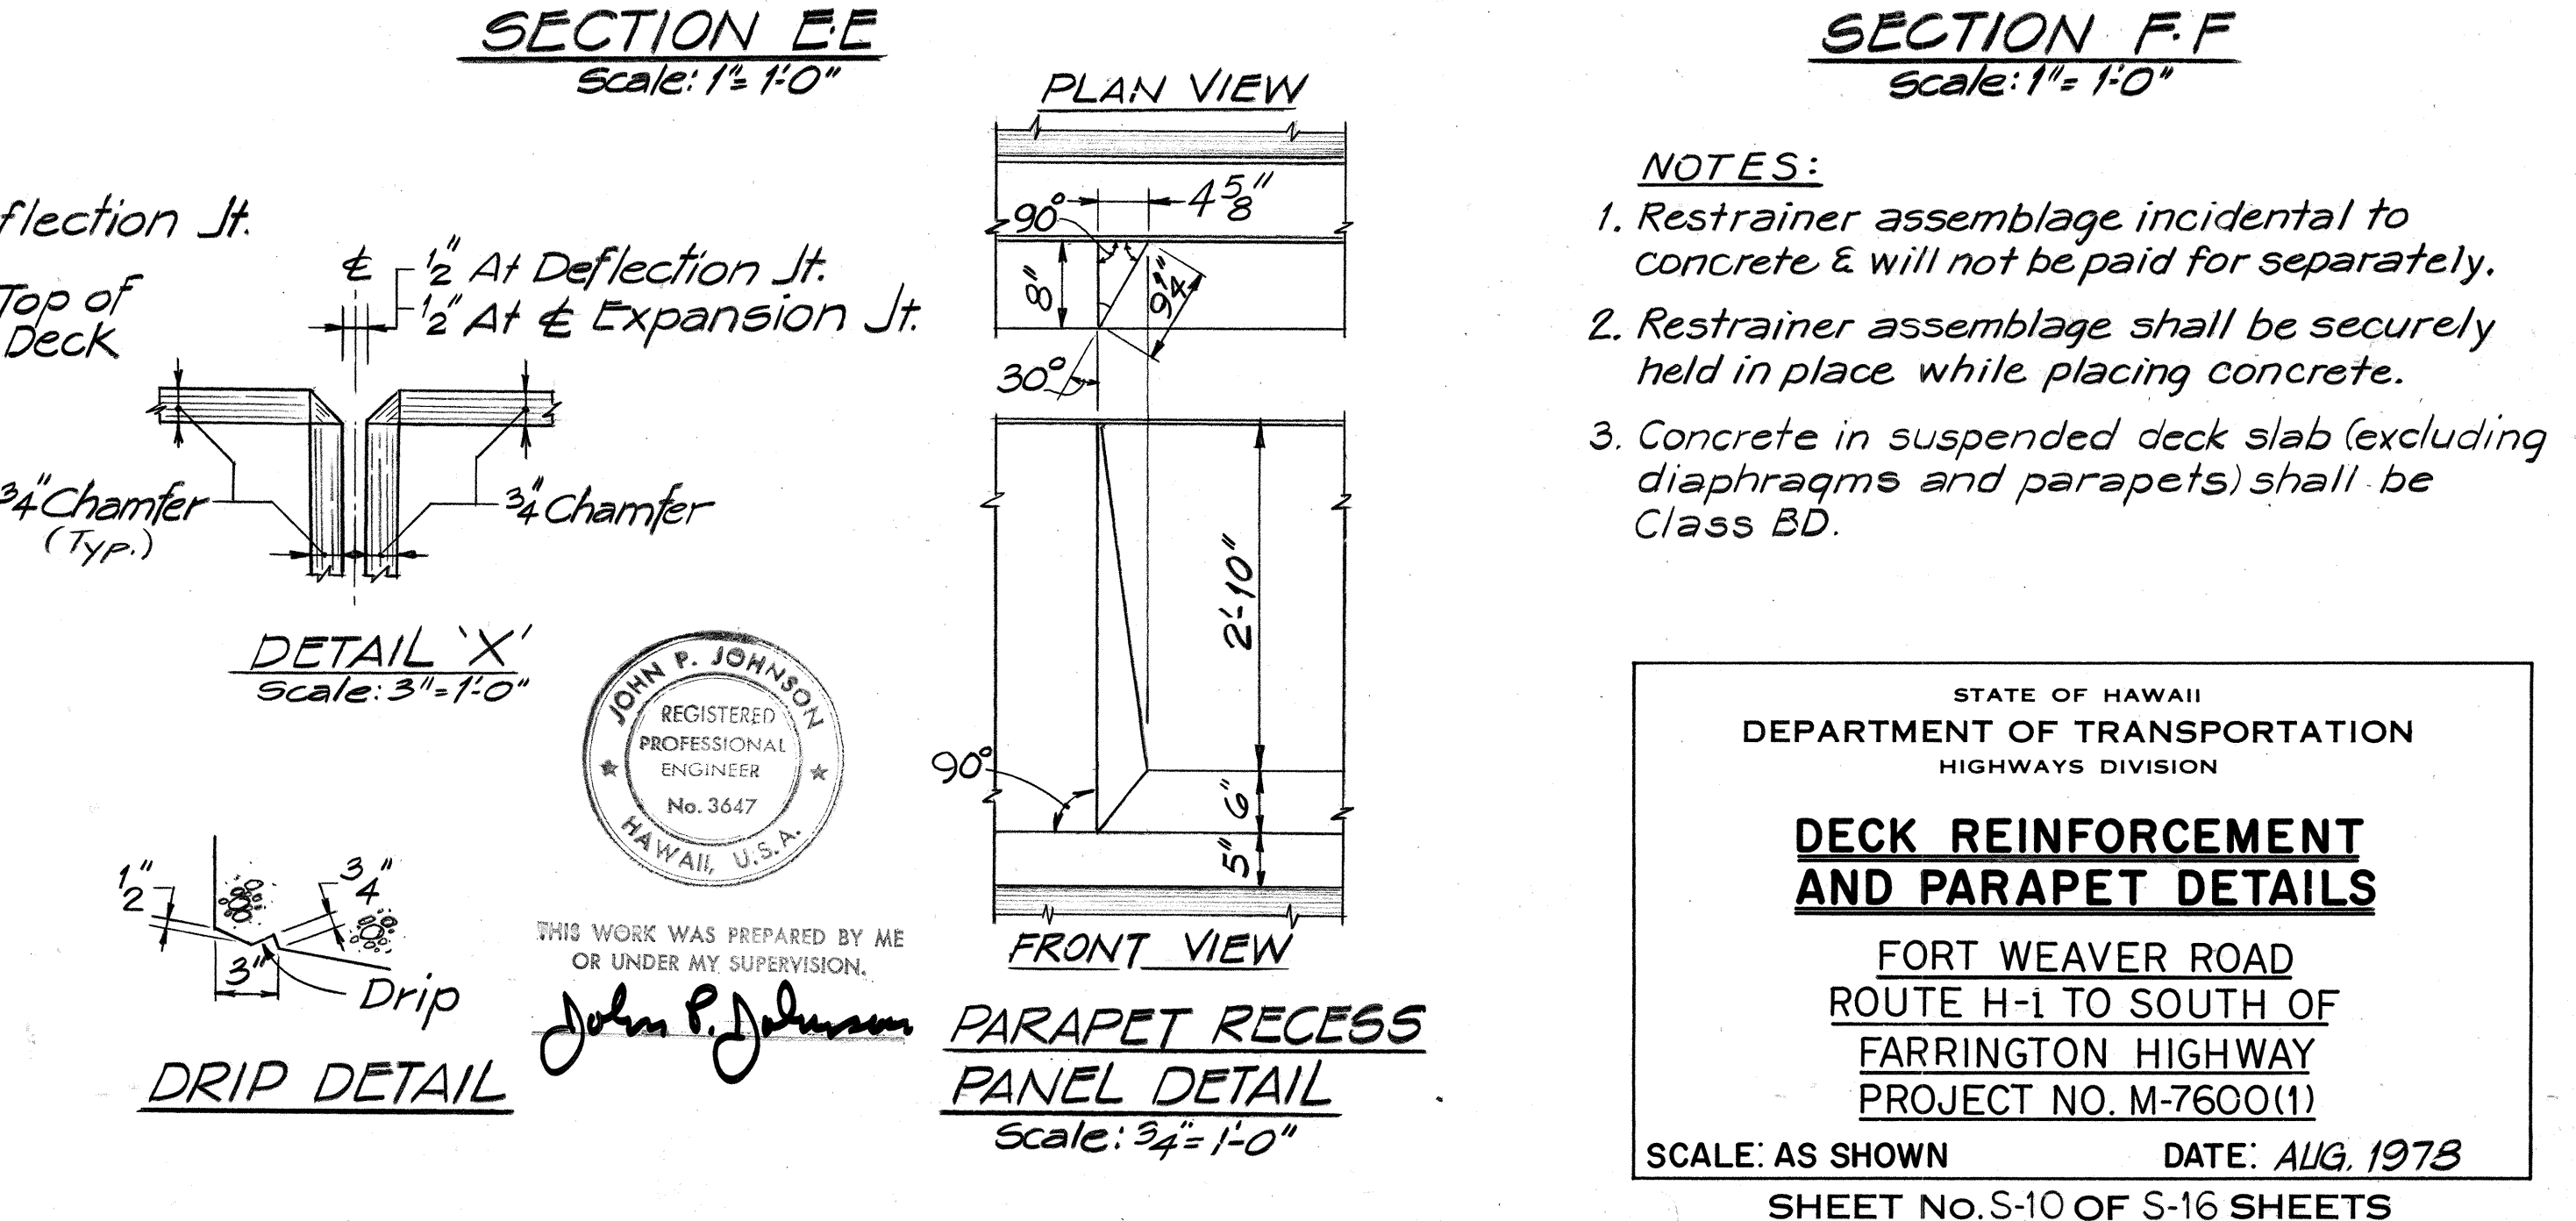


STATE OF HAWAII
DEPARTMENT OF TRANSPORTATION
HIGHWAYS DIVISION

DECK REINFORCEMENT AND PARAPET DETAILS

FORT WEAVER ROAD
ROUTE H-1 TO SOUTH OF
FARRINGTON HIGHWAY
PROJECT NO. M-7600(1)


SCALE: AS SHOWN DATE: AUG. 1978
SHEET No. S-10 OF S-16 SHEETS

DATE: _____
SURVEY PLOTTED BY: _____
DRAWN BY: _____
CHECKED BY: _____
ORIGINAL PLAN: _____
NOTE BOOK: _____
NO. _____

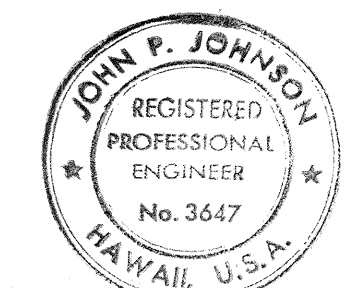


THIS WORK WAS PREPARED BY ME
OR UNDER MY SUPERVISION,
John P. Johnson


FED. ROAD DIST. NO.	STATE	FED. AID PROJ. NO.	FISCAL YEAR	SHEET NO.	TOTAL SHEETS
HAWAII	HAW.	M-7600(1)	1978	142	198

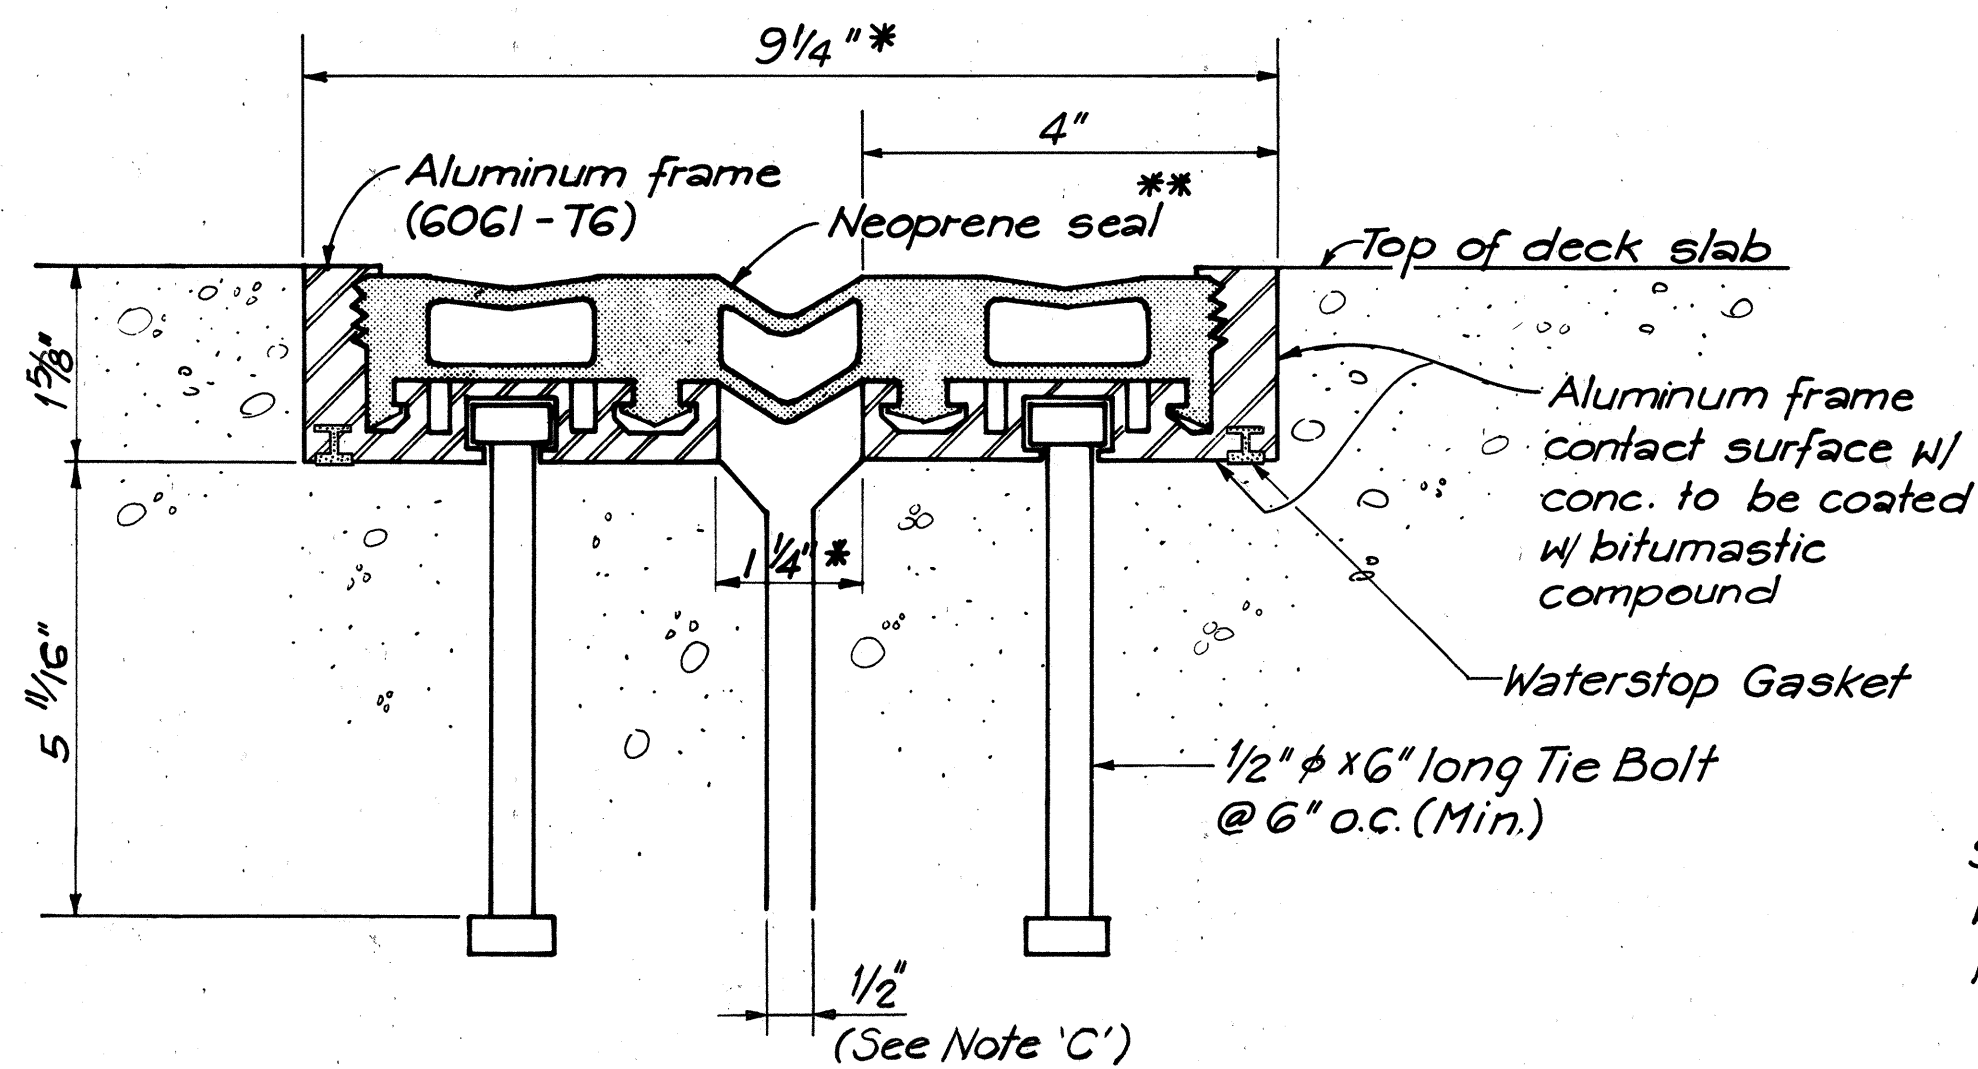

DELASTIFLEX TYPE SM200
(Manufacturer : D.S. Brown & Co.)

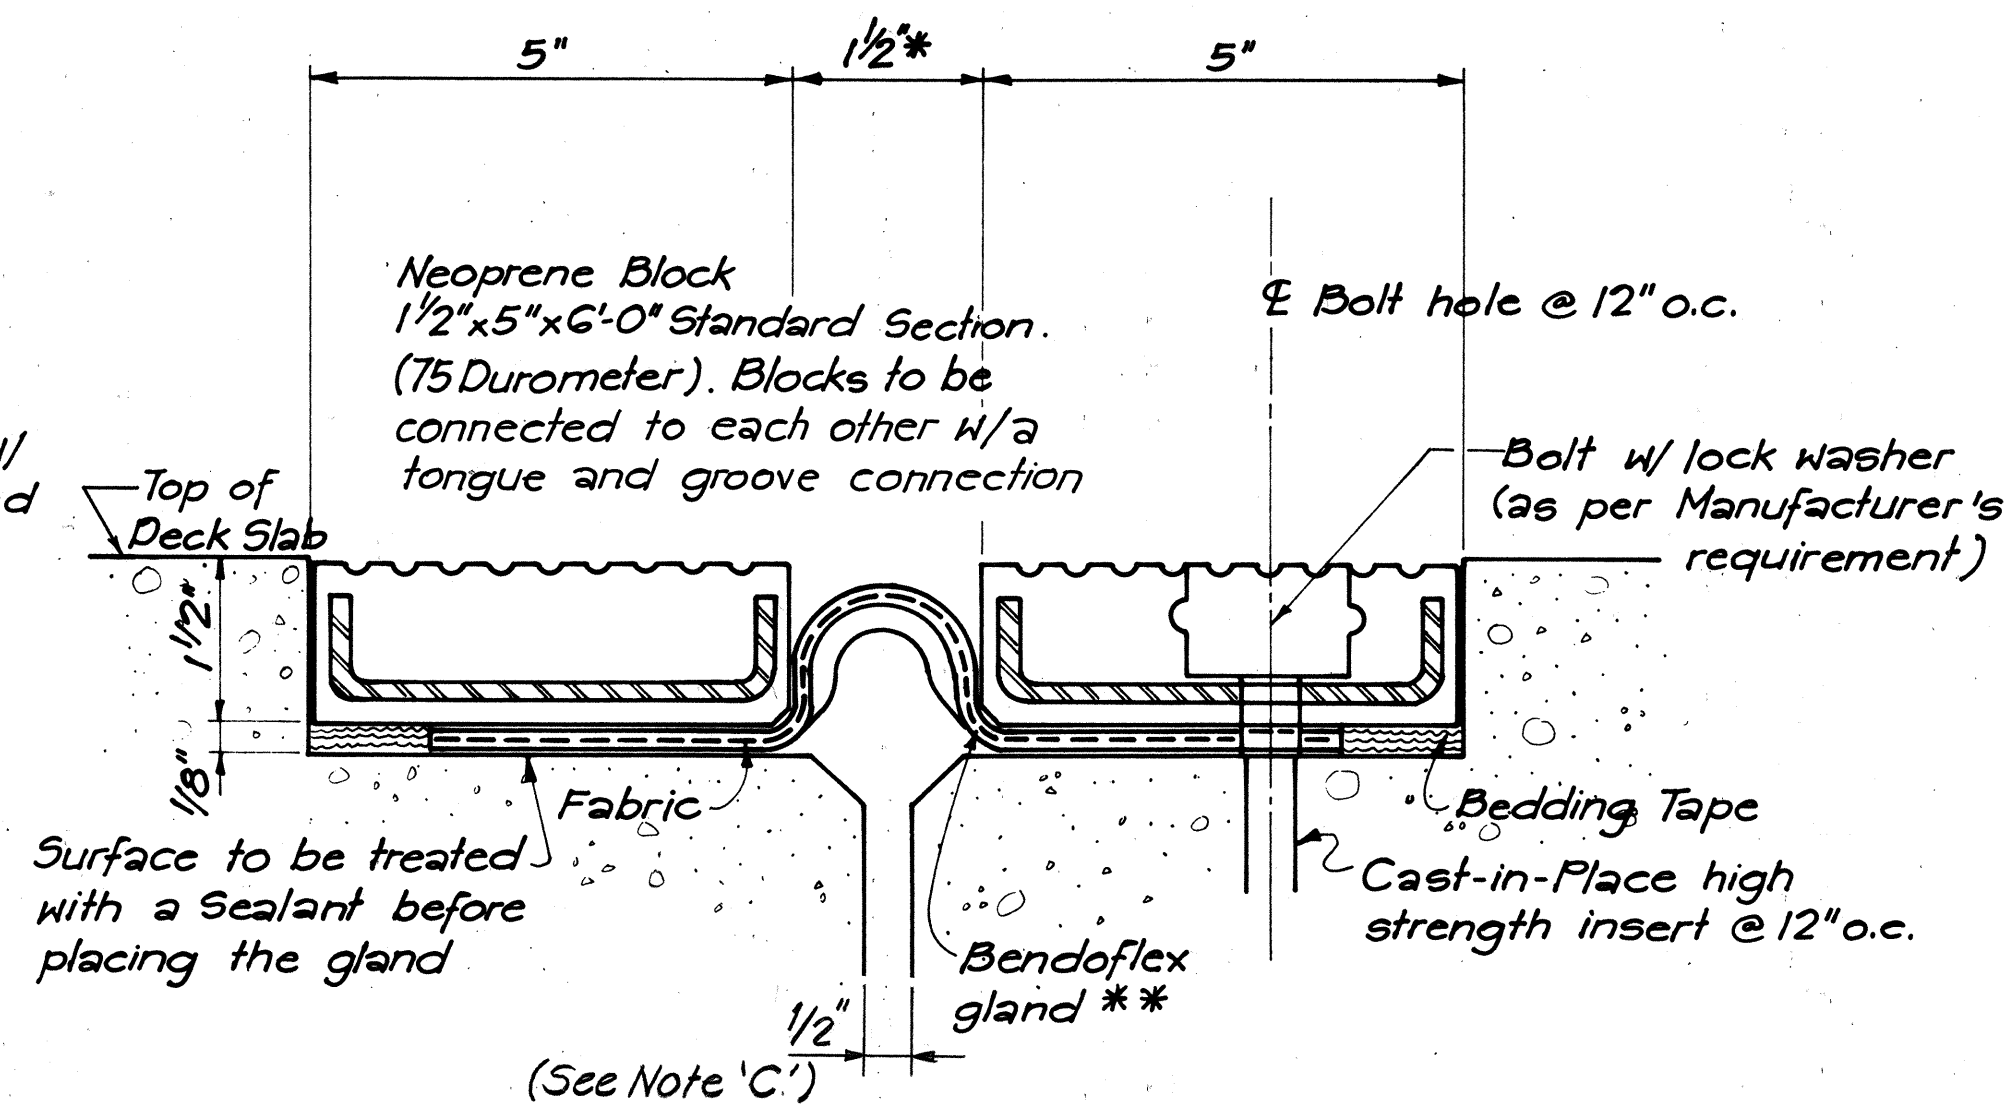


WABO BENDOFLEX SYSTEM
(Manufacturer : Watson Bowman Ass. Inc.)

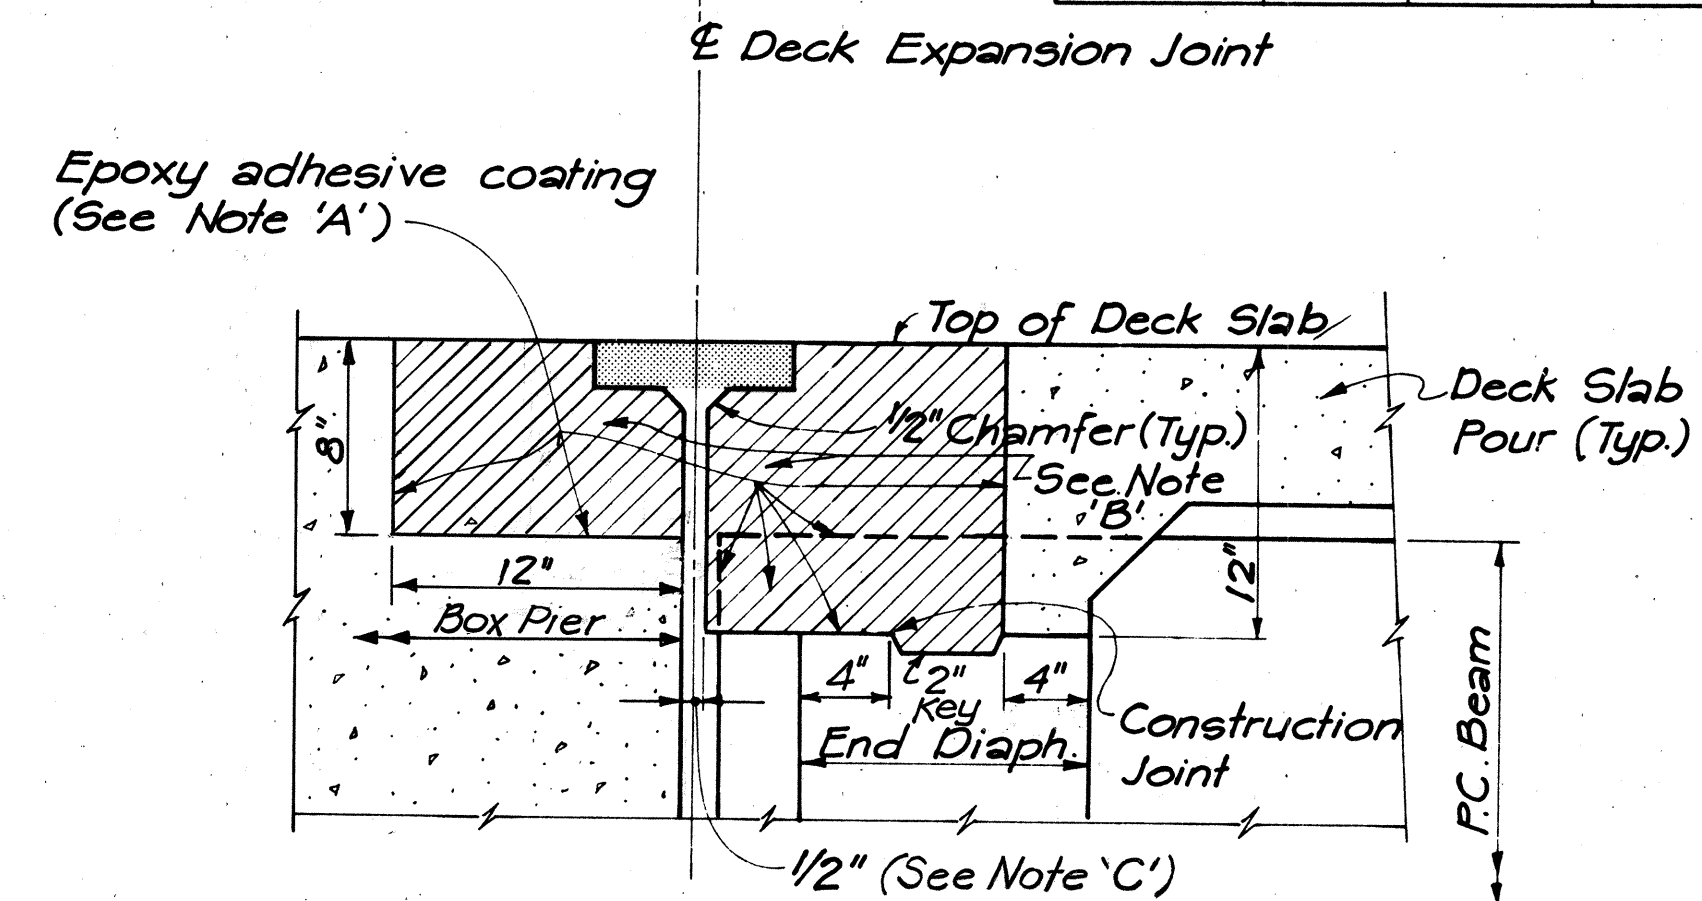


TYPICAL DECK SECTION
Scale: 1 1/2" = 1'-0"

- * = Installation width @ 75°F
** = Seal/Gland shall be continuous across the full width of the structure

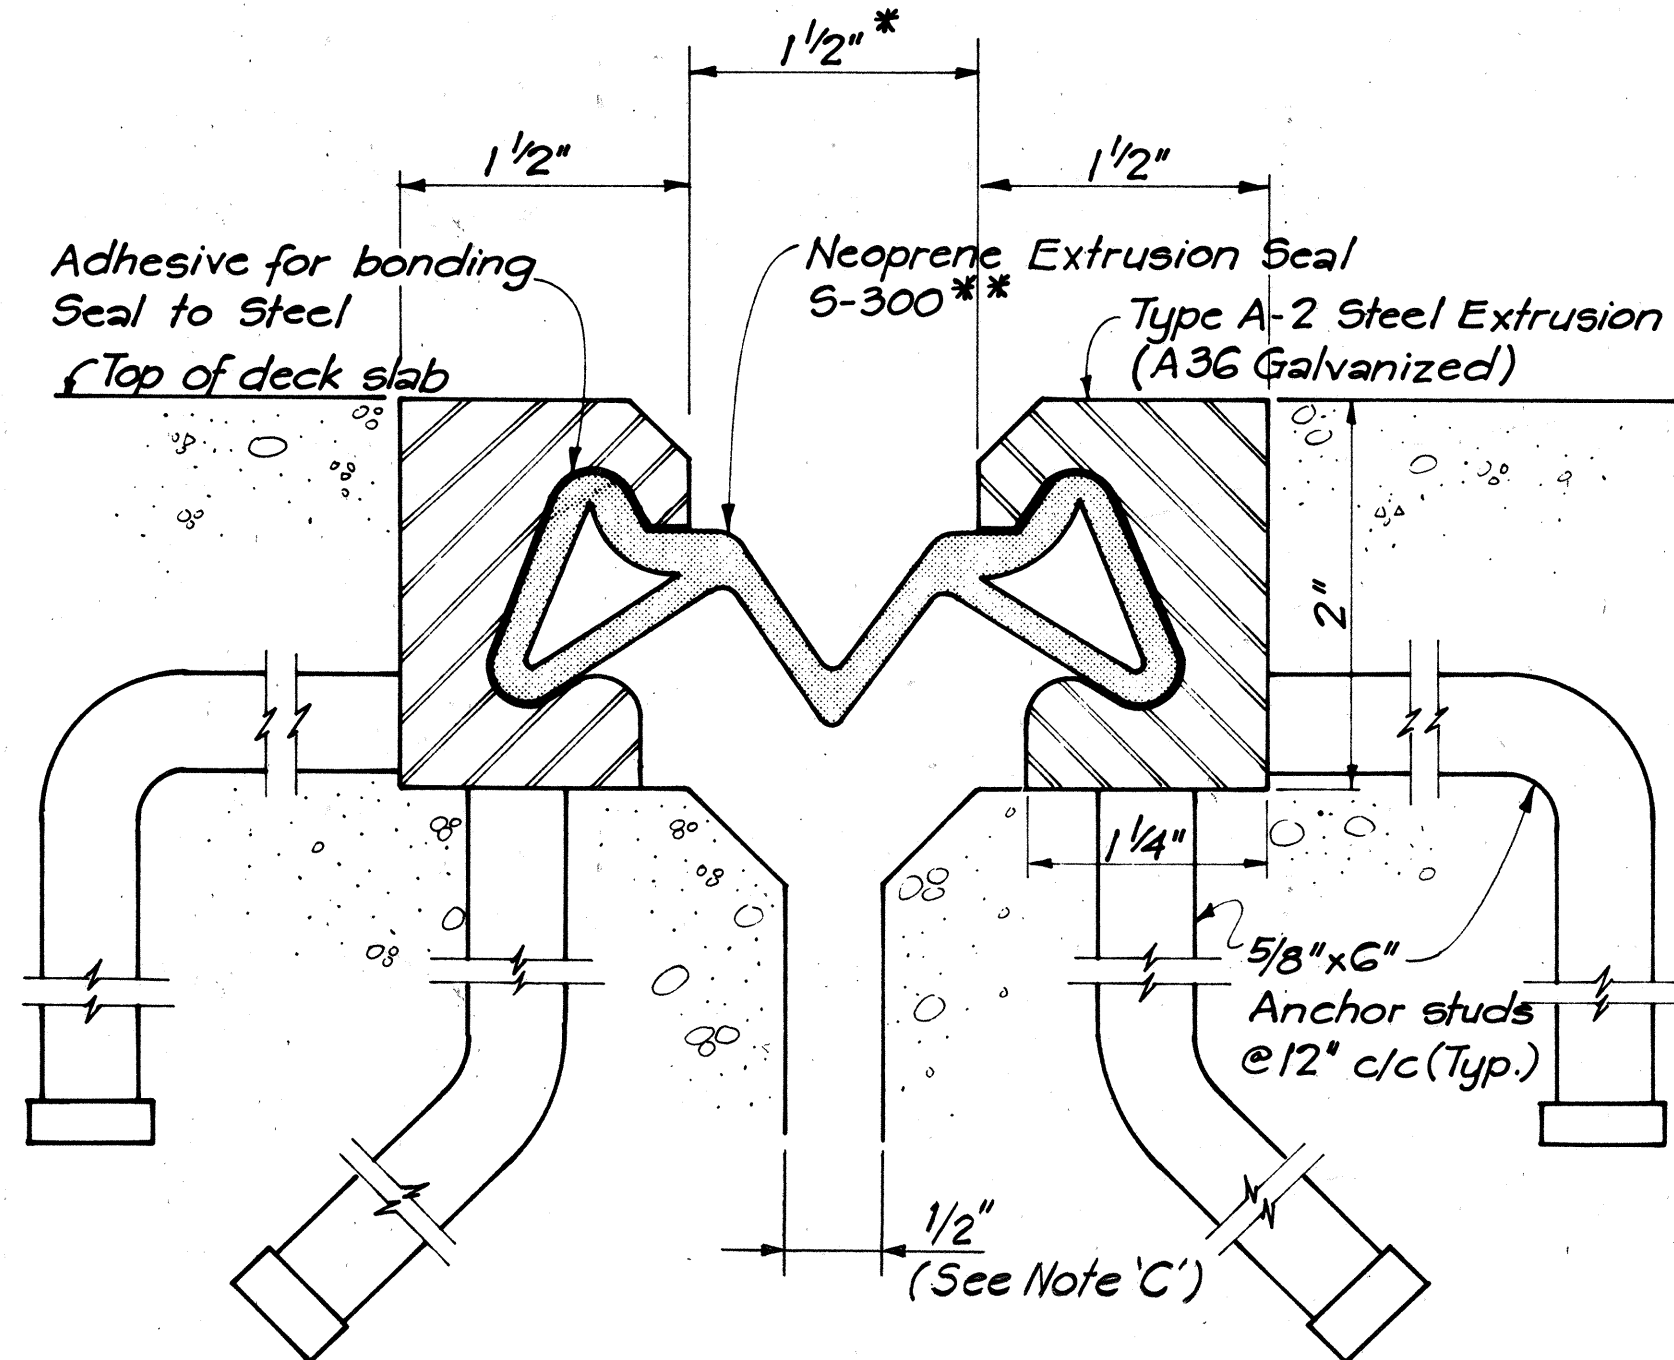


WABO-MAURER STRIP SEAL
(Manufacturer : Watson - Bowman Ass. Inc.)

- NOTE 'A':** Just prior to concreting of the hatched areas, coat the indicated surfaces with an epoxy adhesive. (See Special provision Sec.705.16)
- NOTE 'B':** Hatched Areas shall be concreted after 28 days of deck slab pour. Anchor devices shall be located and held in their final position, as per Manufacturer's requirement, during the concreting of the hatched areas.
- NOTE 'C':** Joint opening at time of installation of joint. Joint to be formed by premolded filler.

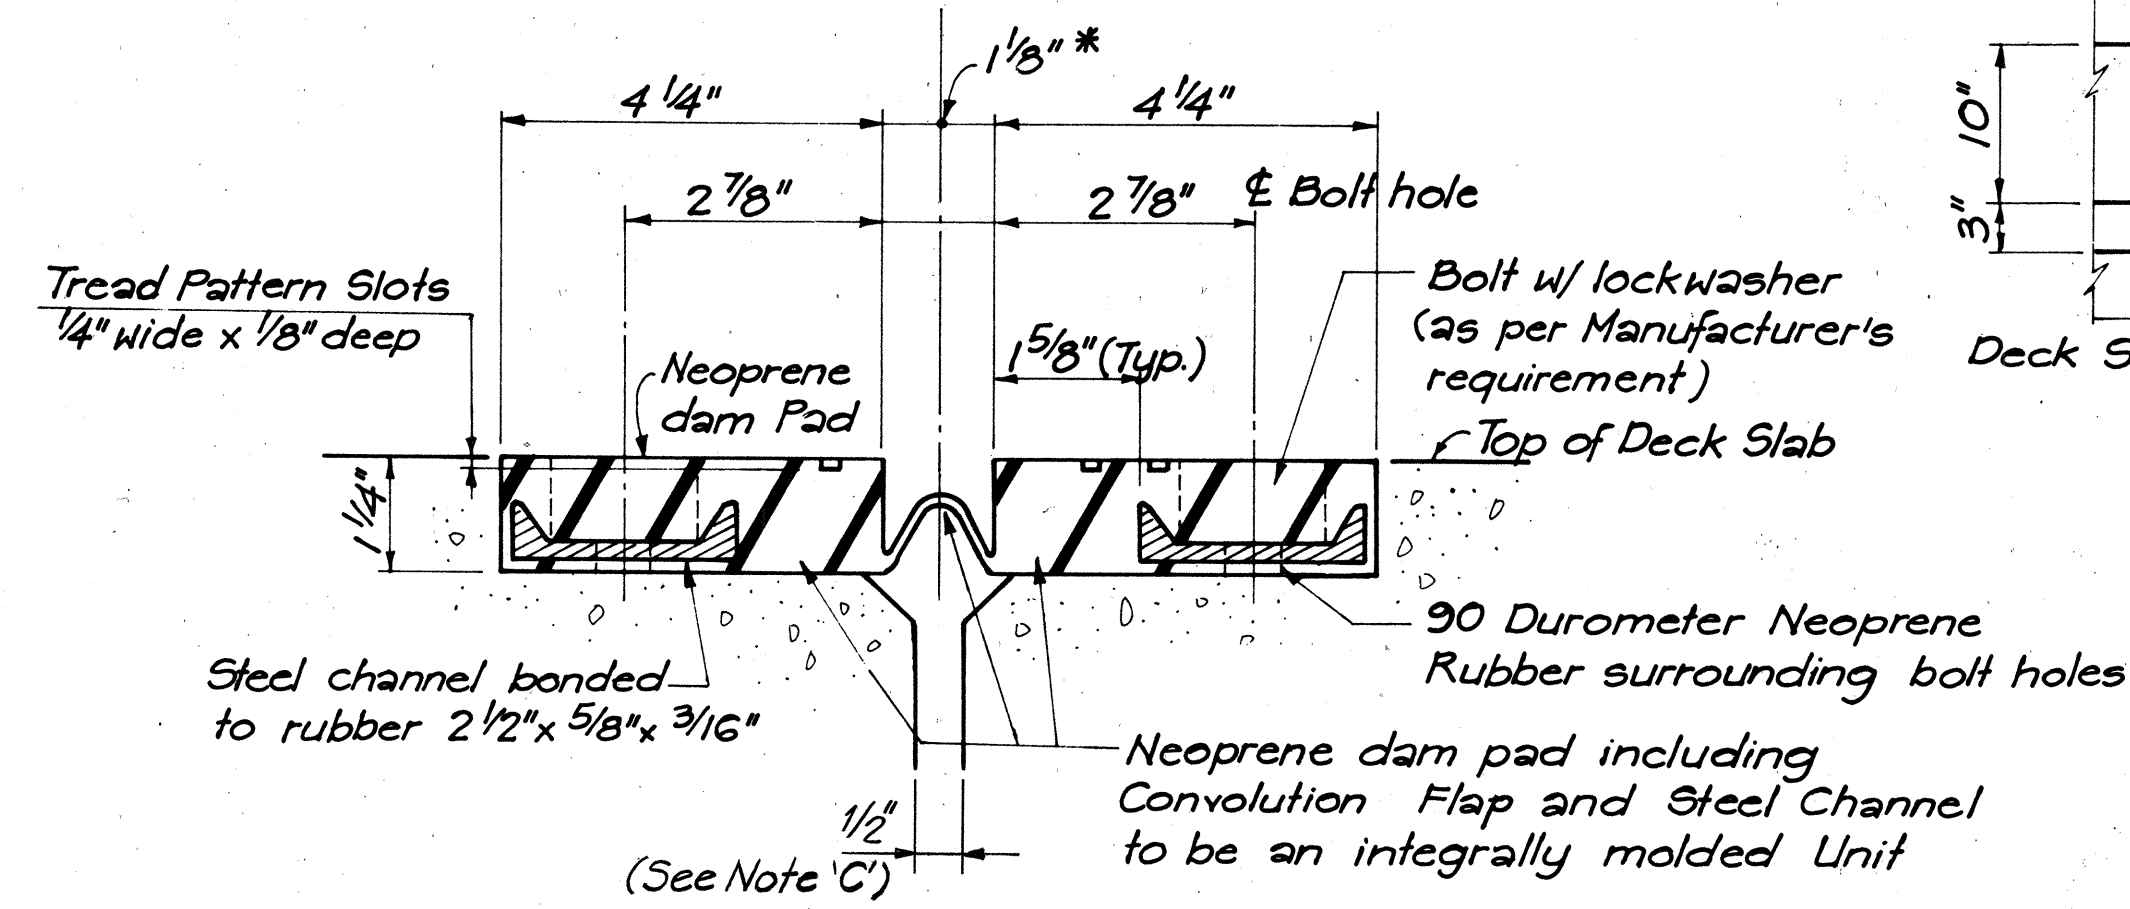


FEL-SPAN TYPE T-20
(Manufacturer : FEL-PRO Incorporated)



- NOTE:** The entire assembly to be factory vulcanized into 8'-0" (Min.) long units before shipping. The convolution flap between units to be lapped and field vulcanized.

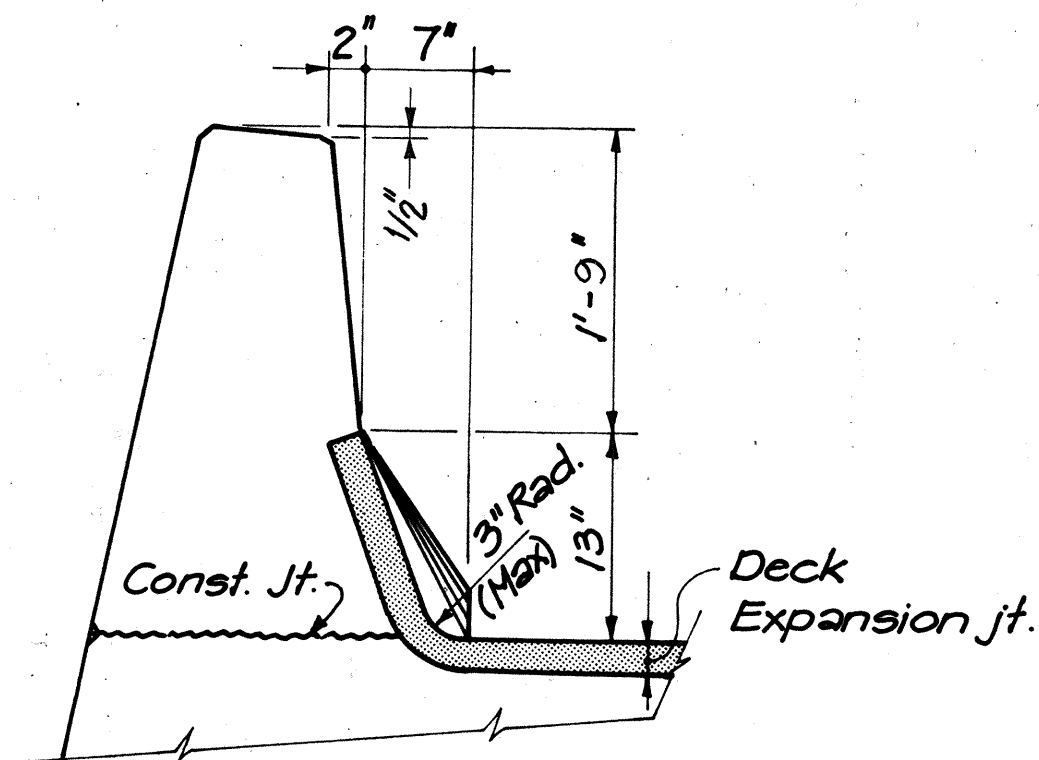

TYPICAL SECTION AT STANDARD PARAPET
N.T.S.

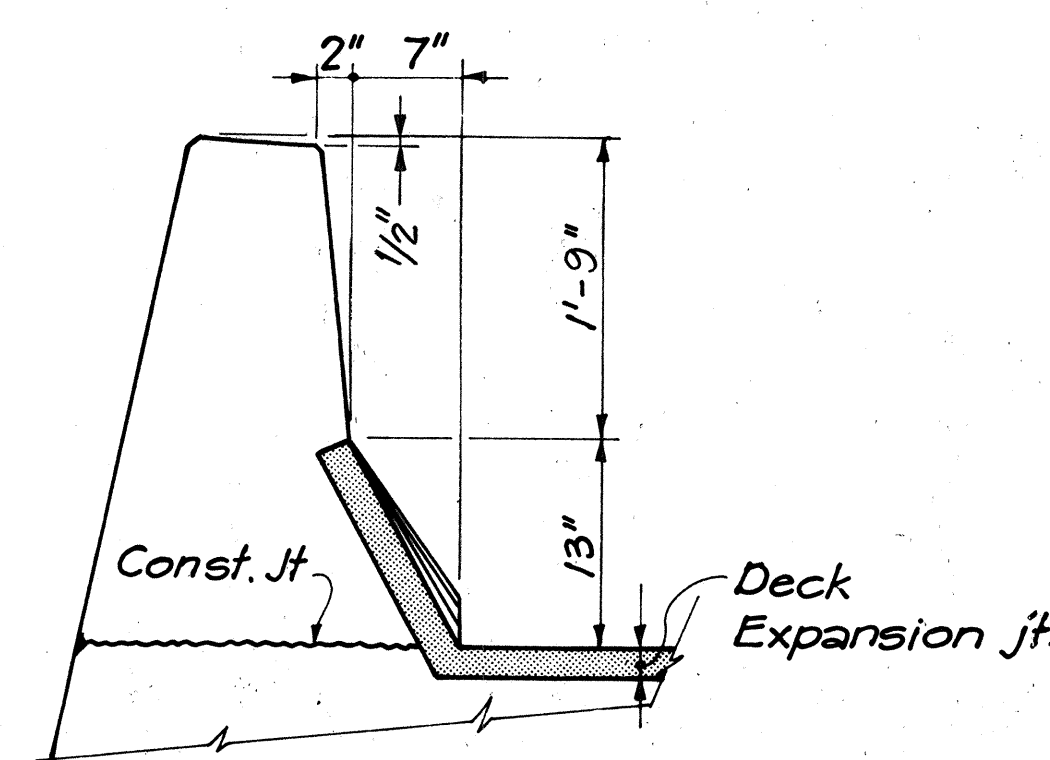


ALTERNATE DETAIL AT PARAPET
N.T.S.

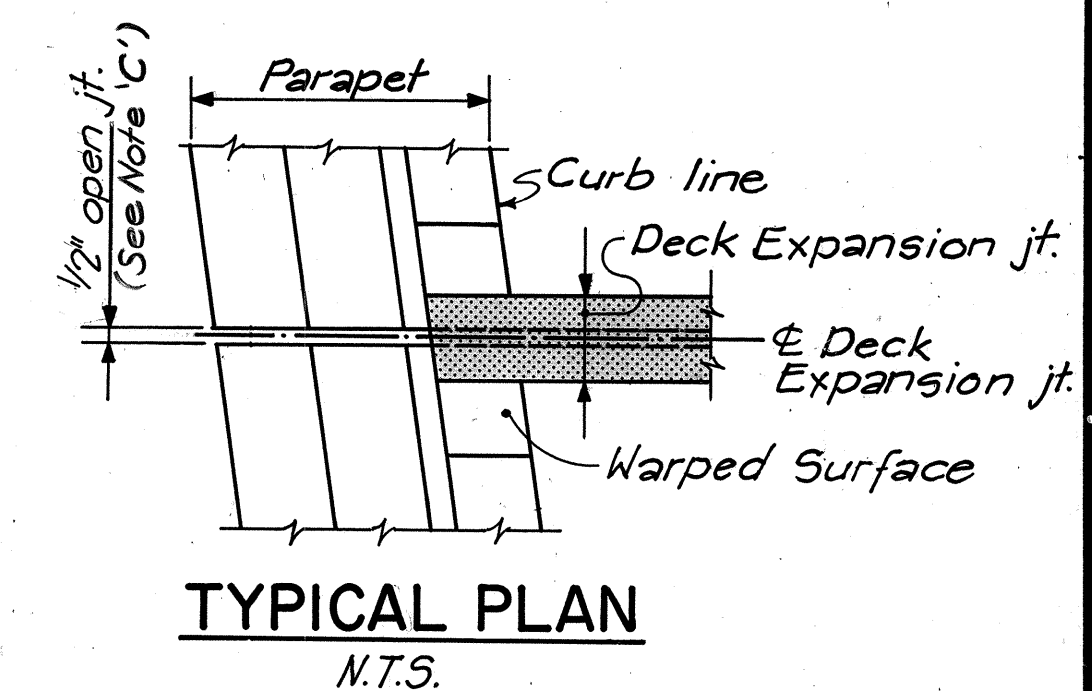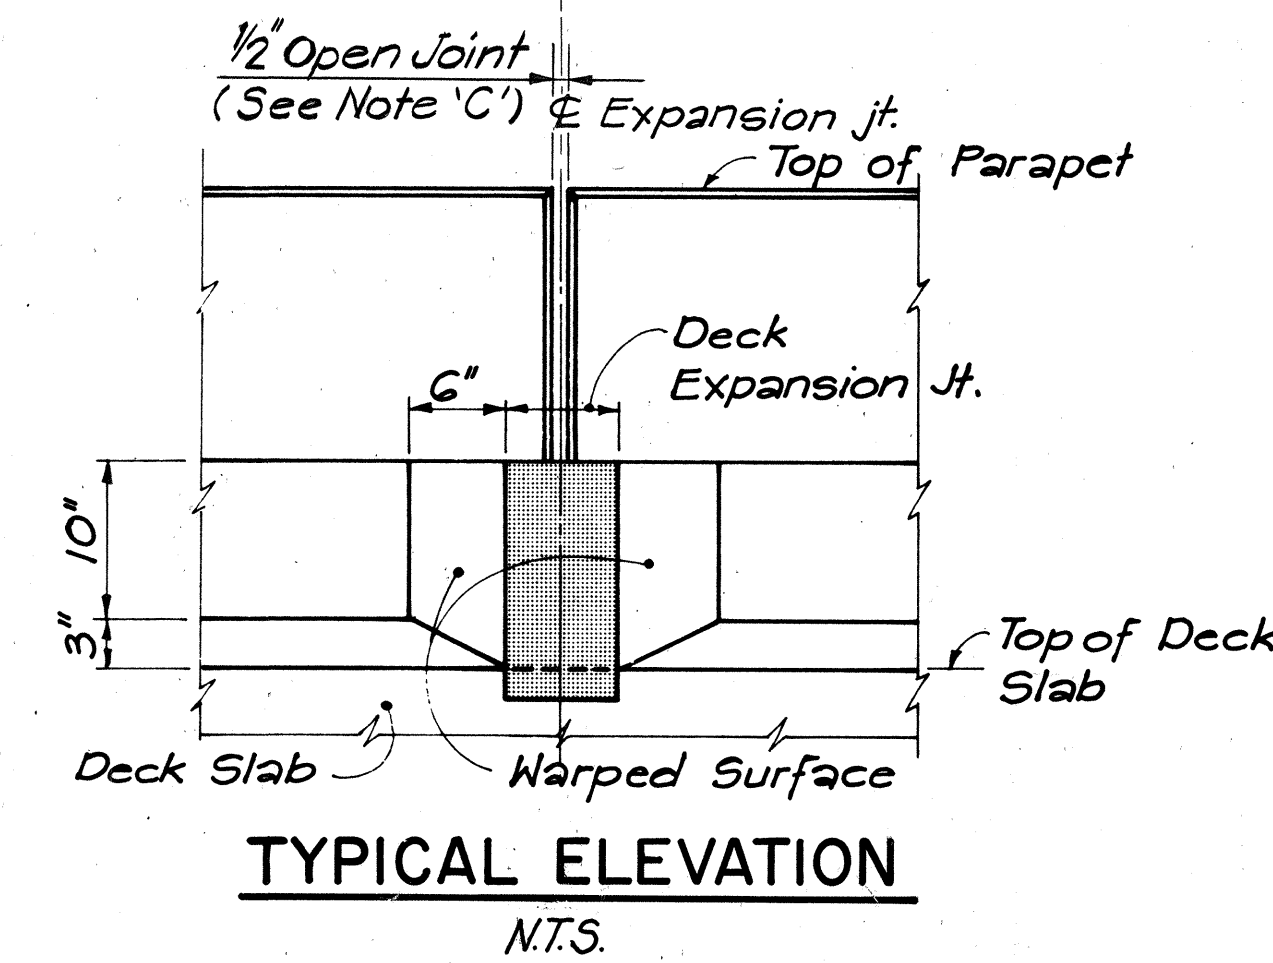

NOTES:

- Four alternative Deck Expansion Joint Systems are shown. Contractor has the option of selecting any one of the systems. The Contractor shall submit detailed shop drawings of the selected joint to the Engineer for approval.
- The Contractor also has the option of using an alternative Deck Expansion Joint system provided it complies with the requirements of the plans and specifications.

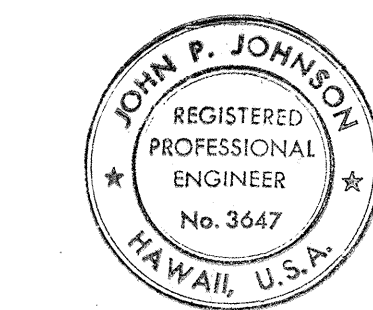


THIS WORK WAS PREPARED BY ME
OR UNDER MY SUPERVISION,
John P. Johnson

STATE OF HAWAII
DEPARTMENT OF TRANSPORTATION
HIGHWAYS DIVISION

DECK EXPANSION JOINT
FORT WEAVER ROAD
ROUTE H-1 TO SOUTH OF
FARRINGTON HIGHWAY
PROJECT NO. M-7600(1)


SCALE: NONE
DATE: AUG. 1978
SHEET NO. S-11 OF S-16 SHEETS

ORIGINAL	SURVEY PLOTTED BY	DATE
PLAN	DRAWN BY	"
	TRACED BY	"
NOTE BOOK	DESIGNED BY	"
	QUANTITIES BY	"
No.	CHECKED BY	"

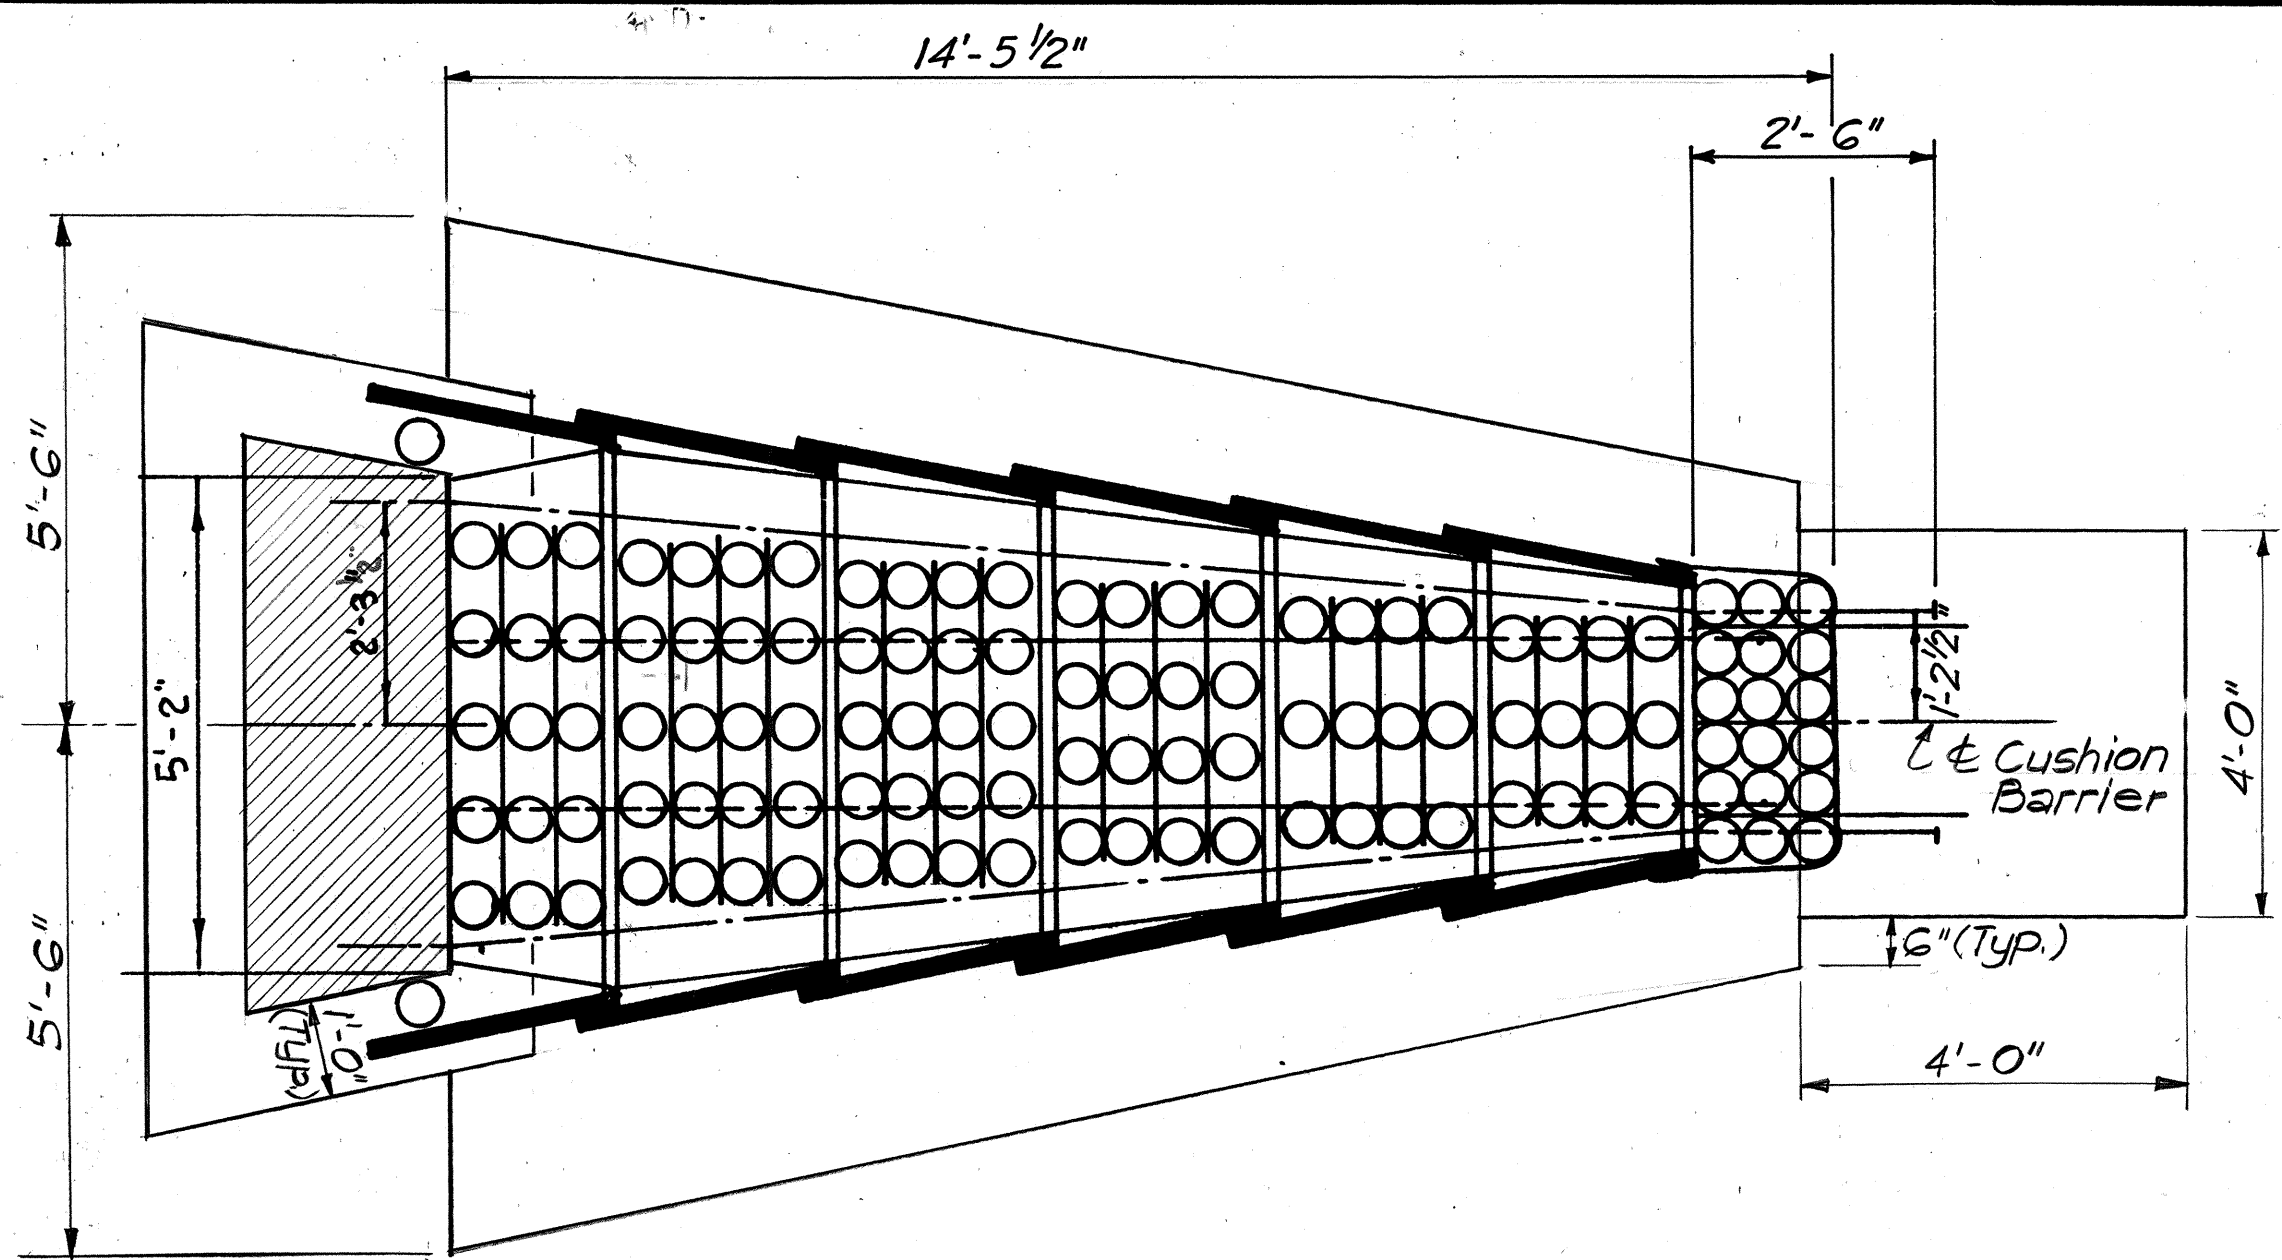


PLAN
SCALE: 1/2" = 1'-0"


NOTE: Footings and Pad for Cushion Barriers shall be of Class A Concrete (Incidental to Item "Cushion Barrier" paid in Roadway Item)

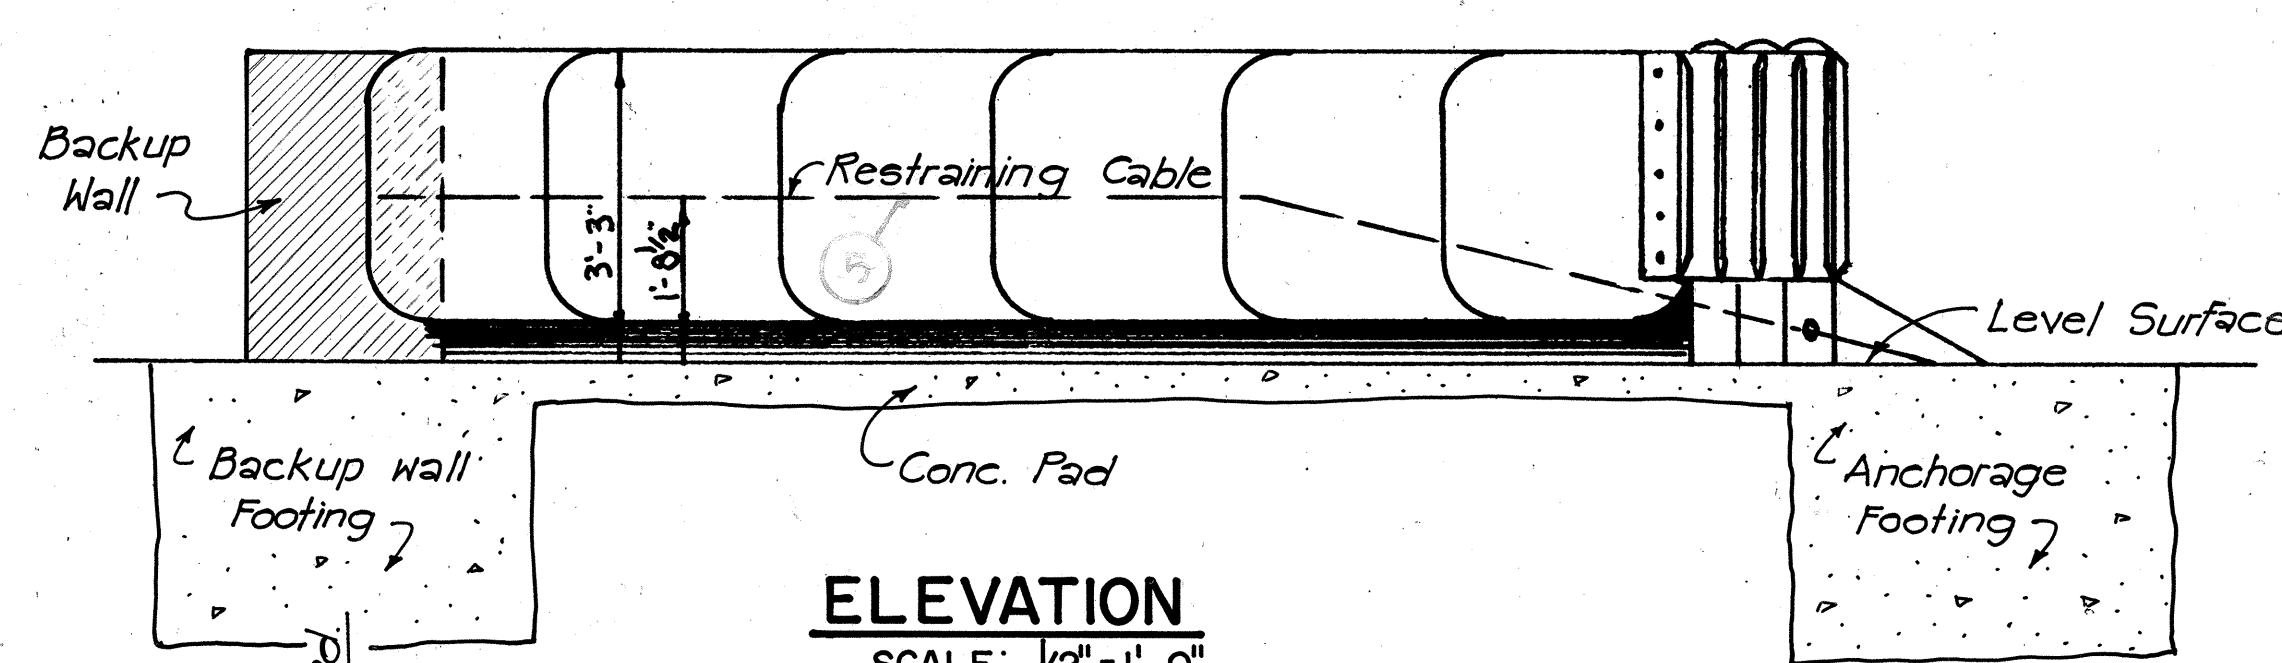


ELEVATION
SCALE: 1/2" = 1'-0"

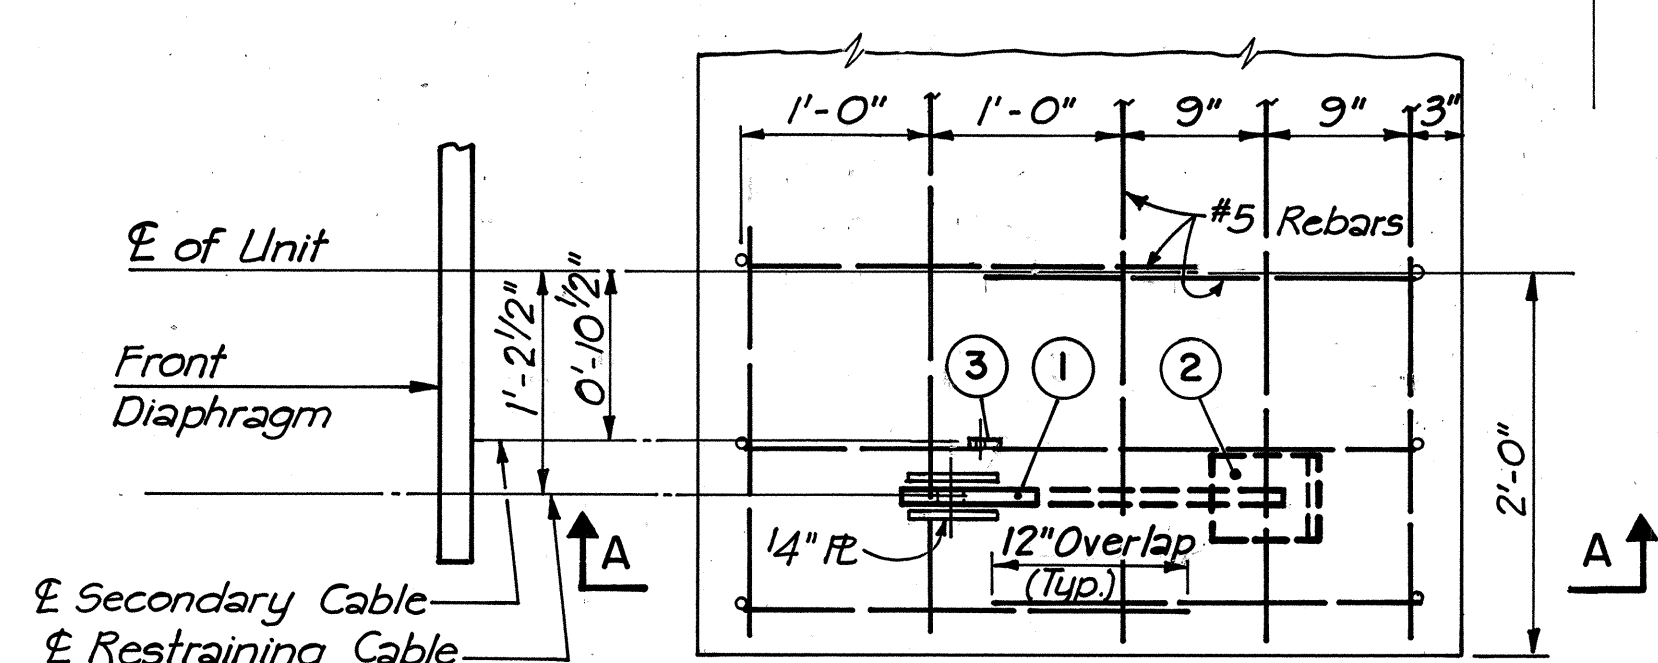


TOP VIEW
SCALE: 1" = 1'-0"

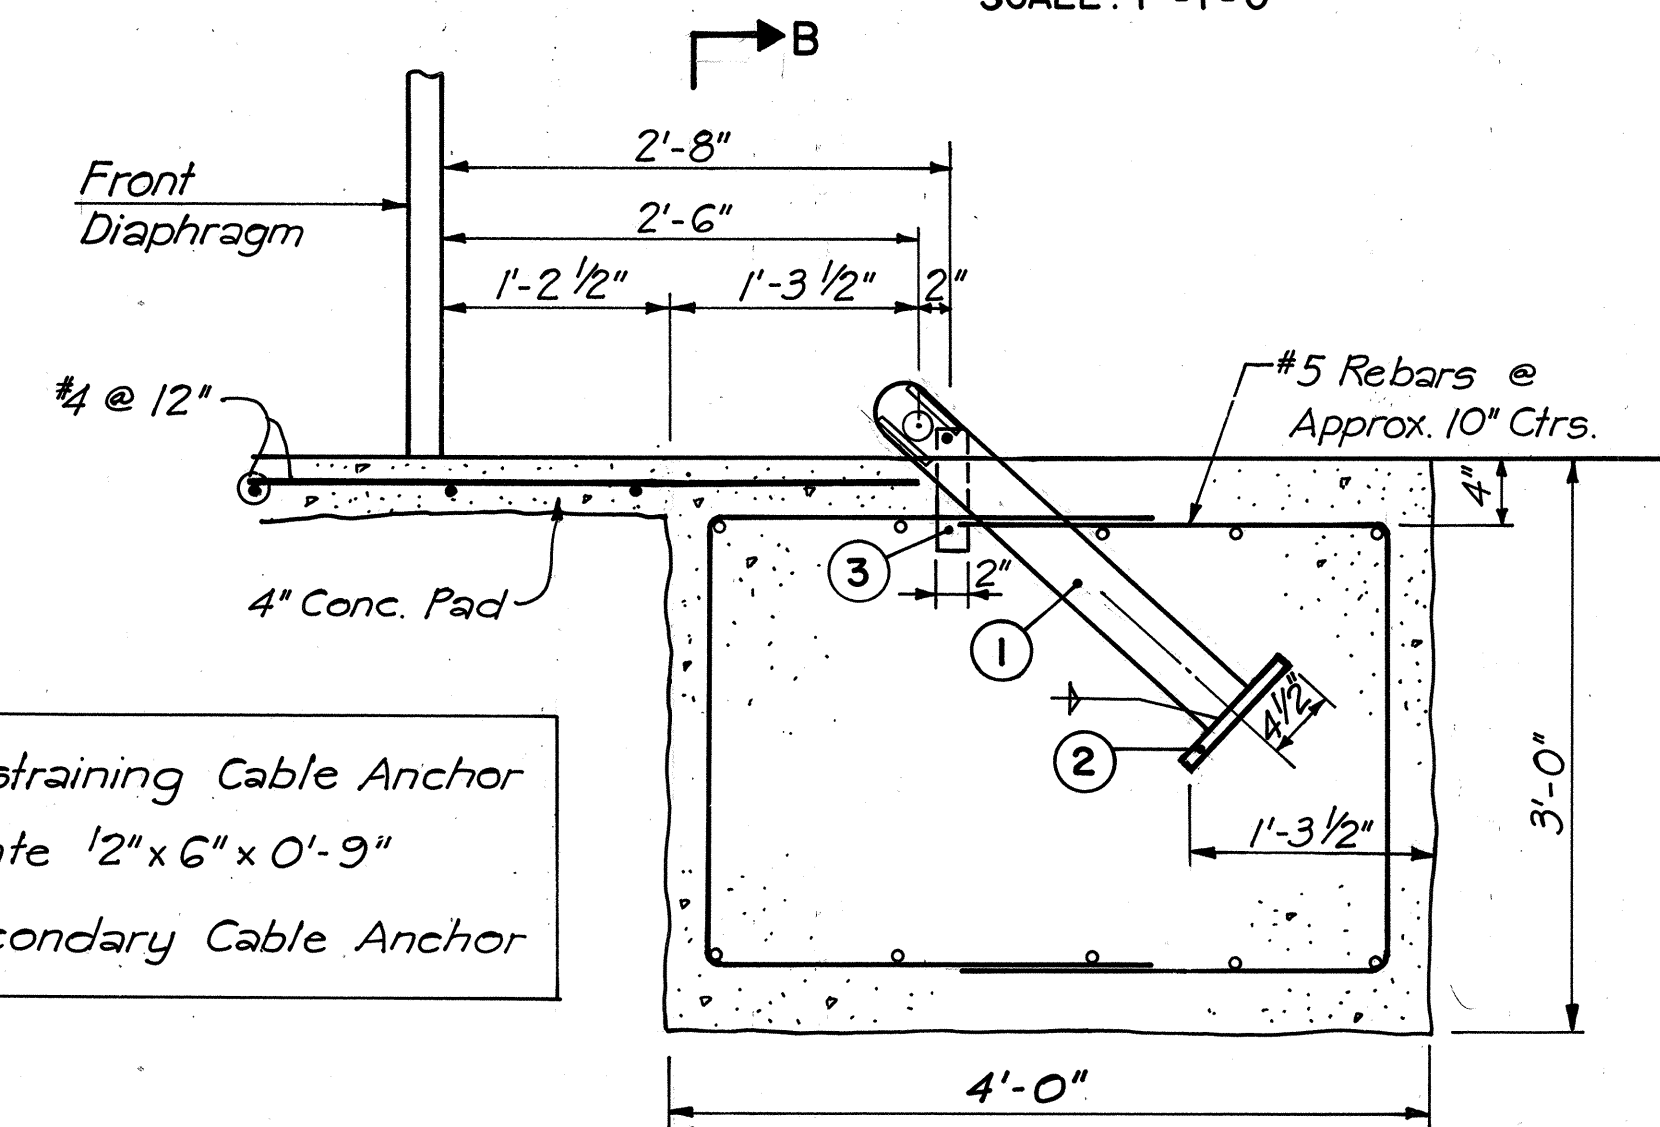

SECTION A-A
SCALE: 1" = 1'-0"

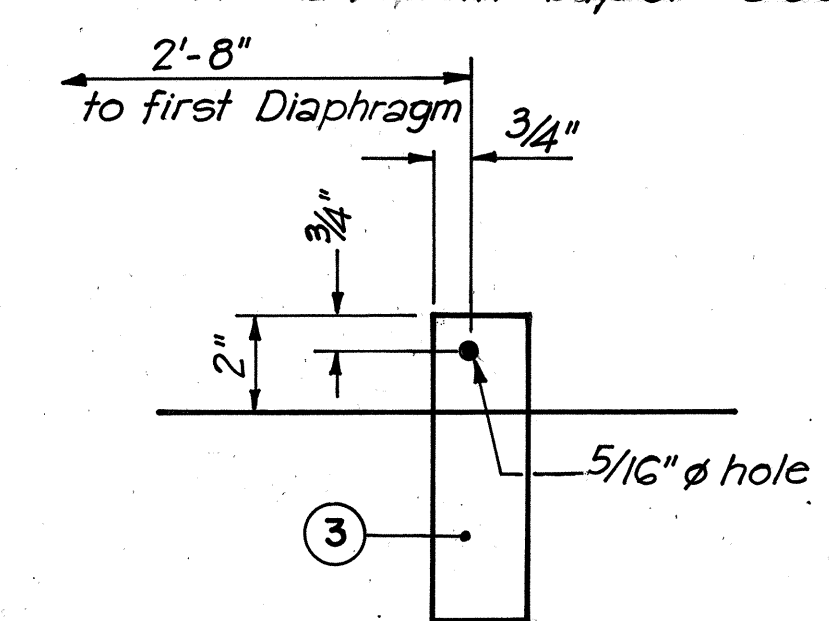

DETAIL A
SCALE: 3" = 1'-0"

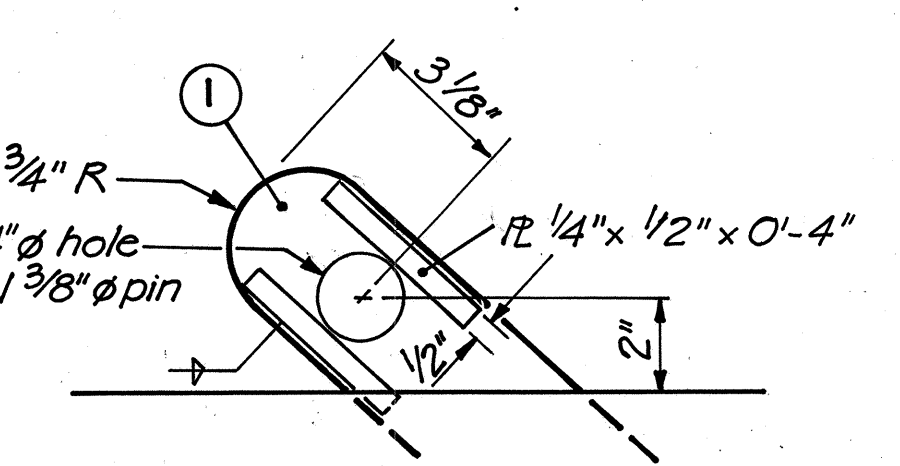


DETAIL B
SCALE: 3" = 1'-0"

- ① Restraining Cable Anchor
- ② Plate 12"x6"x0'-9"
- ③ Secondary Cable Anchor



**FRONT CABLE ANCHORAGE
IMBEDDED TYPE A**

(In lieu of the imbedded type of Cable Anchorage Plate Type of Anchorage may be used, subject to the approval of The Engineer. Expansion Bolts will not be permitted with the use of Plate Type Anchorage)

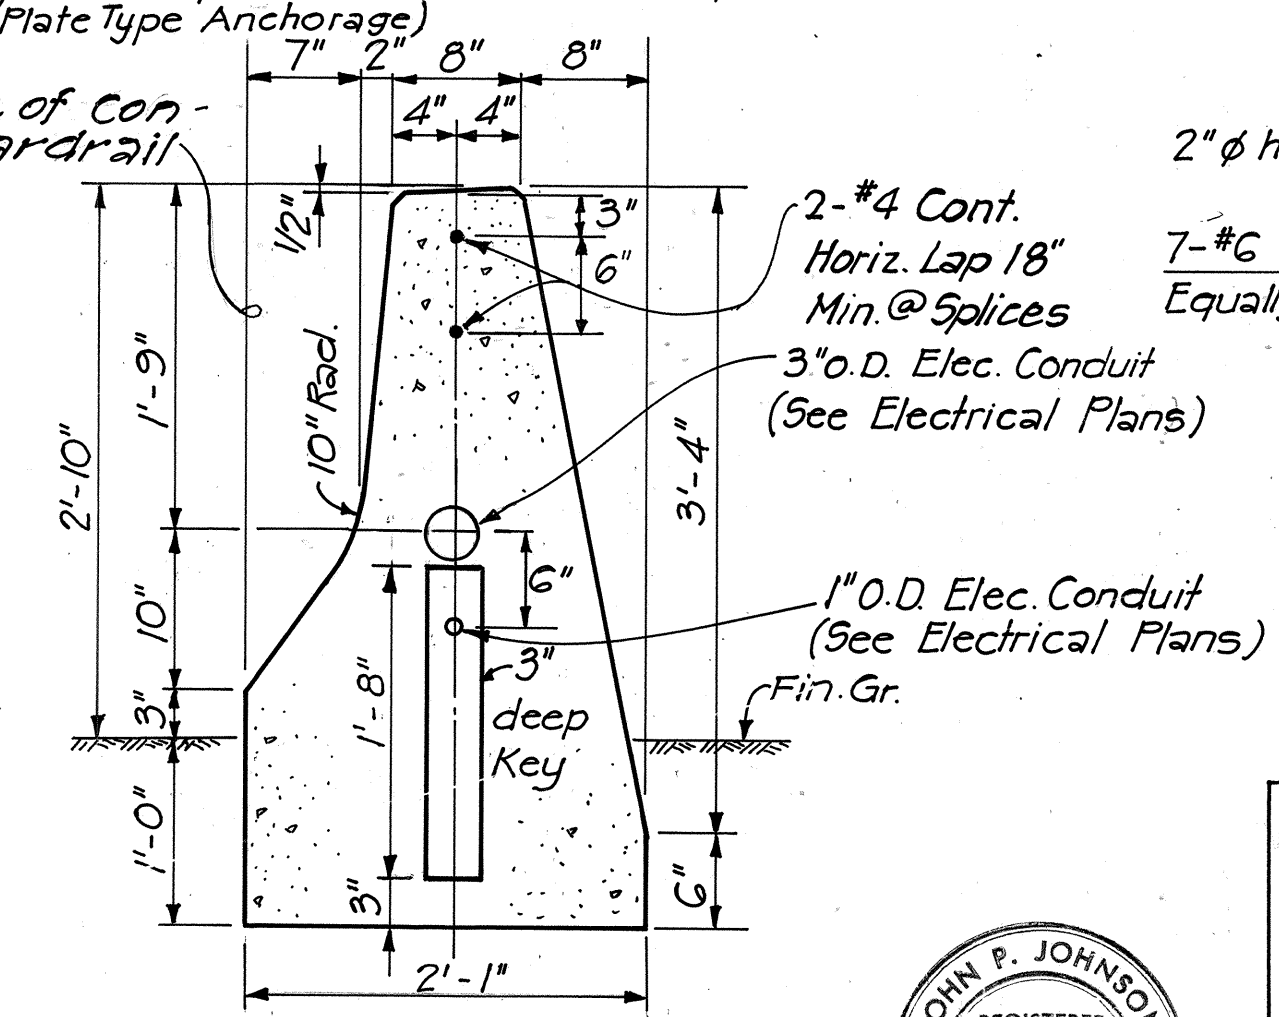


CONCRETE GUARDRAIL
SCALE: 1" = 1'-0"

NOTE: For Details of Concrete Guardrail Expansion and Control Joints, see THIS WORK WAS PREPARED BY ME OR UNDER MY SUPERVISION.

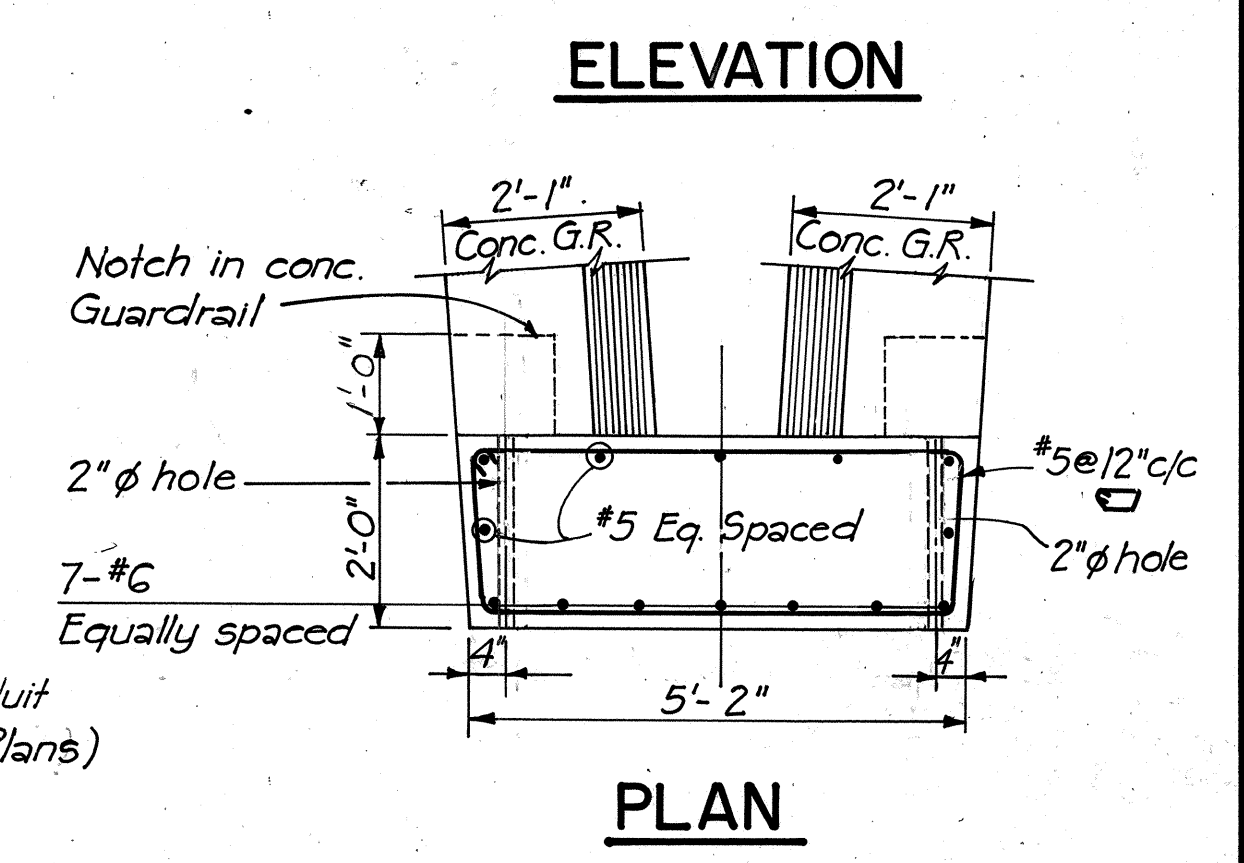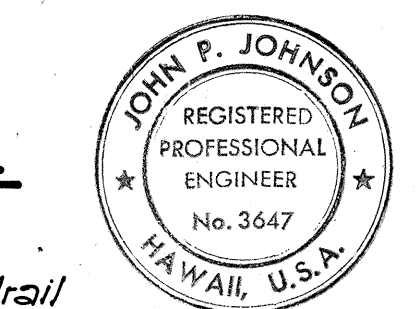

PLAN

CONCRETE BACKUP WALL
SCALE: 1/2" = 1'-0"

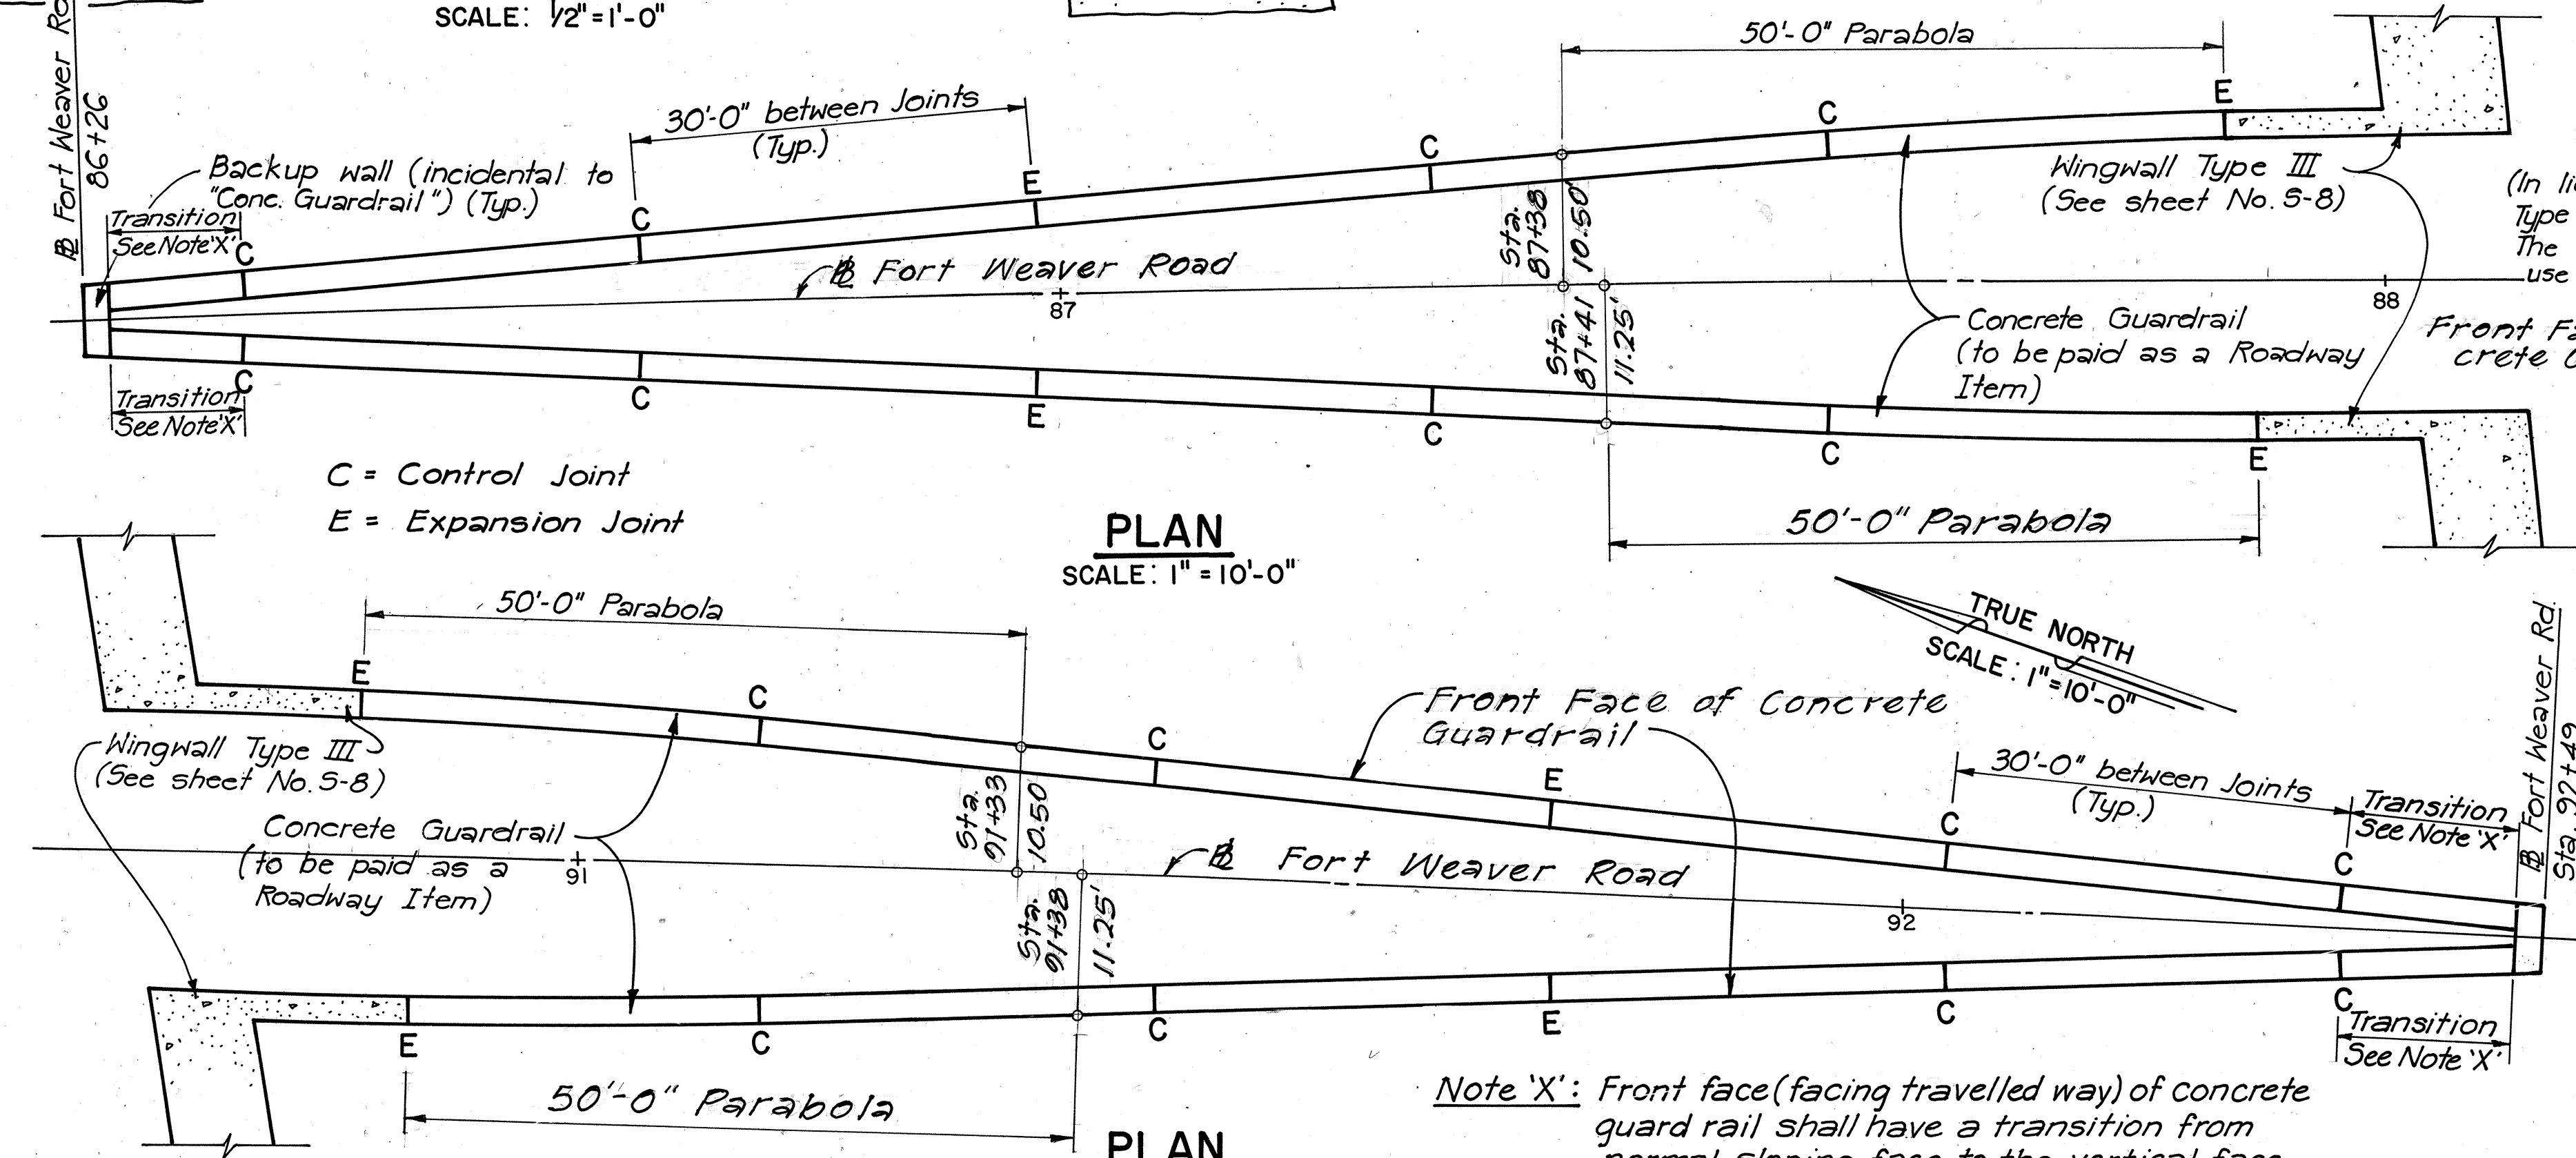

PLAN
SCALE: 1" = 10'-0"

PLAN
SCALE: 1" = 10'-0"




Note 'X': Front face (facing travelled way) of concrete guard rail shall have a transition from normal sloping face to the vertical face of backup wall.

STATE OF HAWAII
DEPARTMENT OF TRANSPORTATION
HIGHWAYS DIVISION



CUSHION BARRIER DETAILS

FORT WEAVER ROAD
ROUTE H-1 TO SOUTH OF
FARRINGTON HIGHWAY
PROJECT NO. M-7600(1)

SCALE: AS SHOWN DATE: AUG. 1978
SHEET NO. S-13 OF S-16 SHEETS

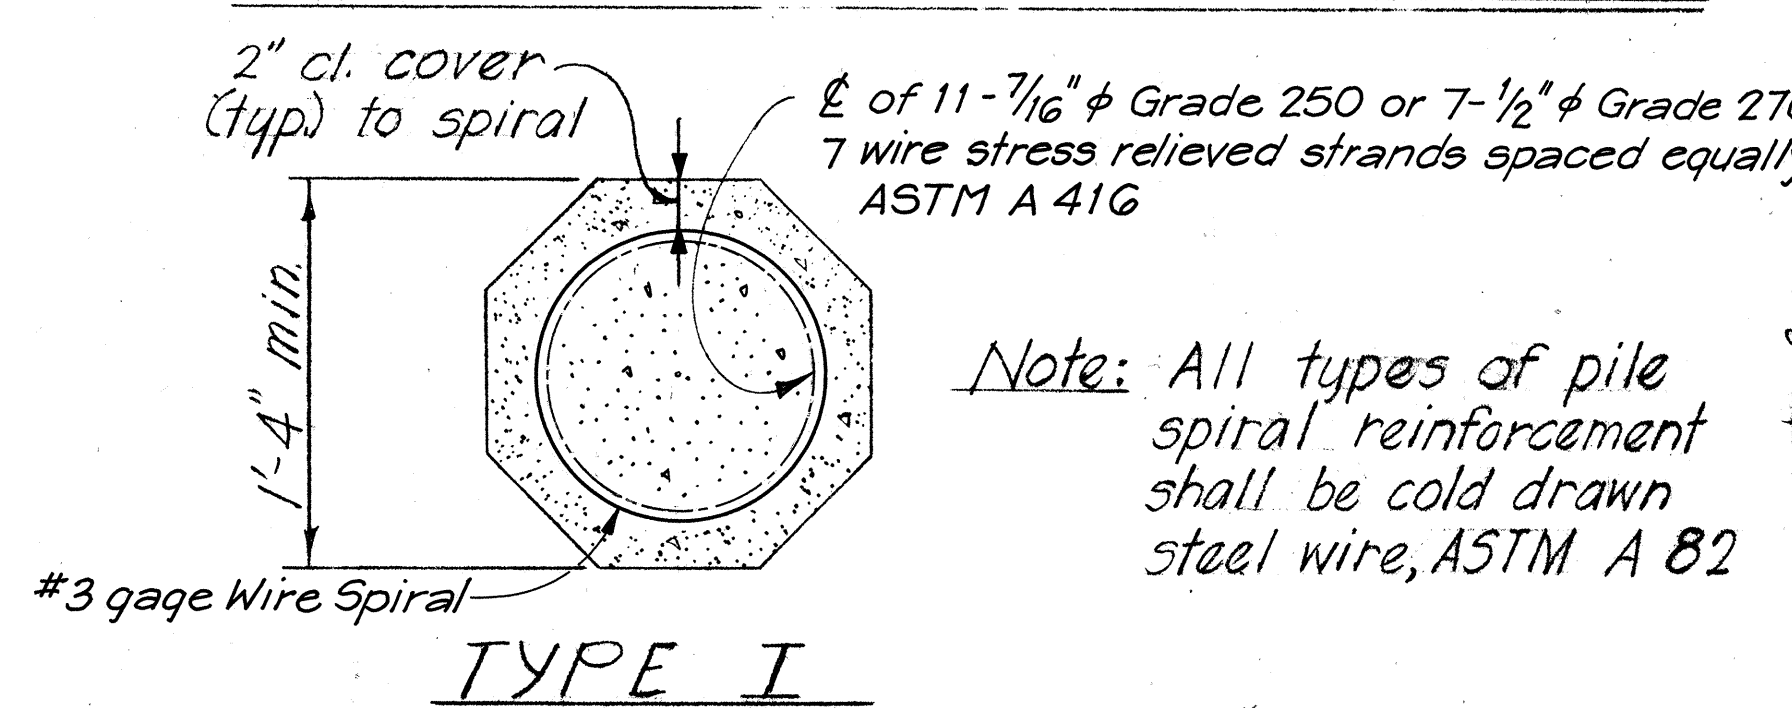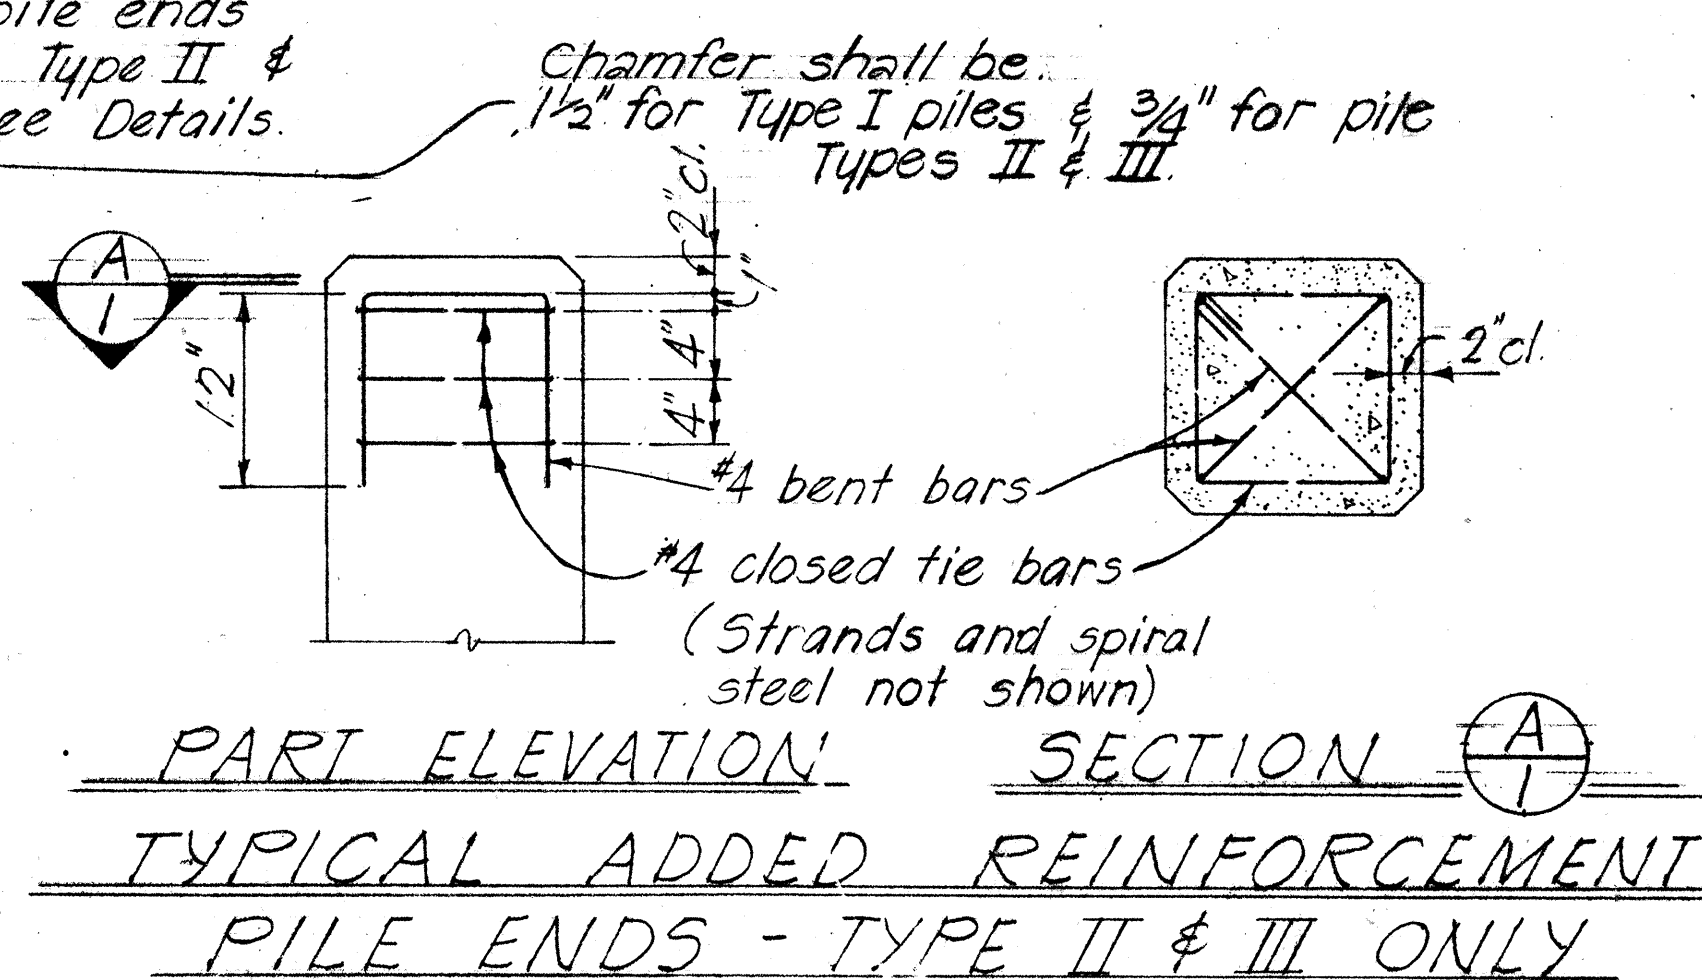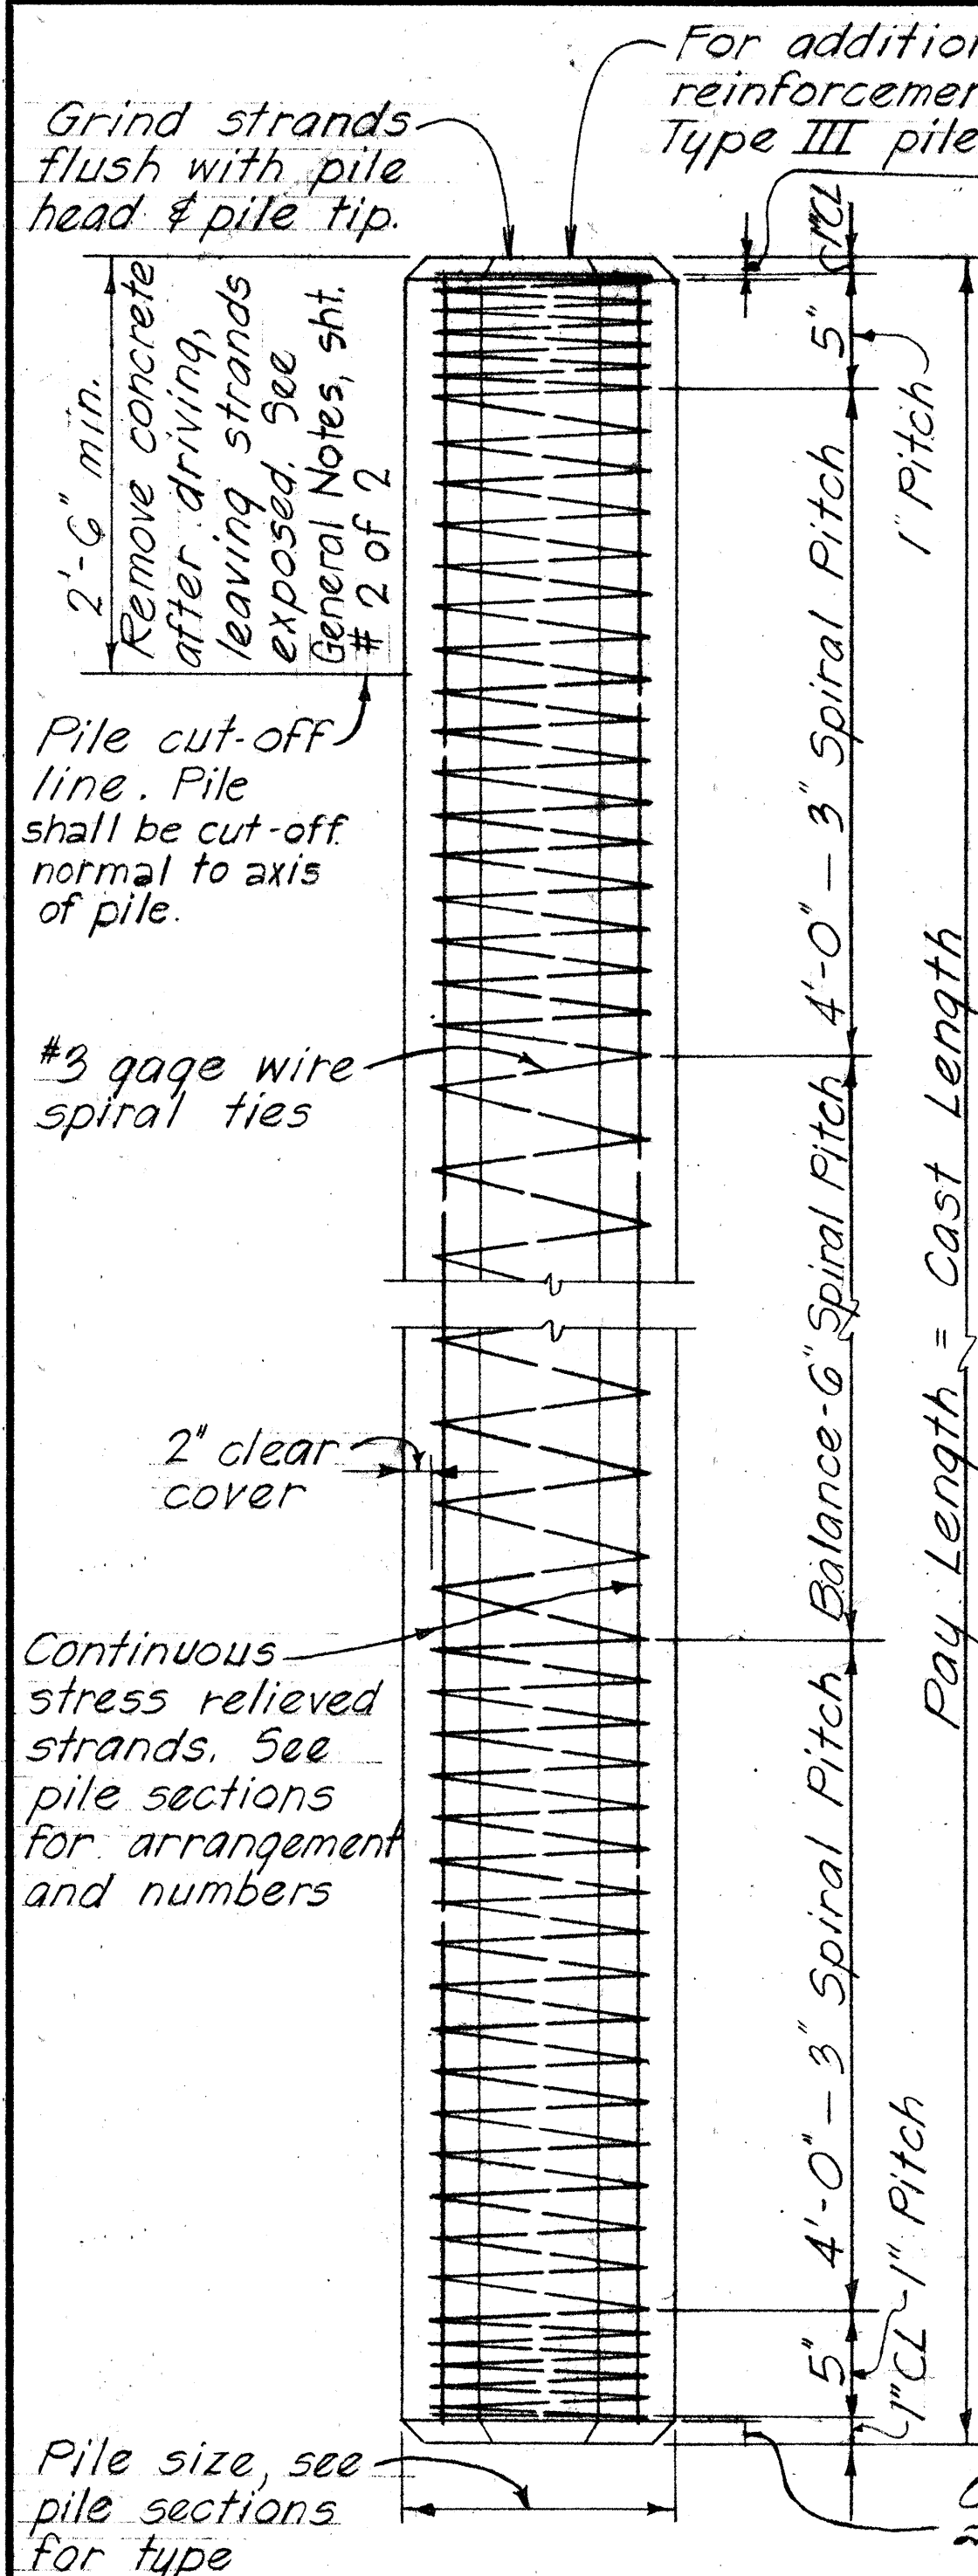

NOTE:
Concrete in pile build-ups without driving shall be Class A Concrete. Concrete in pile build-ups with driving shall have a minimum compressive cylinder strength f'_c of 5000 p.s.i. at 28 days. Build-ups may be driven if the specimen of concrete from which the piles were poured develops a strength of at least 3500 p.s.i. but not earlier than 7 days.

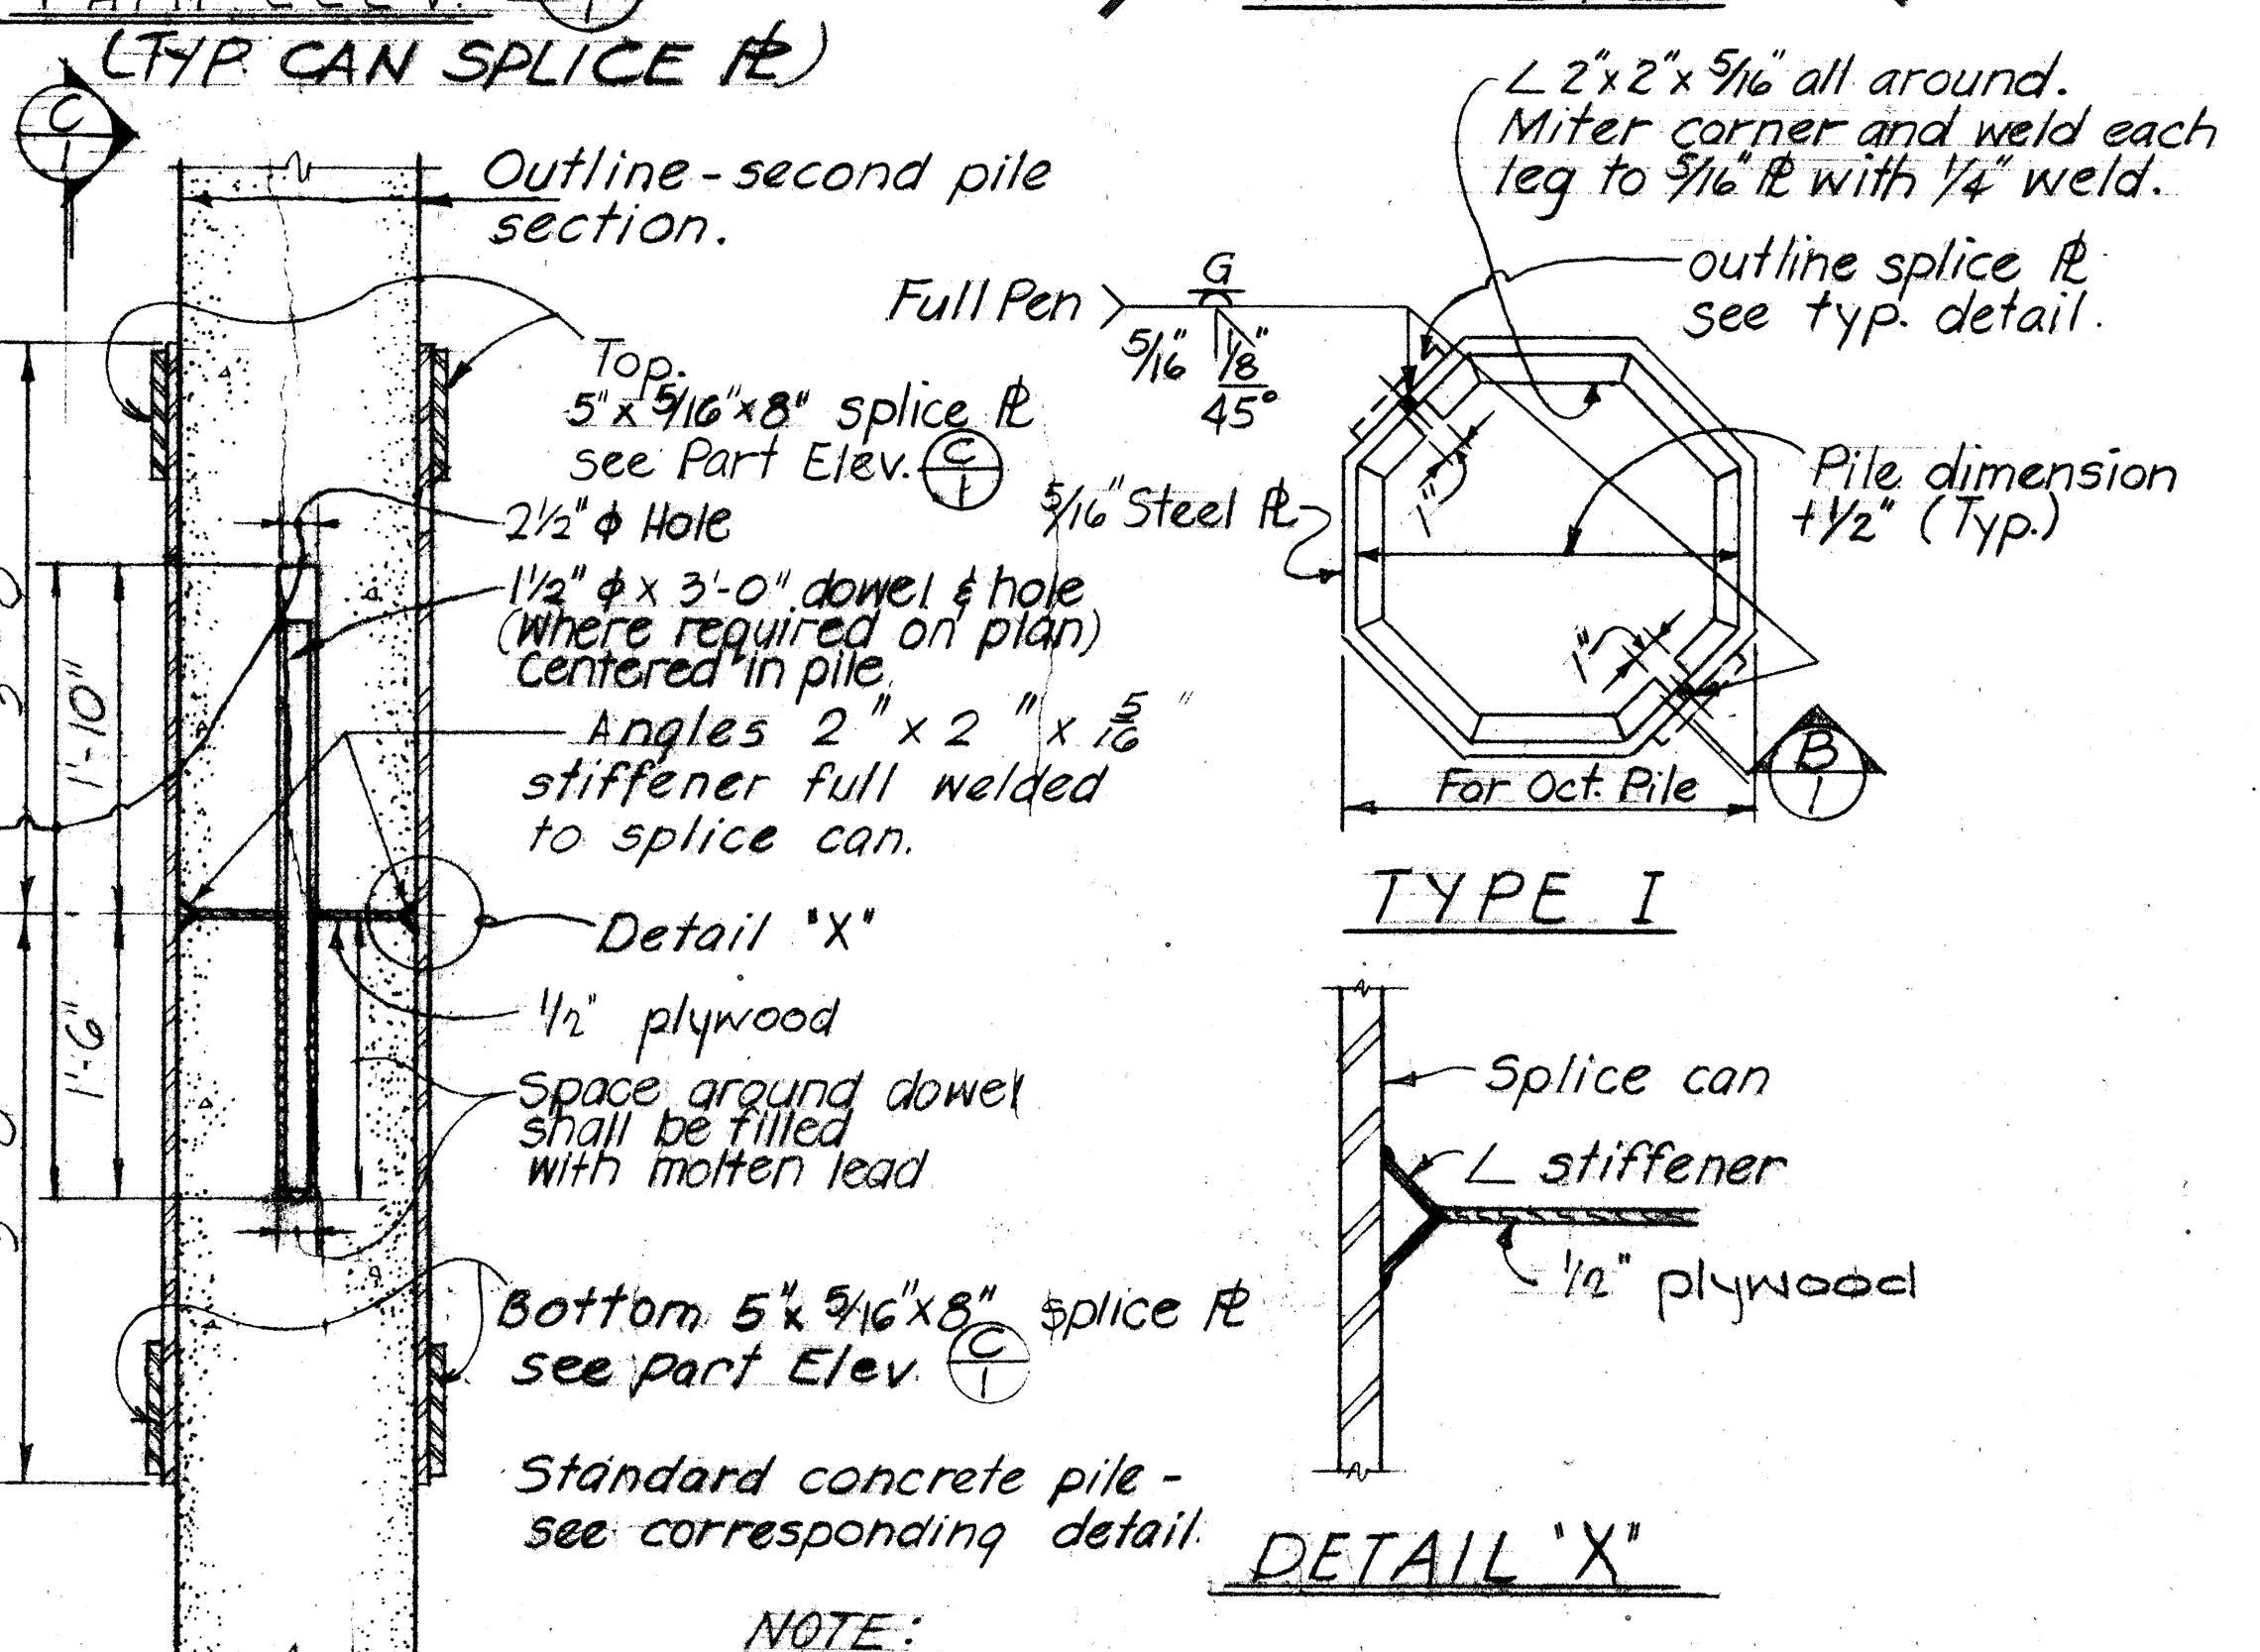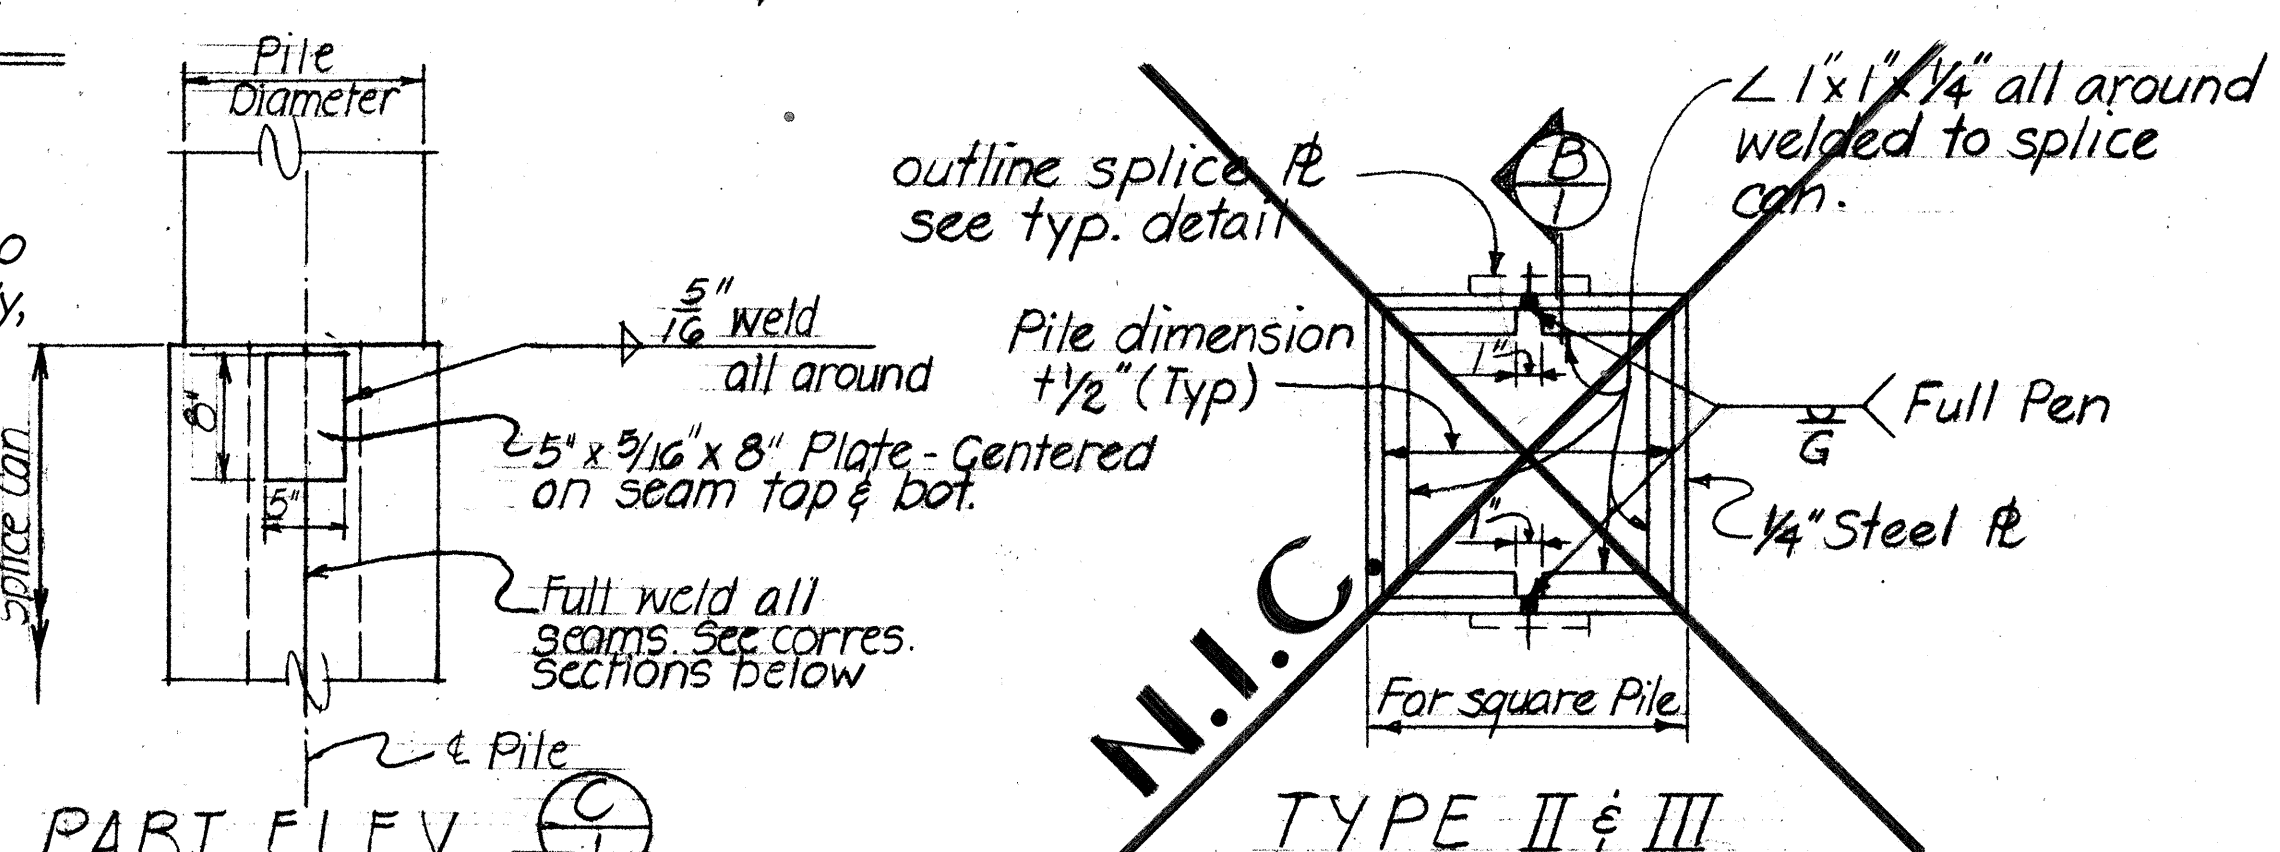


NOTE:
1. Splice detail shown above shall not be used except for pile length in excess of 100'-0" long.
2. Structural steel for splice can shall be ASTM A36.

Max. Length "L" *	Max. Length "L" *	Length "L" *
Type I "L" = 53'-0"	Type I "L" = 75'-0"	Type I "L" over 75'-0"
12" Type II "L" = 50'-0"	12" Type II "L" = 72'-0"	12" Type II "L" over 72'-0"
10" Type III "L" = 46'-0"	10" Type III "L" = 66'-0"	10" Type III "L" over 66'-0"
0.30 L 0.70 L	0.21 L 0.58 L 0.21 L	0.15 L 0.35 L 0.35 L 0.15 L

*The length "L" is the distance end to end of pile.

1 POINT PICK-UP 2 POINT PICK-UP 3 POINT PICK-UP

NOTE: Unless special lifting devices are attached for pick-up points, pick-up points shall be plainly marked on all piles after removal of the forms and all lifting shall be done at these points. The use of special embedded or attached lifting devices, the employment of other pick-up points or any other method of pick-up shall be subject to approval by the Engineer.

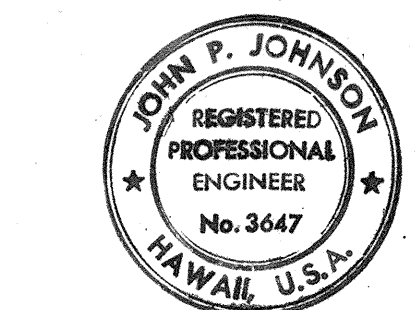


THIS WORK WAS PREPARED BY ME OR UNDER MY SUPERVISION AND CONSTRUCTION OF THIS PROJECT WILL BE UNDER MY SUPERVISION.


STATE OF HAWAII
DEPARTMENT OF TRANSPORTATION
HIGHWAYS DIVISION
PRESTRESSED CONCRETE PILES
DETAILS
FORT WEAVER ROAD
ROUTE H-1 TO SOUTH OF
FARRINGTON HIGHWAY
PROJECT NO. M-7600(1)
SCALE: NONE DATE: AUG. 1978
SHEET No. S-14 OF S-16 SHEETS

FED. ROAD DIST. NO.	STATE	FED. AID PROJ. NO.	FISCAL YEAR	SHEET NO.	TOTAL SHEETS
HAWAII	HAW.	M-7600(1)	1978	146	198

2'-6" min. unless otherwise directed by the Engineer.
Remove concrete after driving, leaving reinf. exposed.
Chamfer - See Typical Pile Detail.

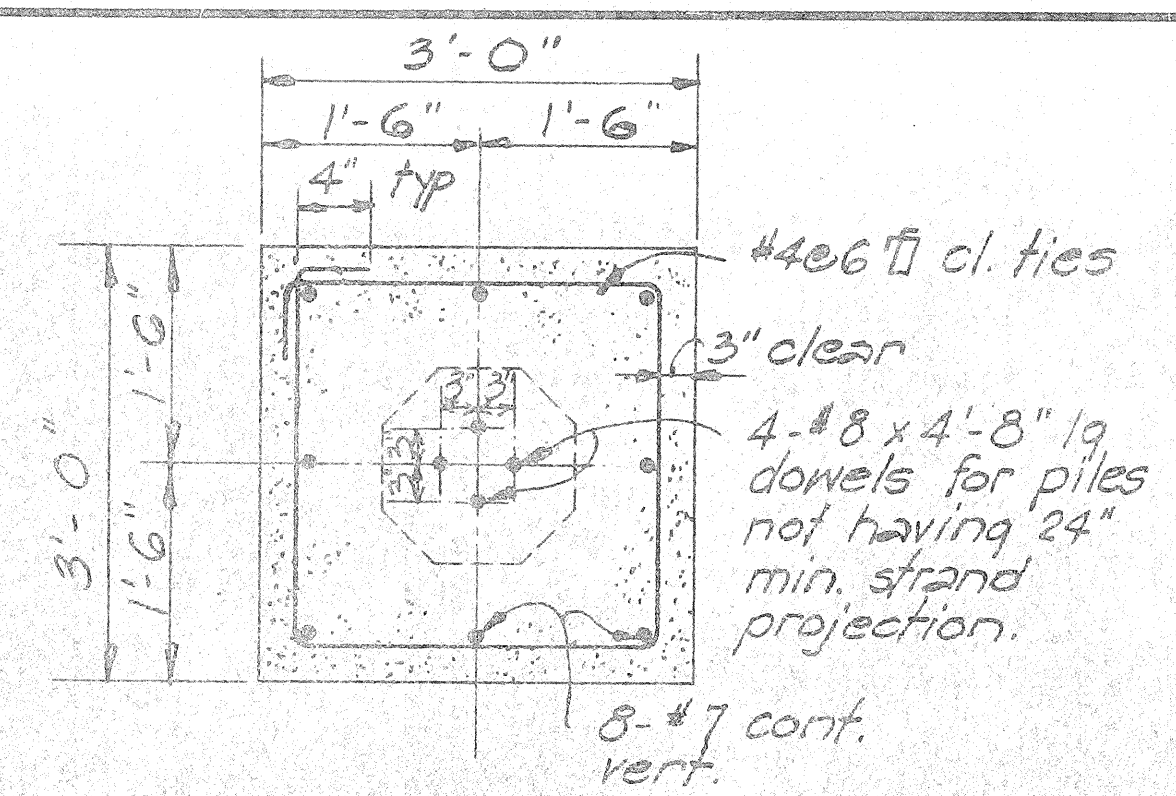


SQUARE BUILD-UP

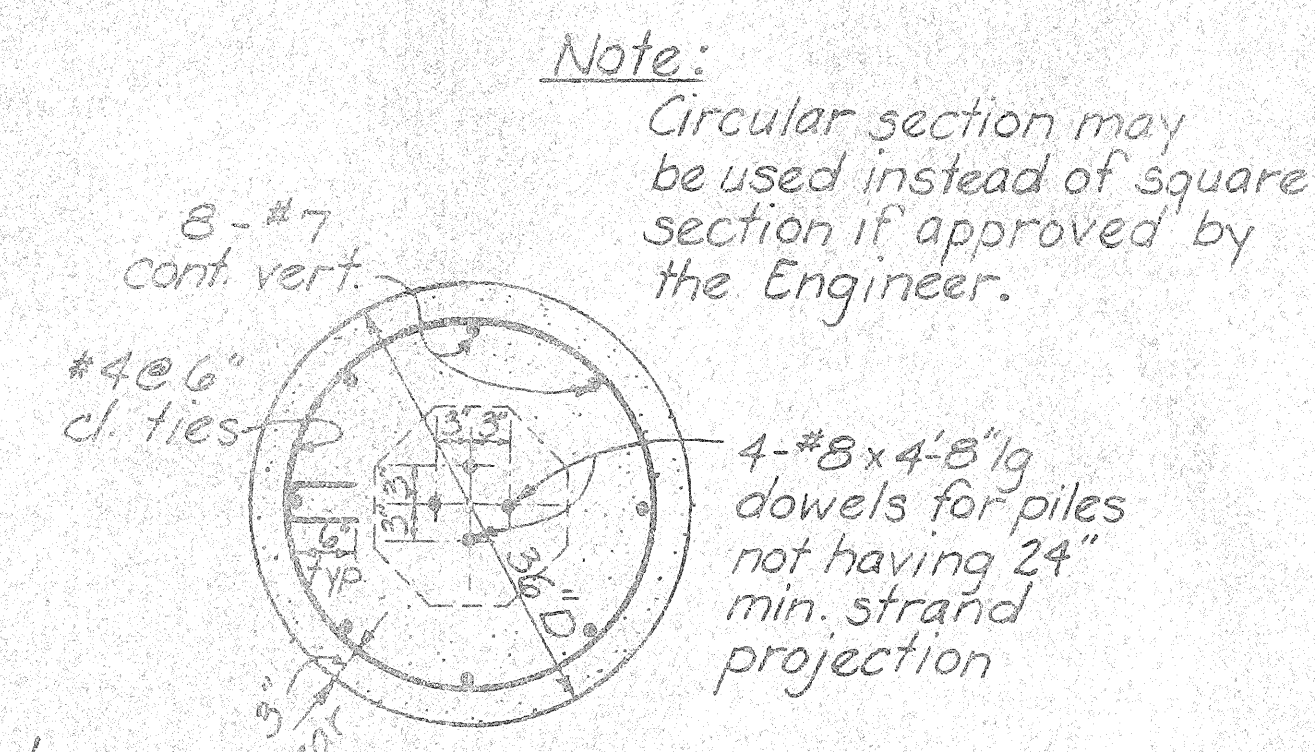

CIRCULAR BUILD-UP SECTION (A/2)

Note:
Circular section may be used instead of square section if approved by the Engineer.

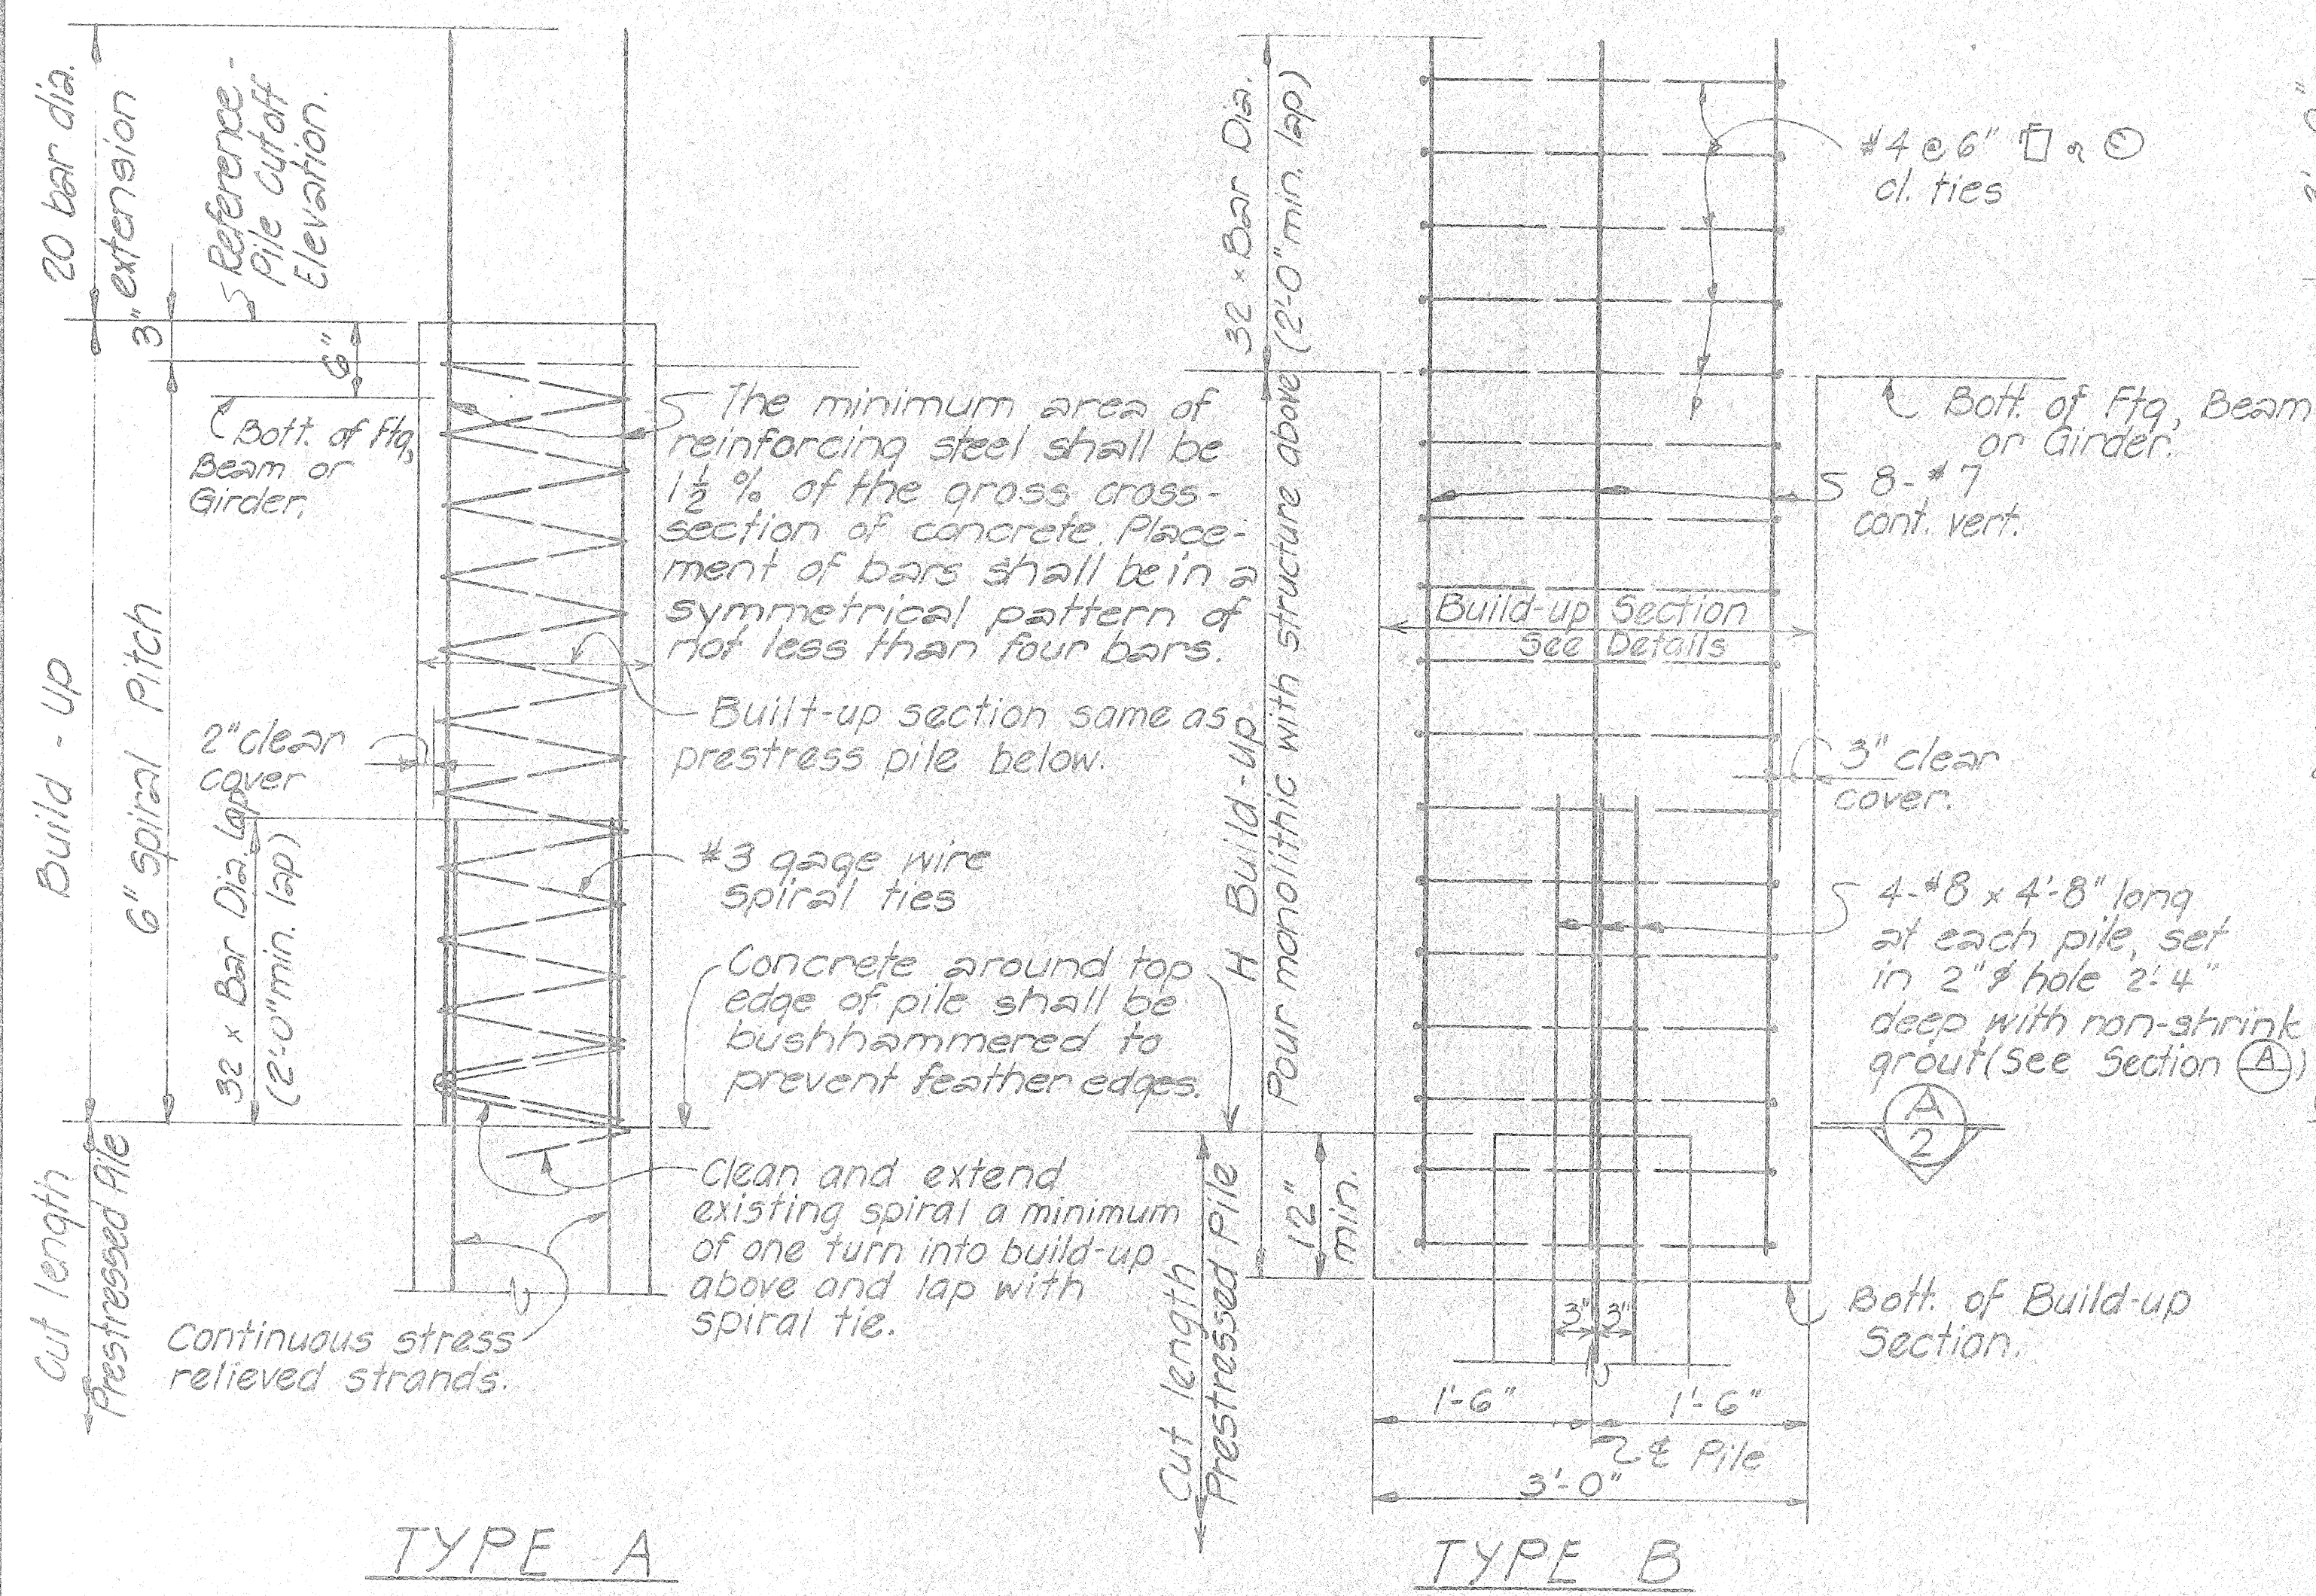

TYPE A

TYPE B


Notes:
Selection of pile build-up type without driving to be determined by the Engineer.
When height of depressed portion of footing (H) exceeds 4", the depressed section shall be poured separately from the main body of the footing.
Depressed portion of footing may be omitted for pile heads embedded at least 4" into footing provided at least 90% of the piles in each footing have the minimum embedment into footing as shown in contract plans.

WITHOUT DRIVING
TYPICAL PILE BUILD-UP DETAILS

GENERAL NOTES

1. Work of cutting off prestressed conc. piles or concrete build-ups shall be performed in such a manner as to avoid spalling or damaging the pile below cut-off. In case of such damage, the pile shall be replaced or repaired by the Contractor at his expense as directed by the Engineer.
2. Portion of pile embedded into footing shall be of sound concrete. Damaged portions shall be removed and pile cut-off elevation lowered as required by the Engineer.

WITH DRIVING
TYPICAL PILE BUILD-UP DETAIL

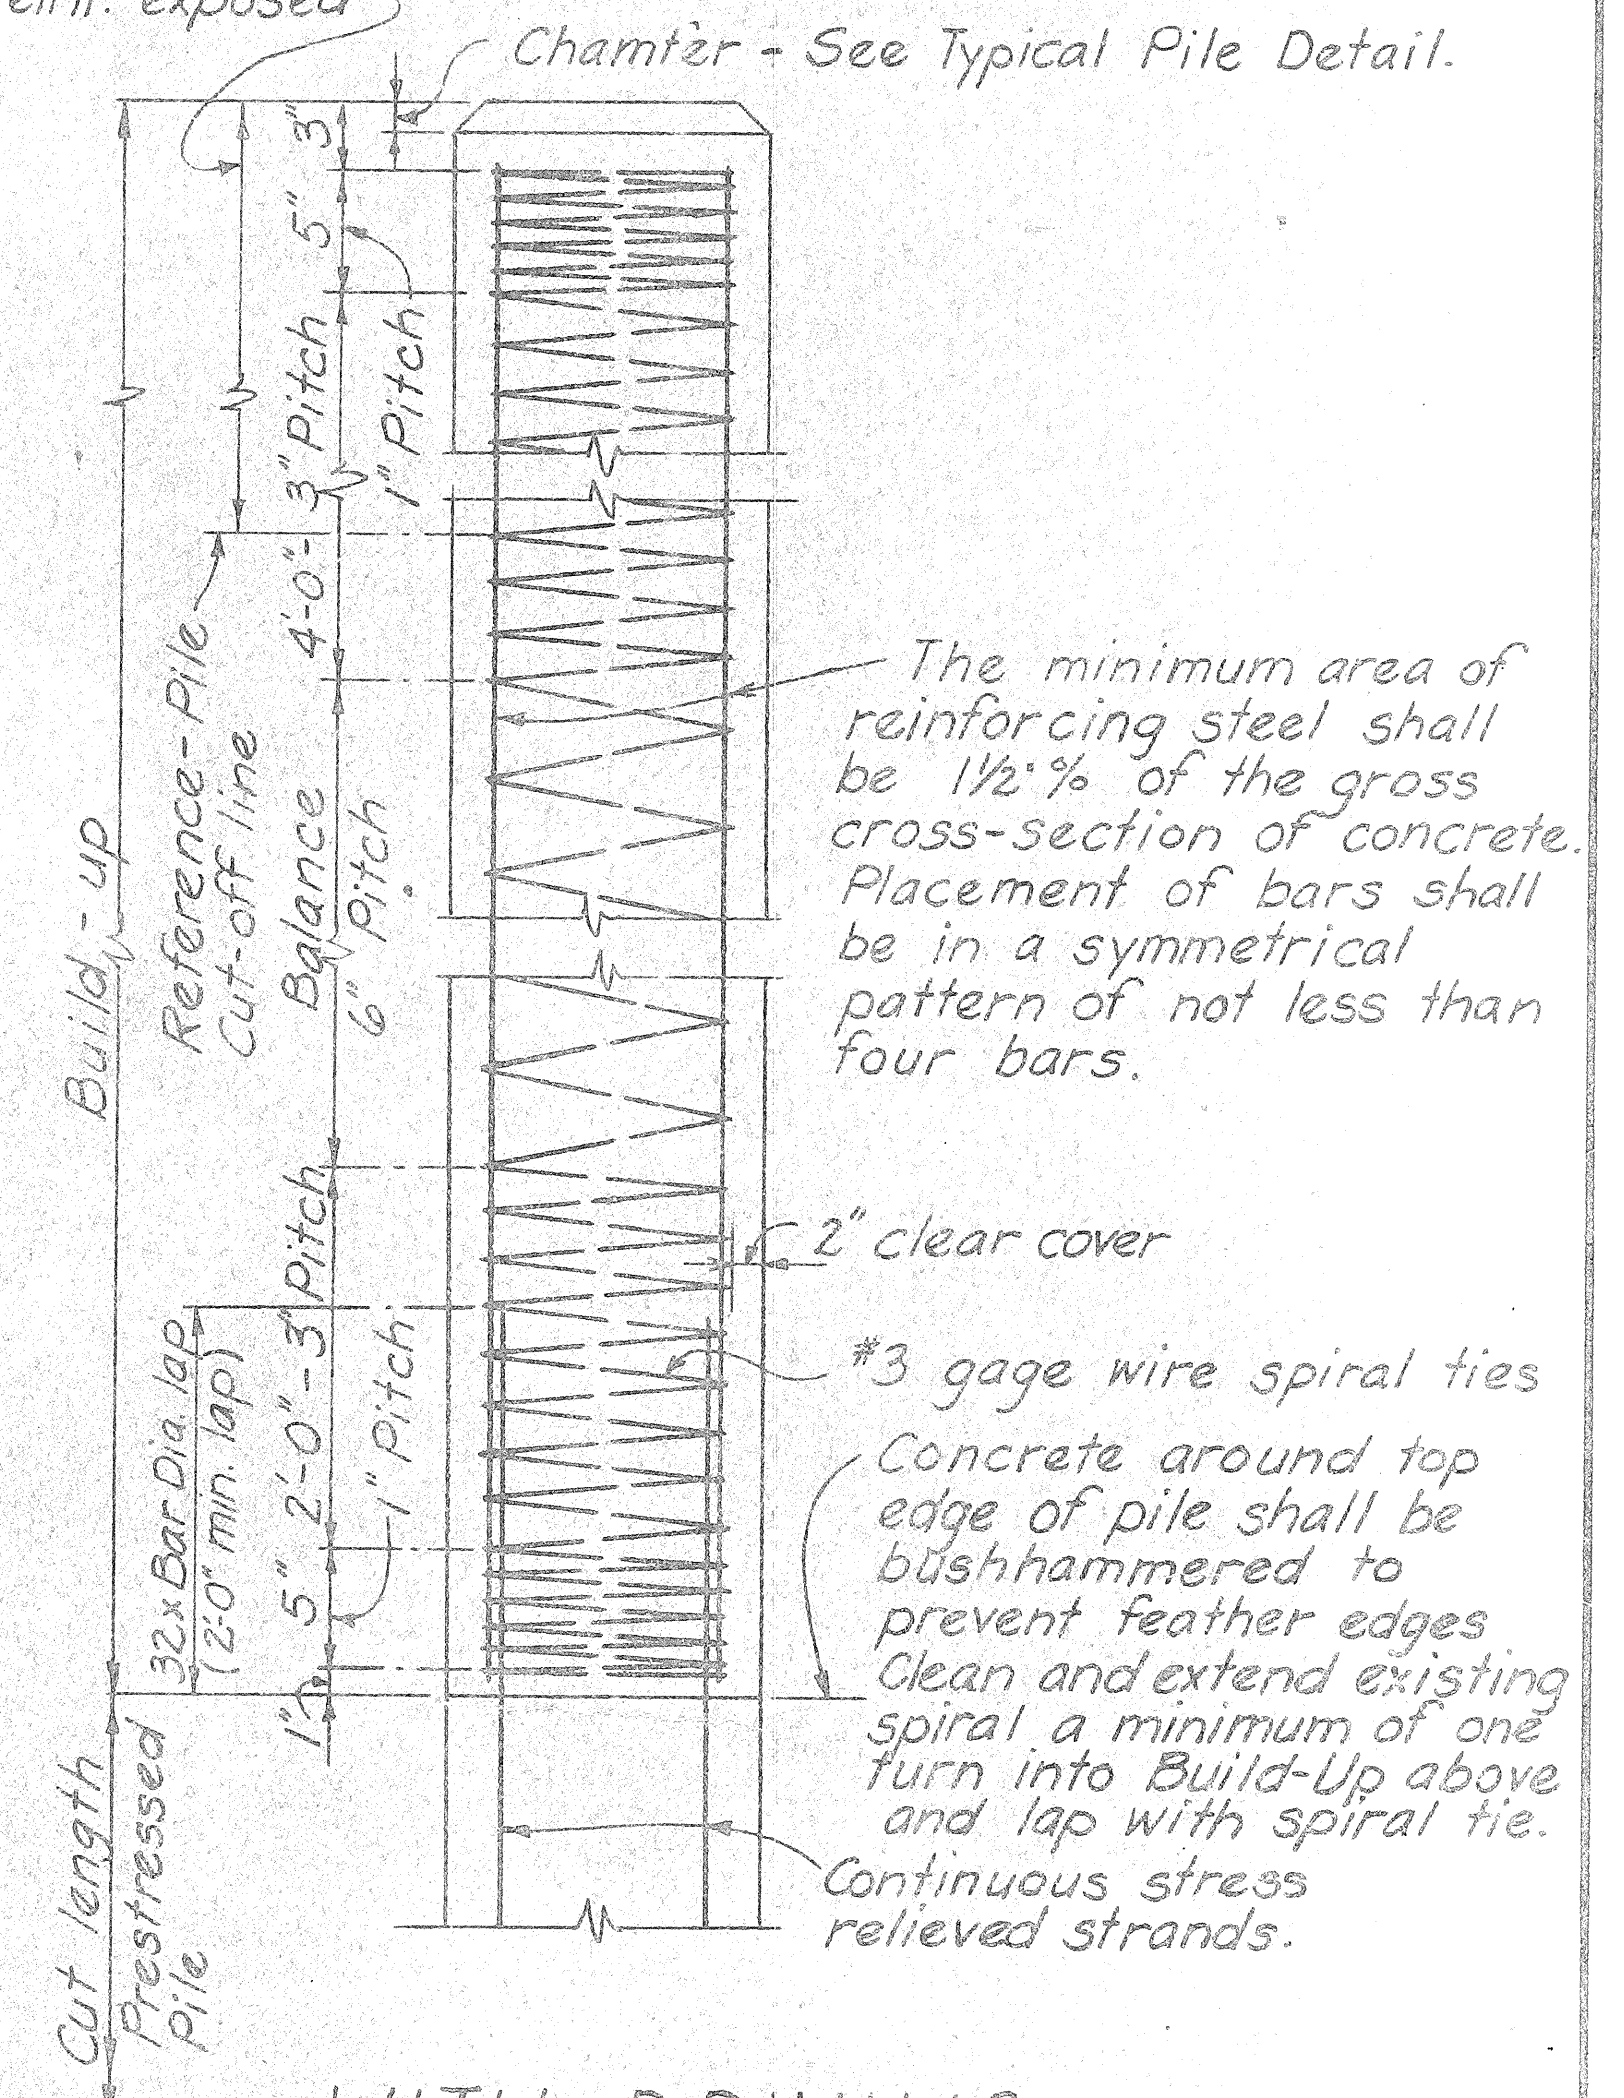


APPROVAL RECOMMENDED:
Paul T. Yamashita 1-23-70
BRIDGE DESIGN ENGINEER DATE
APPROVED
Paul T. Yamashita 1-28-70
ASSISTANT CHIEF, ENGINEERING DATE


NO	REVISION	APPROVED BY	DATE

STATE OF HAWAII
DEPARTMENT OF TRANSPORTATION
HIGHWAYS DIVISION
STANDARD DETAILS
PRESTRESSED CONCRETE PILES
Date: Oct. 1968
SHEET No. S-15 OF S-16 SHEETS DB-300-2


FED. ROAD DIST. NO.	STATE	FED. AID PROJ. NO.	FISCAL YEAR	SHEET NO.	TOTAL SHEETS
HAWAII	HAW.	H-7600(1)	1981	50.147	198

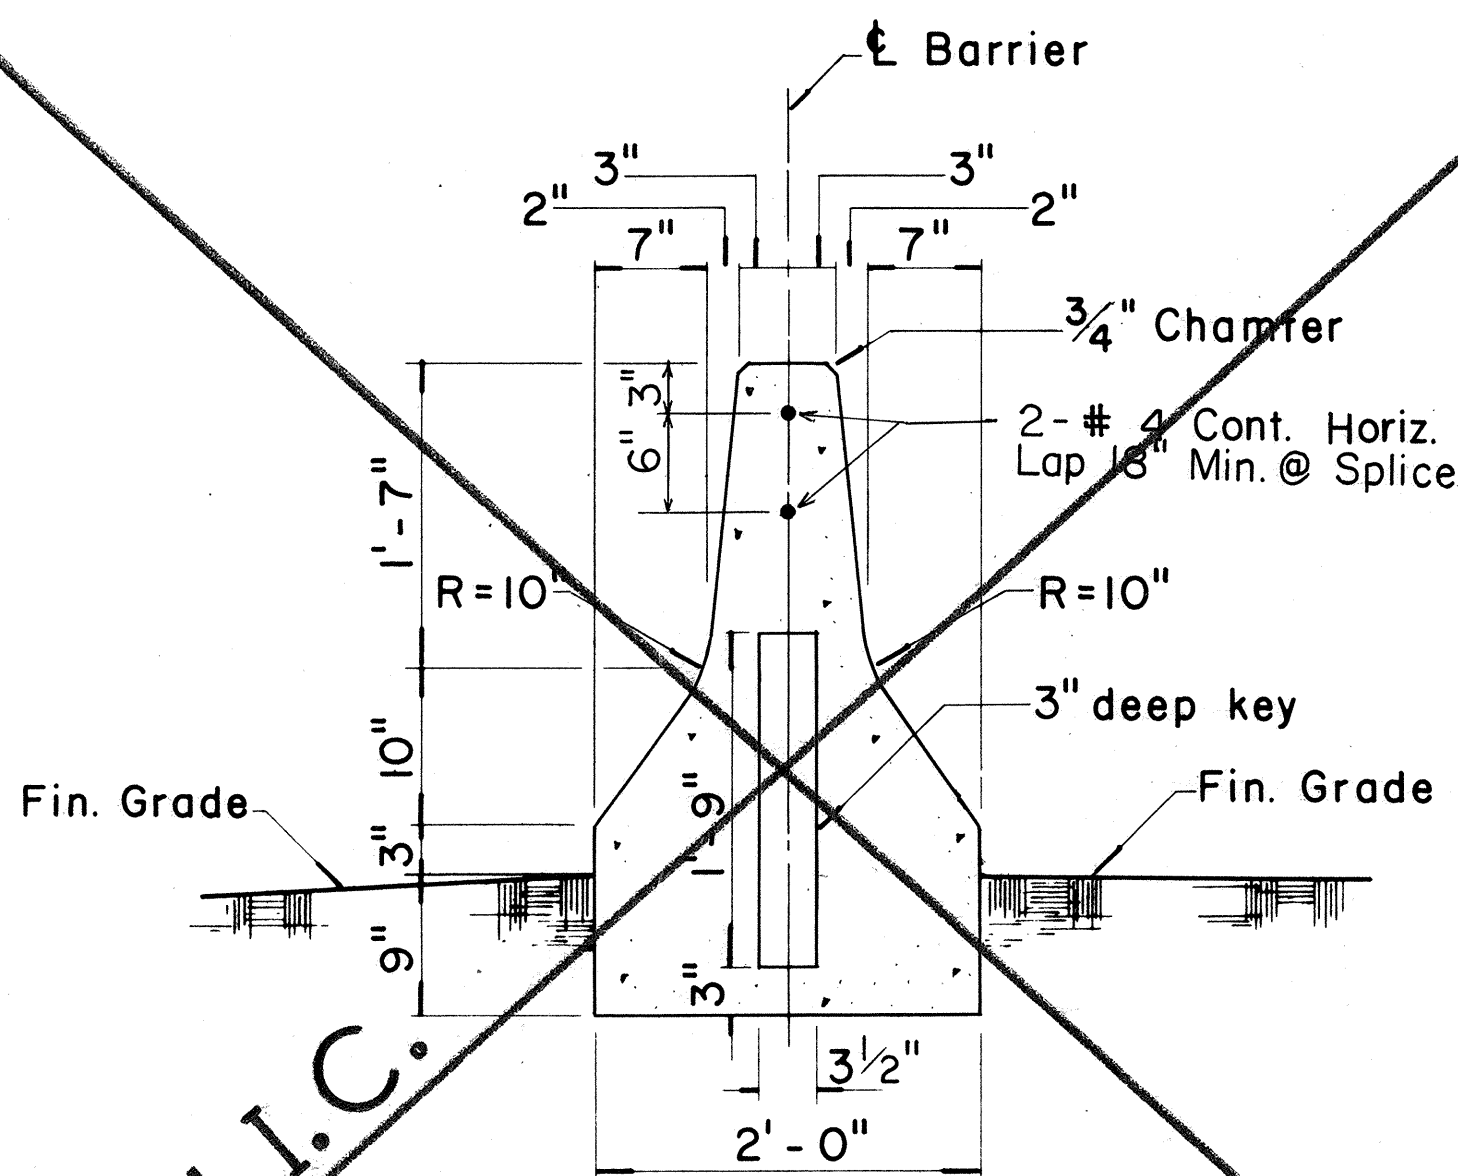

TYPE 4A
Scale: 1" = 1'-0"

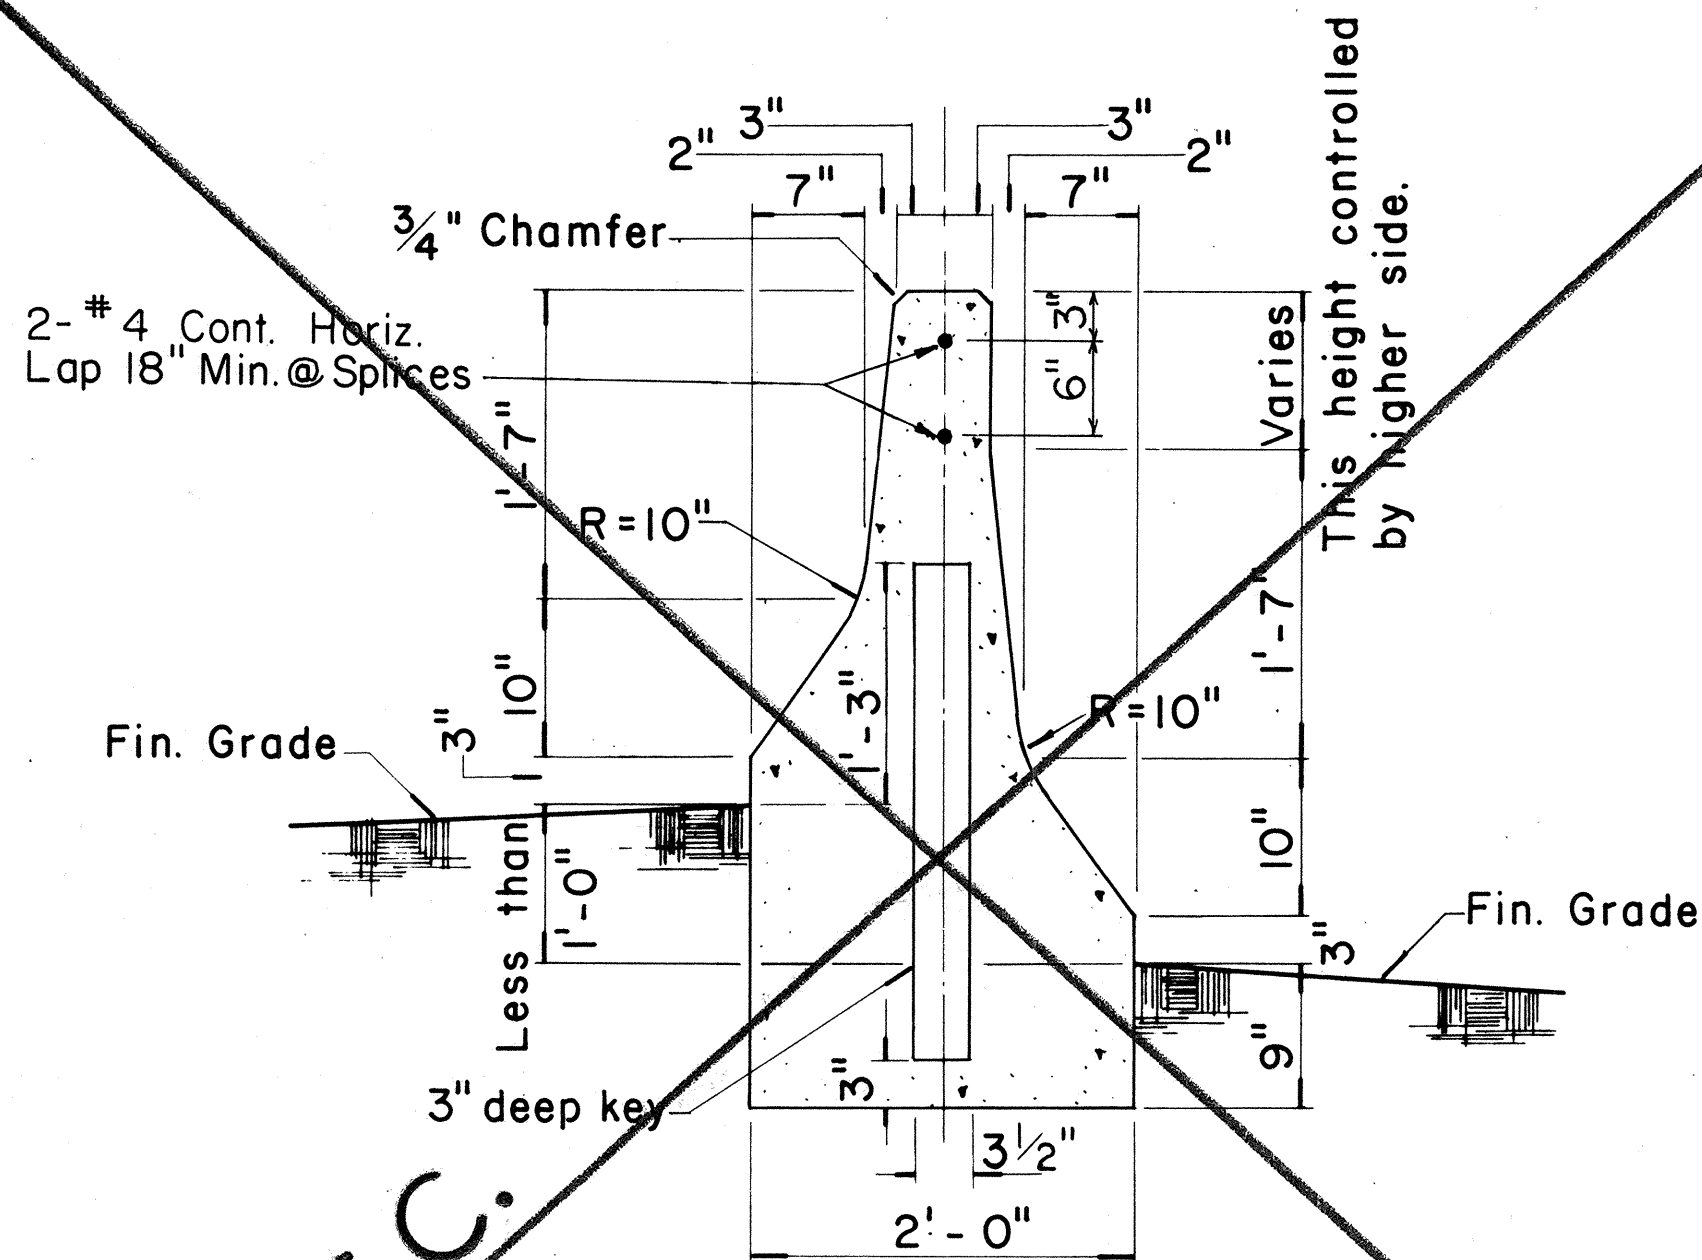

TYPE 4B
Scale: 1" = 1'-0"

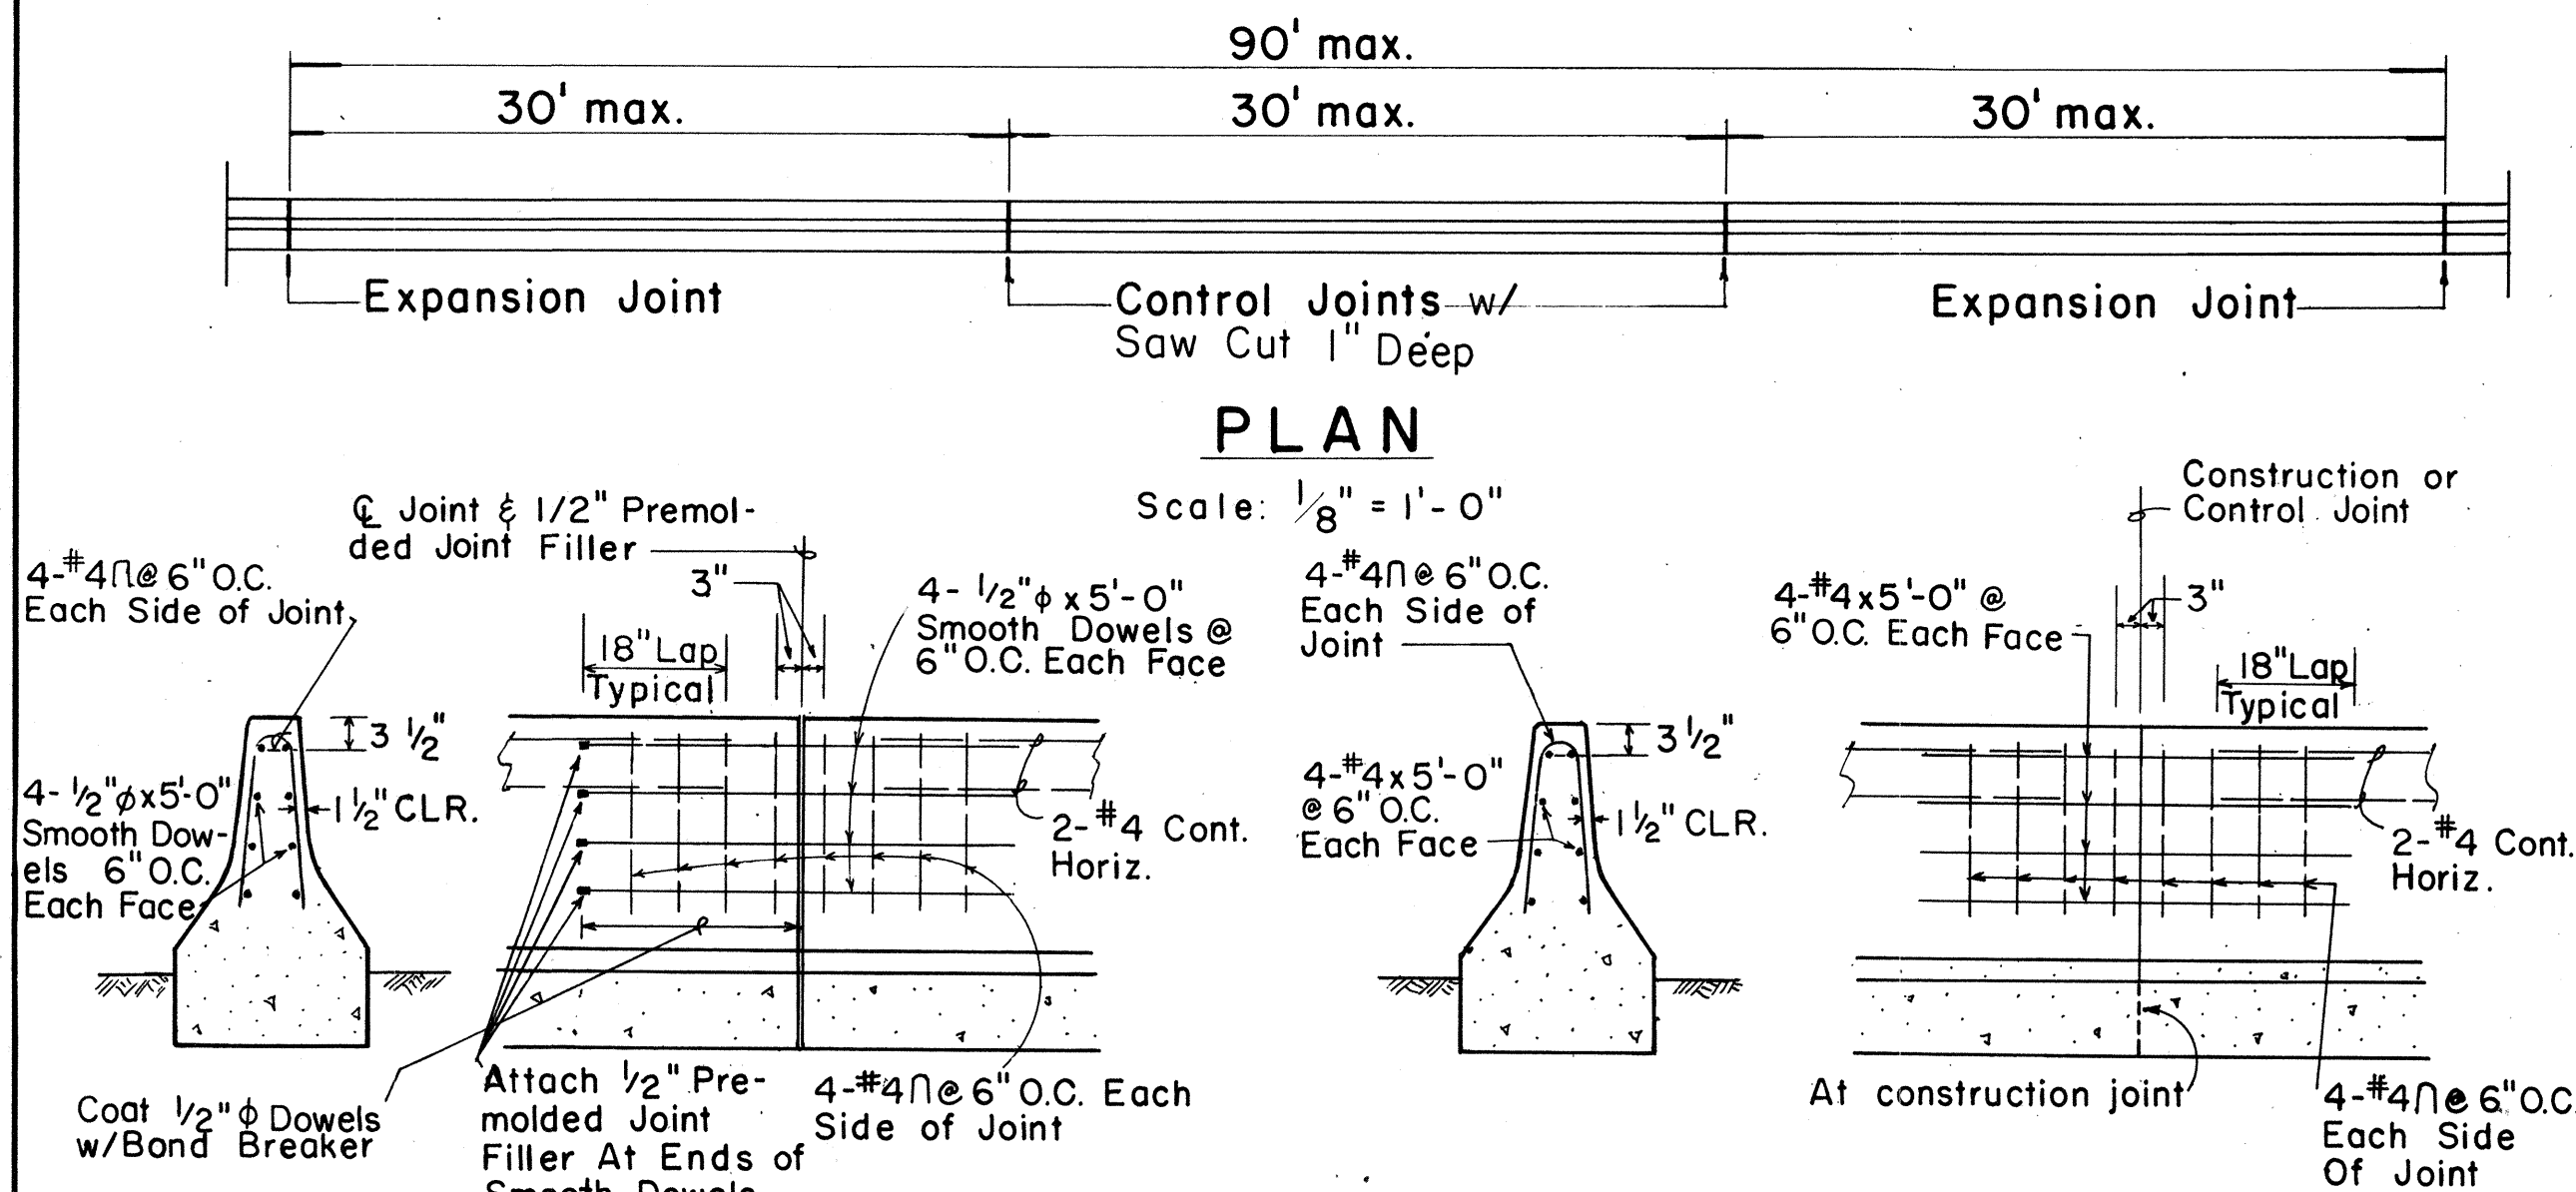


SECTION ELEVATION
EXPANSION JOINT DETAIL
SCALE: 1/2" = 1'-0"

SECTION ELEVATION
CONSTRUCTION & CONTROL JOINT DETAIL
SCALE: 1/2" = 1'-0"

GENERAL NOTES

- Precast Rigid Barrier Guard Rail may be installed as an option to cast-in-place Type 4 Rigid Barrier Guard Rail. Contractor shall submit shop drawings to Engineer for approval.
- Expansion Joints shall be constructed at ninety-foot (90 ft.) maximum intervals and at existing expansion joints of structures. (Use 1/2" pre-molded joint filler, incidental to Type 4 Rigid Barrier Guard Rail). Control Joints shall be placed between expansion joints at 30' maximum. Shear keys shall be required at all construction joints.
- The exterior surface and vertical alignment of the Type 4 Rigid Barrier Guard Rail shall be constructed to give a uniform and presentable appearance. Variation of more than 1/4" in 20' max. and 1/2" in 40' or more will be considered objectionable. The Engineer will determine the acceptability of the work. During the course of the work, samples may be tested and measurements made to establish whether or not the specified values or dimensions are being met. If the specified values or dimensions are not being met, the Engineer will determine the degree of the non-conformance, the effect on the serviceability of the project, whether the work be accepted and remain in place and, if so, the amount to be paid for such work, or whether the work shall be removed and replaced or otherwise corrected at the Contractor's expense.

NOTE: 1/2" PREMOLDED JOINT FILLER IS NOT REQUIRED AT CONSTRUCTION JOINTS.

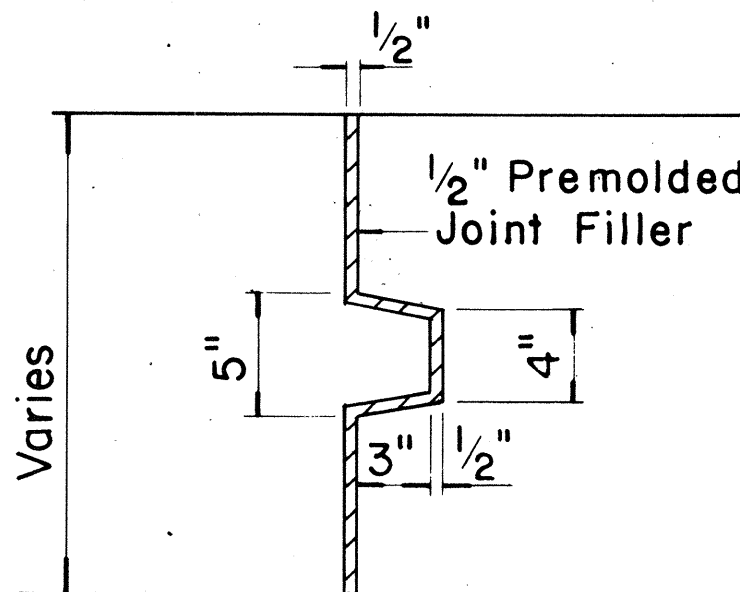

SECTION THRU KEY
AT EXPANSION JOINT

Scale: 1/2" = 1'-0"

APPROVAL RECOMMENDED:
Erich Tanaka
TRAFFIC ENGINEER
2/10/12
DATE


APPROVED:
Mubet Zalsin
ASSISTANT CHIEF, ENGINEERING
2/10/12
DATE

STATE OF HAWAII
DEPARTMENT OF TRANSPORTATION
HIGHWAYS DIVISION

STANDARD DETAILS GUARD RAIL TYPE 4 (RIGID BARRIER)

Scale: As Shown
SHEET No. / OF / SHEETS
DT 521


NO.	REVISION	APPROVED BY	DATE
1	Supersede Sht. DT 521 Approved 12-30-69	H.T.	2/10/12
2	Added No. 4 Steel Reinforcing Bar. Change Dimension on Type 4C & 4D Detail	H.T.	8/16/11
3	Added additional Reinforcing Bars and Revised Control & Expansion Joints	H.T.	6/25/80

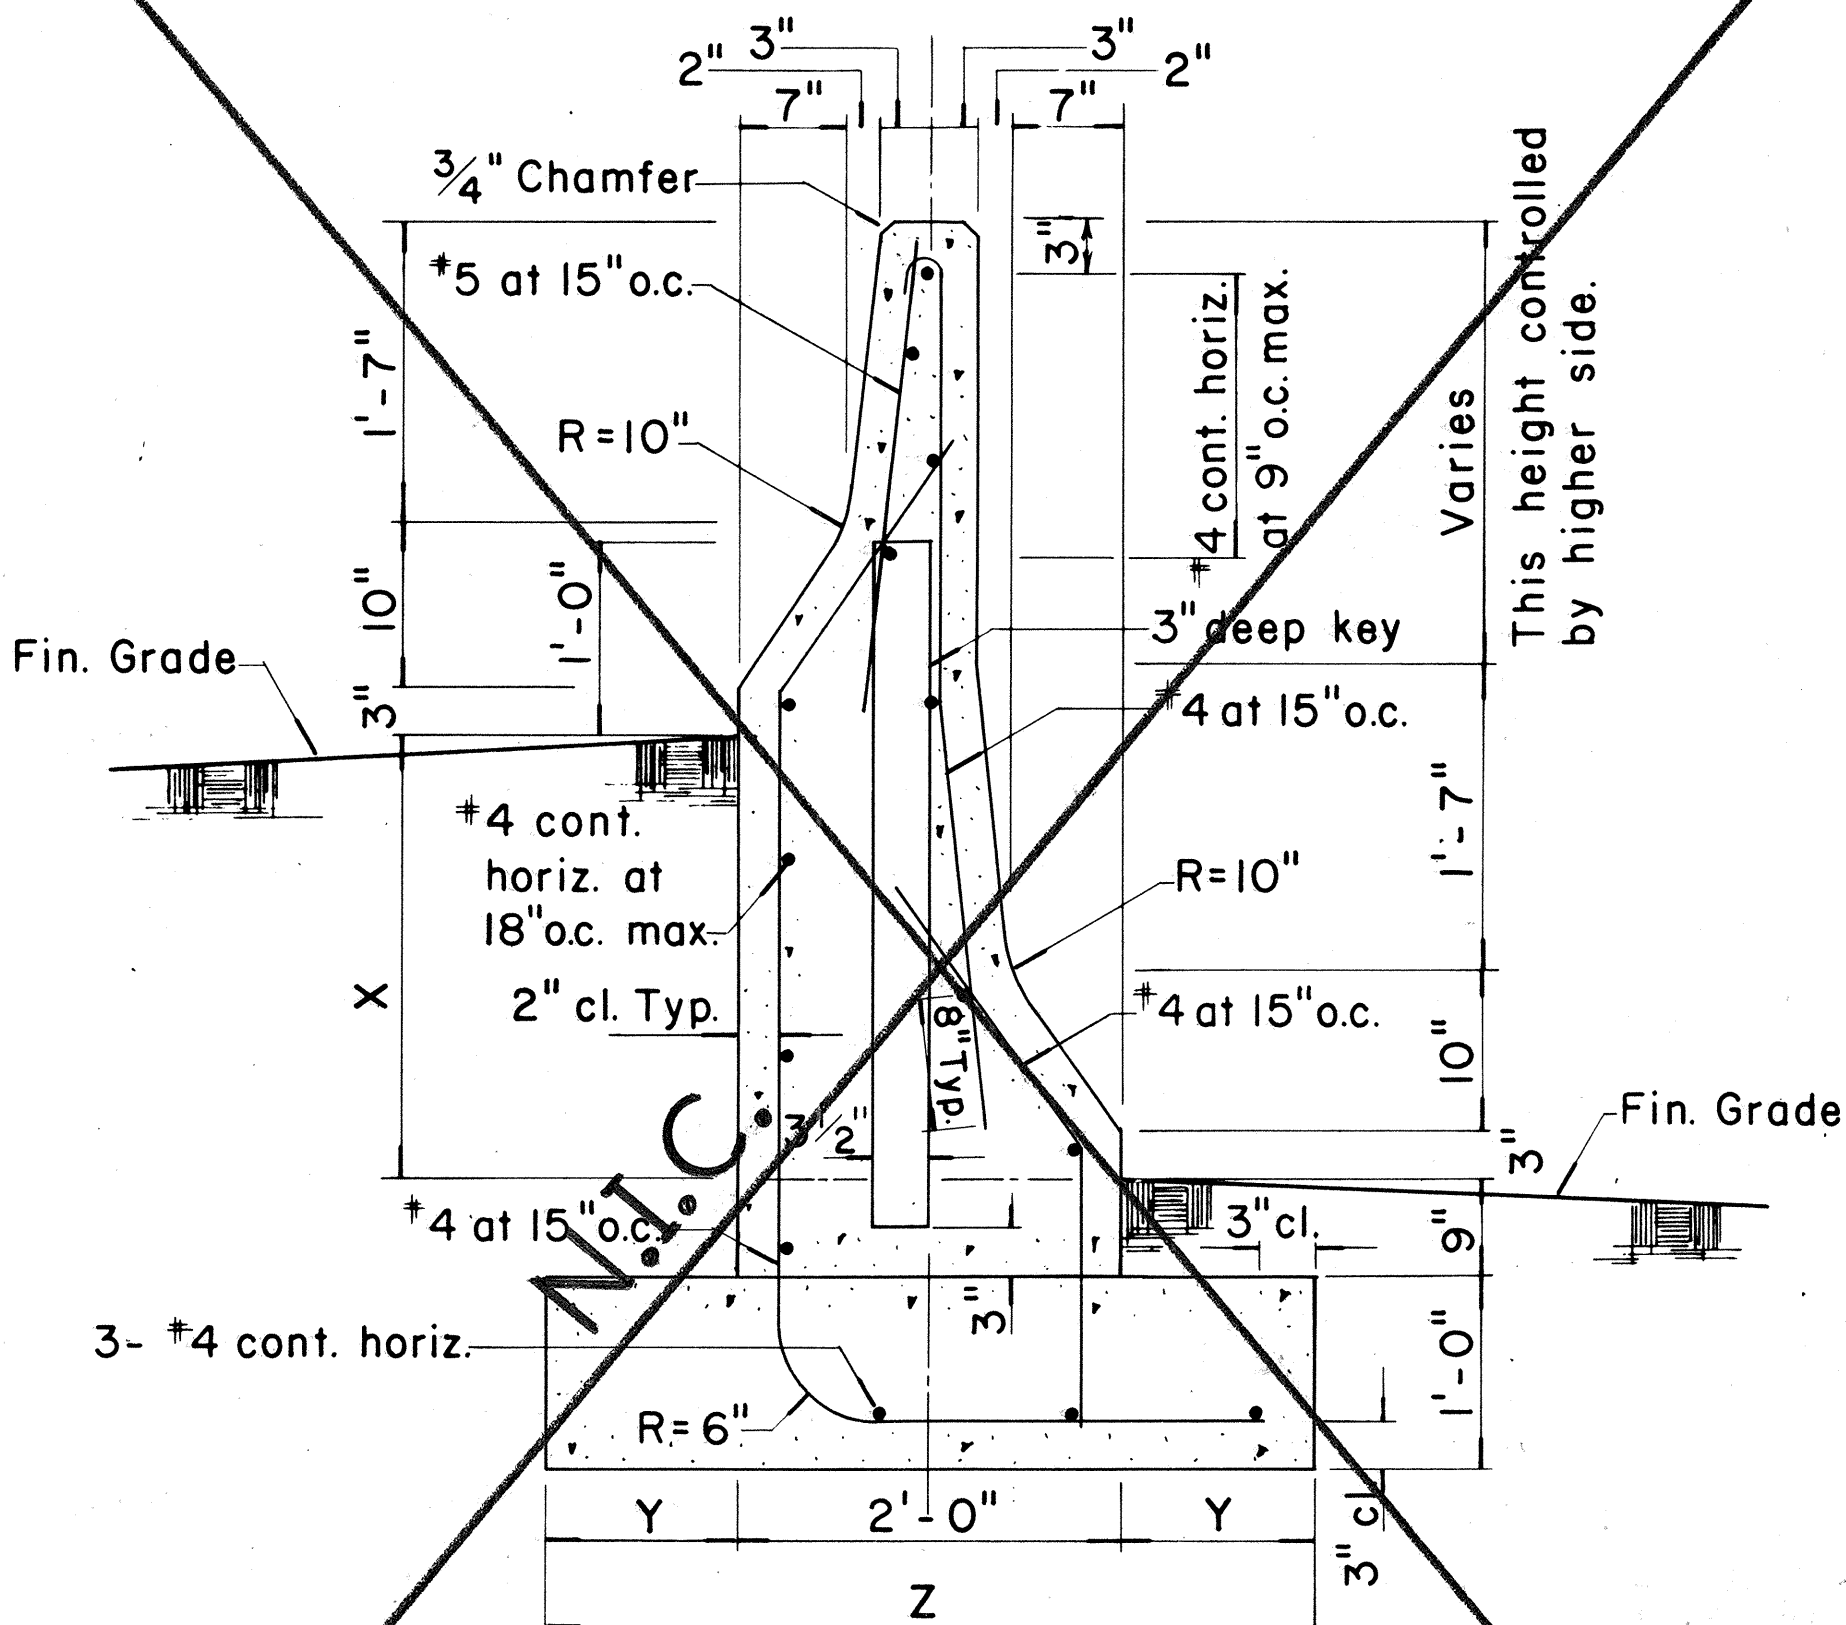

TYPE 4C & TYPE 4D
Scale: 1" = 1'-0"

TYPE	DIFFERENCE IN FIN. GRADE	FOOTING
	X	Y Z
4C	1'-0" min., 2'-4" max.	1'-0" 4'-0"
4D	Greater than 2'-4", 4'-4" max.	1'-3" 4'-6"

NOTE:
Except where noted all dimensions shall be the same for Type 4C and Type 4D.

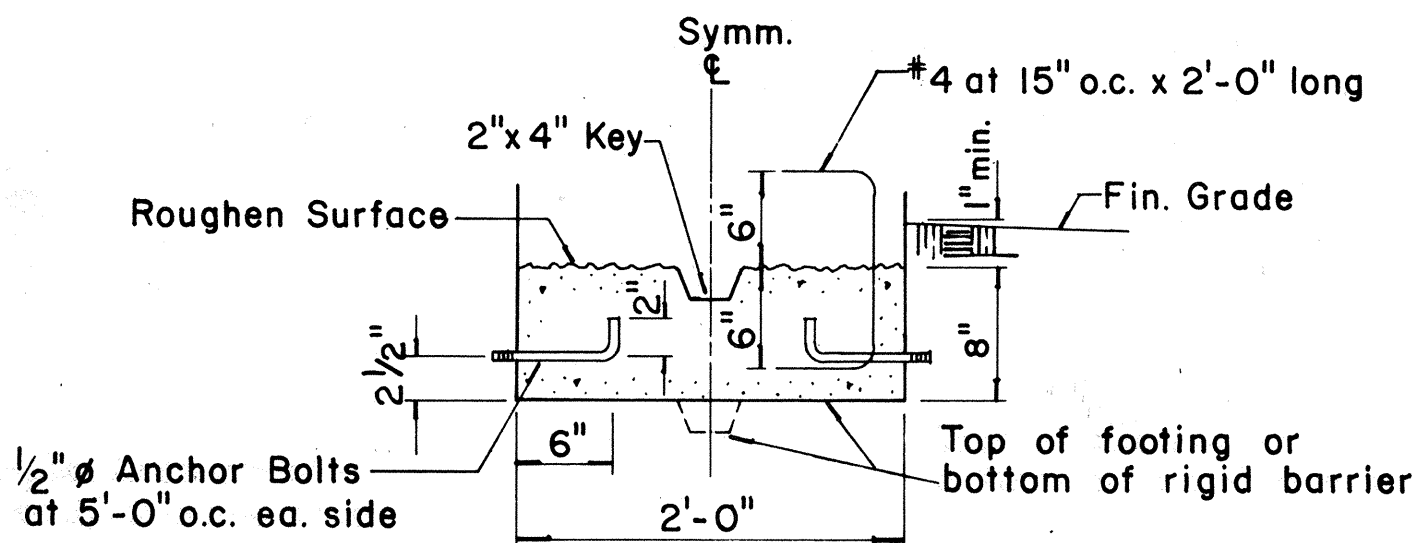

OPTIONAL CONSTRUCTION
JOINT DETAILS
Scale: 1" = 1'-0"

NOTE:
The intent of the optional construction joint details for the Type 4 Rigid Barrier Guard Rail is to provide a method of securing the forms and preventing uplift so that the barrier will have a uniform and presentable appearance. The Contractor may submit an alternate method of constructing the barrier for the approval of the Engineer and for use on a trial basis. Any unsatisfactory work shall be removed or corrected as directed by the Engineer and at the Contractor's expense.

7-10-80	Replaces Superseded Standard Detail DT-521.
DATE	REVISION