
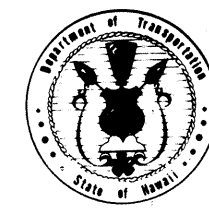


| INDEX TO DRAWINGS |                                             |
|-------------------|---------------------------------------------|
| SHEET NO.         | DESCRIPTION                                 |
| 1                 | TITLE                                       |
| 2                 | GENERAL PLAN                                |
| 3-4               | TYPICAL SECTIONS                            |
| 5-9               | ALIGNMENT PLANS                             |
| 10-17             | PROFILES & S.E. DIAGRAMS                    |
| 18-21             | RAMP TERMINAL DETAILS                       |
| 22-56&22A         | GRADING, DRAINAGE & CONSTR.                 |
|                   | PLANS AND DETAILS                           |
| 57-58             | RETAINING WALL DETAILS                      |
| 59-66             | CONSTRUCTION SEQUENCE AND TEMPORARY SIGNING |
| 67-88             | SIGNING & STRIPING PLANS                    |
| 89-99&93A         | LIGHTING & SIGNAL PLANS                     |
| *100-131          | UTILITY PLANS & DETAILS                     |
| 132-147           | STRUCTURE PLANS & DETAILS                   |
| 148-149           | CROSS SECTION KEY                           |
| 150-194           | CROSS SECTIONS                              |
| *114&117A         | UTILITY PLANS & DETAILS                     |

SUPPLEMENTARY SHEETS TO THIS PROJECT ARE SHEET NOS.

- (a) C.O. 4 S-1  
(b) 21 S-1  
(c) C.O. 28 S-1, C.O. 31 S-1, S-2, S-3, S-4, S-5, S-6 & S-7, ADD. 40 S-1, ADD. 47 S-1, C.O. 56 S-1 & S-2  
(d) C.O. 68 S-1  
(e) C.O. 95 S-1, C.O. 96 S-1 & S-2  
(f) 104 S-1

TOTAL SHEET COUNT AFTER "AS-BUILT" POSTINGS: 217 SHEETS

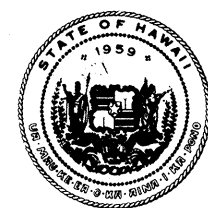

STATE OF HAWAII  
DEPARTMENT OF TRANSPORTATION  
LAND TRANSPORTATION FACILITIES DIVISION

HONOLULU, HAWAII

"AS-BUILT"  
PLANS FOR

CONSTRUCTION OF A PORTION OF  
**FORT WEAVER ROAD REALIGNMENT AND WIDENING**  
ROUTE H-1 TO SOUTH OF FARRINGTON HIGHWAY

FEDERAL AID URBAN SYSTEM PROJECT NO. M-7600(1)

DISTRICT OF EWA  
ISLAND OF OAHU

ALL CHANGES MADE DURING CONSTRUCTION HAVE BEEN INCORPORATED ON THESE PLANS IN RED EXCEPT CHANGES IN THE ORIGINAL THEORETICAL QUANTITIES. FOR ACTUAL QUANTITIES, REFER TO PROJECT LEDGER AND/OR COMPUTATION BOOK.

RESIDENT ENGINEER

DATE

**DESIGN CLASSIFICATION**


DESIGN ADT (1998).....34,800  
DHV.....3200  
D.....55/45  
T.....3 %  
V.....50 MPH

**SCALES**



PLANS.....HOR. 1" = 50'  
PROFILES.....HOR. 1" = 50'  
VER. 1" = 10'  
DETAIL ROADWAY PLANS....HOR. 1" = 20'  
CROSS SECTIONS.....HOR. 1" = 10'  
VER. 1" = 10'

DEPARTMENT OF TRANSPORTATION  
FEDERAL HIGHWAY ADMINISTRATION  
APPROVED:  
DIVISION ADMINISTRATOR  
DATE 9/21/78

DEPARTMENT OF TRANSPORTATION  
STATE OF HAWAII  
APPROVED:  
DIR. OF TRANSPORTATION  
DATE 8/29/78

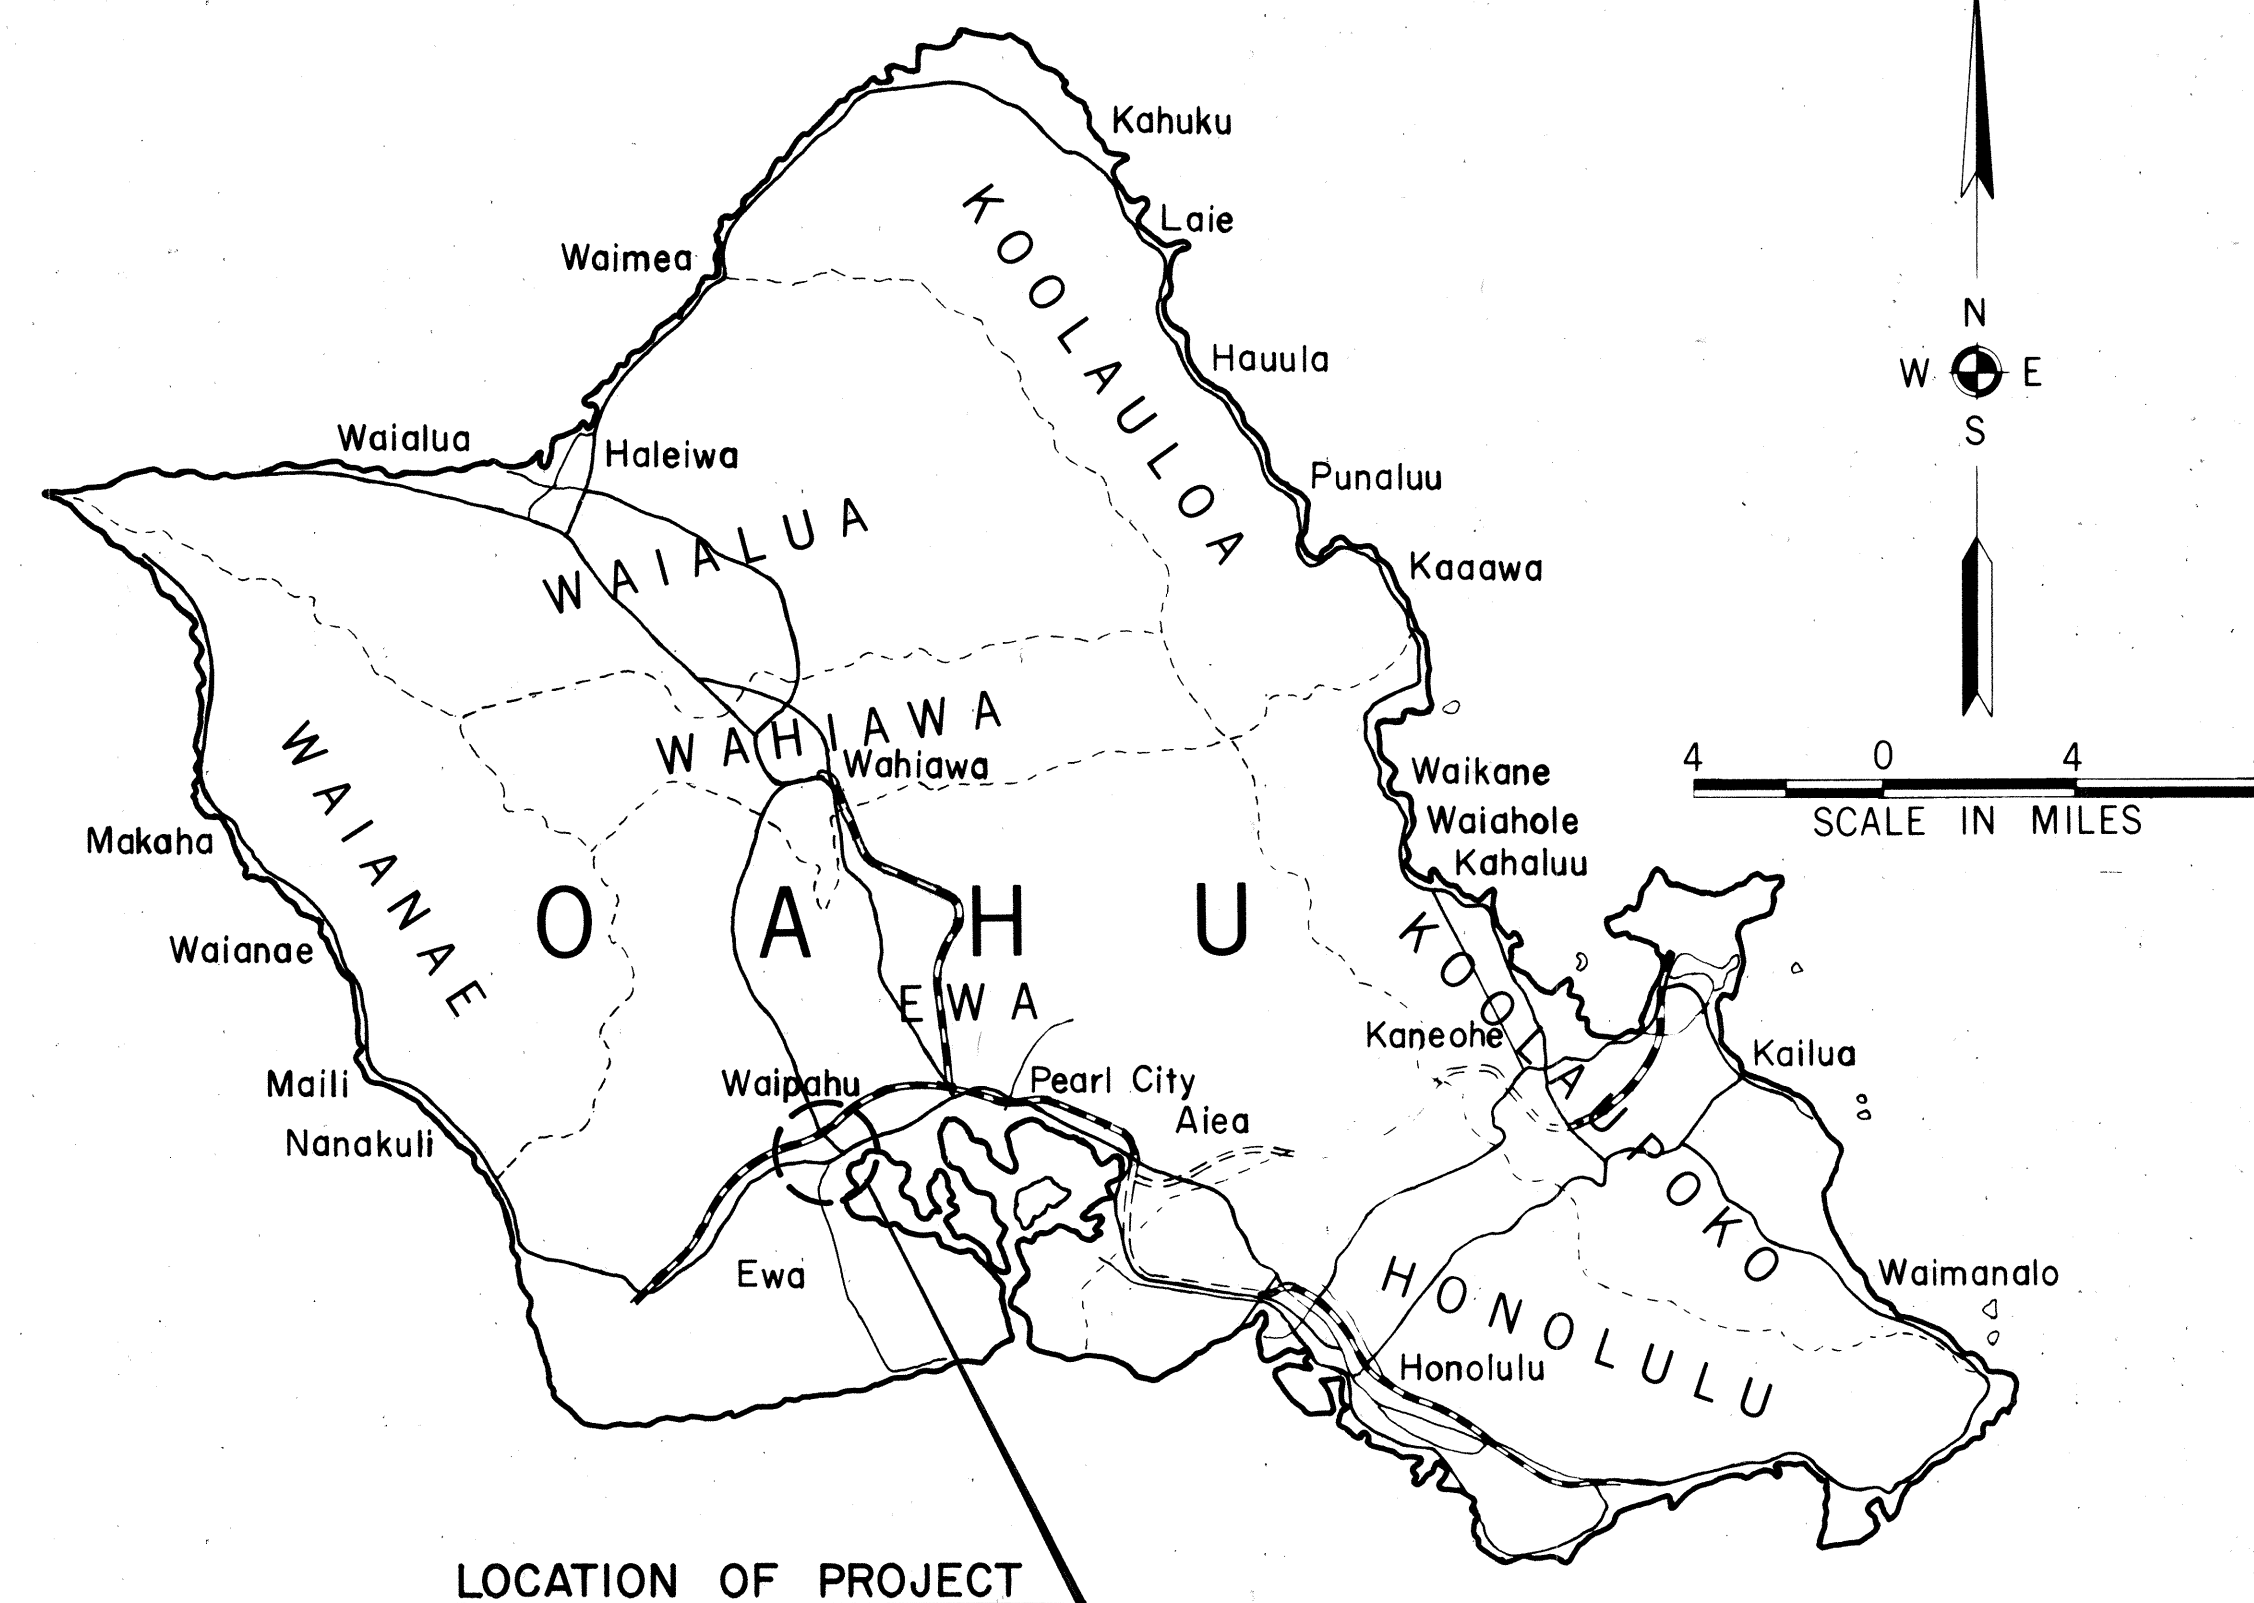

Federal Aid Interstate Projects Previously Constructed or Under Construction

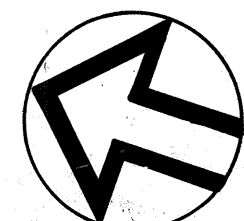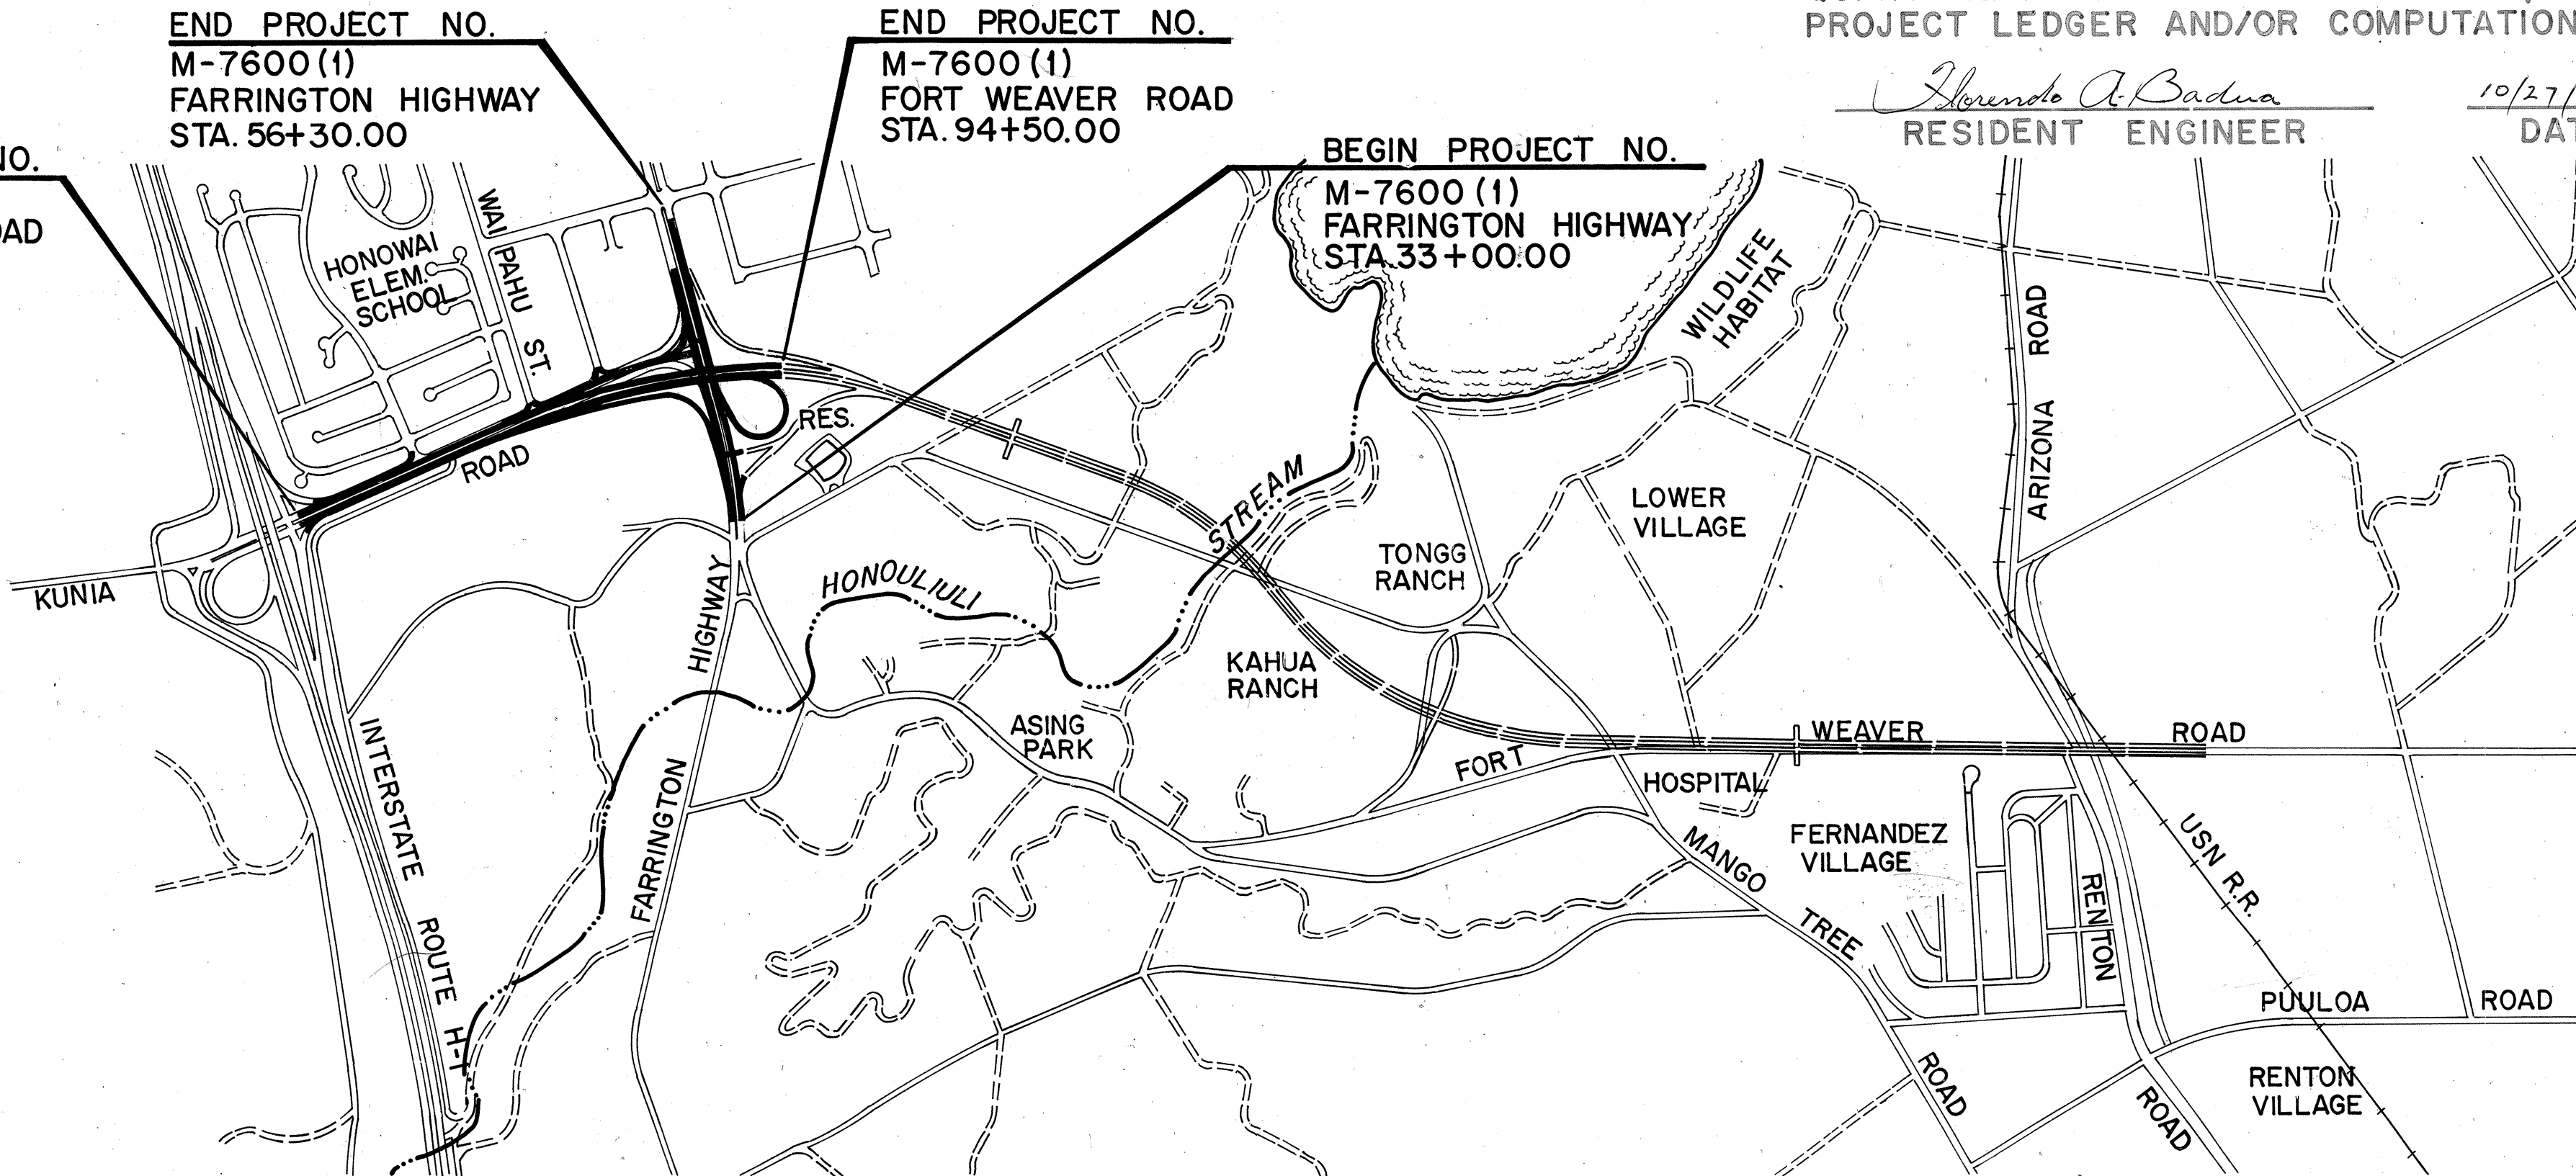

0 1000 2000 3000  
GRAPHIC SCALE IN FEET

**LAYOUT PLAN**

GROSS LENGTH OF PROJECT 0.70 MI.  
BRIDGE 0.05 MI.  
NET LENGTH OF ROADWAY 0.65 MI.

PBQ&D  
DESIGNED BY  
D. LEE  
P. S. & E. BY  
548-7532  
15 AUG 78  
DATE