

FED. ROAD DIST. NO.	STATE	FED. AID PROJ. NO.	FISCAL YEAR	SHEET NO.	TOTAL SHEETS
HAWAII	HAW.	M-7600(1)	1978	100	198

GENERAL UTILITY NOTES (ALL UTILITIES)

- The Contractor shall be liable for damage to any existing utility and structure.
- The existence and location of underground utilities, appurtenances and structures as shown on the plans are based on existing records of varying degrees of accuracy and completeness. They are not guaranteed as to the location shown or that other obstacles may not be encountered in the course of work. The Contractor shall assume that existing utilities may exist, although not shown.
- Restoration of existing pavements and improvements unavoidably demolished due to work on utility reconstructions shall be incidental to the various contract items. Restoration shall be to original or better condition.
- The Contractor shall give all property owners five (5) days notice before entering into their respective properties.

TELEPHONE NOTES

(HAWAIIAN TELEPHONE CO., LTD.)

- The Contractor shall give HTCo., in writing, at least 20 working days advance notice of intent to commence work on the Telephone System.
- Existing telephone facilities shown on these plans are approximate only. The Contractor shall verify their actual location and shall make adjustments to the proposed facility as directed by HTCo.
- HTCo. will coordinate its work with the Contractor in such a manner as to expedite construction.
- Stake-out of new manholes, pullboxes, ducts, poles and anchors shall be done by the Contractor.
- All manholes, pullboxes and ducts shall be installed by the Contractor.
- Telephone ducts encased in concrete jacket shall be inspected and approved by HTCo. before concrete placement. Advance notice of at least 24 hours shall be given before placing concrete.
- Poles, anchors, and cables will be removed by HTCo.
- HTCo. to furnish the Contractor for proper installation, all manhole frames and covers, all pullbox sections and covers, all pulling irons, cable racks, bolts, nuts, washers and ground rods for installation in manholes, pullboxes; all ducts, fittings and spreaders, except as shown on Plans.
- Stations and Offsets to new manholes, pullboxes, and poles are to the center of the facilities.
- All underground ducts shall be encased in plain concrete jacket for Telephone Lines "B", "D", "E" & "F". Telephone Lines "A" & "C" shall be direct burial.
- Excavation and backfill for splice pits for the Wolfe Cable and Signal Corps Cable shall be incidental to excavation and backfill for the cables.

DATE	
SURVEY PLOTTED BY	
DRAWN BY	
RECHECKED BY	
QUANTITIES BY	
CHECKED BY	
ORIGINAL PLAN	
NOTE BOOK	
NO.	

GAS NOTES (GASCO, INC.)

- The Contractor shall give GASCO, Inc., in writing, at least 14 calendar days advance notice of intent to commence work on the Gas System.
- The Contractor shall verify the exact locations and depths of existing gas lines prior to start of construction operations. The Contractor shall call Gasco, Inc. a minimum of 48 hours before starting excavation to arrange for field location of all exist. gas pipe lines. The telephone number is 548-2126 during business hours, and 548-2123 after hours. The Contractor shall excavate and backfill around gas pipe lines in the presence of a Gasco, Inc. representative. All backfill within six inches of gas line shall be select cushion material approved by Gasco, Inc.
- For relocation of any gas pipe line, the Contractor shall notify Gasco, Inc. 5 working days before starting work. The Contractor shall provide the necessary excavation and backfill, arrange for traffic permits and restore sidewalk pavement or other improvements. The Contractor shall perform all necessary excavation for new gas lines until the new lines are in service.
- The Contractor shall furnish all materials, labor and equipment for performing all necessary excavation, backfill, and concrete work necessary for the installation of new gas pipes in trench and adjustments to existing gas pipes and appurtenances. Gasco, Inc. will provide all materials, labor and equipment for the installation of the gas line in trenches, including fabrication, welding, and testing.
- All existing gas facilities shall remain in place until all new facilities are installed and pressurized into service. All costs for temporary relocation required during construction shall be borne by the Contractor.
- The Contractor shall be extremely careful when working near gas pipe lines.
- The Contractor shall notify Gasco, Inc. immediately after any damage has been caused to exist. gas pipelines, their coatings or their cathodic protection devices. Repair work on this damage will be done by Gasco, Inc. with payment for this work to be borne by the Contractor.
- Minimum vertical or horizontal clearance between gas pipe lines and other pipelines, conduits, or ductlines shall be 12 inches. Adequate support and protection for gas pipe lines exposed in the trench shall be provided. Such support and protection will be approved by Gasco, Inc. If this clearance cannot be attained, the gas line shall be protected with a Gasco, Inc. - Approved insulation material furnished and installed by the Contractor, and the work must be approved by Gasco, Inc.
- The Contractor shall work in an expeditious manner in order to keep uncovered gas pipe lines exposed for as short a period of time as possible.

ELECTRIC NOTES (HAWAIIAN ELECTRIC CO., INC.)

- The Contractor shall give HECo. in writing, at least 20 working days advance notice of intent to commence work on the Electric System.
- All existing facilities shall remain in place until the proposed facilities are installed. Existing electric facilities shown on these plans are approximate only. The Contractor shall verify their actual locations and shall make adjustments to the proposed facility as directed by HECo.
- HECo. will coordinate its work with the Contractor in such a manner as to expedite construction.
- All materials required for the relocation and rearrangement of the HECo.'s overhead facilities will be furnished by HECo.
- The Contractor shall furnish and install all materials to complete construction of the underground ductline system, including riser conduits. All electric ducts shall be encased in concrete jacket unless otherwise specified. All ducts and conduits shall be inspected and approved by HECo. prior to placing concrete. The Contractor shall notify HECo.'s Inspection Division (Phone 548-4428) at least 24 hours prior to placing concrete.
- Location and depth of all handholes and manholes shall be verified and approved in the field by HECo. prior to excavation, construction or installation.
- The Contractor is to mandrel test all ductlines in the presence of HECo's Inspector prior to acceptance.
- Excavation of pole holes and anchors, installation of poles and anchors, and backfill of pole holes and anchors will be done by HECo. Stake out of wood pole and anchor locations to be done by the Contractor and verified by HECo.
- Electric duct banks shall enter and leave manholes at zero percent slope for a minimum distance of ten feet.
- For anchor stake out details see HECo. Project Dwg. No. 25503. HECo. to provide Contractor with HECo. Project Dwg No. 25503.
- Stations and Offsets to new manholes, handholes and poles are to the center of the facilities.
- Location and depth of Transformer Concrete Pad for Lighting System shall be verified and approved in the field by the State Engineer prior to excavation, construction and installation.



THIS WORK WAS PREPARED BY
ME OR UNDER MY SUPERVISION.
A.R. Daleso

M. J. Karunika
Hawaiian Electric Co., Inc.
Date 7/16/78

R. Yamada
Hawaiian Telephone Co.
Date 6/6/78

Ron H. Washington
Gas Co. Inc.
Date 4/12/78

STATE OF HAWAII
DEPARTMENT OF TRANSPORTATION
HIGHWAYS DIVISION


GENERAL UTILITY NOTES

FORT WEAVER ROAD
ROUTE H-1 TO SOUTH OF
FARRINGTON HIGHWAY


DATE: AUG. 1978

SHEET NO. 100 OF 331 SHEETS

FED. ROAD DIST. NO.	STATE	FED. AID PROJ. NO.	FISCAL YEAR	SHEET NO.	TOTAL SHEETS
HAWAII	HAW.	M-7600(1)	1978	102	198

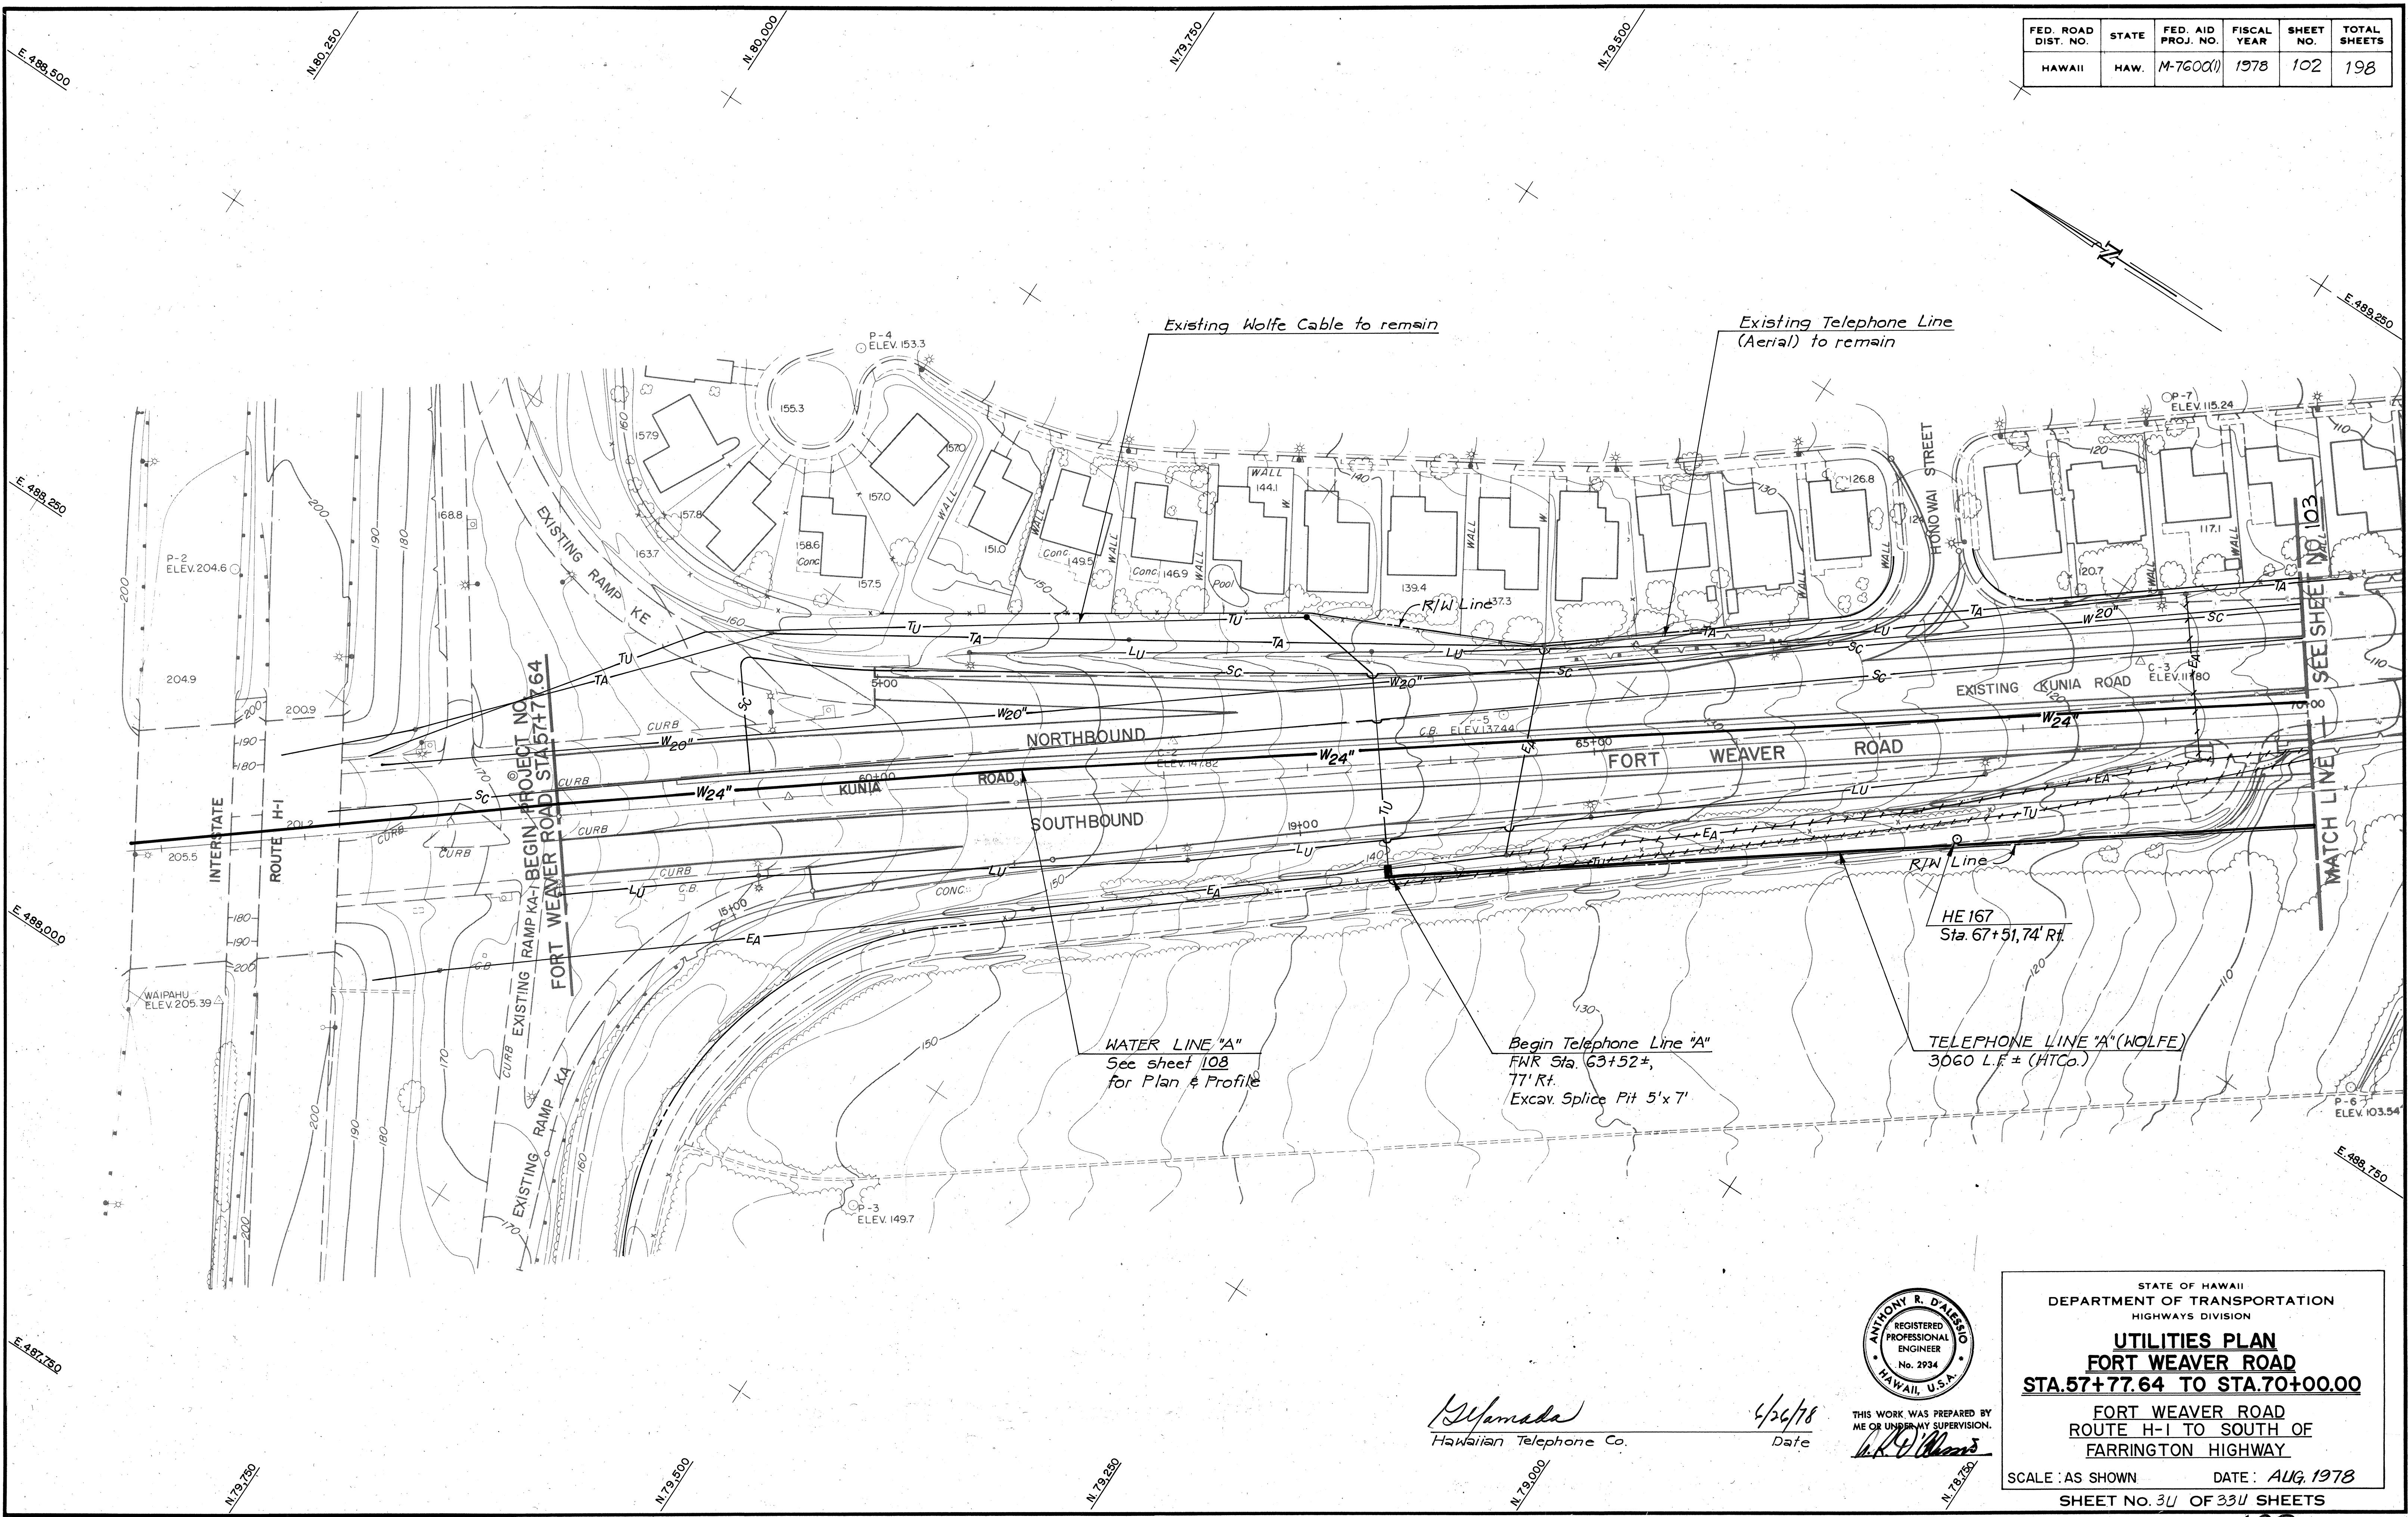

FED. ROAD DIST. NO.	STATE	FED. AID PROJ. NO.	FISCAL YEAR	SHEET NO.	TOTAL SHEETS
HAWAII	HAW.	M-7600(1)	1978	103	198

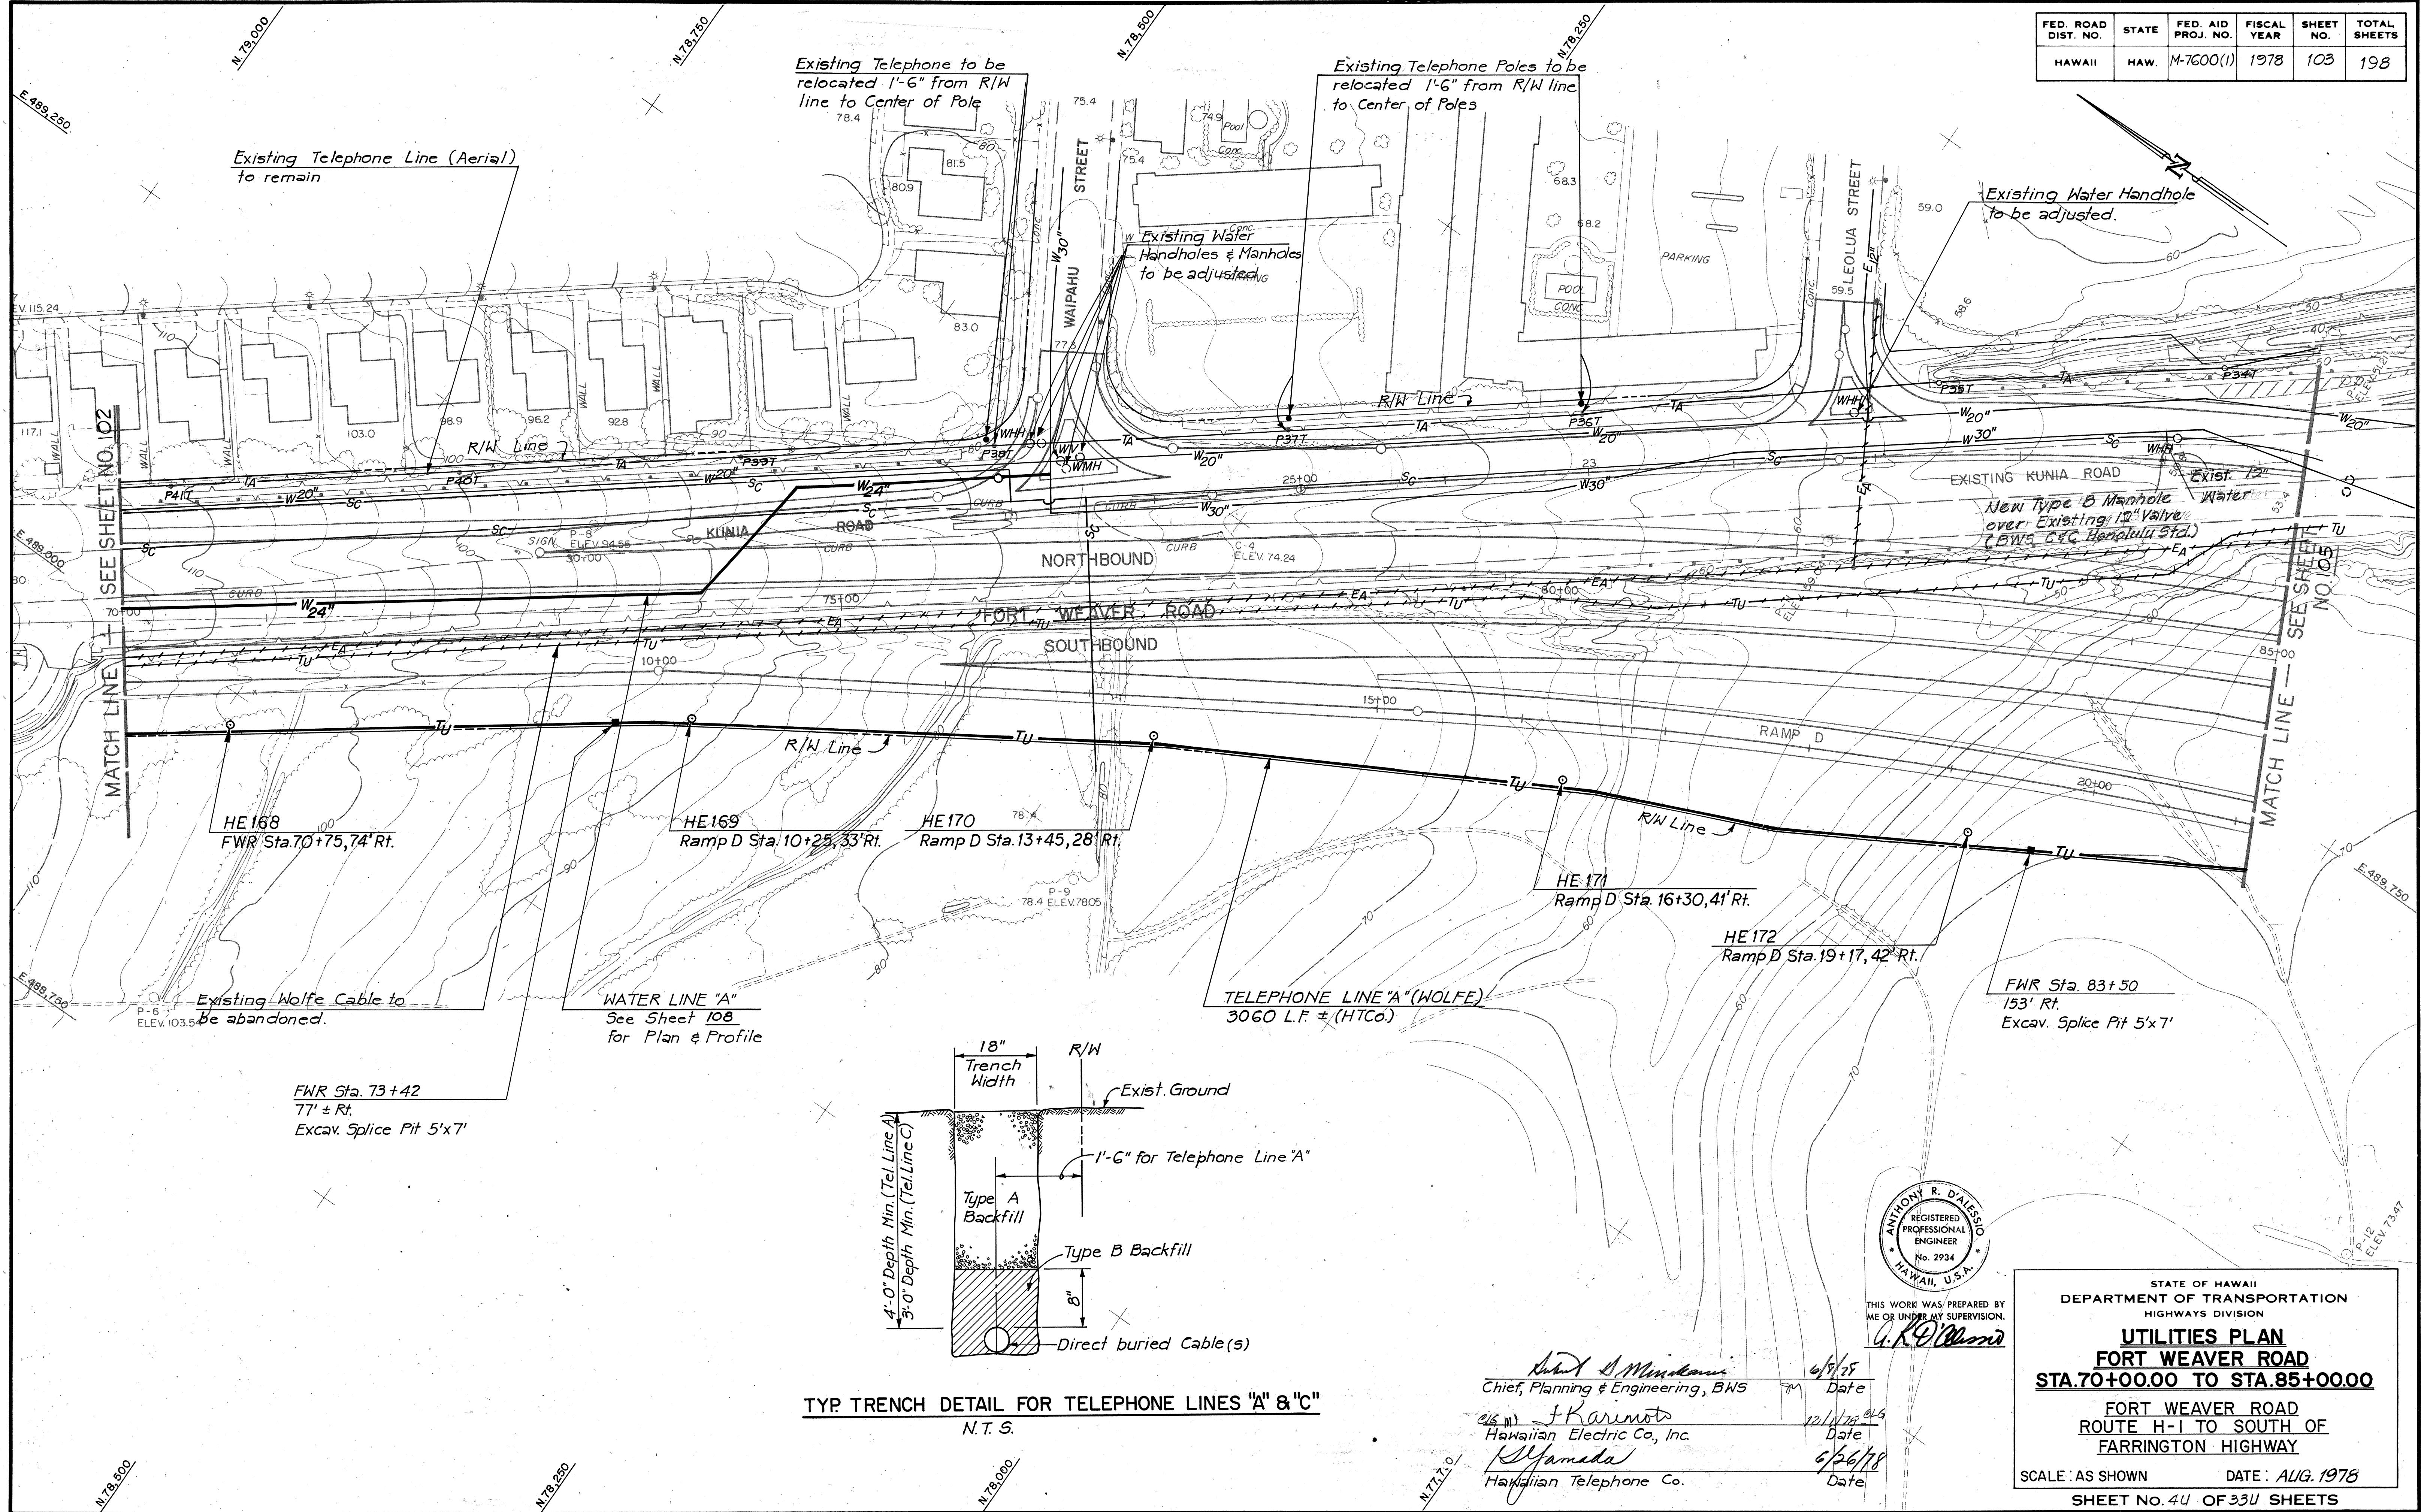

**STATE OF HAWAII
DEPARTMENT OF TRANSPORTATION**

UTILITIES PLAN

FORT WEAVER ROAD

FORT WEAVER ROAD
STA.70+00.00 TO STA.85+00.00

SCALE: AS SHOWN DATE: AUG. 1978
SHEET NO. 44 OF 334 SHEETS

03

FED. ROAD DIST. NO.	STATE	FED. AID PROJ. NO.	FISCAL YEAR	SHEET NO.	TOTAL SHEETS
HAWAII	HAW.	M-7600(1)	1978	104	198

Date: 1-12-70 Revision: Revised 5" PVC to 5" G.S. ss per Addendum No. 1.


NOTE:
16" Water Main installed by BWS Job No. 80-39 Part "A". For profile see Plan Sheet No. 104S-1. For additional details on water main installation see copy of BWS plans on file with this project.

* NOTE 'A': Provide minimum 3' cover for all Electric Duct Lines
Exist. Water Valve Boxes replaced with Type A Manhole
End 30" Water Line "B" Sta. 16t 31±
= B Ramp E Sta. 17+44, 10' Lt.
Connect to Exist. 30" Main.
1-30" 8" Bend
1-Conc. Block w/ Struct. Strut
1-Temp. Cleanout with Cap for Testing
1-30" Butt Strap
8-LF. 30" Conc. Cyl. Pipe Class 150


WATER LINE "B"
30-inch. Conc. Cylinder Pipe
TMH#6, Corner Small Type End Electric Line "C"
Farr. Sta. 48+45, 87L.F. Break 1-3" & 1-5" Ducts into EMH#4
EHH#3 (2"x4")
Farr. Sta. 48+73, 68' Lt.
5LF. 3-4" Ducts
3-4" 90° Bend EHH#1 (2"x4")
Farr. Sta. 50+73.5, 68' R.R.

EMH#808 Type 4 (7"x16')
Farr. Sta. 50+30, 51' Lt.
3-4" PVC, 6" Radius, 5-5" G.S., 3" Radius Bends
2-3" Ducts, 6" Radius, 5-5" G.S., 3" Radius Bends
1-2" Duct, 118 L.F. 1-2" Duct, 315 L.F.
Begin Elec. Line "C" Pull Box 4357B
EHH#2 (2"x4") Farr. Sta. 45+67
Farr. Sta. 45+54.5 60+R.L. (See HTCo Dug No. 51056)
G.B. Lt.
TMH#4, Type A-3-6 Farr. Sta. 44+45, 47' Lt.
Begin 30" Water Line "B" Sta. 10+00.00
= B Farr. Hwy. Sta. 42+21 ±, 6' Lt.
Remove Exist. 30" Bend
Connect to Exist. 30" Main
1-Temp. Cleanout w/ Cap for Testing
1-30" Butt. Strap
8-LF. 30" Conc. Cyl. Pipe Class 150
30" Water Line "B" Sta. 10+20
= 30" 5° Bend + Conc. Block
CAUTION
400# High Pressure Gas Line Hand dig to expose Gas line before excavating w/ Machinery

Anthony R. D'Alessio
REGISTERED PROFESSIONAL ENGINEER
No. 2934
HAWAII, U.S.A.
STATE OF HAWAII
DEPARTMENT OF TRANSPORTATION
HIGHWAYS DIVISION
UTILITIES PLAN
FORT WEAVER ROAD
STA. 85+00.00 TO STA. 94+50.00
FARRINGTON HIGHWAY
STA. 34+00.00 TO STA. 51+00.00
FORT WEAVER ROAD
ROUTE H-1 TO SOUTH OF FARRINGTON HIGHWAY
SCALE: 1" = 50'
DATE: AUG. 1978
SHEET NO. 50 OF 331 SHEETS

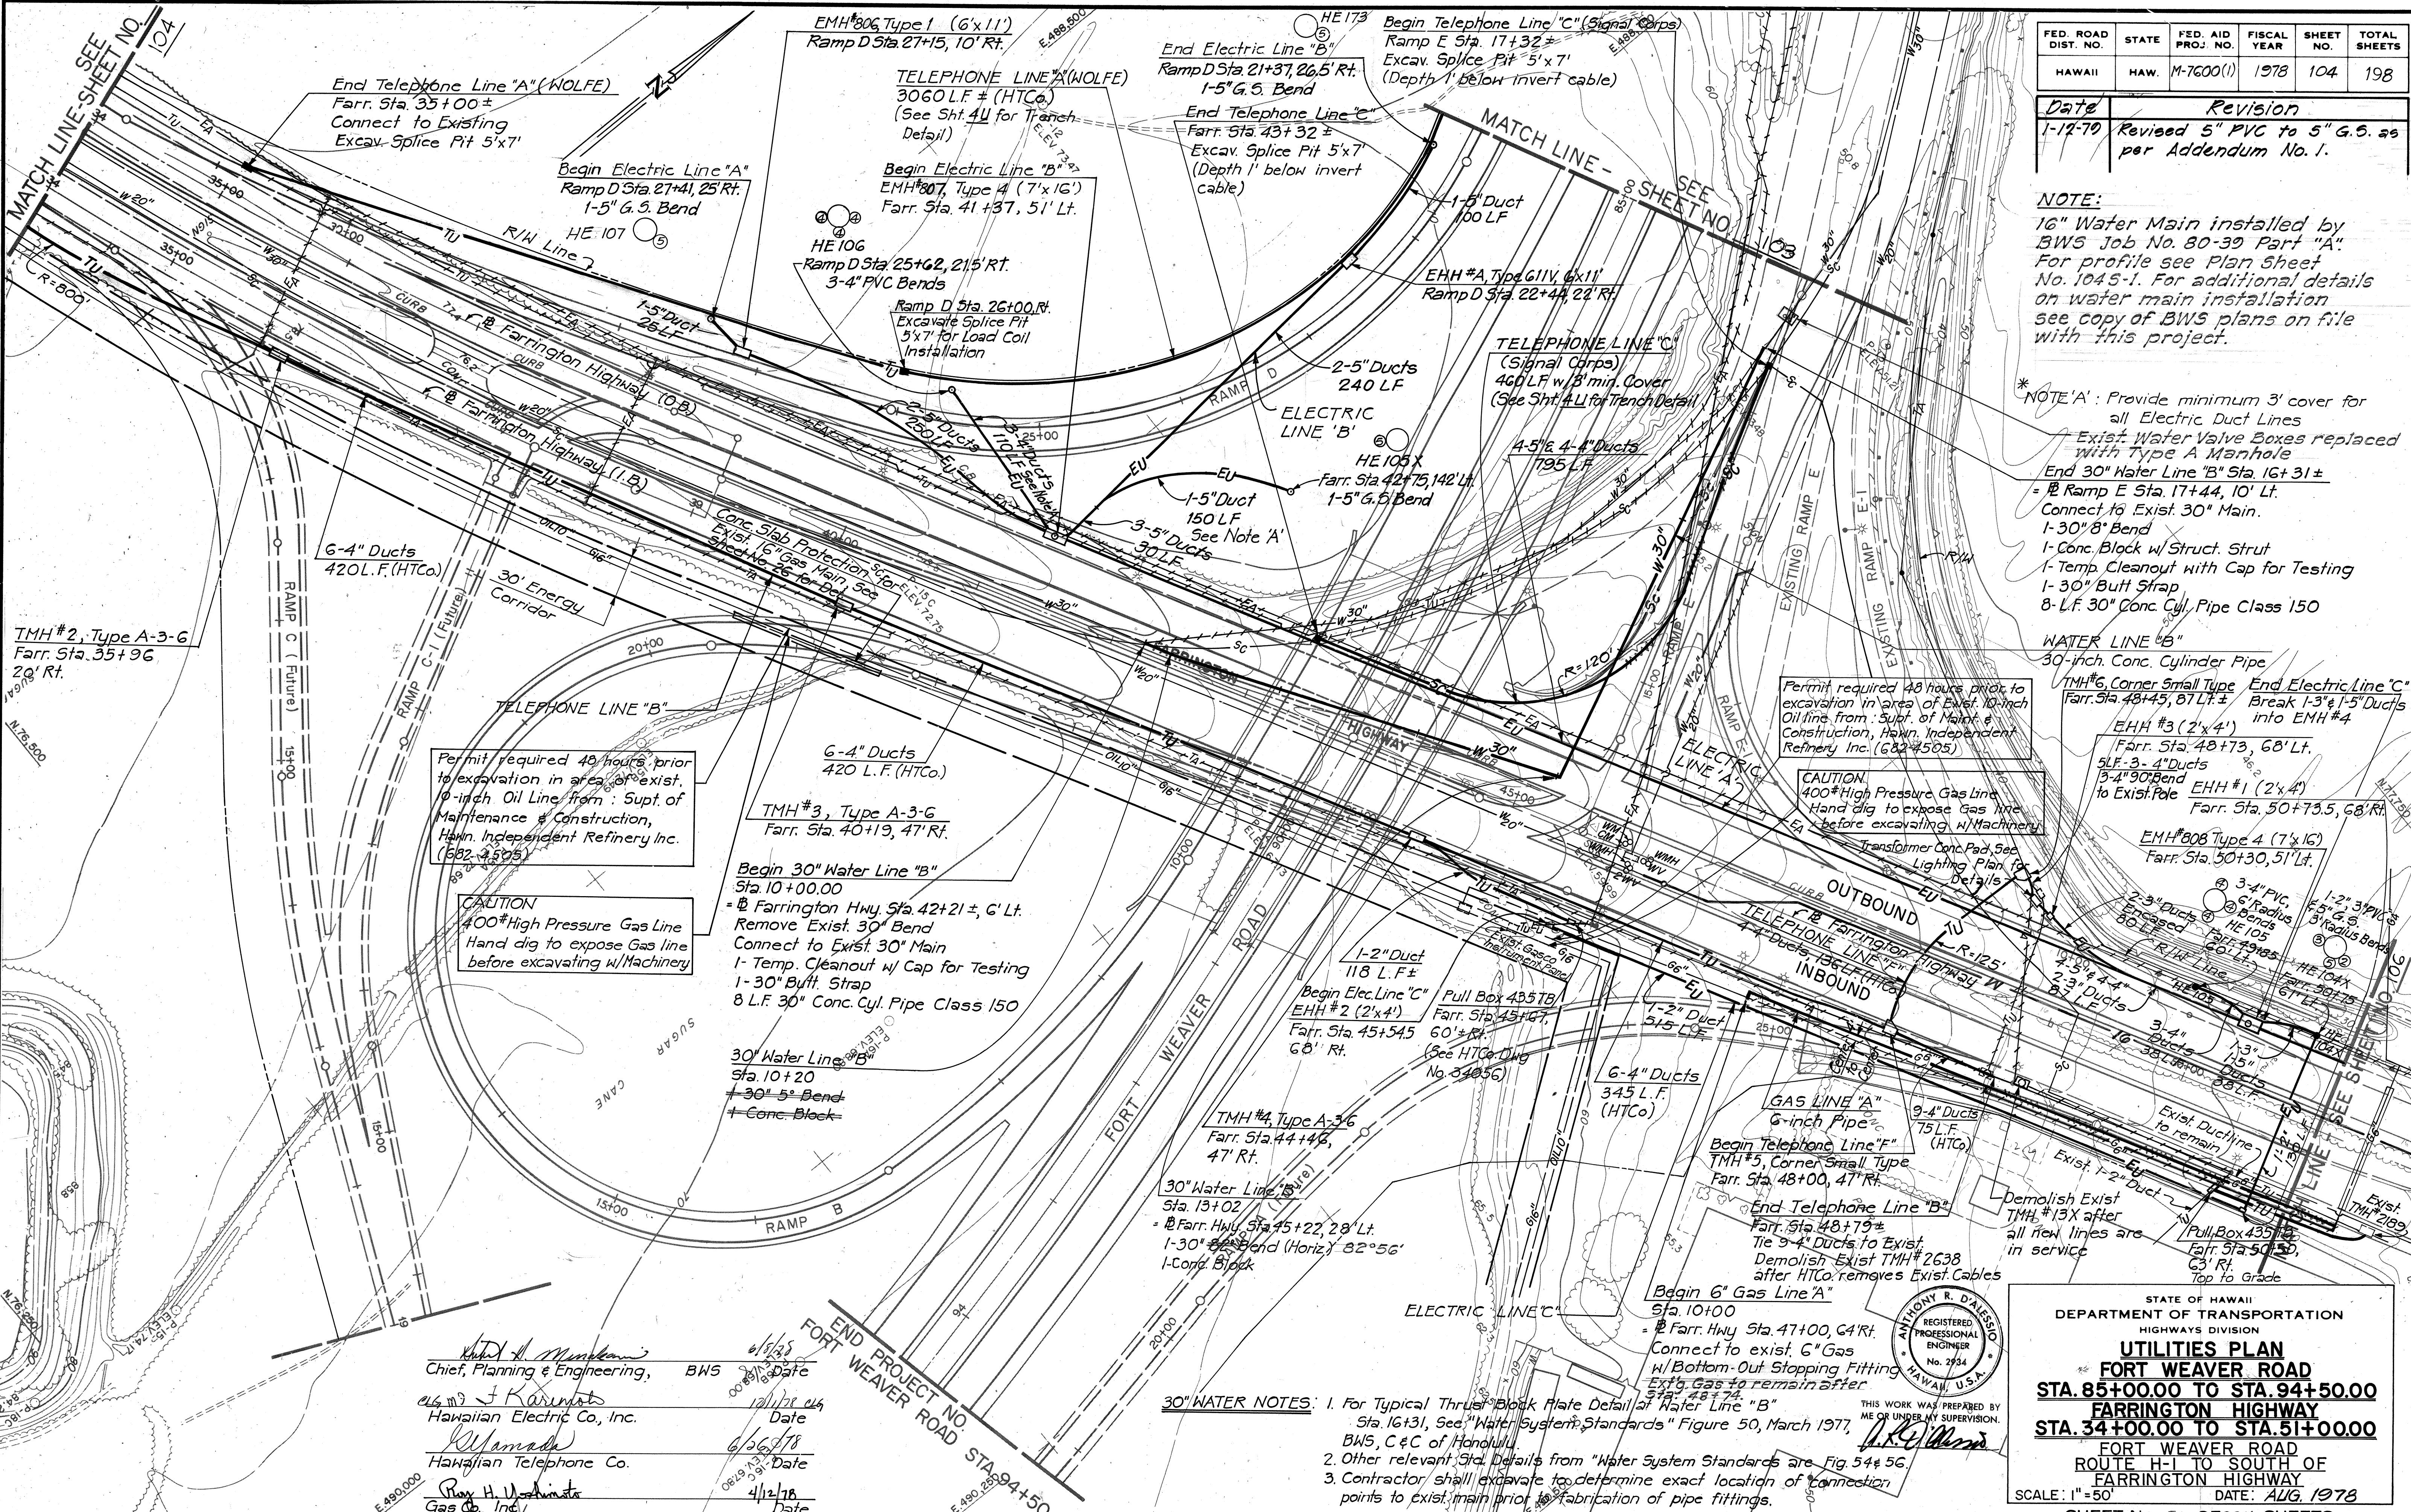

FED. ROAD DIST. NO.	STATE	FED. AID PROJ. NO.	FISCAL YEAR	SHEET NO.	TOTAL SHEETS
HAWAII	HAW.	M-7600(1)	1978	1045-1	198

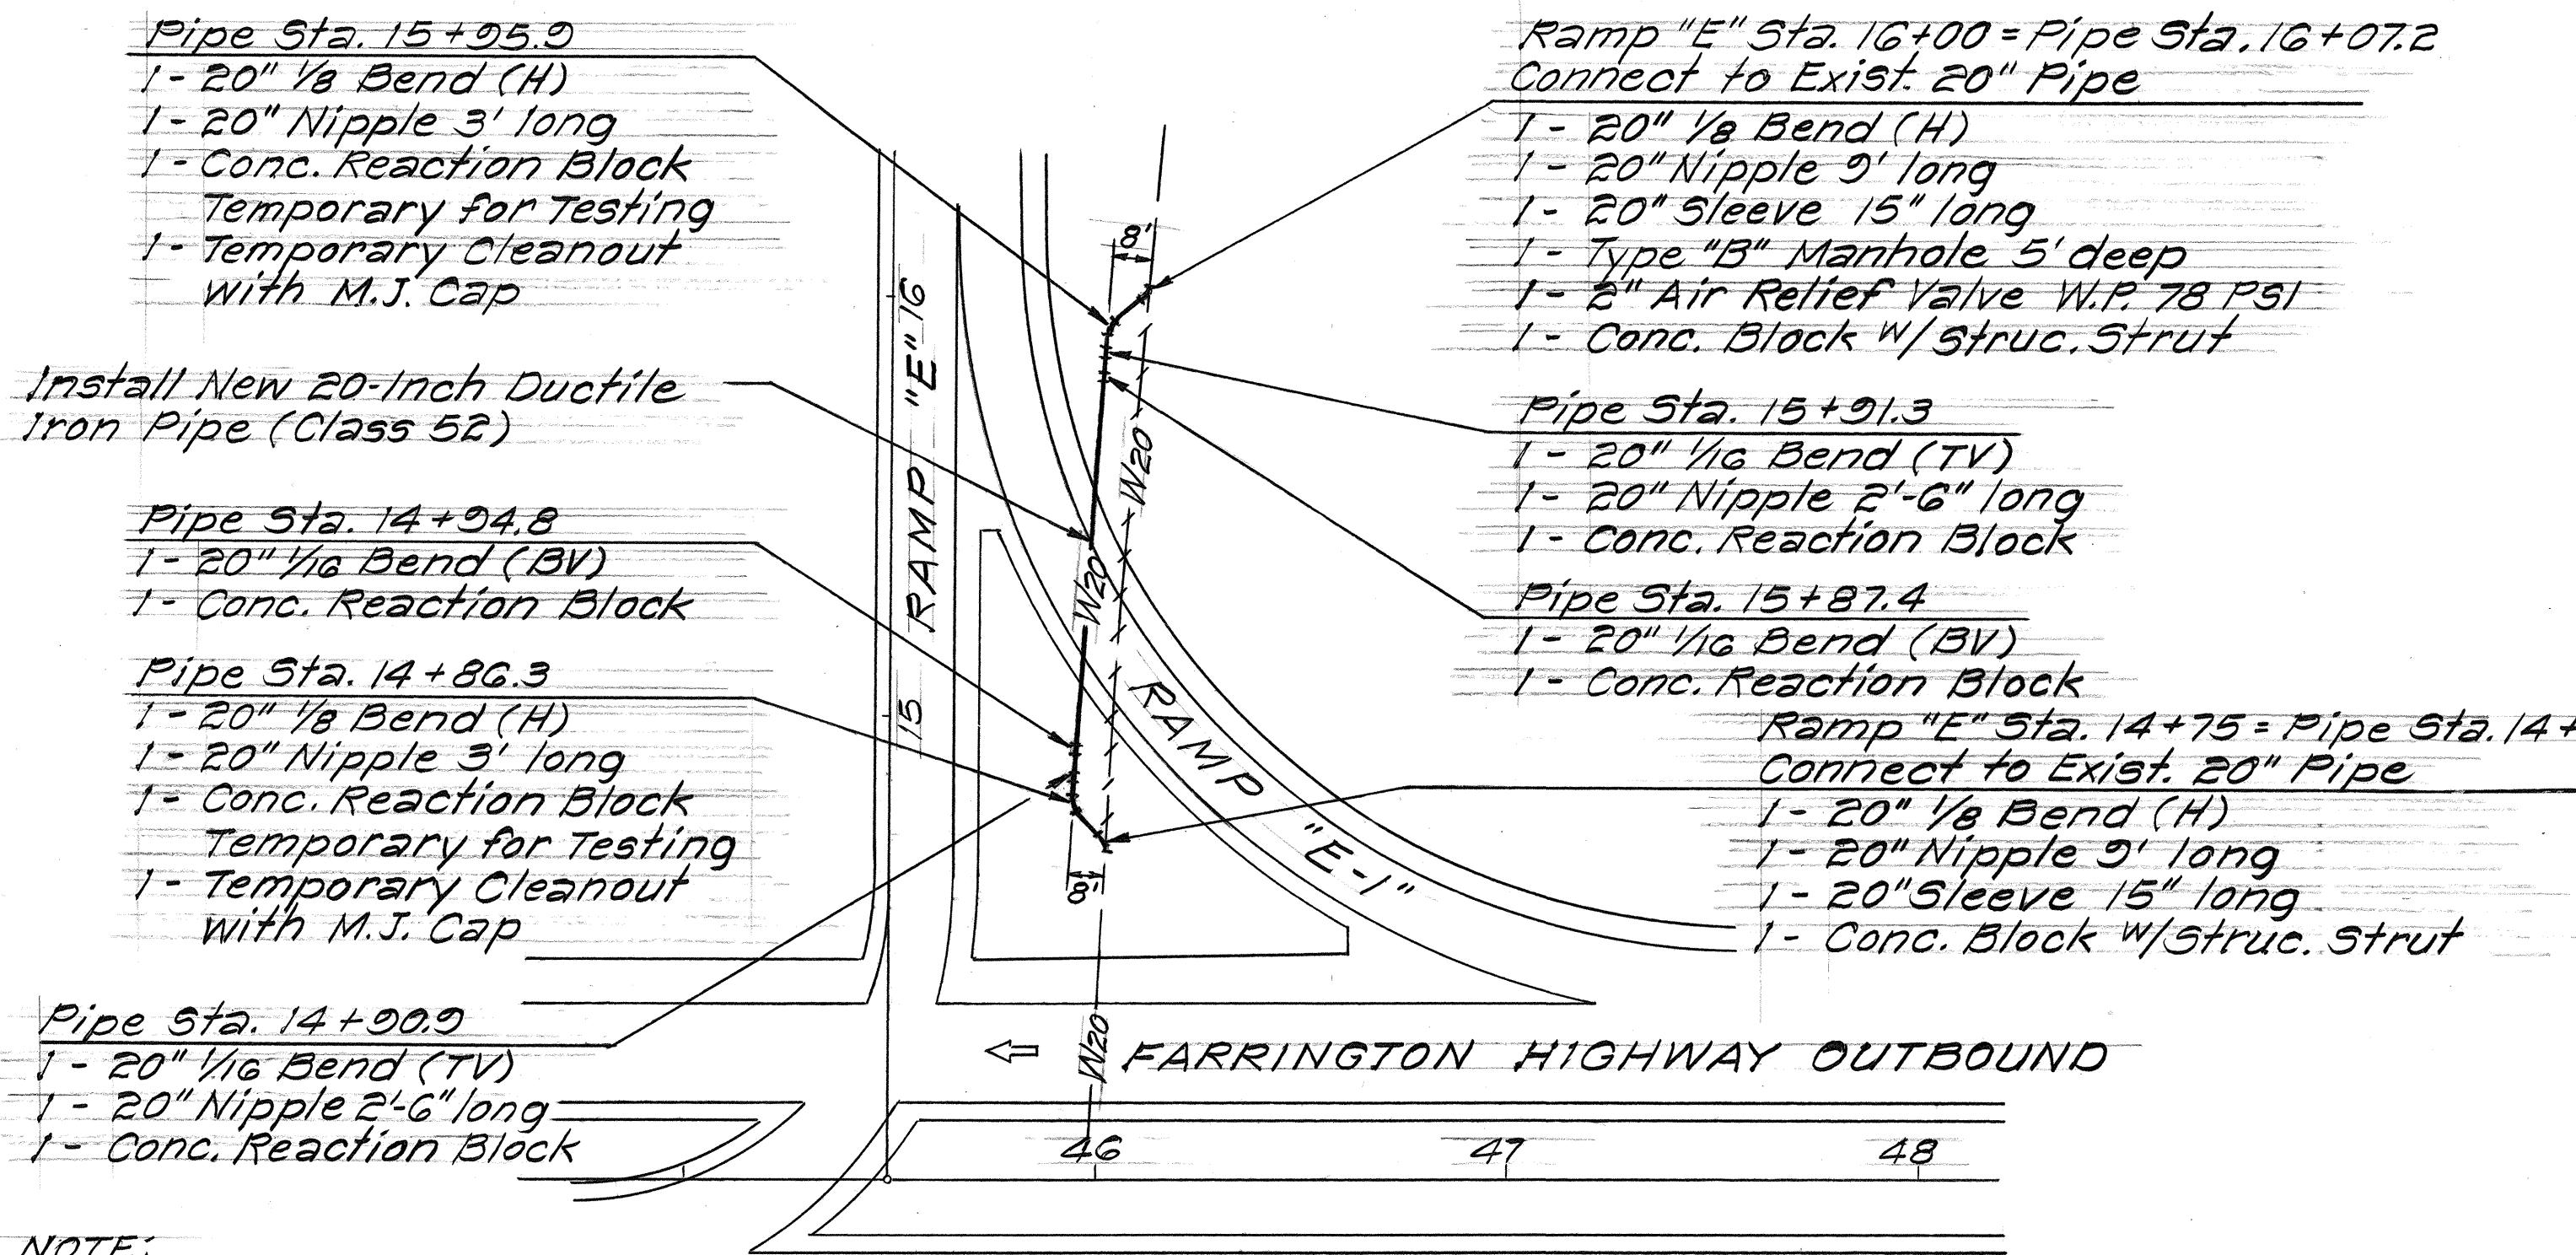


NOTE:
Pipe stations are computed along the slope of the pipe

PLAN


LOWERING OF 20" WATER LINE
RAMP "E" STA. 14+75 TO 16+00

Scale: 1" = 40

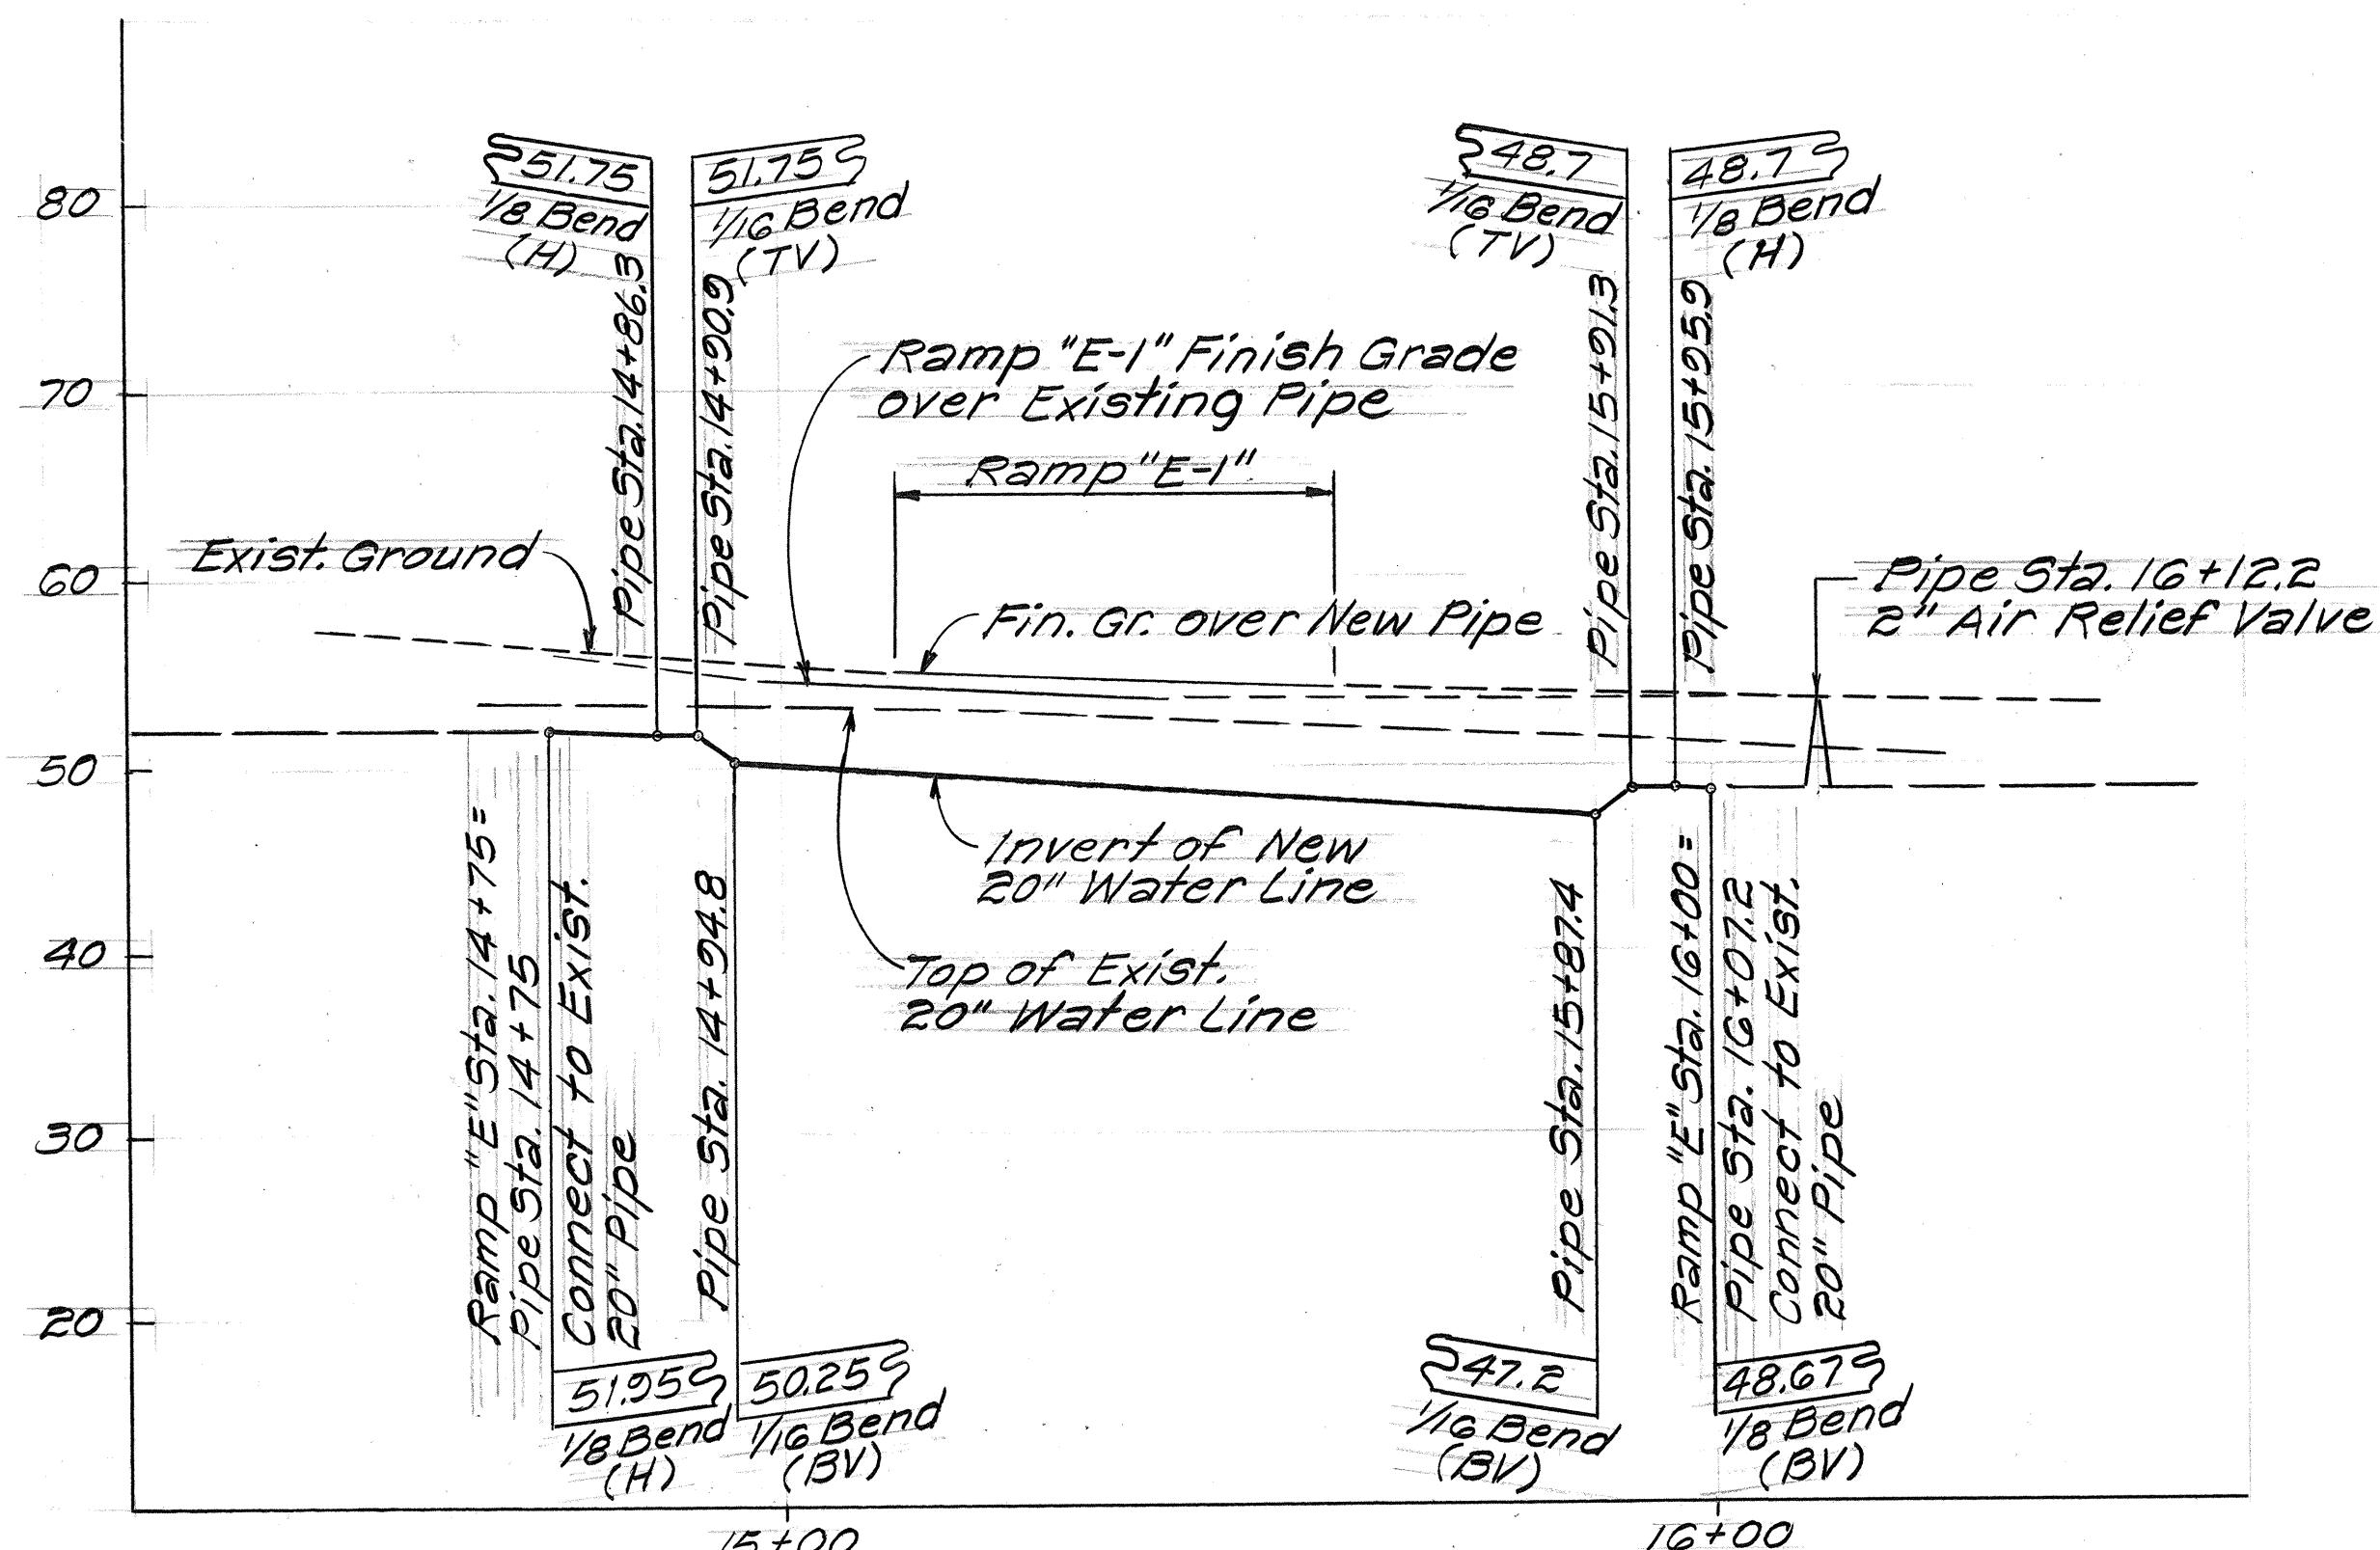


PROFILE OF NEW 20" WATER LINE

Scale: Horiz. 1" = 20'
Vert. 1" = 10'

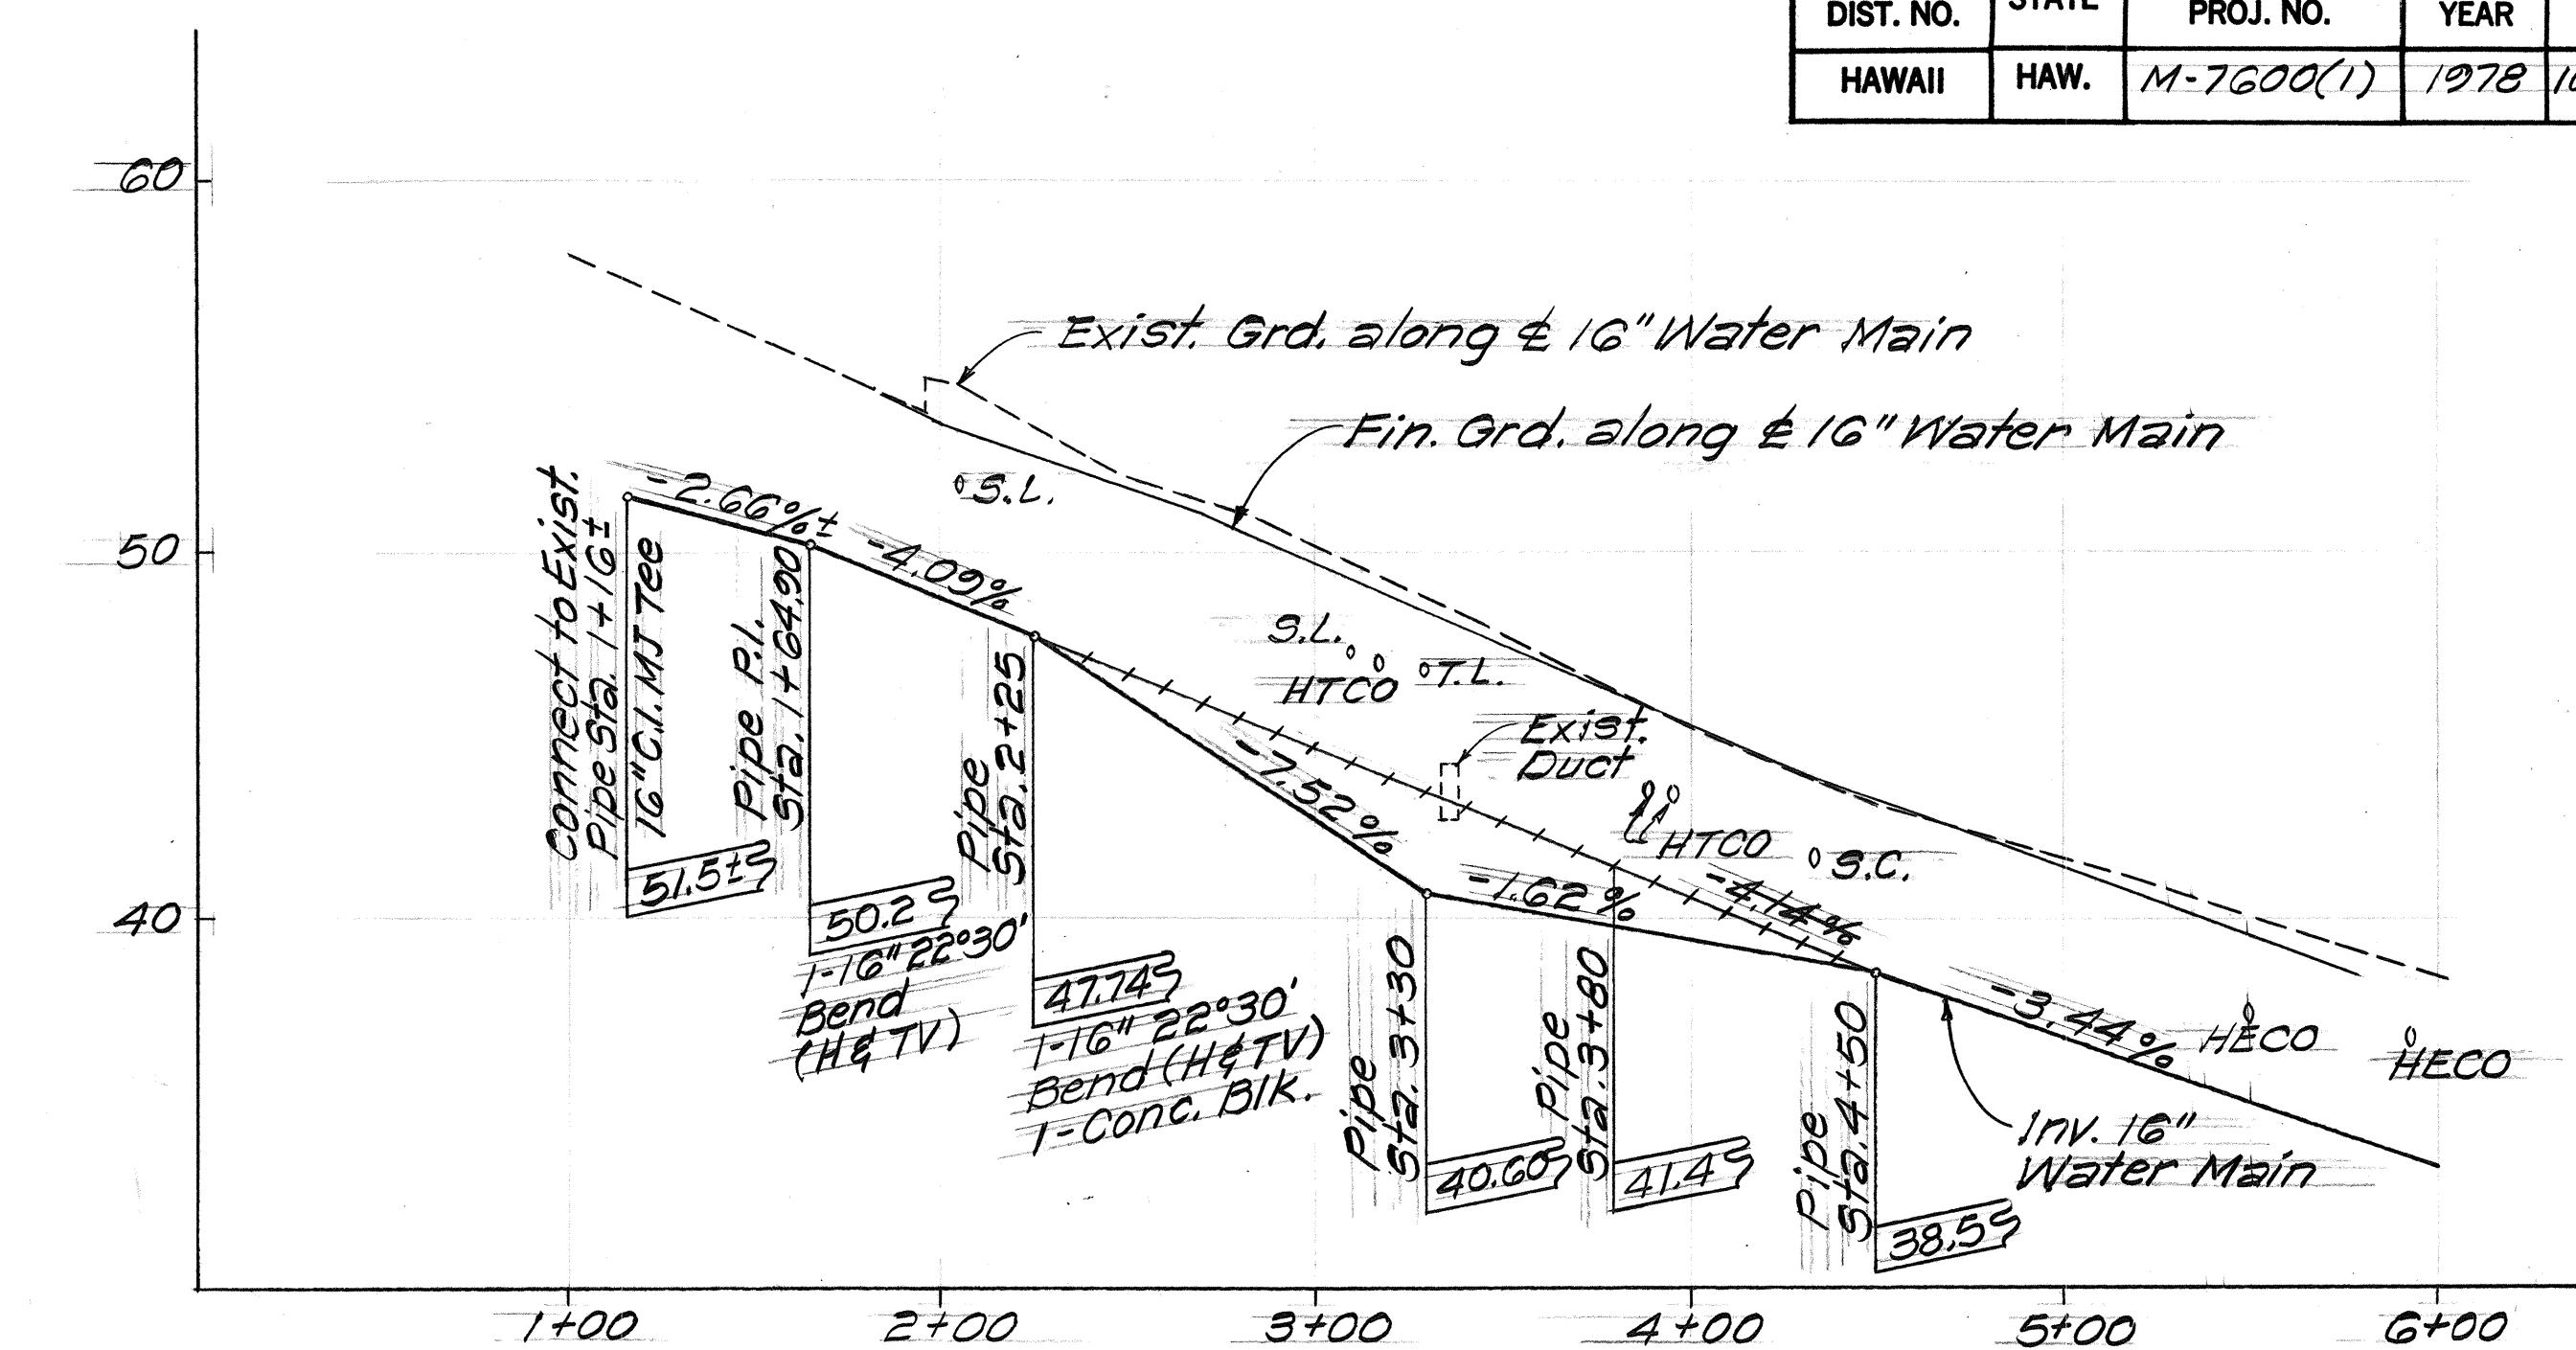

NEW 16" WATER MAIN
B.W.S. JOB NO. 80-39 PART "A"

Scale: Horiz. 1" = 50'
Vert. 1" = 5'

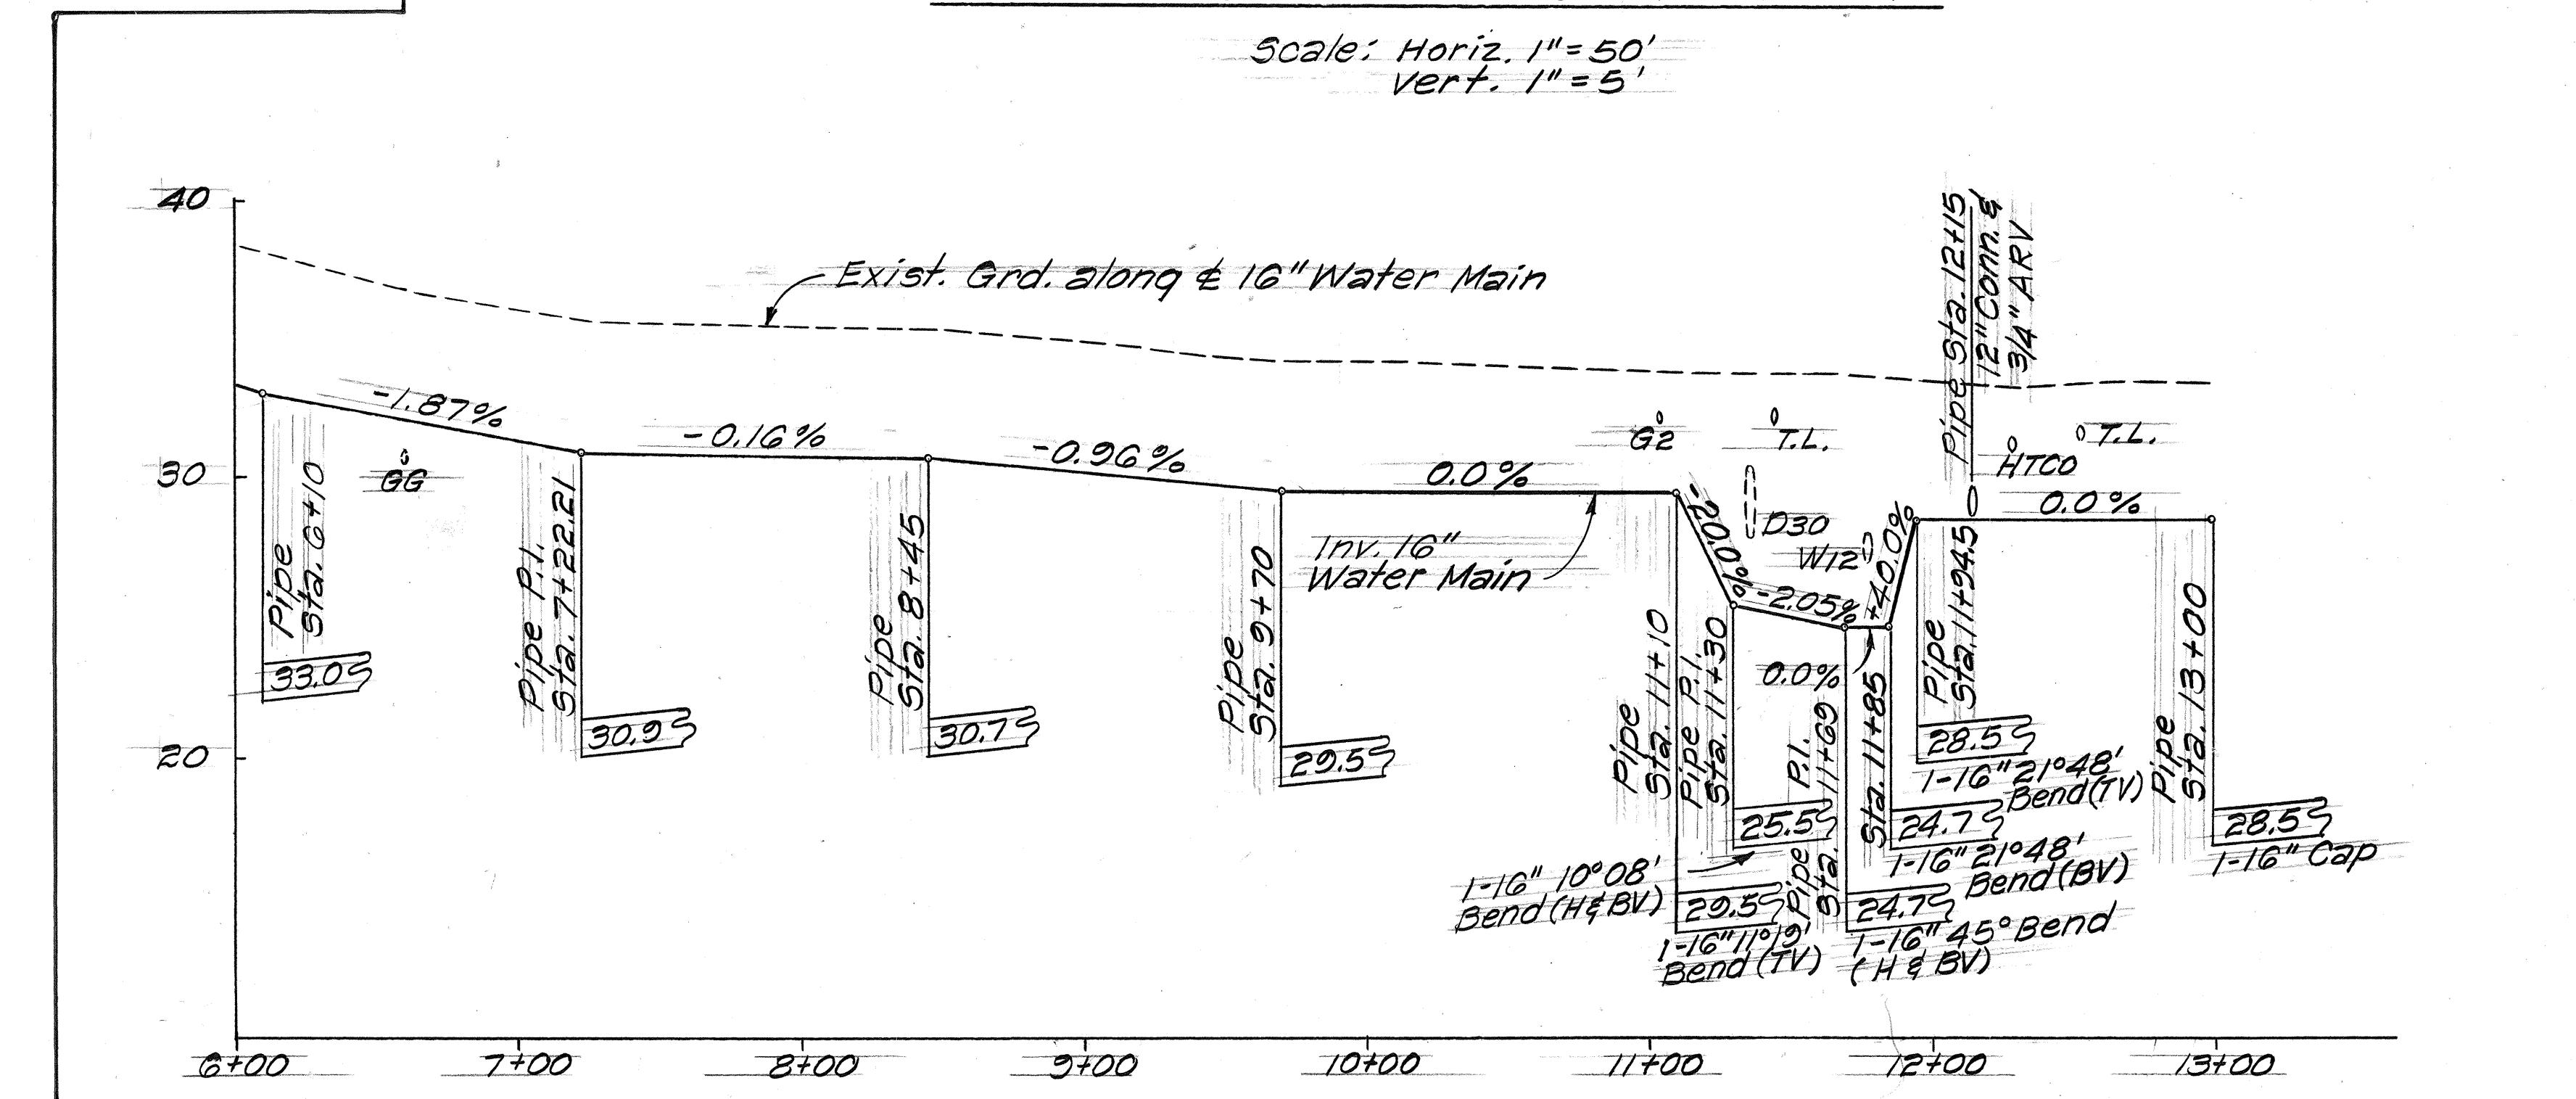

**THIS TRACING PREPARED
DURING "AS-BUILT" POSTING**

**STATE OF HAWAII
DEPARTMENT OF TRANSPORTATION
LAND TRANSPORTATION FACILITIES DIVISION**


UTILITIES PLAN

FORT WEAVER ROAD
ROUTE H-I TO SOUTH OF
FARRINGTON HIGHWAY

SCALE: As Shown **DATE: August, 1981**


SHEET No. **OF** **SHEETS**

FED. ROAD DIST. NO.	STATE	FED. AID PROJ. NO.	FISCAL YEAR	SHEET NO.	TOTAL SHEETS
HAWAII	HAW.	M-7600(i)	1978	105	198

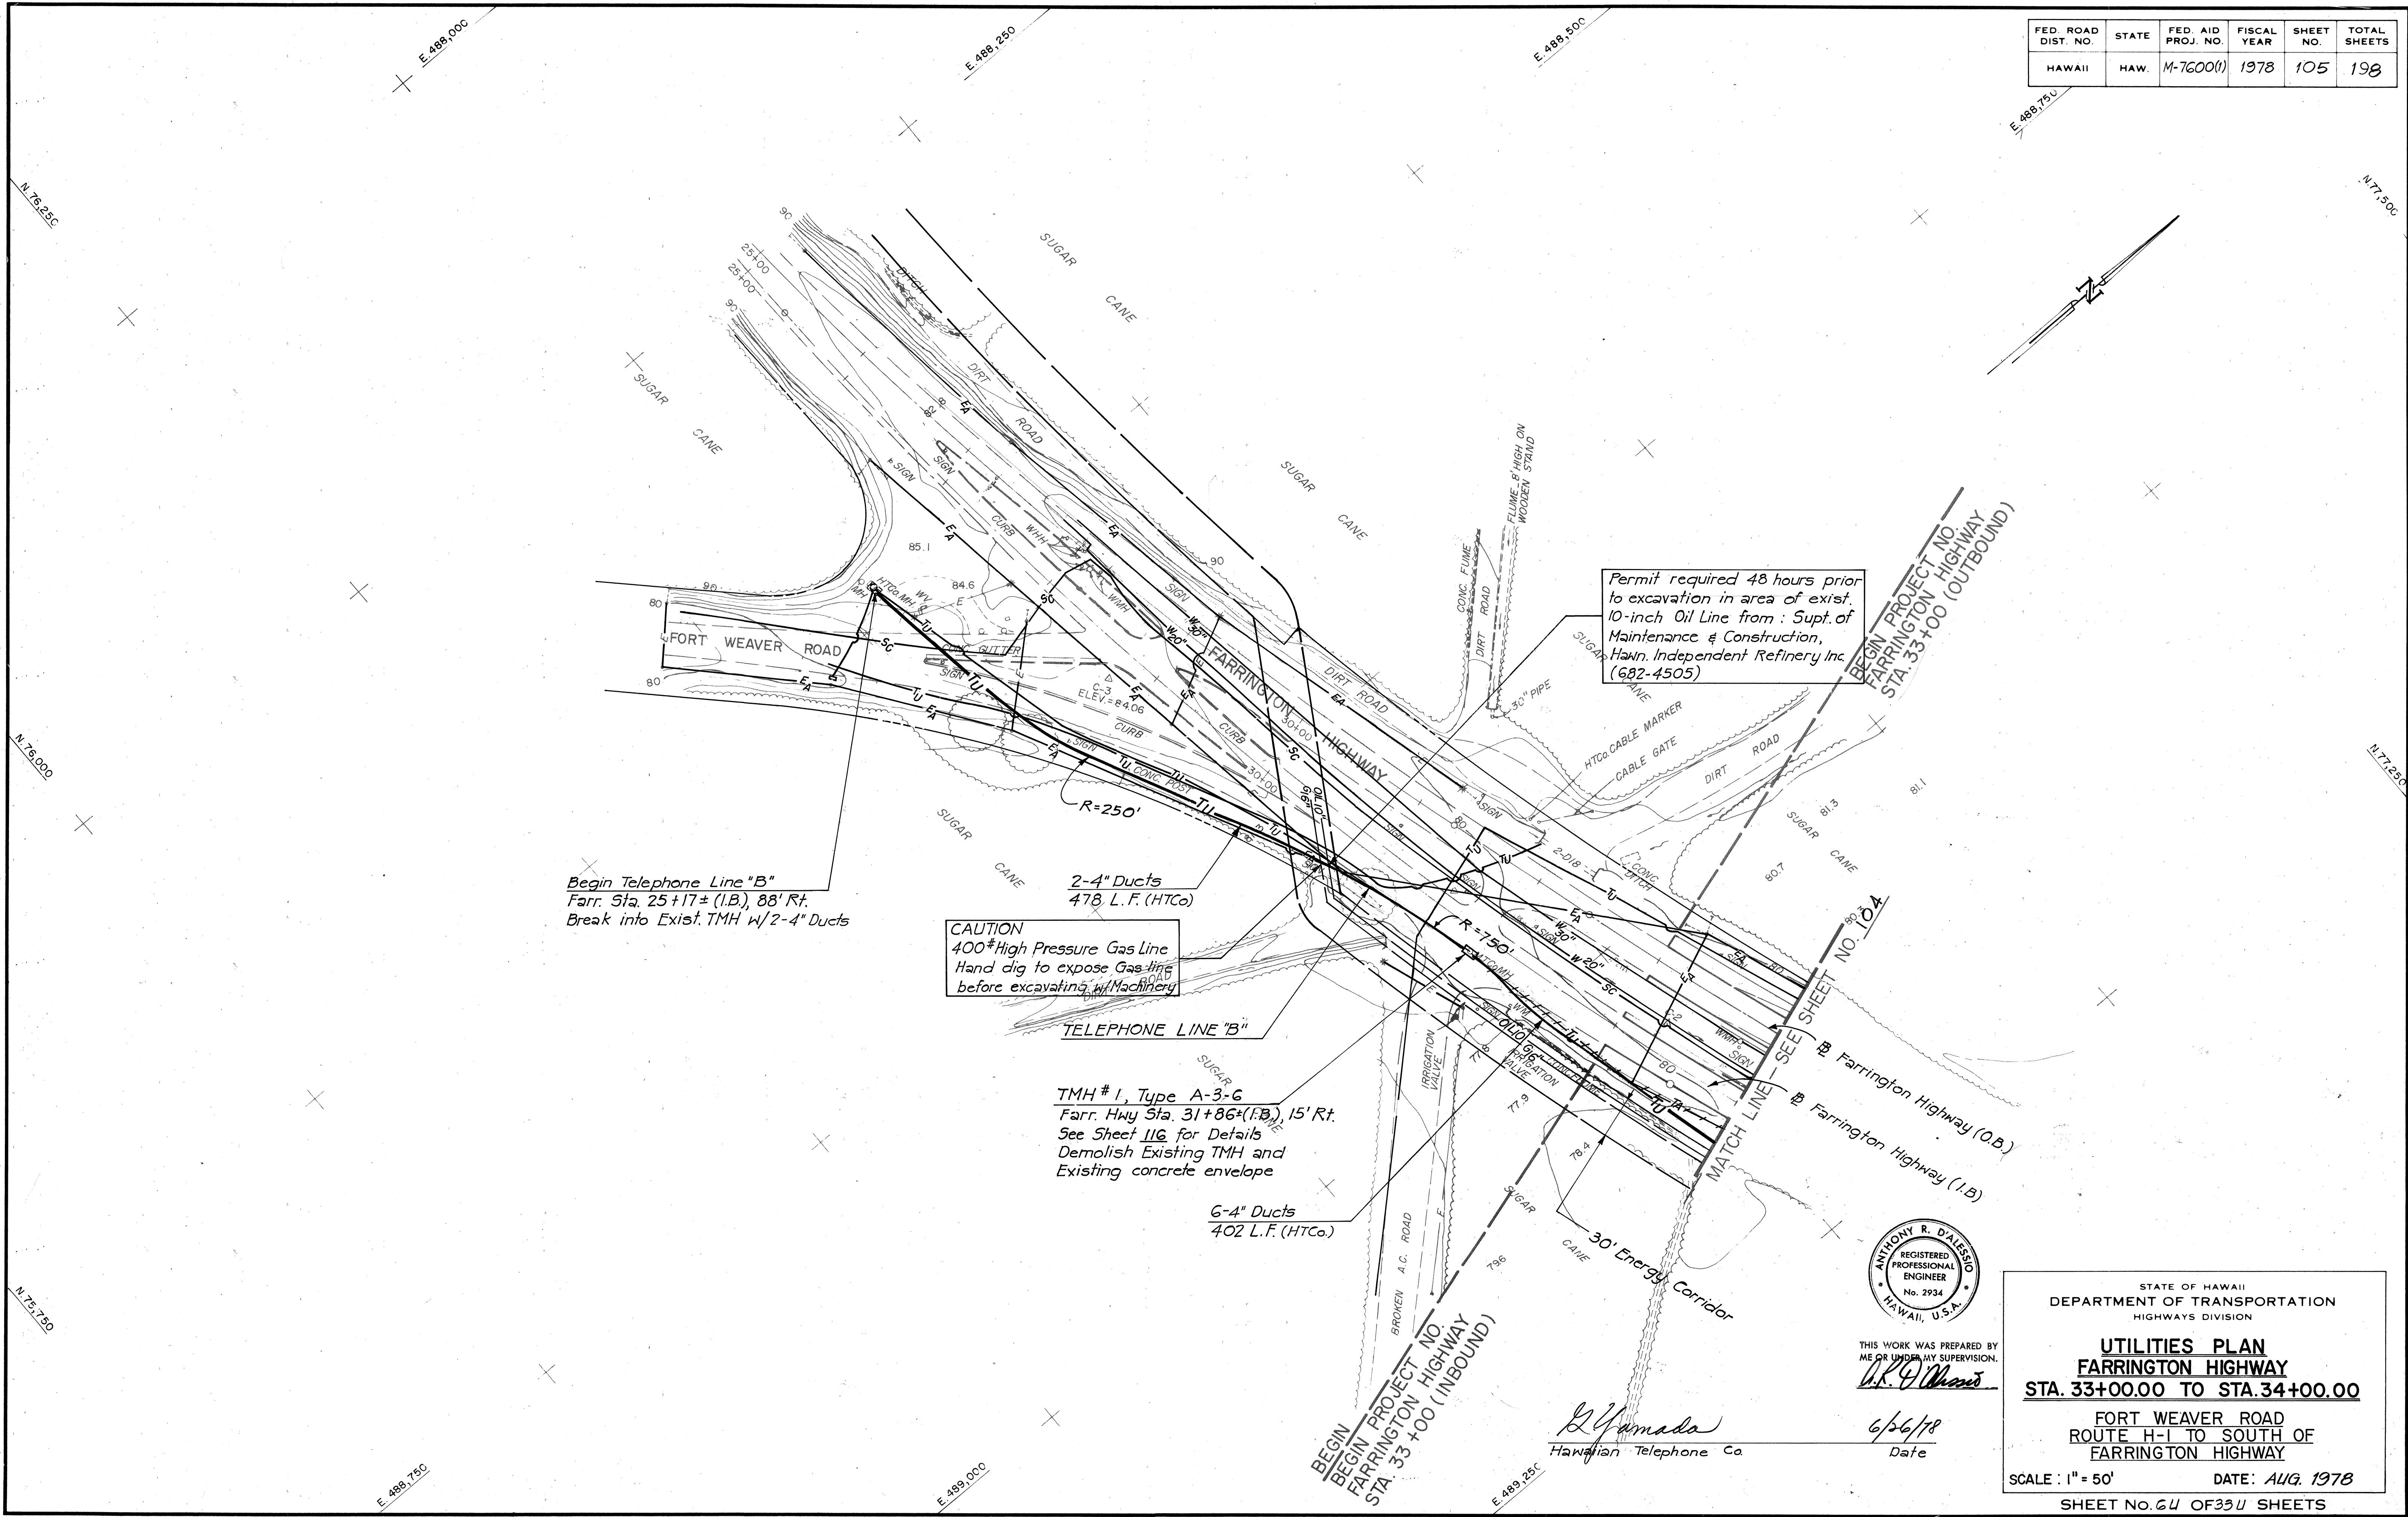

Date	Revision
1-12-79	Revised EMH number and 5" PVC to 5" G.S. as per Addendum No. 1.

FED. ROAD DIST. NO.	STATE	FED. AID PROJ. NO.	FISCAL YEAR	SHEET NO.	TOTAL SHEETS
HAWAII	HAW.	M-7600(1)	1978	106	198

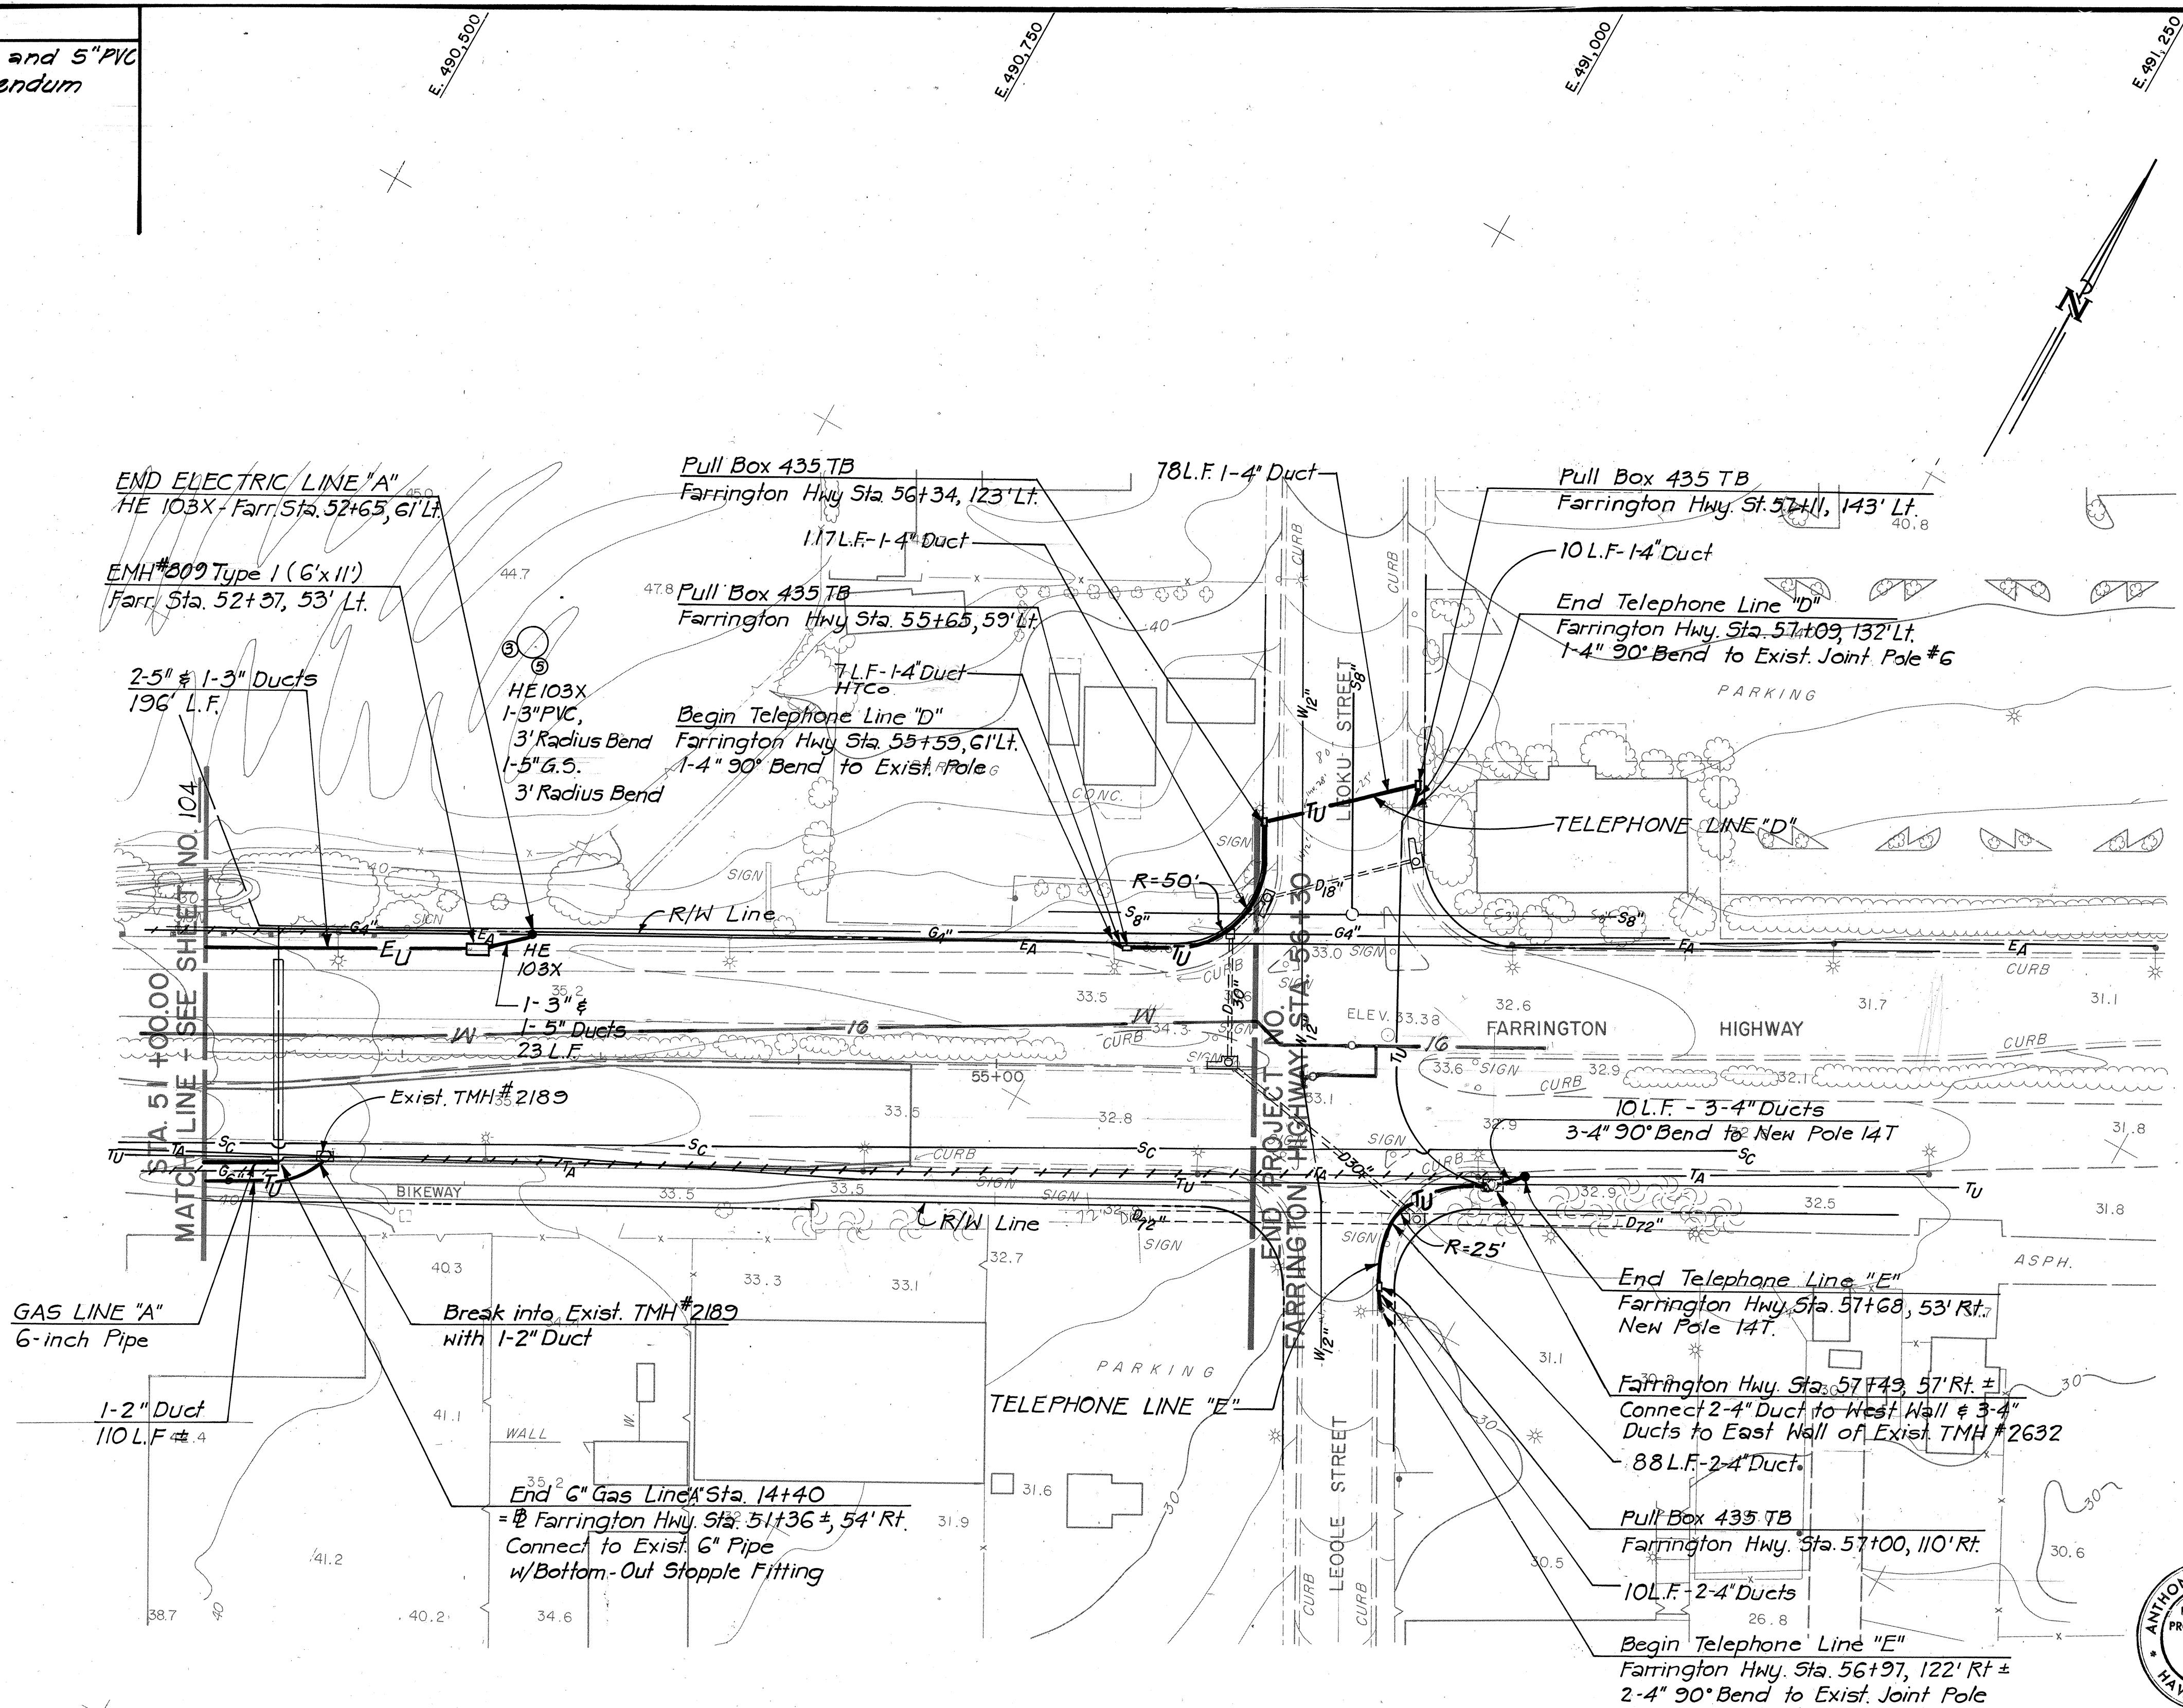

NOTE:

16" Water Main installed by BWS Job No. 80-39 Part "A" For profile see Plan Sheet No. 1045-1. For additional details on water main installation see copy of BWS plans on file with this project.

THIS WORK WAS PREPARED BY
ME OR UNDER MY SUPERVISION.

AP/AB

as m + Karmad
Hawaiian Electric Co., Inc.

Kelamani
Hawaiian Telephone Co.

Ron H. Updike
Gas Co. Inc.

7/16/78
Date

6/26/78
Date

4/12/78
Date

STATE OF HAWAII
DEPARTMENT OF TRANSPORTATION
HIGHWAYS DIVISION

UTILITIES PLAN
FARRINGTON HIGHWAY
STA. 51+00.00 TO STA. 56+30.00

FORT WEAVER ROAD
ROUTE H-1 TO SOUTH OF
FARRINGTON HIGHWAY

SCALE: 1" = 50'
DATE: AUG. 1978

SHEET NO. 74 OF 334 SHEETS

106R

FED. ROAD DIST. NO.	STATE	FED. AID PROJ. NO.	FISCAL YEAR	SHEET NO.	TOTAL SHEETS
HAWAII	HAW.	M-7600(1)	1978	107	198

Sta. 76+46 87' 9" L Conn. to exist. 30" Cone. Cyl. pipe

1- 30"x 24" Tee
2- 30" Bootstrap
2- 30" conc. Cyl. nipple,
3.0' long S & PE
1- Conc. blk. 'Y' struct. strut.
TEMP FOR TESTING
1- Temp. cleanout w/ cap

FWR @ Sta. 76+08

- 1- 24" Butterfly Valve, FE CL 150
- 1- 24" Adaptor F&B
- 1- 24" Adaptor F&S
- 1-Type A M.H. 6.0' deep
(BWS fig. 8)
- 1- 20" M.H. frame & cover (BWS fig. 8)
- 1- 6" M.H. frame & cover (BWS fig. 5)


Sta. 74+70 83' 9" L

- 1- 24" 45° bend
- 1- Conc. blk.

Sta. 76+35
1- 24" 22° bend (B.Y.)
1- Conc. blk.



Sta. 76+15
1- 24" 22° bend (T.Y.)
1- Conc. blk.

MATCHLINE # Sta. 64+00

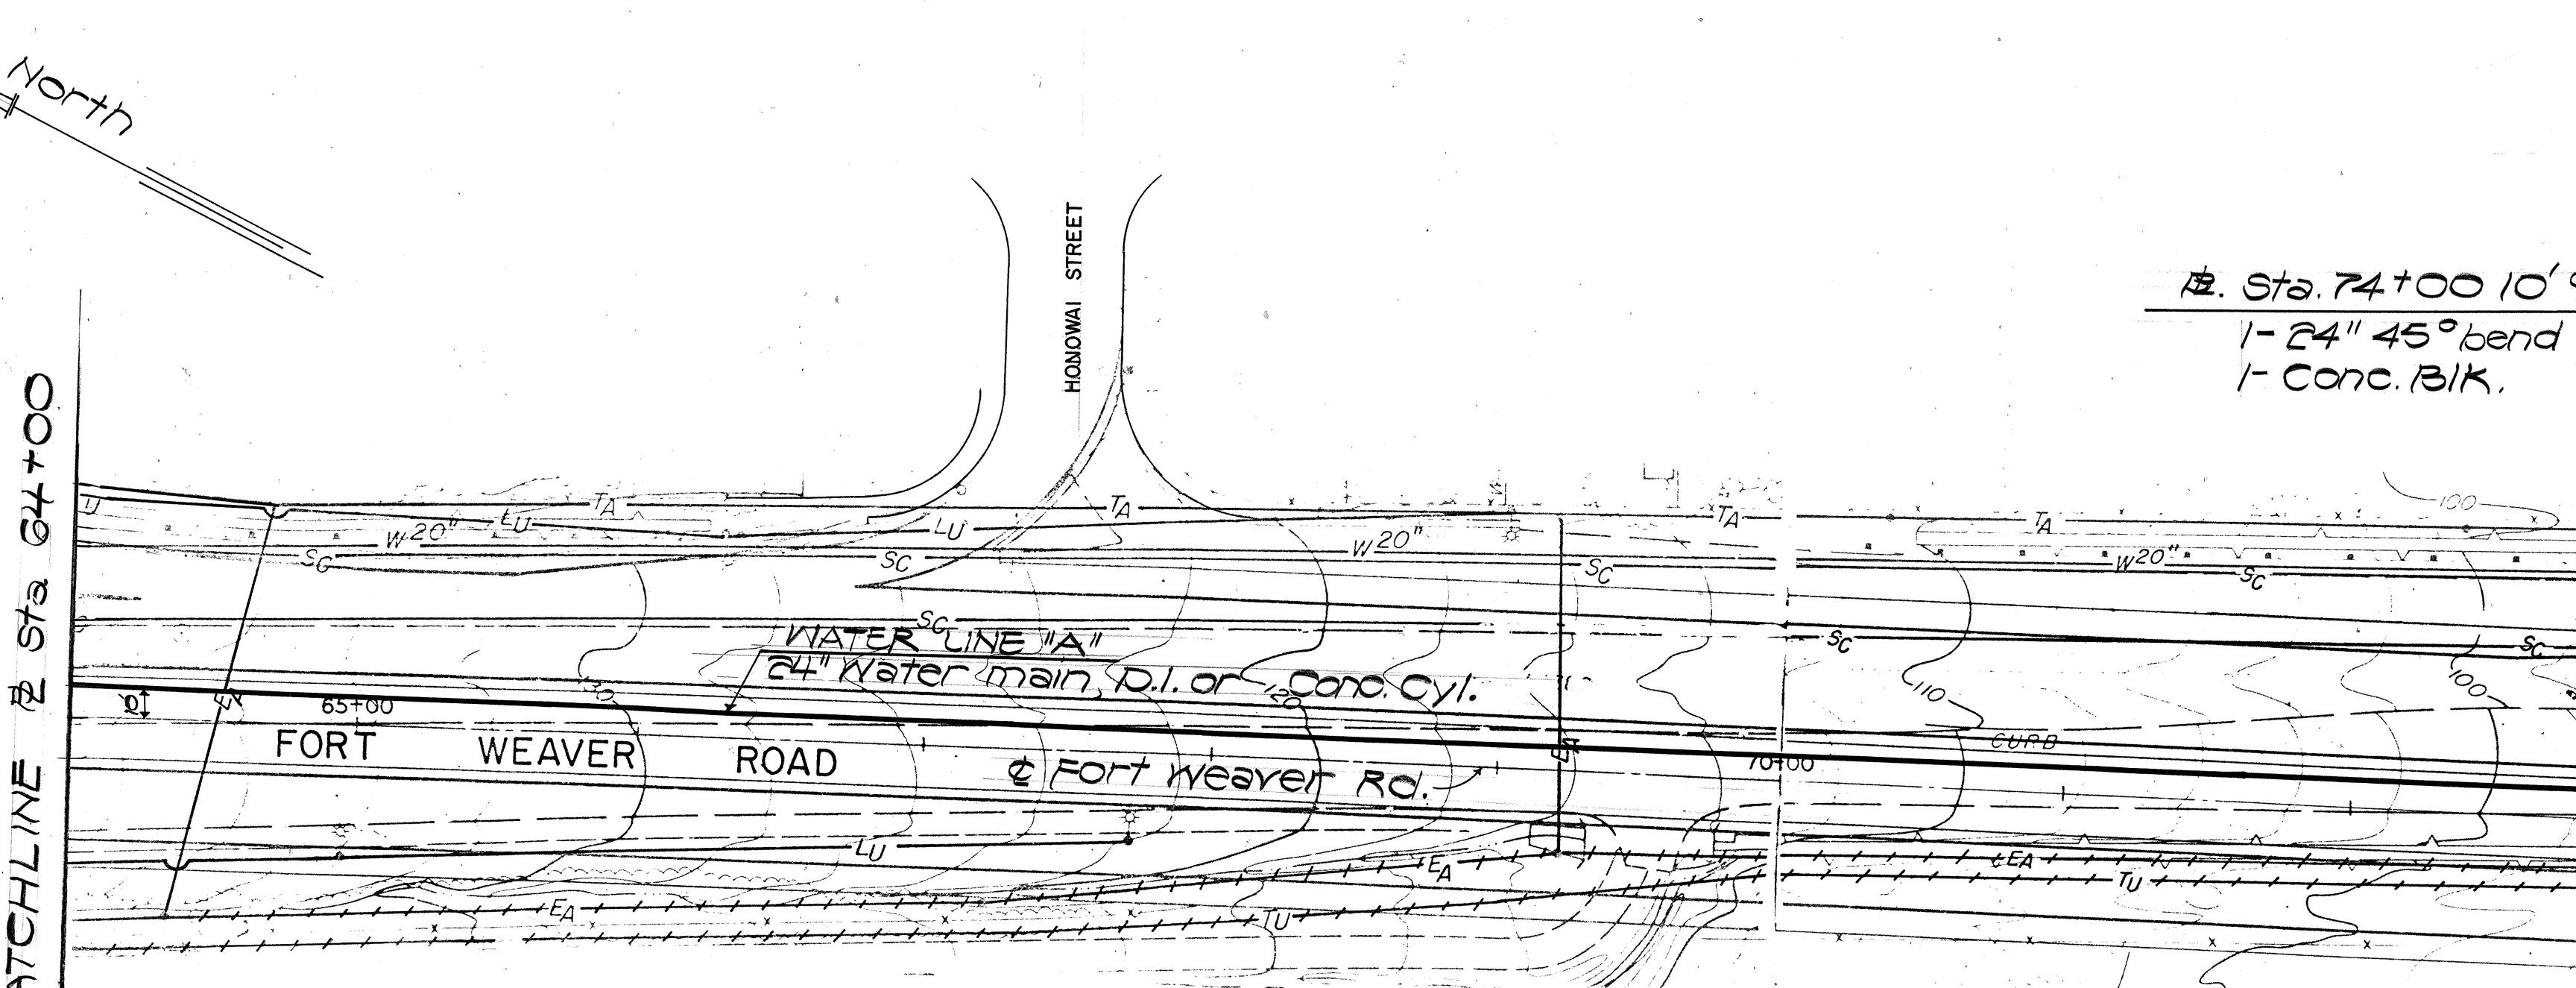

PLAN

scale 1" = 50'

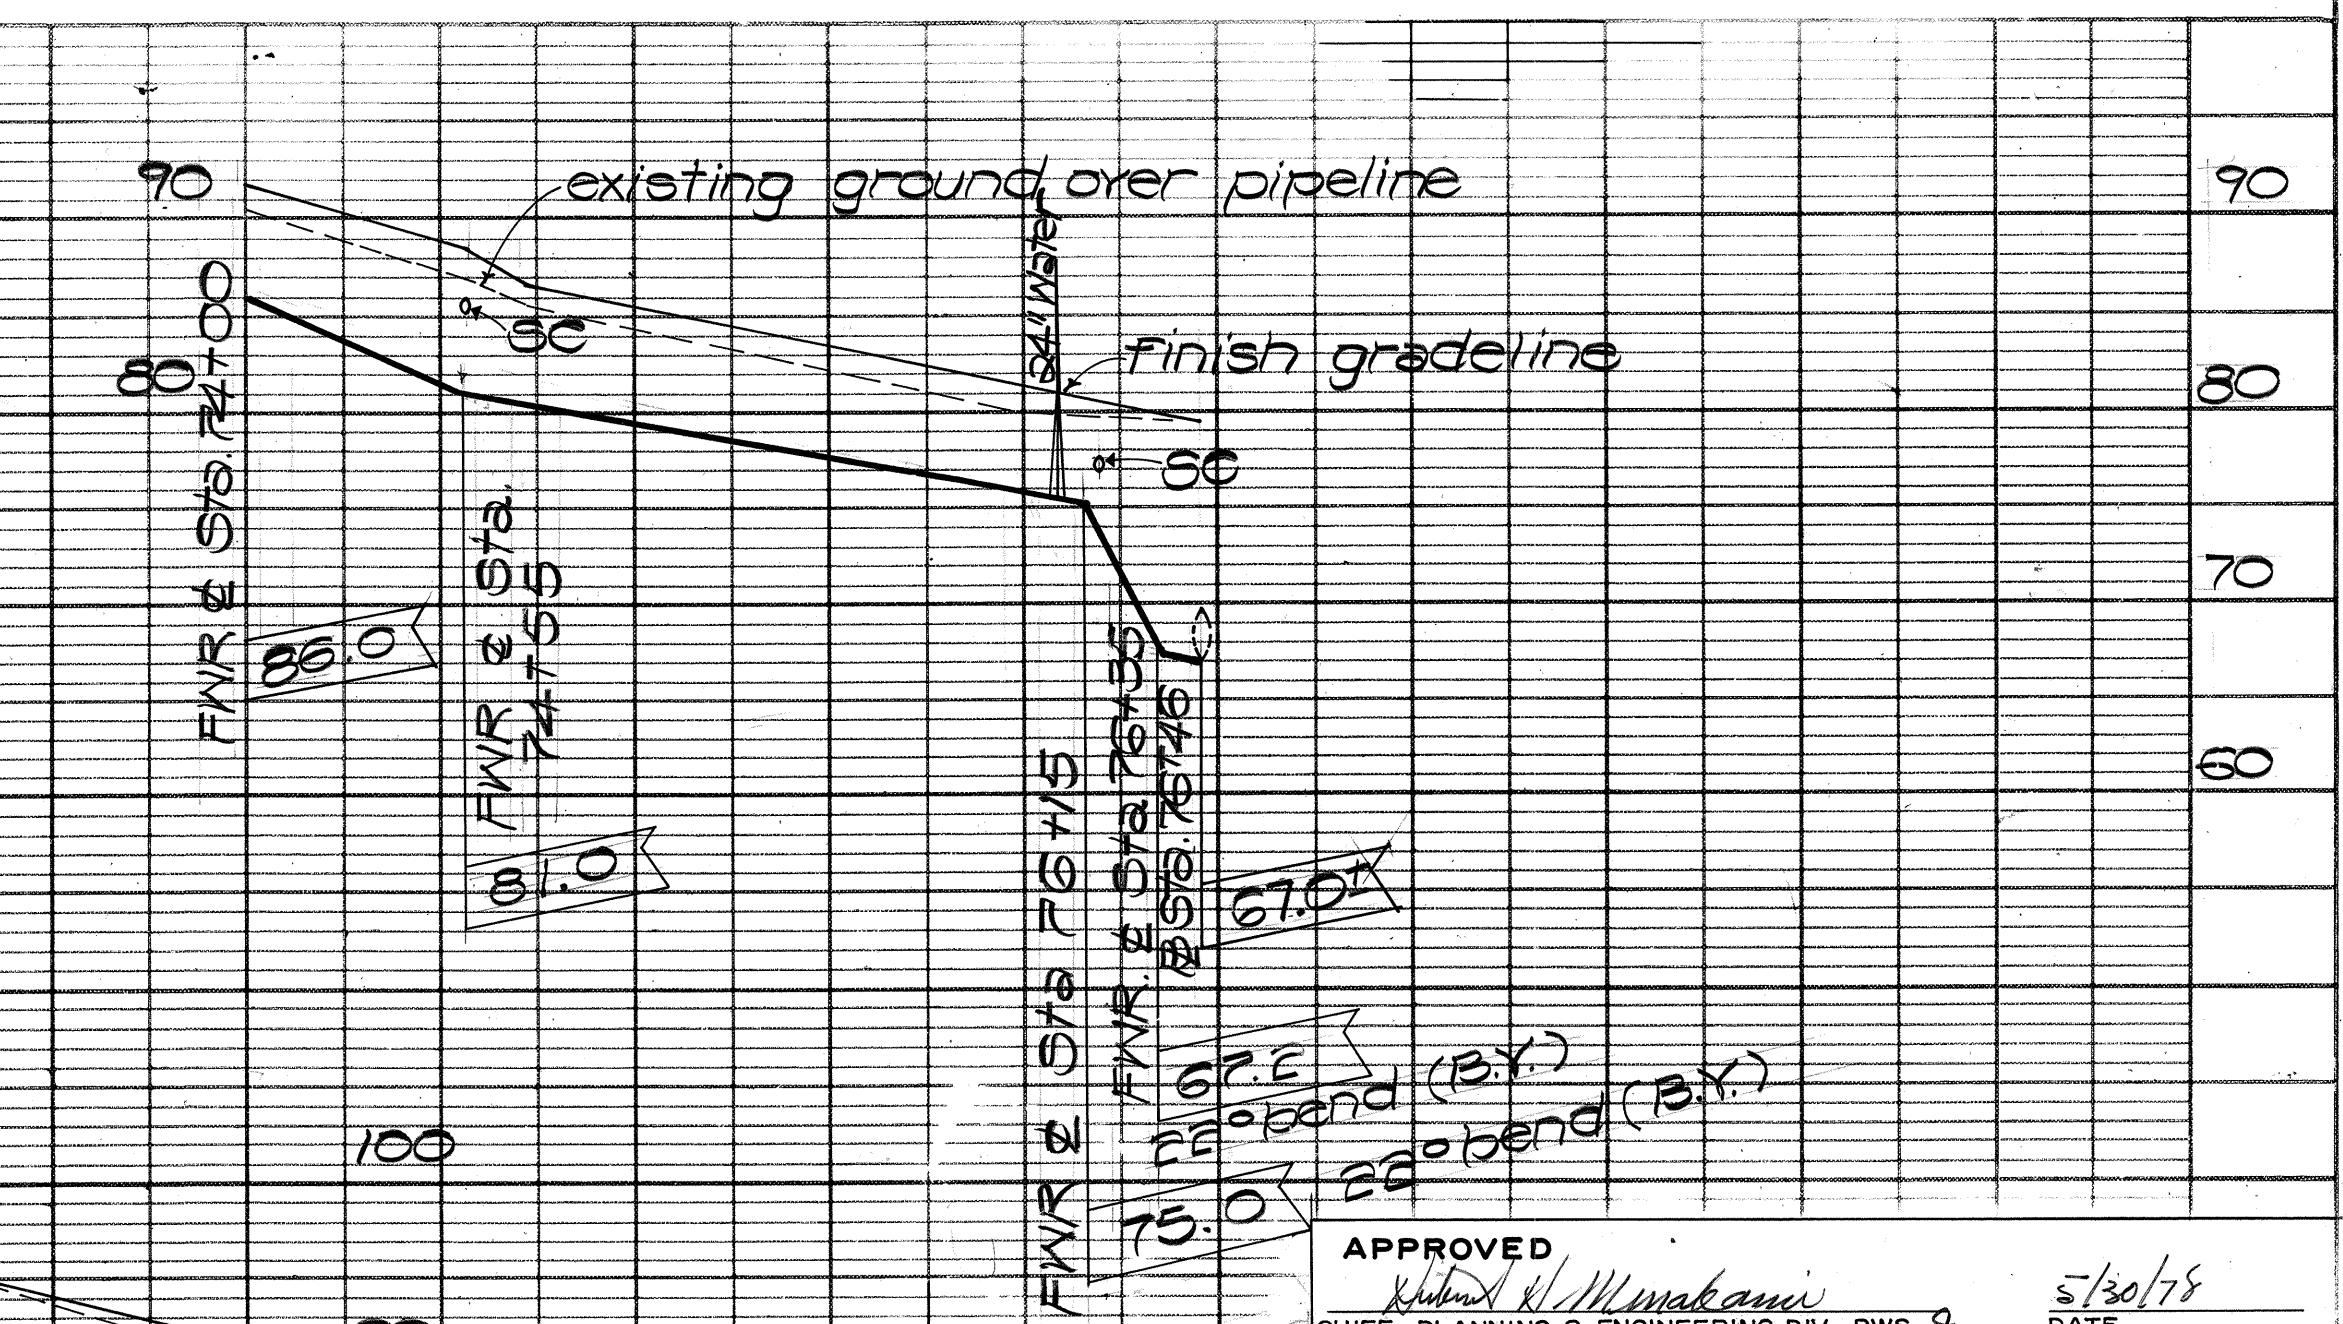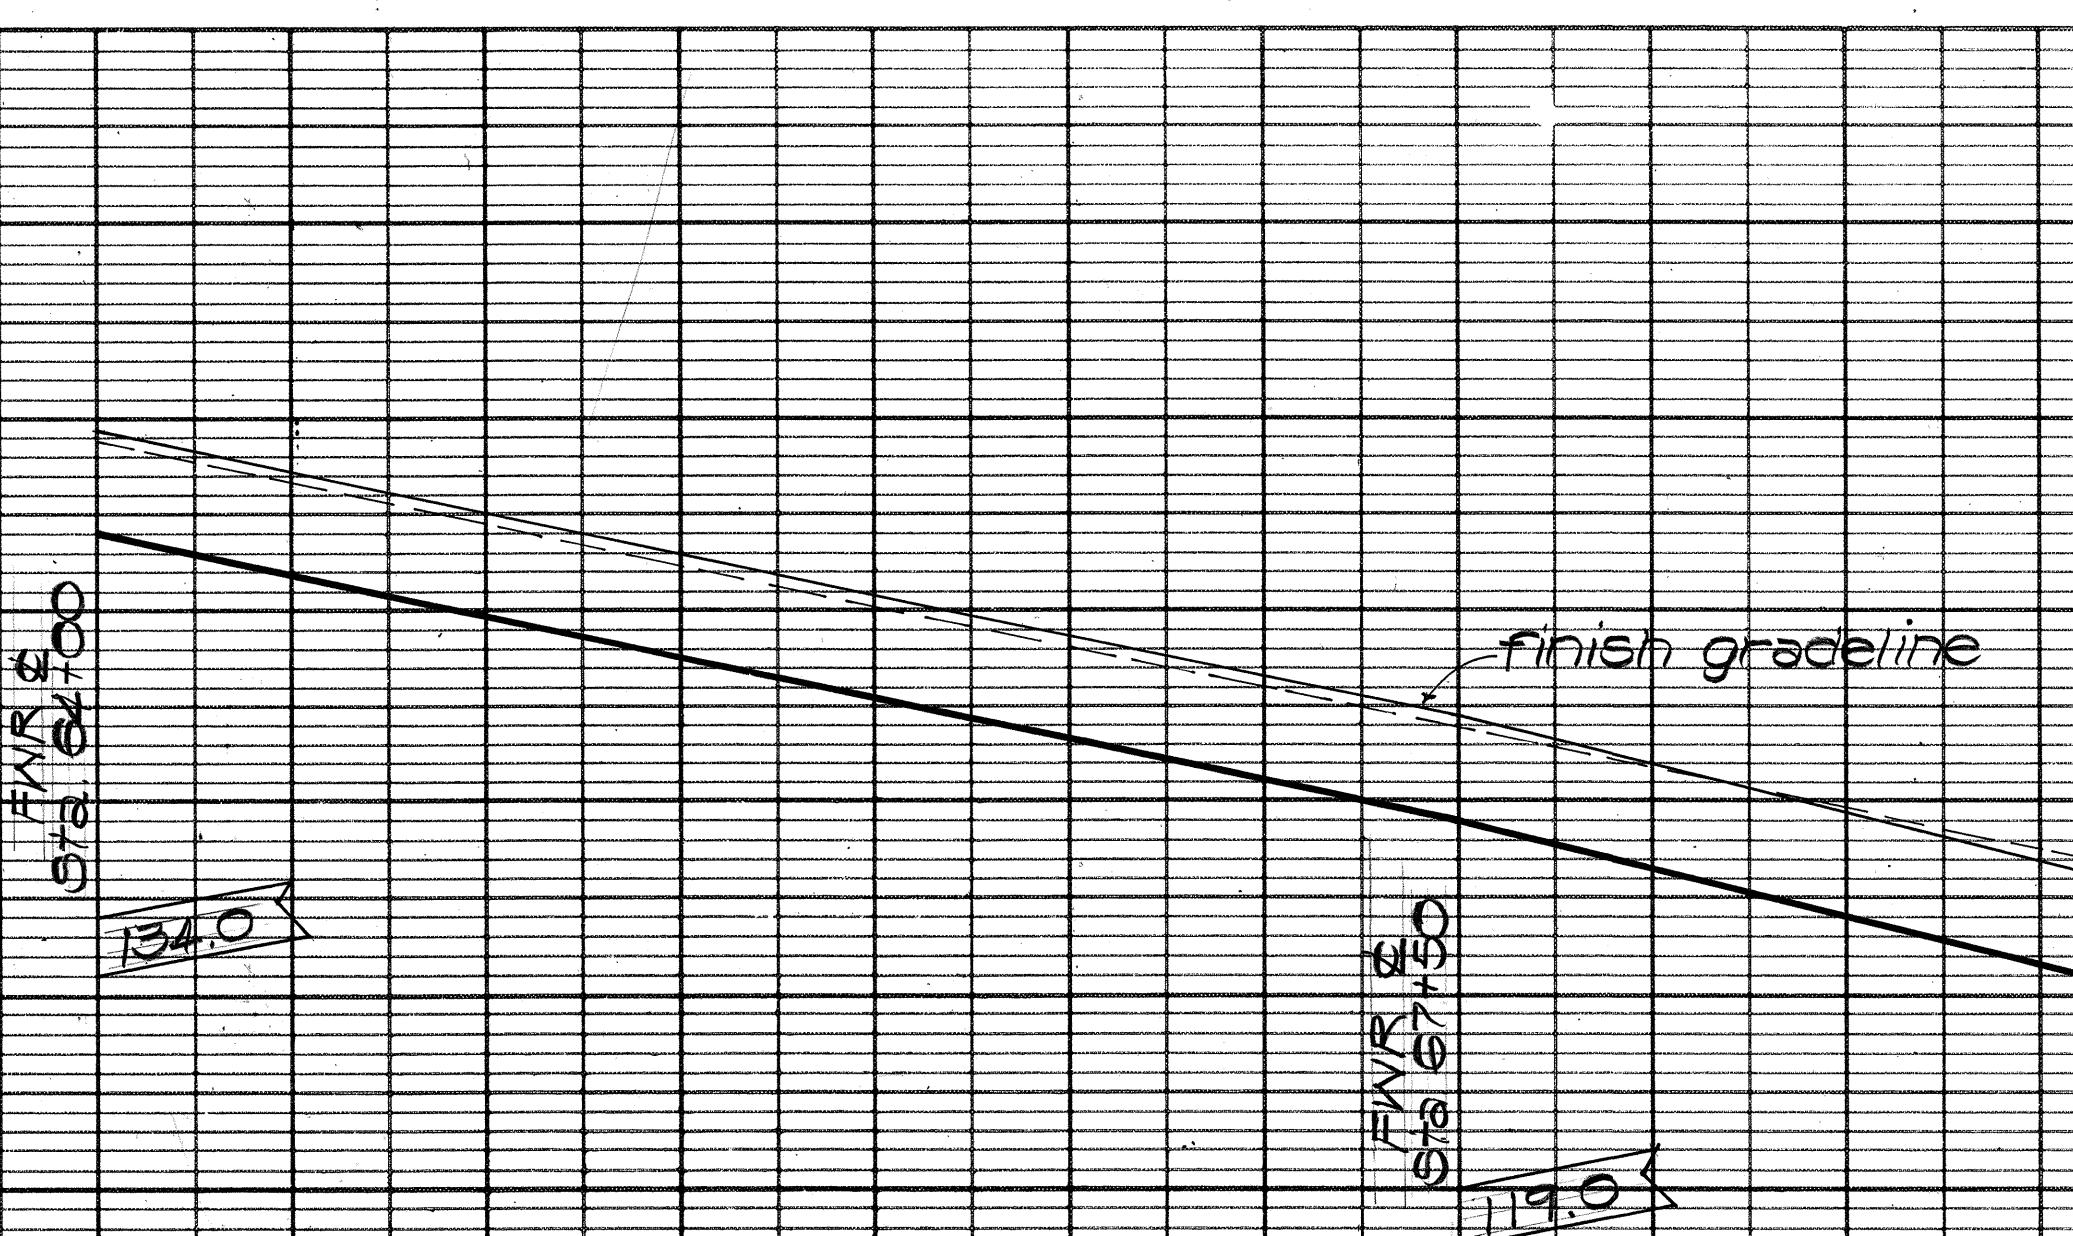

PROFILE

SC. Horiz. 1" = 50'
Vert. 1" = 10'

STATE OF HAWAII
DEPARTMENT OF TRANSPORTATION
HIGHWAYS DIVISION

WATER LINE 'A'

KUNIA ROAD 24 INCH WATER

MAIN FROM KUNIA WELLS I

TO WAIPAHU STREET

FORT WEAVER ROAD
ROUTE H-1 TO SOUTH OF
FARRINGTON HIGHWAY

SHEET No. 107 OF SHEETS

FED. ROAD DIST. NO.	STATE	FED. AID PROJ. NO.	FISCAL YEAR	SHEET NO.	TOTAL SHEETS
HAWAII	HAW.	M-7600(1)	1978	108	198

Sta. 0+00
Conn. to exist. main
KUNIA RESERVOIR SITE

2- 20"x20" Tee

1- 20" Butterfly valve FE CL. 150

1- 20" sleeve, 15" long

8-L.F. 20" D.I. pipe CL. 52

1-Type A M.H. 9.0" deep (BWS Fig 3)

1- 20" M.H. frame & cover (BWS Fig 6)

1- 6" M.H. frame & cover (BWS Fig 5)

2-Conc. blk. (1/4" thick strut)

2-20" D.I. Adaptor F&B

1-24"x20" Reducer S.S.

Bell end of 24" Conc. Cyl.

pipe to fit D.I. pipe O.D. 25.80"

TEMP FOR TESTING

- Temp. cleanout

w/ M.J. cap

Pipeline Sta. (-) 0+17

1-20" 1/2 bend (BY)

1-Conc. Blk.

Check Valve Assembly

See Details Below

Pipeline Sta. 1+07 74

1-24" 45° bend

1-conc. blk.

Sta. (-) 0+73
Connect to exist. 20" water

1- 20"x20" Tee

1- 20" Sleeve, 15" Long

8-L.F. 20" D.I. Pipe, CL. 52

1-Conc. Blk. w/ struct. strut

TEMP FOR TESTING

- Temp. cleanout

w/ M.J. cap

Pipeline Sta. (-) 0+35

1- 20" 1/2 bend (TV)

1-Conc. block

20" Ductile Iron pipe CL. 52

KUNIA INTERCHANGE

STRUCTURE

CRM WALL



CRM DITCH

CRM

SC M.H.

SC

FED. ROAD DIST. NO.	STATE	FED. AID PROJ. NO.	FISCAL YEAR	SHEET NO.	TOTAL SHEETS
HAWAII	HAW.	M-7600(1)	1978	109	198

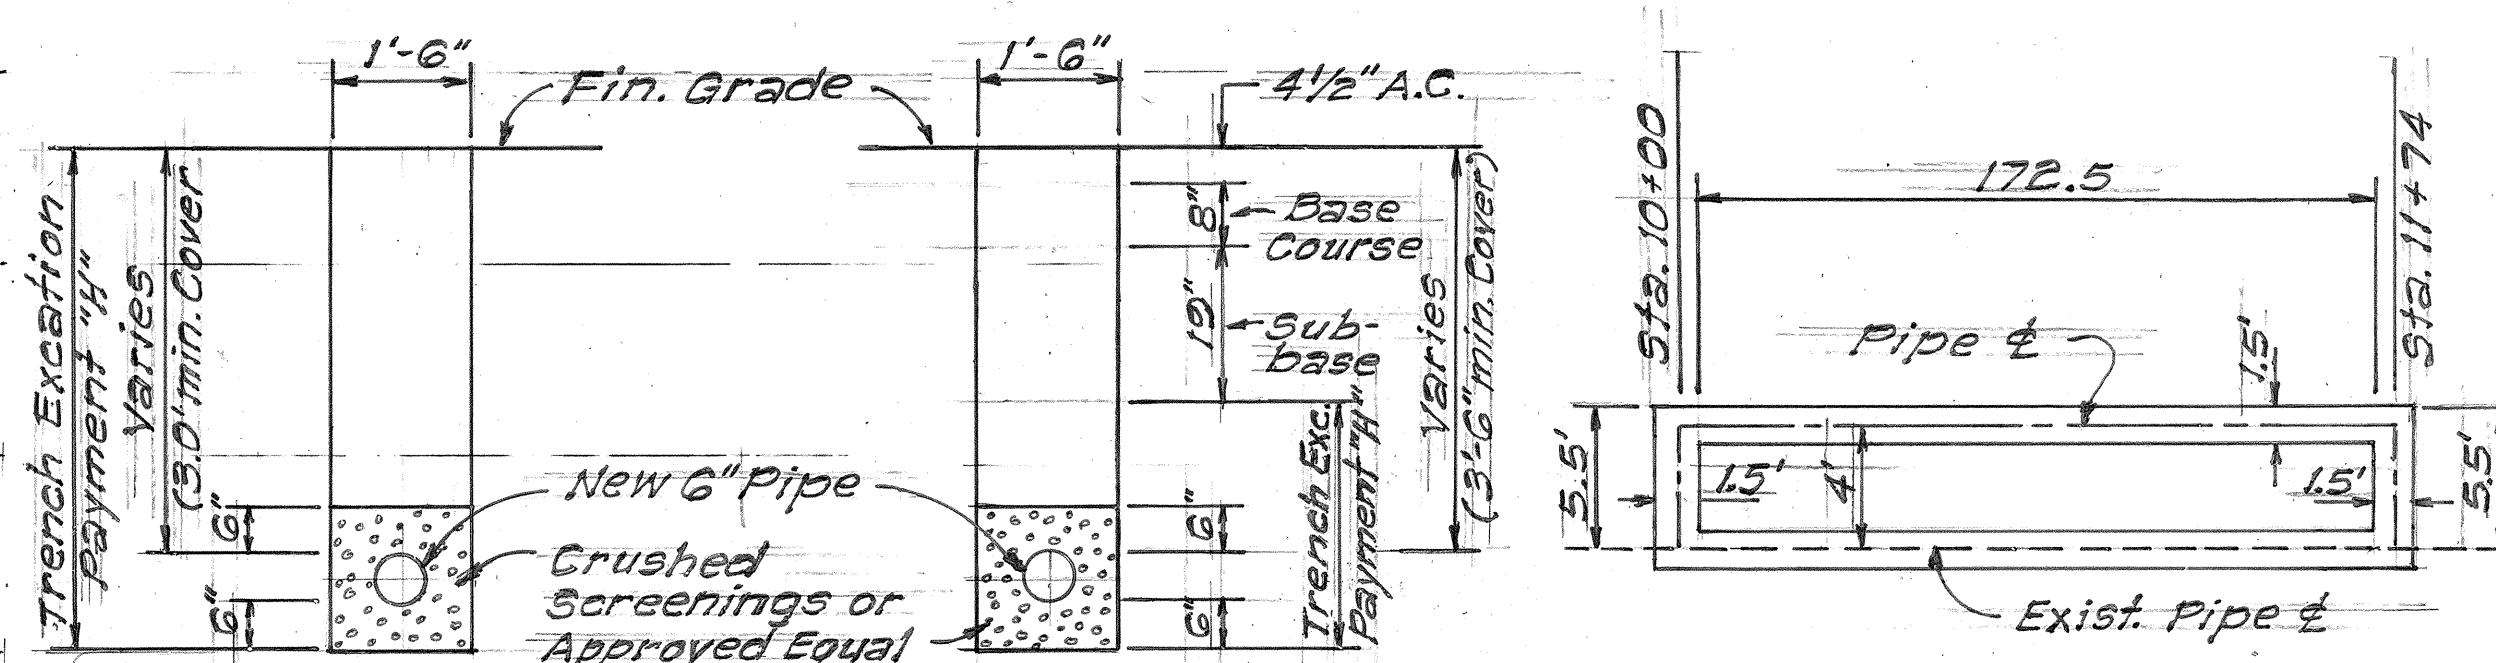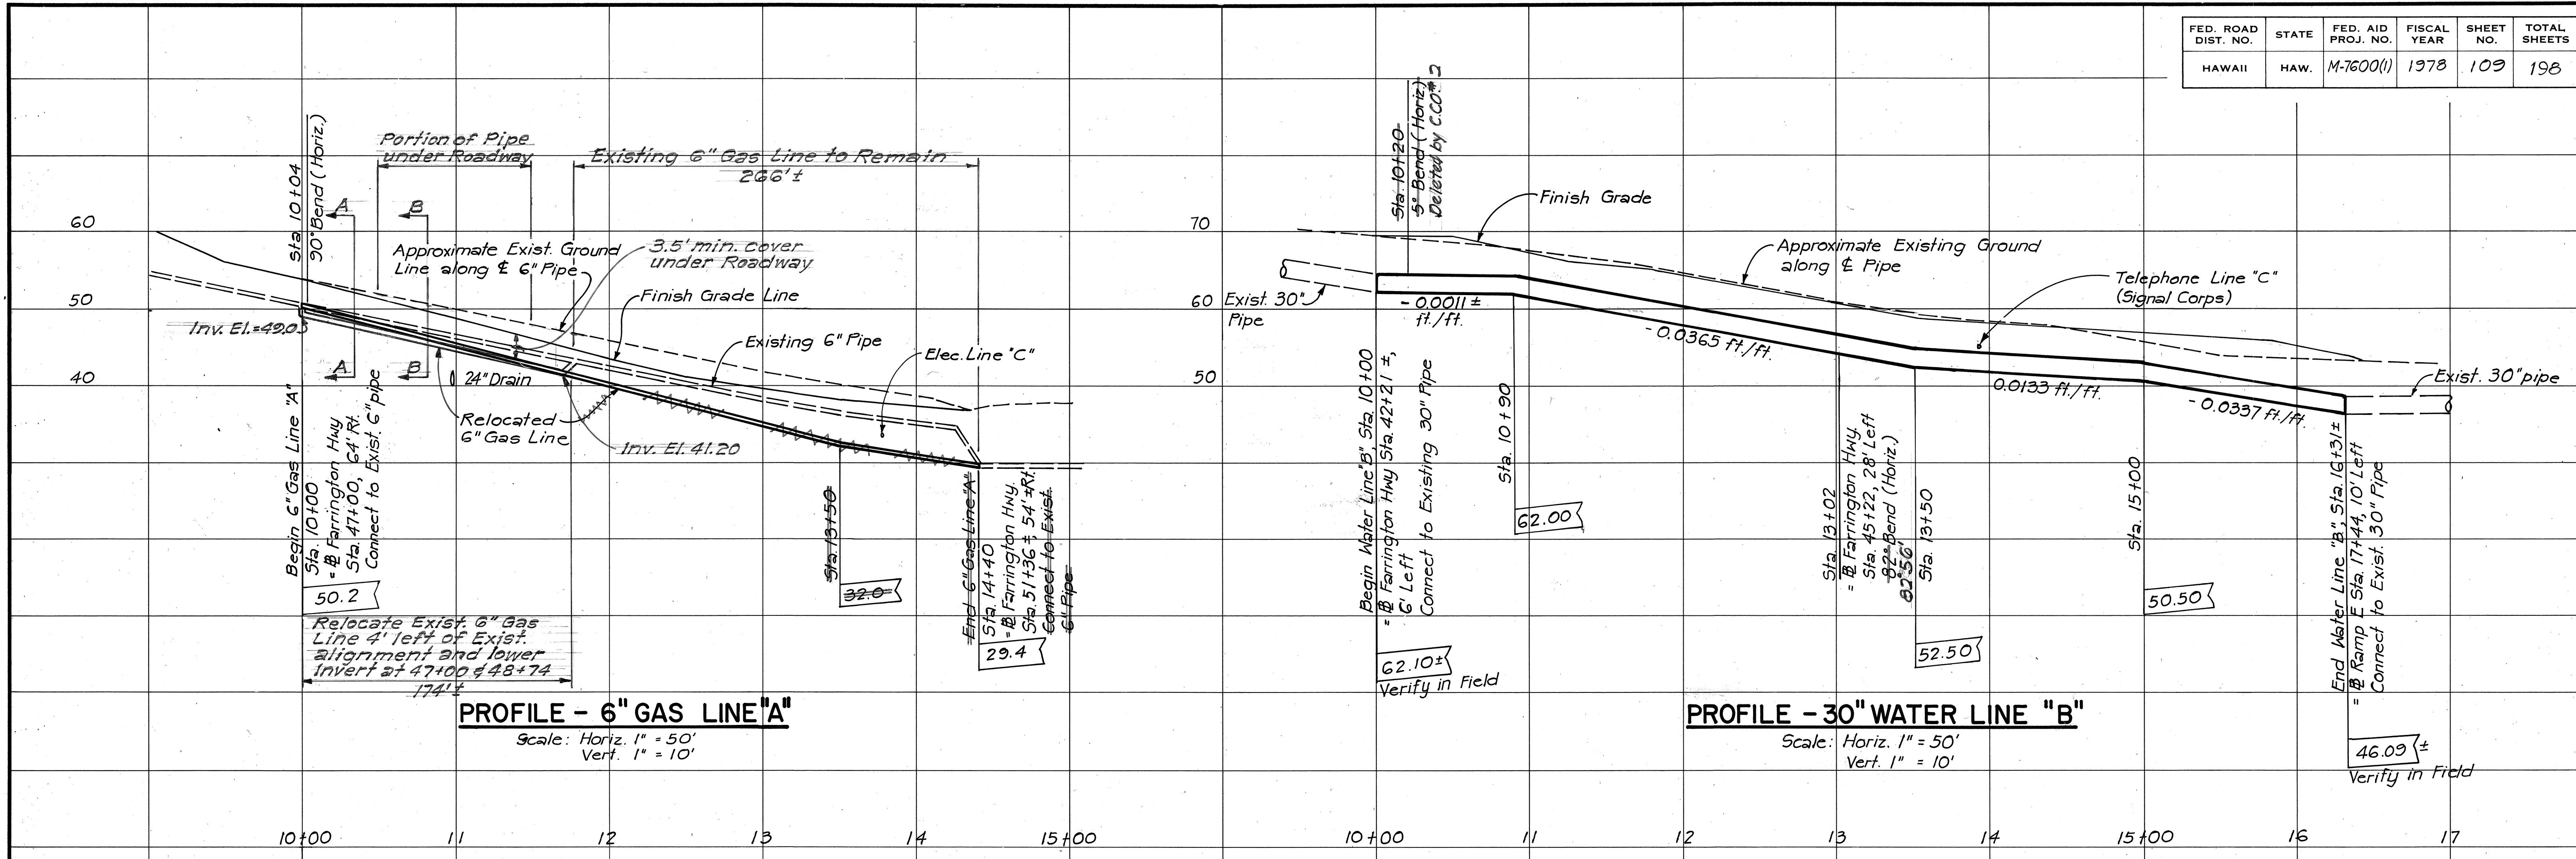


A-A
OTHER THAN
UNDER ROADWAY
NTS

B-B
UNDER ROADWAY
NTS

TRENCH PLAN FOR VOLUME CALCULATION
NTS

SURVEY PLOTTED BY
DRAWN BY
TRACED BY
DESIGNED BY
QUANTITIES BY
CHEKED BY
NOTE BOOK
NO.

Rubix A. Makanai
Chief, Planning & Engineering, BWS 4/12/78
Gas Co., Inc.

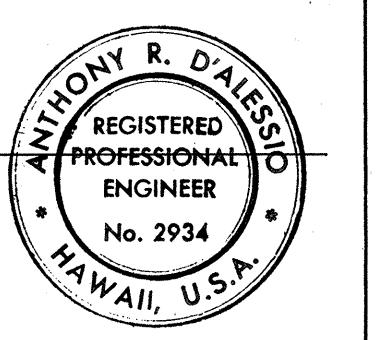

THIS WORK WAS PREPARED BY
ME OR UNDER MY SUPERVISION.
L.P. D'Alessio


STATE OF HAWAII
DEPARTMENT OF TRANSPORTATION
HIGHWAYS DIVISION

UTILITIES PROFILES

FORT WEAVER ROAD
ROUTE H-1 TO SOUTH OF
FARRINGTON HIGHWAY

SCALE AS SHOWN DATE: AUG. 1978
SHEET NO. 8U OF 33U SHEETS

ED. ROAD DIST. NO.	STATE	FED. AID PROJ. NO.	FISCAL YEAR	SHEET NO.	TOTAL SHEETS
HAWAII	HAW.	M-7600(1)	1978	110	198

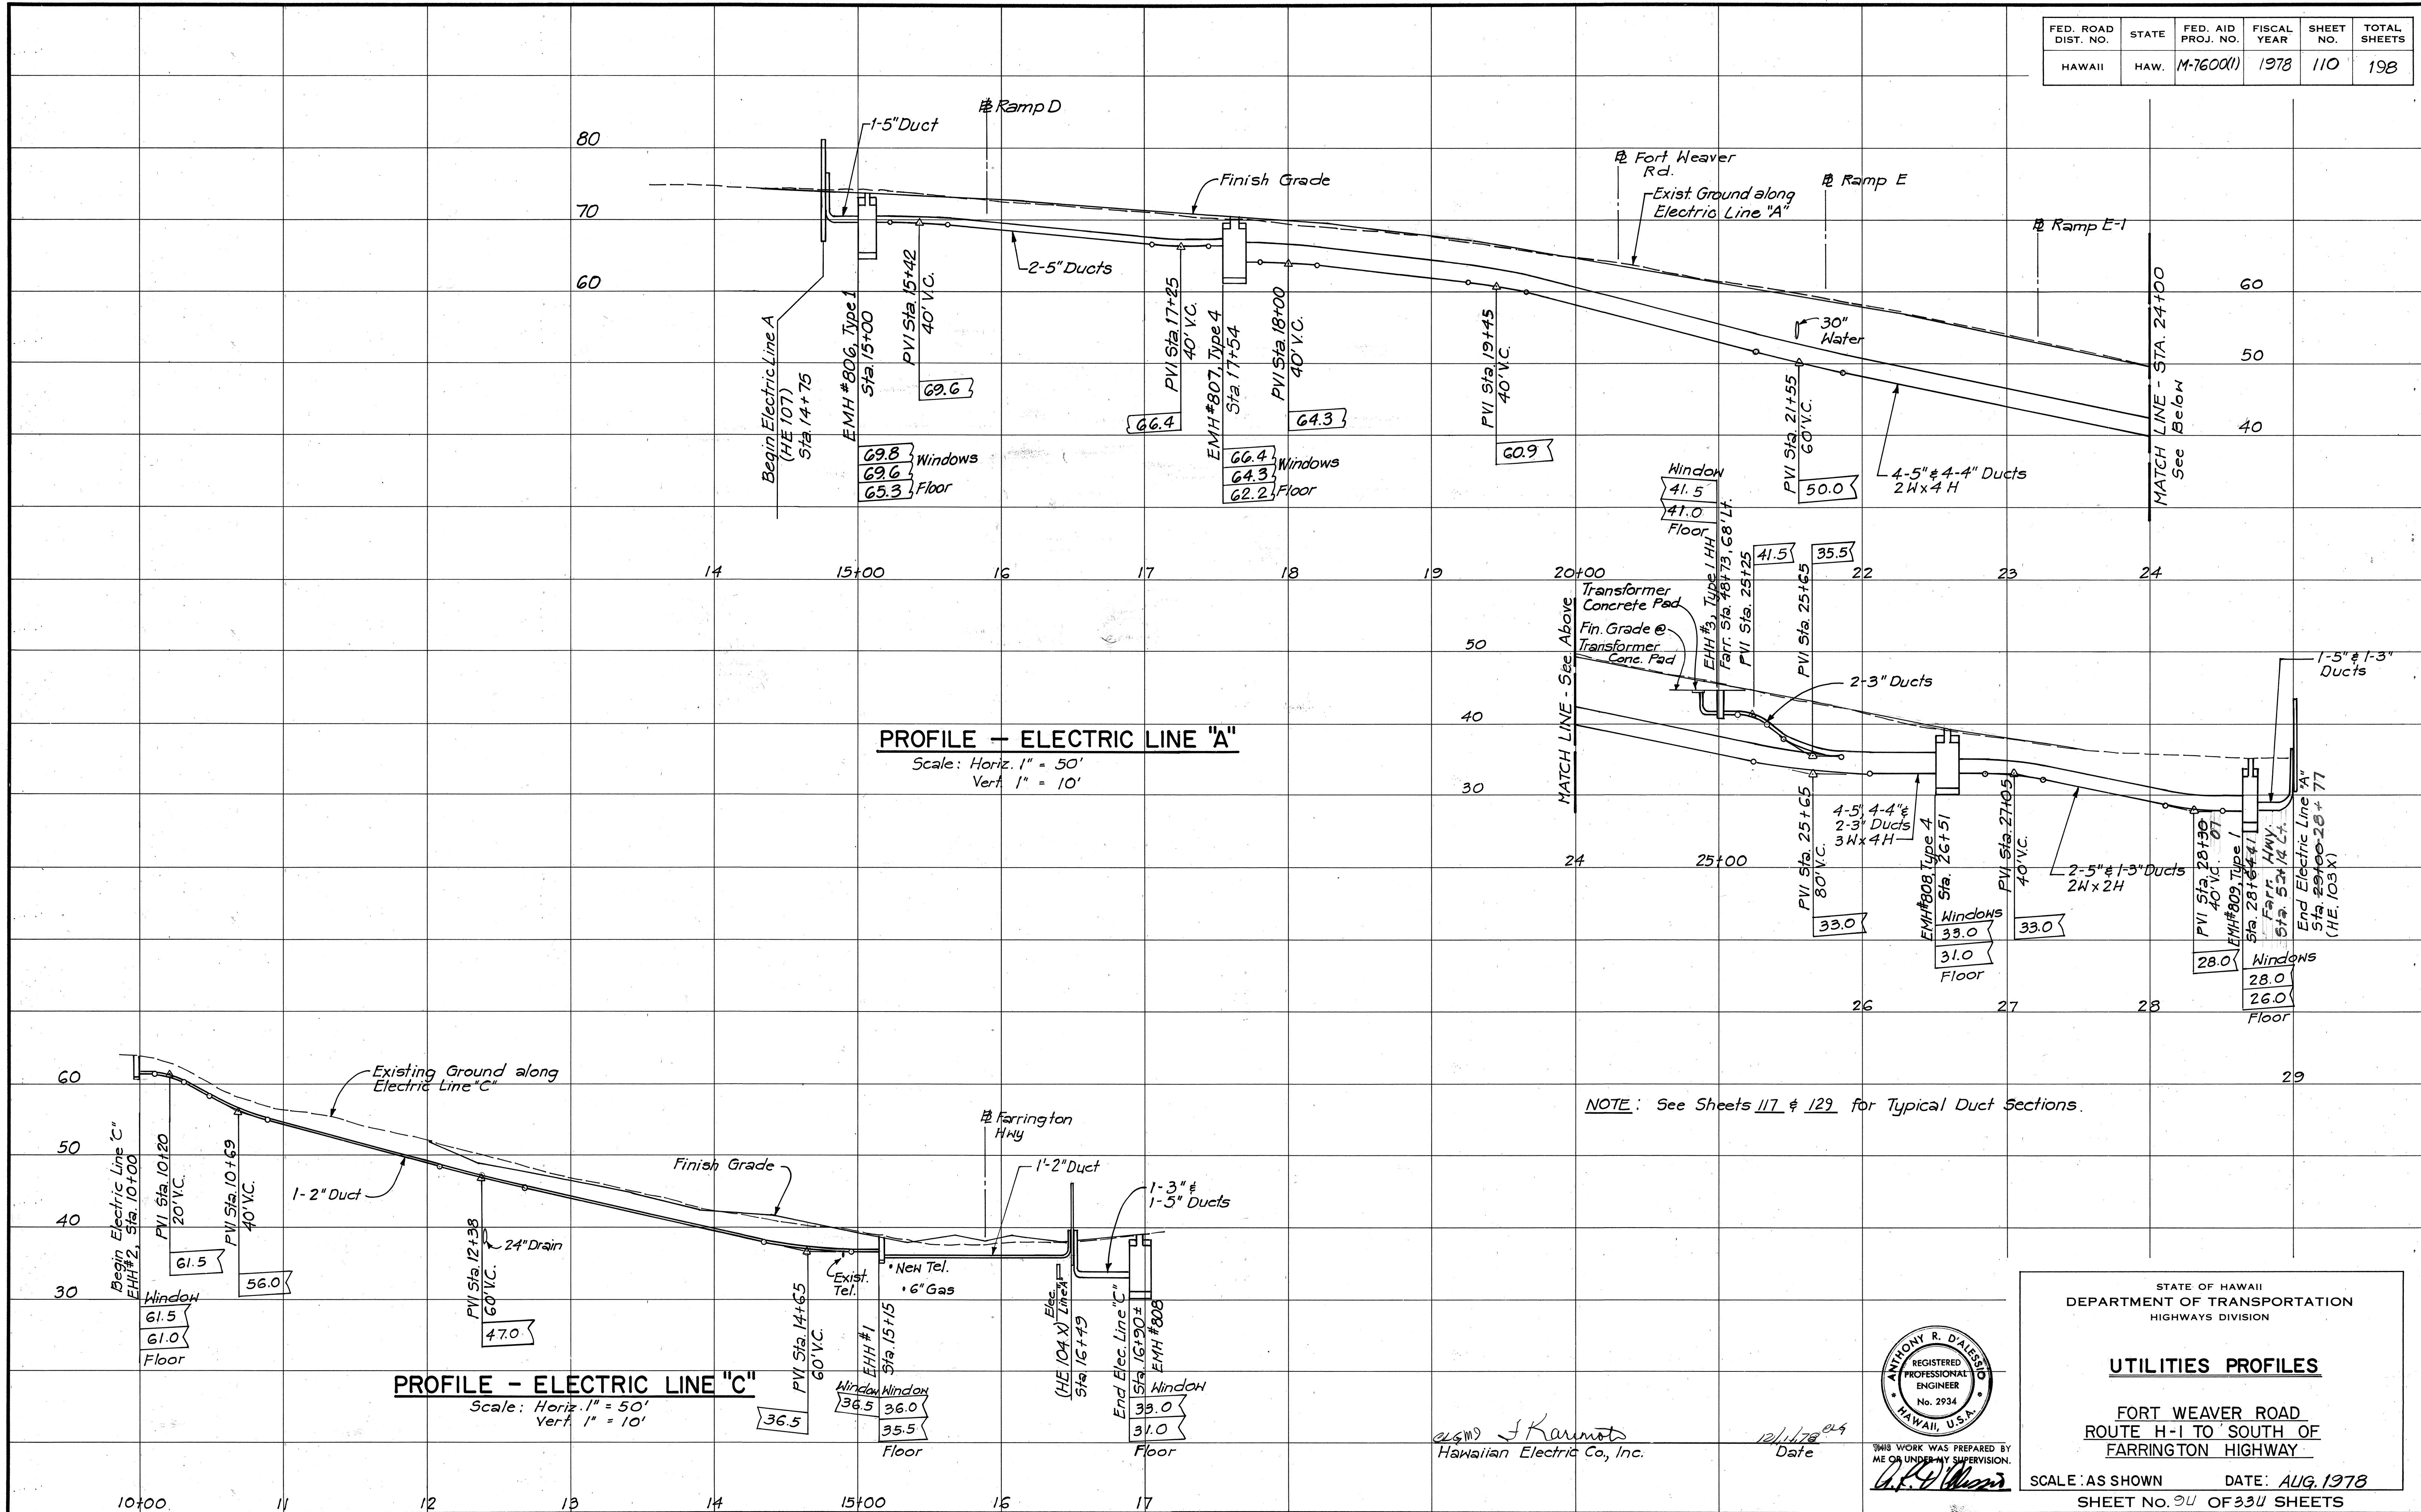

ORIGINAL PLAN	SURVEY PLOTTED BY DRAWN BY TRACED BY	DATE
NOTE BOOK	DESIGNED BY QUANTITIES BY	
NO.	CHECKED BY	

NOTE: See Sheets 117 & 129 for Typical Duct Sections.




**STATE OF HAWAII
DEPARTMENT OF TRANSPORTATION
HIGHWAYS DIVISION**

UTILITIES PROFILES

FORT WEAVER ROAD
ROUTE H-1 TO SOUTH OF
FARRINGTON HIGHWAY

SCALE : AS SHOWN DATE: AUG. 1978
SHEET NO. 9U OF 33U SHEETS


D. ROAD ST. NO.	STATE	FED. AID PROJ. NO.	FISCAL YEAR	SHEET NO.	TOTAL SHEETS
HAWAII	HAW.	M-7600(1)	1978	111	198

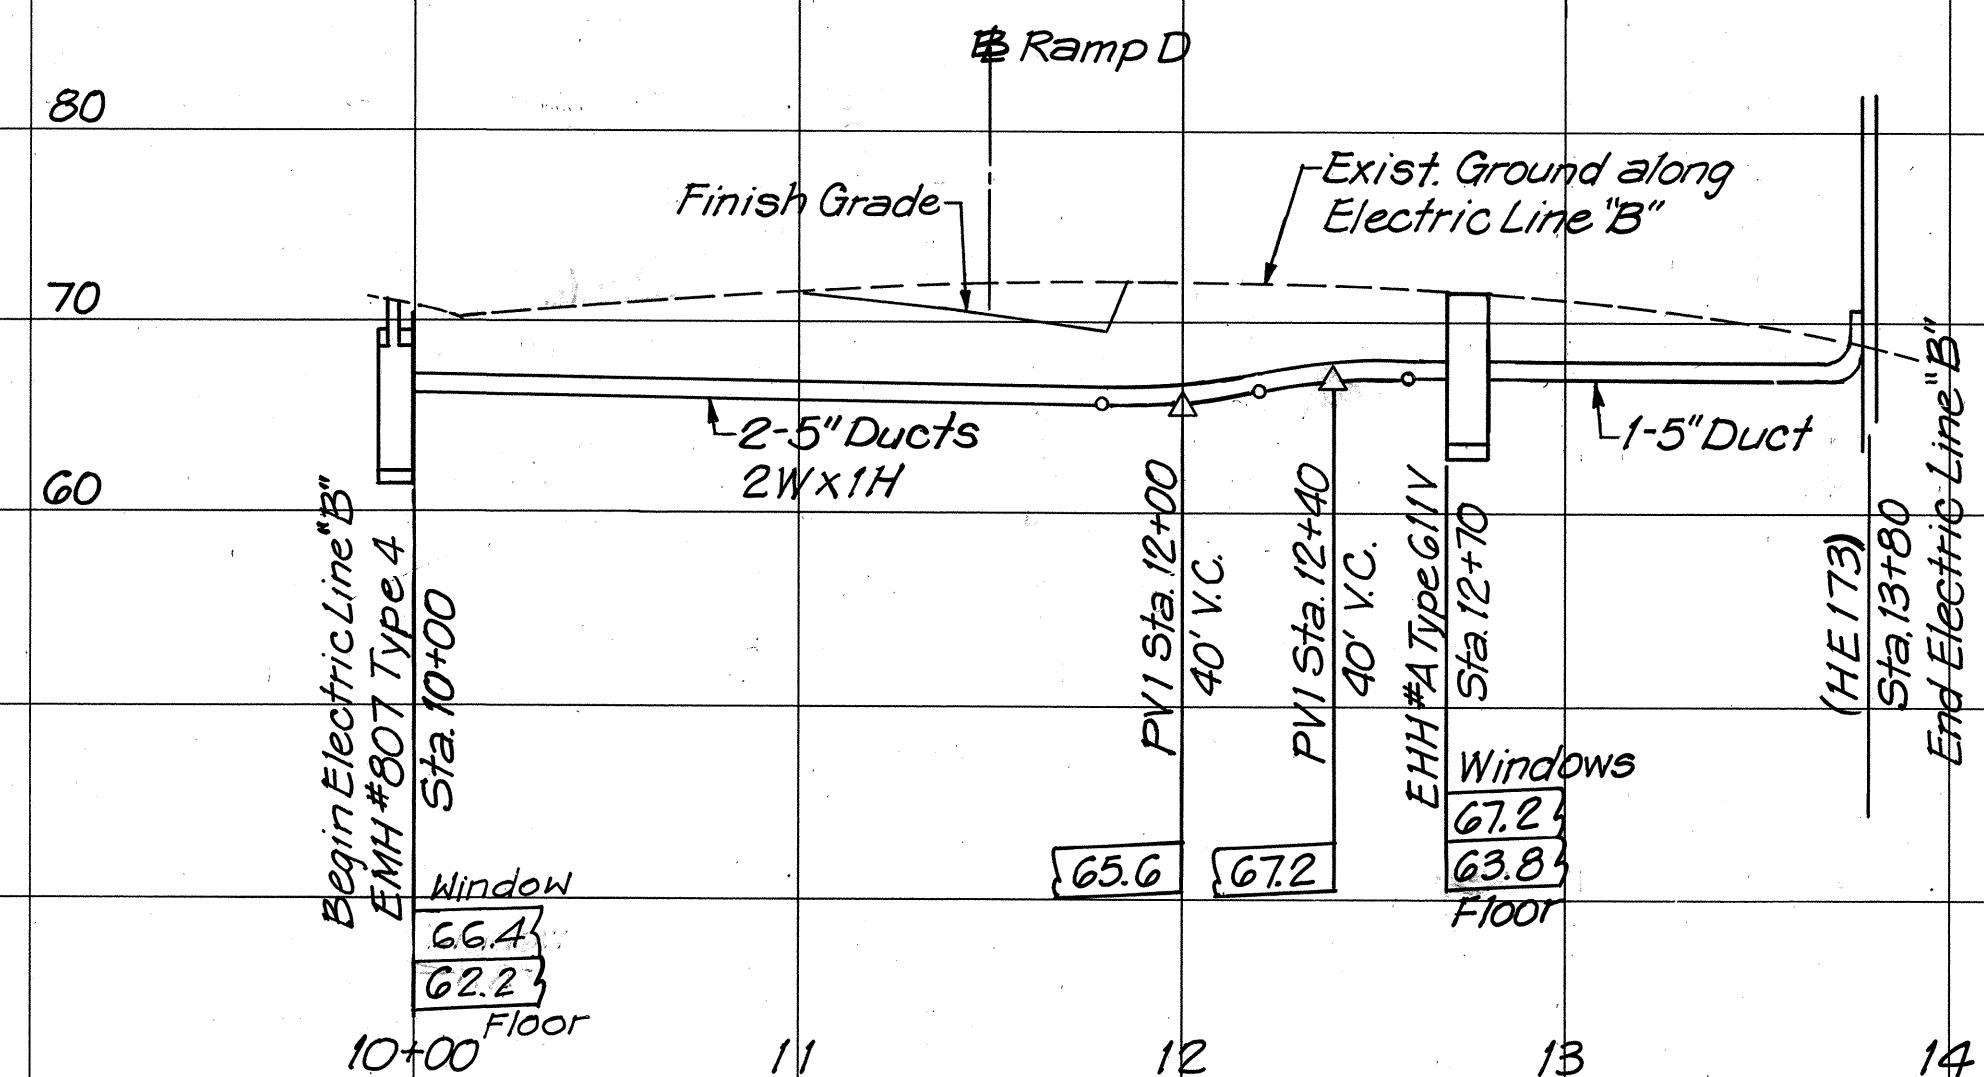

PROFILE - ELECTRIC LINE "B"

Scale: Horiz. 1" = 50'
Vert. 1" = 10'

NOTE: See Sheets 117 & 129 for Typical HECO Duct Sections.

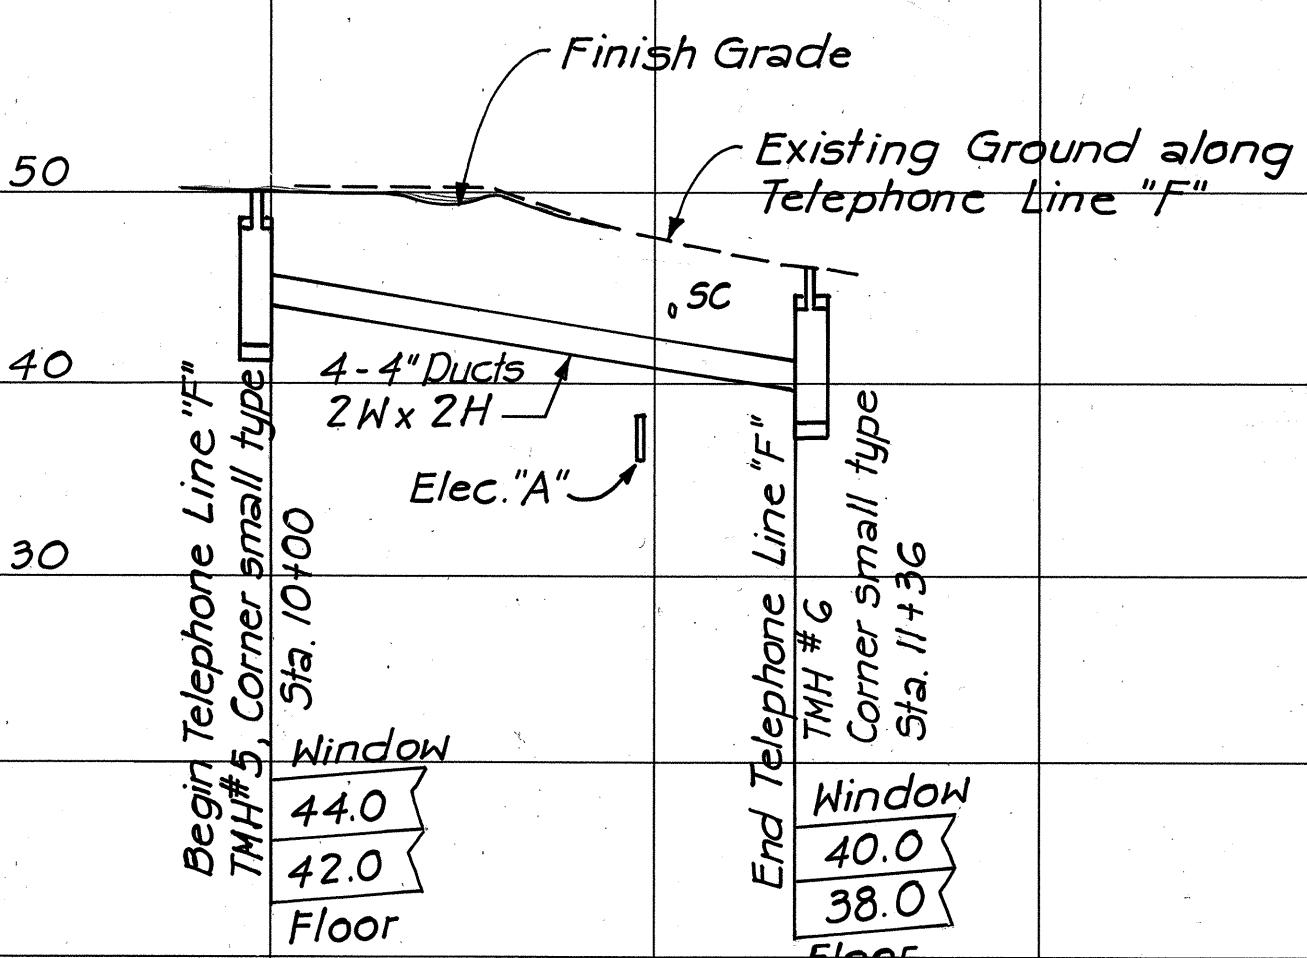

PROFILE - TELEPHONE LINE "F"

Scale: Horiz. 1" = 50'
Vert. 1" = 10'

10 + 00 11 12

Aug 19 J Karmot
Hawaiian Electric Co., Inc.
Olamada
Honolulu Telephone Co.

12/1/78 049
Date
4/26/78
Bal.



THIS WORK WAS PREPARED BY
ME OR UNDER MY SUPERVISION.




STATE OF HAWAII
DEPARTMENT OF TRANSPORTATION

UTILITIES PROFILES


FORT WEAVER ROAD
ROUTE H-I TO SOUTH OF
FARRINGTON HIGHWAY

SCALE : AS SHOWN DATE: AUG. 1978
SHEET NO 104 OF 331 SHEETS


FED. ROAD DIST. NO.	STATE	FED. AID PROJ. NO.	FISCAL YEAR	SHEET NO.	TOTAL SHEETS
HAWAII	HAW.	M-7600(1)	1978	112	198

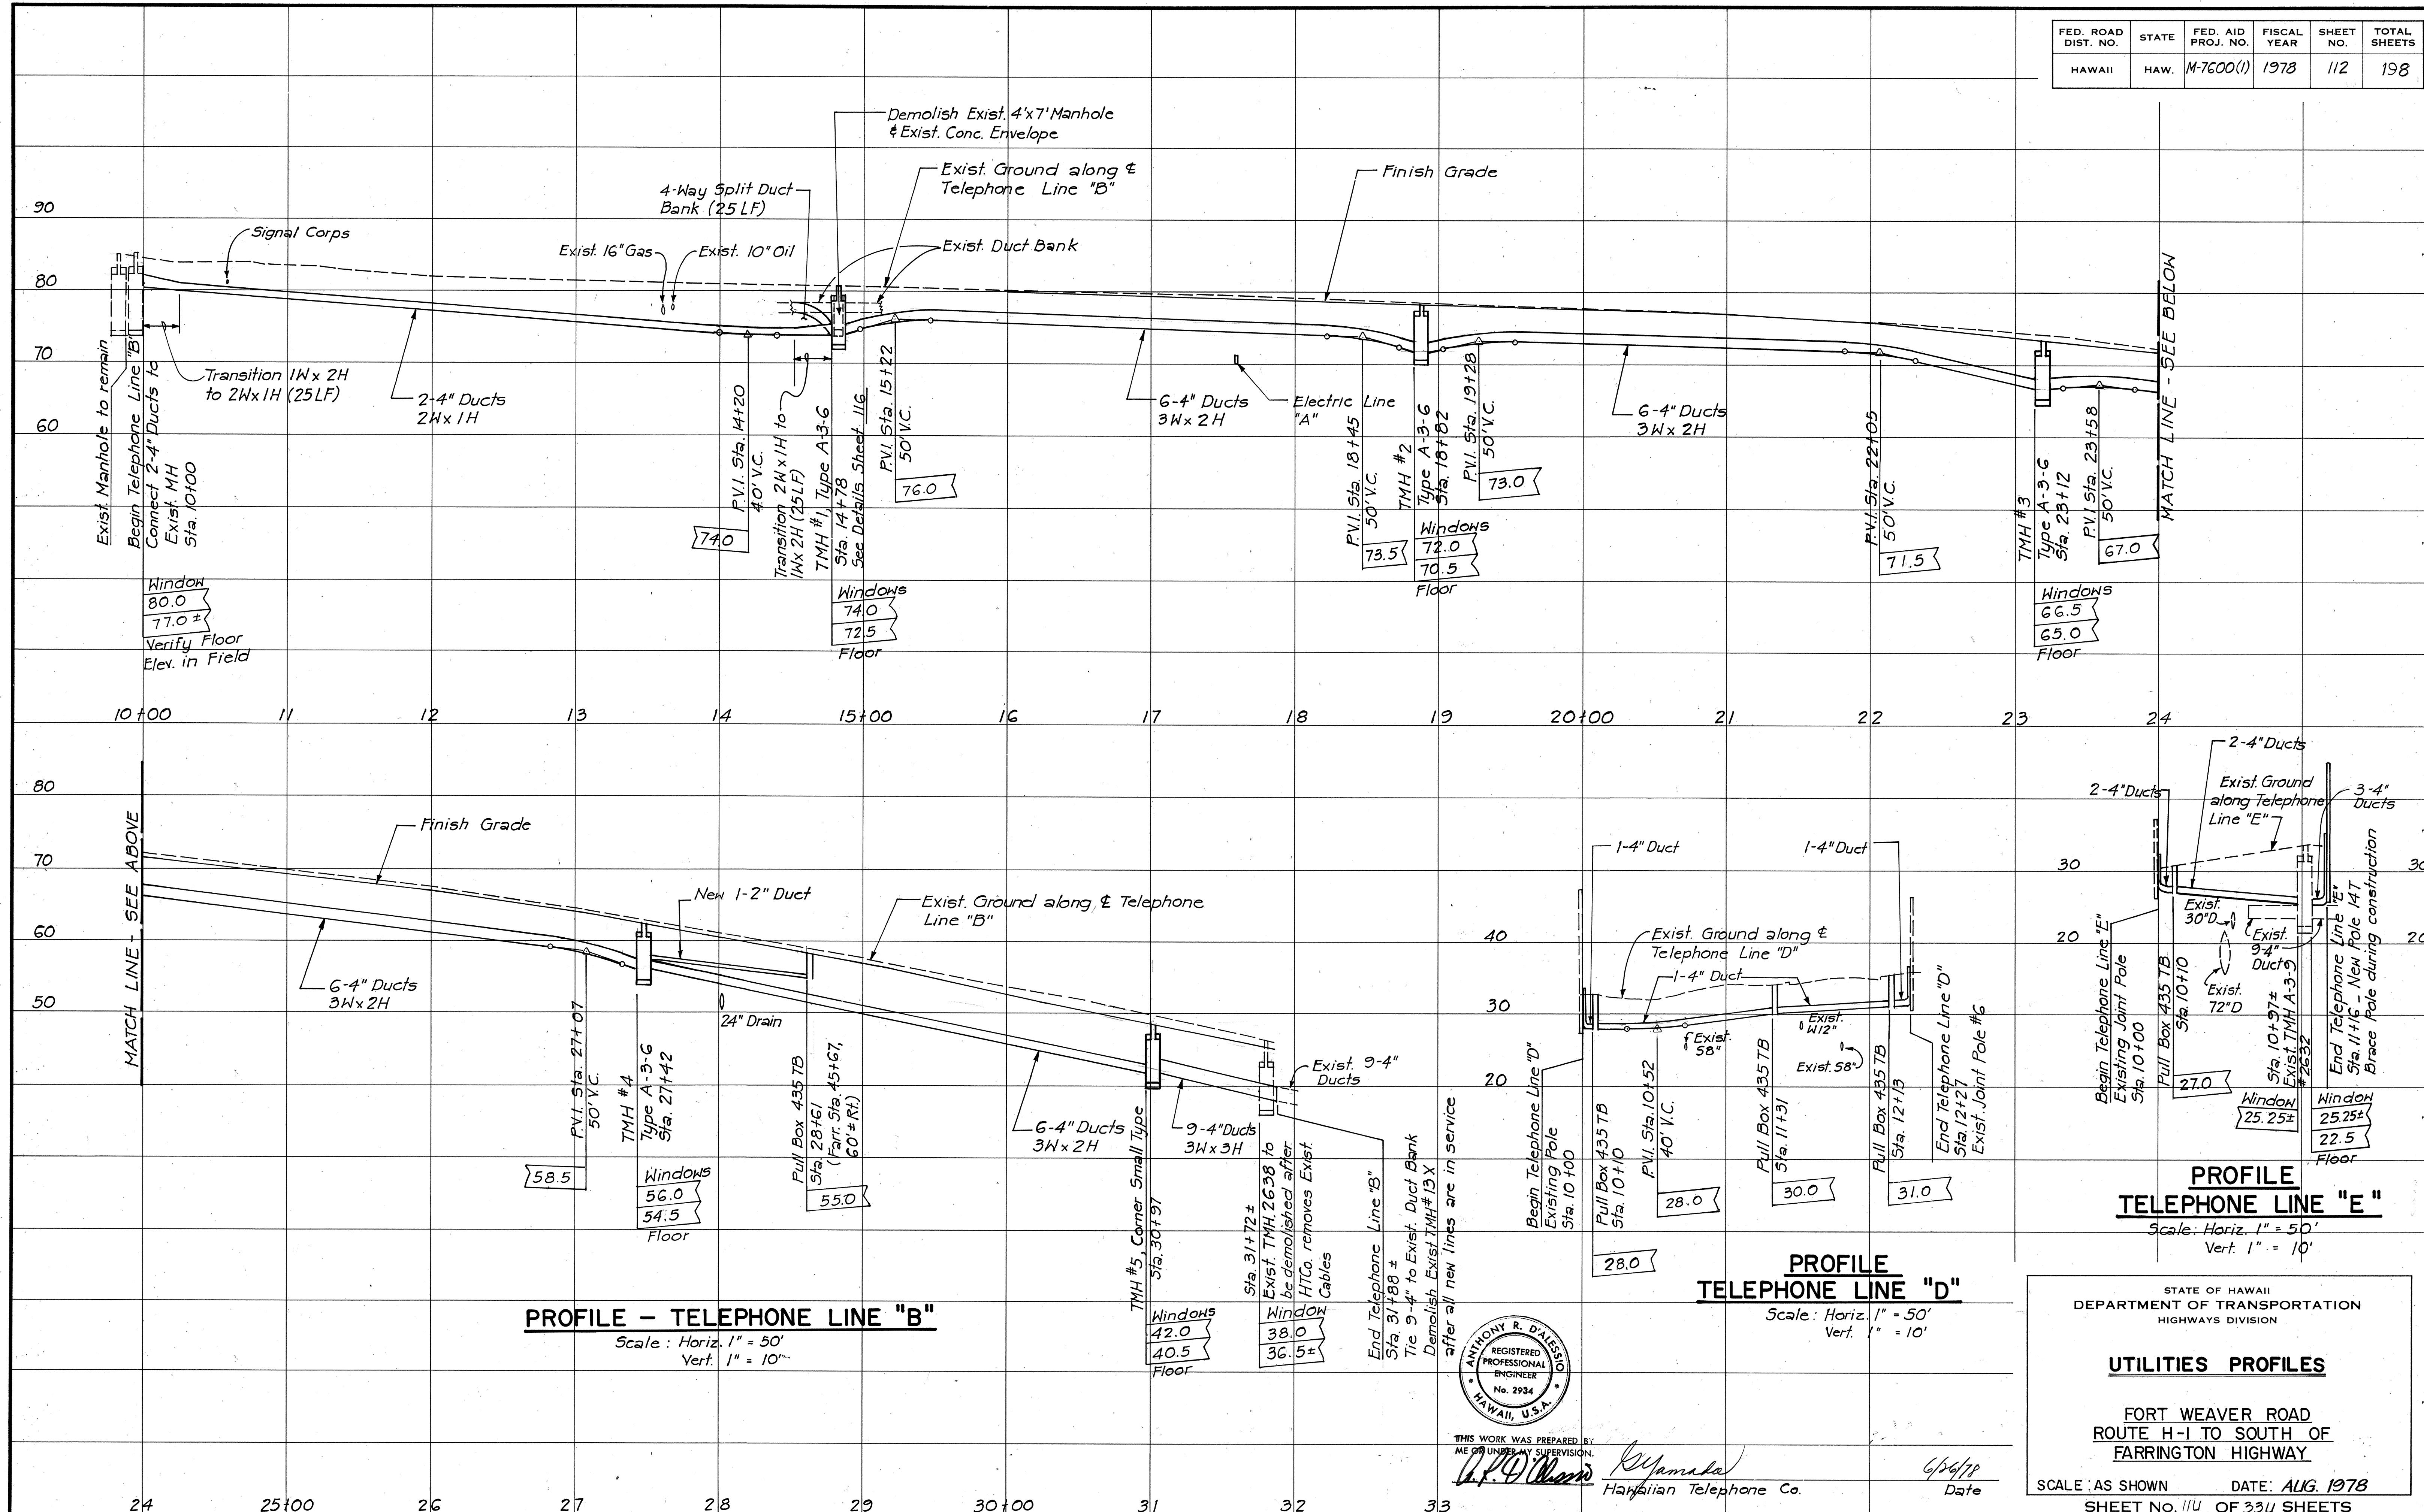


FED. ROAD DIST. NO.	STATE	FED. AID PROJ. NO.	FISCAL YEAR	SHEET NO.	TOTAL SHEETS
HAWAII	HAW.	M-7600(I)	1978	113	198

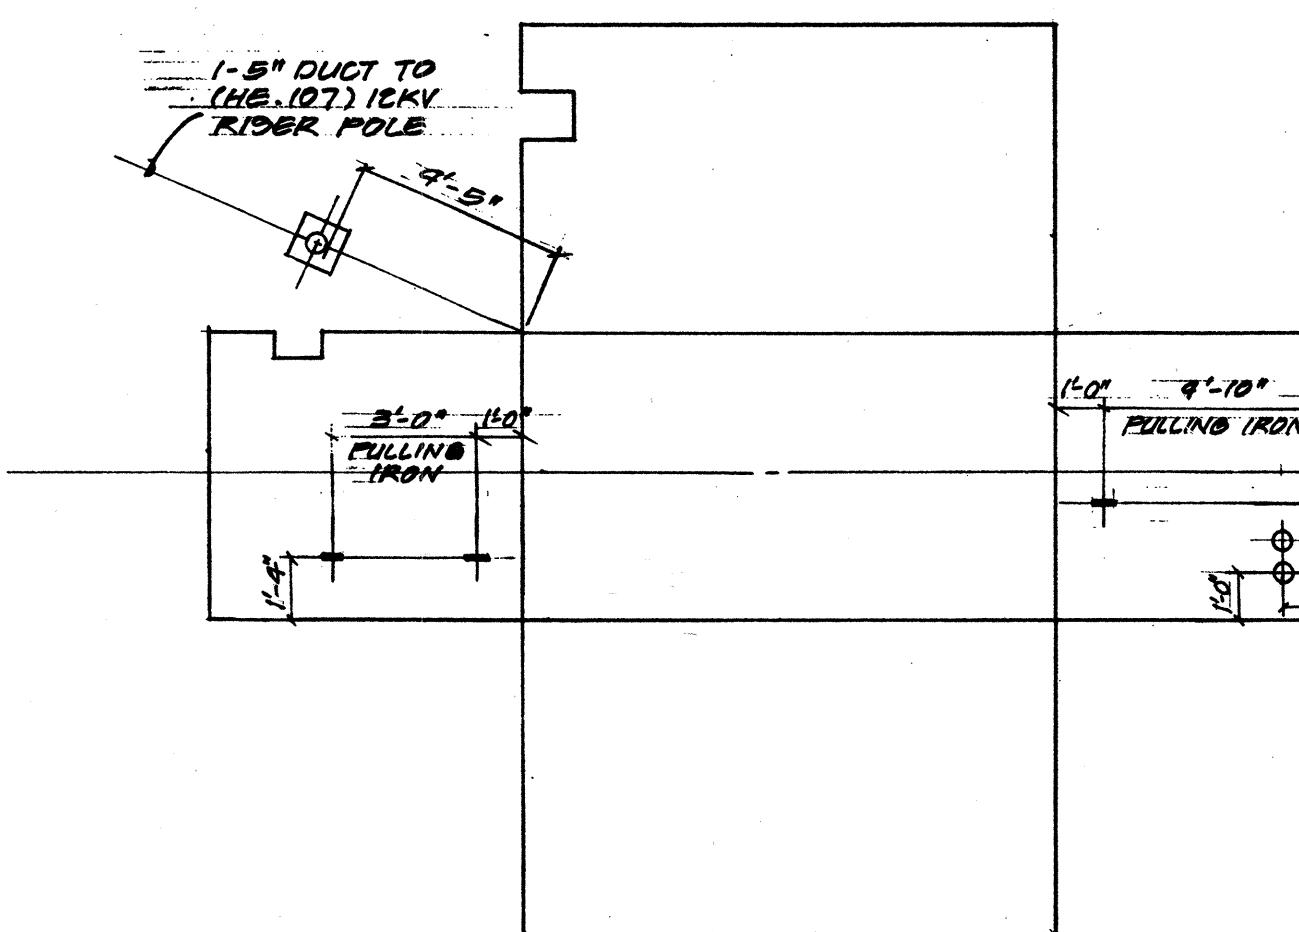


EMH. #806 (6'x11') TYPE 1
STA. 27+15 FARRINGTON HY. (O.B.)

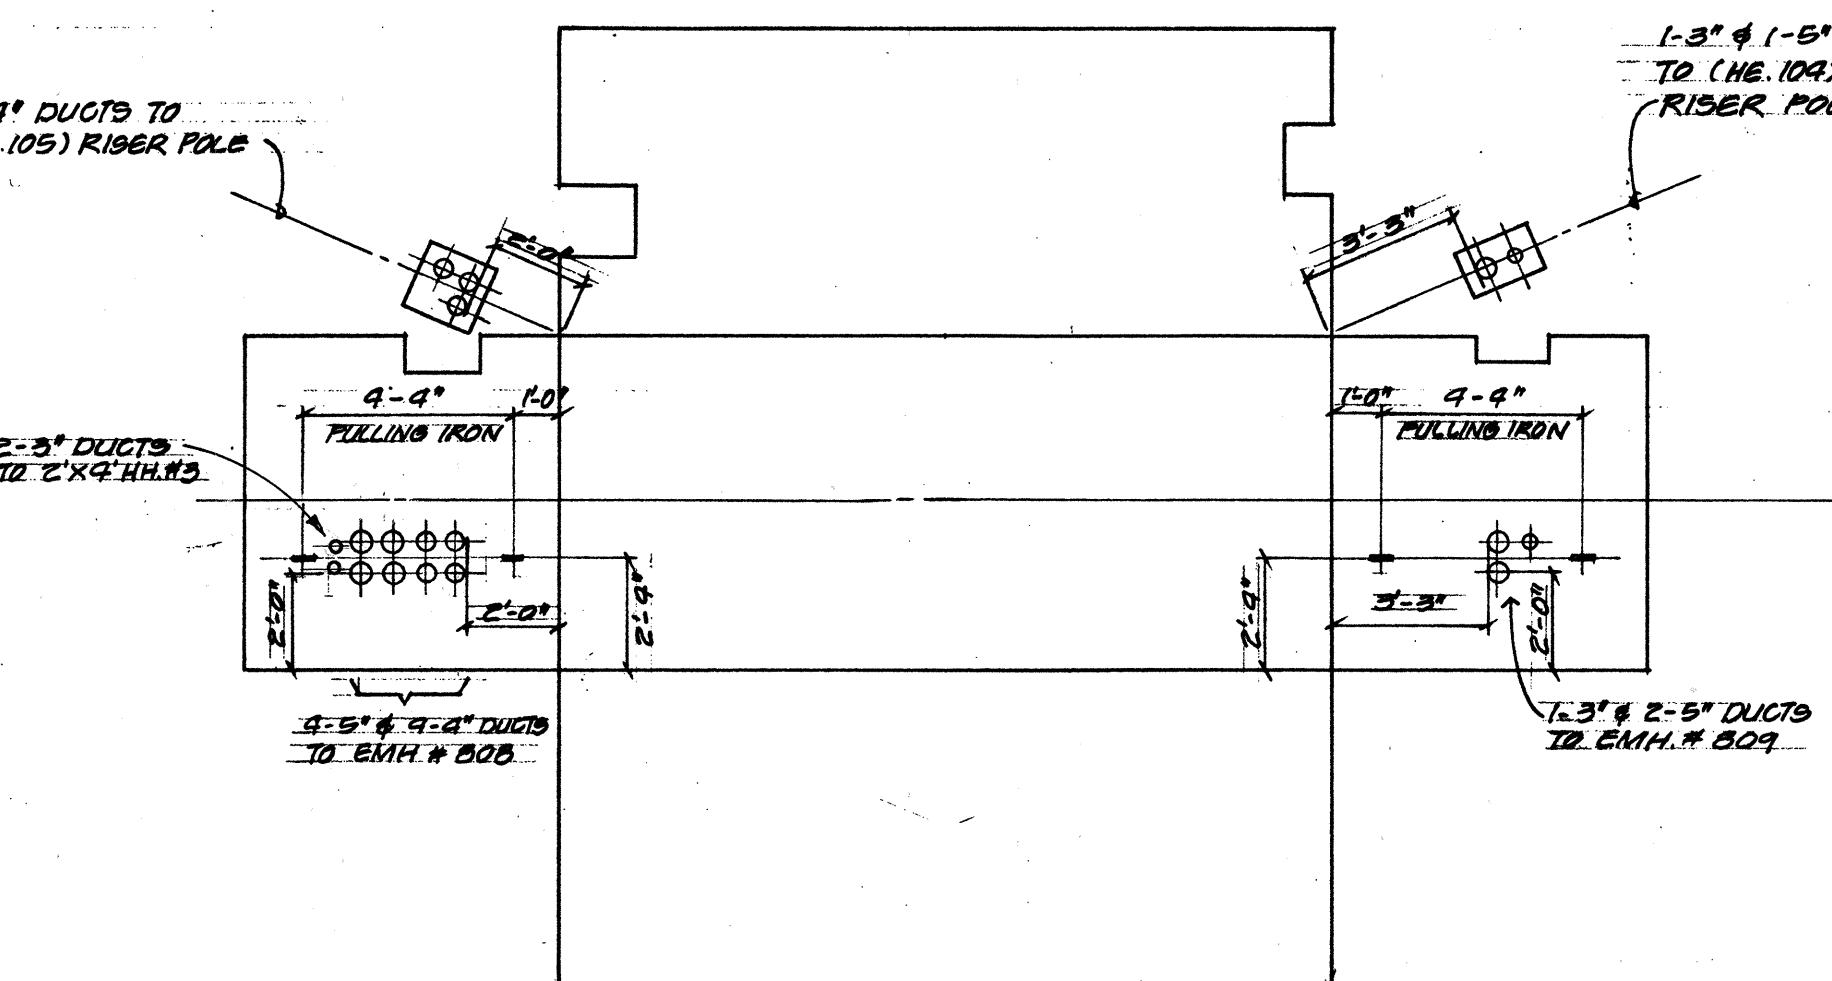


EMH. #808 (7'x10') TYPE 4
STA. 50+30 FARRINGTON HY.

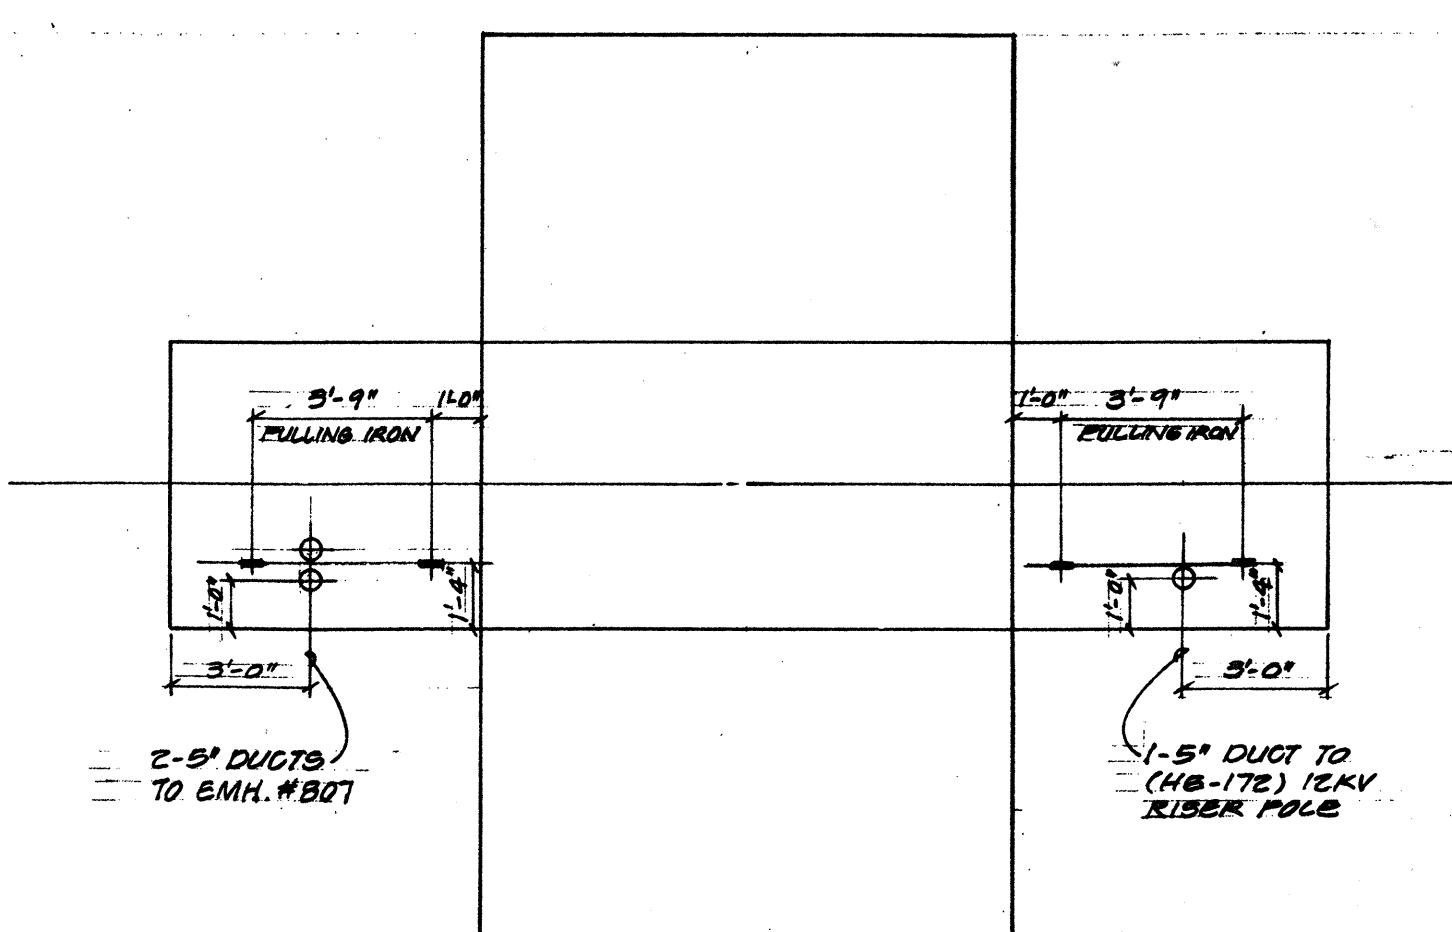

EHH. #A (6'x11') TYPE 611
STA. 22+94 RAMP "D"

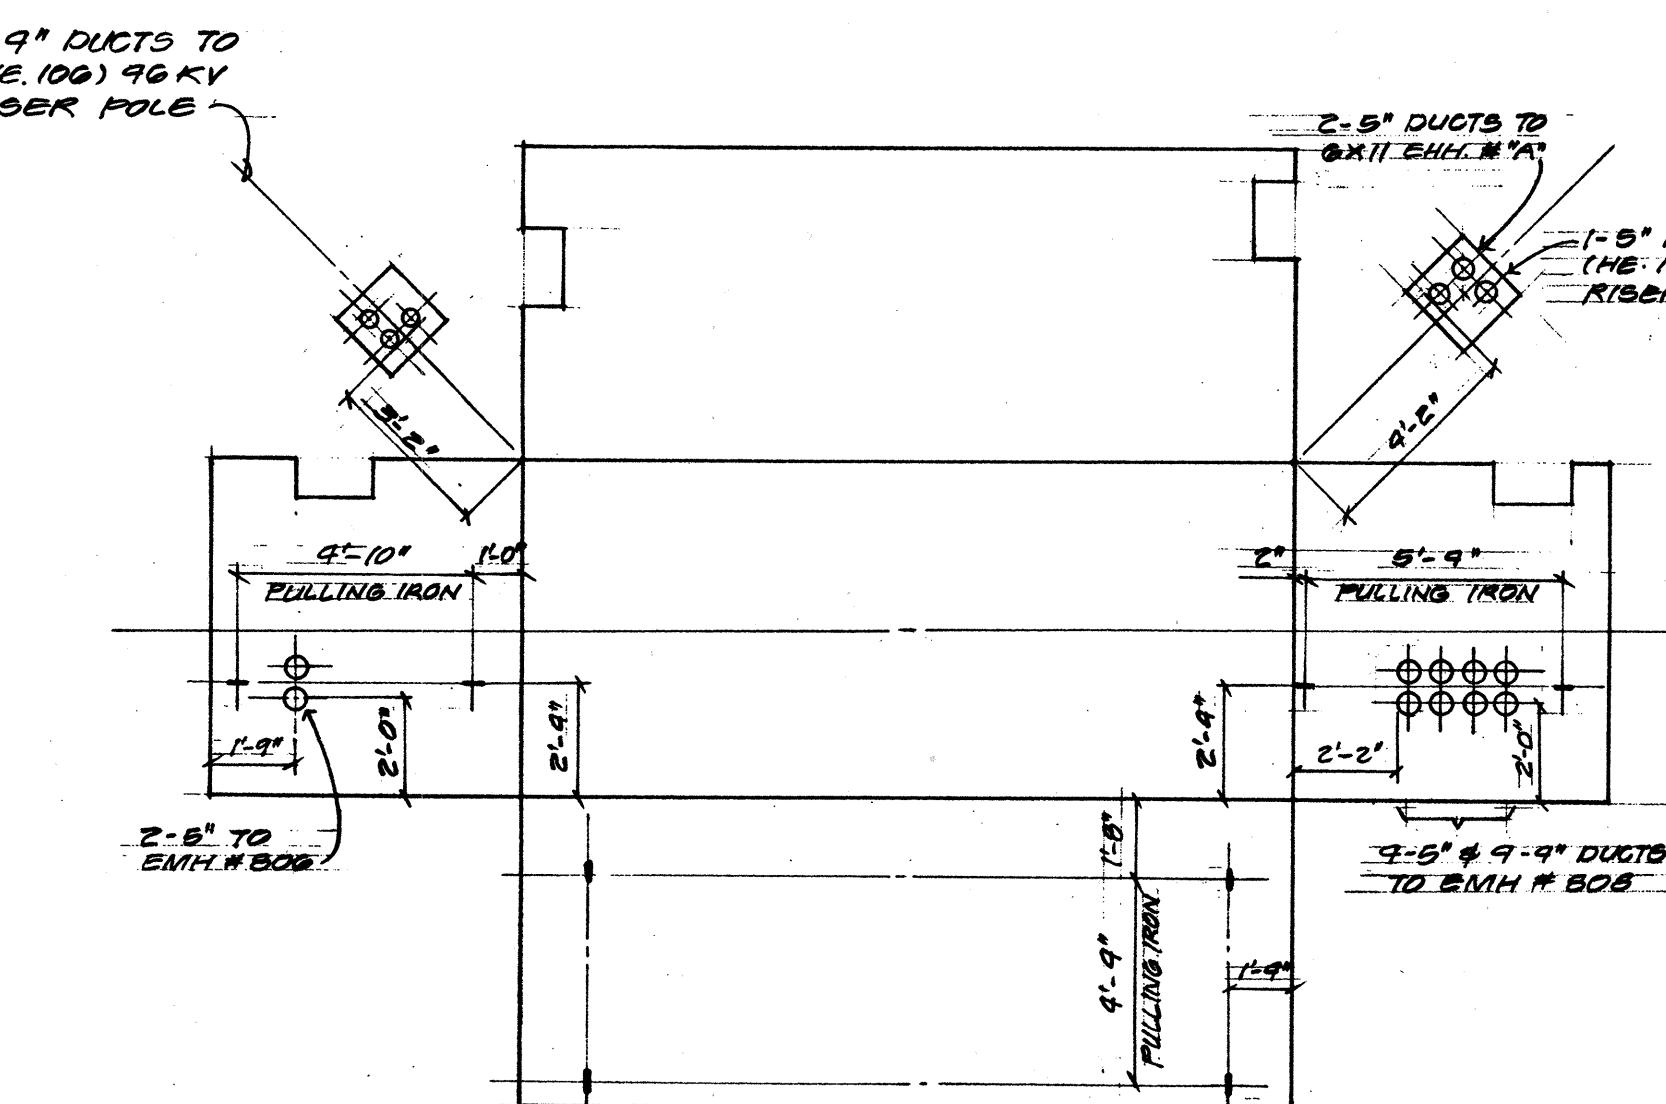

EMH. #807 (7'x10') TYPE 4
STA. 41+37 FARRINGTON HY. (I.B.)

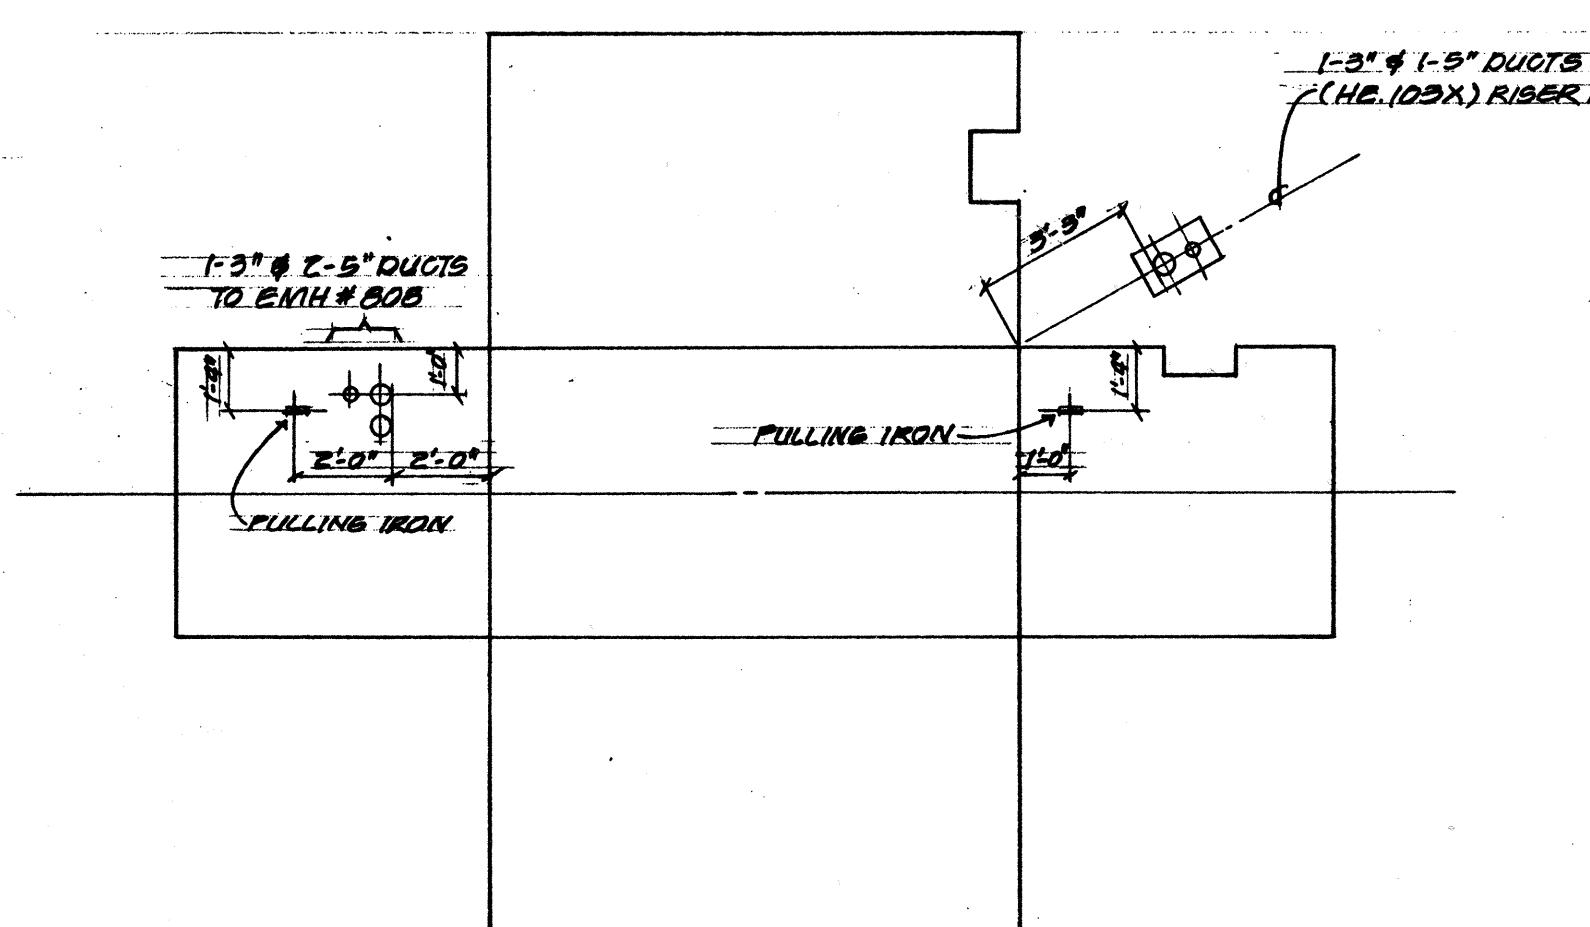

EMH. #809 (6'x11') TYPE 1
STA. 52+37 FARRINGTON HY.

APPROVED:

L. N. L. S. 12/15/78
Date
Hawaiian Electric Co., Inc.

STATE OF HAWAII
DEPARTMENT OF TRANSPORTATION
HIGHWAYS DIVISION

**MANHOLE WALL
ELEVATIONS - ELECTRIC**


FORT WEAVER ROAD
ROUTE H-1 TO SOUTH OF
FARRINGTON HIGHWAY

SCALE: N.T.S. DATE: AUG. 1978
SHEET No. / OF / SHEETS


FED. AID DIST. NO.	STATE	FED. AID PROJECT	FISCAL YEAR	SHEET NO.	TOTAL SHEETS
HAWAII	HAWAII	M-700(i)	1978	114-A	198

GENERAL NOTES


- Concrete to develop compressive cylinder strength of 3000 PSI in 28 days.
- CONCRETE FINISH:**
Top of Handhole - Woodfloated (sidewalk finish) according to Highways Division, State of Hawaii or Division of Engineering, City and County of Honolulu specifications whichever Agency has authority over the work.
Floor - Smooth metal trowelled.
Exposed Wall Surfaces, and Edges - Smooth and free from defects.
- CONCRETE POURING:**
Notify the Hawaiian Electric Co. Contracting & Inspection Div. 24 hours before pouring any concrete. All concrete pouring shall be done in the presence of an H.E. CO. Engineer or Inspector.
- REINFORCING:** Round deformed bars, new billet stock grade 40, ASTM A615. All hooked bars shall have ACI std. hook unless otherwise shown.
- FORMS:** Form handhole to size and shape as shown. Exterior face of handhole wall shall be formed except:
A) Excavation in solid material such as coral or rock, neat cut, no forms required.
B) Excavation in solid material other than coral or rock, lining such as salvaged corrugated iron, canec etc. may be used.
- PULLING IRONS:**
For location and number required, see duct entrance plan of project concerned.
- DRAINAGE:** Slope floor down $\frac{1}{2}$ " to sump.
- For slope of top of handhole, see plan of project concerned.
- FINISH STEEL WORK:**
Channel Iron frames for removable concrete slabs and pulling irons shall be HOT DIP GALVANIZED AFTER FABRICATION.
- EXCAVATION:**
Excavate for handhole to accurate alignment, grades and dimensions as shown on drawing. All excavation must be approved by the Engineering Department, the Hawaiian Electric Co., Inc., before any concrete is poured. All excess cut shall be backfilled with concrete or rock.
- BACKFILL:** Remove all debris before backfilling. Backfill in accordance with latest specifications of and subject to approval of Highways Division State of Hawaii or Division of Engineering, City and County of Honolulu whichever Agency has authority over the work.
- For duct line construction standards see H.E.CO. Dwg. I8585 & 20191 and specification sheets CS 7001-O.
- DUCTS:** For number, size, and exact location of duct entrances, refer to project drawings.
- ALL MATERIALS SHALL BE NEW AND SHALL BE MANUFACTURED IN THE UNITED STATES OF AMERICA.**

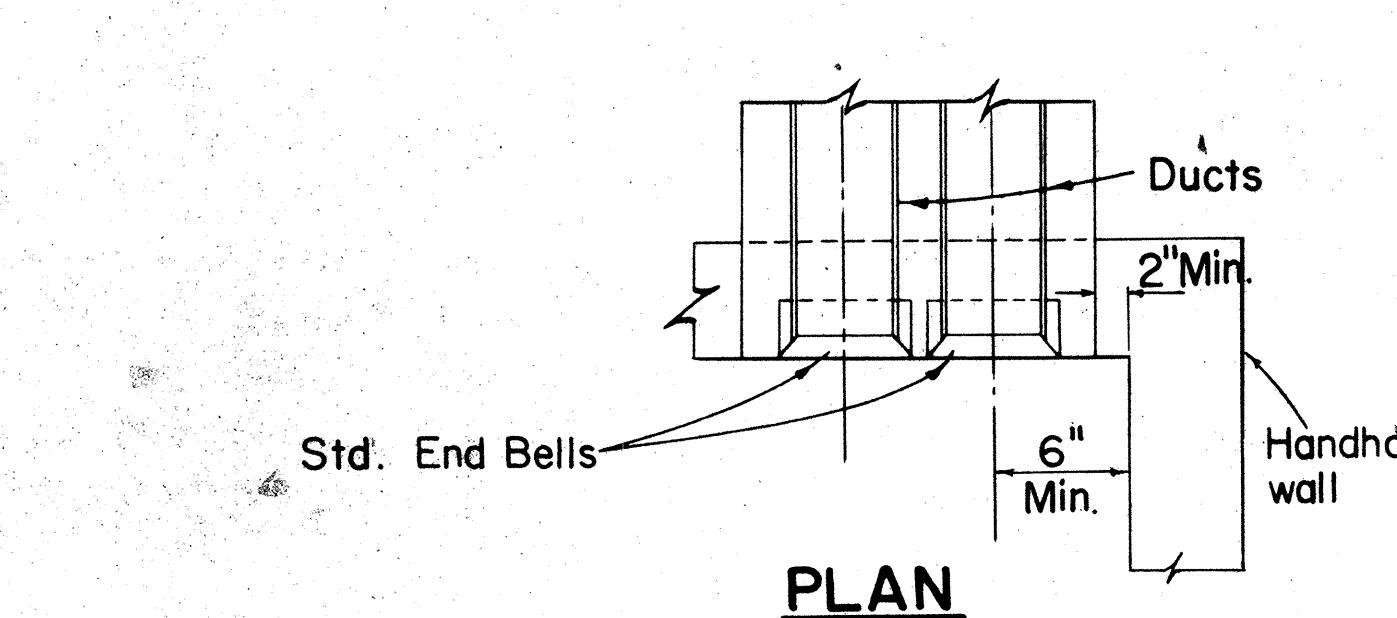


PLAN

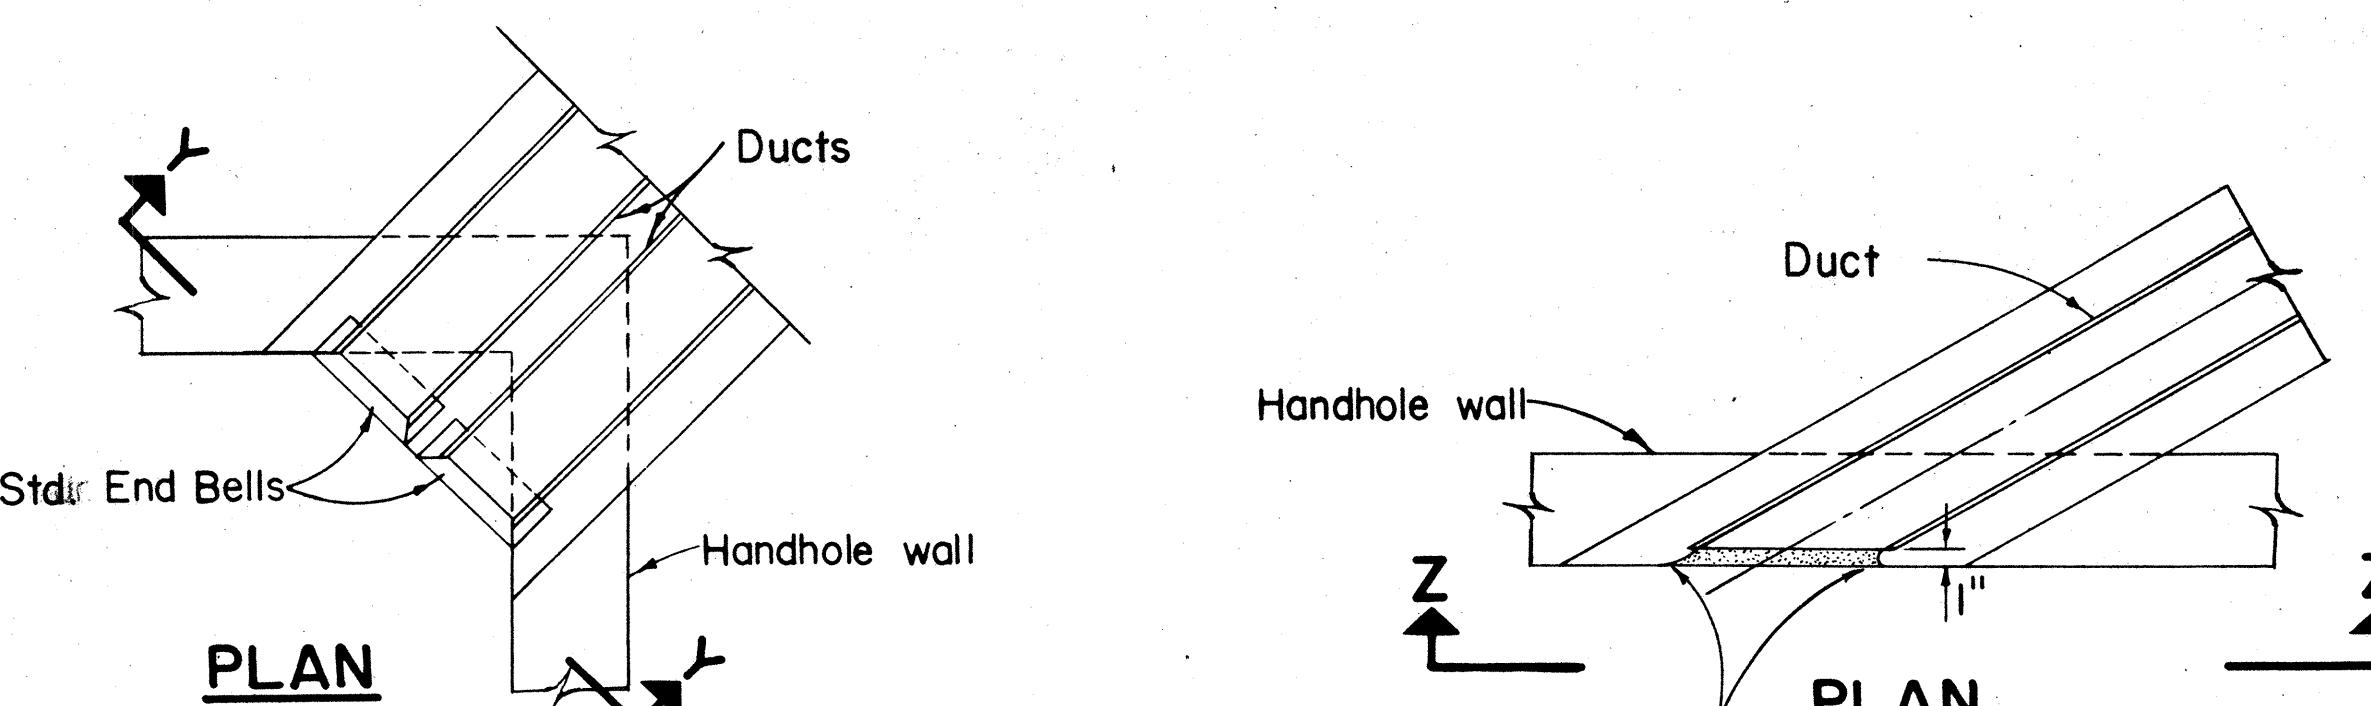

PLAN

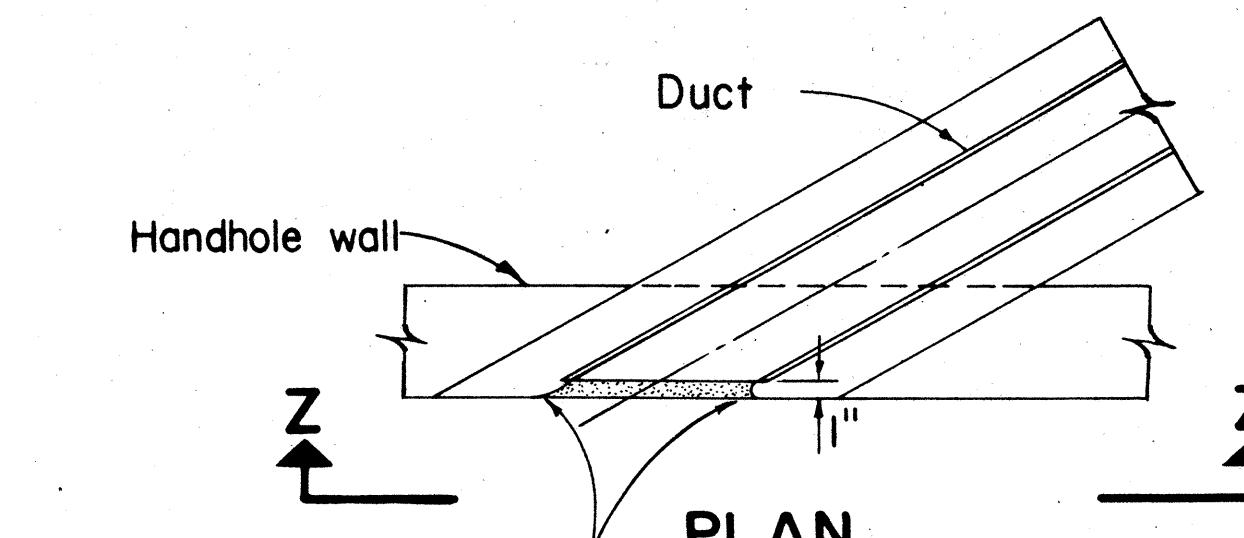

PLAN

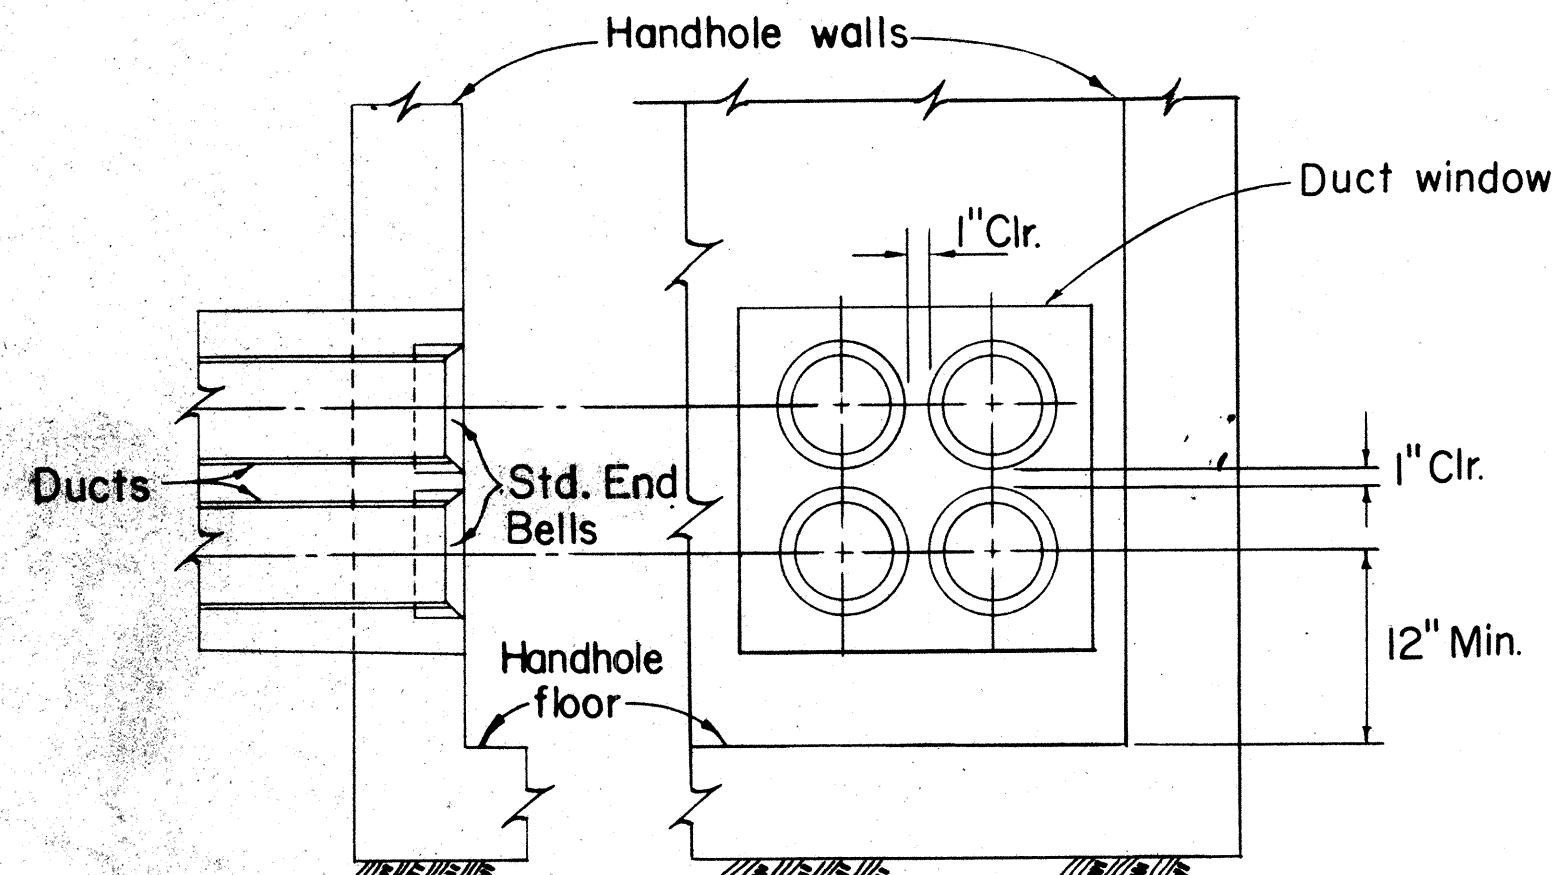


SIDE ELEV.

FRONT ELEV.

END & SIDE ENTRANCES


(FOUR WAY DUCT)

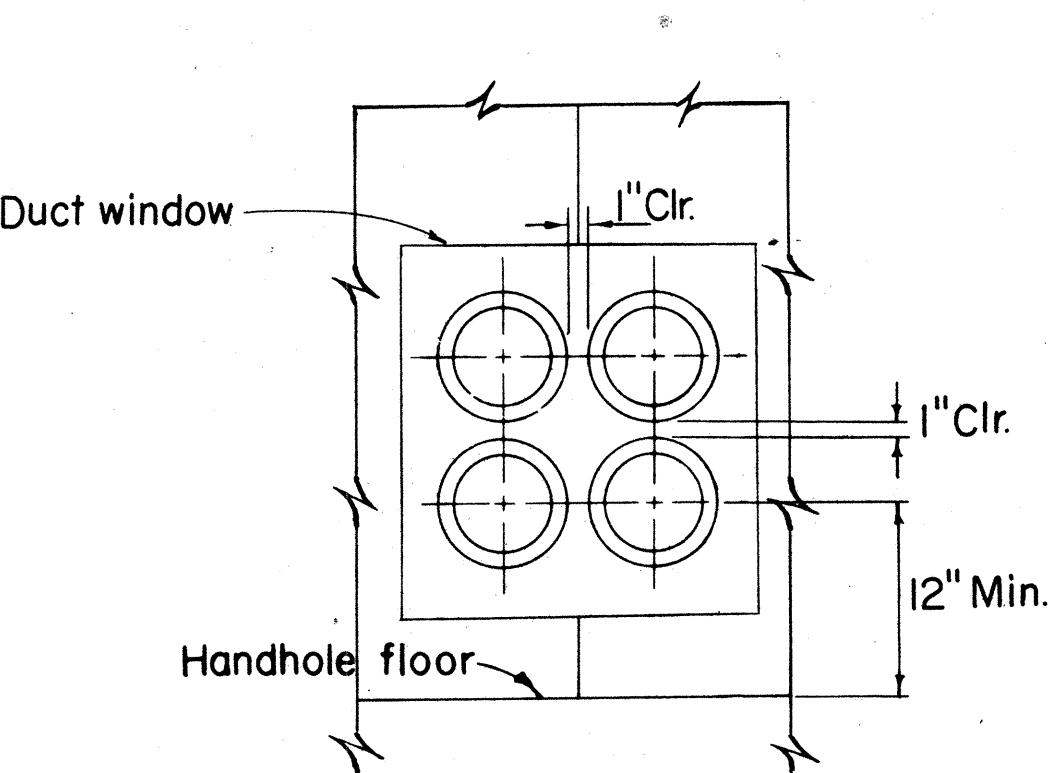

ELEV. Y-Y

CORNER ENTRANCE

(FOUR WAY DUCT)

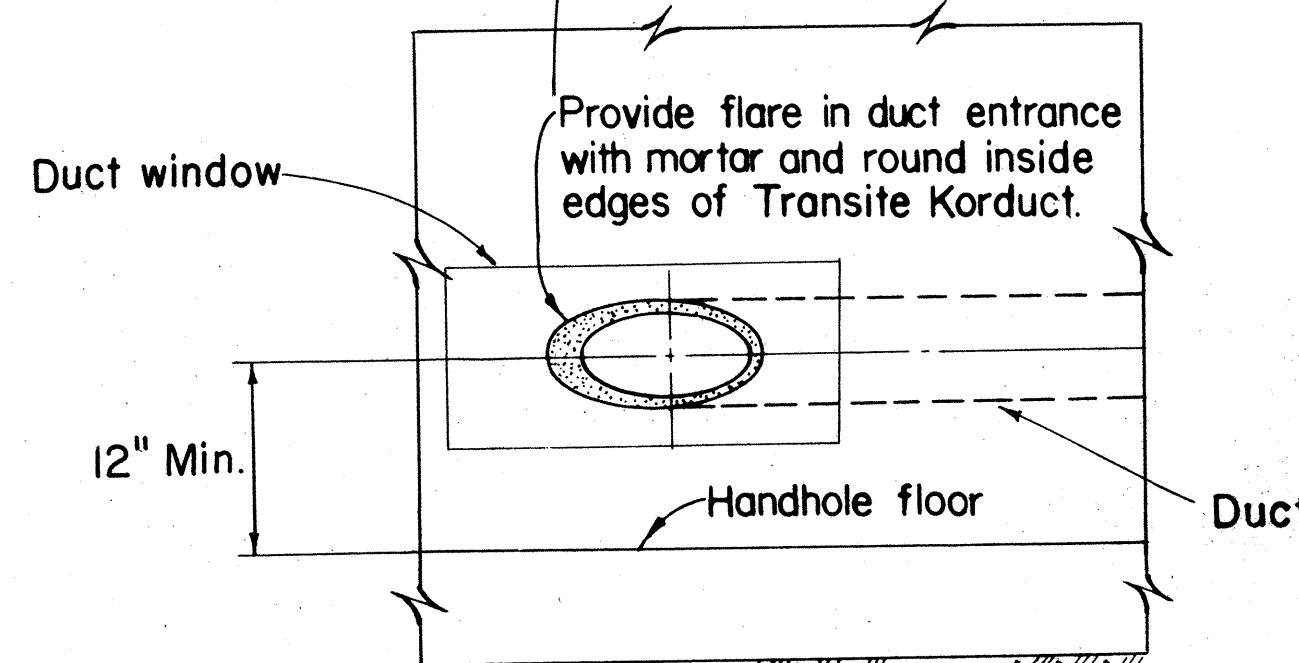


ELEV. Z-Z

DIAGONAL ENTRANCE

(ONE WAY DUCT)

TYPICAL DUCT LINE ENTRANCE DETAILS


NOT TO SCALE

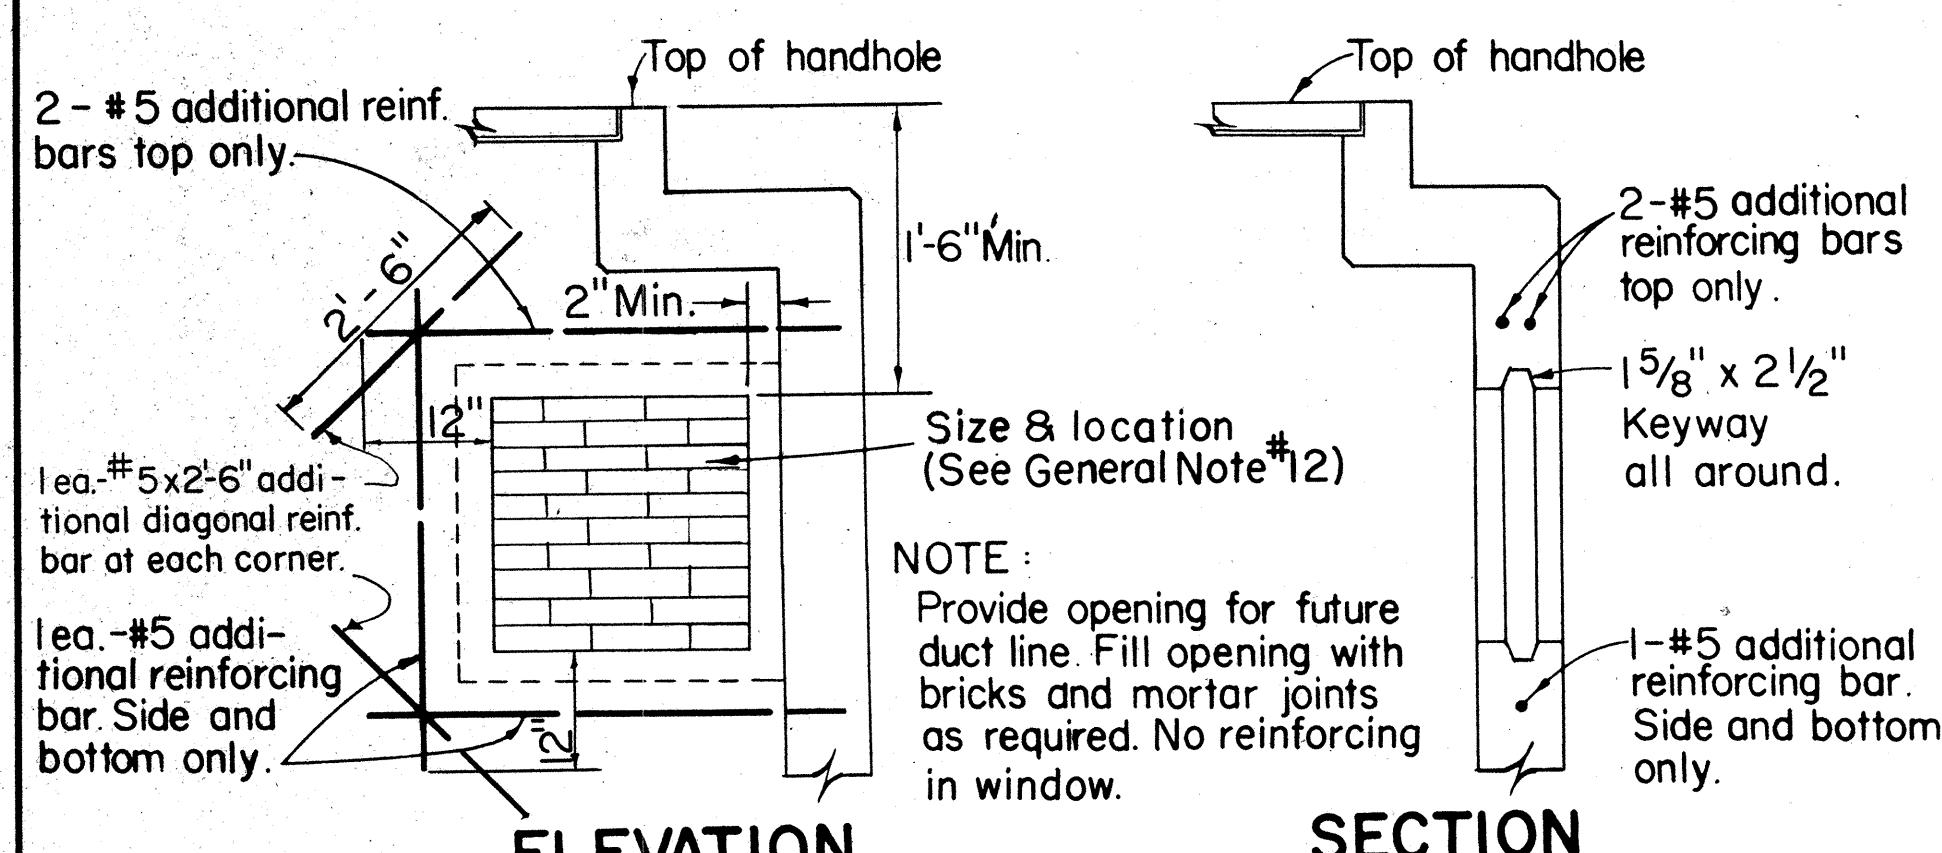

ELEVATION

SECTION

KNOCKOUT FOR FUTURE DUCT LINE

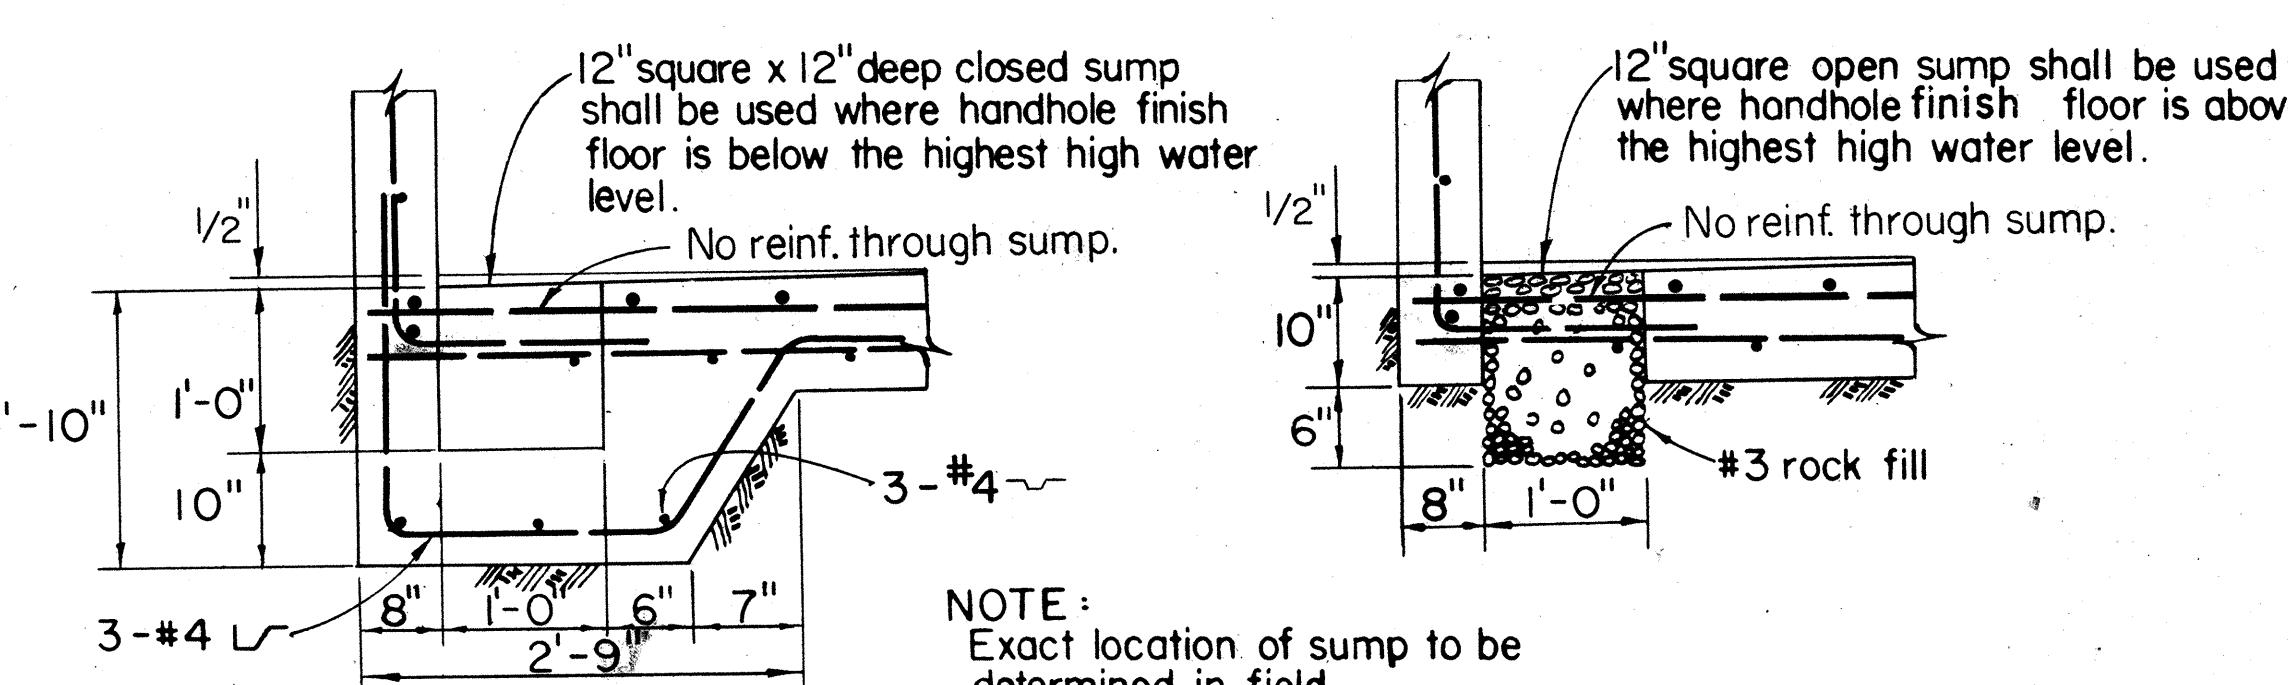

SECTION ELEV.


CLOSED SUMP

NOT TO SCALE

SECTION ELEV.

OPEN SUMP

NOT TO SCALE

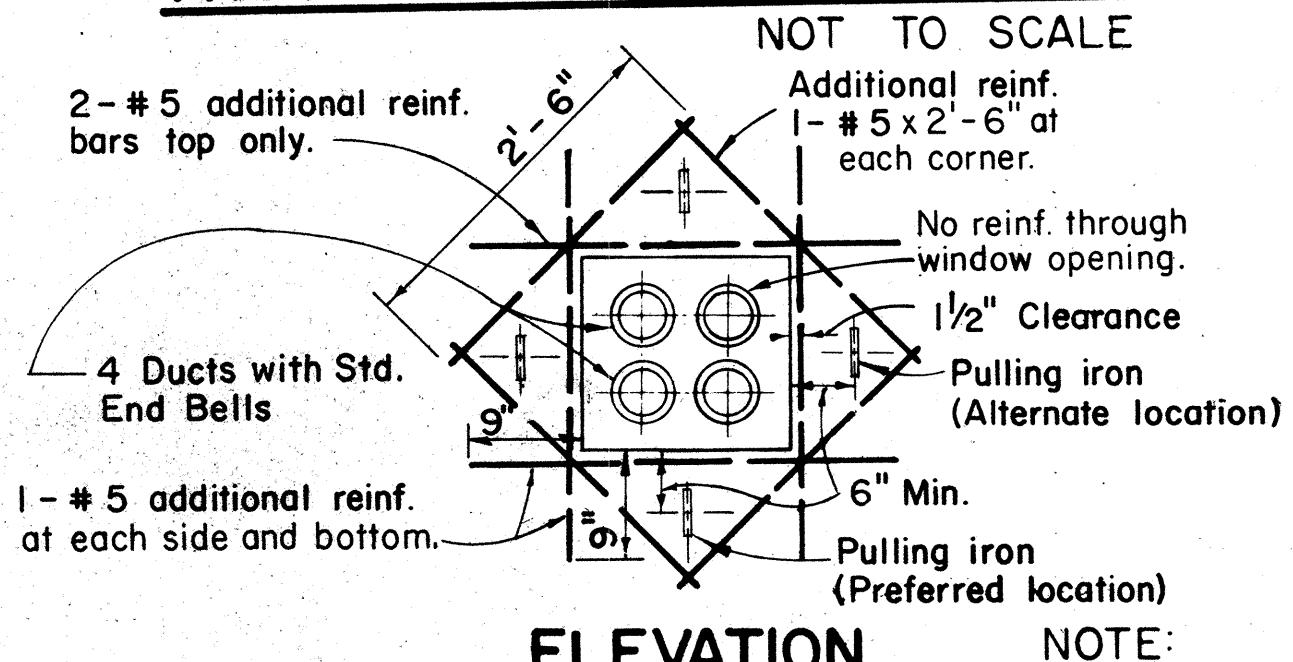


ELEVATION

TYPICAL DETAIL

AT DUCT WINDOW

NOT TO SCALE

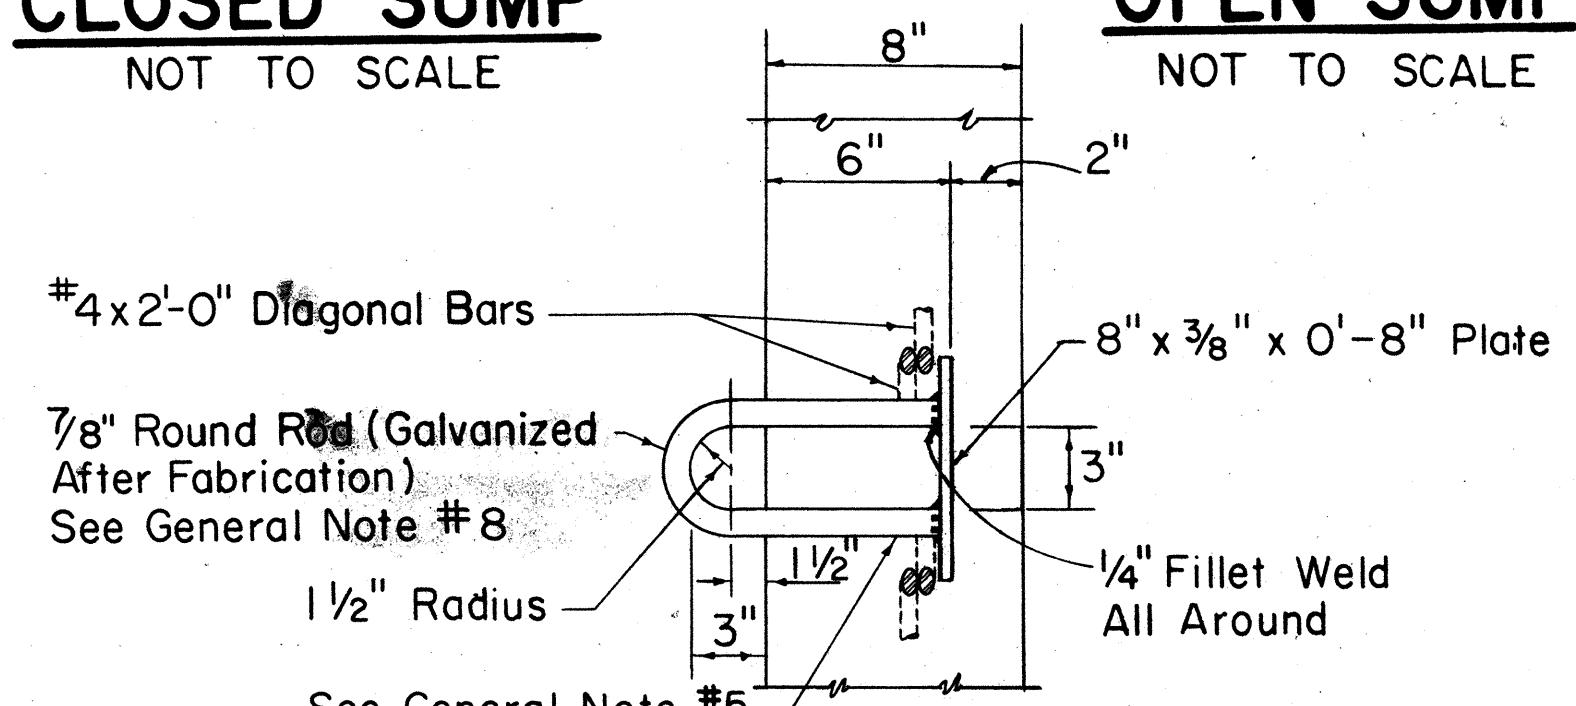

SECTION ELEV.

PULLING IRON

NOT TO SCALE

FOR USE IN AREAS SUBJECT
TO LIGHT VEHICULAR TRAFFIC

APPROVED:

W. C. L. S.

12/15/78

DATE

12/15/78

DATE

DATE

18849-A SHEET No. 2
OF 2 SHEETS

STATE OF HAWAII
DEPARTMENT OF TRANSPORTATION
LAND TRANSPORTATION FACILITIES DIVISION

STANDARD DETAILS





HANDHOLE TYPE 611V
(6'-0" x 11'-0")

UNDERGROUND STANDARDS


Scales: As Noted Date

SHEET NO. OF SHEETS

FED. ROAD DIST. NO.	STATE	FED. AID PROJ. NO.	FISCAL YEAR	SHEET NO.	TOTAL SHEETS
HAWAII	HAW.	M-7600(1)	1978	115	198

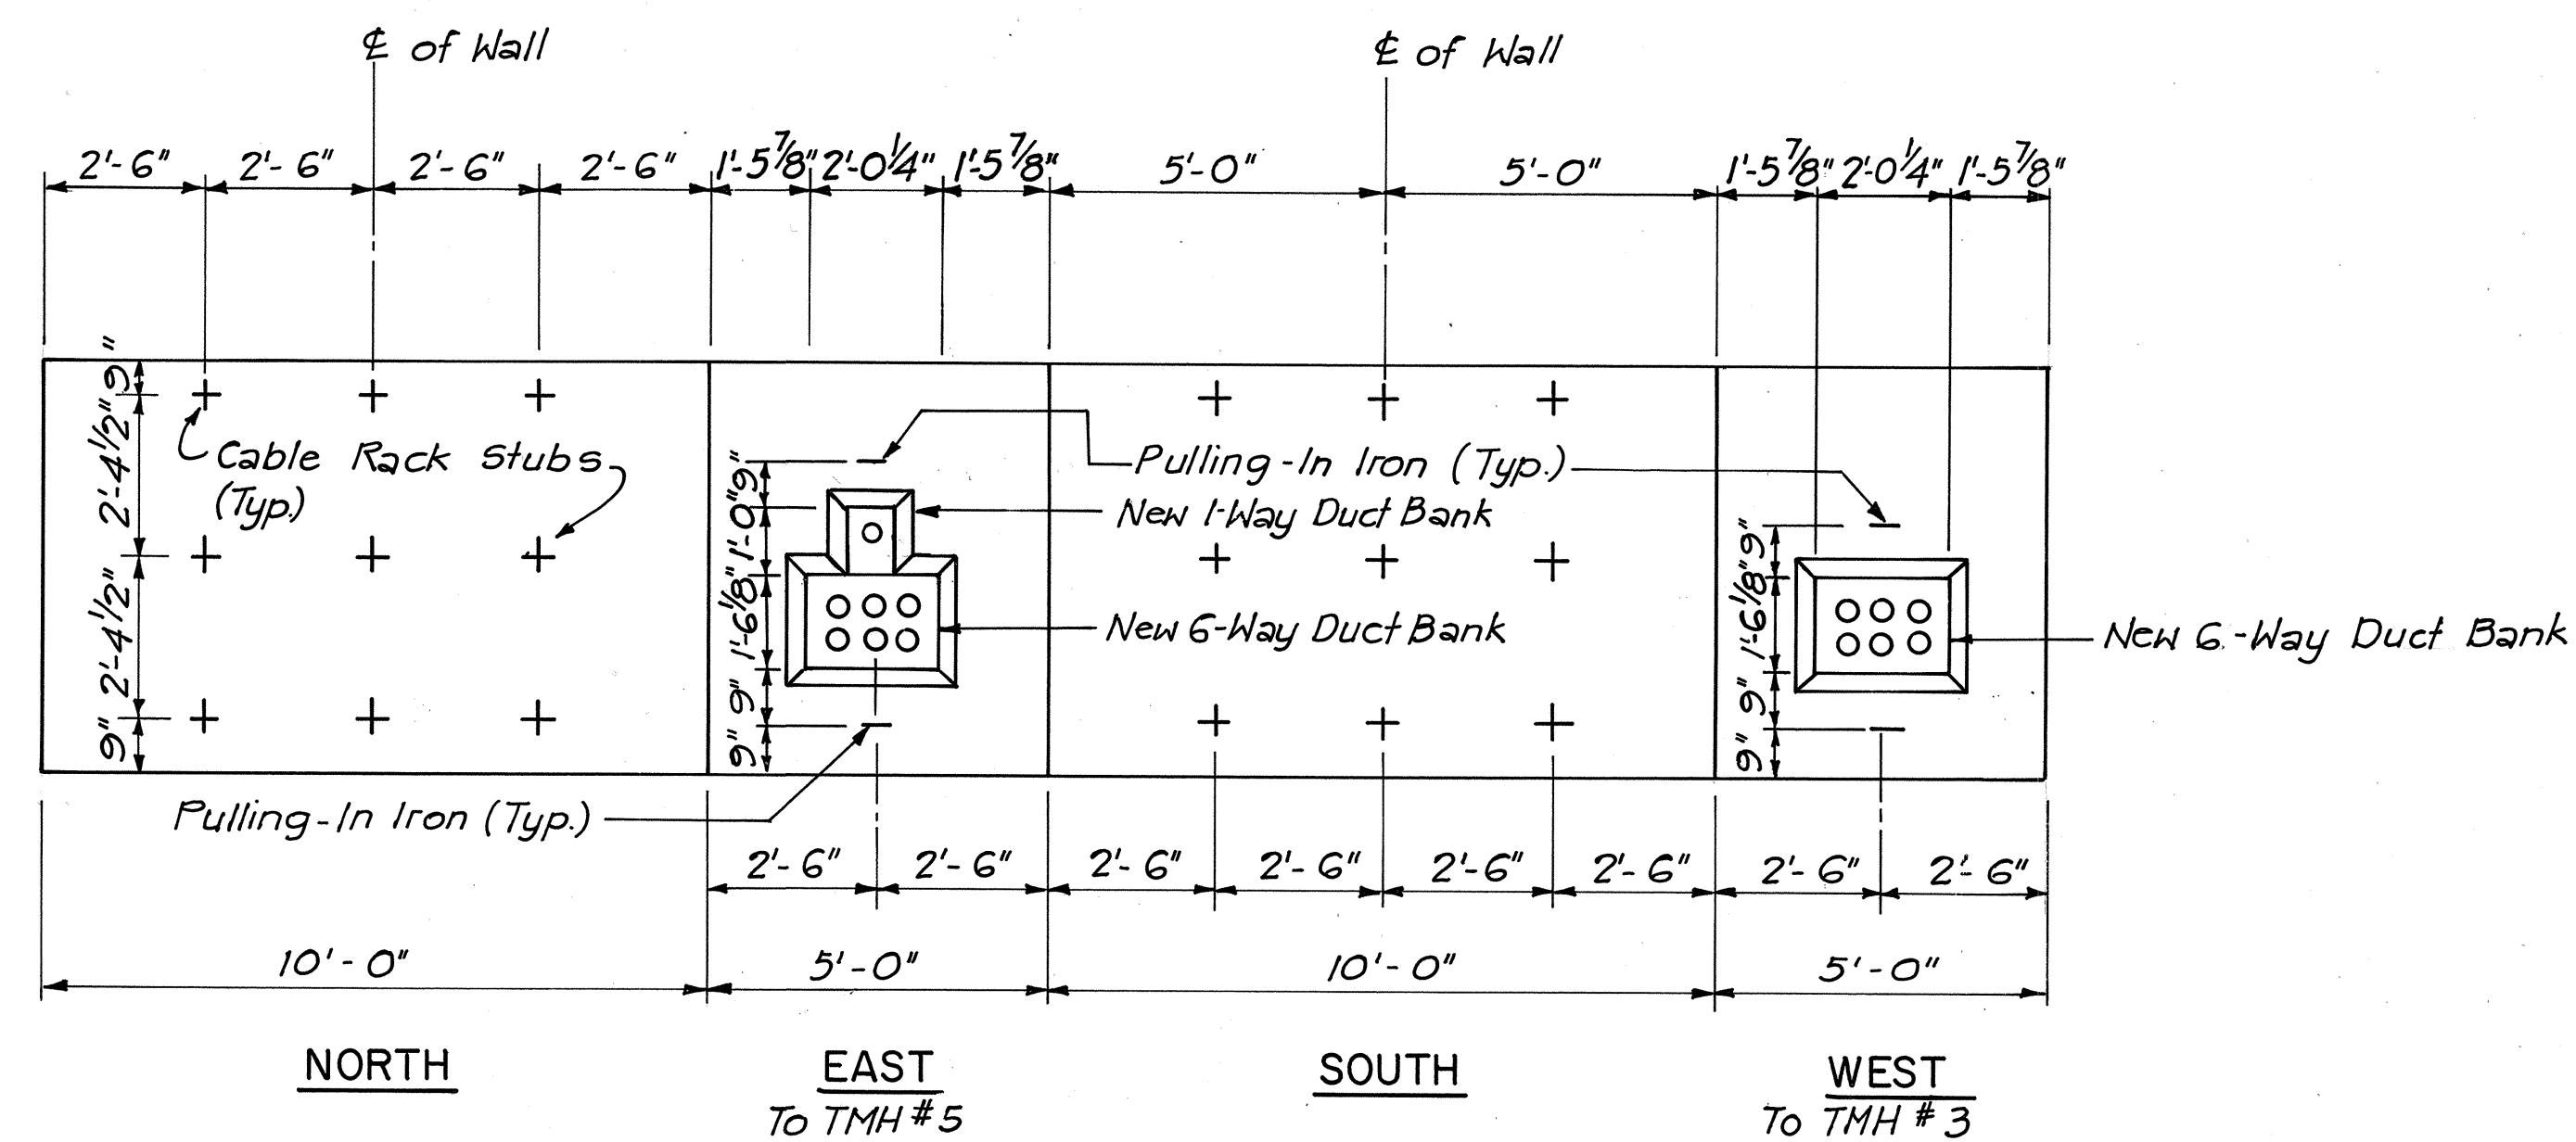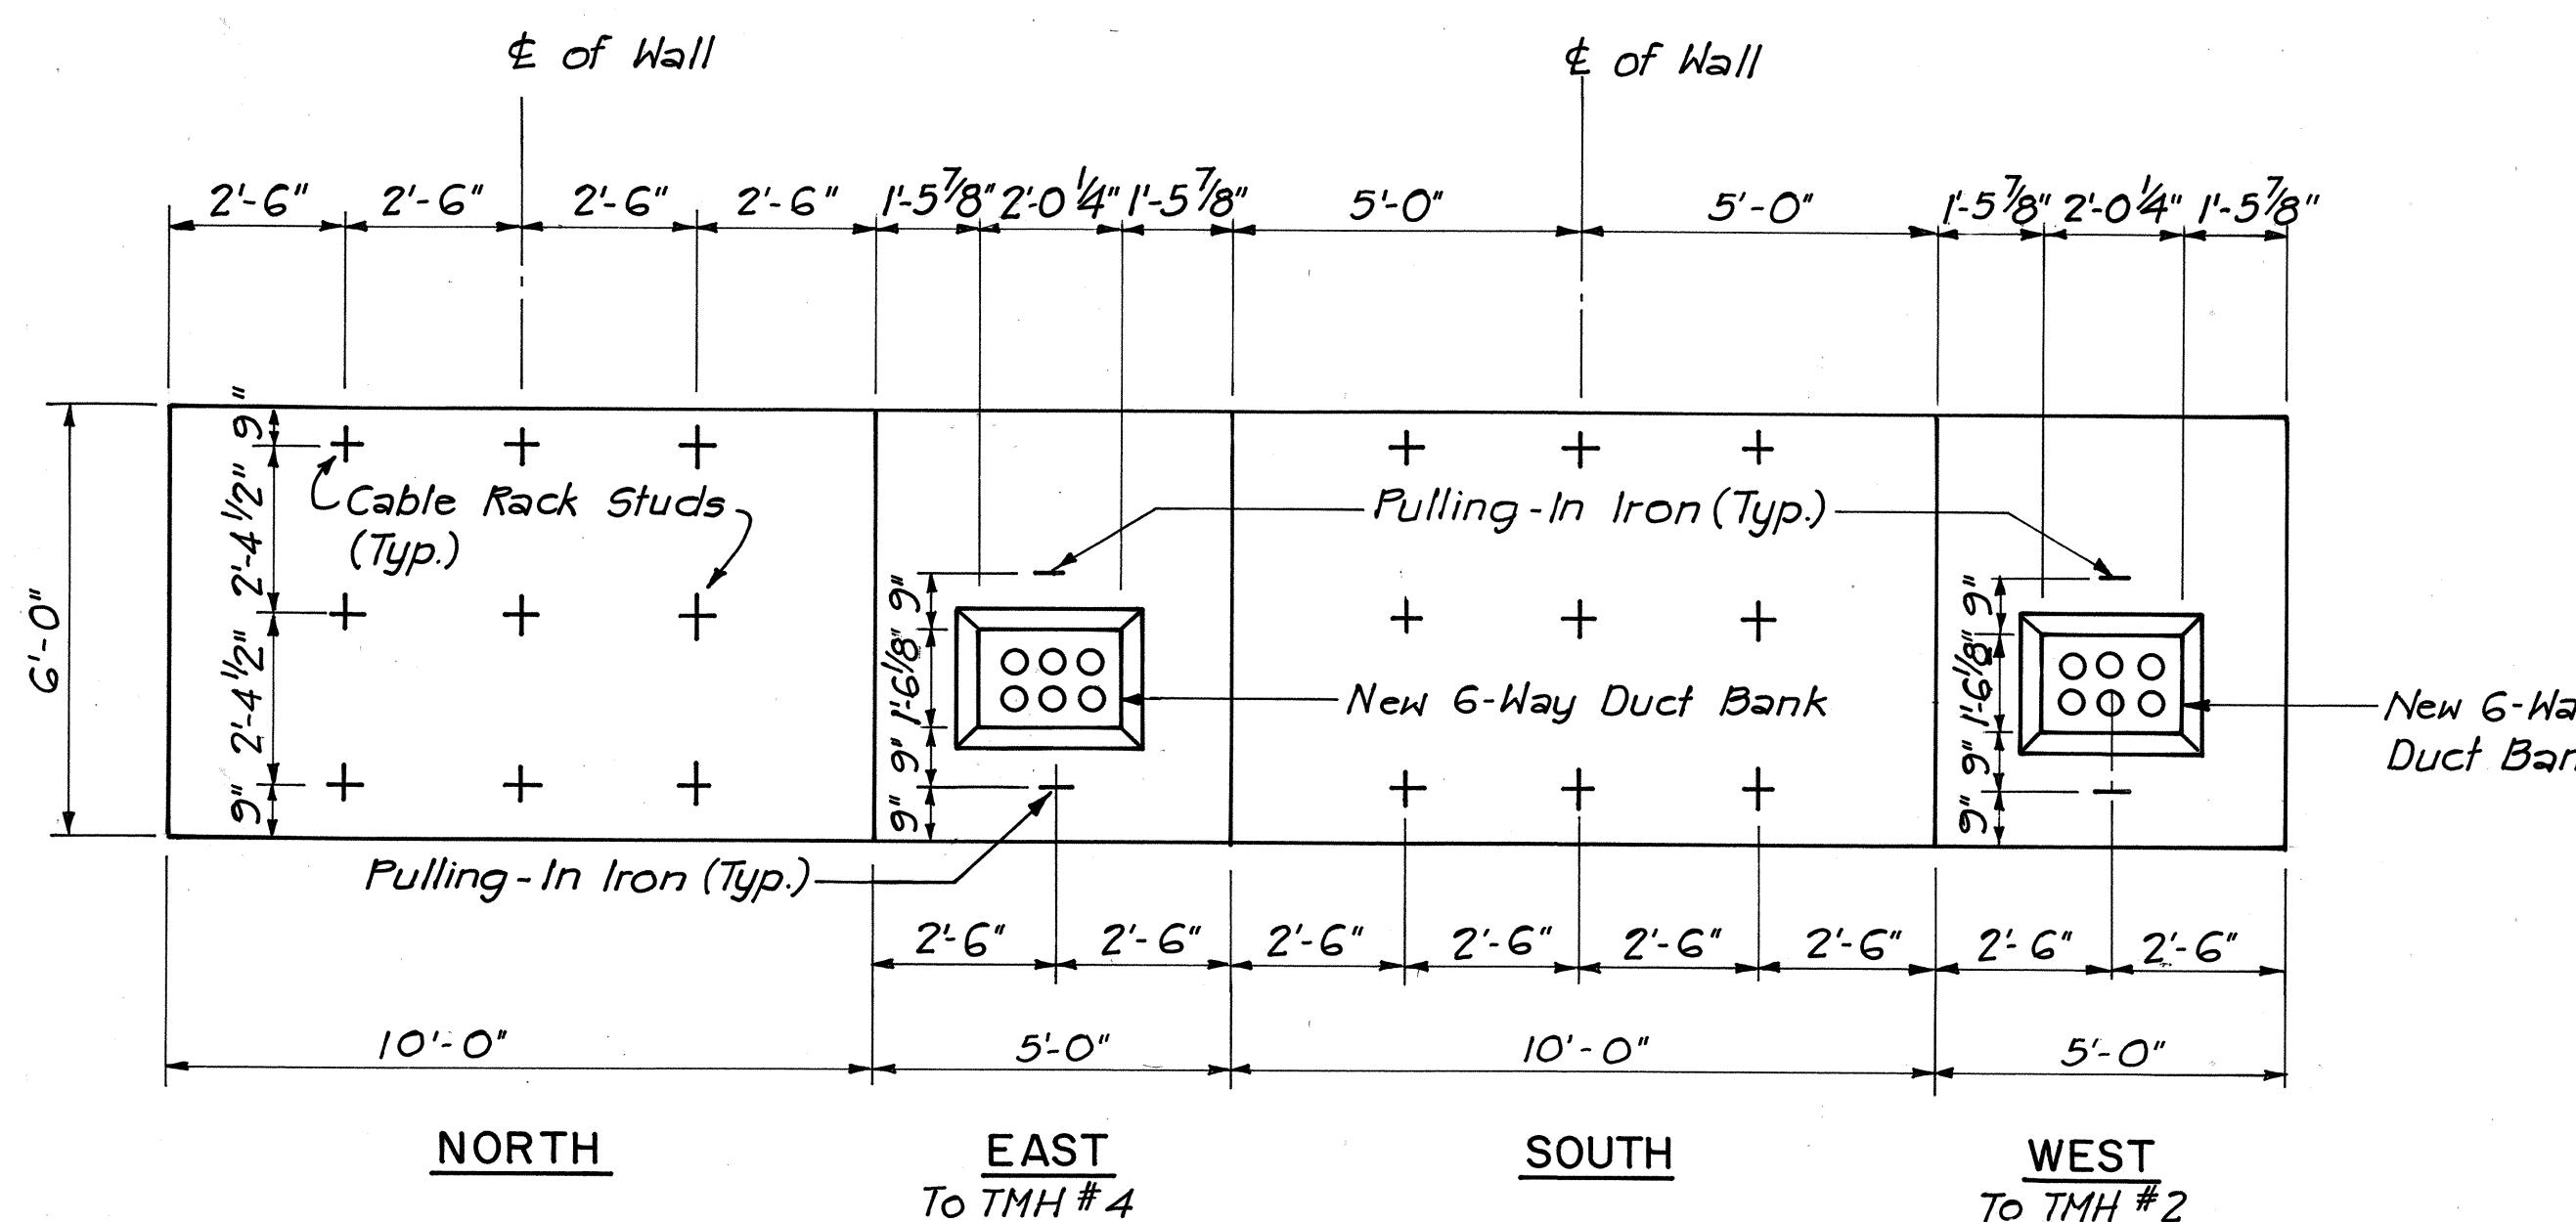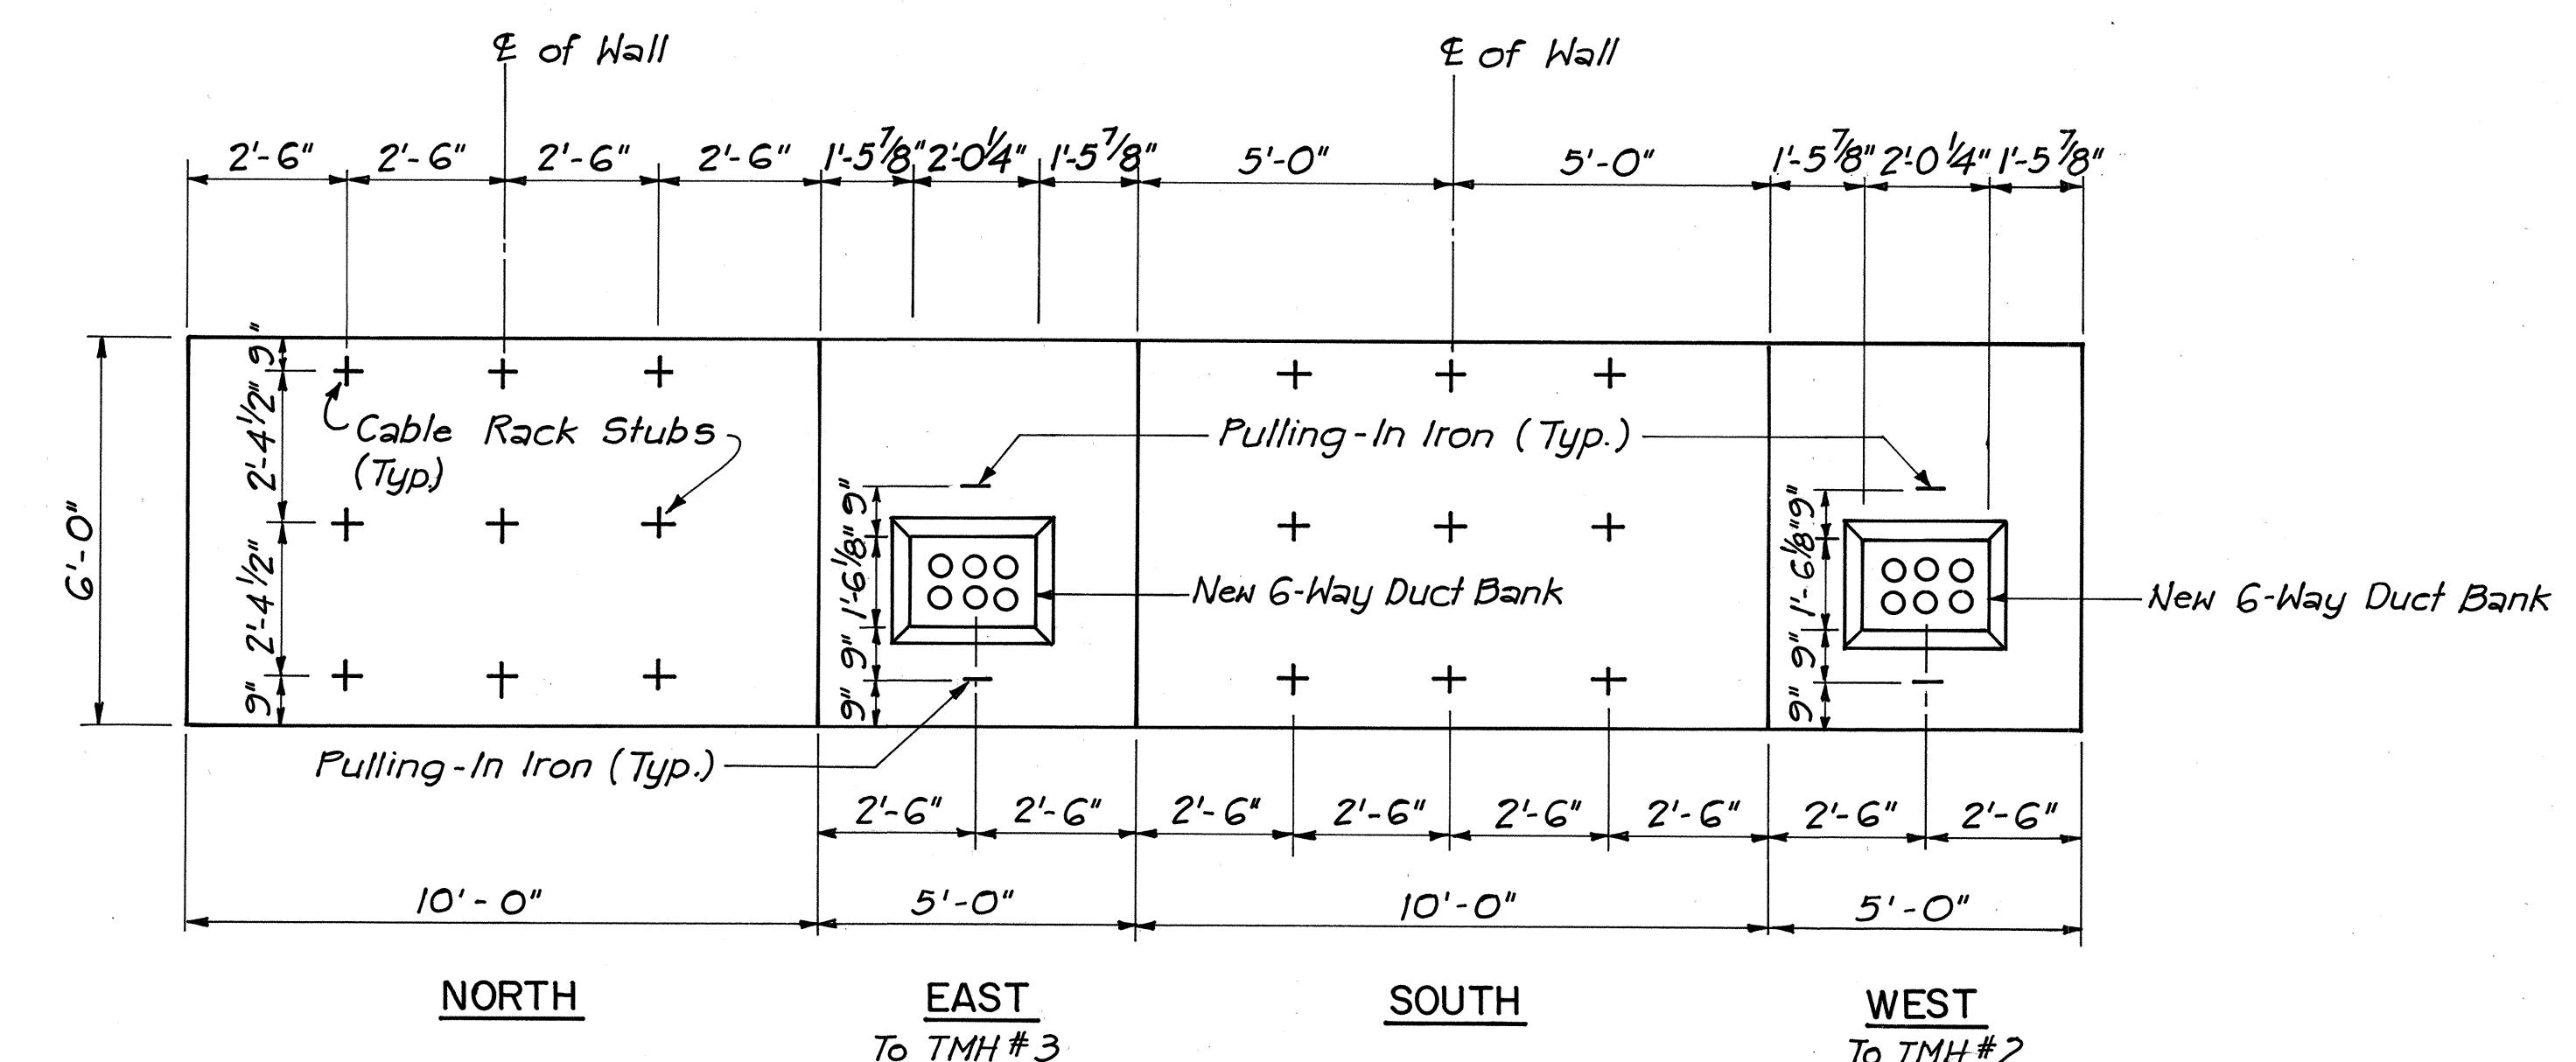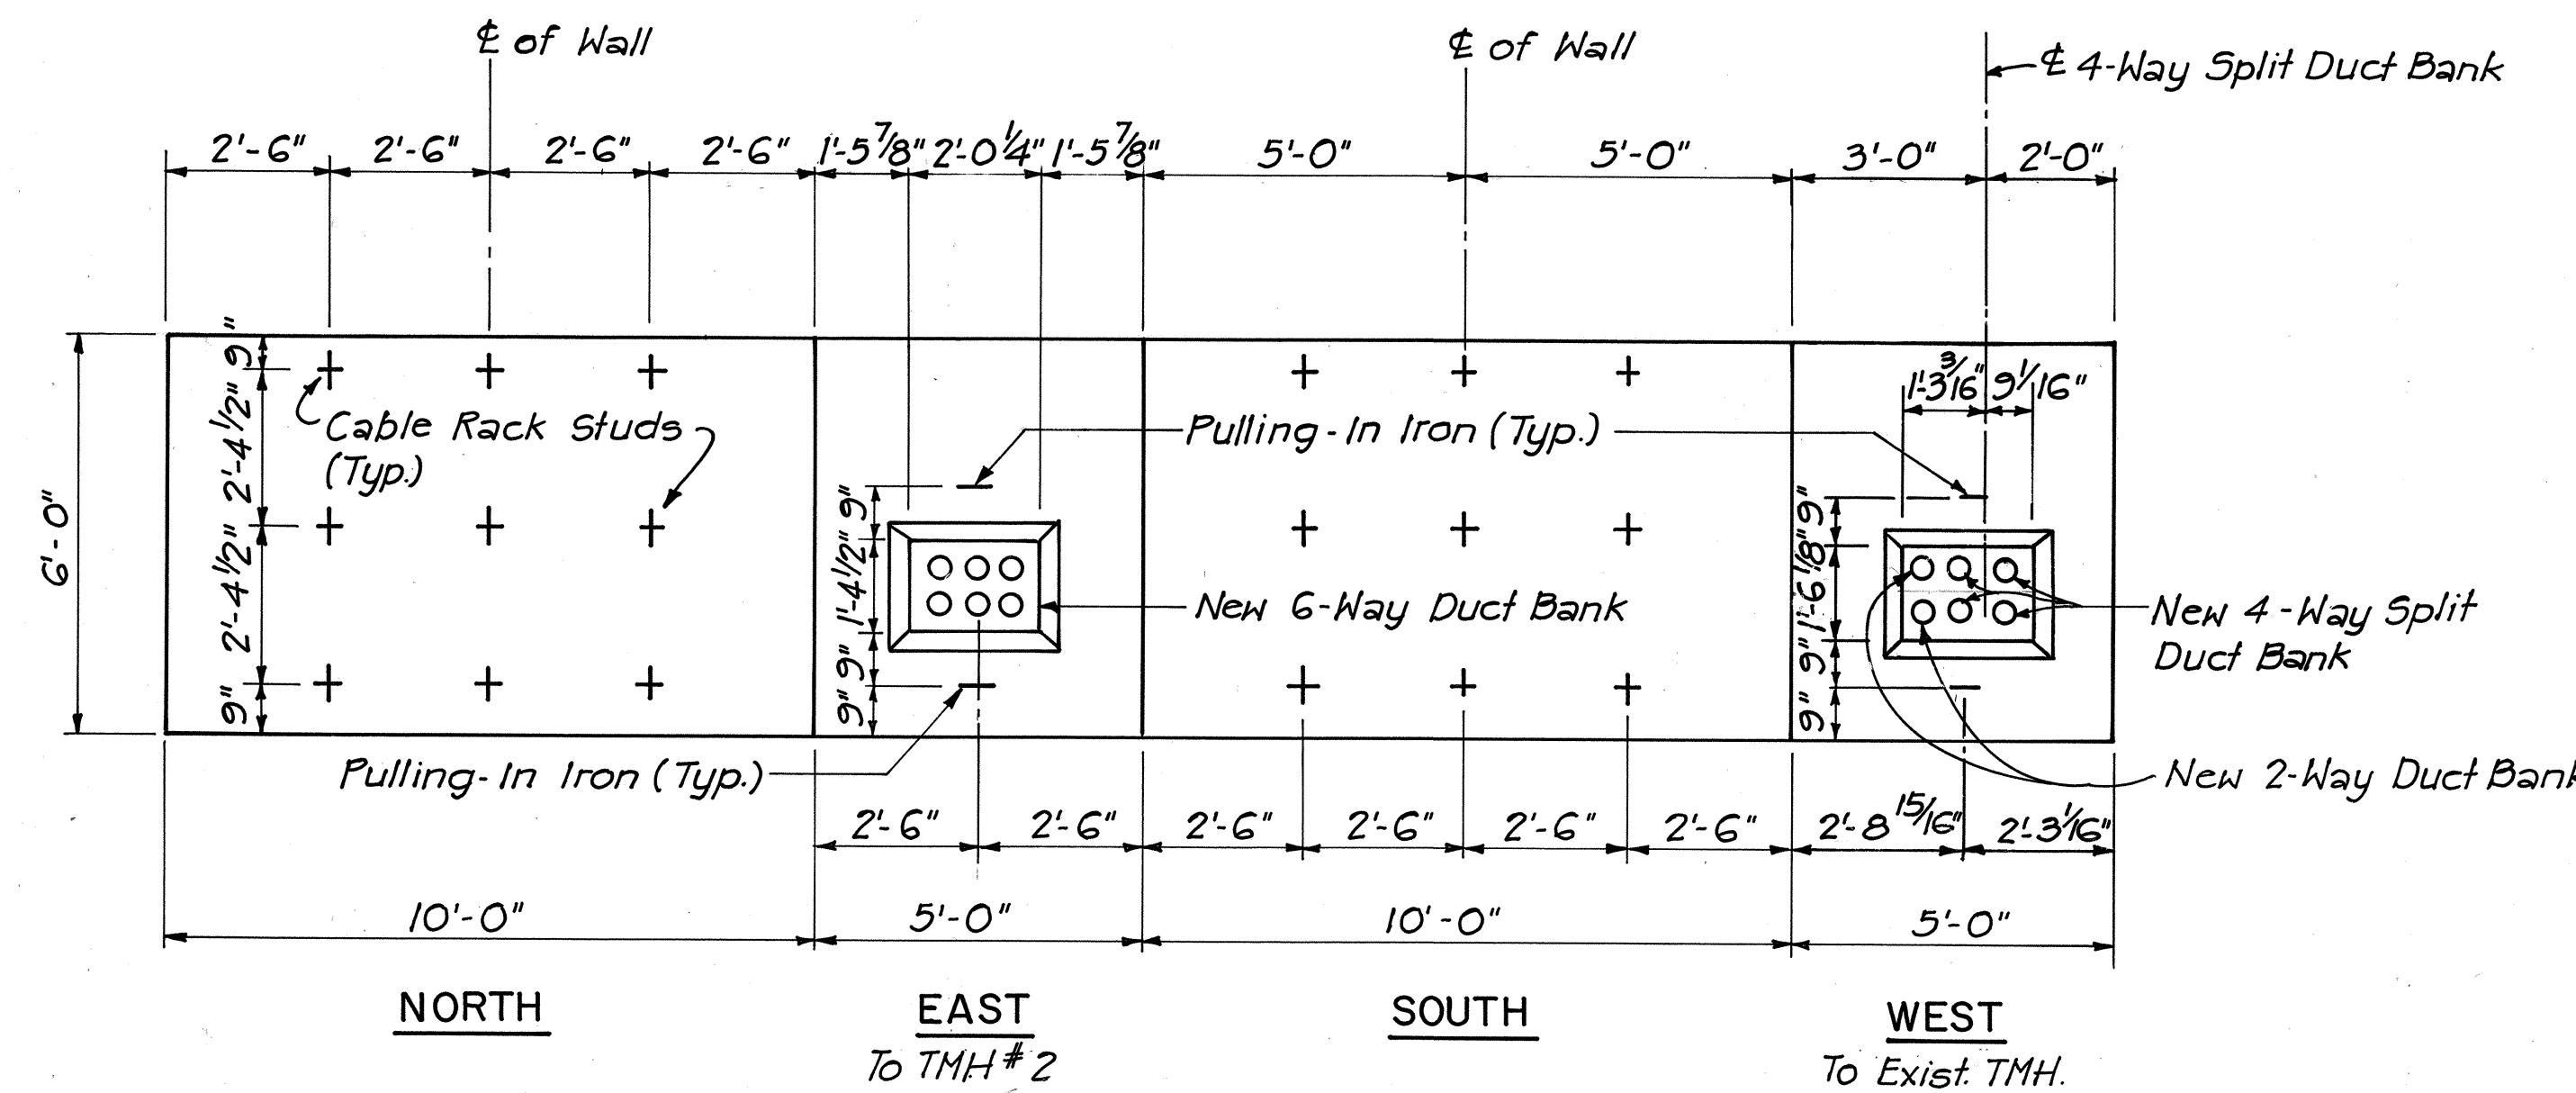

ORIGINAL DRAWN BY _____
SURVEY PLOTTED BY _____
NOTE BOOK _____
TRACED BY _____
DESIGNED BY _____
QUANTITIES BY _____
CHECKED BY _____

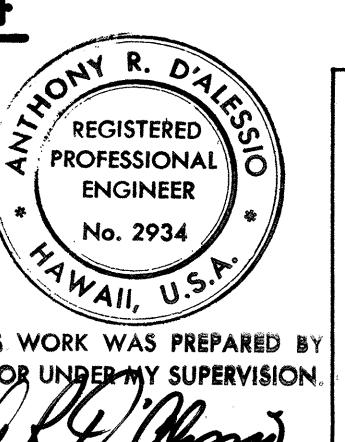


THIS WORK WAS PREPARED BY
ME OR UNDER MY SUPERVISION.
R. J. D'Alessio


Telephone Co.
Hawaiian Telephone Co.

STATE OF HAWAII
DEPARTMENT OF TRANSPORTATION
HIGHWAYS DIVISION
MANHOLE WALL ELEVATIONS - TELEPHONE
FORT WEAVER ROAD
ROUTE H-1 TO SOUTH OF
FARRINGTON HIGHWAY
SCALE: N.T.S. DATE: AUG. 1978
SHEET NO. 144 OF 330 SHEETS

FED. ROAD DIST. NO.	STATE	FED. AID PROJ. NO.	FISCAL YEAR	SHEET NO.	TOTAL SHEETS
HAWAII	HAW.	M-7600(1)	1978	116	198

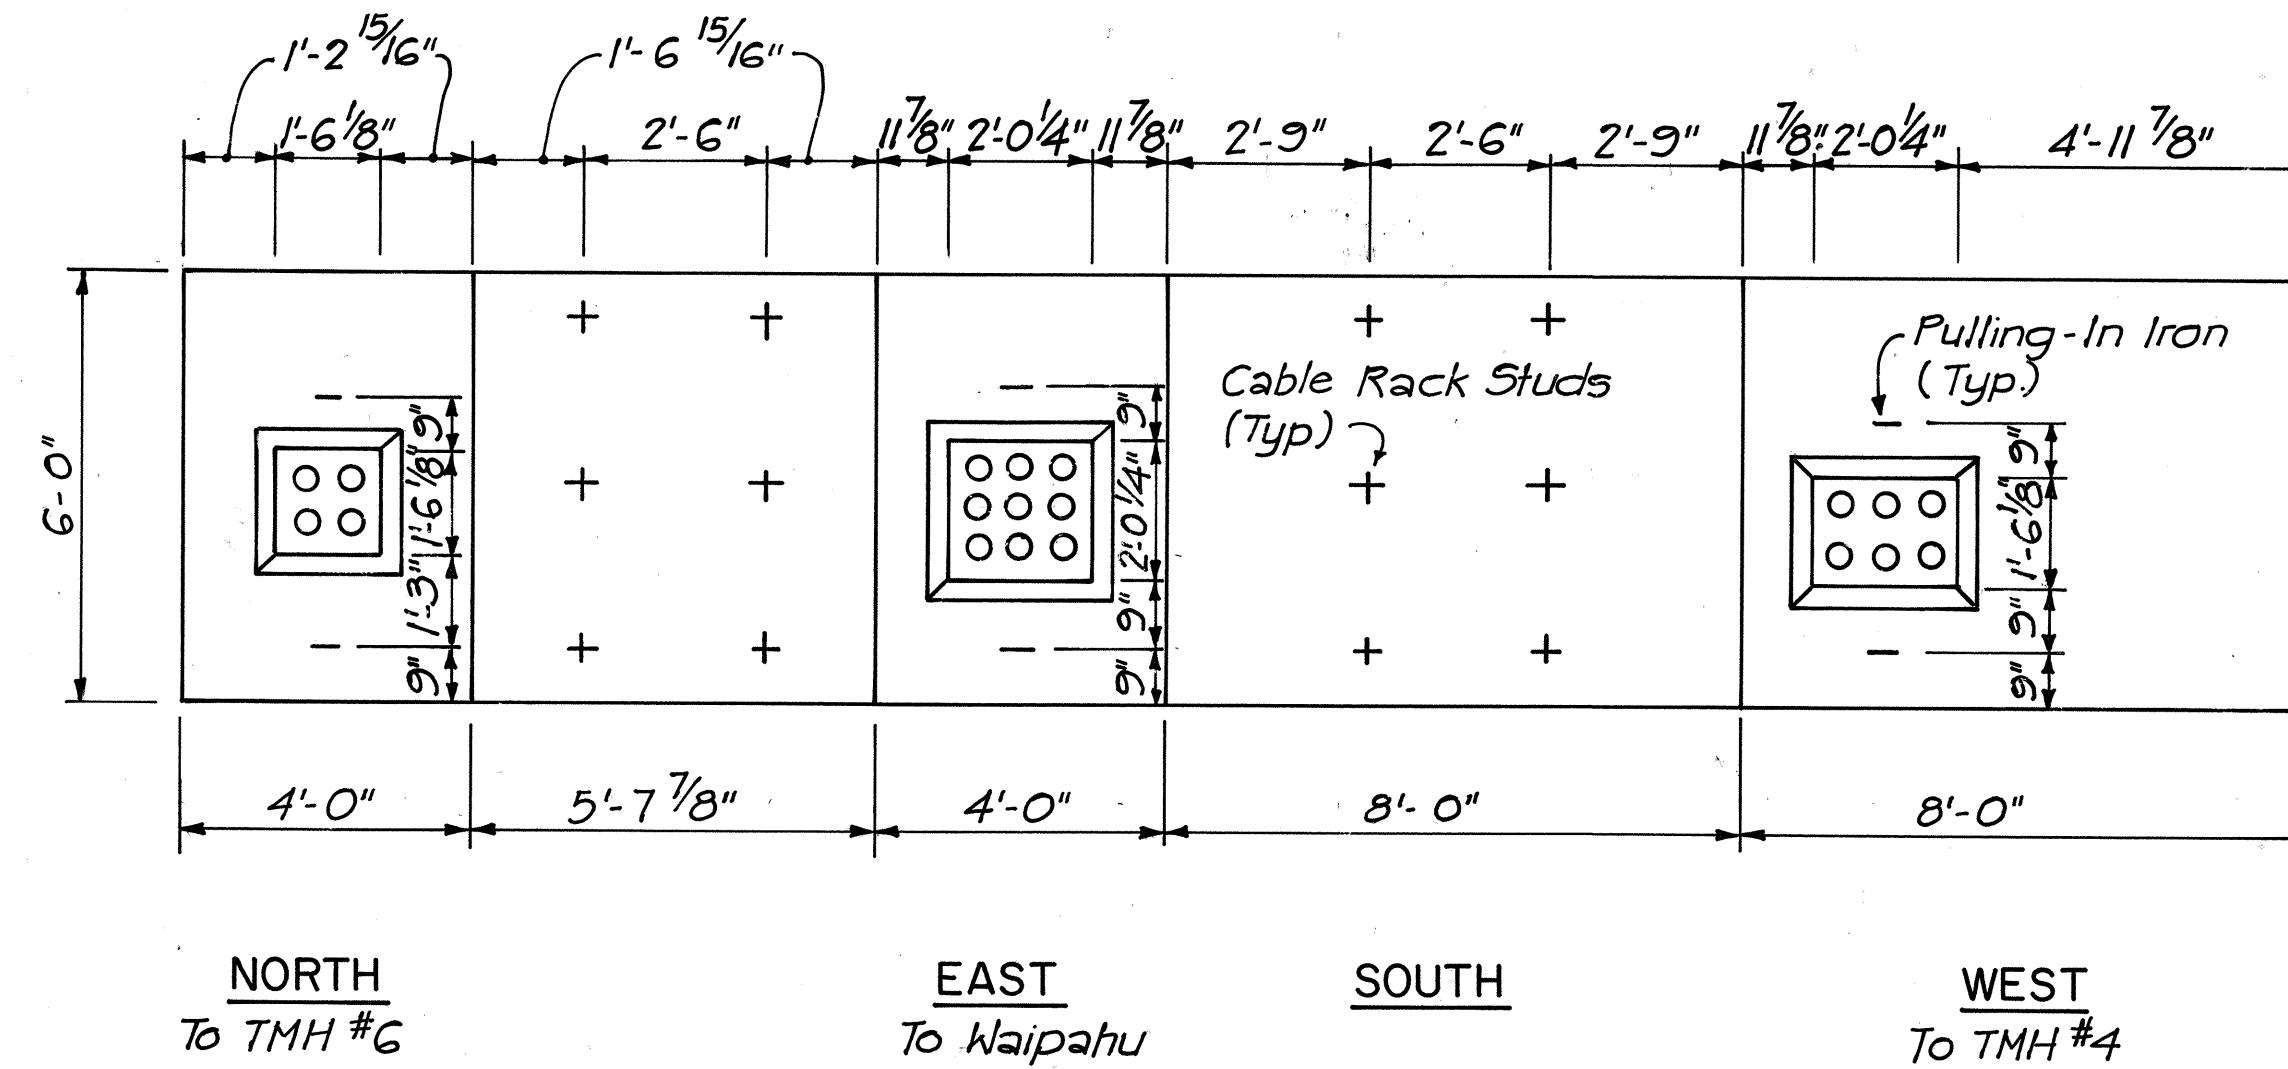


SMALL CORNER TYPE MANHOLE NO.5

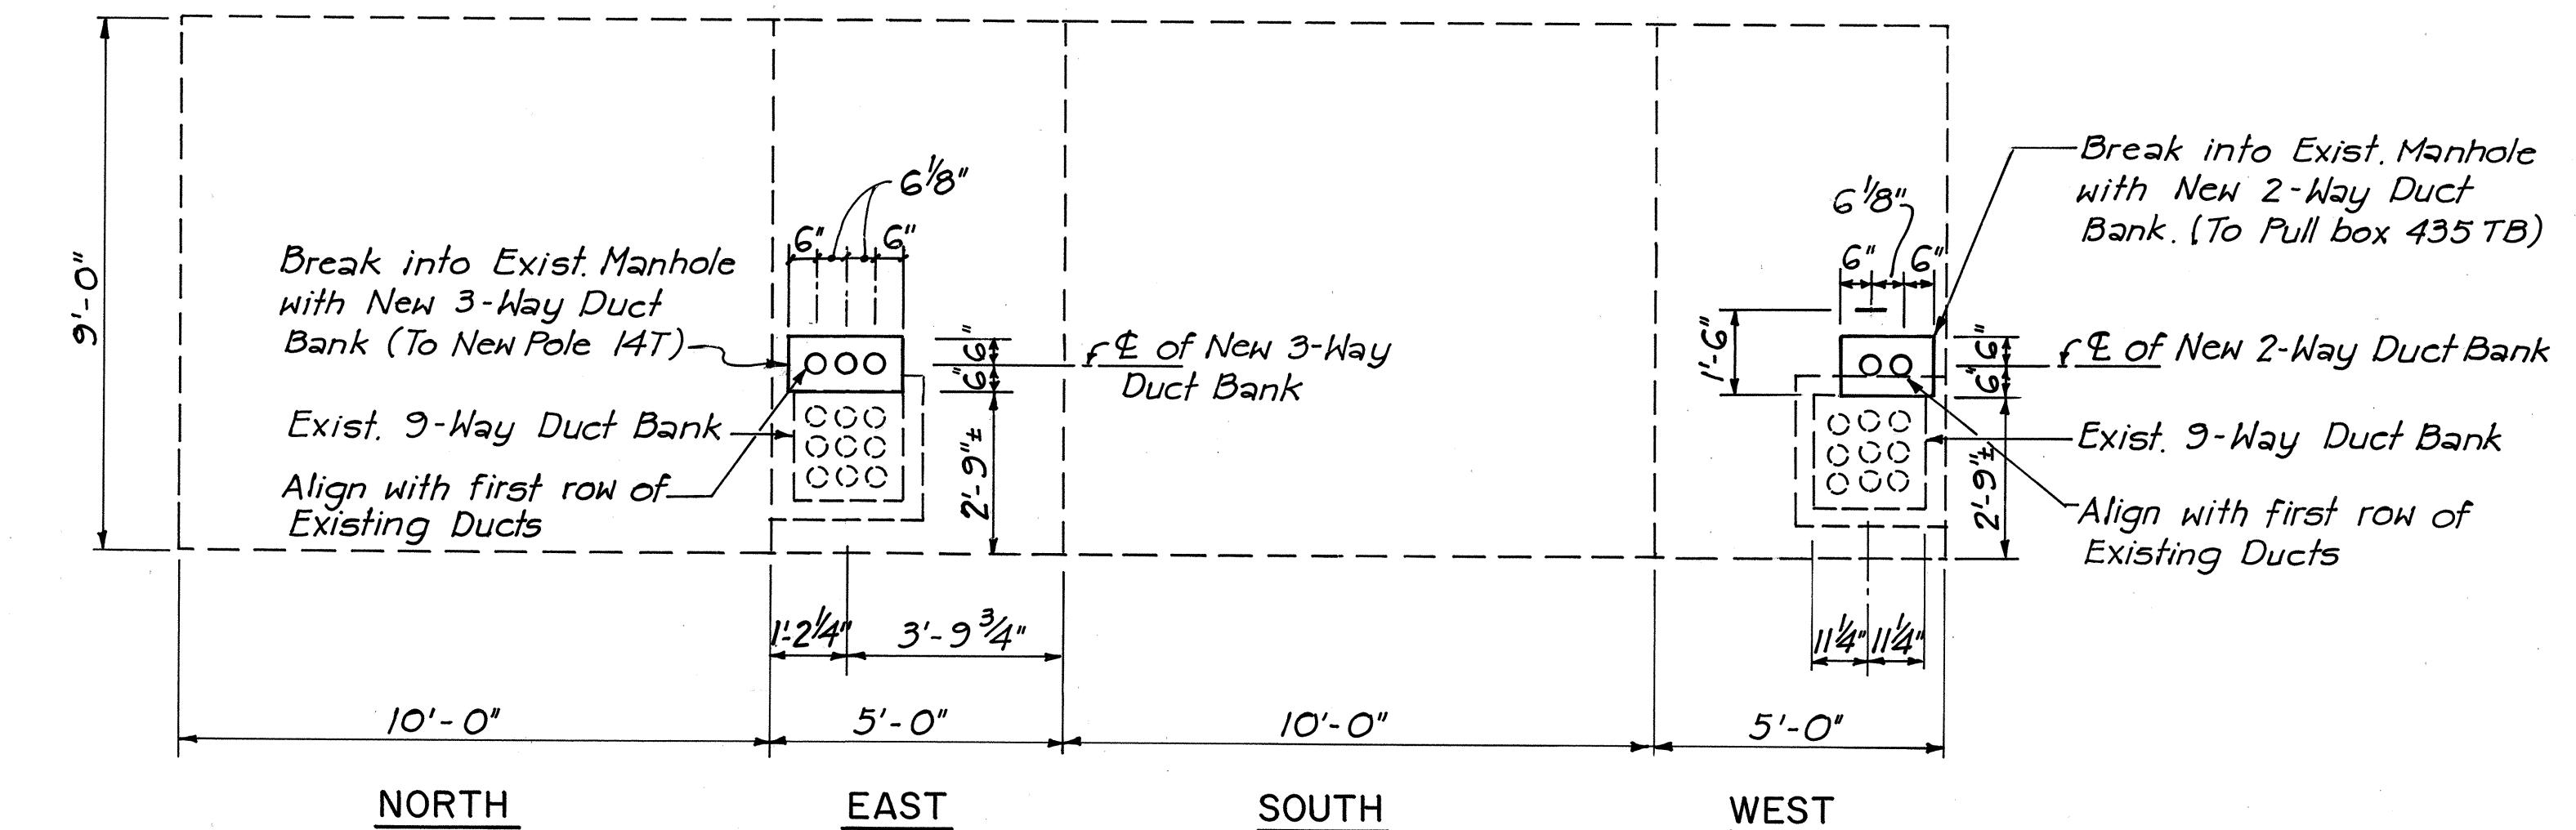


EXISTING MANHOLE # 2632

Farrington Hwy Sta. 57 + 49 ±

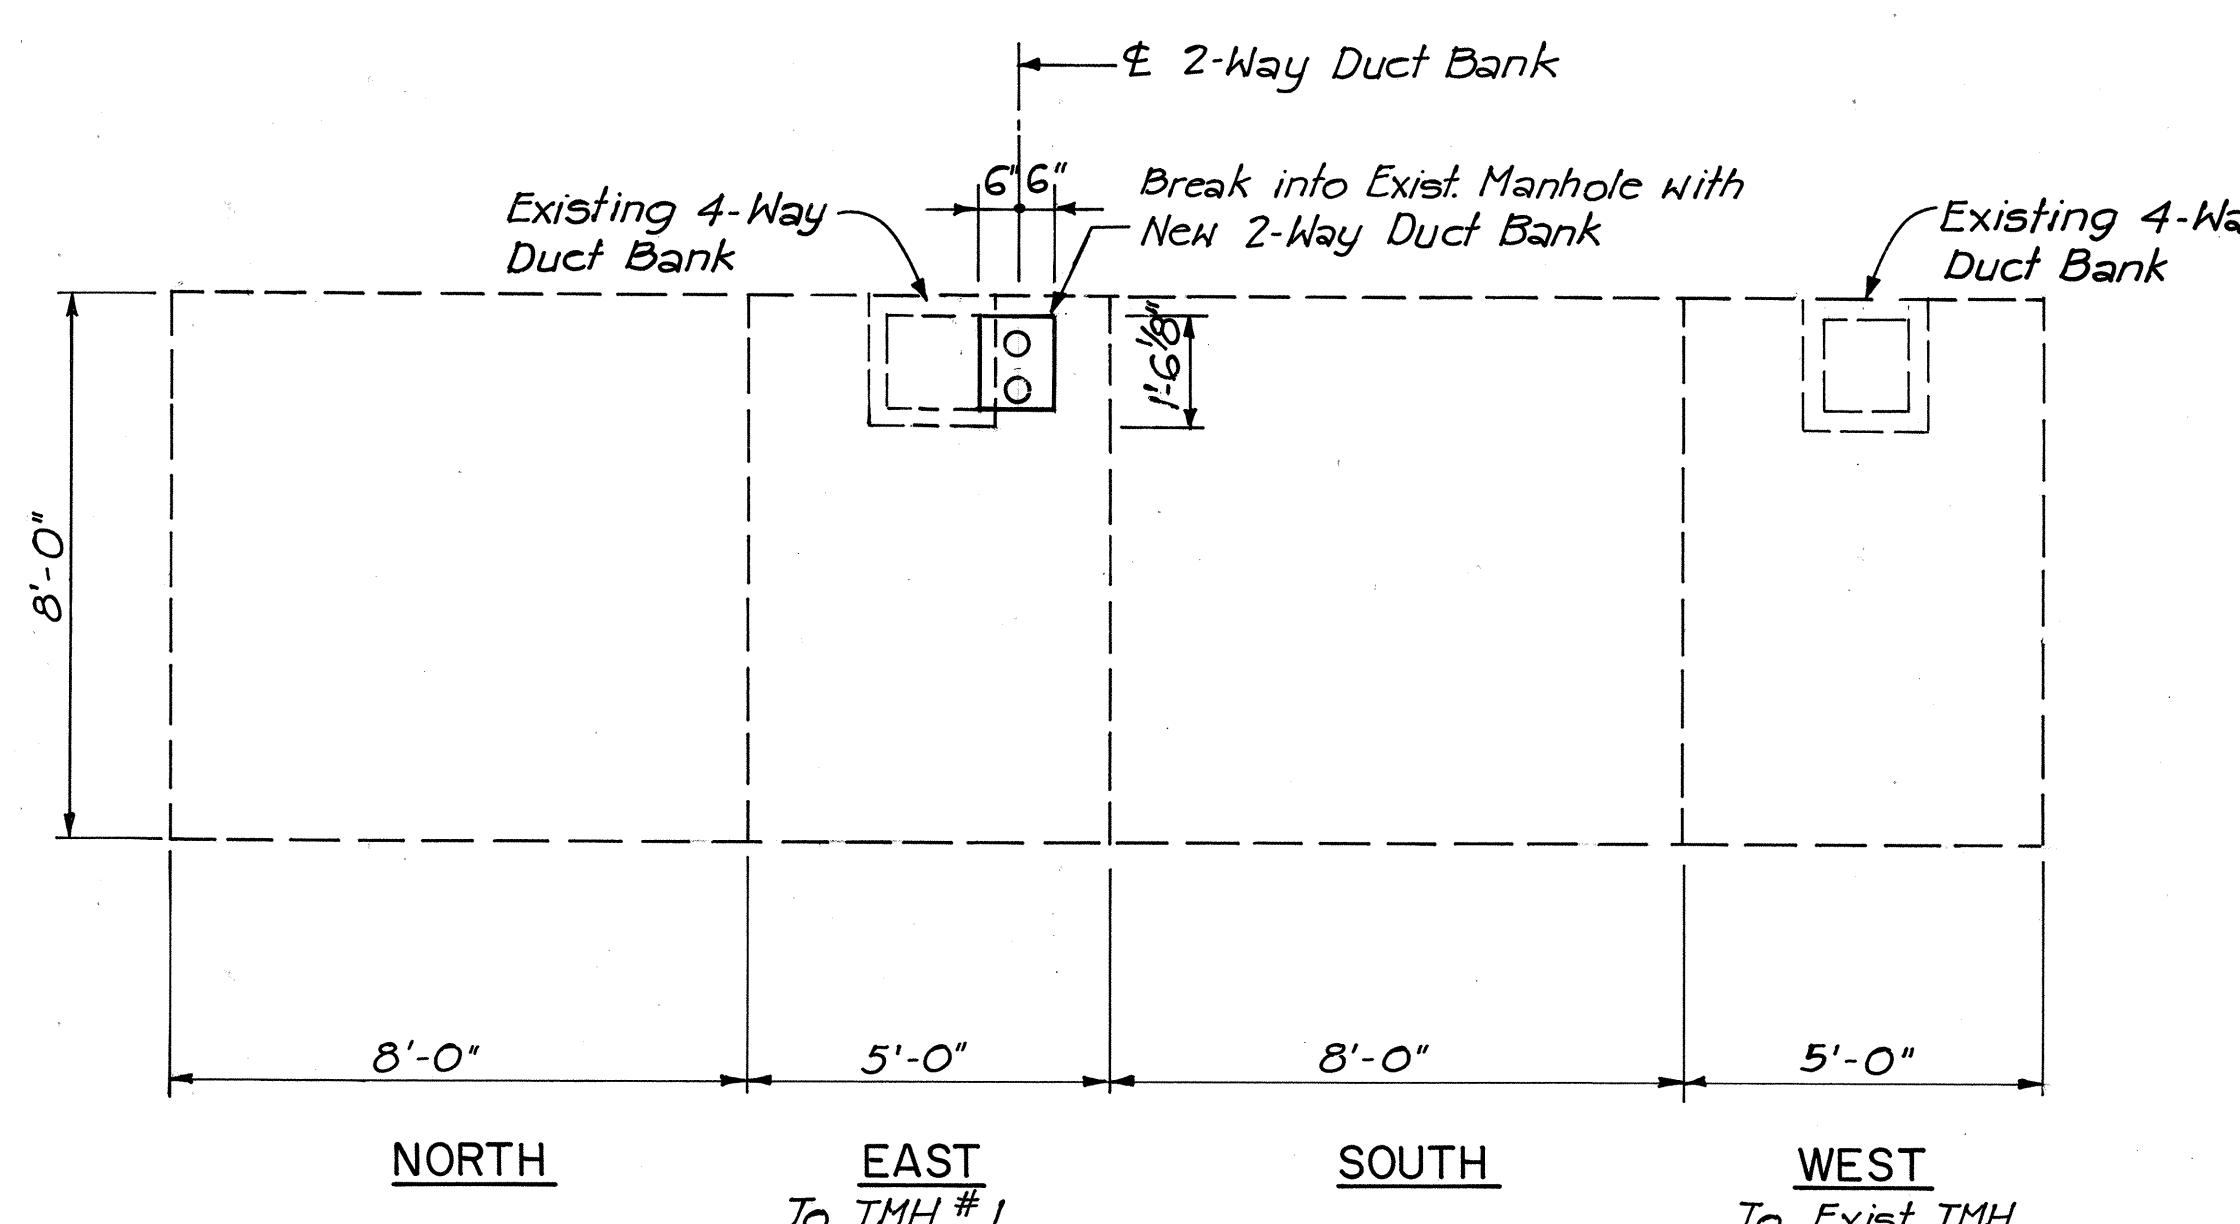


EXISTING MANHOLE

Farrington Hwy. Sta. 25 + 17±(I.B)

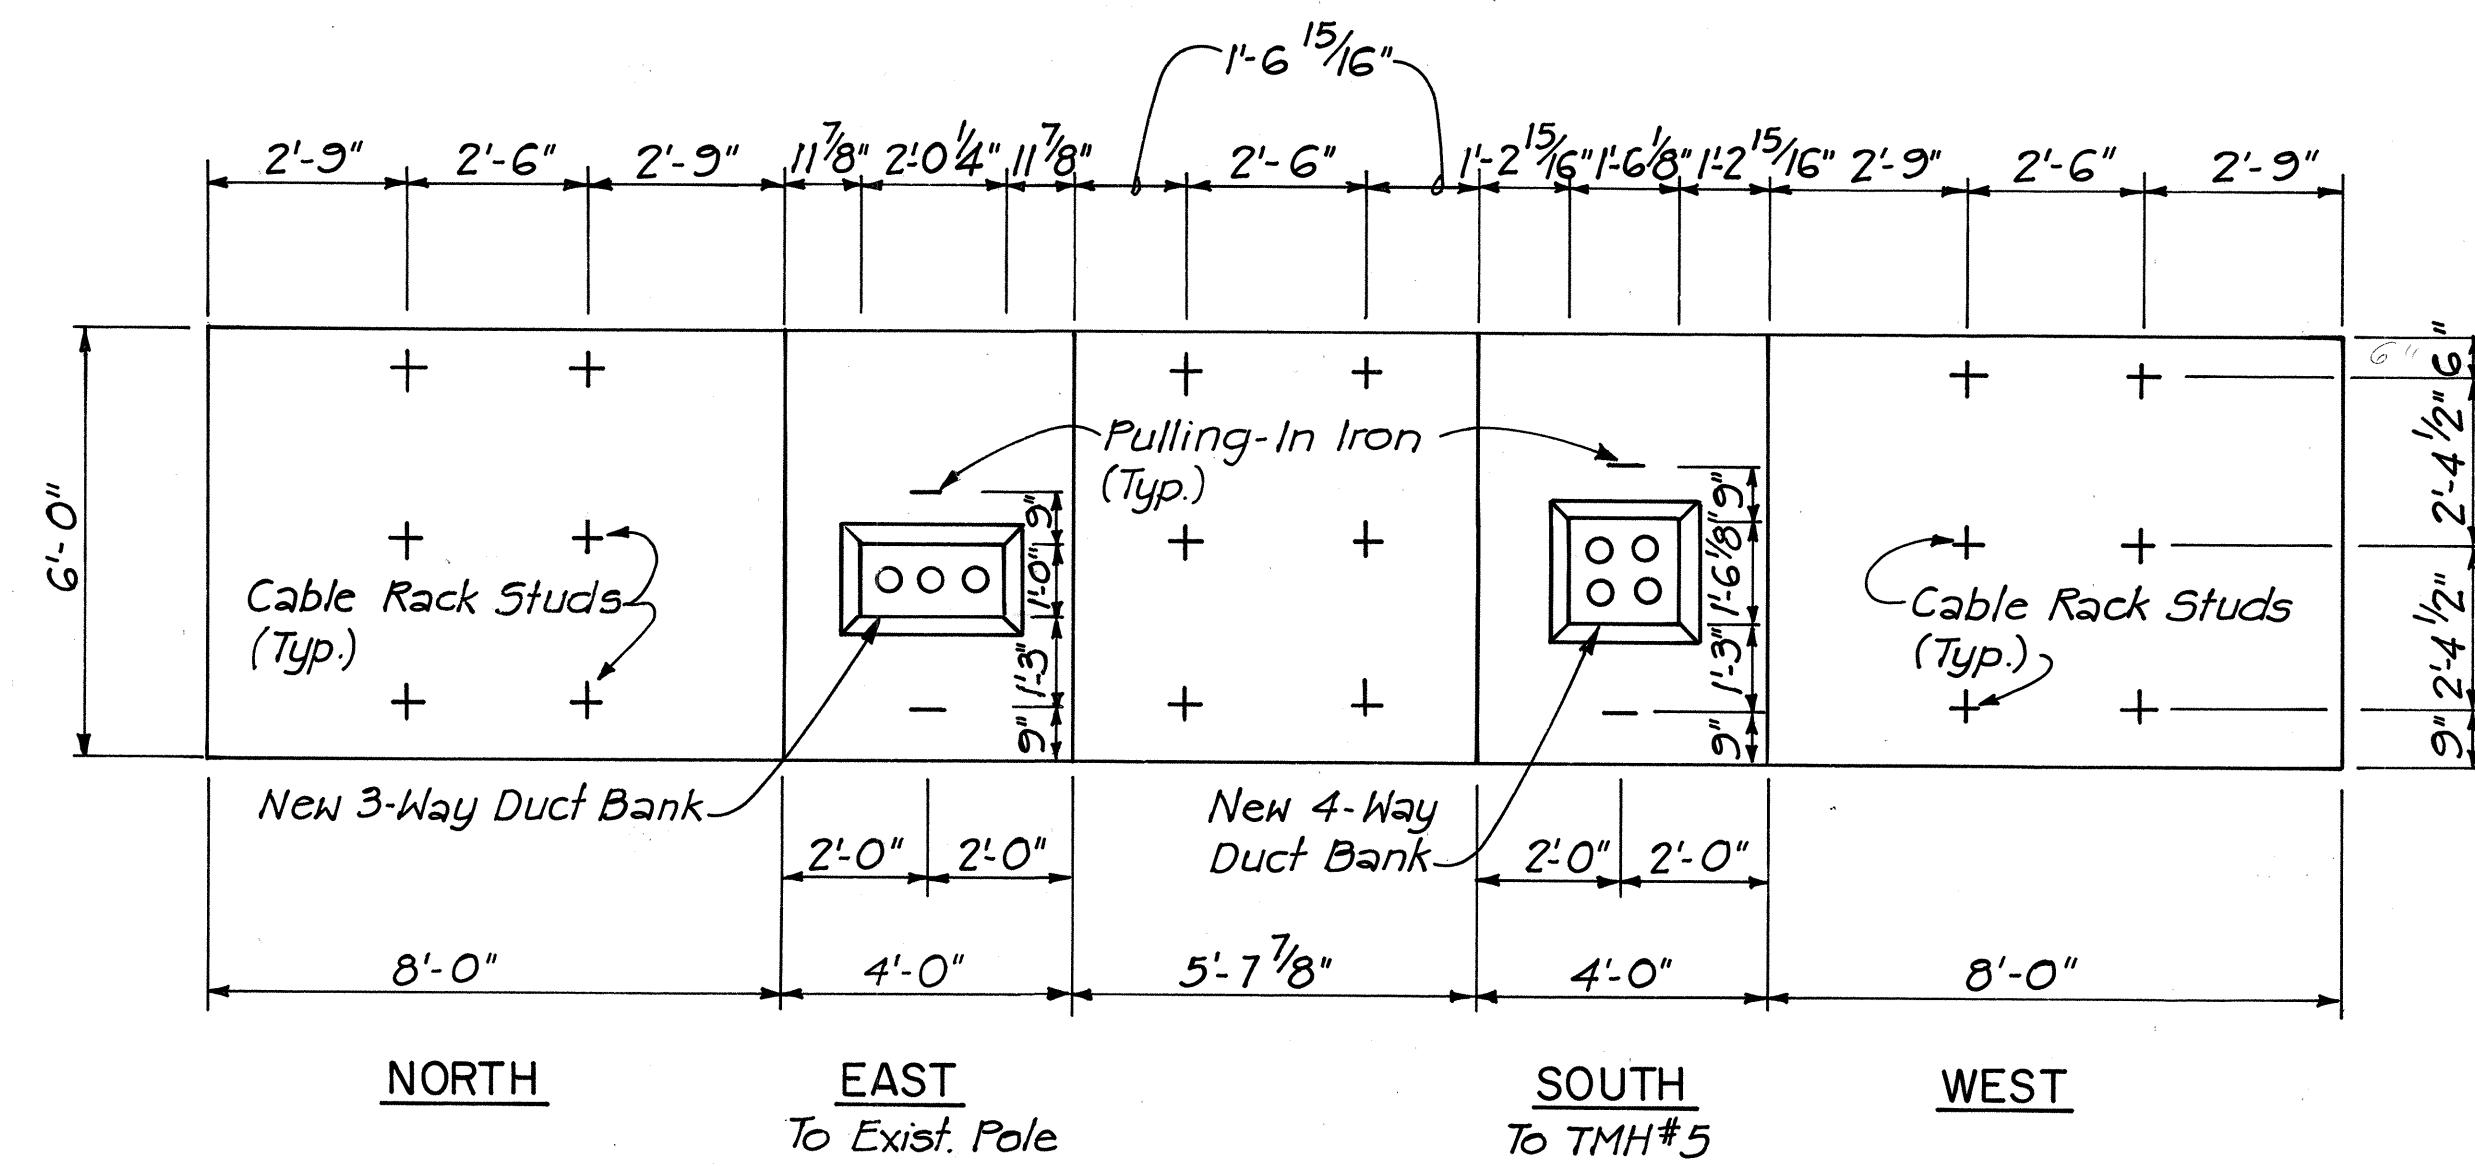

SMALL CORNER TYPE MANHOLE NO.6

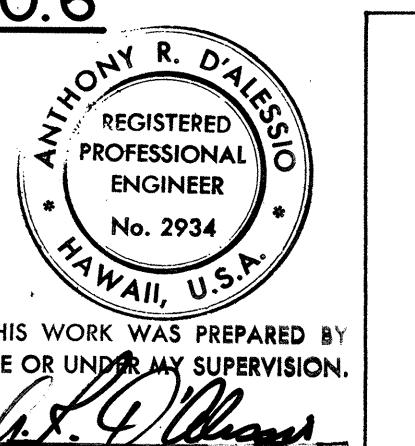

THIS WORK WAS PREPARED BY
ME OR UNDER MY SUPERVISION.

6/26/78
Date

Hawaiian Telephone Co.


**STATE OF HAWAII
DEPARTMENT OF TRANSPORTATION
HIGHWAYS DIVISION**

MANHOLE WALL
ELEVATION - TELEPHONE

FORT WEAVER ROAD
ROUTE H-1 TO SOUTH OF
FARRINGTON HIGHWAY


SCALE : N.T.S. DATE: AUG. 1978
SHEET NO. 15U OF 33U SHEETS

FED. ROAD DIST. NO.	STATE	FED. AID PROJ. NO.	FISCAL YEAR	SHEET NO.	TOTAL SHEETS
HAWAII	HAW.	M-7600(1)	1978	117	198

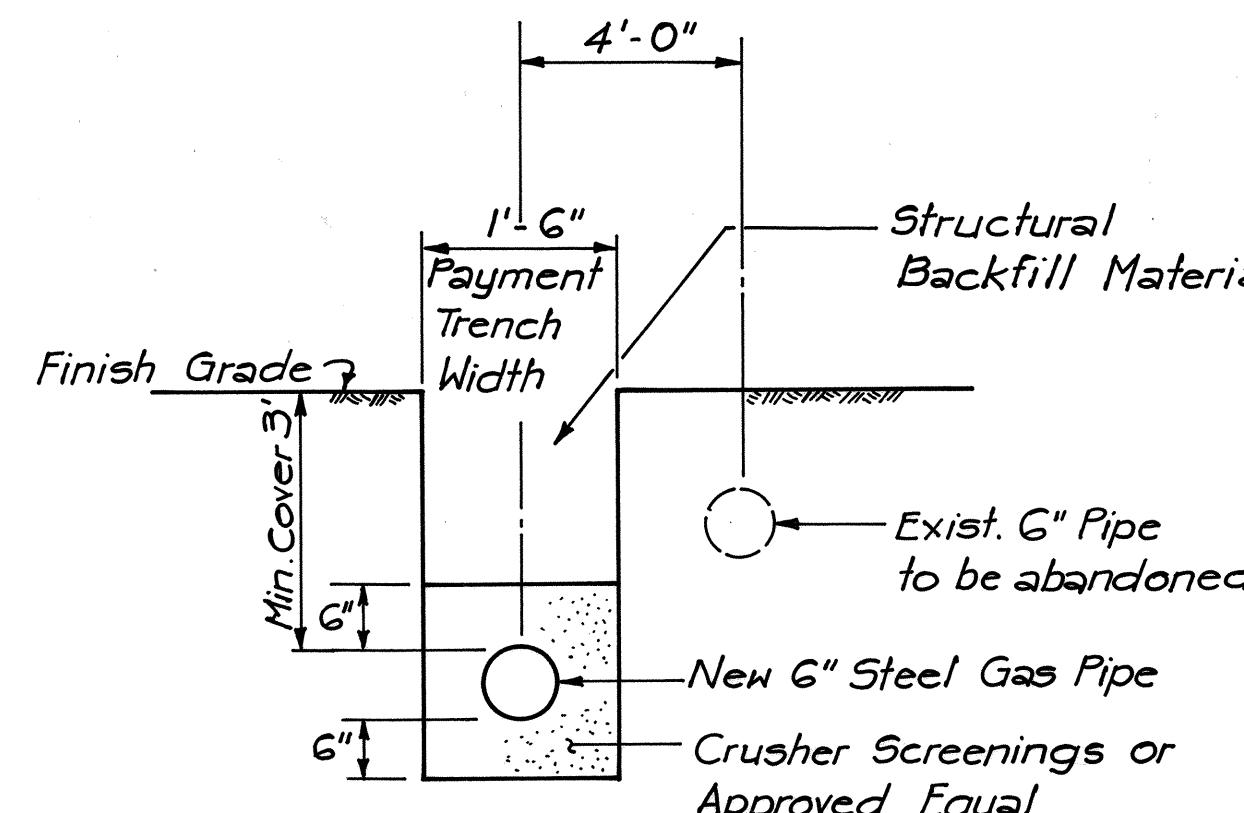


GAS TRENCH DETAIL


N.T.

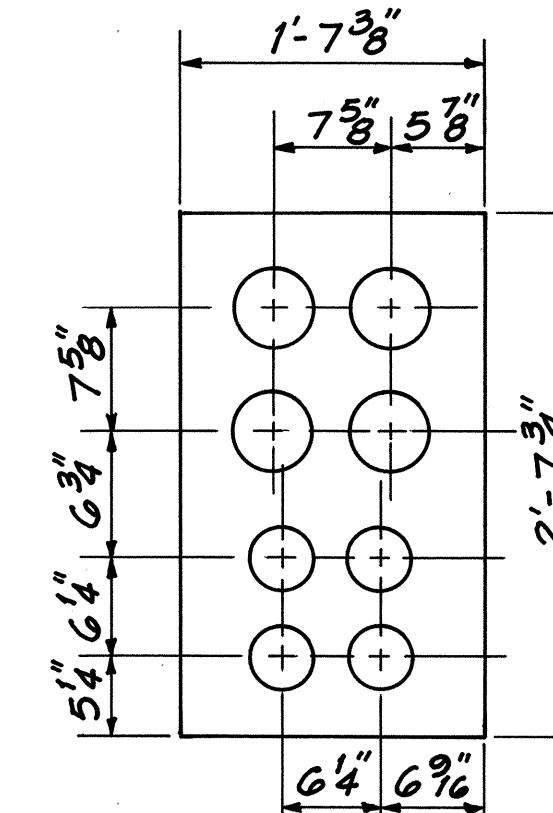


4-5", 4-4" DUCTS

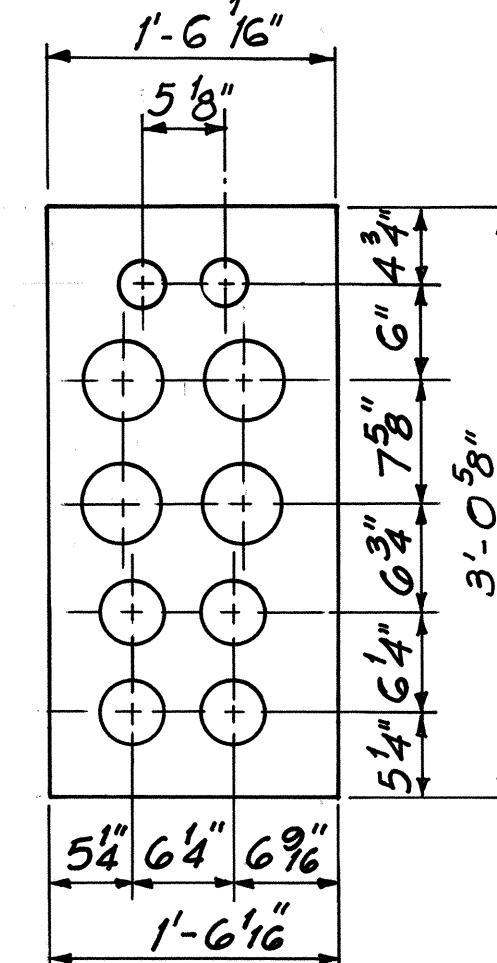

4-5", 4-4", 2-3" DUCTS

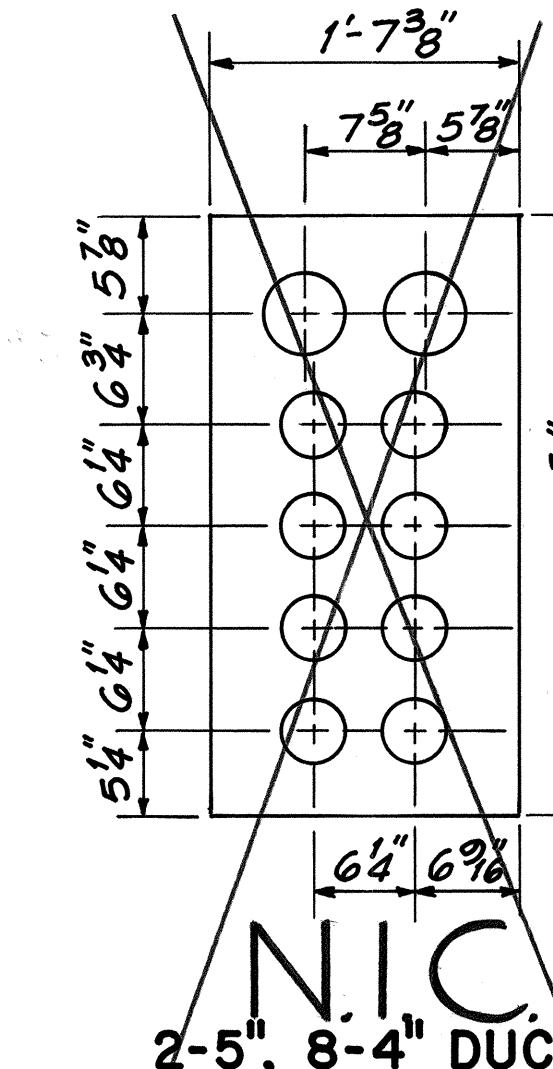


I-5", I-3" DUCTS

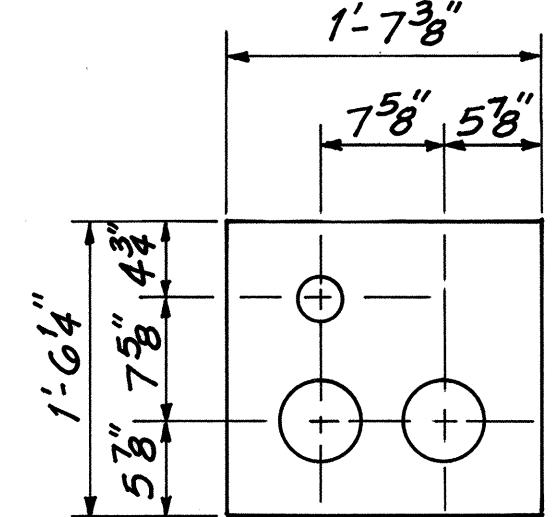


2-5", 1-3" DUCTS

HECO DUCT SECTIONS


SCALE: 1" = 1'-0"

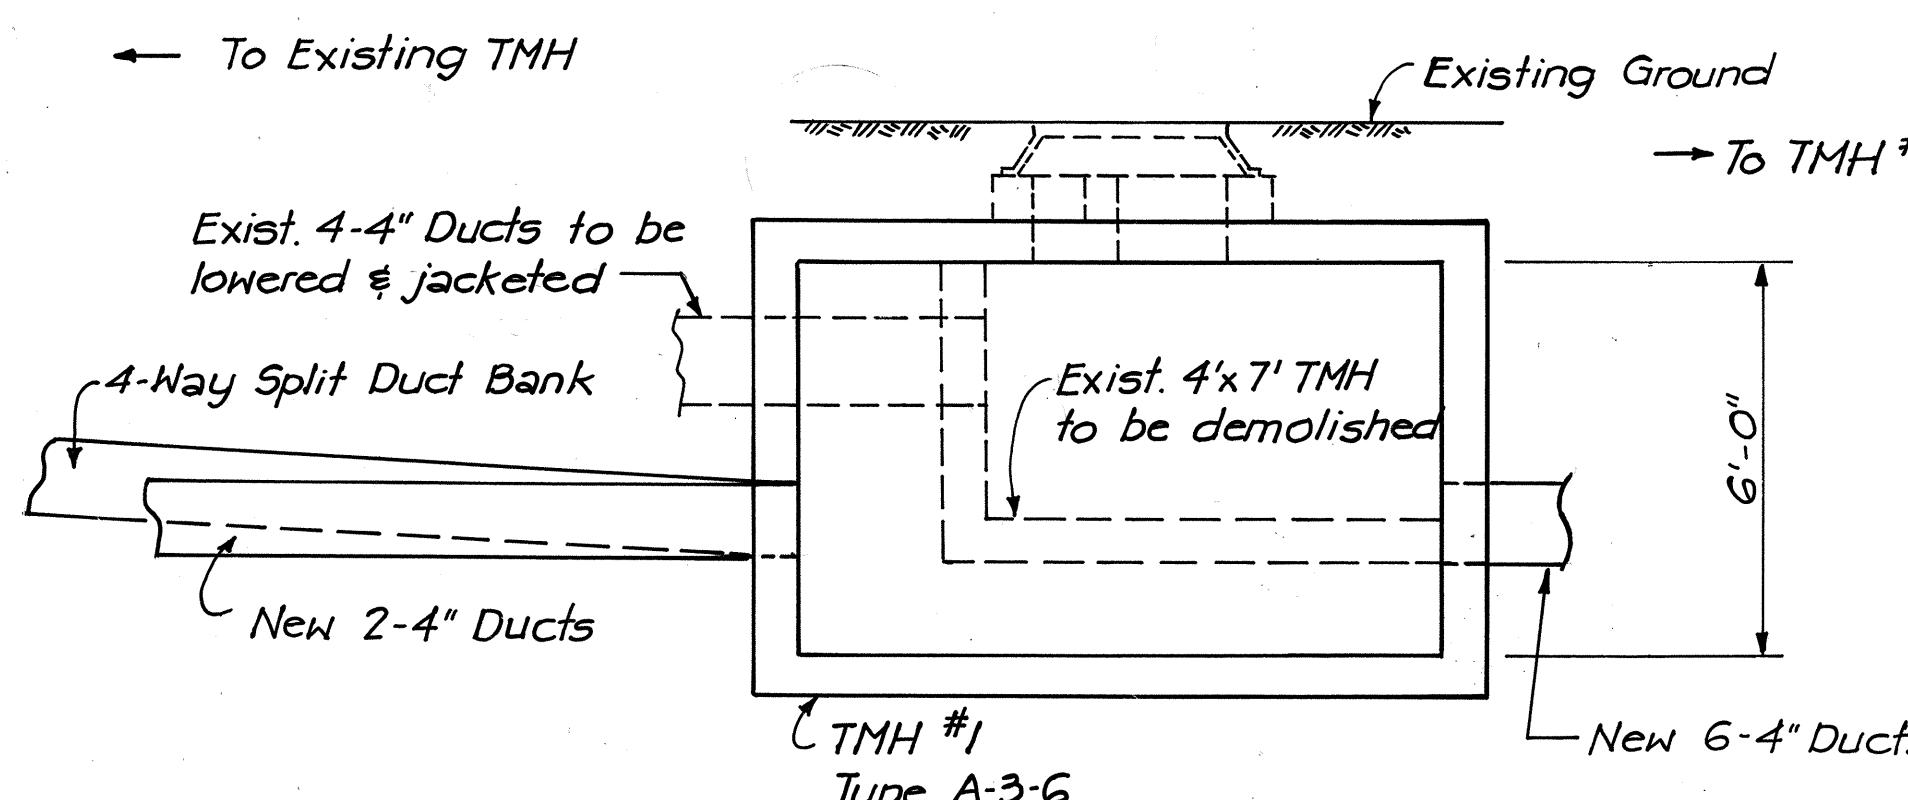

ELEVATION

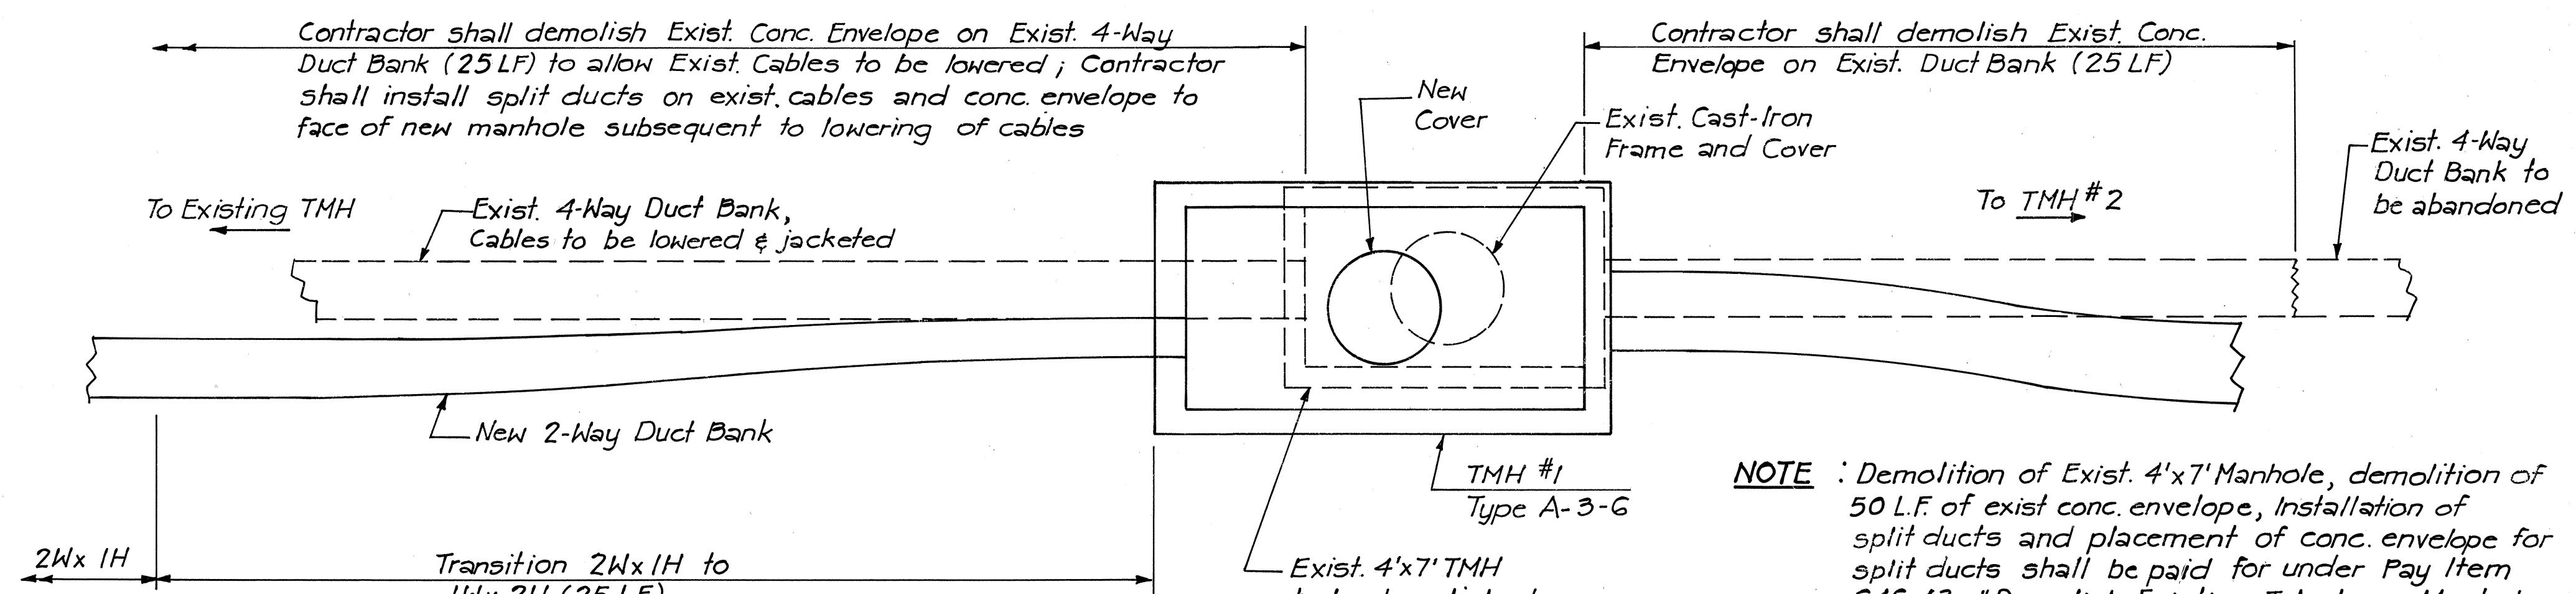

PLAN

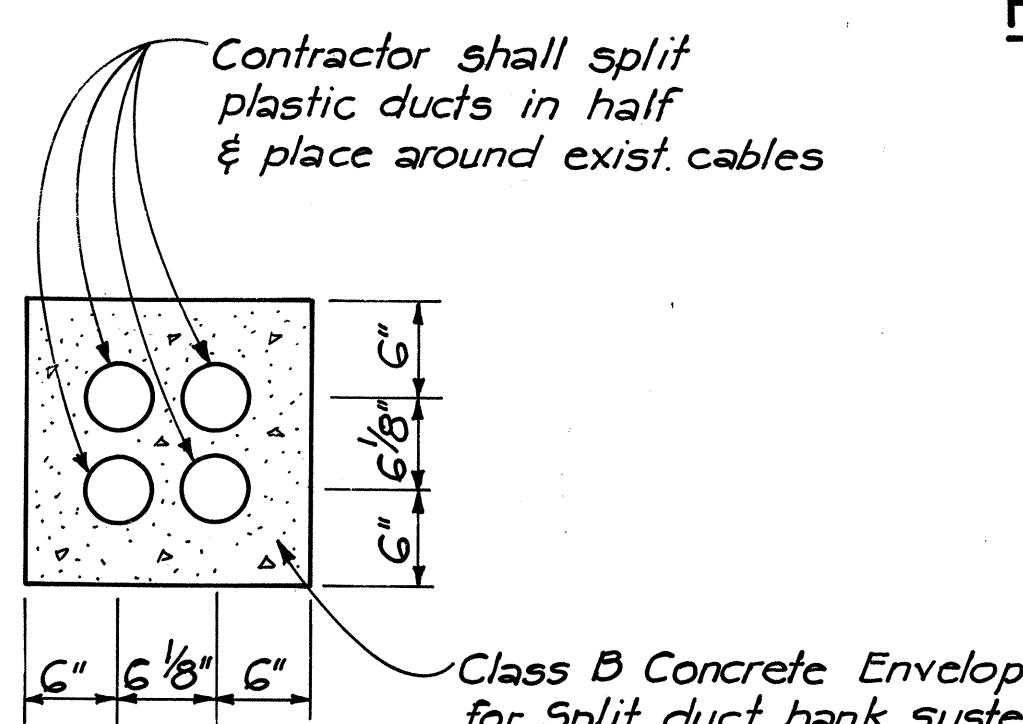

HTCO. SPLIT DUCT BANK DETAIL

NTC

APPROVED:

Aug 19 J Karmot
Hawaiian Electric Co Inc

W. Hamada
Hawaiian Telephone Co. Ltd.

Ron H. Yoshimoto
Gas Co., Inc.



THIS WORK WAS PREPARED BY
ME OR UNDER MY SUPERVISION.



**STATE OF HAWAII
DEPARTMENT OF TRANSPORTATION
HIGHWAYS DIVISION**

MISCELLANEOUS DETAILS


FORT WEAVER ROAD
ROUTE H-1 TO SOUTH OF
FARRINGTON HIGHWAY

SCALE: AS SHOWN DATE: AUG. 1978
SHEET NO. OF SHEETS


FED. ROAD DIST. NO.	STATE	FED. AID PROJ. NO.	FISCAL YEAR	SHEET NO.	TOTAL SHEETS
HAWAII	HAW.	M-76003	1978	117A	198

GENERAL NOTES


- Design Data
 $f_s = 20,000 \text{ psi}$
 $f'_c = 3,000 \text{ psi}$
 $f_c = 1,200 \text{ psi}$
 $n = 10$
 $w = \text{Equiv. fluid pressure } 30 \text{#/ft}^2$
- Concrete shall be Class A.
- Reinforcing - Intermediate Grade deformed bars.
- Unless otherwise indicated, for vertical location of Duct Windows see profile sheet.
- Manhole Walls shall be doubled formed
- All Concrete shall be cured by an Impervious Liquid Membrane Compound.
- Concrete shall not be loaded, except by its own weight, until 28 days after placement.
- All Construction Joints shall be waterproofed.
- Plug all ducts in Manhole.
- Concrete Admixture shall be $2\frac{1}{2}$ Lbs. "Tricosol Normal" per cubic yard.
- Apply Dampproofing to the surfaces of Reinforced Concrete that are in contact with the earth excluding the underside of the floor slab. Material and application shall be according to the 1969 edition of the "State" Highway Department's Standard Specifications for Road and Bridge Construction.
- For Details "A", "B", "C", Sections "D-D", "E-E", "F-F", and other miscellaneous manhole construction details, see supplement sheet to Type "A-1", "A-2", and "A-3" Telephone Manholes.

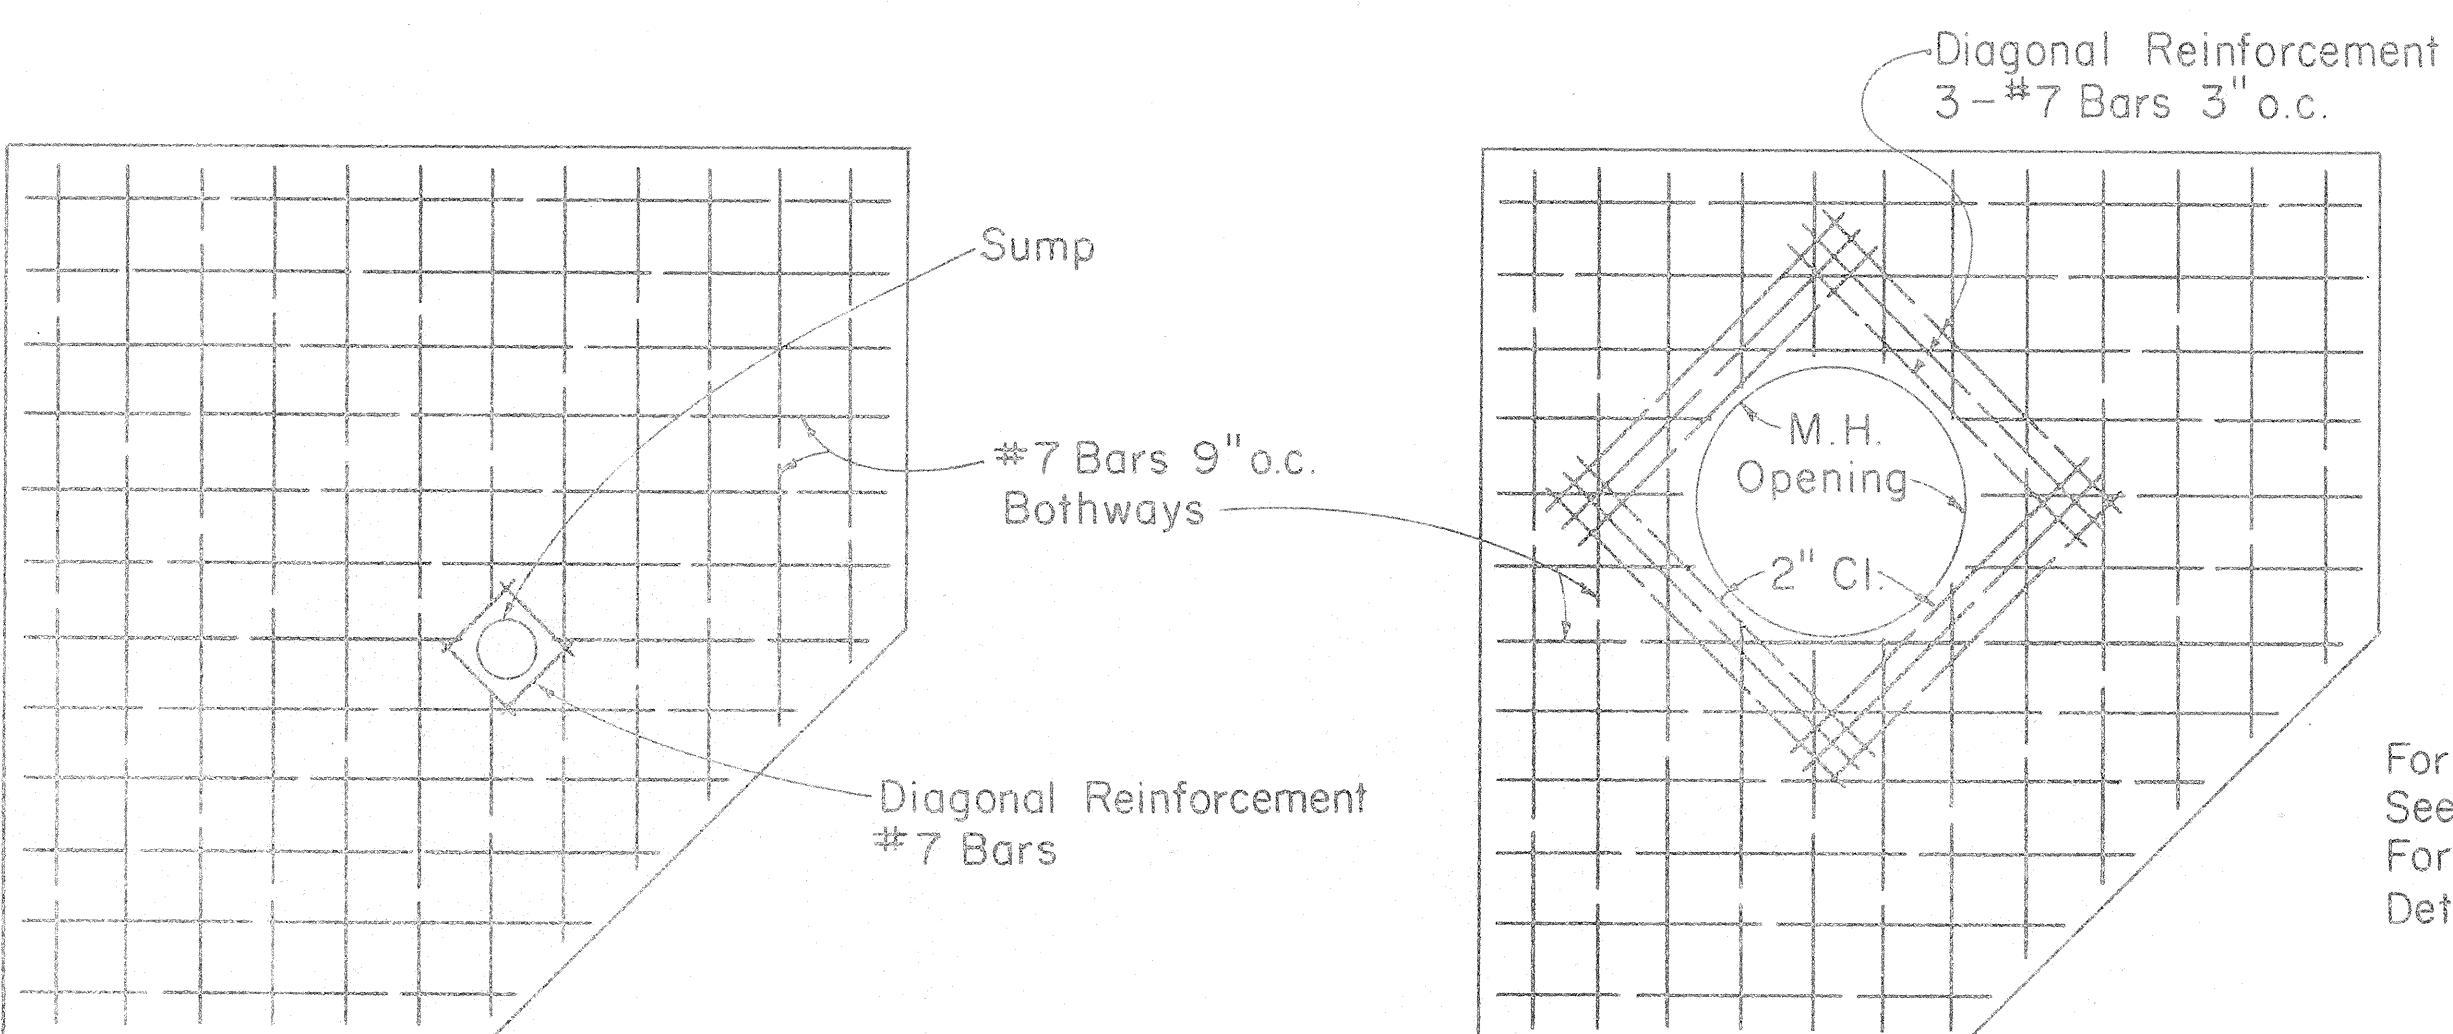


FLOOR SLAB REINF. PLAN

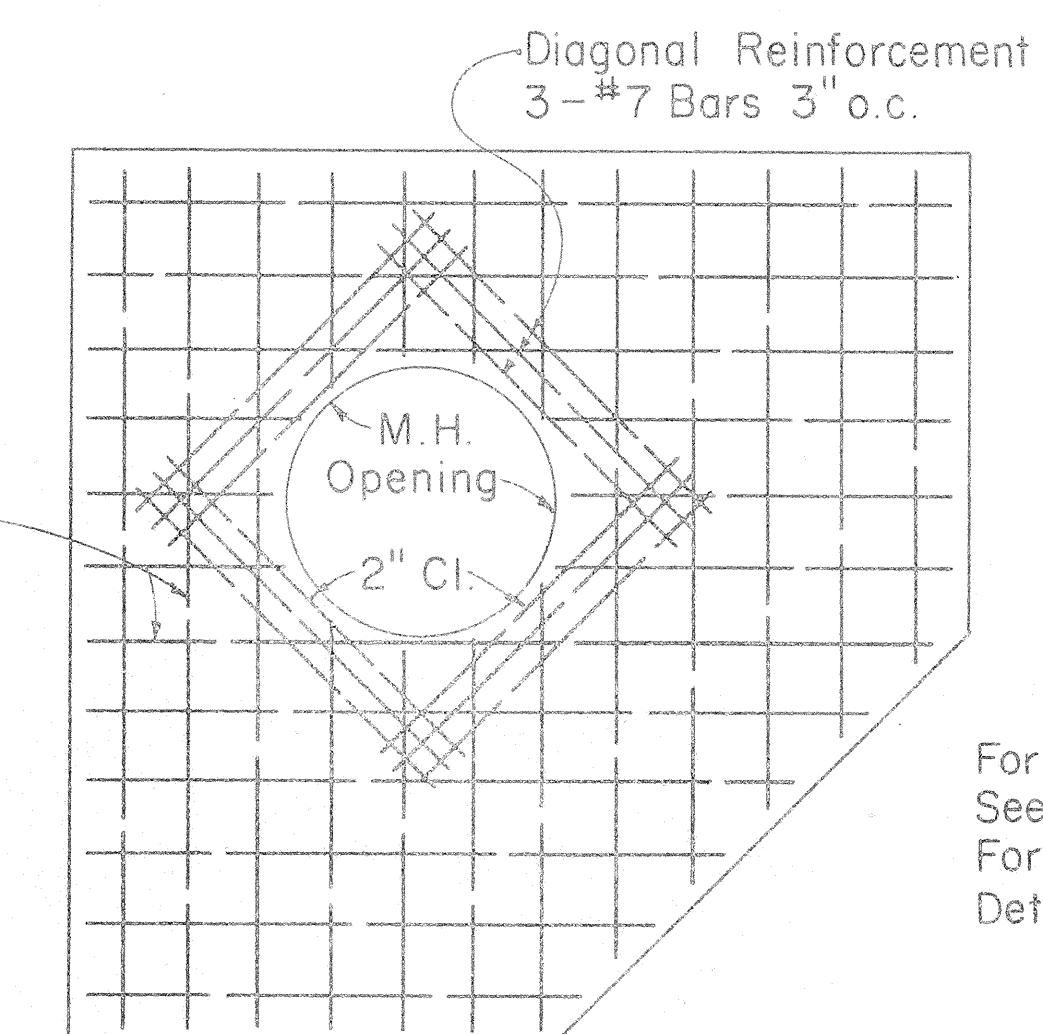


ROOF SLAB REINF. PLAN

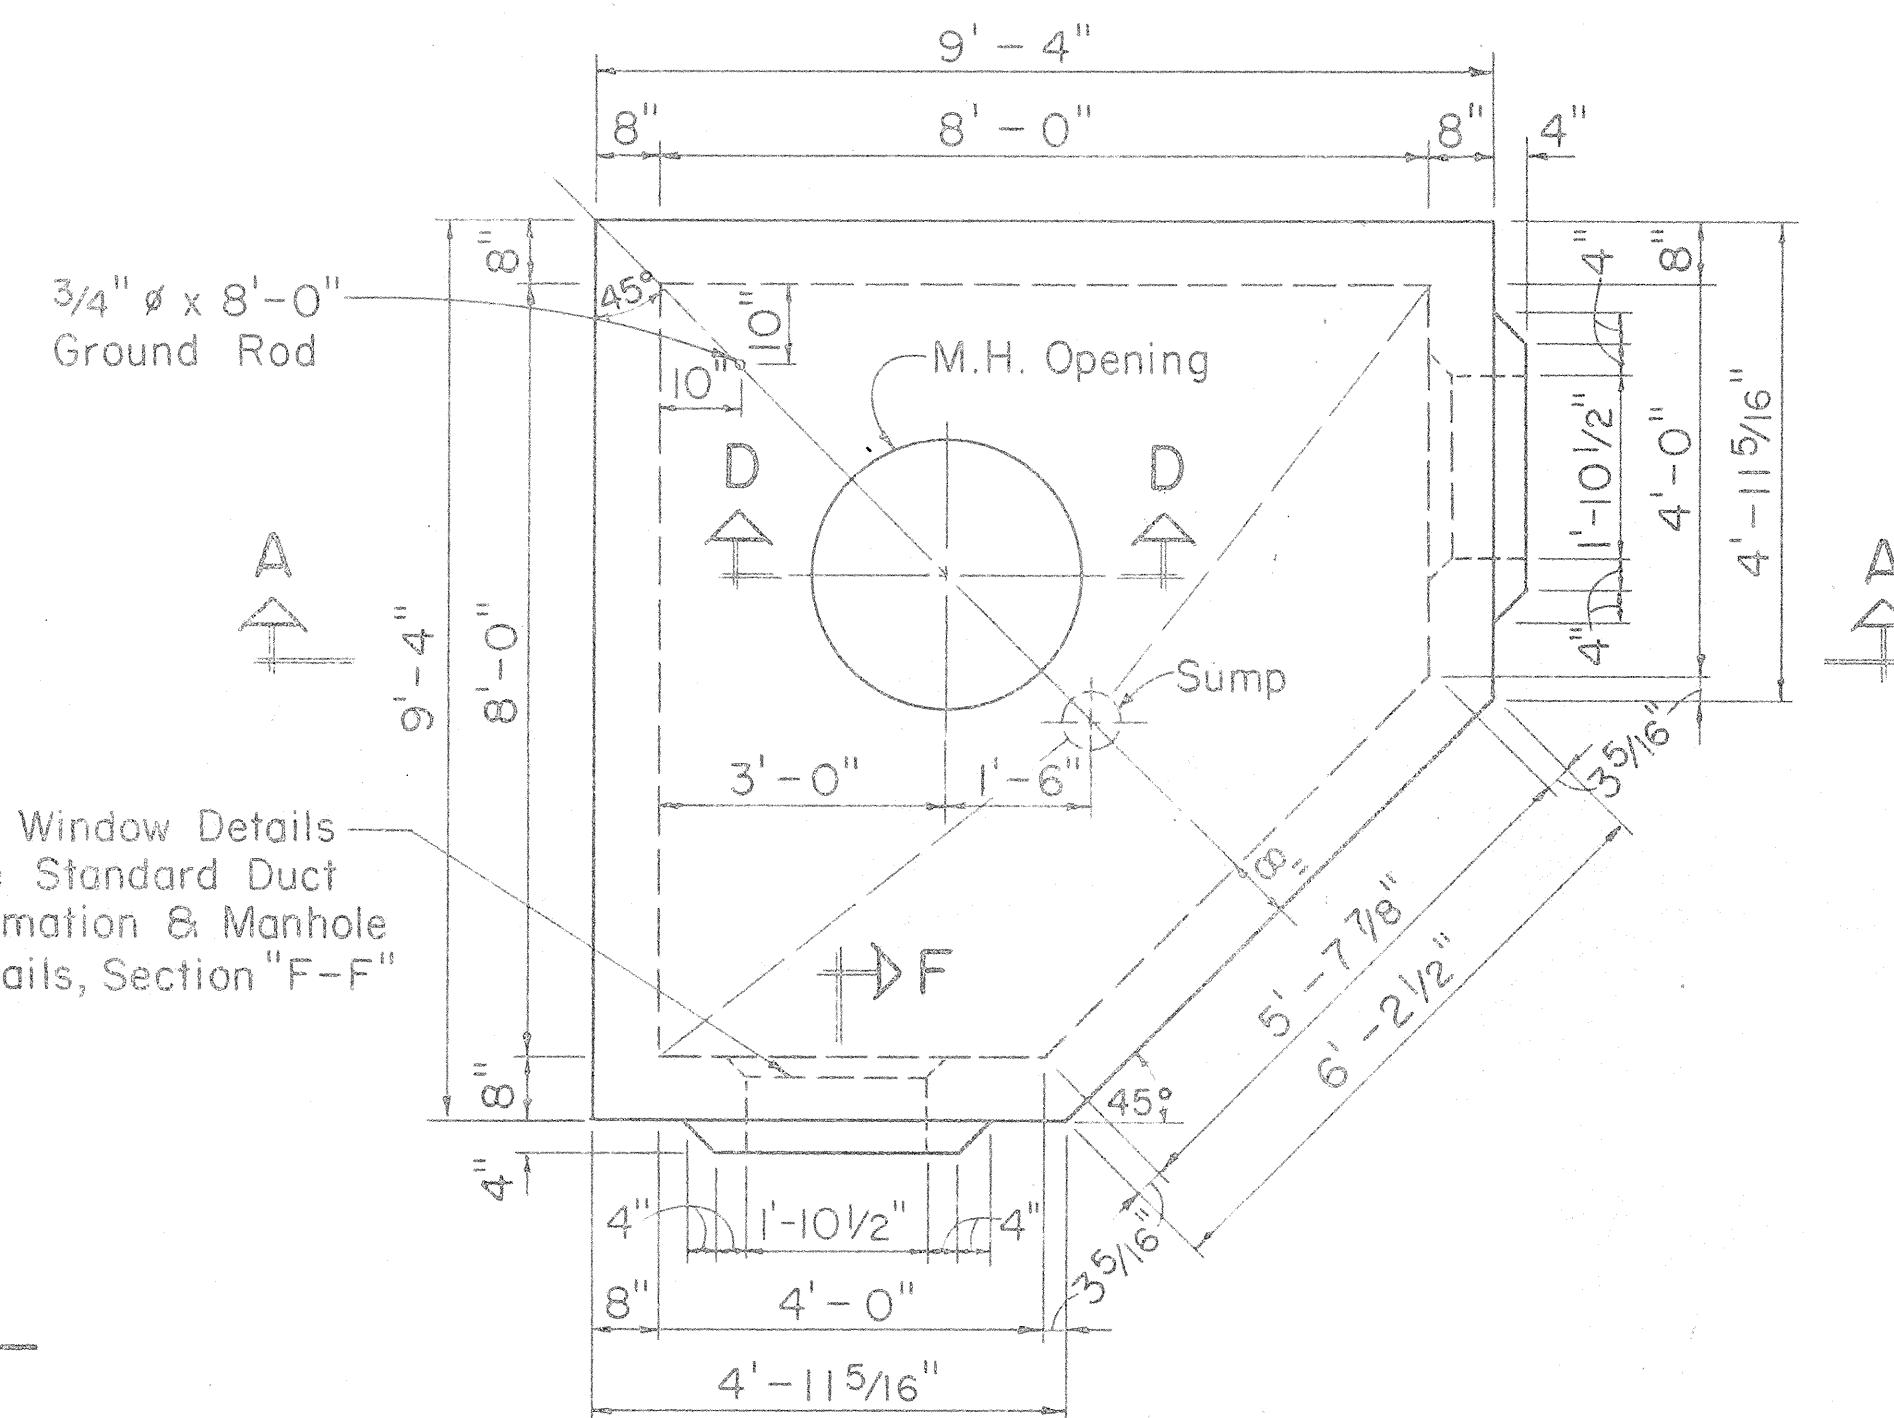


PLAN

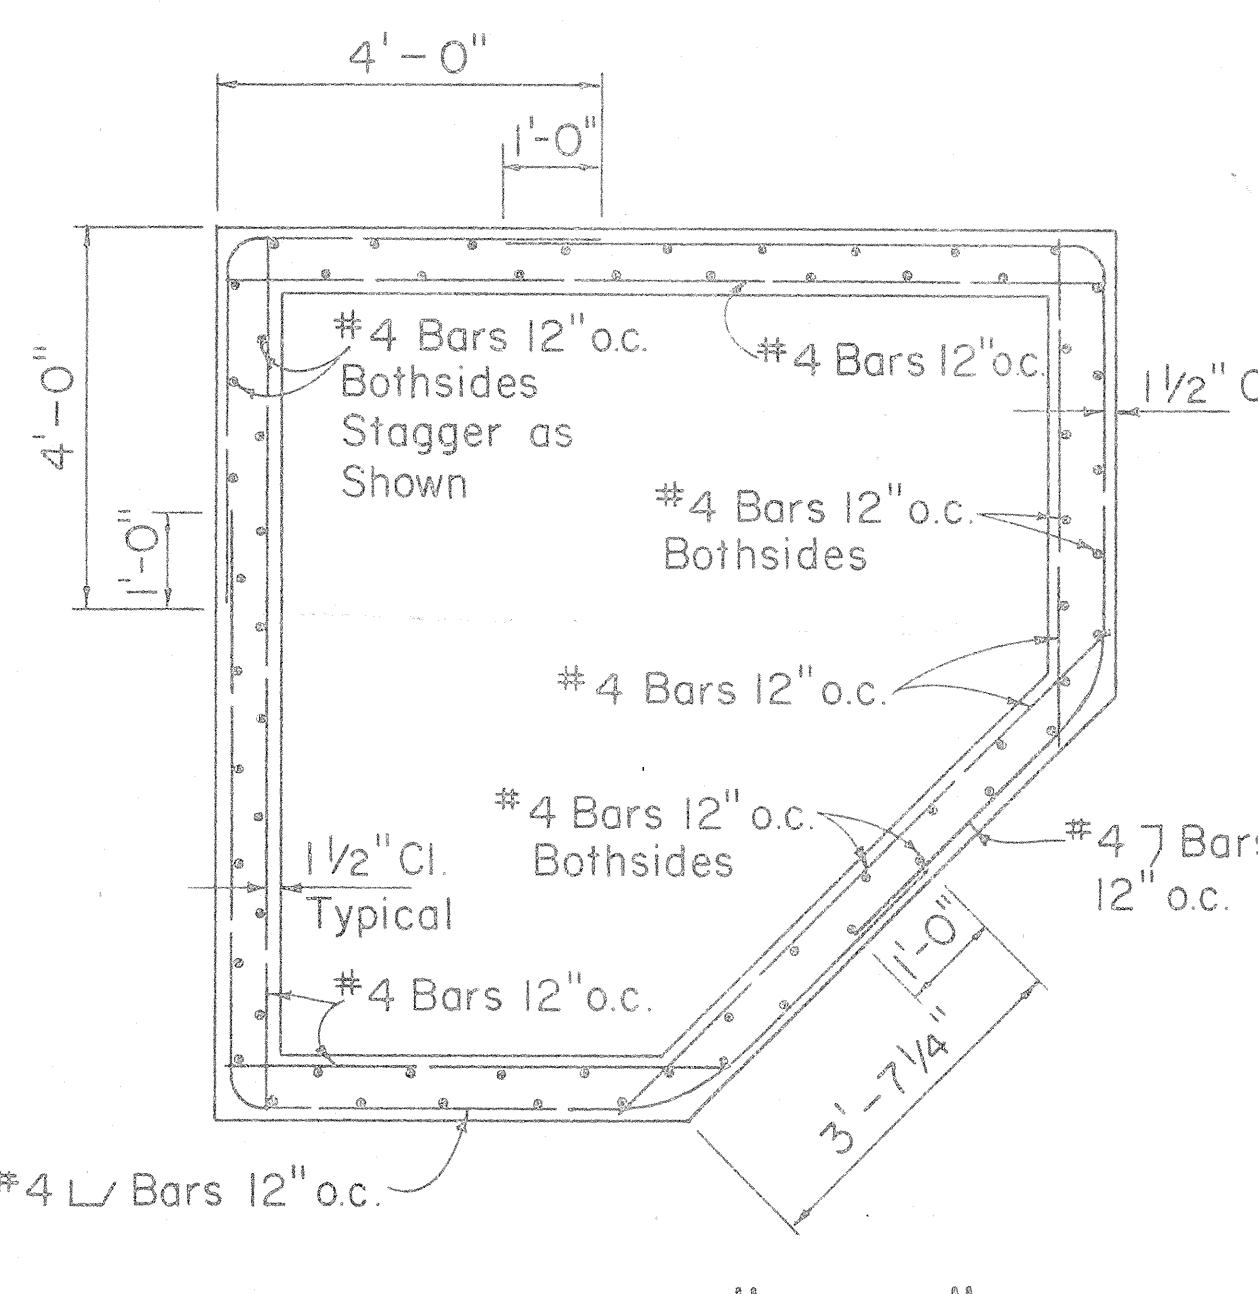

SECTION "B-B"

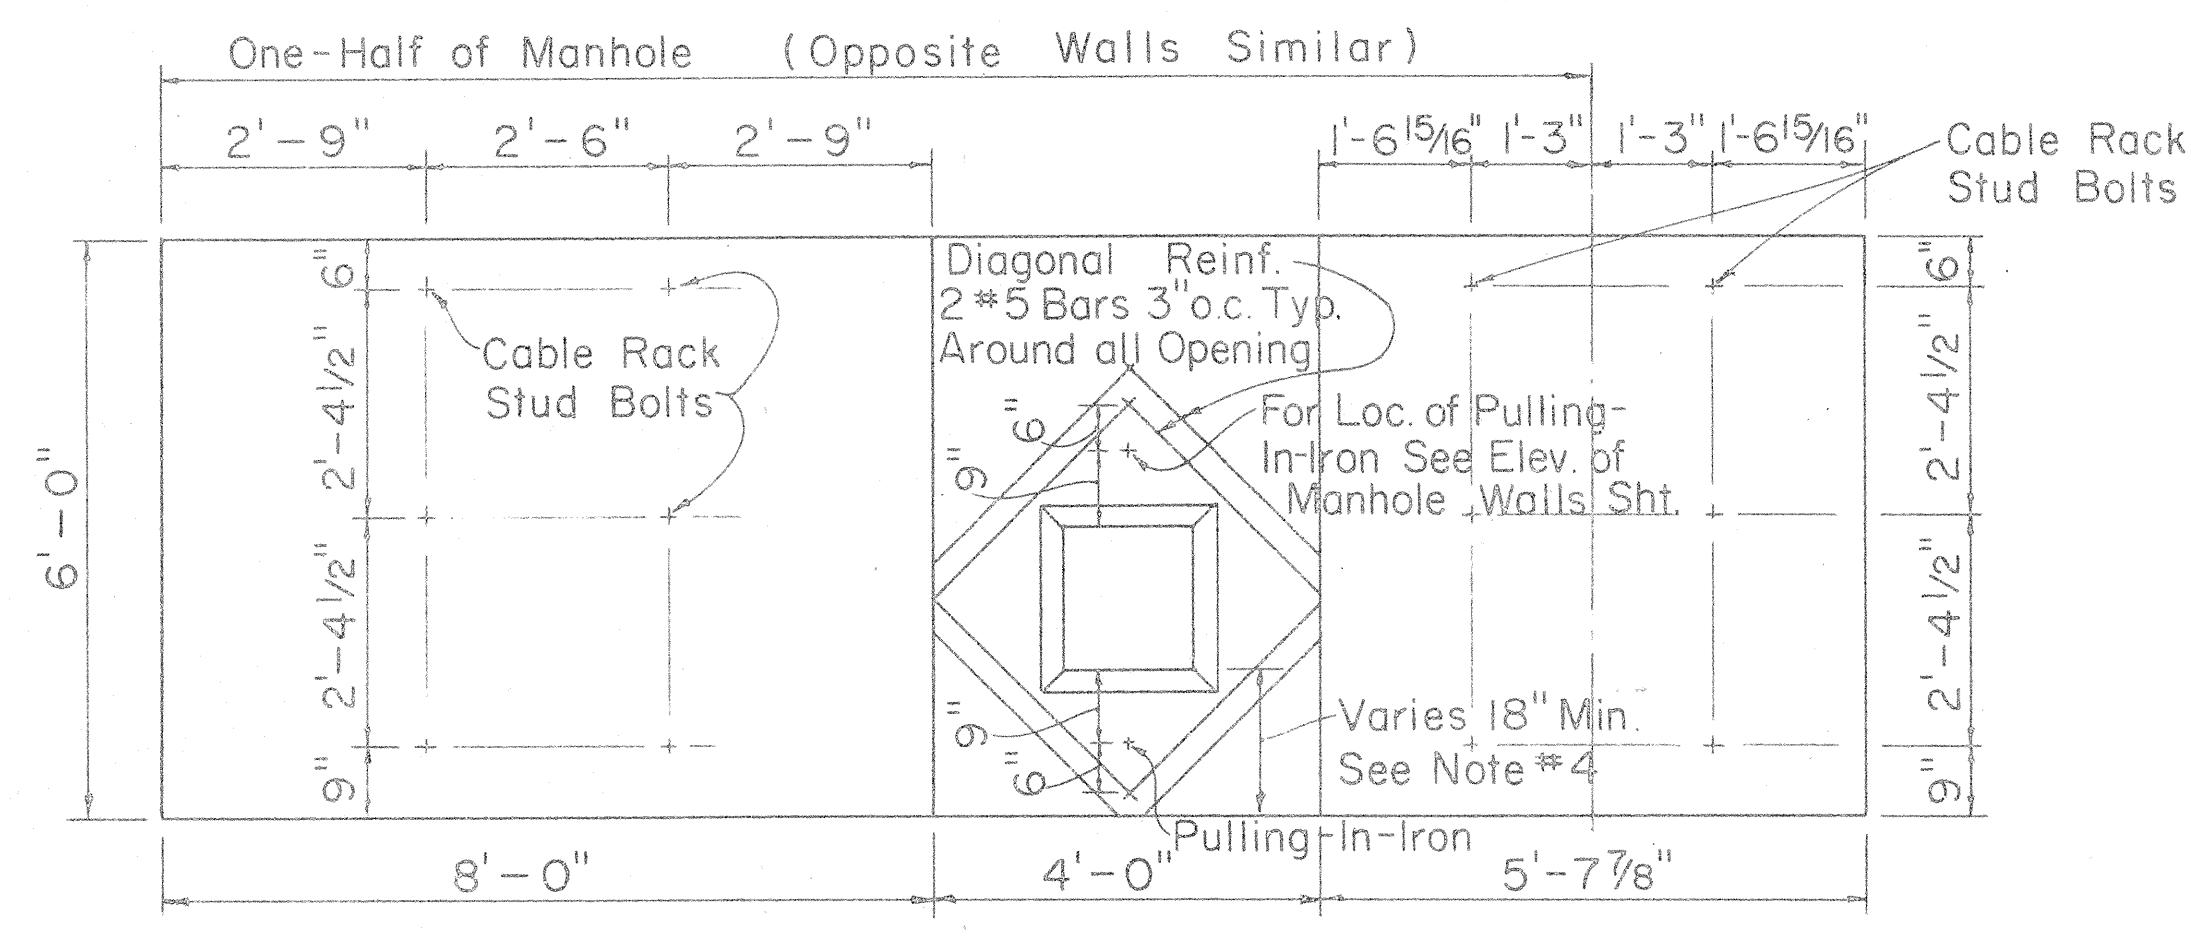


ELEVATION OF INSIDE WALLS

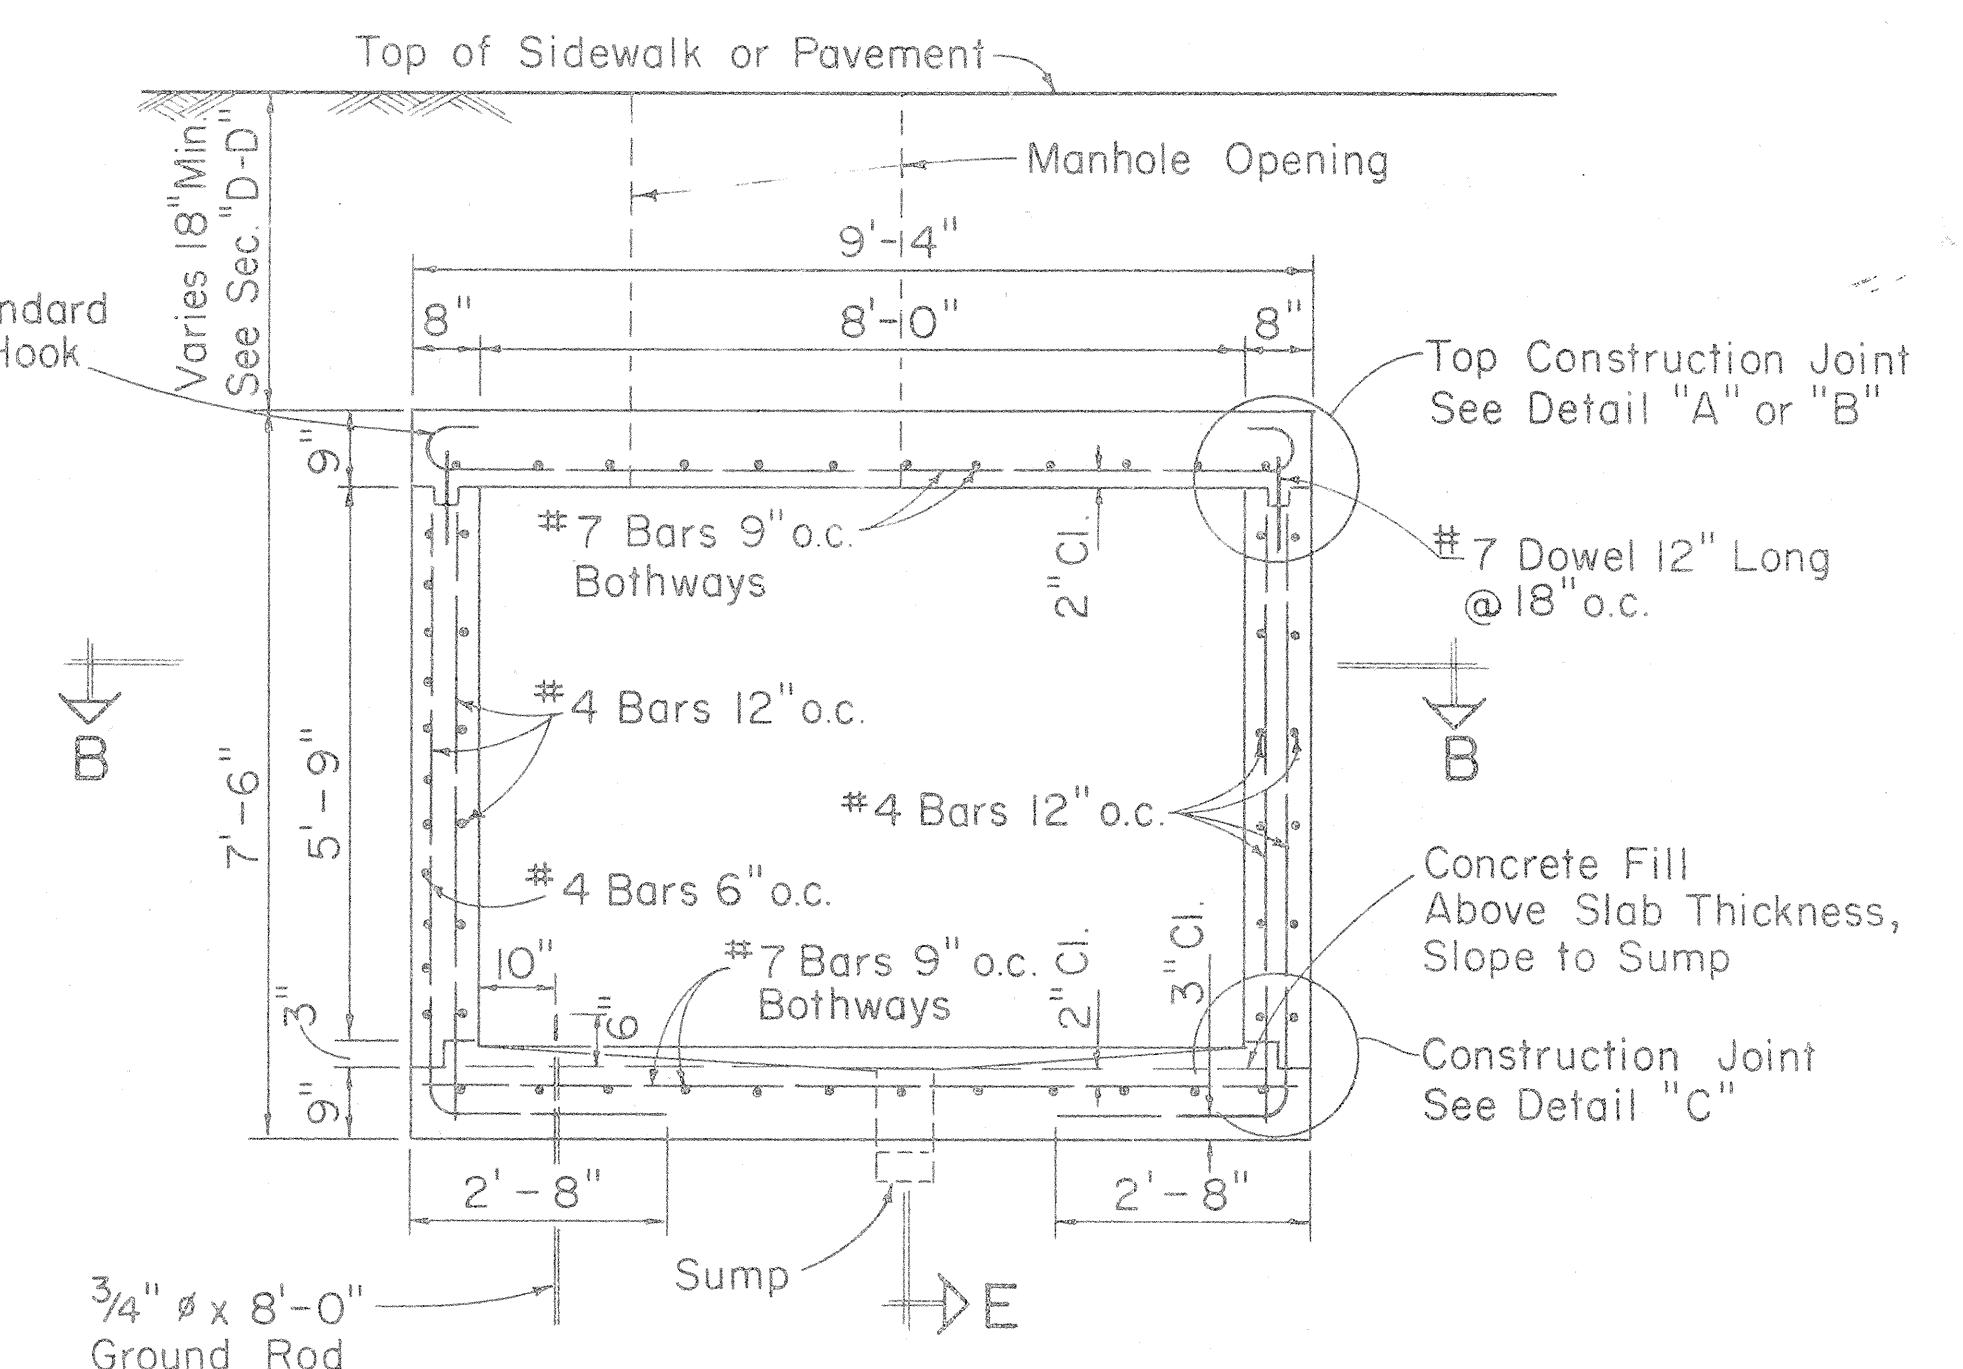

SECTION "A-A"

APPROVED:	<i>Yamada</i>	Date: 6/2/78
Hawaii Telephone Co., Ltd.		Date
H.T. Co., Ltd. Drawing No. 34030		
STATE OF HAWAII DEPARTMENT OF TRANSPORTATION LAND TRANSPORTATION FACILITIES DIVISION		
STANDARD CORNER SMALL TYPE MANHOLE		
Scale: 1/2" = 1'-0" Date:		
SHEET NO. 117A OF SHEETS		


FED. ROAD DIST. NO.	STATE	FED. AID PROJ. NO.	FISCAL YEAR	SHEET NO.	TOTAL SHEETS
HAWAII	HAW.	M-7600(1)	1978	118	198

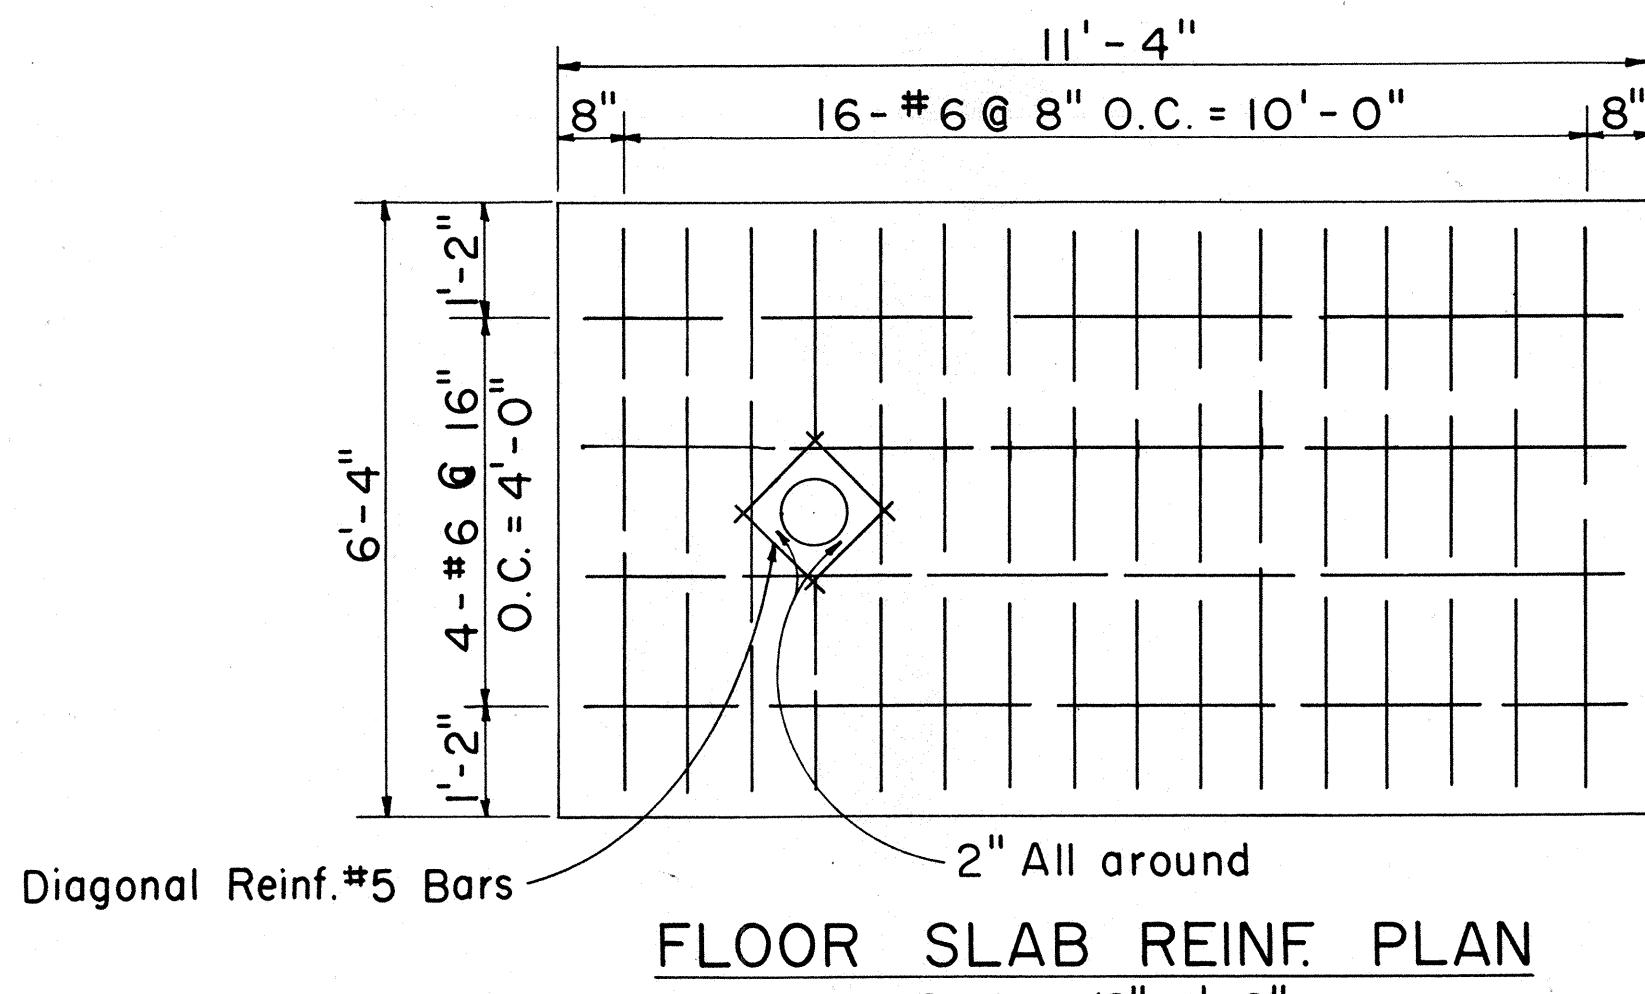

FLOOR SLAB REINF. PLAN


Scale: 1/2" = 1'-0"

4 "L" Bars @ 20" O.C.
Spaced in between Straight
Bars or "U" Bars _____

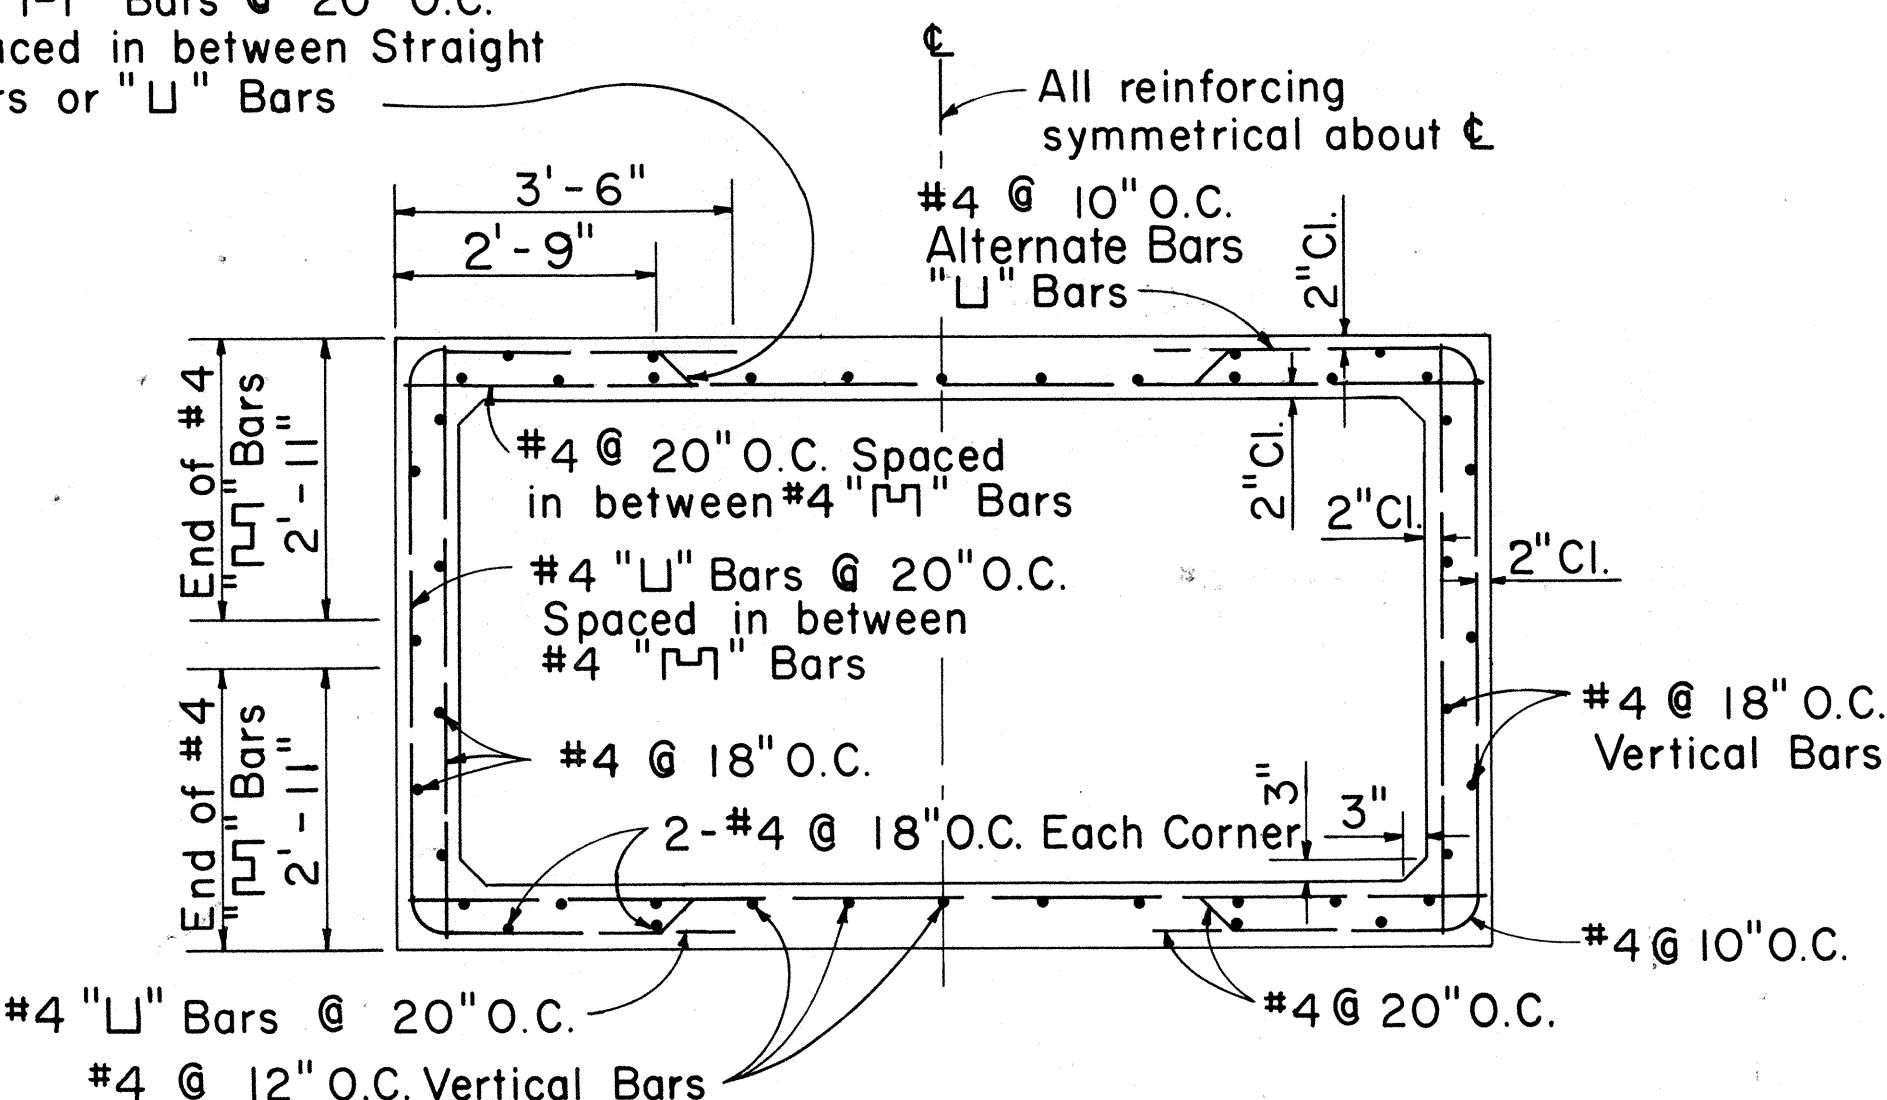


SECTION "C-C"

Scale: 1/2" = 1'-0"

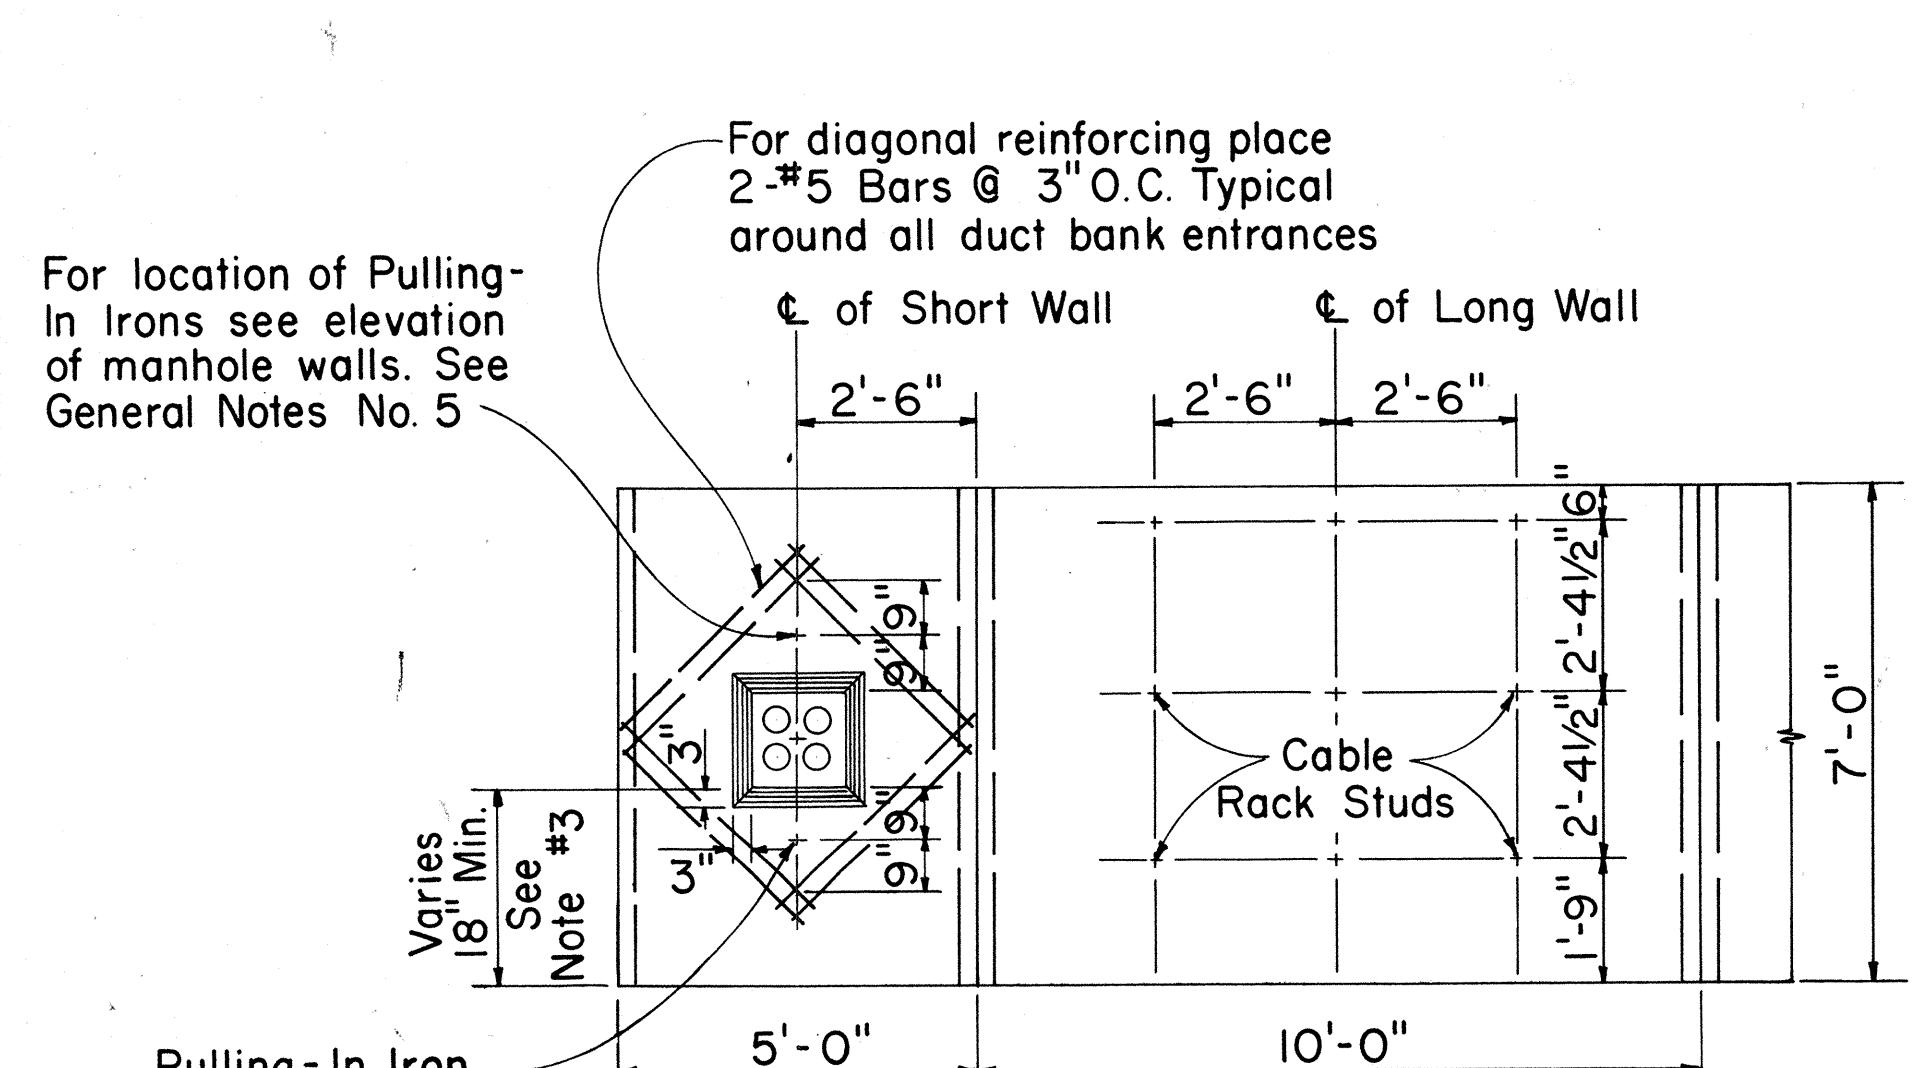


ELEVATION OF M.H. WALLS - TYPE "A-3" SERIES
(OPPOSITE FACES SIMILAR)

Scale: $3/8" = 1' = 0"$

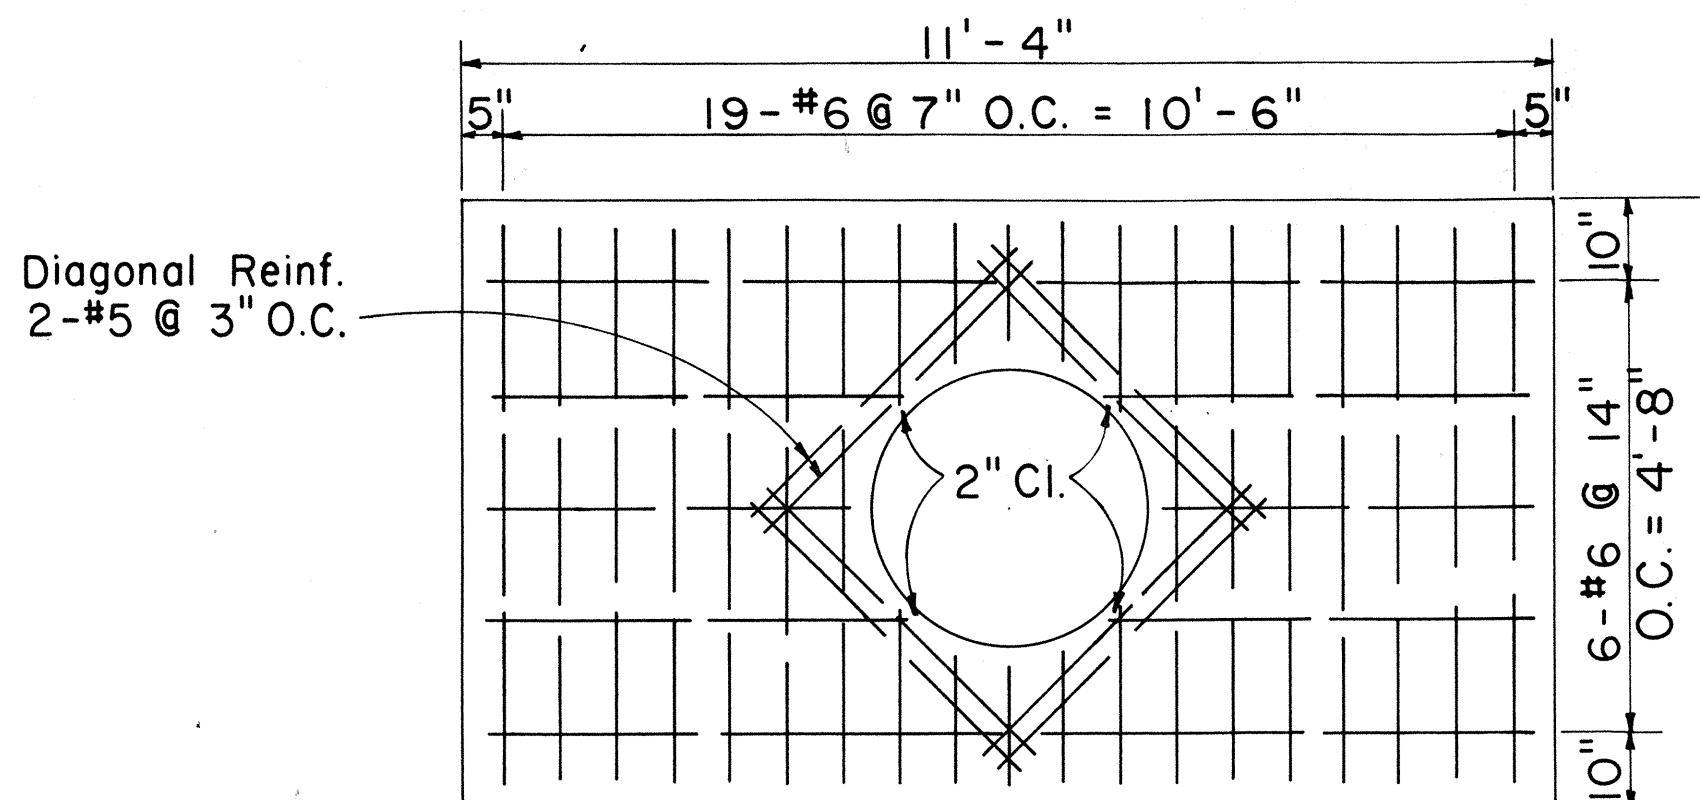

ROOF SLAB REINF. PLAN

Scale: $\sqrt{2}'' = 1'-0''$

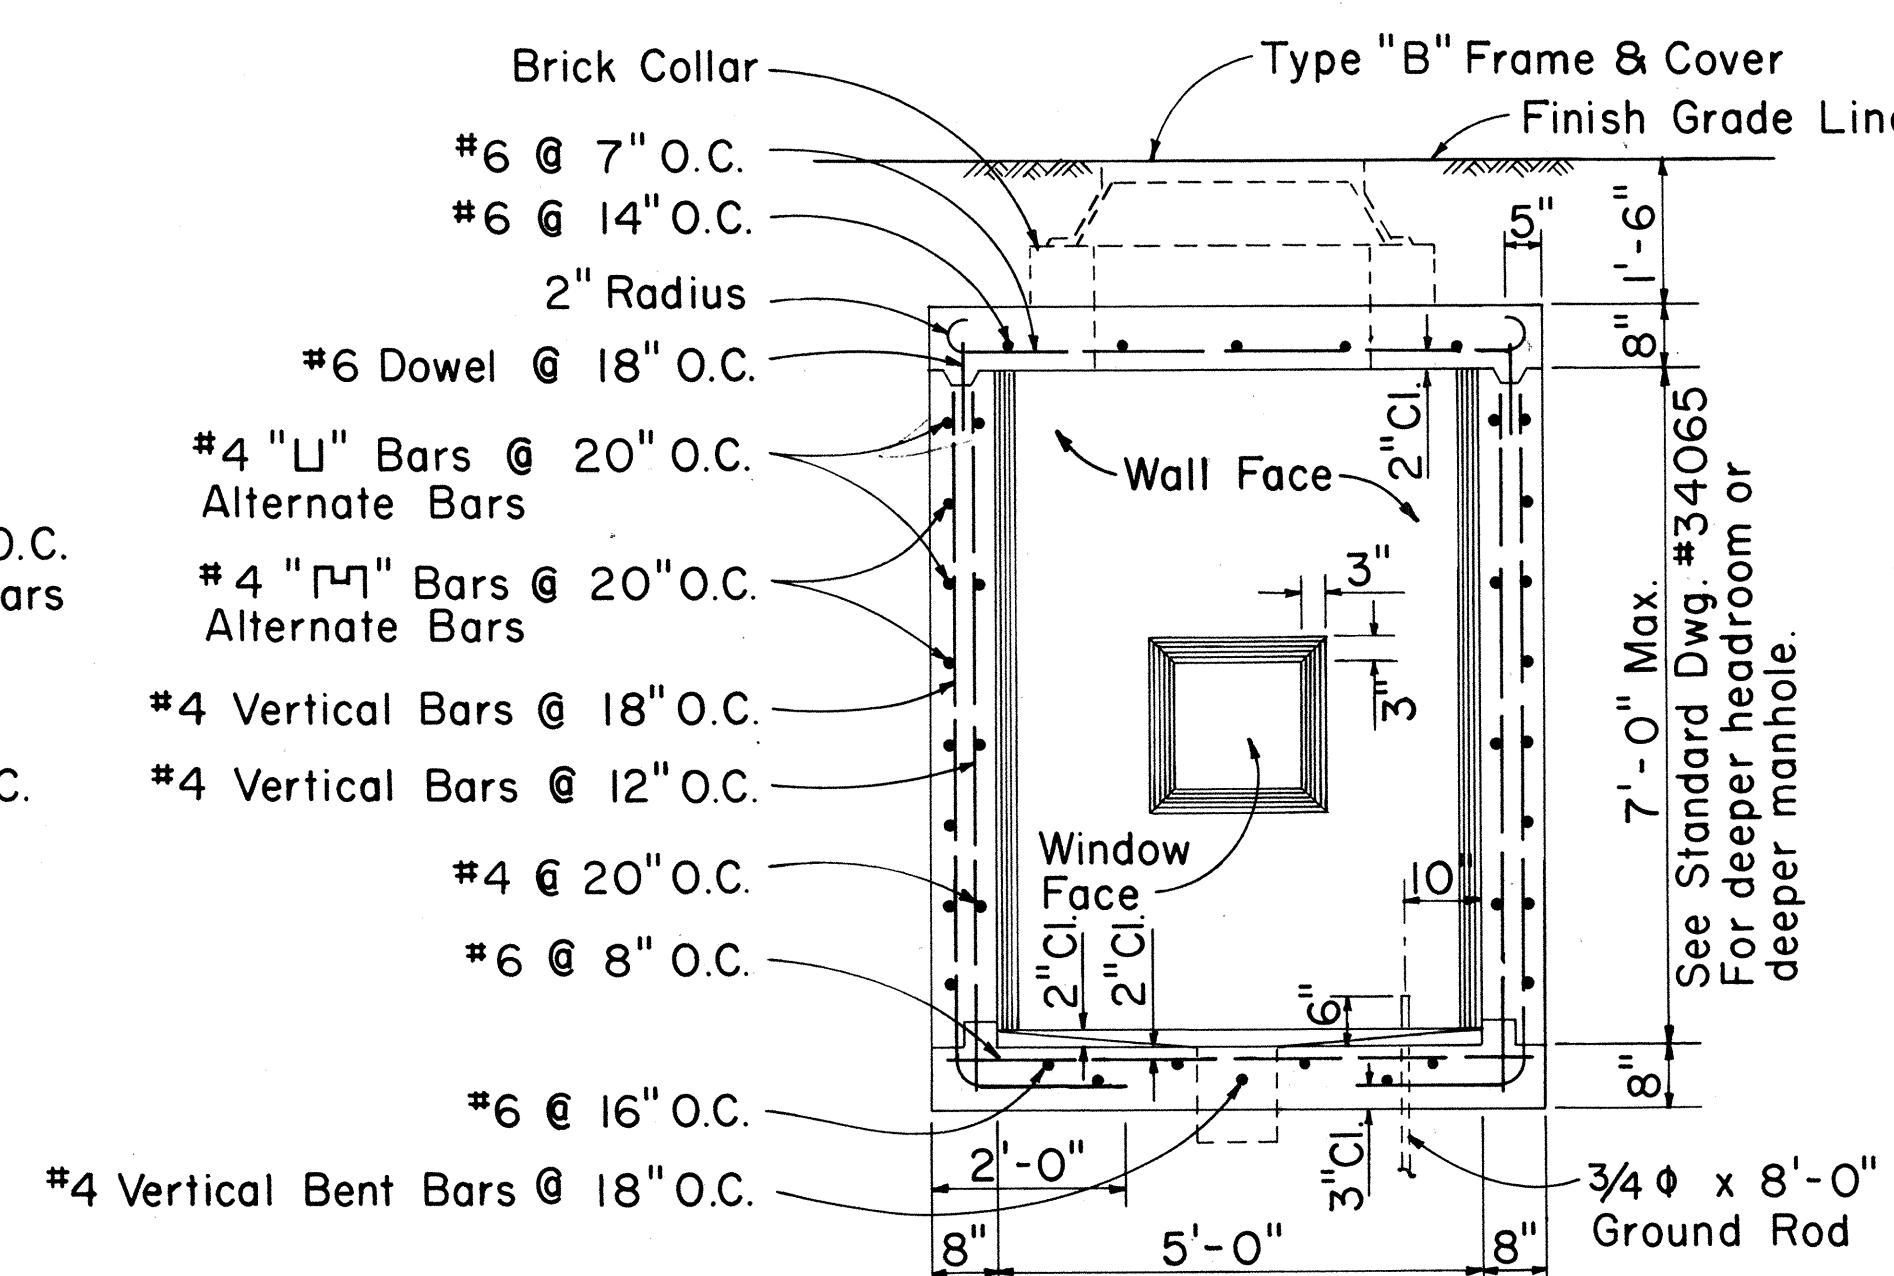


SECTION "B-B"


Scale: $1/2'' = 1' - 0''$

GENERAL NOTES:

- I. Design Data:
 $f_s = 20,000 \text{ psi}$; $f_c' = 3,000 \text{ psi}$; $f_c = 1,350 \text{ psi}$; $n = 10$
 $w = \text{Equivalent Fluid Pressure: } 30\#/\text{ft}^2$
 2. All Construction Joints shall be waterproofed with two applications of Thoro Seal or equal.
 3. For Duct Window location see Plan Profile Sheets for Elevations.
 4. Duct Window to suit - See Plan & Profile & Standard Detail Sheets for Location & Details.
 5. For Details "A", "B", "C", Sections "D-D", "E-E", "F-F" and other miscellaneous Manhole Construction Details see Supplement Sheet to Type "A-1", "A-2" and "A-3" Telephone Manholes

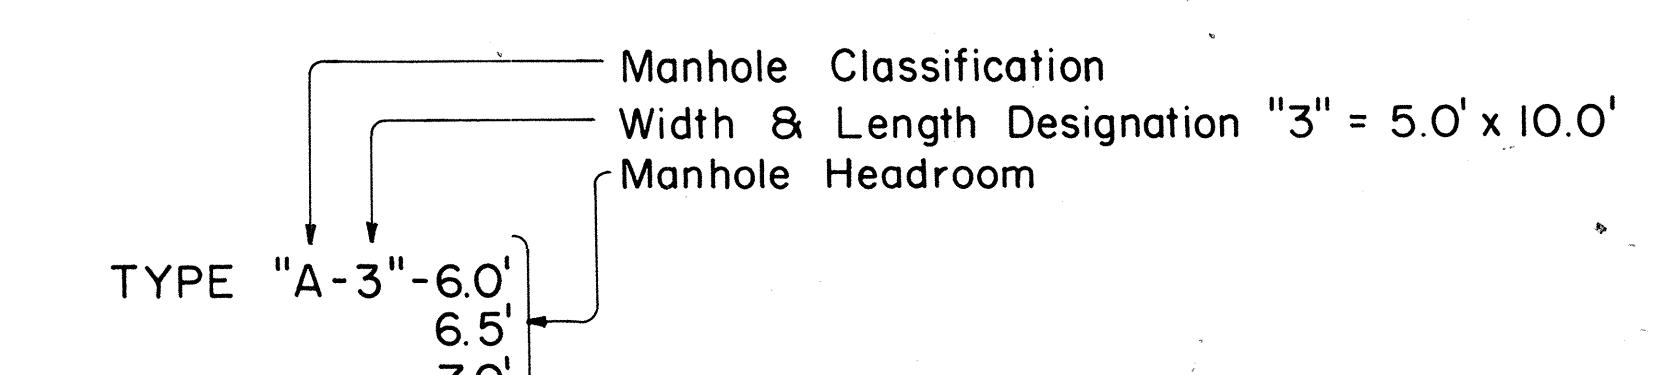


- Manhole Classification
- Width & Length Designation "3" = 5.0' x 10'
- Manhole Headroom

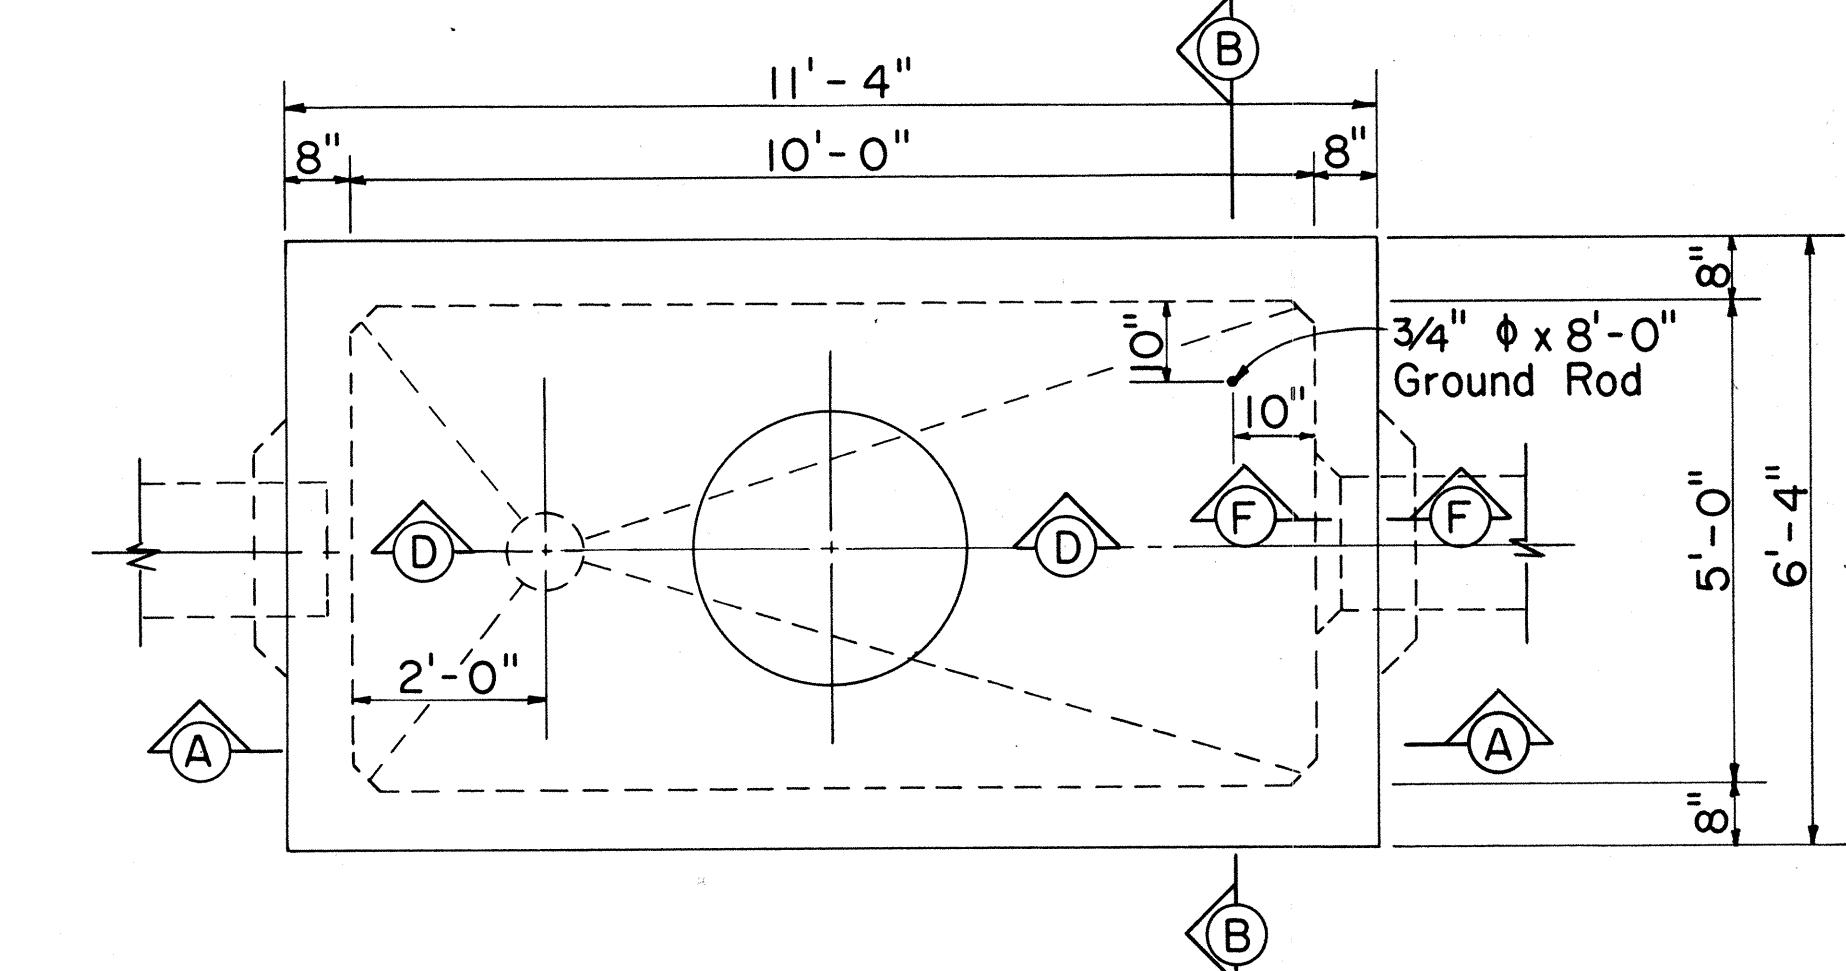

PLAN - M.H. TYPE "A-3" SERIES
FOR ROADWAY & SIDEWALK AREAS

Scale: 1/2" = 1'-0"

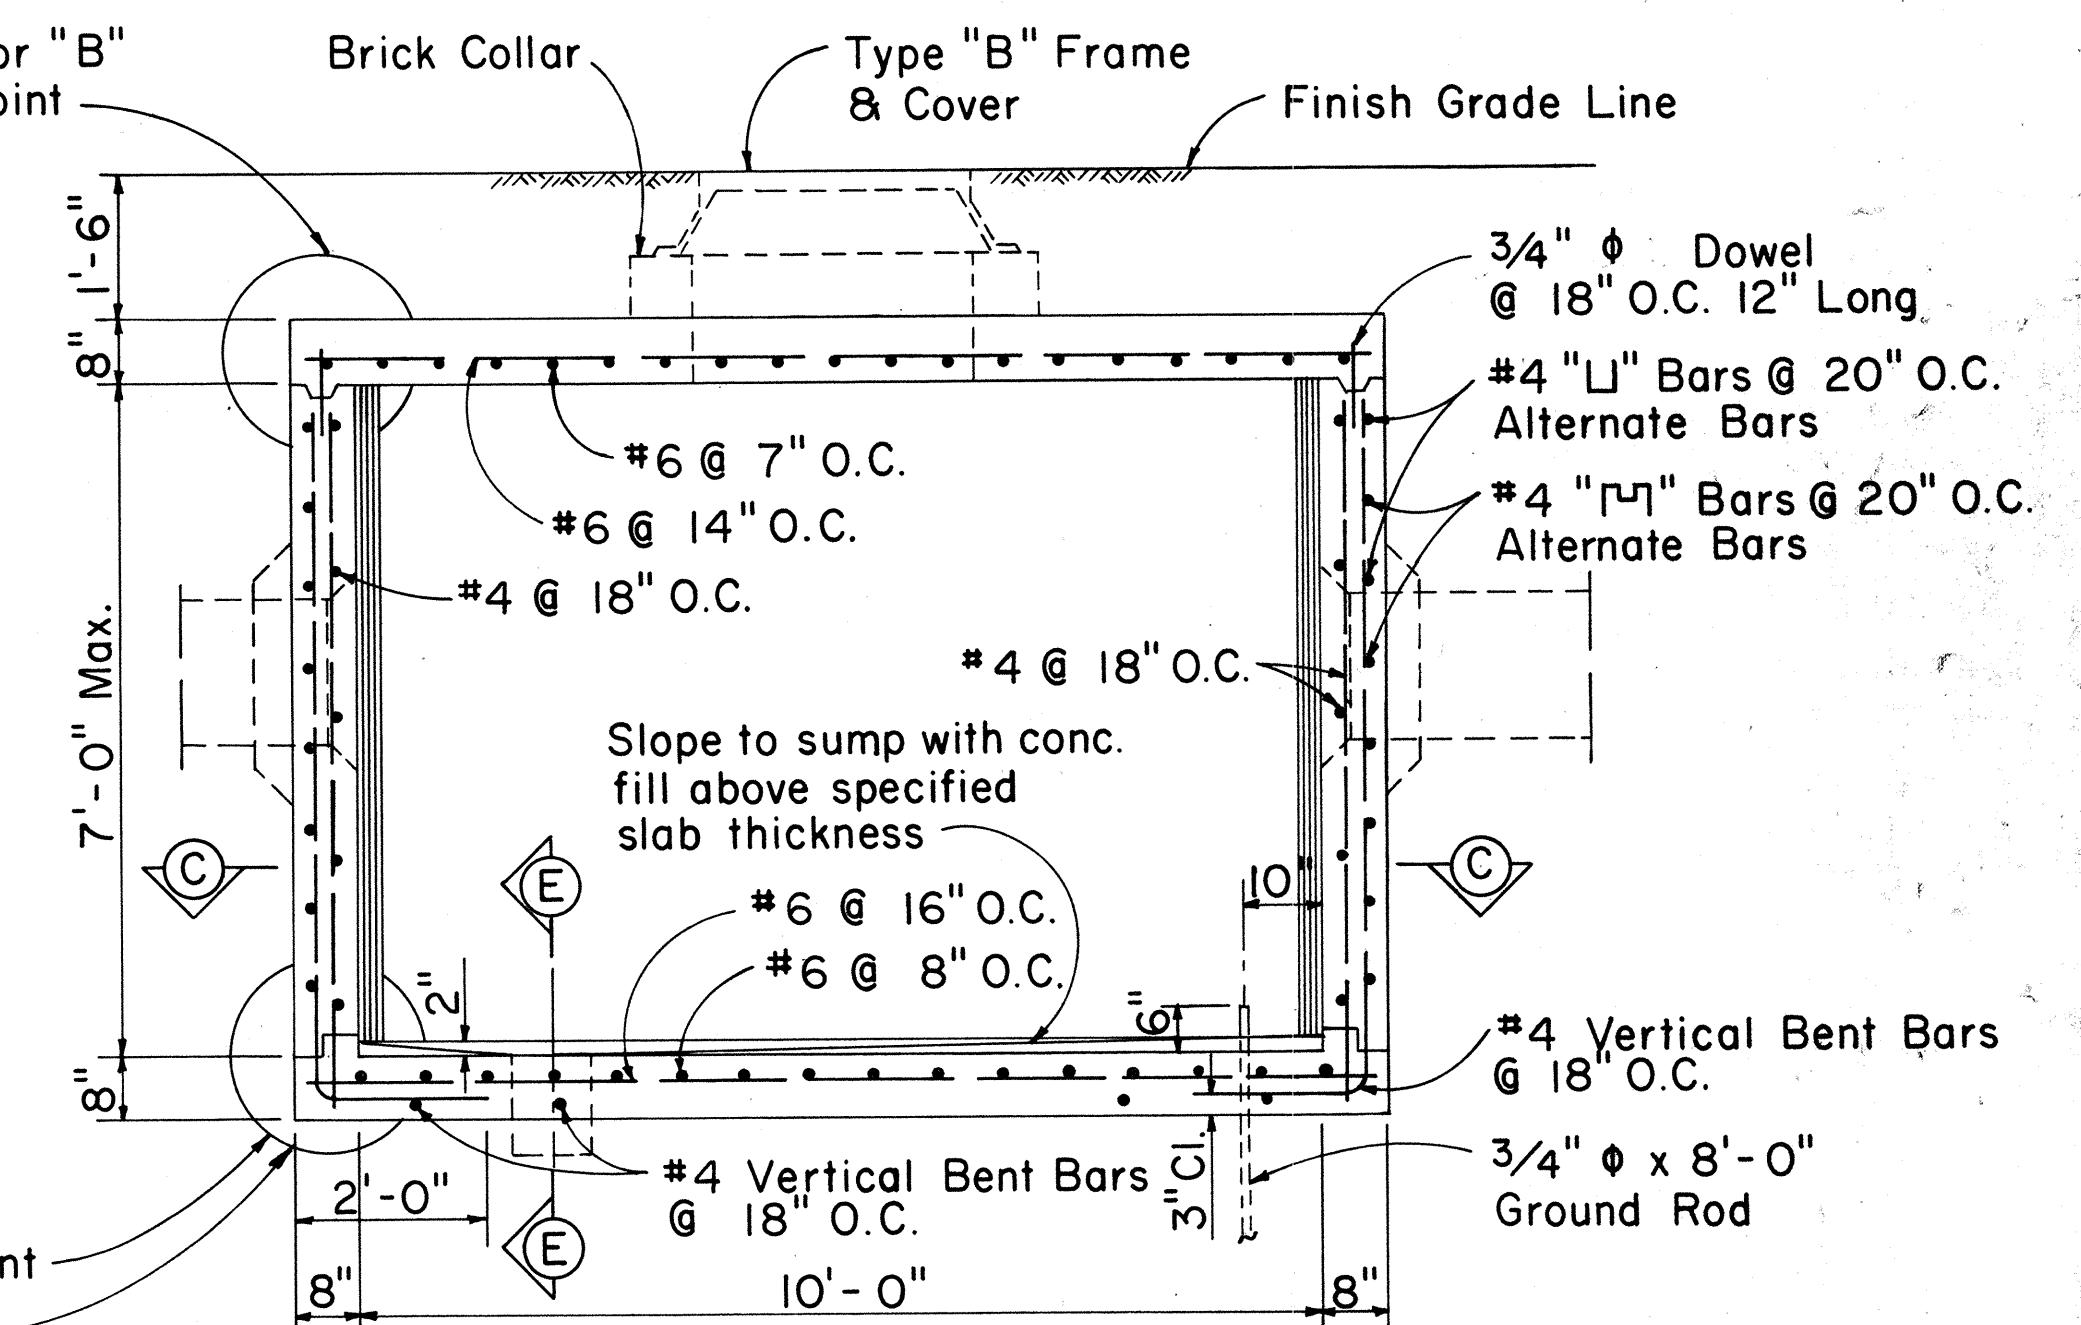


SECTION "A-A"

Scale: 1/2" = 1'-0"


APPROVED:	
<i>G Yamada</i>	
Hawaiian Telephone Co., Ltd.	Date <i>6/26/78</i>
H.T. Co., Ltd.	Drawing No. 34064
STATE OF HAWAII DEPARTMENT OF TRANSPORTATION LAND TRANSPORTATION FACILITIES DIVISION	
<u>TYPE "A-3" MANHOLES</u> <u>FOR 6.0' TO 7.0'</u> <u>HEADROOM</u>	
Scale: As Noted	Date:
SHEET No. 55 OF 56 SHEETS	

ED. ROAD DIST. NO.	STATE	FED. AID PROJ. NO.	FISCAL YEAR	SHEET NO.	TOTAL SHEETS
HAWAII	HAW.	M-7600(1)	1978	119	198

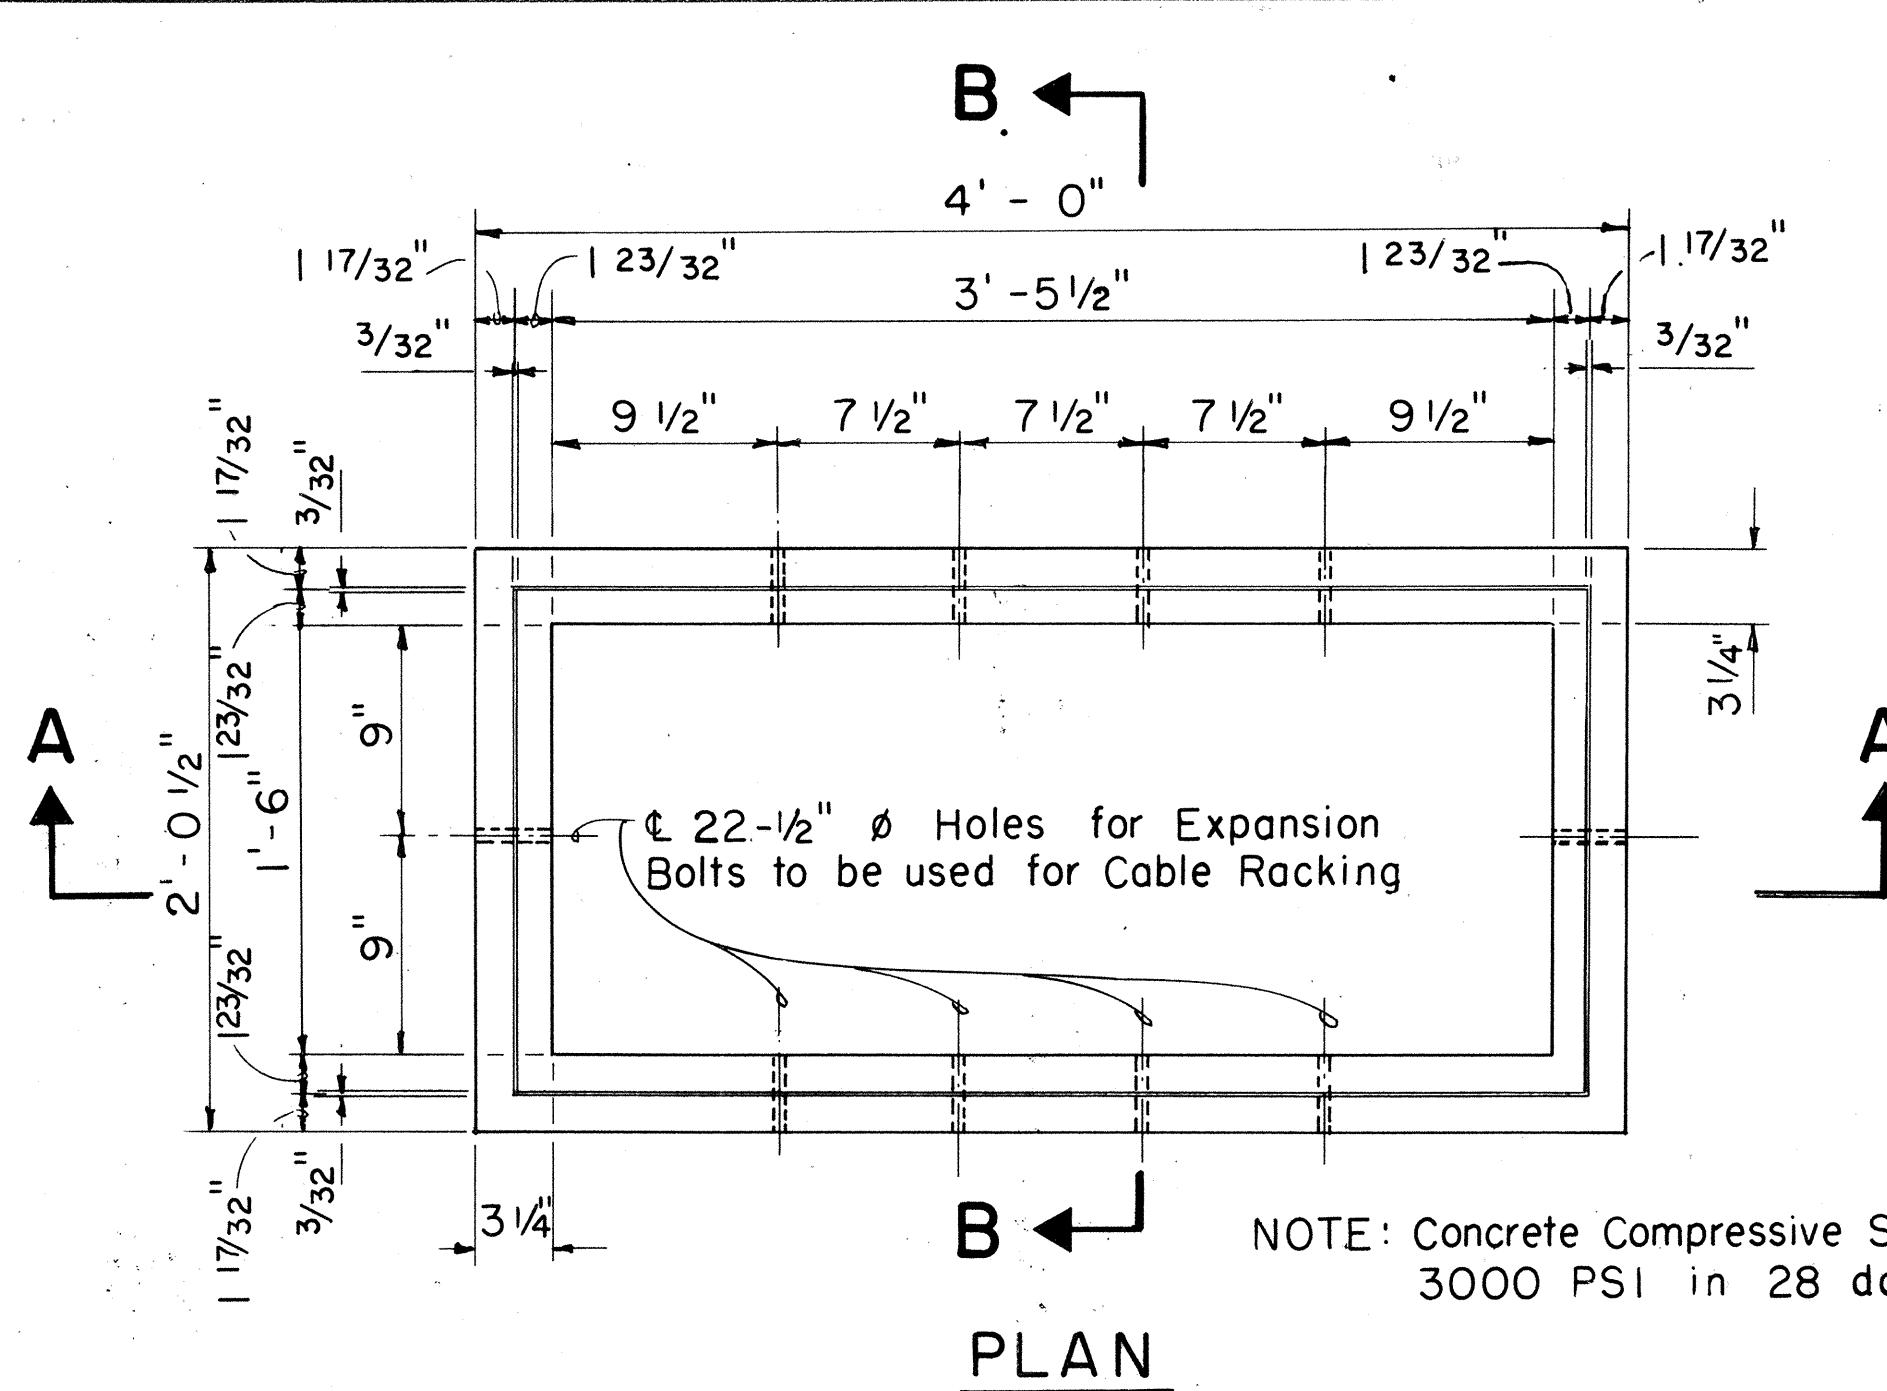


NOTE: Concrete Compressive Strength
3000 PSI in 28 days.

PLAN

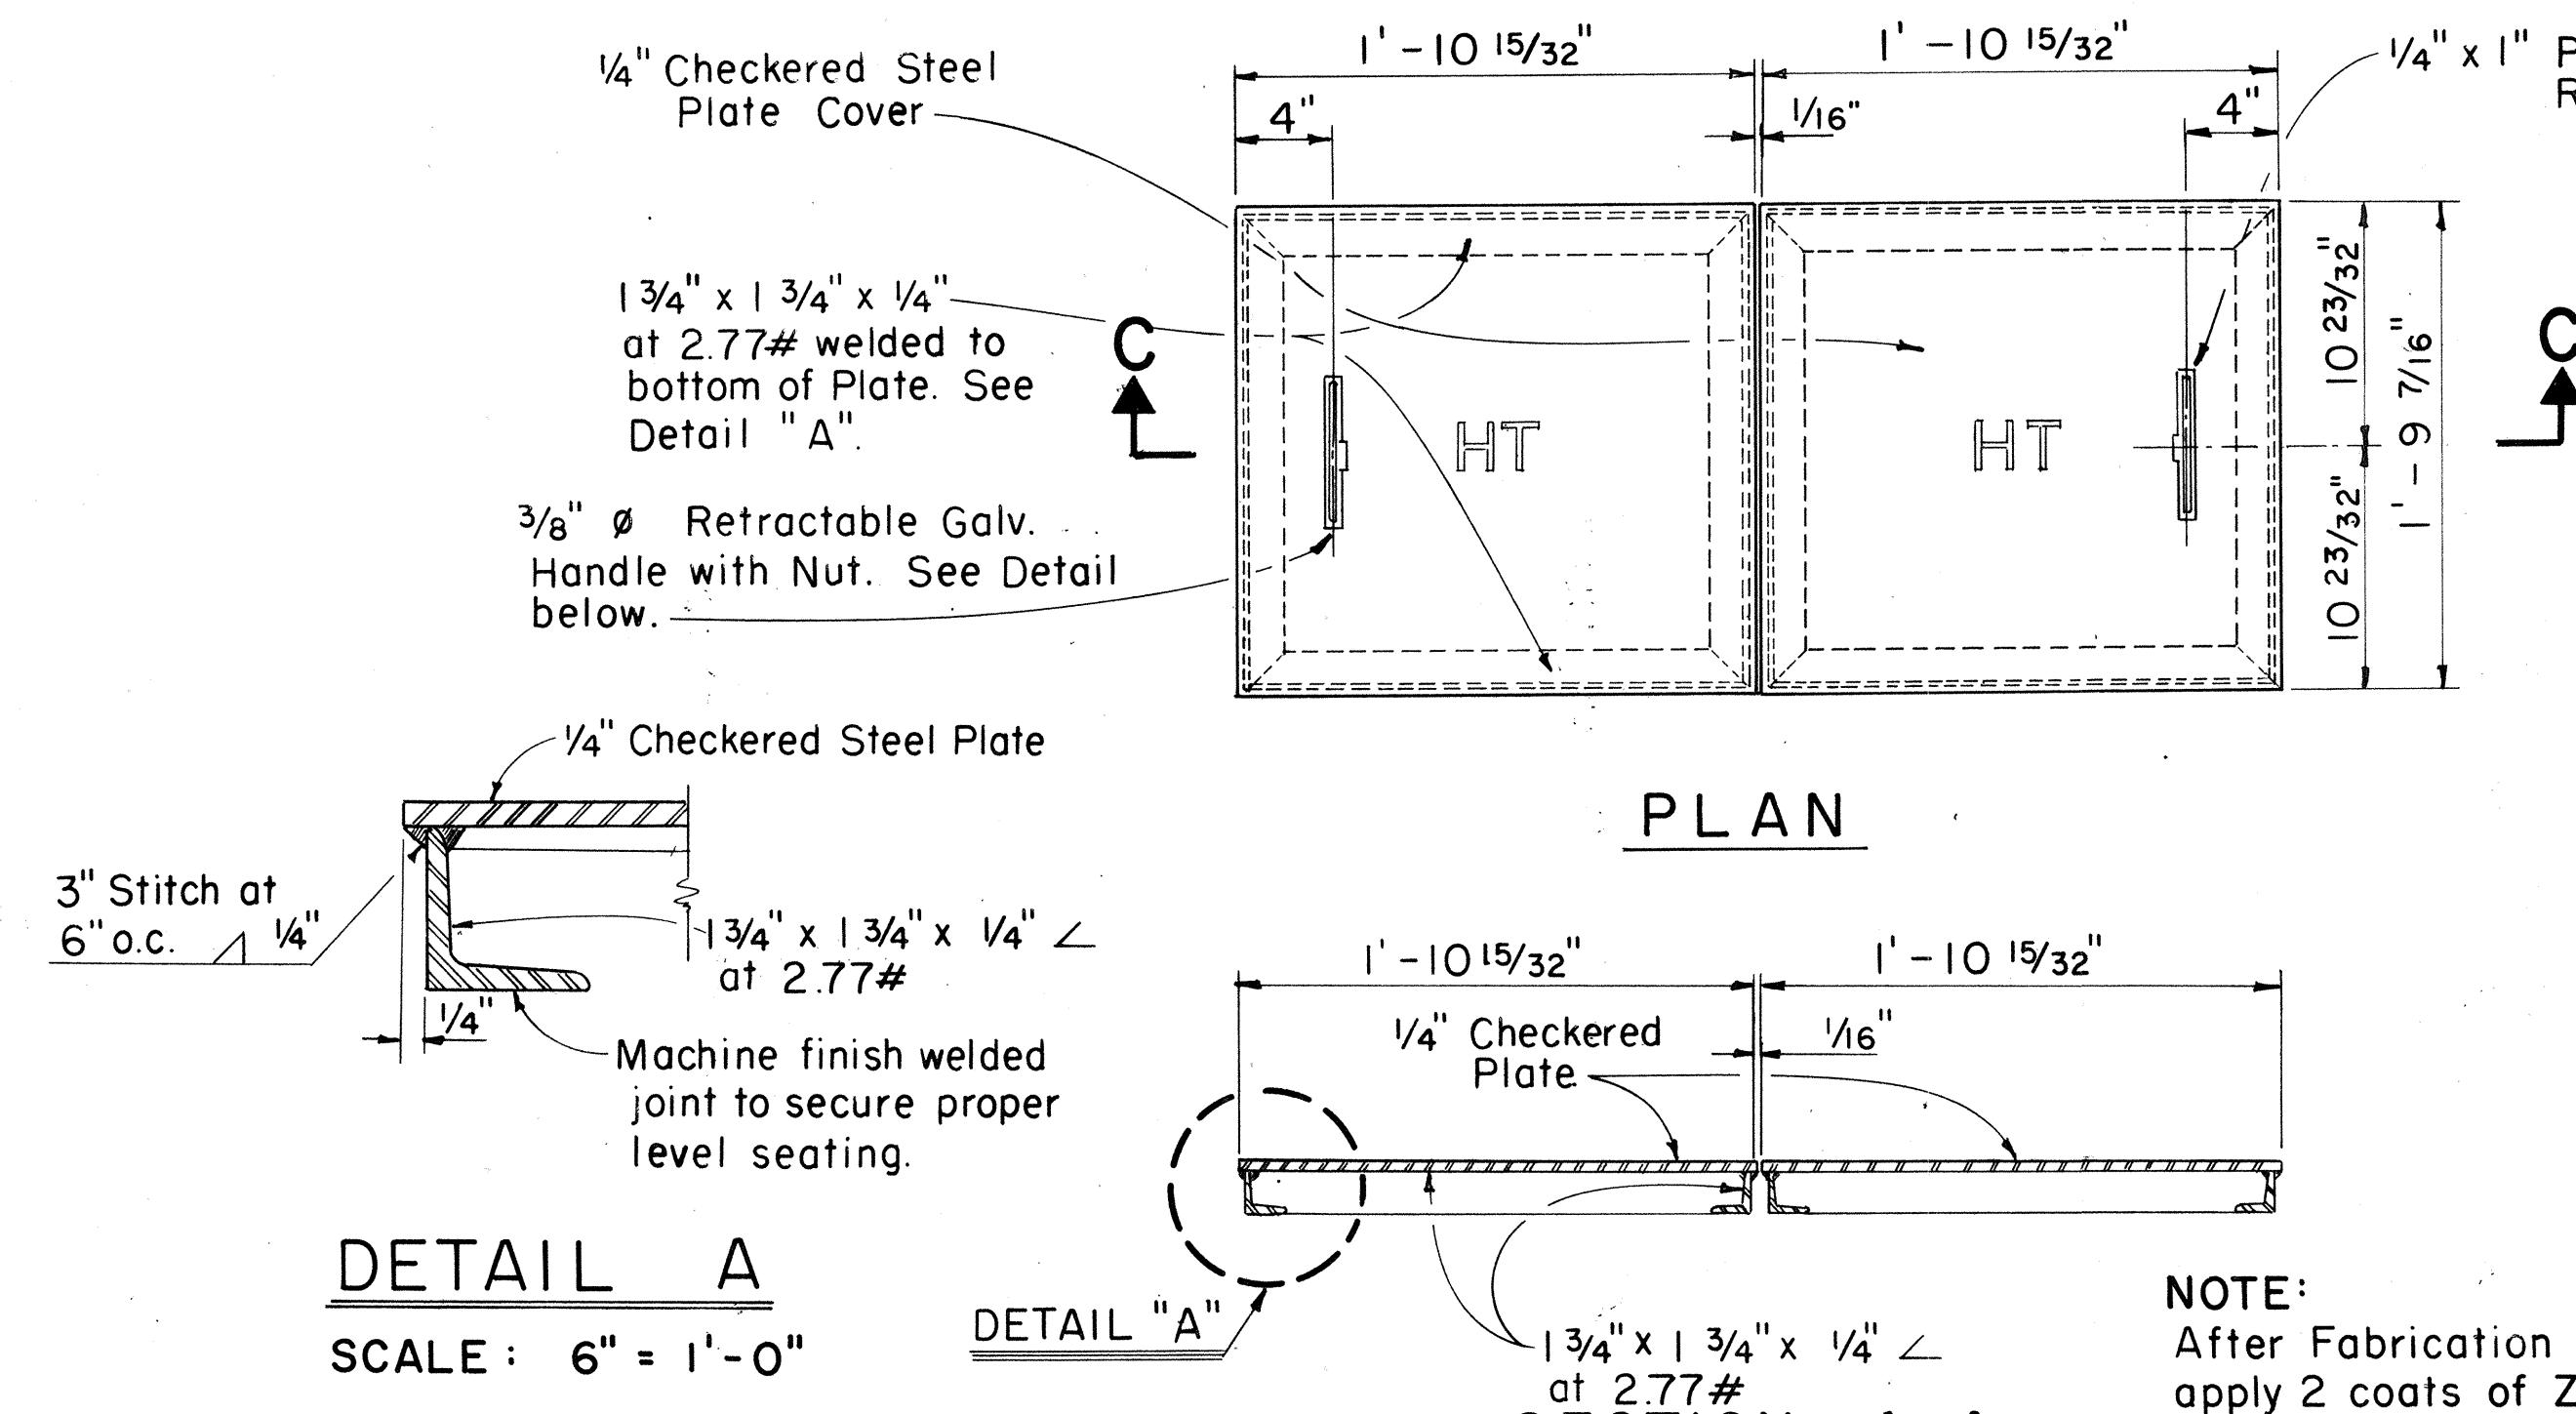

INSTALLATION NOTES:


- I. A minimum of Two(2) Precast Sections must be used on all installations.
 2. The minimum layers of Bricks to be used shall always be at least One (1) layer lower than the lowest Duct entering the Pullbox. At no time, however, shall there be less than Two (2) layers of Bricks on each installation.
 3. At no time shall Cement Mortar, Wood or any other material be used between Precast Sections. Leveling or raising of Boxes to grade must be done at Brickwork Section using Cement Mortar. The permanent installation of Wooden Wedges to accomplish this purpose will not be accepted.
 4. For 3-Cover P.B. join 435TB P.B. Half Section to Full Section using Strap and Bolts as shown in 3-Cover P.B. Section Plan.

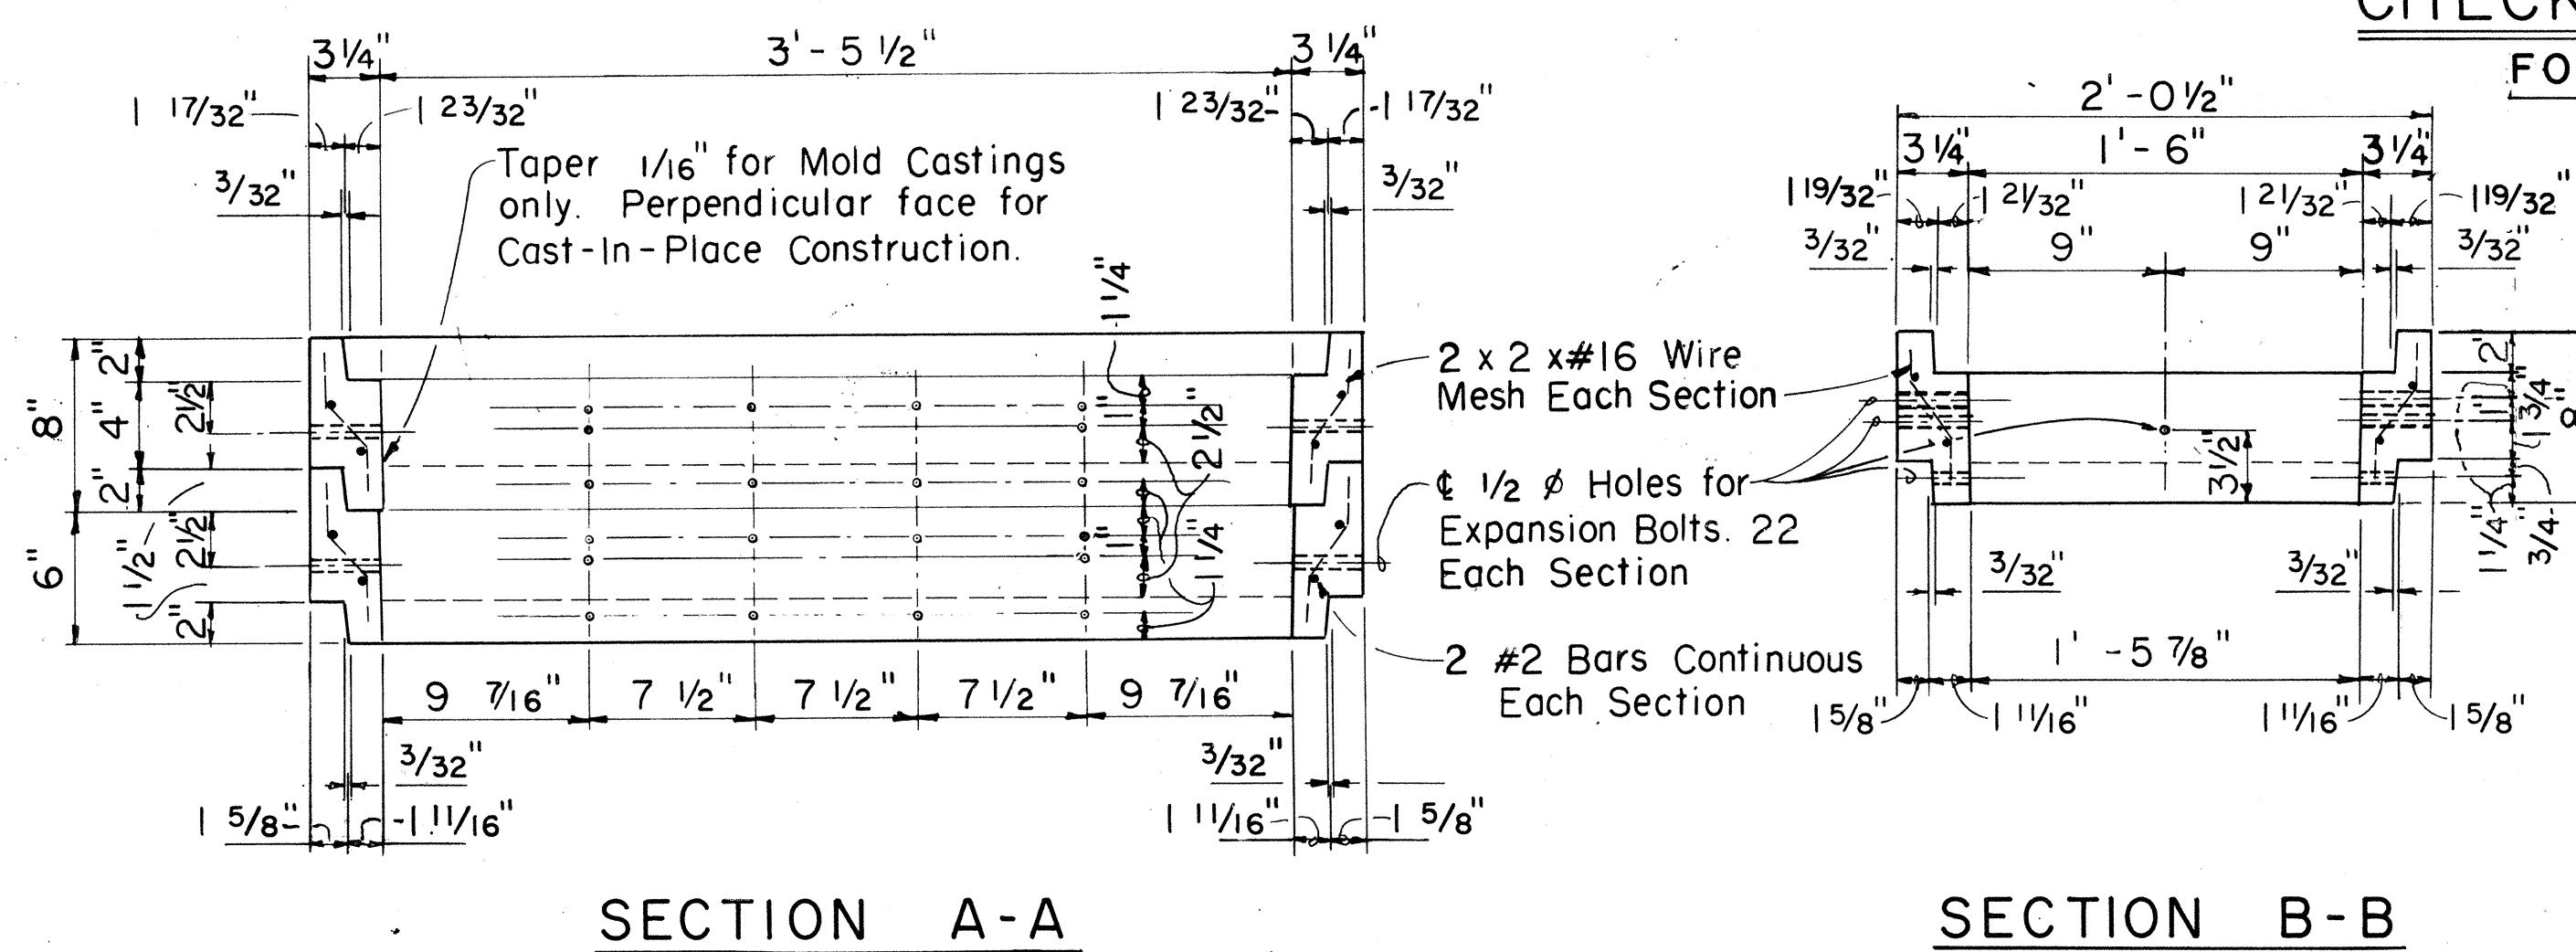

SECTION A-A

SECTION B-B

PULLBOX #435 T-B

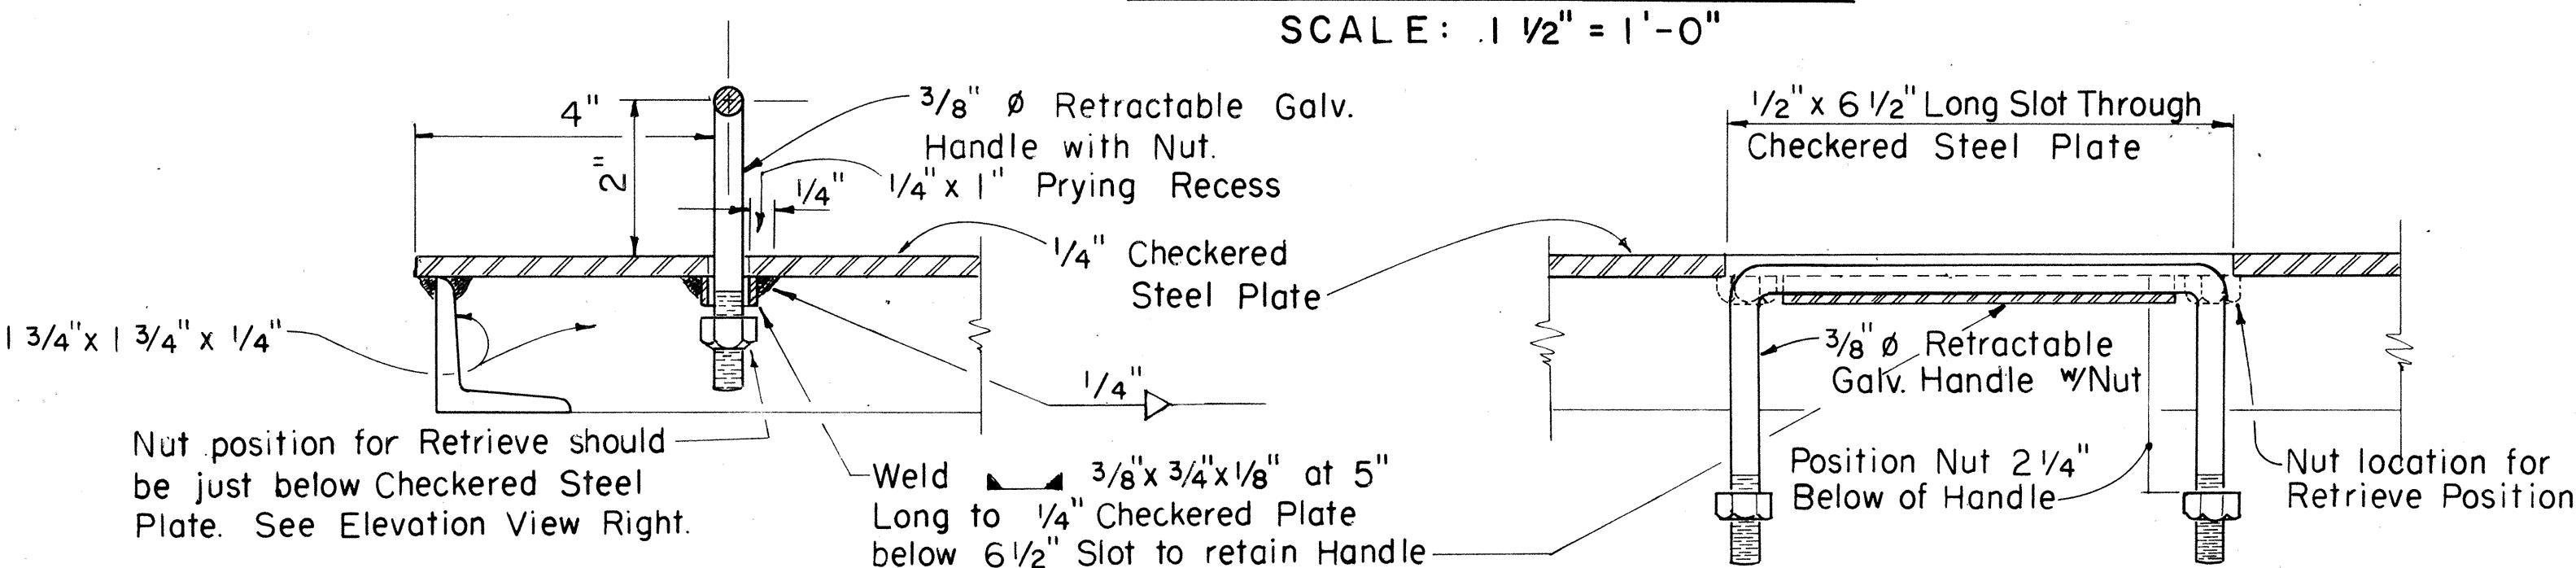


SECTION - RETRIEVE POSITION

ELEVATION - AT REST POSITION

RETRACTABLE HANDLE

SCALE: 6" = 1'-0"

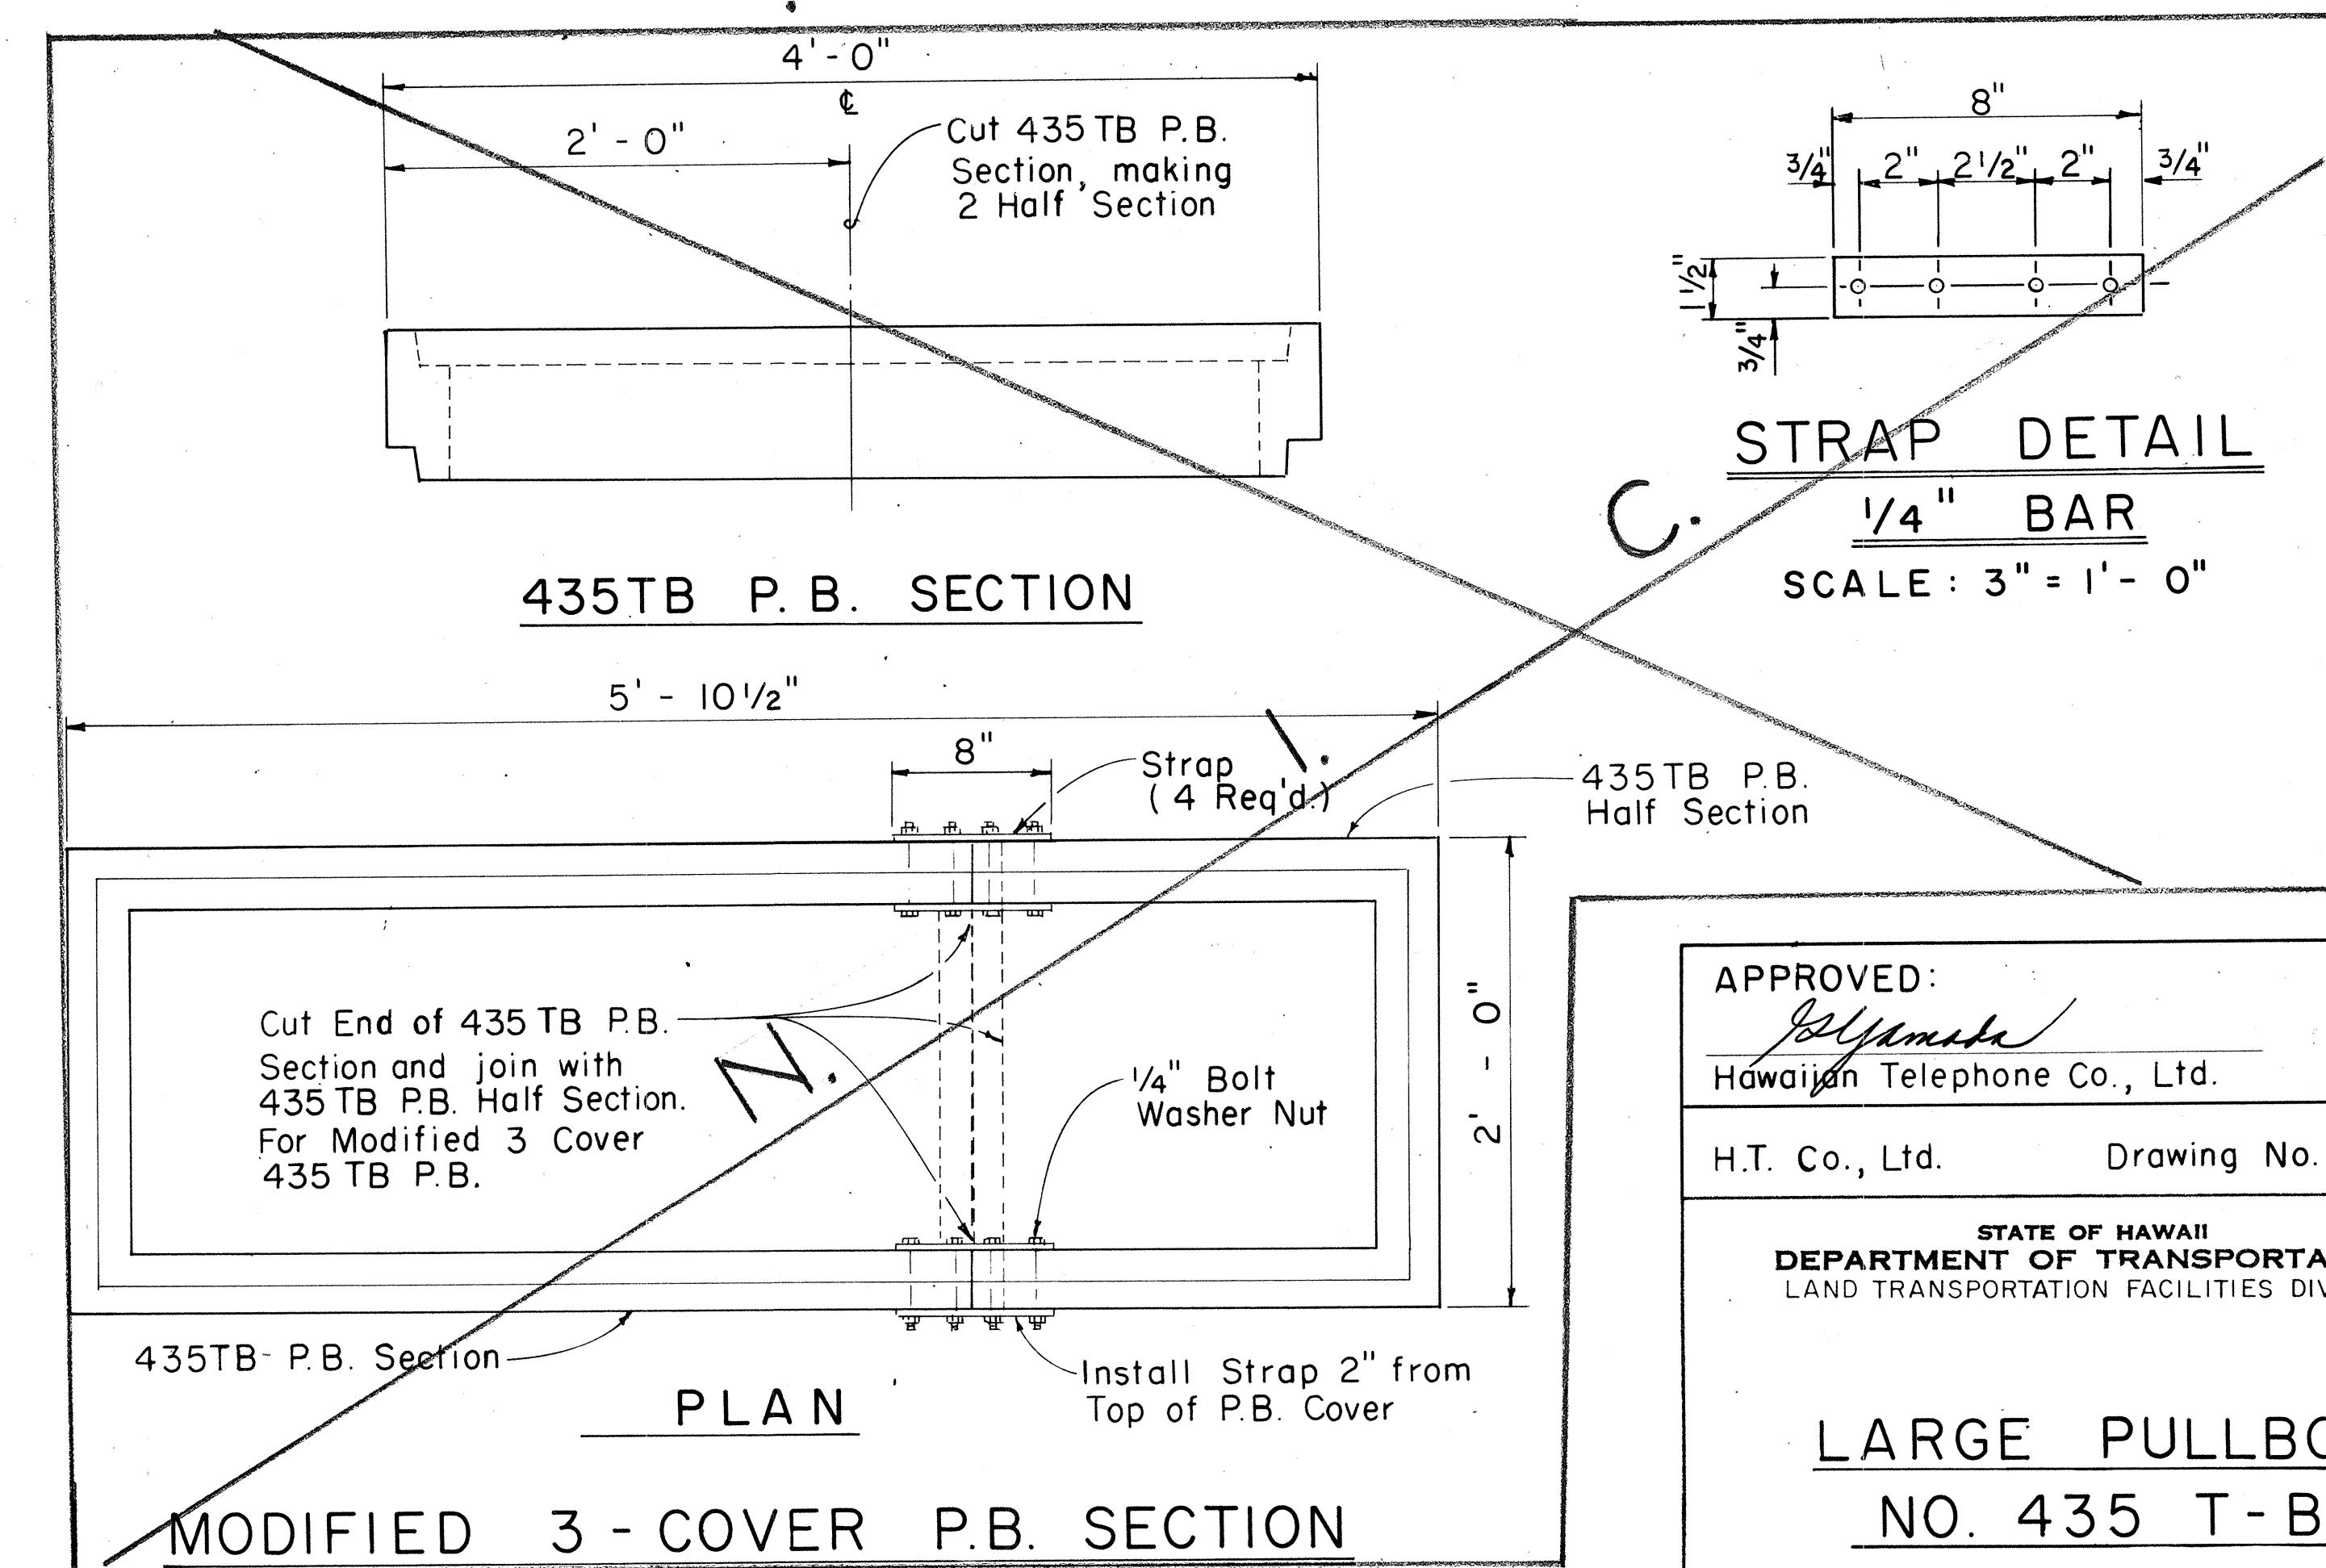

APPROVED: J. Yamada Date 6/26/78
Swanson Telephone Co., Ltd.

T. Co., Ltd. Drawing No. 34056







**STATE OF HAWAII
DEPARTMENT OF TRANSPORTATION
LAND TRANSPORTATION FACILITIES DIVISION**

LARGE PULL BOX


NO. 435 T-B

SHEET No. OF SHEETS



FED. ROAD DIST. NO.	STATE	FED. AID PROJ. NO.	FISCAL YEAR	SHEET NO.	TOTAL SHEETS
HAWAII	HAW.	M-7600(1)	1978	120	198

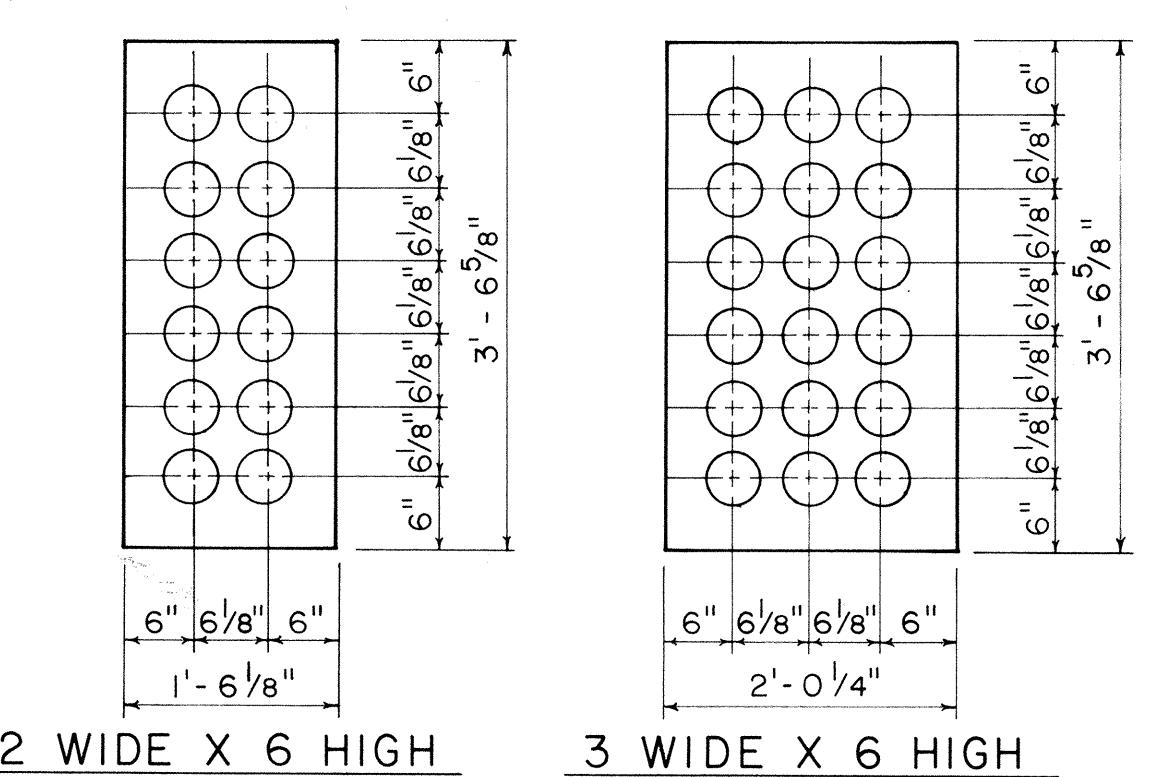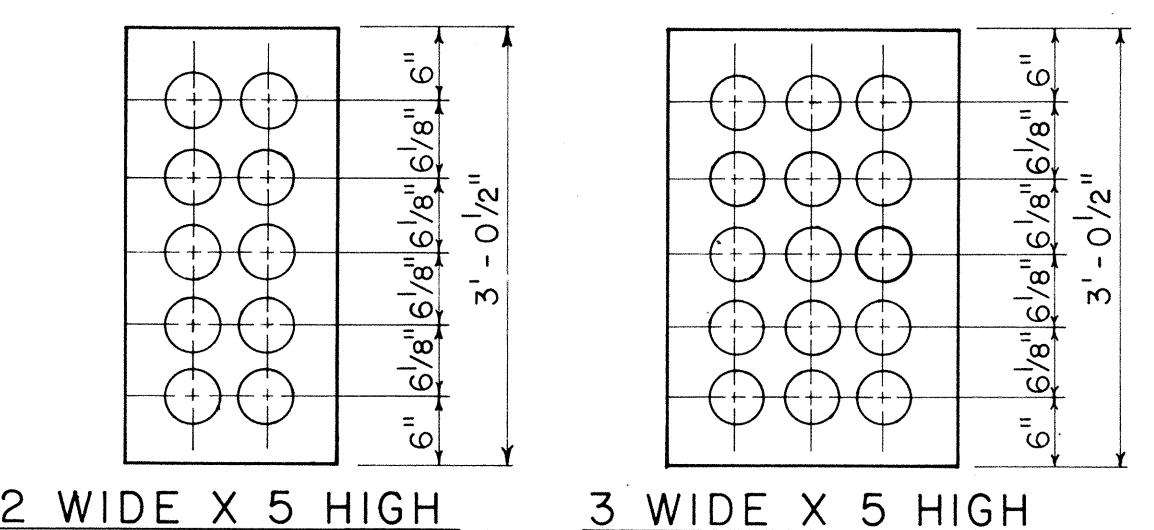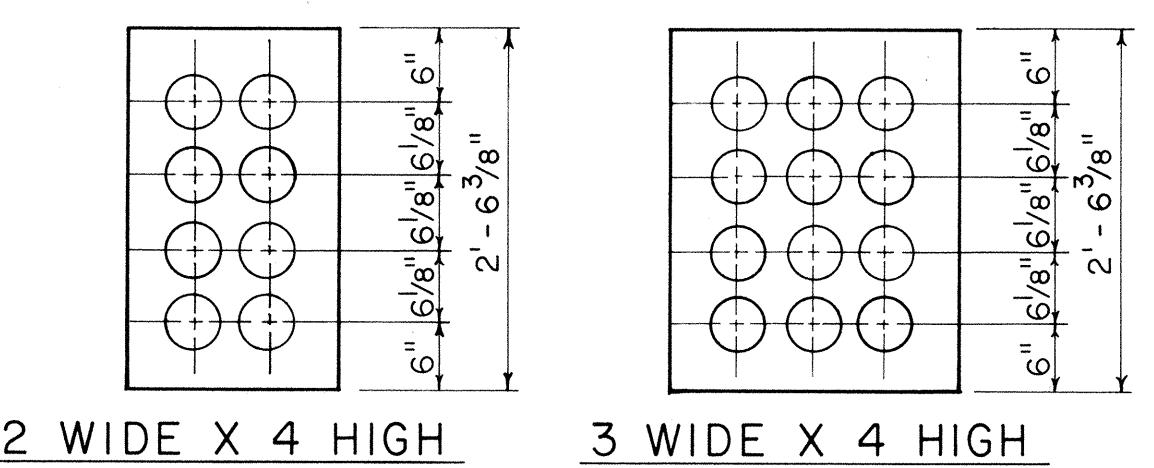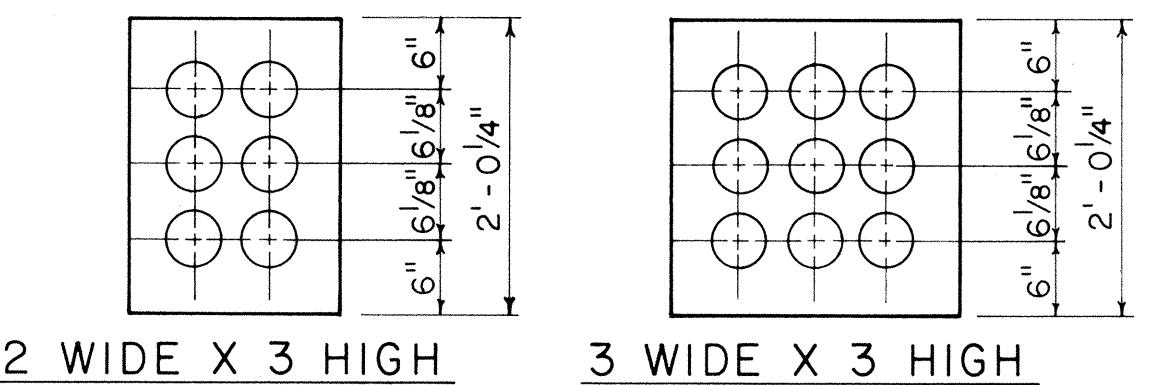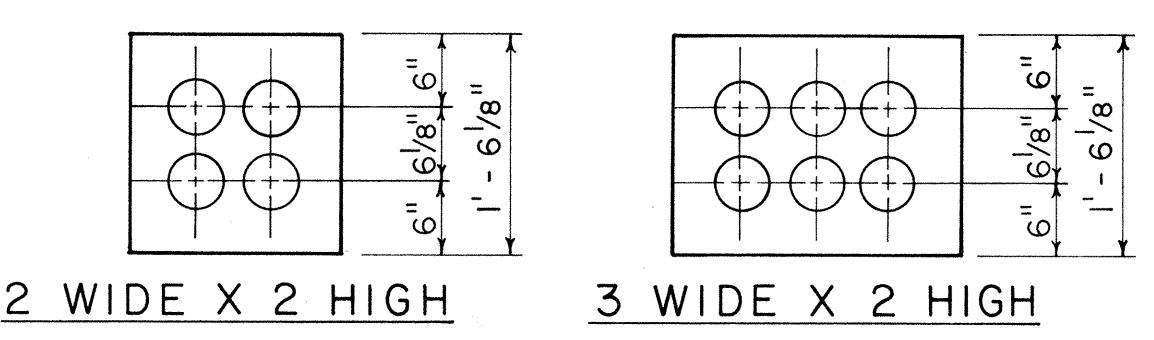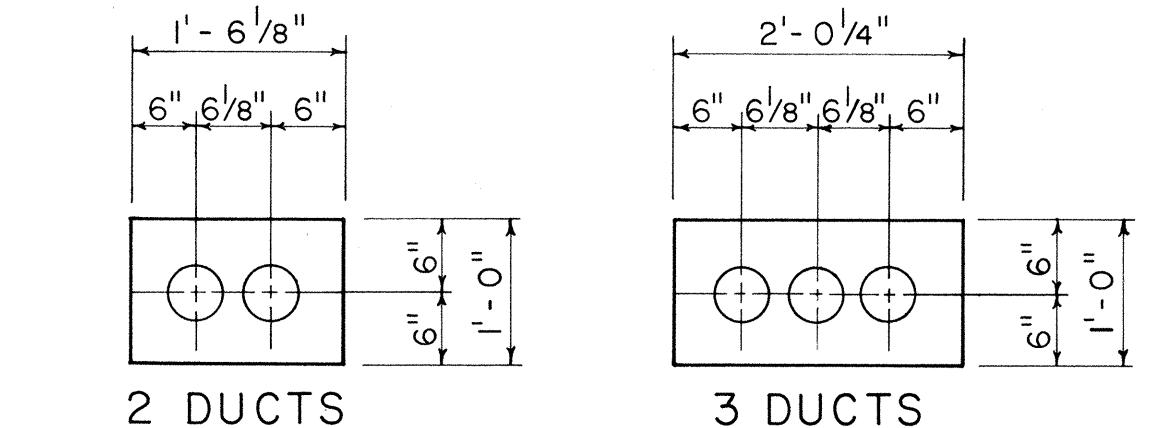



STANDARD DUCT FORMATIONS

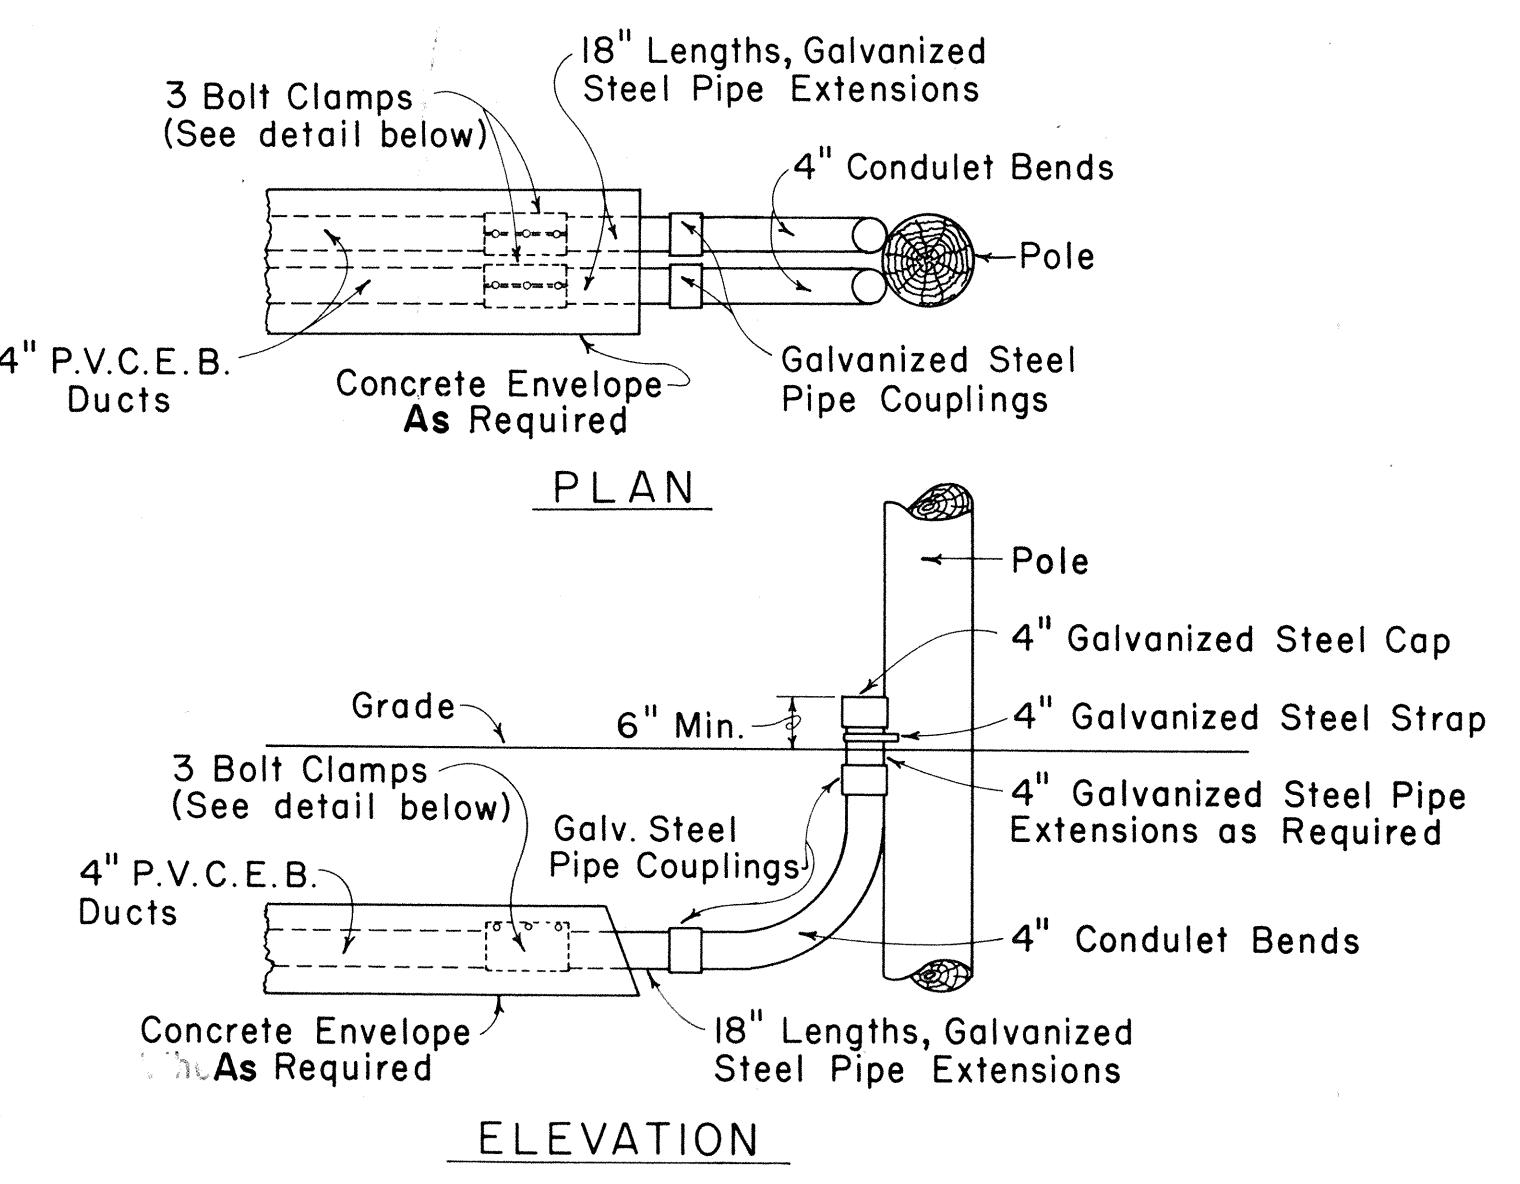


TYPICAL INSTALLATION DETAILS

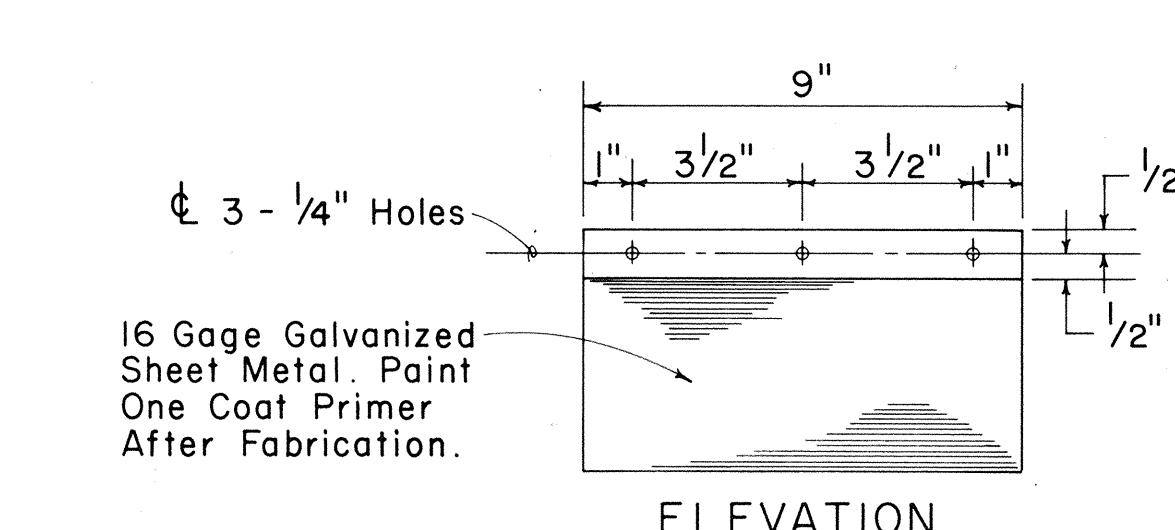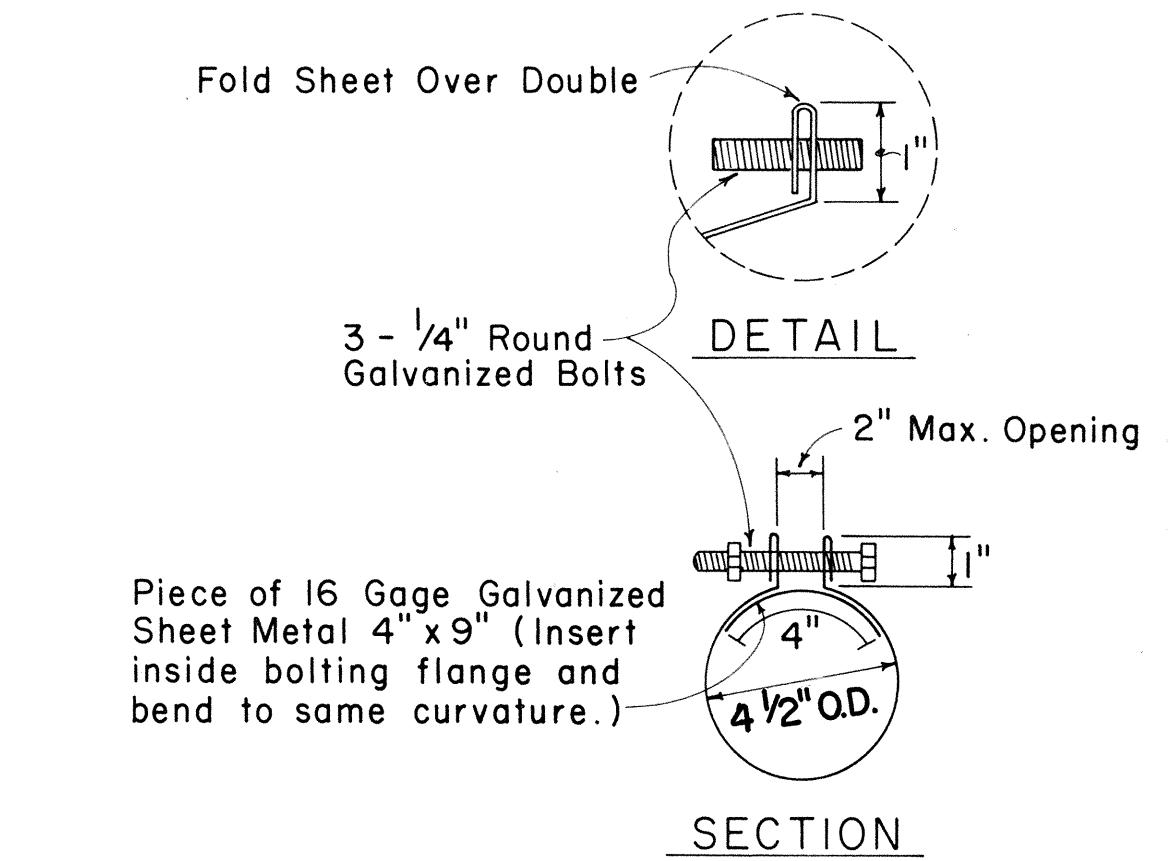


3-BOLT CLAMP ADAPTOR DETAIL

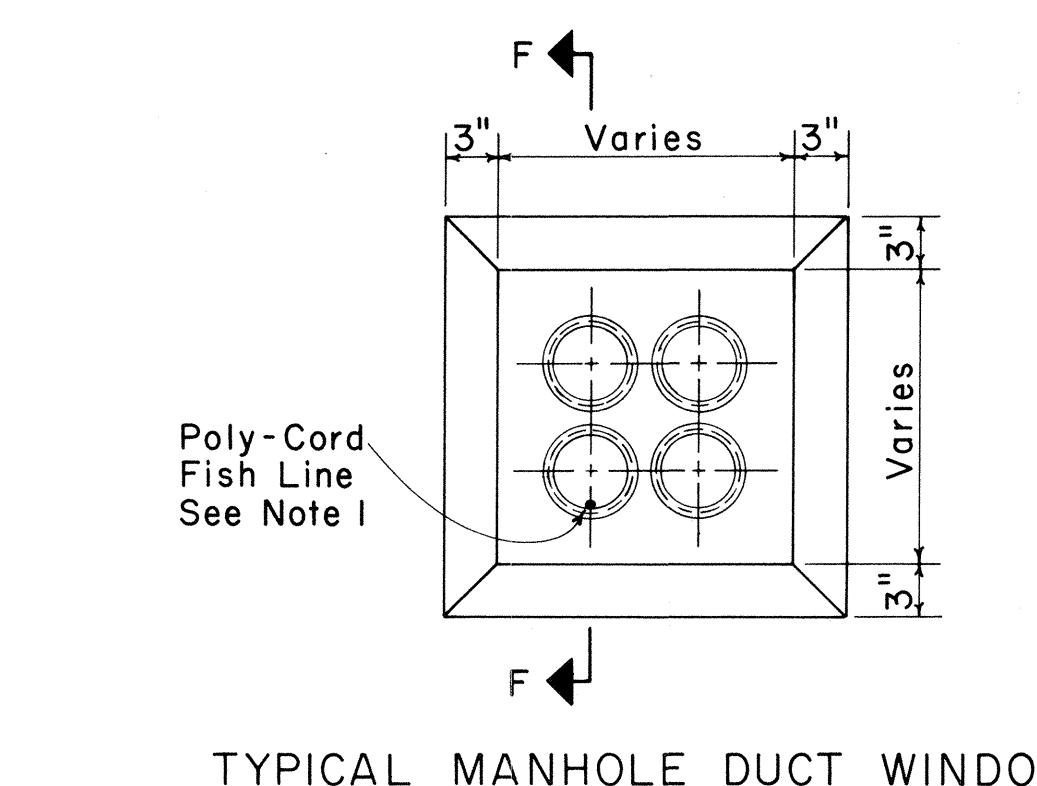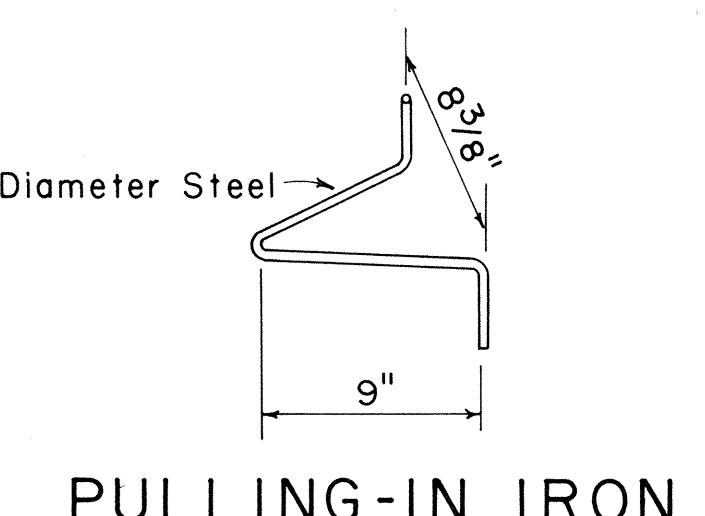



NOTE:
I. The contractor shall place poly-cord fish line in each duct throughout its entire length with protrusions of 2 feet in manholes and handholes at each end and 1 foot in pullboxes.

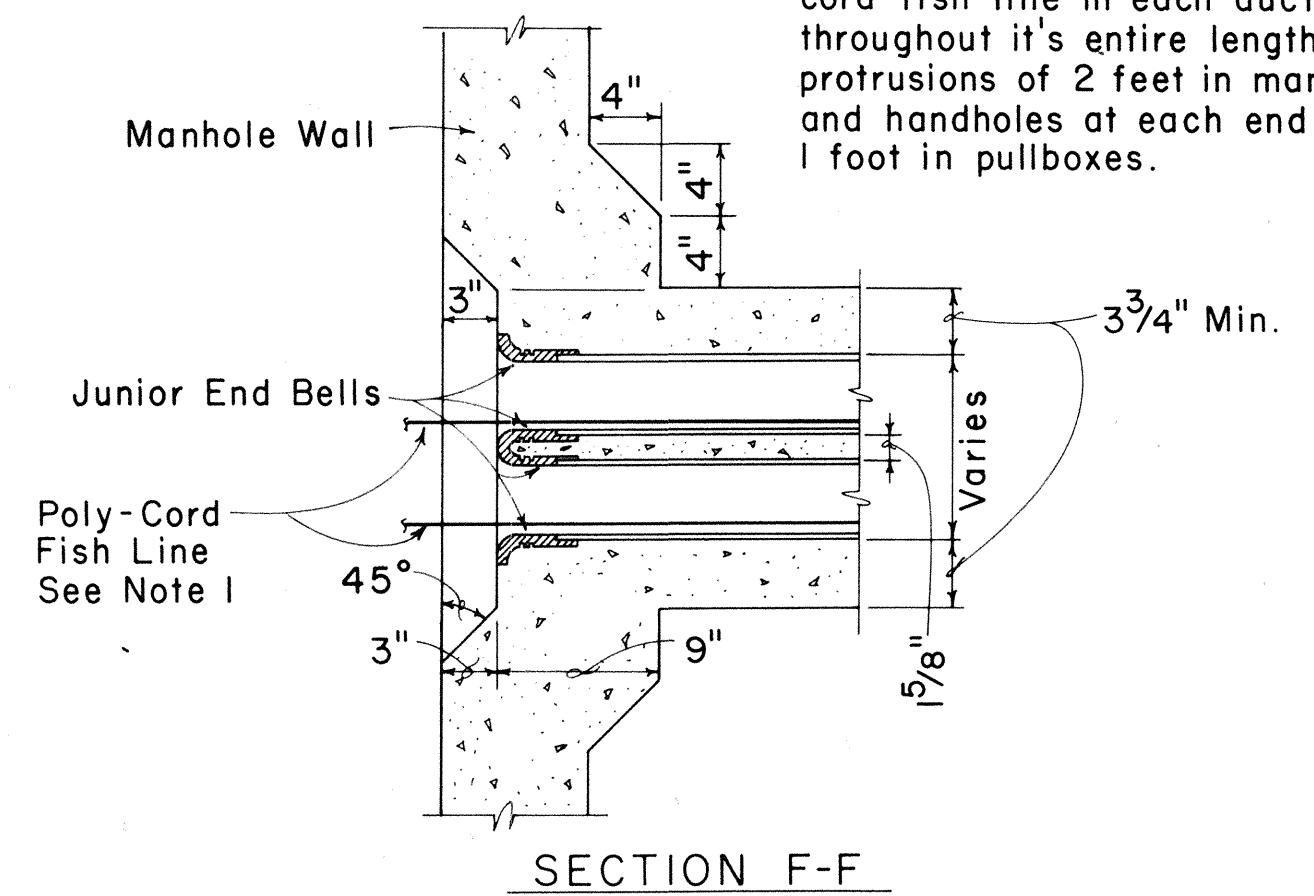



TYPICAL DUCT WINDOW DETAIL & JUNIOR END BELL

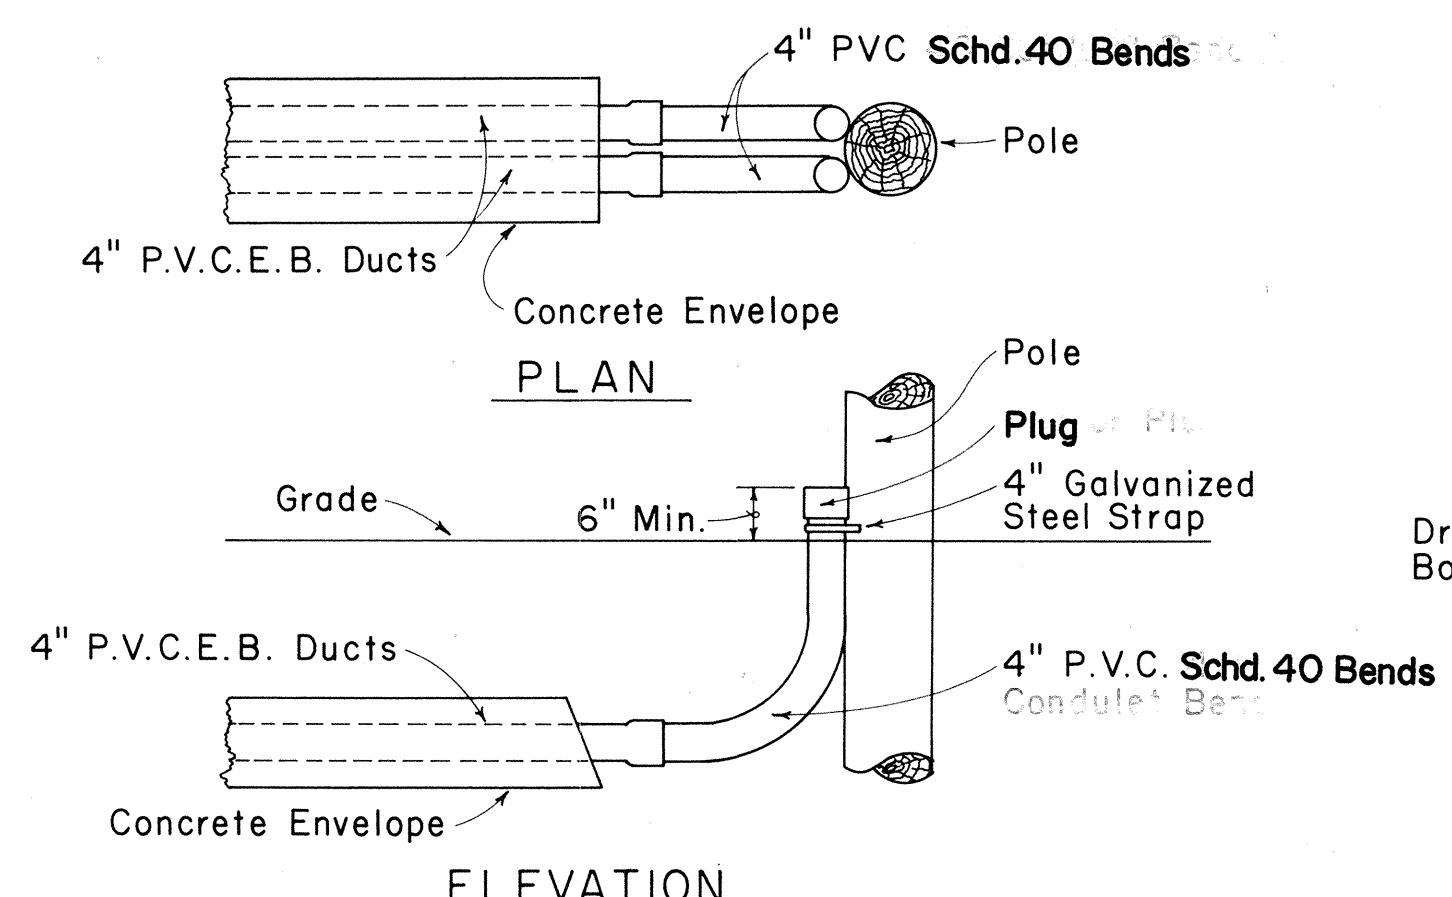

TYPICAL CONDULET BEND INSTALLATION DETAILS

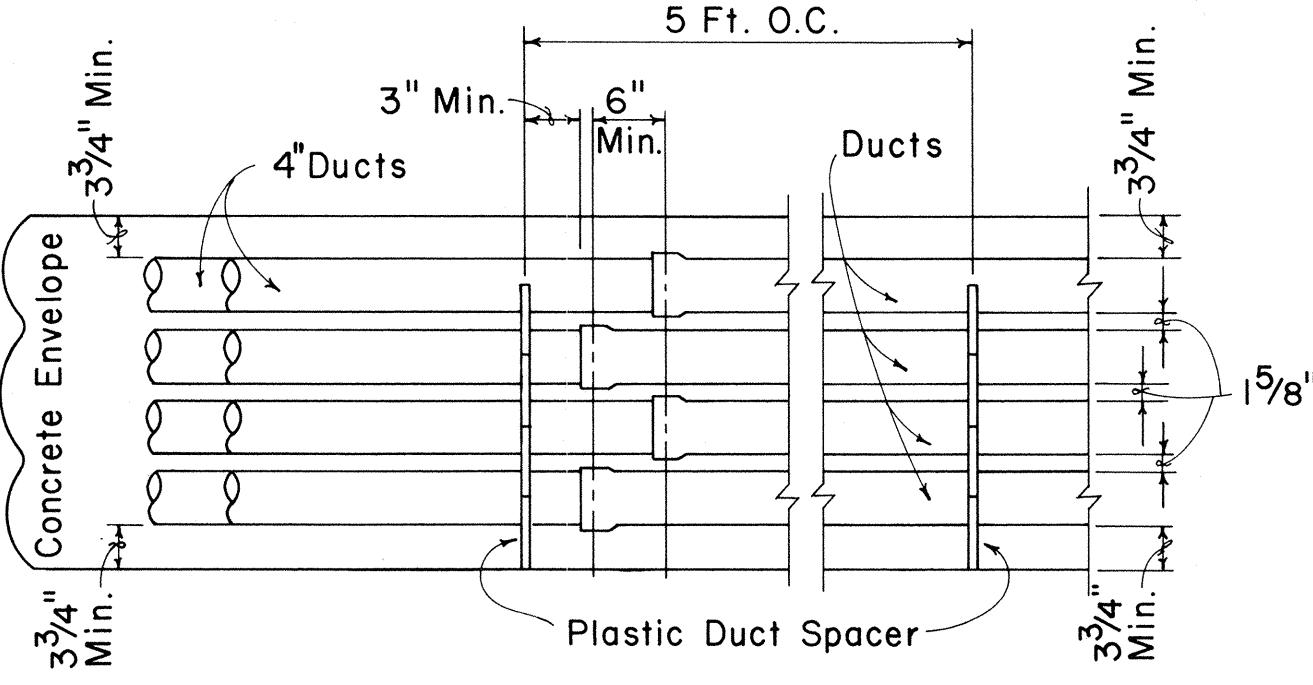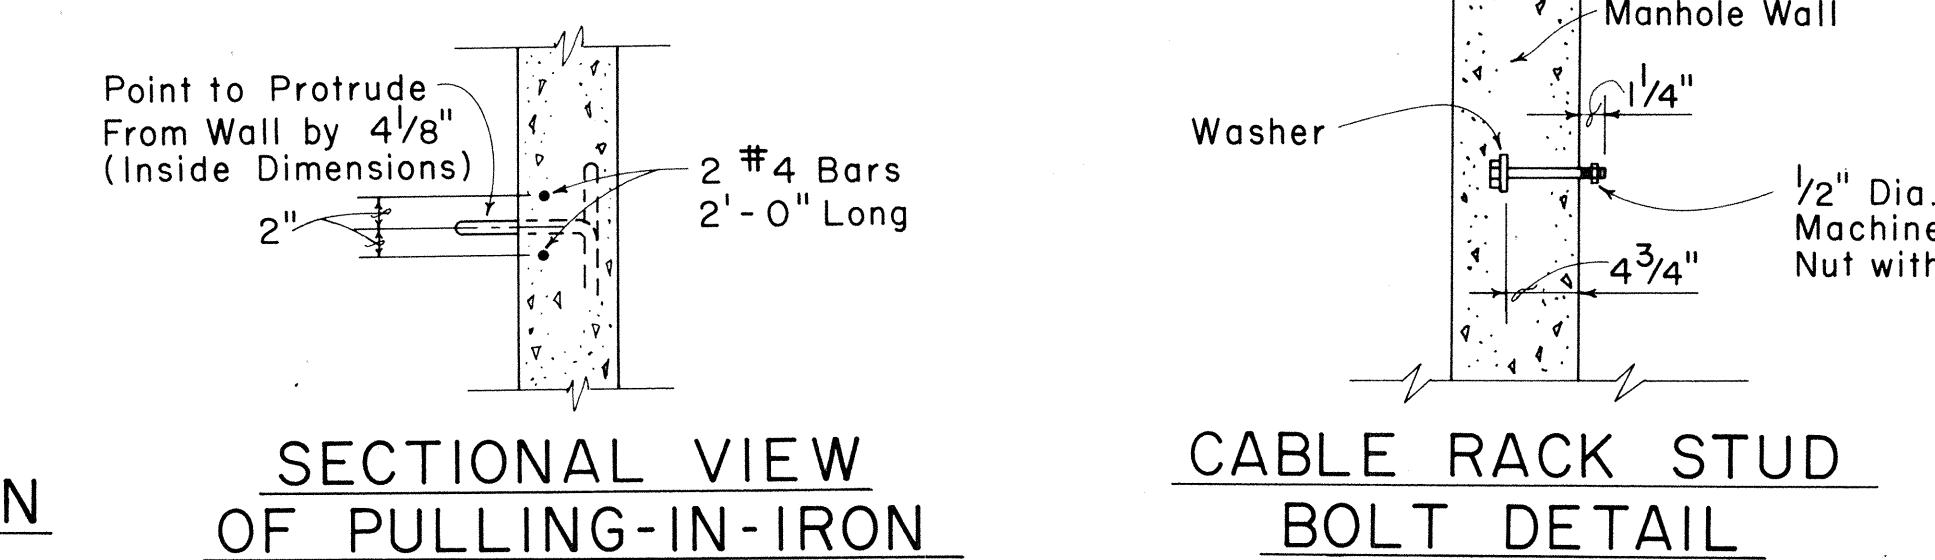

TYPICAL DUCT ENVELOPE ELEVATION ARRANGEMENT OF PLASTIC SPACERS

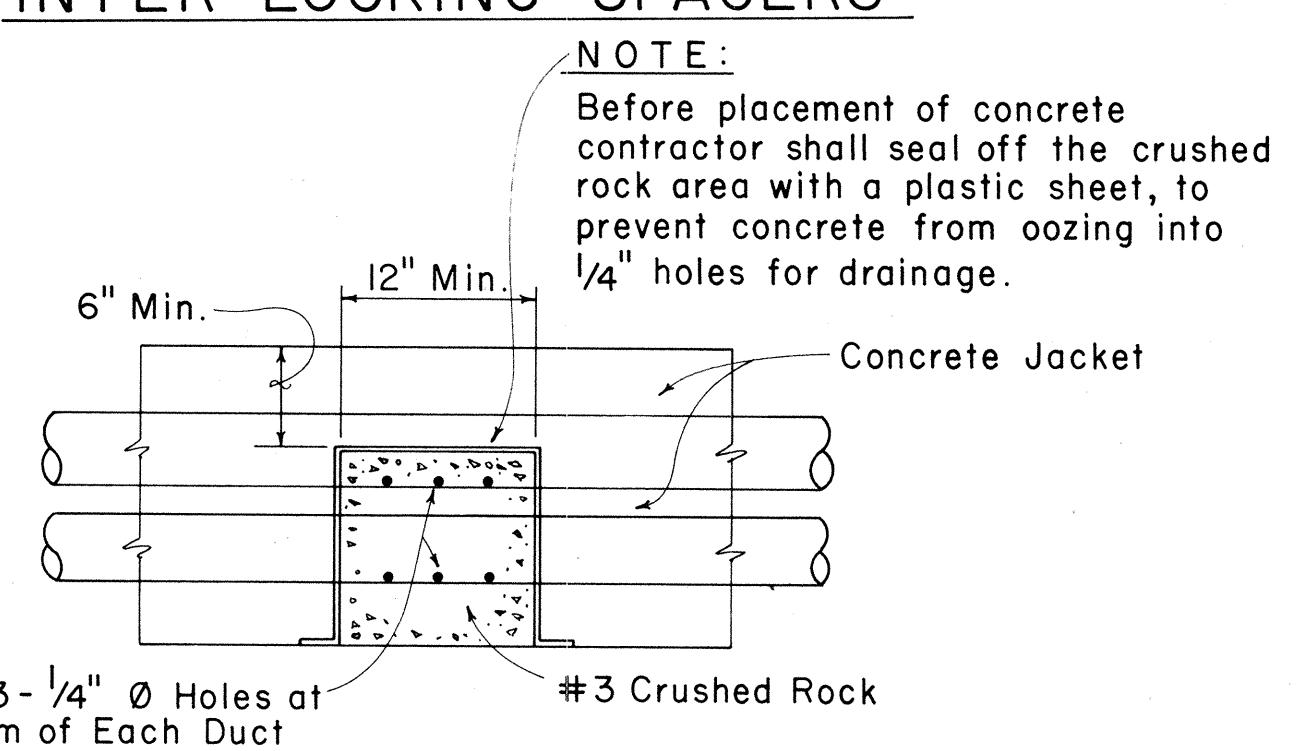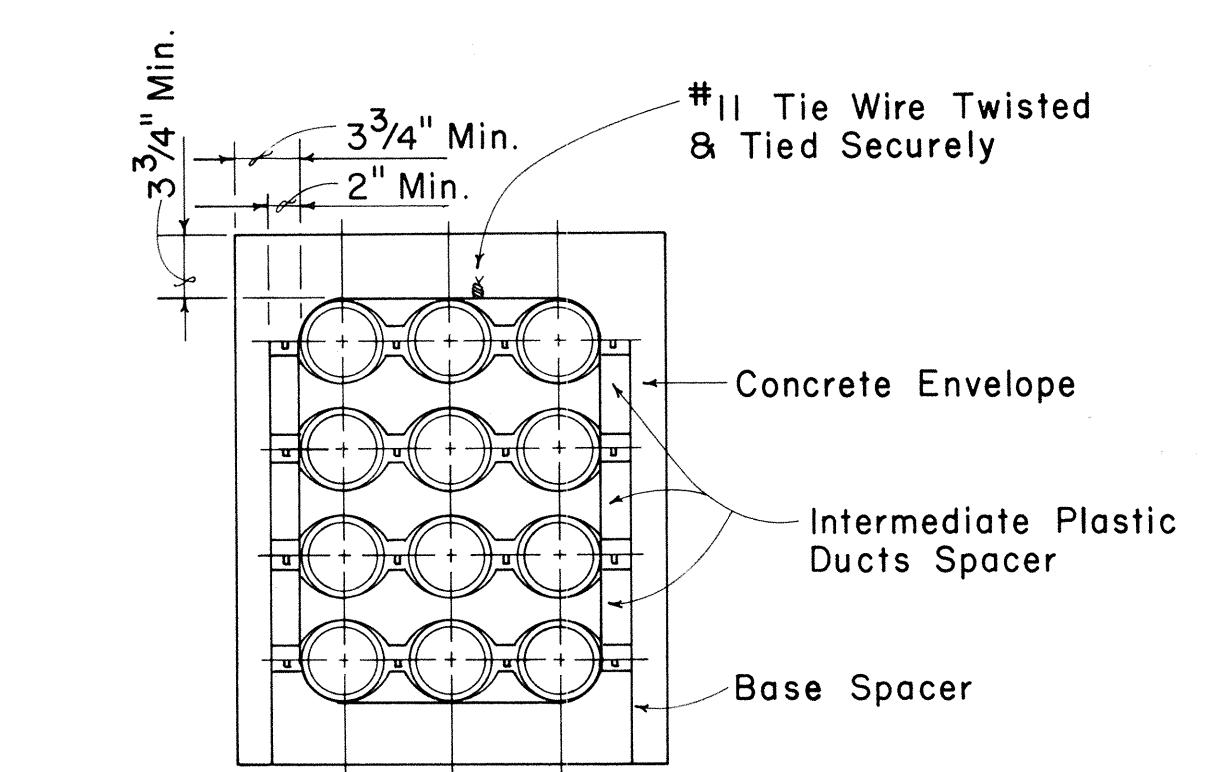

APPROVED:
J. Yamada
Hawaiian Telephone Co., Ltd. Date
6/26/78



H.T. Co., Ltd. Drawing No. 34028

STATE OF HAWAII
DEPARTMENT OF TRANSPORTATION
LAND TRANSPORTATION FACILITIES DIVISION

STANDARD DUCT FORMATIONS

Not to Scale
SHEET NO. OF SHEETS

FED. ROAD DIST. NO.	STATE	FED. AID PROJ. NO.	FISCAL YEAR	SHEET NO.	TOTAL SHEETS
HAWAII	HAW.	M-7600(1)	1978	122	198

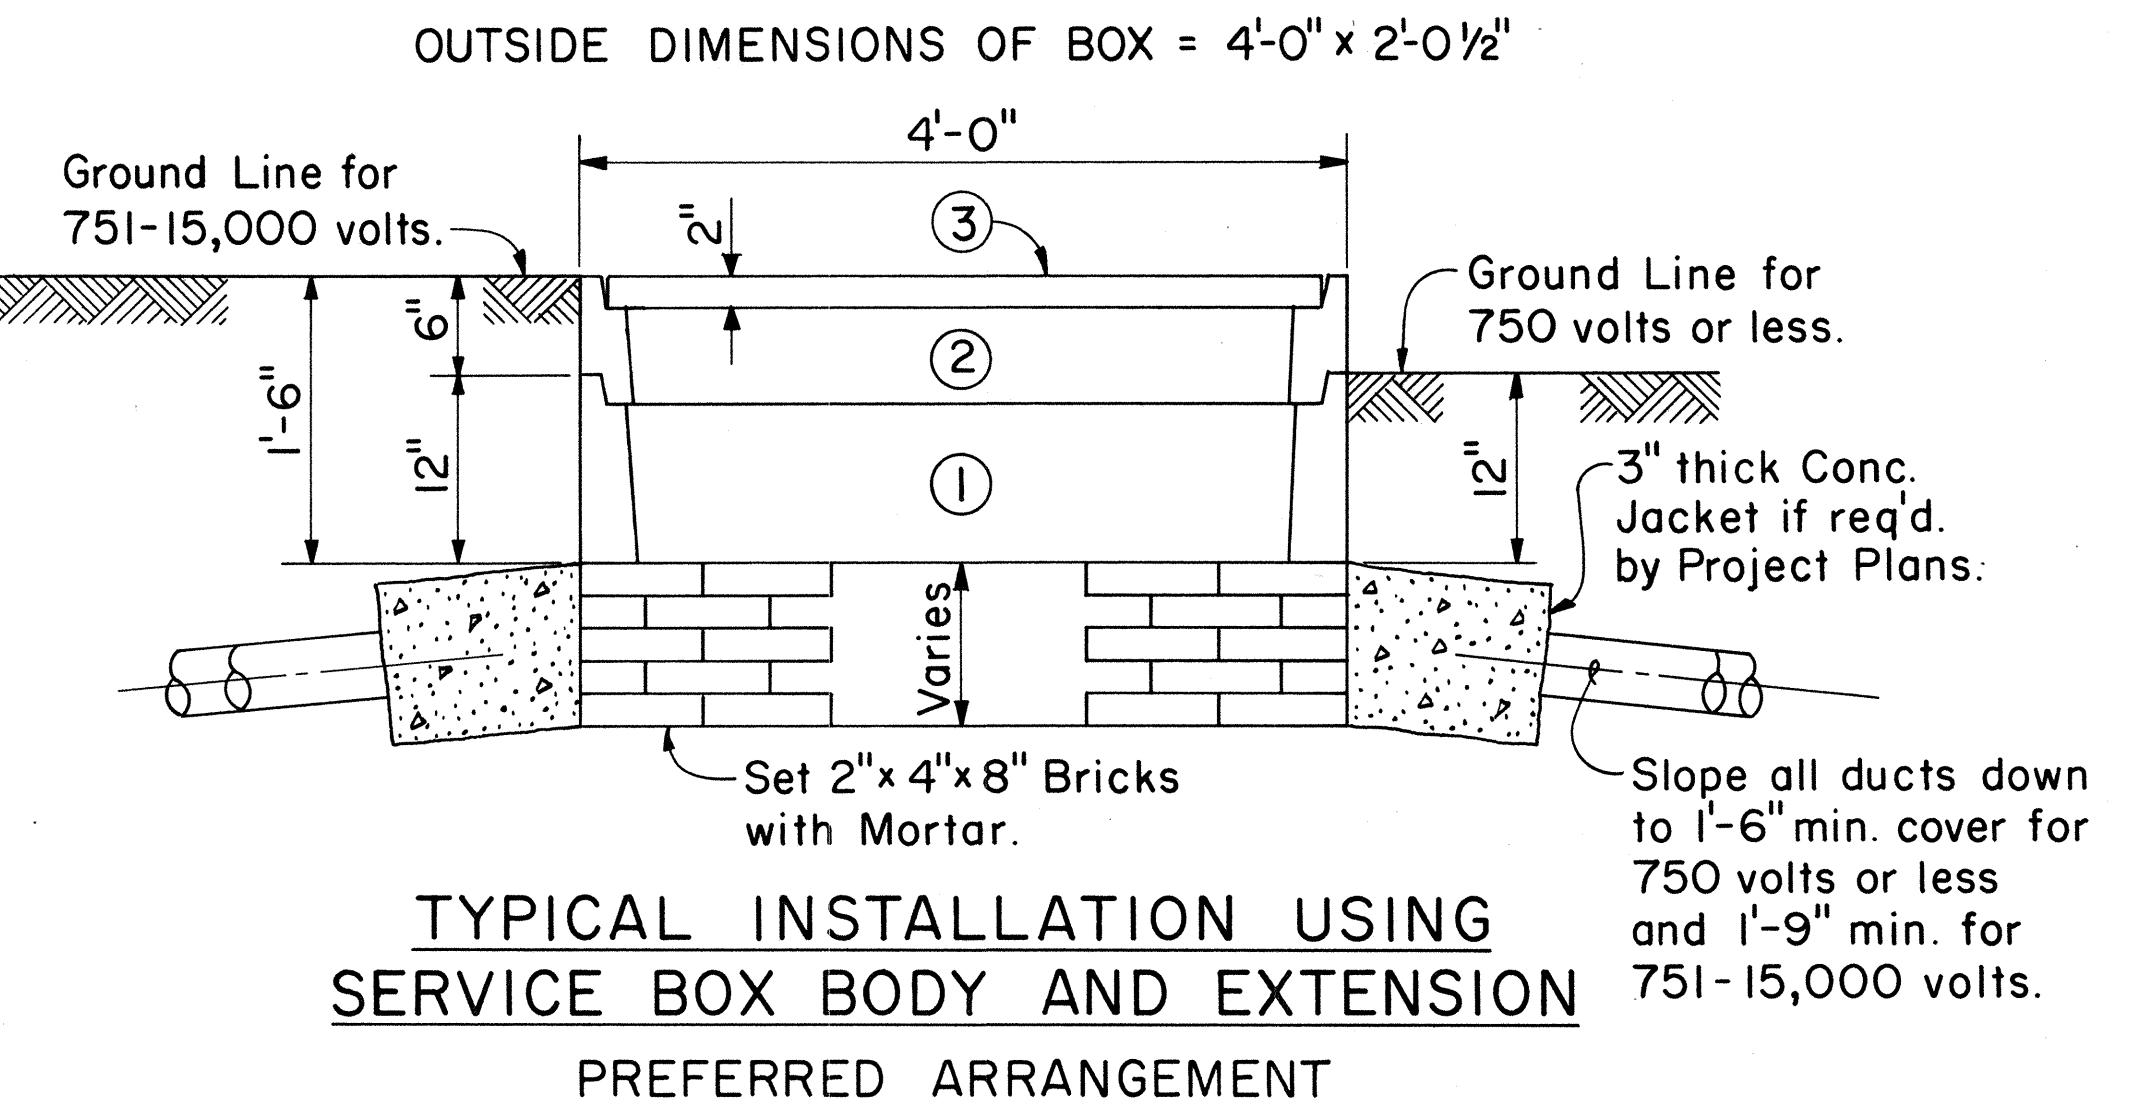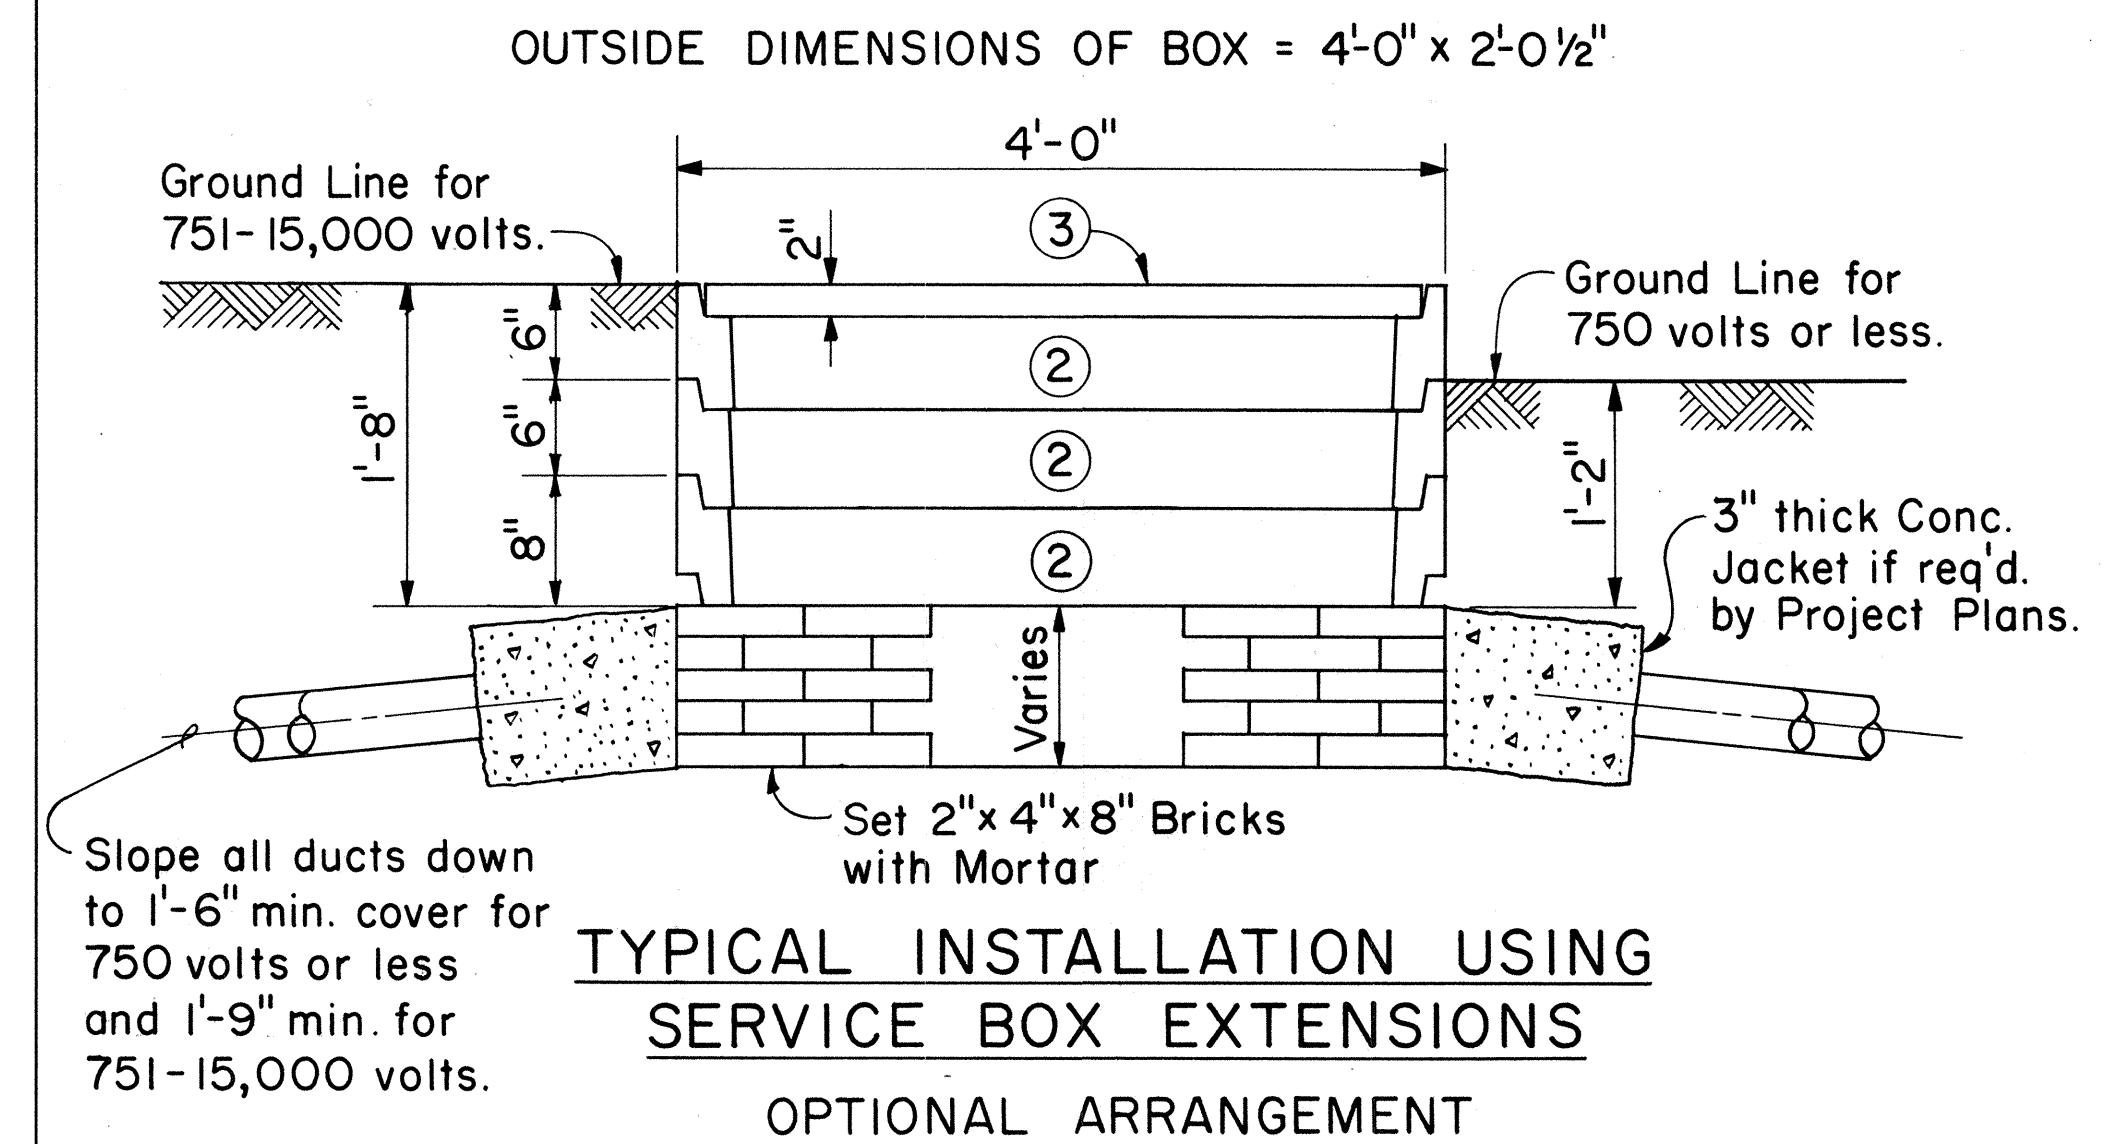

VOLTAGE CLASS	NO. OF UNITS REQUIRED	
	PREFERRED	OPTIONAL
750 volts or less	1 Body	2 Extensions
751 to 15,000 volts (See Note 1)	1 Body and 1 Extension	3 Extensions

ITEM NO.	DESCRIPTION	H. E. CODE NO.
1	Body	11310
2	Extension	11311
3	Cover, Non Traffic Type	11312

**SERVICE BOX (1'-6" x 3'-6")
INSTALLATION DETAILS UNDERGROUND**

Scale : 1" = 1'-0"

H. E. Co. DWG. NO.
30 - 2005

NOTES:

1. Refer to "Guide for Handhole Applications - I2 KV" for proper application of Service Box with type and size of I2 KV cable.
2. Contractor may either install the Preferred or Optional Arrangements of Service Box units.

APPROVED:

as mg J Karunaratne
HAWAIIAN ELECTRIC Co., Inc.

DATE:

STATE OF HAWAII
DEPARTMENT OF TRANSPORTATION
LAND TRANSPORTATION FACILITIES DIVISION

STANDARD DETAILS


SERVICE BOX
INSTALLATION DETAILS

SHEET No. OF SHEETS


122

GENERAL NOTES FOR MANHOLES & HANDHOLES STANDARD DETAILS

- All work shall be subject to inspection by the Hawaiian Electric Co., Inc., Contracting & Inspection Division, City & County of Honolulu and/or Land Transportation Facilities Division, State of Hawaii, whichever Government has authority over the work.
- Contractor shall notify the Hawaiian Electric Co., Inc., Contracting & Inspection Division, phone 548-4427 or 548-4428 24 hours before proceeding with any work on facilities owned by Hawaiian Electric Co., Inc..
- Ducts: For number, size and exact location of Duct Entrances, refer to Project Drawings.
- Pulling Irons: For number and locations, refer to Project Drawings.

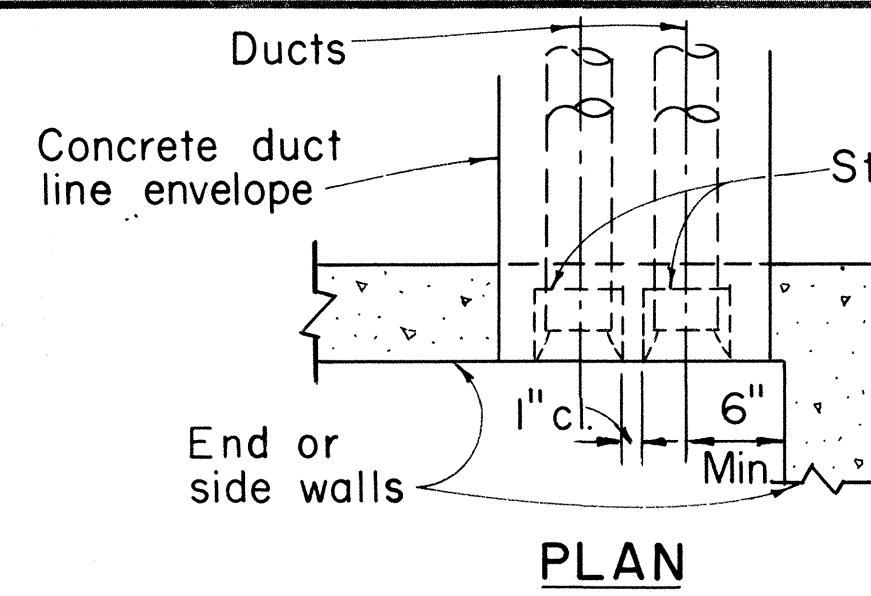


PLAN

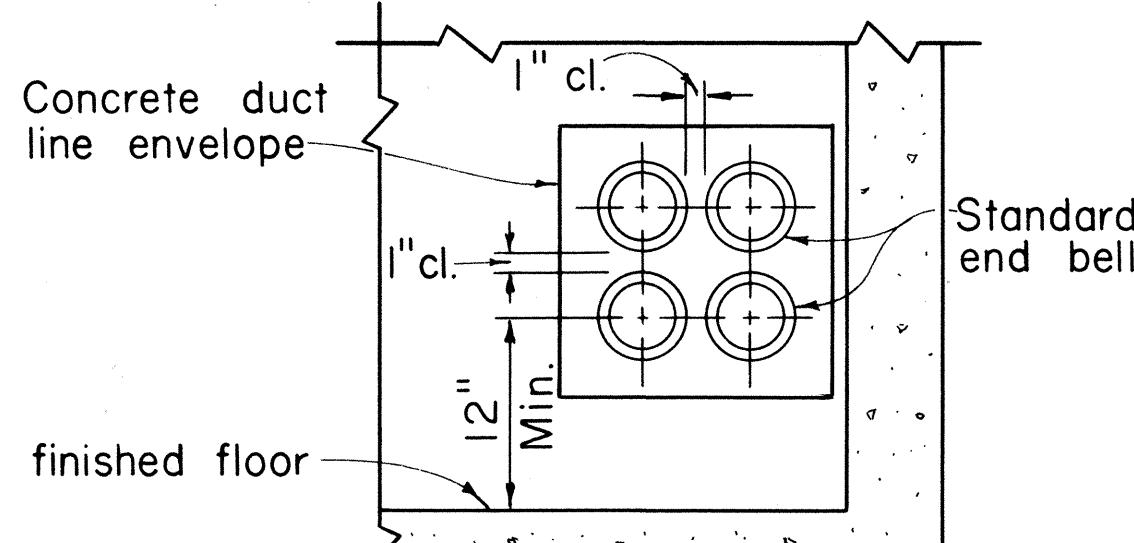


ELEVATION
END OR SIDE ENTRANCE

Scale: 1" = 1'-0"

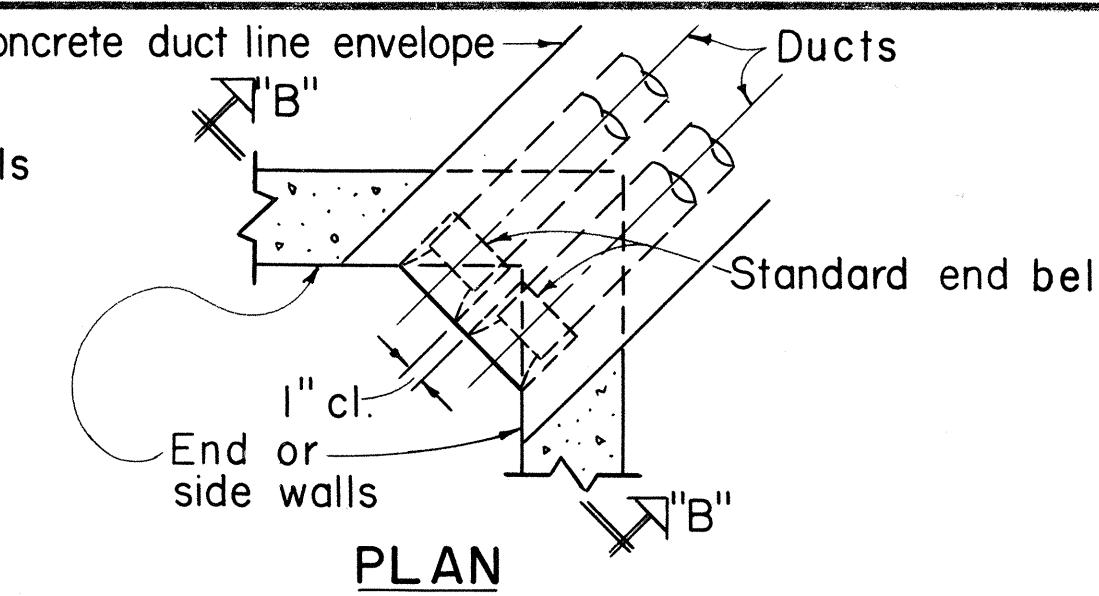


PLAN

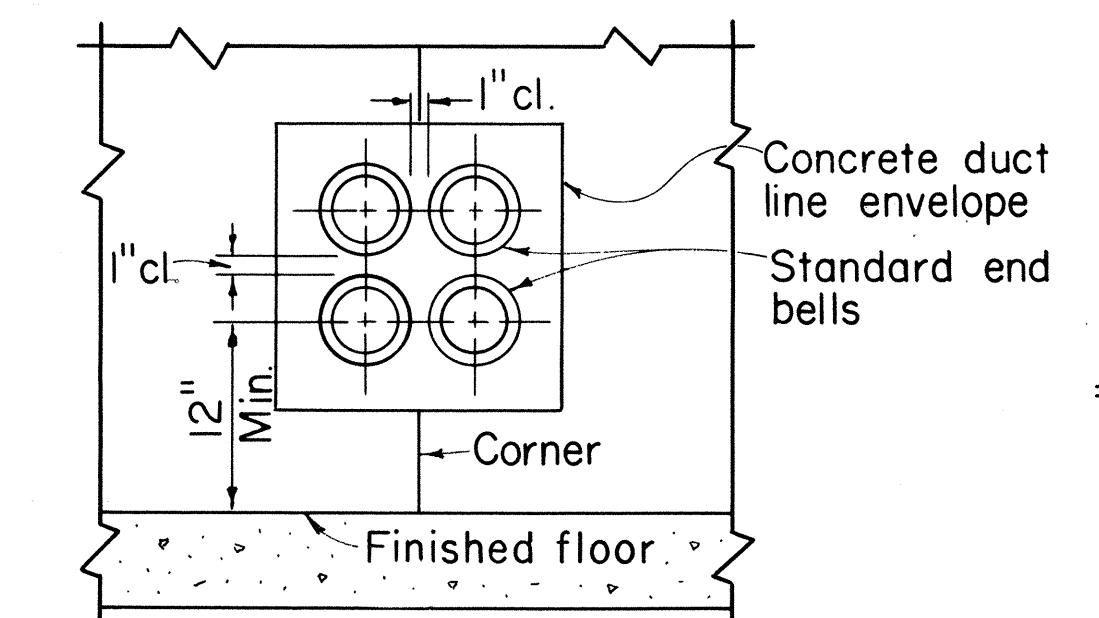


ELEVATION "B-B"
CORNER ENTRANCE

Scale: 1" = 1'-0"

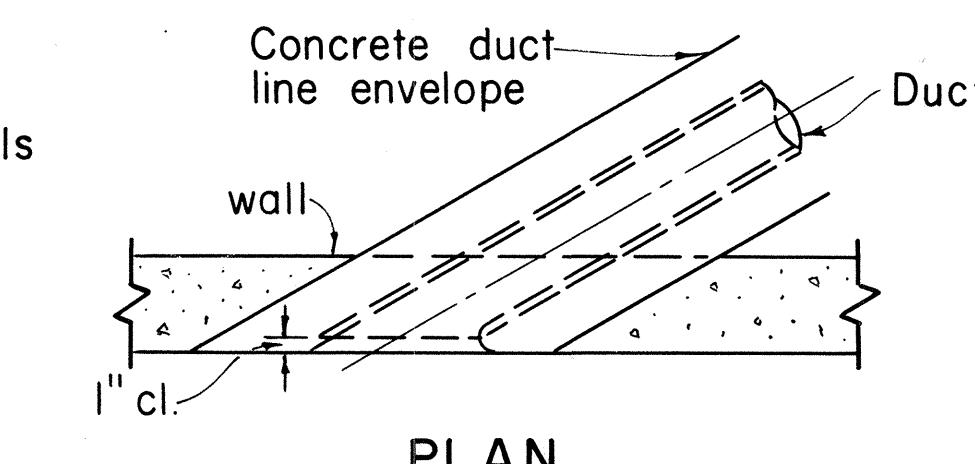


PLAN

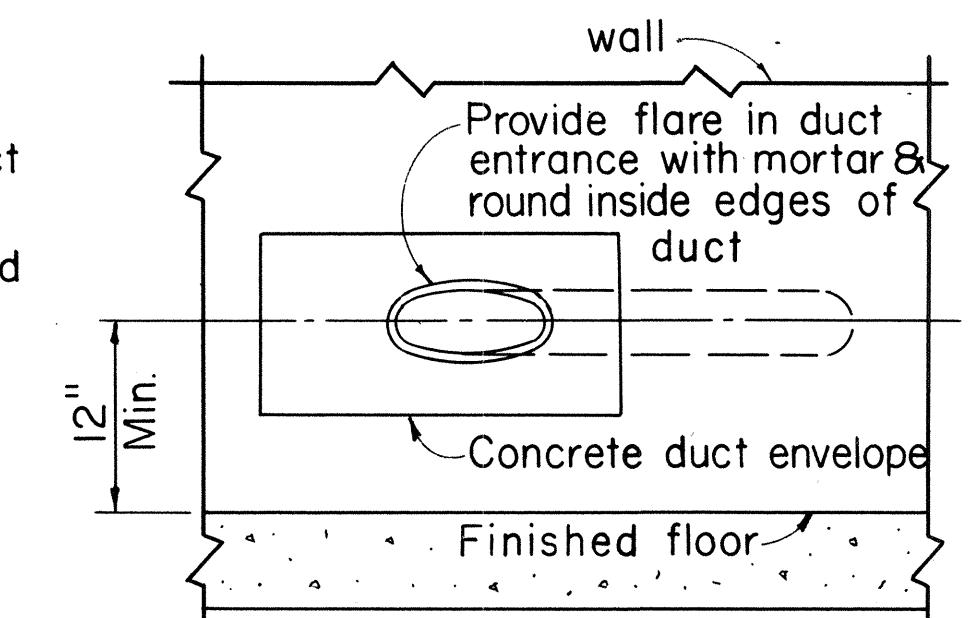

ELEVATION
DIAGONAL ENTRANCE

Scale: 1" = 1'-0"


FED. ROAD DIST. NO.	STATE	FED. AID PROJ. NO.	FISCAL YEAR	SHEET NO.	TOTAL SHEETS
HAWAII	HAW.	M-7600(1)	1978	125	198

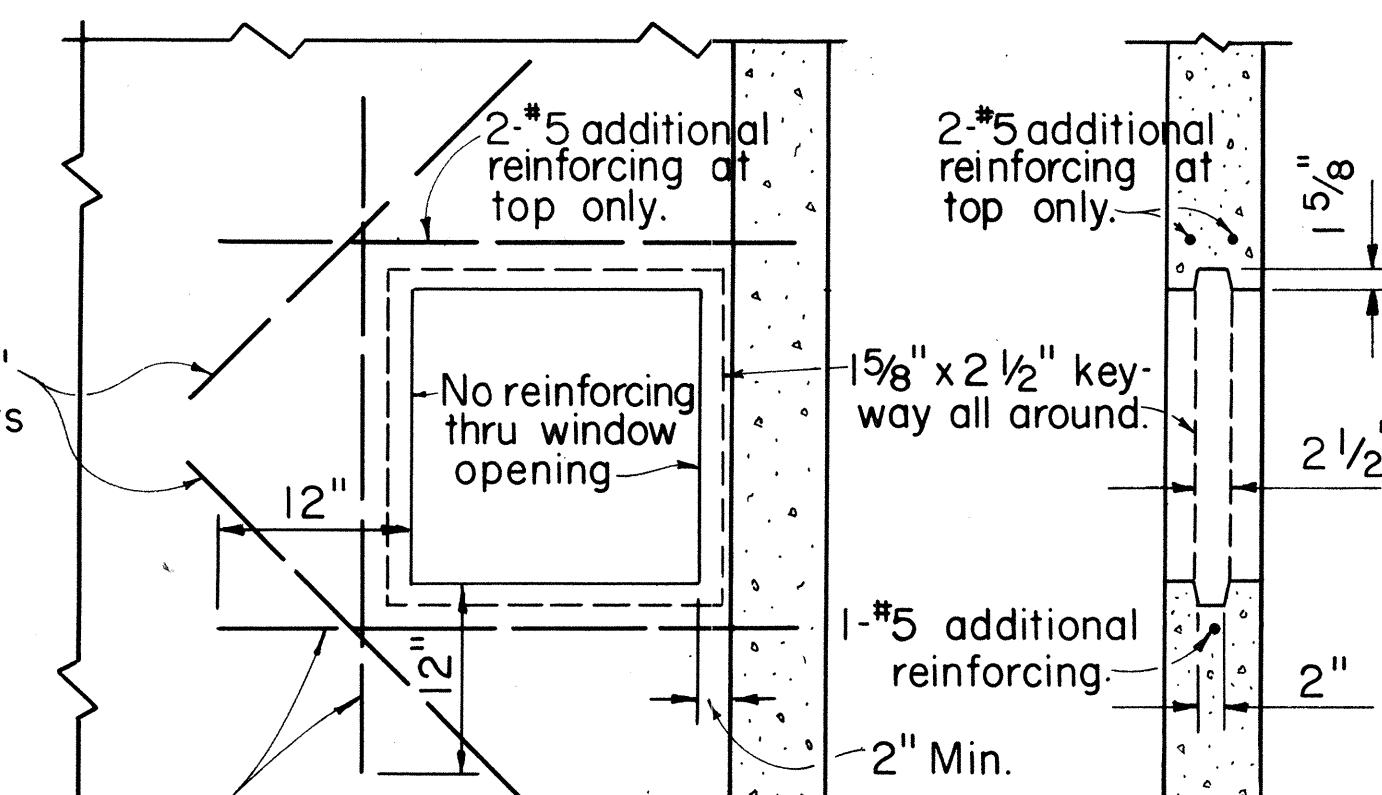

NOTE:
Provide opening for future ductline.
Fill opening with bricks and mortar joints as required. (See Gen. Note 3)


ELEVATION
SECTION

Scale: 1" = 1'-0"

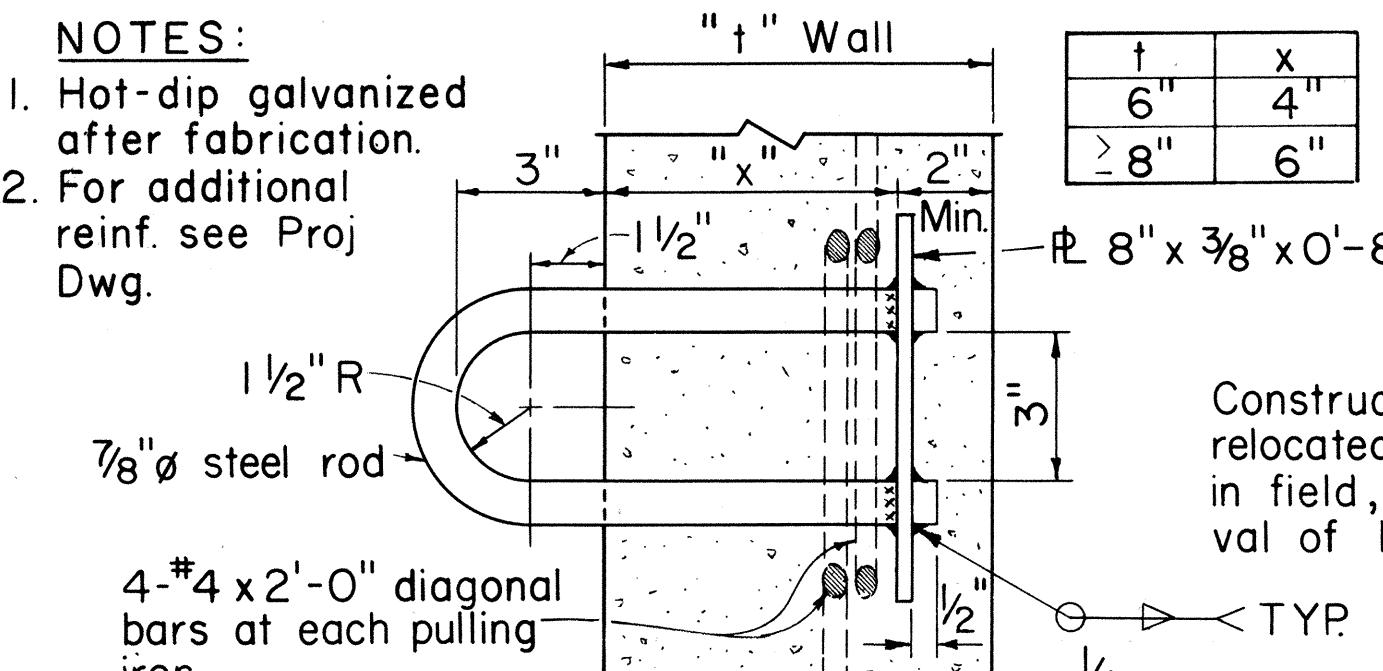

SECTION
PULLING IRON


Scale: 3" = 1'-0"
TYPE II (OPTIONAL)

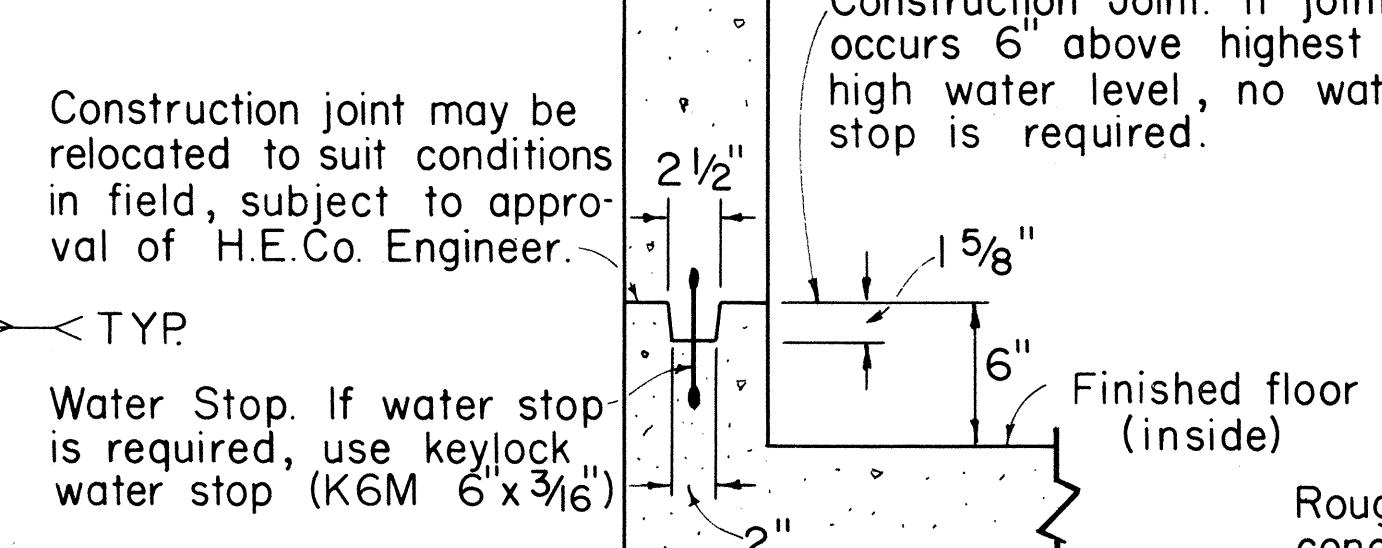

SECTION

TYPICAL CONSTRUCTION JOINT


Scale: 1 1/2" = 1'-0"

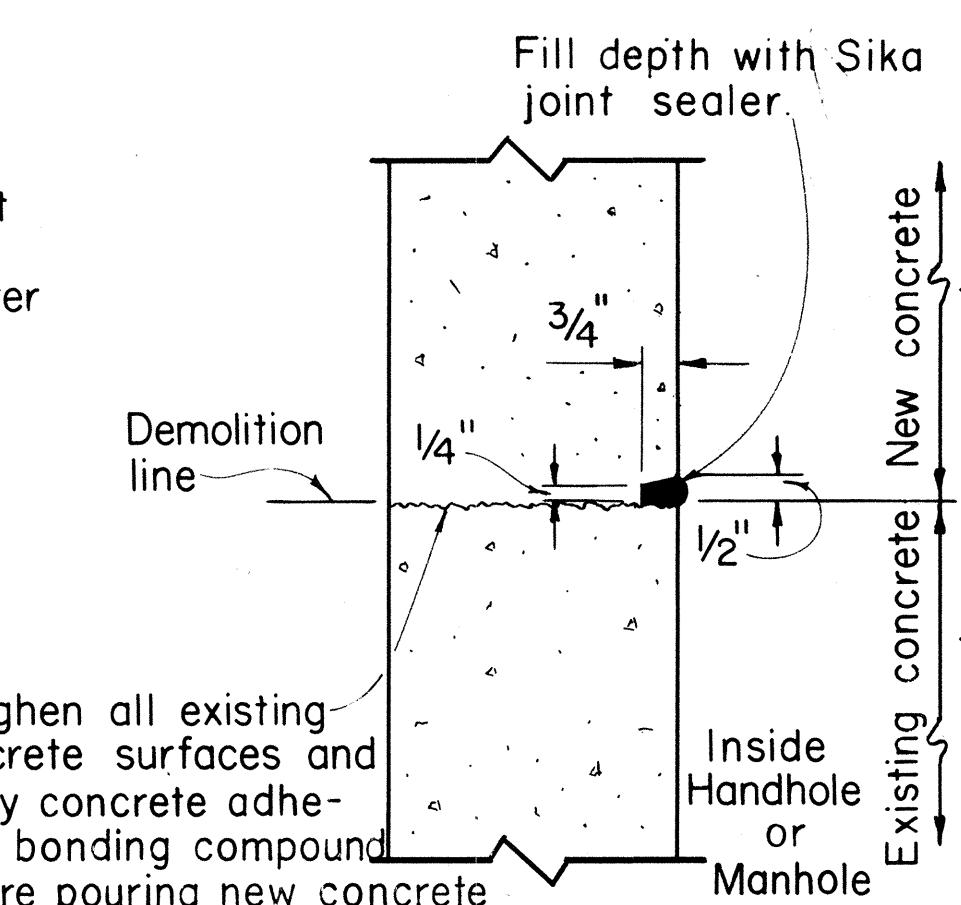

SECTION

TYPICAL COLD JOINT


Scale: 3" = 1'-0"

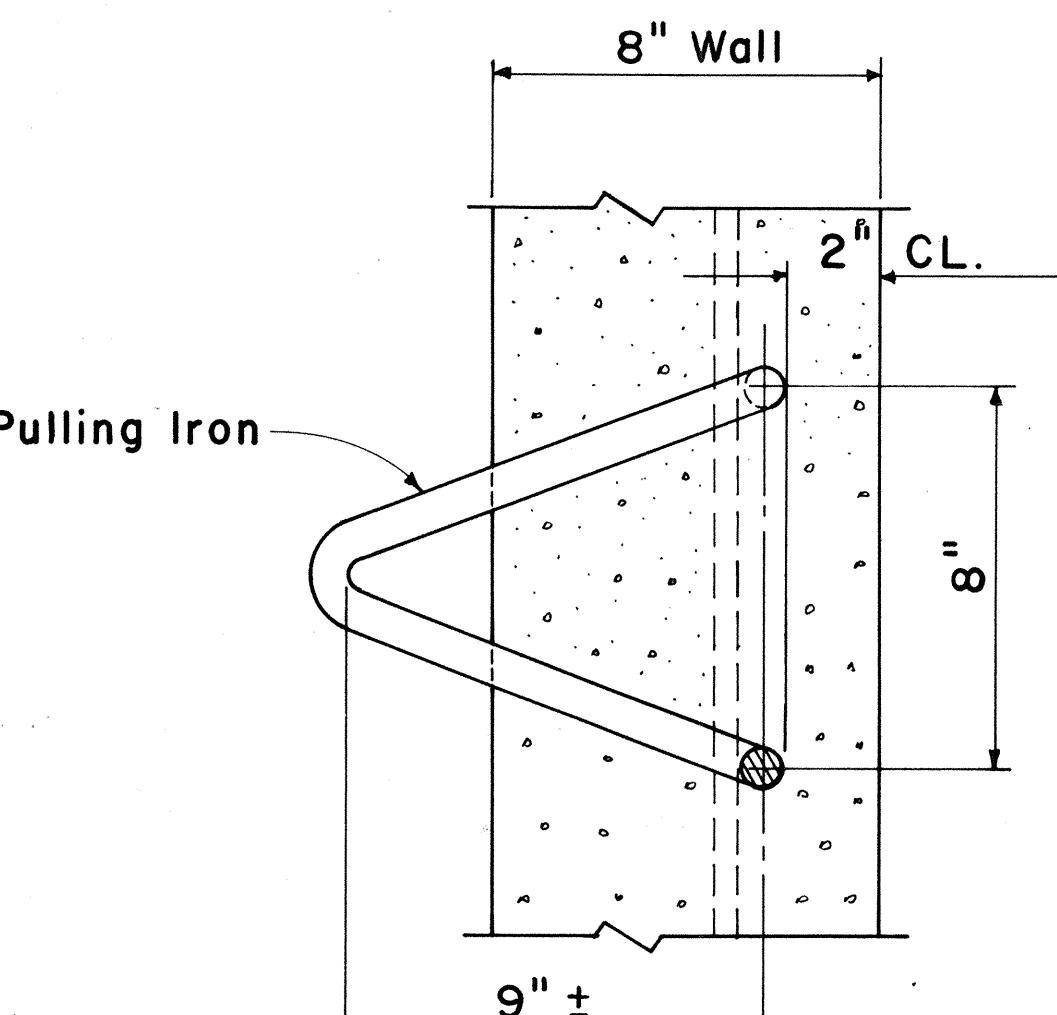


PLAN

PULLING IRON FOR 8" WALL - TYPE I (PREFERRED)

Scale: 3" = 1'-0"

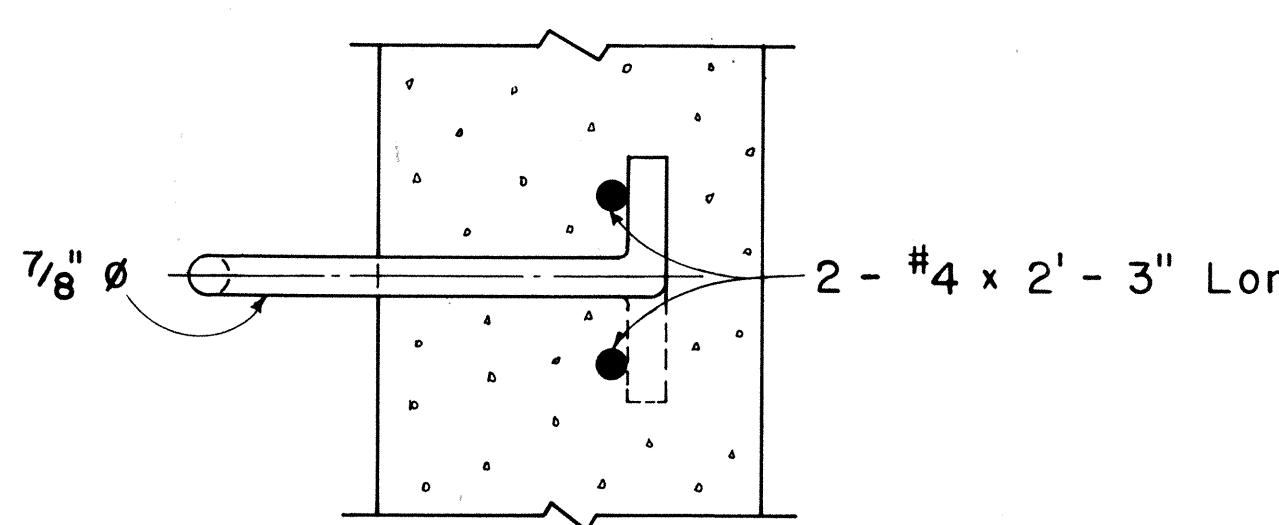


SECTION

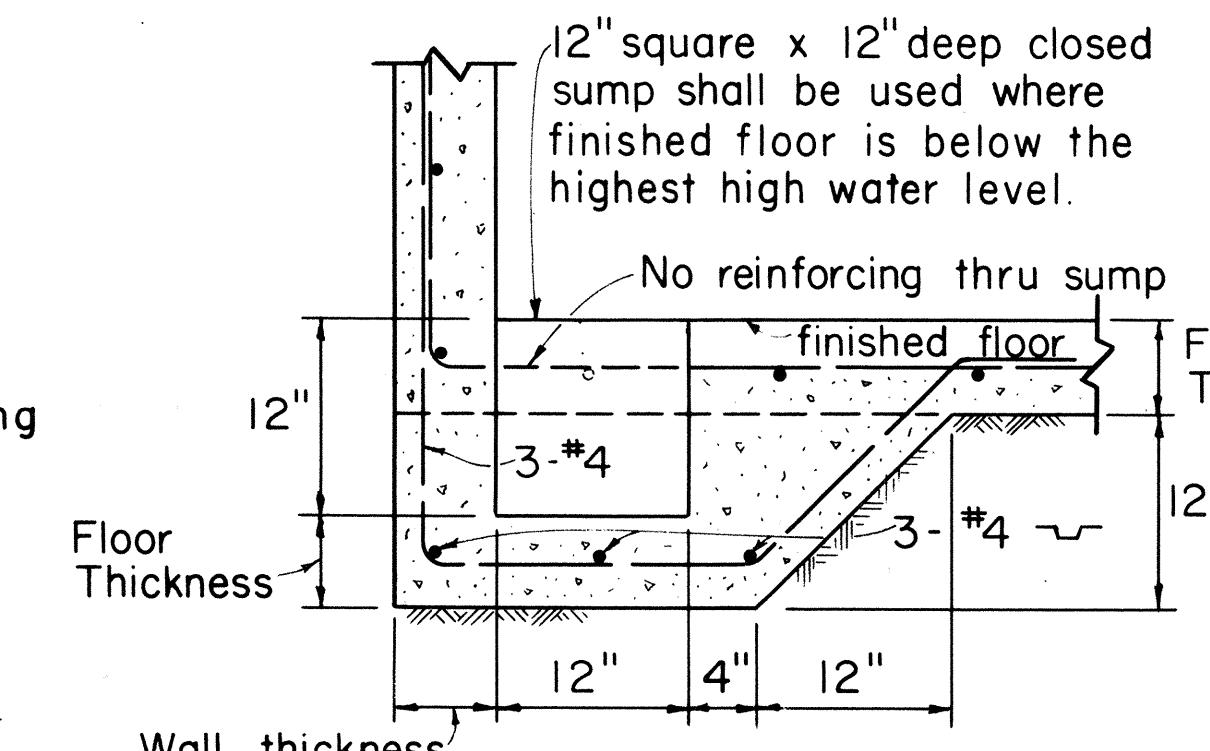

SECTION

CLOSED SUMP

Scale: 1" = 1'-0"

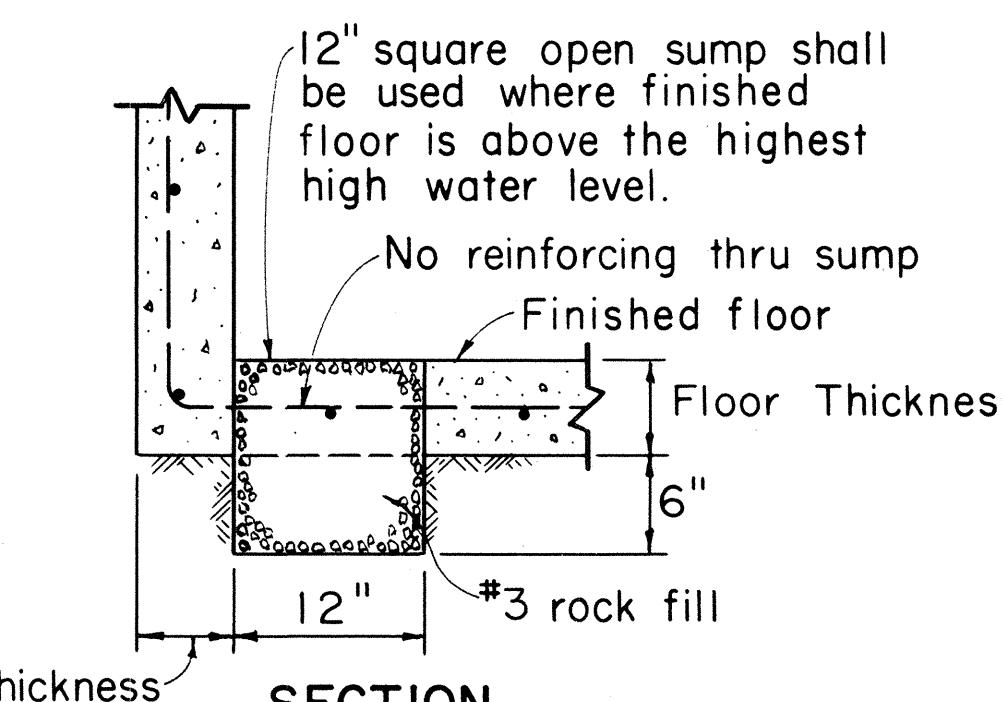

SECTION

OPEN SUMP

Scale: 1" = 1'-0"
APPROVED:


J. Karunaratne
Hawaiian Electric Co., Inc.

HECo., Inc. Drawing Number	Sheet No. 1 of 2 Sheets
16688	Sheet No. 1 of 2 Sheets
STATE OF HAWAII DEPARTMENT OF TRANSPORTATION LAND TRANSPORTATION FACILITIES DIVISION	



MISCELLANEOUS DETAILS
HANDHOLES & MANHOLES
UNDERGROUND STANDARDS

Scale as noted
SHEET No. OF SHEETS

FED. ROAD DIST. NO.	STATE	FED. AID PROJ. NO.	FISCAL YEAR	SHEET NO.	TOTAL SHEETS
HAWAII	HAW.	M-76001	1978	126	198

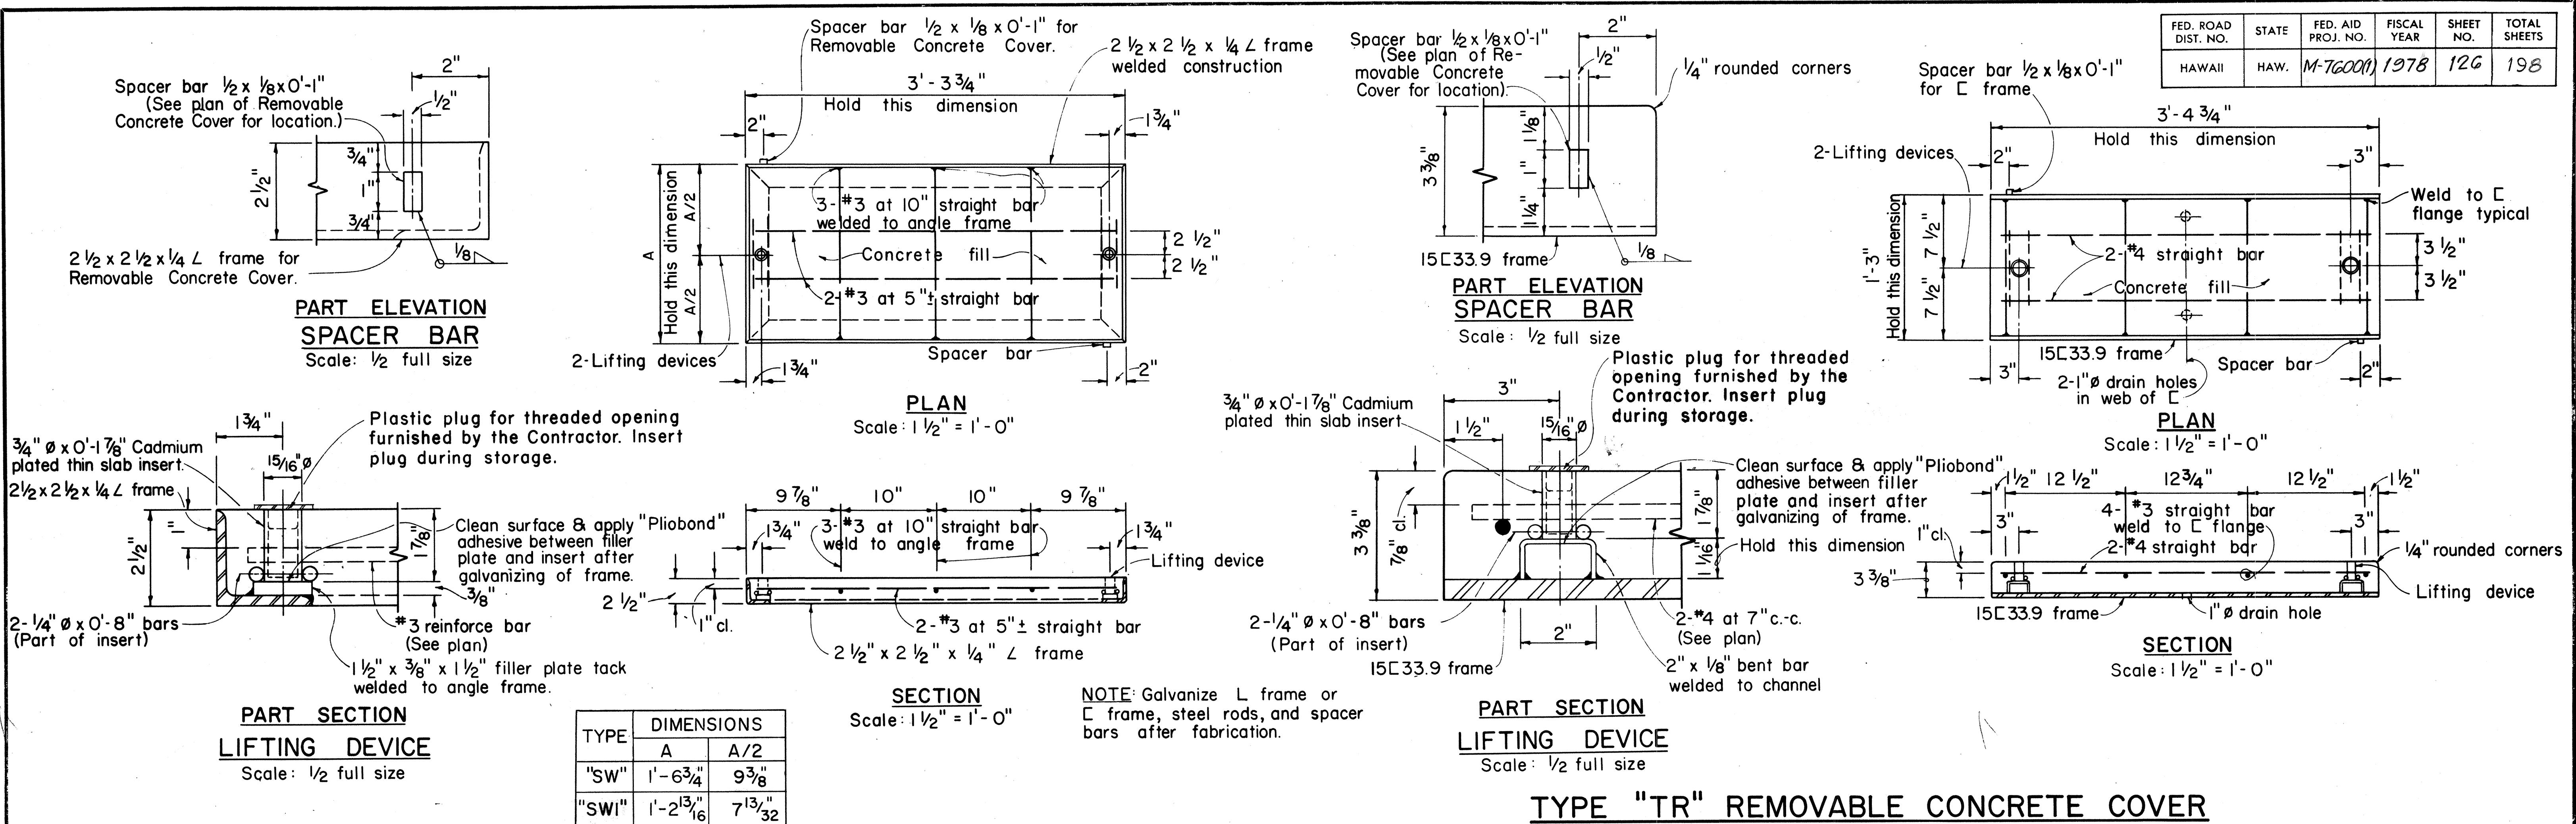


TYPE "TR" REMOVABLE CONCRETE COVER

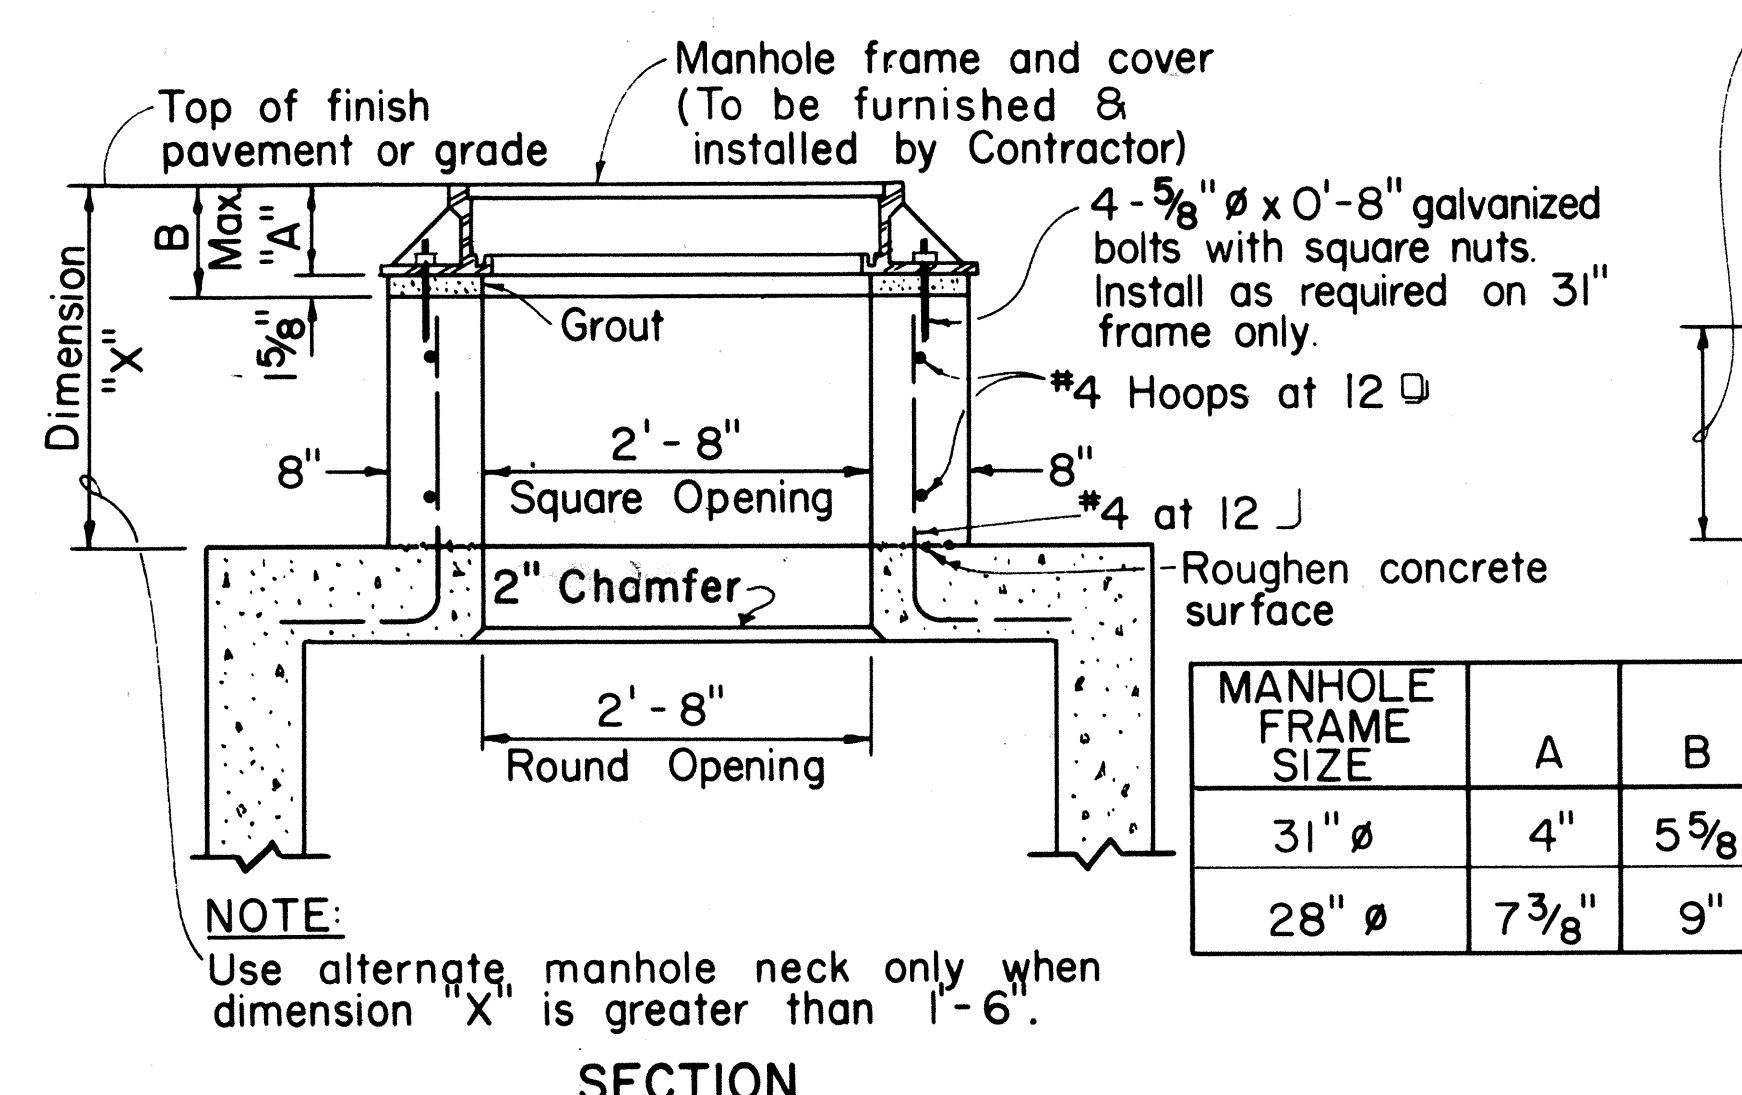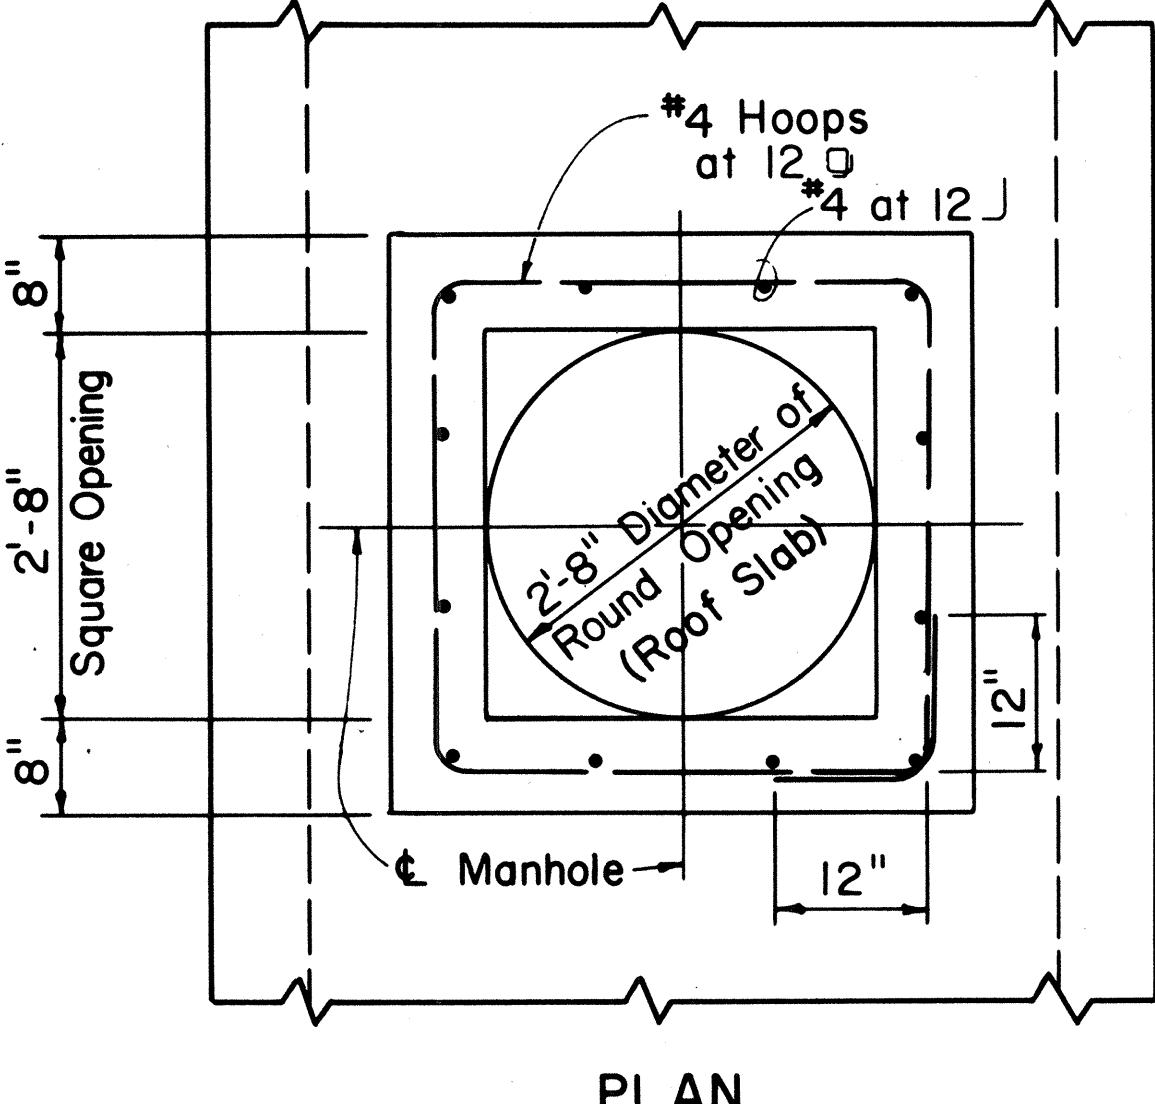

ALTERNATE MANHOLE NECK

Scale: 3/4" = 1'-0"

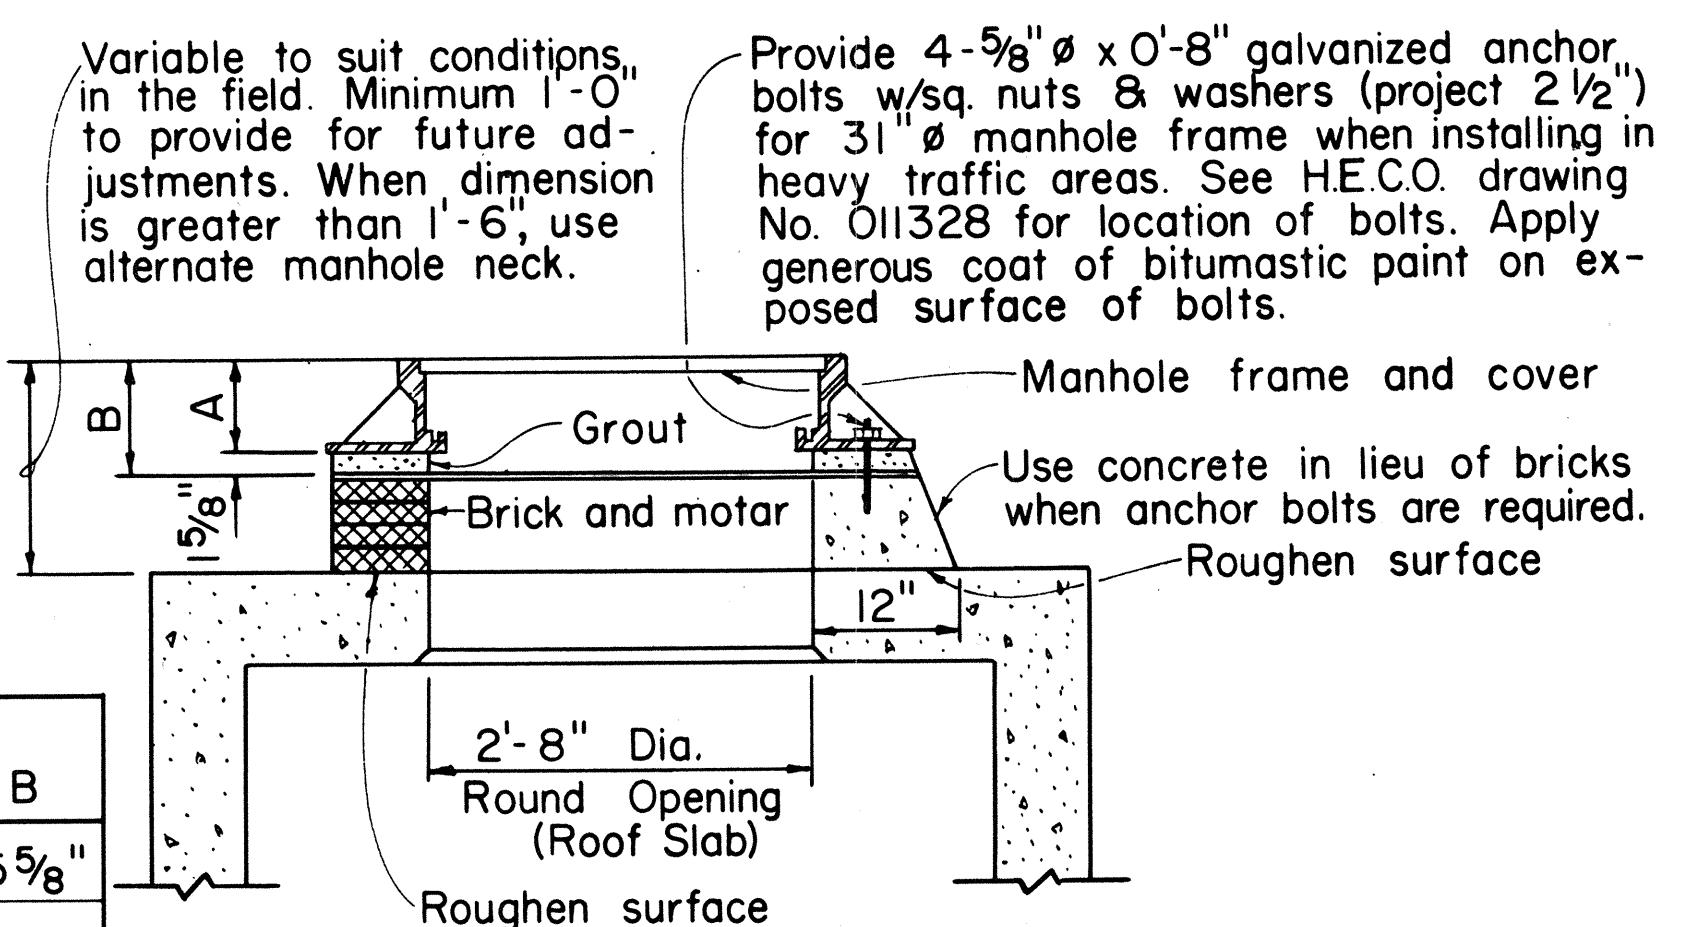

NOTE: See table alternate manhole neck detail for dimension A and B.

31" Ø & 28" Ø MANHOLE FRAME NECK DETAIL

Scale: 3/4" = 1'-0"

APPROVED:

EG M J Karunaratne
Hawaiian Electric Co., Inc.

7/6/78
Date

Scale as noted



SHEET NO. OF SHEETS

HECo., Inc. Drawing Number
16688
SHEET NO. 2
OF 2 SHEETS

STATE OF HAWAII
DEPARTMENT OF TRANSPORTATION
LAND TRANSPORTATION FACILITIES DIVISION

MISCELLANEOUS DETAILS
HANDHOLES & MANHOLES
UNDERGROUND STANDARDS

FED. ROAD DIST. NO.	STATE	FED. AID PROJ. NO.	FISCAL YEAR	SHEET NO.	TOTAL SHEETS
HAWAII	HAW.	M-7600(1)	1978	127	198

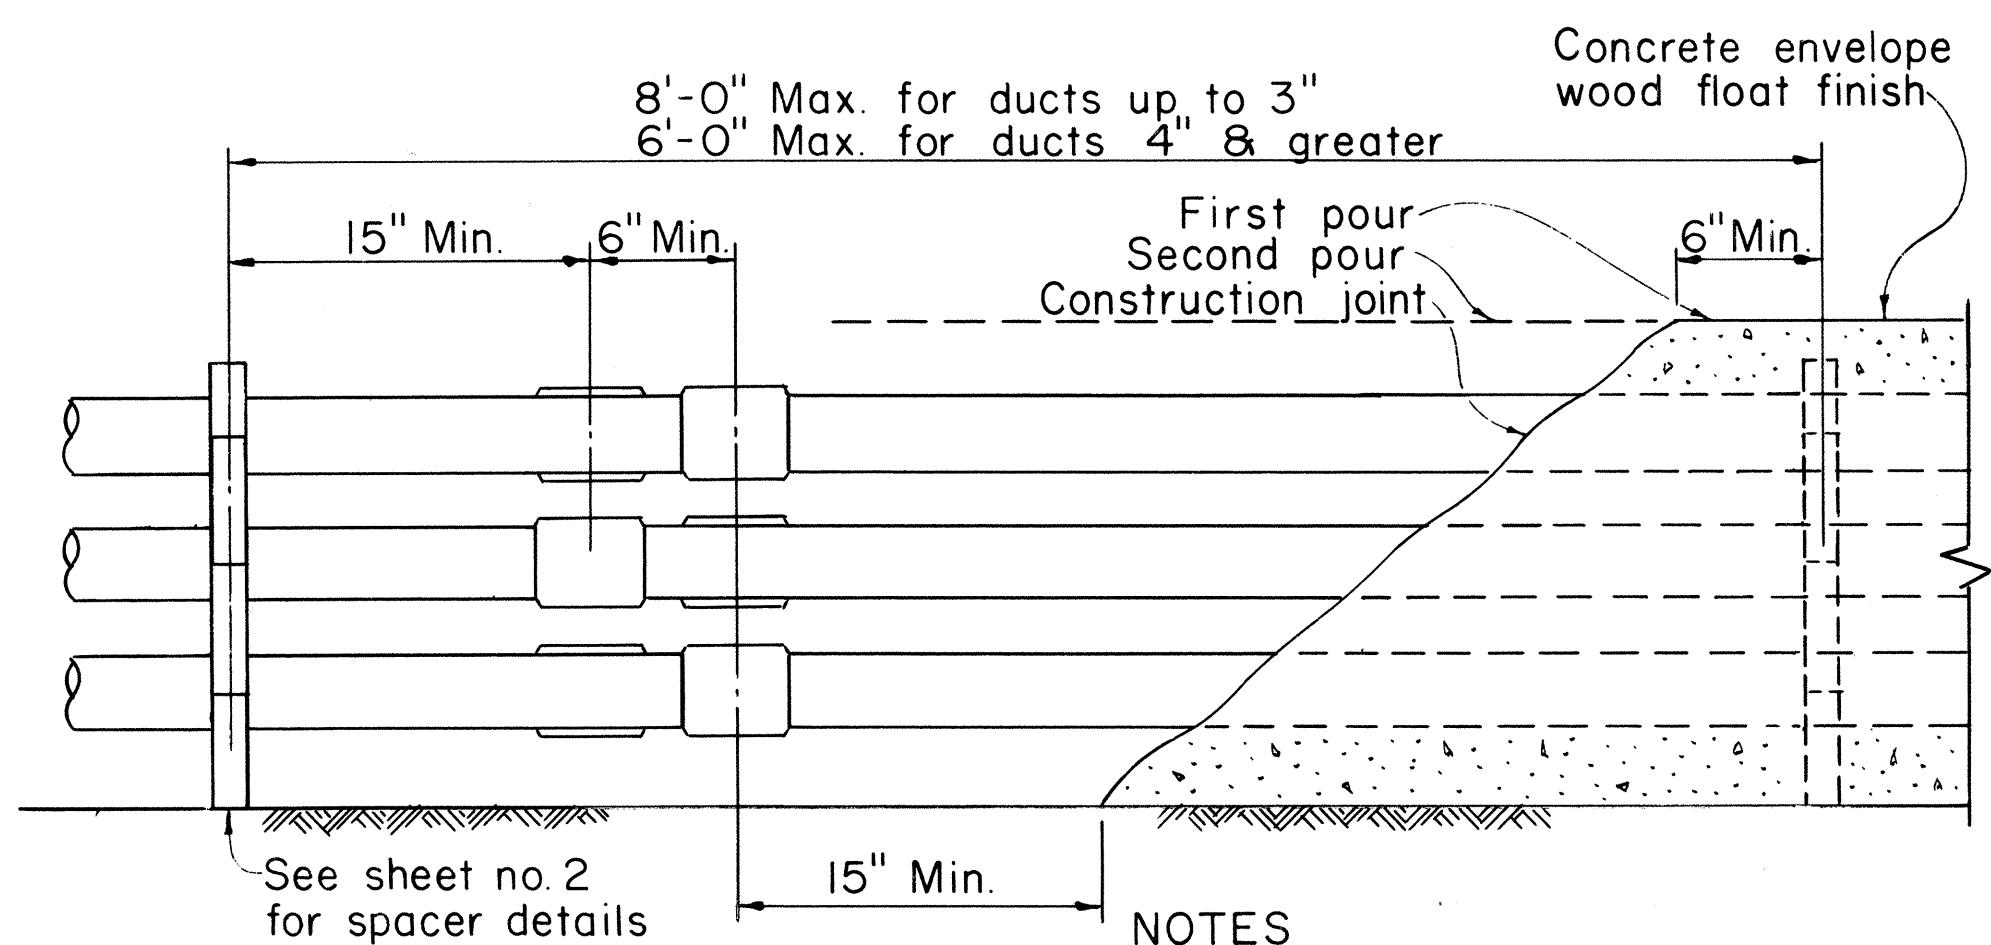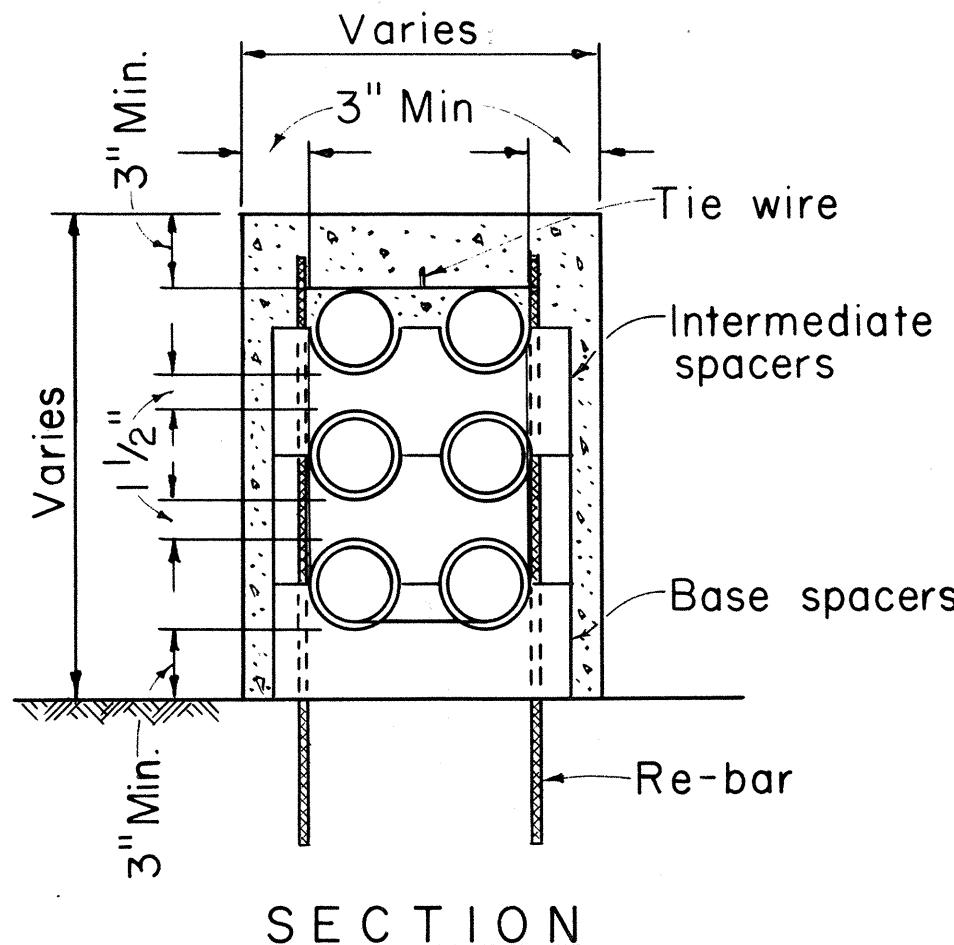


TYPICAL DUCT LINE

(6-WAY DUCT SHOWN)

Scale: $1\frac{1}{2}'' = 1'-0''$

- NOTES:
1. Stagger couplings (or belled ends).
 2. Anchor conduit with #14 steel tie wire & #4 reinforcing bars.
 3. Cement all joints.
 4. Avoid standing on conduit.

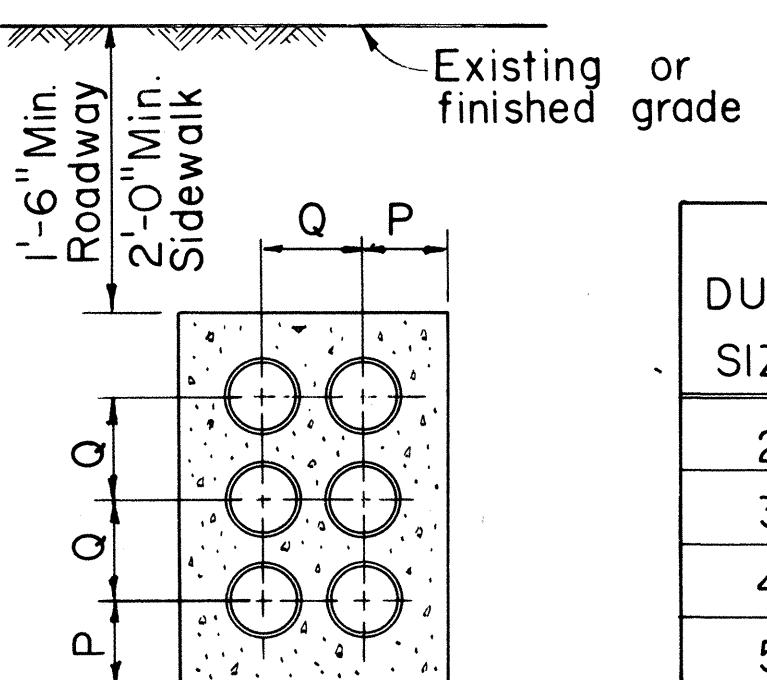


DUCT SIZE	DIMENSIONS (INCHES)	
	P	Q
2	$4\frac{1}{4}$	$4\frac{1}{8}$
3	$4\frac{3}{4}$	$5\frac{1}{8}$
4	$5\frac{1}{4}$	$6\frac{1}{4}$
5	$5\frac{7}{8}$	$7\frac{5}{8}$
6	$6\frac{5}{16}$	$8\frac{5}{8}$

EB TYPICAL DUCT SECTION


(6-WAY DUCT SHOWN)

Scale: $1'' = 1'-0''$

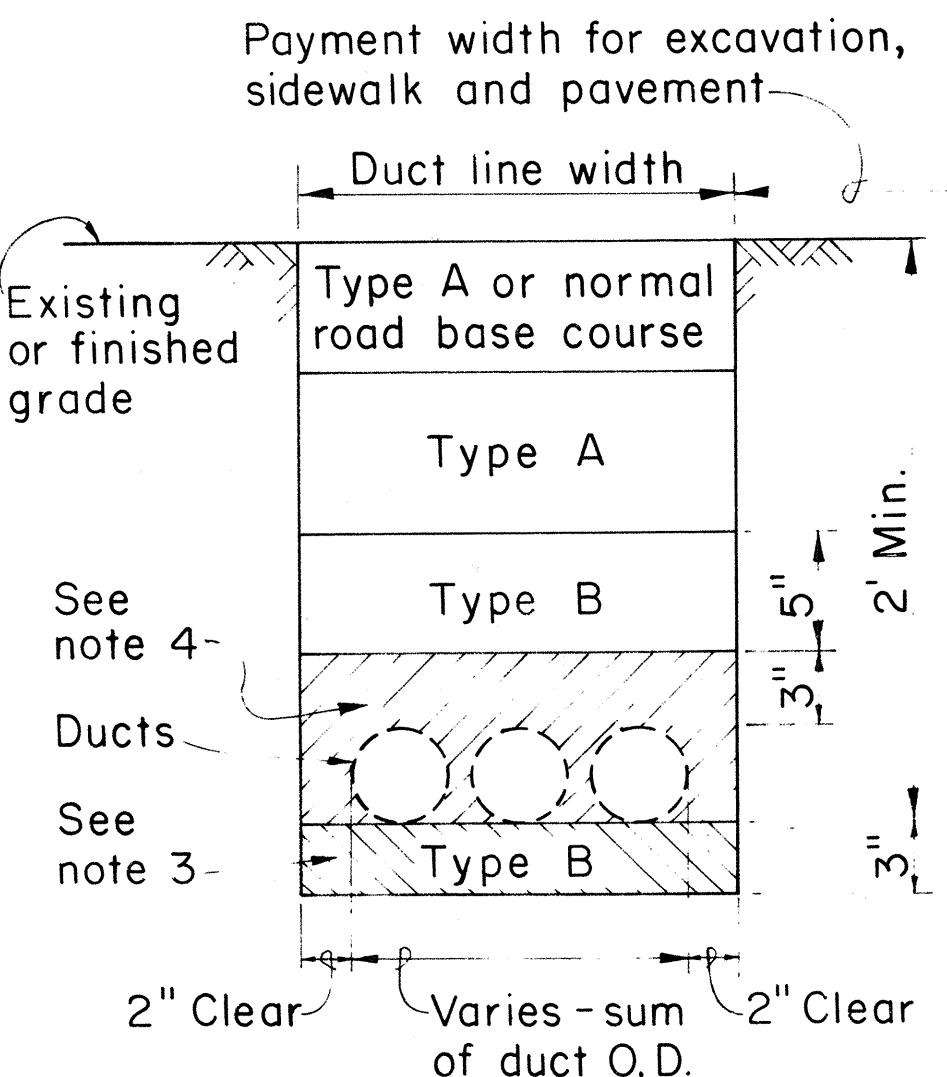


D.B. EXCAVATION & BACKFILL DETAILS (TYPICAL)

Scale $1\frac{1}{2}'' = 1'-0''$

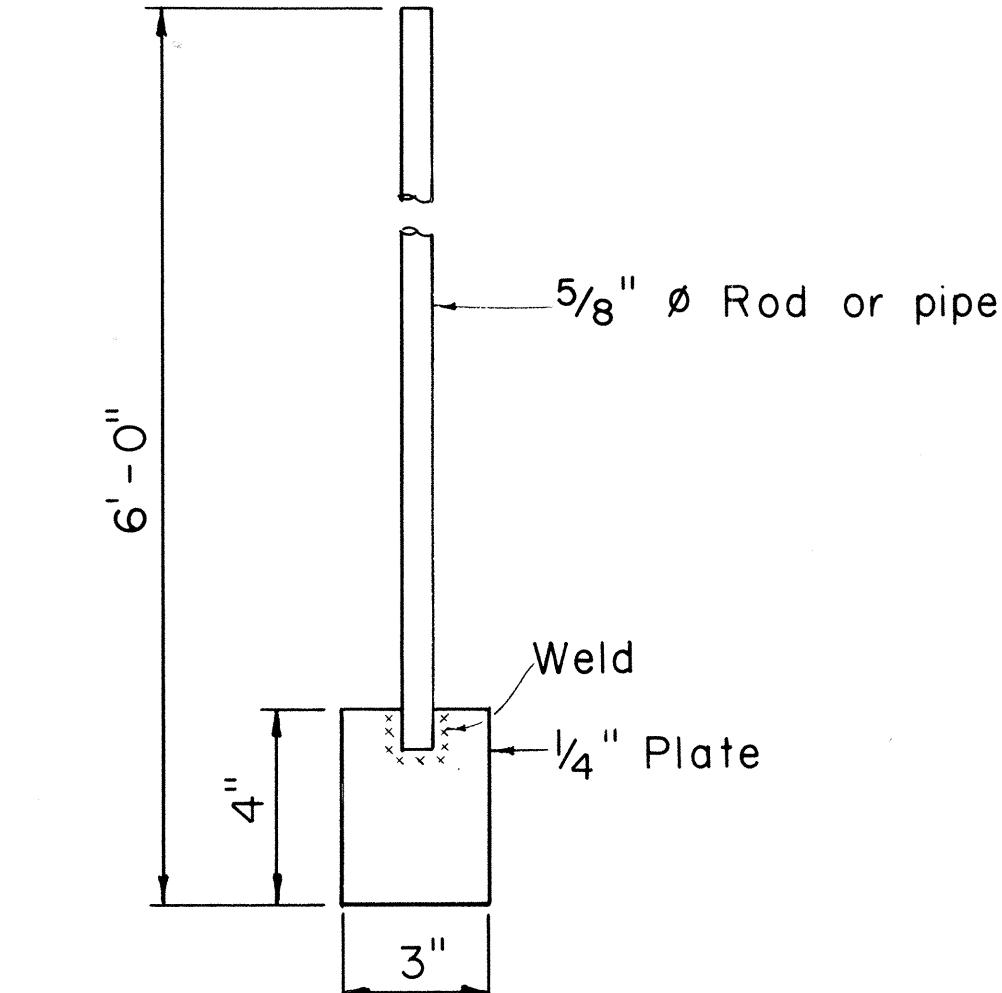

Scale: $3'' = 1'-0''$

Street pavement or finished grade

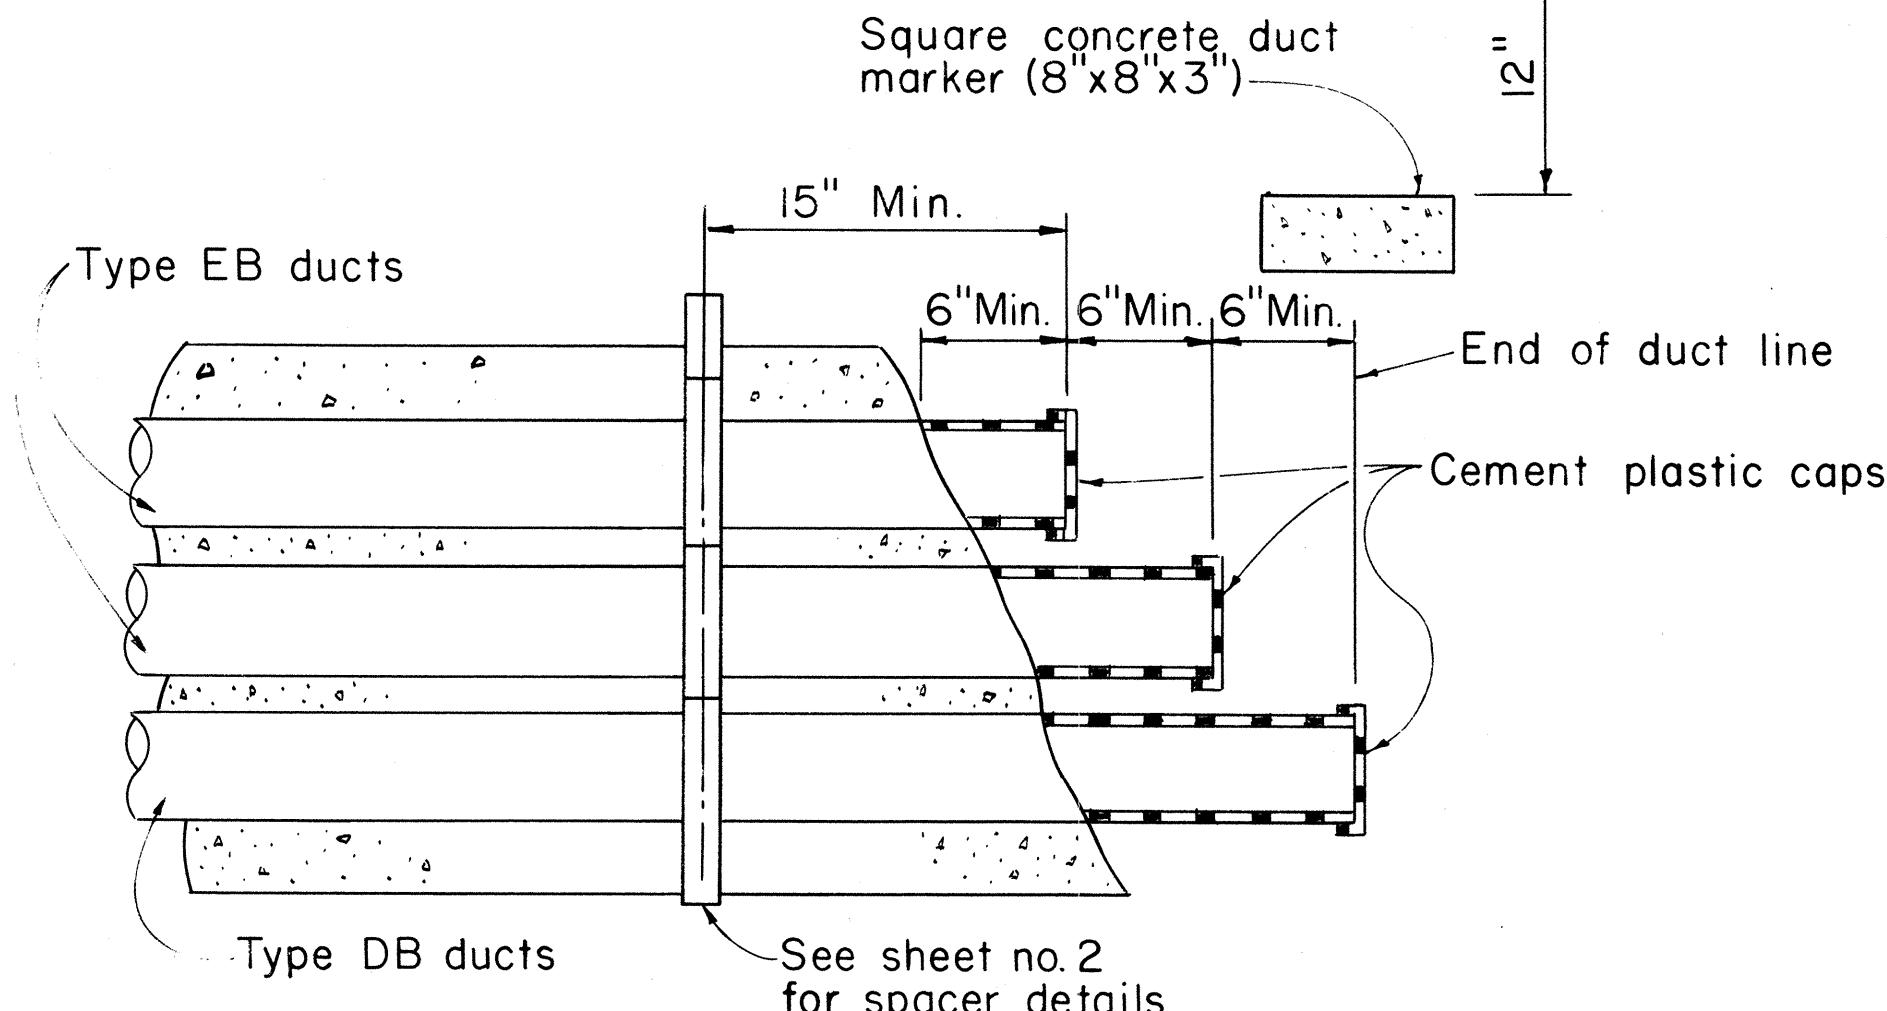

TYPICAL STUB OUT DETAIL

(6-WAY DUCT SHOWN)

Scale: $1\frac{1}{2}'' = 1'-0''$

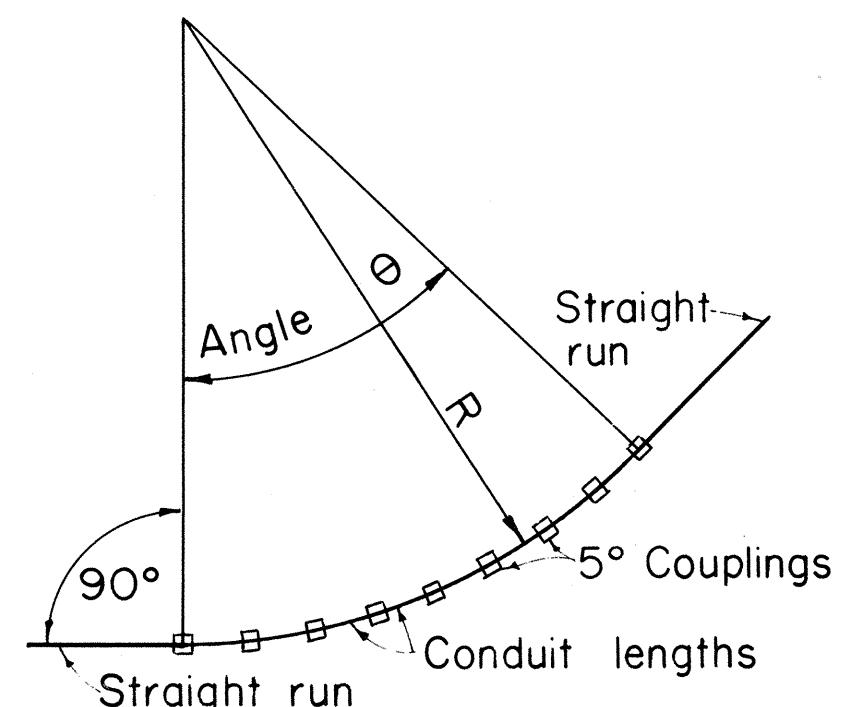


TABLE "A"	
APPROX. RADIUS OF BEND, R	LENGTH OF EA CONDUIT, FT USING 5° BEND AT COUPL.
11' - 6"	1
17' - 3"	1.5
23' - 0"	2
28' - 9"	2.5
34' - 6"	3
40' - 3"	3.5
46' - 0"	4
51' - 9"	4.5
57' - 6"	5
69' - 0"	6
80' - 6"	7
92' - 0"	8

ANGLE OF BEND θ	NO. OF COUPLINGS	LENGTH OF CONDUIT
15°	3	2
30°	6	5
45°	9	8
60°	12	11
75°	15	14
90°	18	17

EXAMPLE:

Radius of bend (R) = 60'
Angle of bend (θ) = 45°

From Table A, the nearest value to 60' radius is 57'-6". Length of conduit = 5'

From Table B, for 45° angle.
Number of couplings required = 9
Number of conduit lengths required = 8

METHOD OF FORMING CURVES:

There are 4 methods of forming curves with plastic conduit.

1. "Cold" bending: Limit trench formed radius sweeps to 25' minimum radius.
2. "Heat" bending: Do not heat bend conduit.
3. 5° angle couplings may be used as shown.
4. Factory made elbows and sweeps may be used only when specified by Engineer.

APPLICATION OF 5° COUPLING FOR LONG RADIUS BENDS

REFERENCE SPECIFICATION

- CS 7202 General Conditions
CS 7001 Construction of U.G. Facilities
CS 7003 Construction of Electrical Facilities

APPROVED:	<i>M. J. Karanots</i>	Date: 7/6/78
Hawaiian Electric Co., Inc.		

HECO PURCHASE
SPECIFICATION NO.

GENERAL NOTES

- A. APPROVED CONDUIT MATERIALS
 - 1. Encased Burial (EB) Conduit
 - a) Asbestos Cement, Type I ----- M7005
 - b) ABS (Acrylonitrile-Butadiene-Styrene) Plastic Conduit, Type EB ----- M7001
 - c) PVC (Polyvinyl Chloride) Plastic Conduit, Type EB ----- M7001
 - d) PVC Plastic Conduit, Schedule 40 ----- 116
 - See note 3 EB Typical Duct Section
2. Direct Burial (DB) Conduit
 - a) ABS Plastic Conduit, Type DB ----- M7001
 - b) PVC Plastic Conduit ----- M7001
 - c) PVC Plastic Conduit, Schedule 40 ----- 116
- B. This drawing provides details for installing Plastic Ducts (ABS & PVC) only. Refer to drawing 30-1030 & 30-1033 for installing Asbestos Cement Ducts Encased Burial.


HECo., Inc. Drawing Number
30-1035 SHEET No. 1
OF 2 SHEETS

STATE OF HAWAII
DEPARTMENT OF TRANSPORTATION
LAND TRANSPORTATION FACILITIES DIVISION


STANDARD DETAILS

PLASTIC DUCTS
INSTALLATION DETAILS
UNDERGROUND STRUCTURES

Scale as noted
SHEET No. OF SHEETS

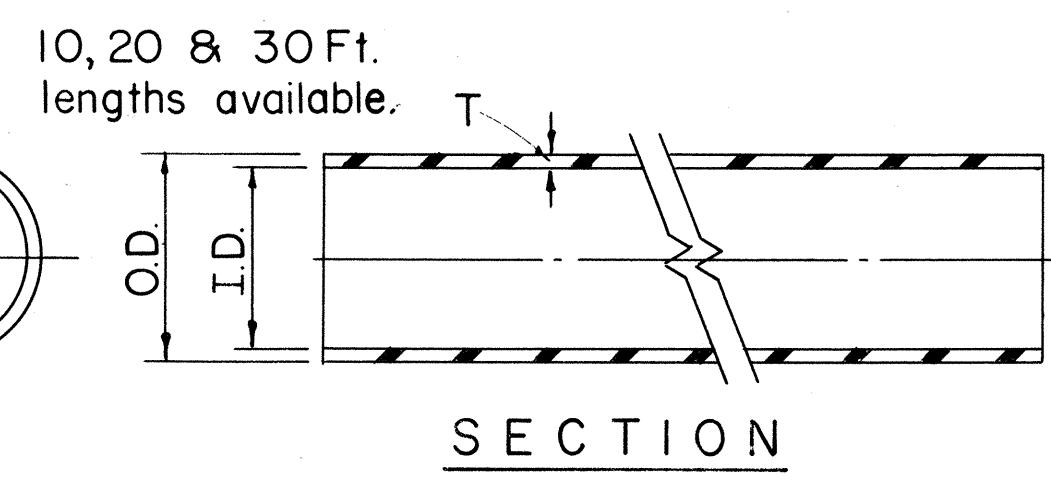


CONDUIT

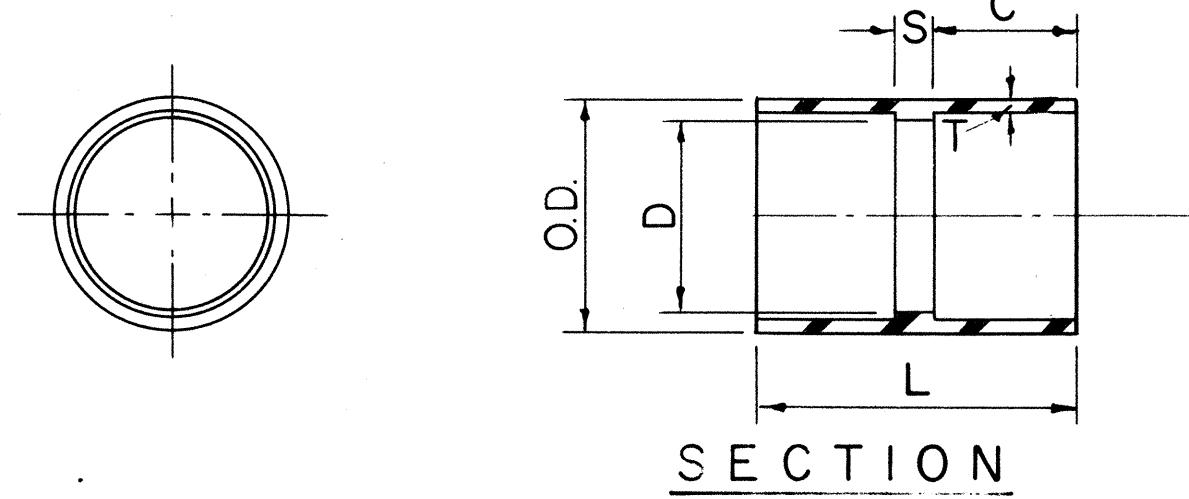

COUPLING (ASTM D-2750)


SIZE	HECO CODE	O.D.	I.D.	L	C	S	T
2		2,620	2,255	2 7/16	1.16	.110	.110
3		3,780	3,350	3 3/8	1.63	.120	.125
4		4,855	4,310	3 11/16	1.78	.120	.160
5		5,965	5,363	4 3/32	1.97	.160	.180
6		7,050	6,375	4 15/32	2.16	.160	.190

ADAPTER - PLASTIC TO STEEL

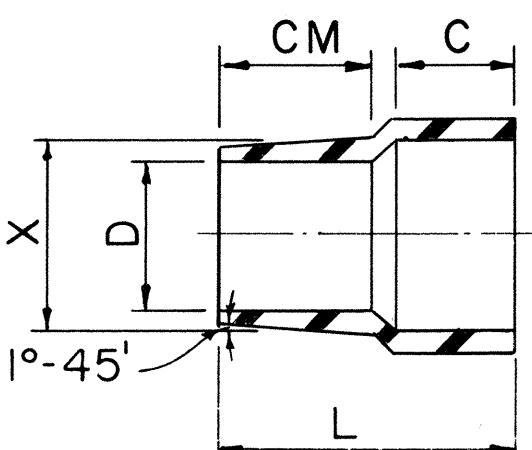

ADAPTER - PLASTIC TO ASBESTOS CEMENT


SIZE	HECO CODE	L	X	C.M.	D	C
2		3 1/16	2,580	1 3/4	2.18	1.16
3		3 19/32	3,620	1 3/4	3.09	1.63
4		4 1/32	4,620	2	4.03	1.78
5						

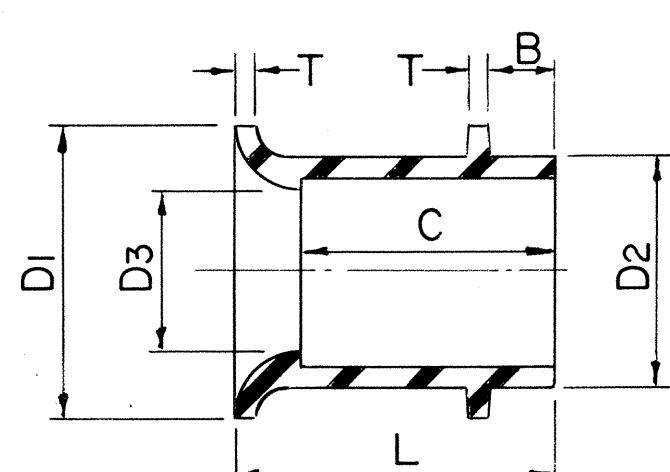

END BELL (ASTM D-2750)

SIZE	HECO CODE	D	C	L	T
2		2.52	.59	.65	.060
3		3.68	.81	.89	.075
4		4.725	.91	1.01	.095
5		5.805	1.00	1.10	.100
6		6.920	1.13	1.25	.125

CAP (RIGID) - FOR SEMI-PERMANENT USE (ASTM D-2750)

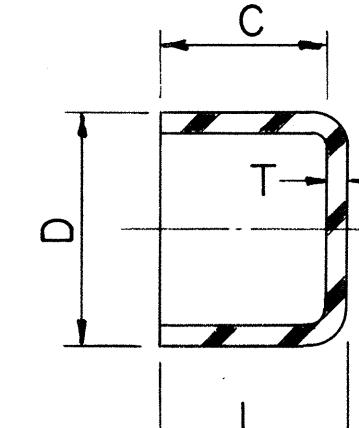


E B (ENCASED BURIAL)				DB (DIRECT BURIAL)						
CONDUIT SIZE	HECO CODE	O.D.	I.D.	T (MIN.)	WEIGHT #/10 ² FT.	HECO CODE	O.D.	I.D.	T (MIN.)	WEIGHT #/10 ² FT.
2		2,375	2.25	.060	.21	29010	2,375	2.15	.110	.38
3		3,500	3.35	.075	.39	29012	3,500	3.25	.125	.64
4		4,500	4.31	.095	.63	29014	4,500	4.18	.160	1.04
5		5,563	5.36	.100	.82	29016	5,563	5.20	.180	1.46
6		6,625	6,375	.125	1.21		6,625	6.25	.190	1.82

NOTE: Type EB & DB Conduits have same O.D. for a given size. All fittings which go over Conduits are DB type & fit both types of Conduits.

SIZE	HECO CODE	O.D.	D	L	C	S	T
2		2,620	2,255	2 7/16	1.16	.110	.110
3		3,780	3,350	3 3/8	1.63	.120	.125
4		4,855	4,310	3 11/16	1.78	.120	.160
5		5,965	5,363	4 3/32	1.97	.160	.180
6		7,050	6,375	4 15/32	2.16	.160	.190

DUCT SPACER COMPONENTS (FORMEX SPACER OR EQUIVALENT)

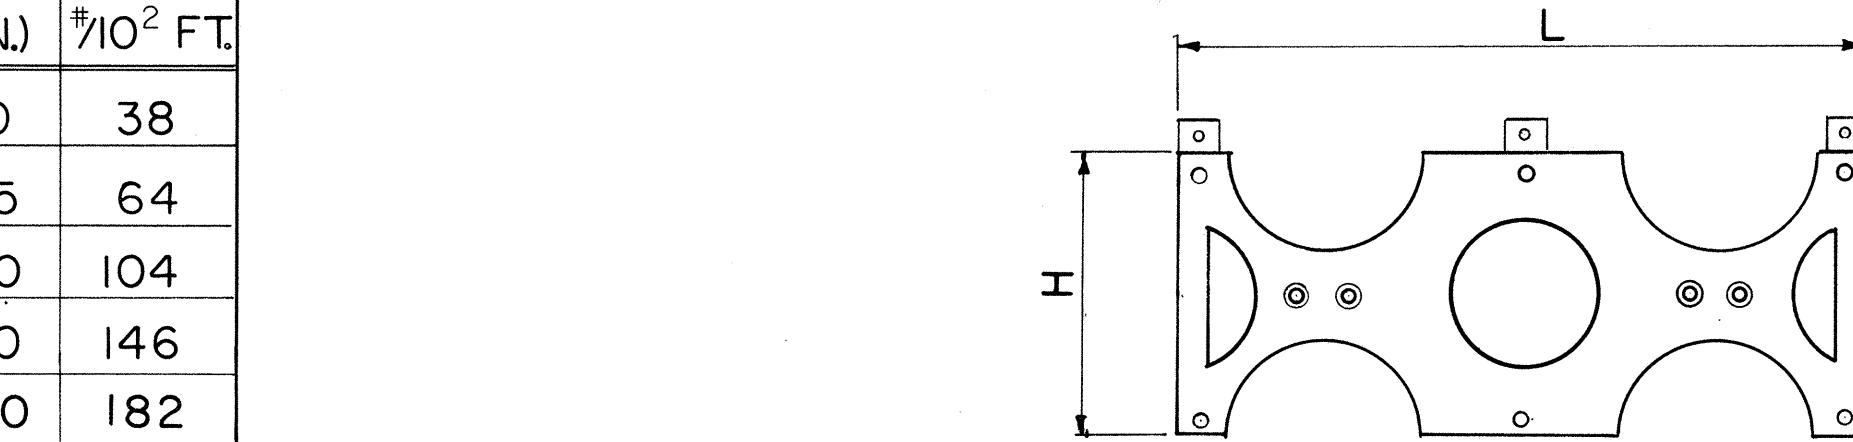

INTERMEDIATE


SIZE	HECO CODE	L	H
2		9.50	1.75
3		11.25	2.25
4		13.75	3.13
5		15.87	3.63
6		18.0	4.25

CAP SPACER

BASE SPACER

DUCT SPACER

COMPONENTS (FORMEX SPACER OR EQUIVALENT)

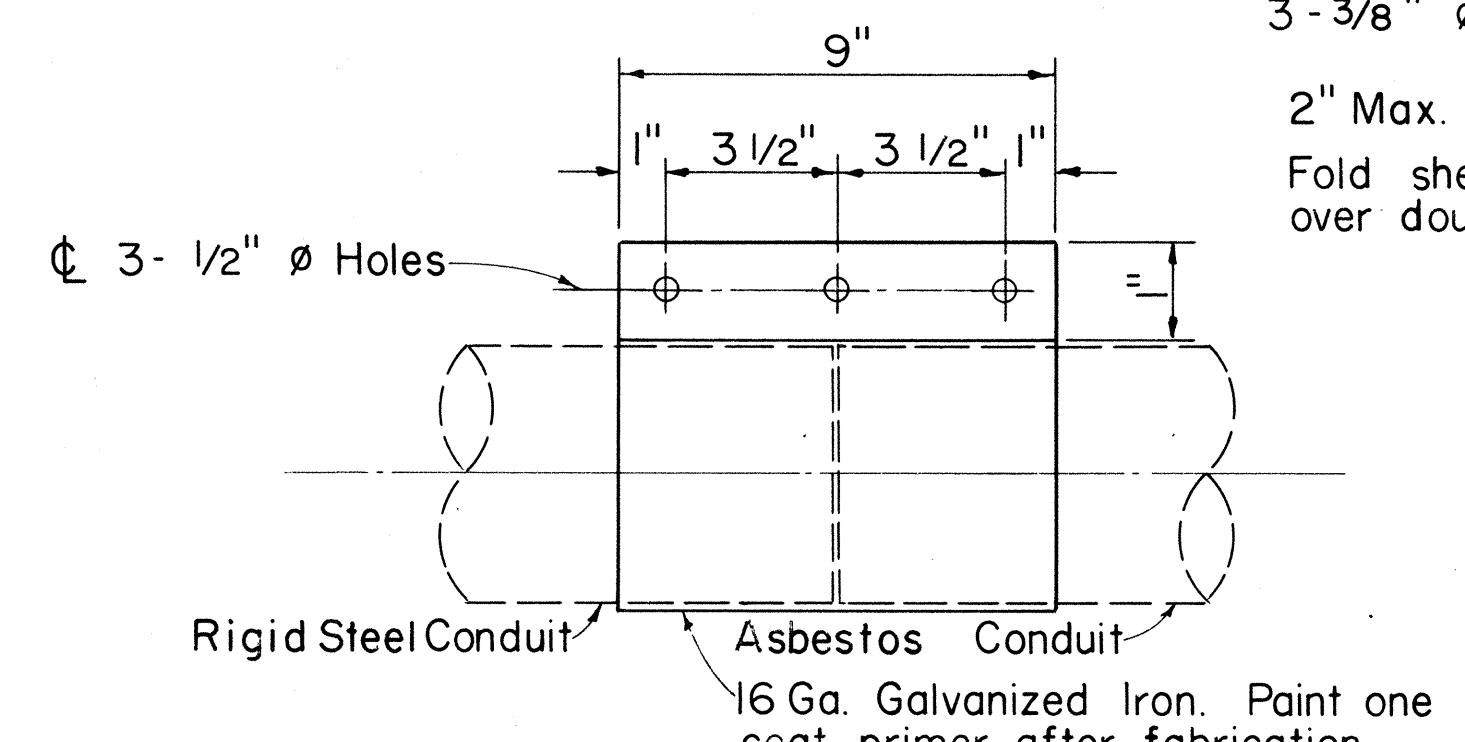

1-Piece 16 Ga. Galvanized Sheet Metal - 2" x 9" inserted inside bolting flange, bent to match curvature.

SIZE	HECO CODE
2	I3I26
3	I3I28
4	I3I30
5	I3I32
6	

NOTE: D = Duct I.D. + 1/2"

16 Ga. Galvanized Iron. Paint one coat primer after fabrication.

3 - BOLT CLAMP

GENERAL NOTES:

- All dimensions in inches.
- Spacers shown are different than that used for Asbestos Cement Type.
- These accessories are to be used with ABS (Acrylonitrile-Butadiene - Styrene), or PVC (Poly-Vinyl Chloride) Plastic Conduit, per HECO purchase specification M7001-O.

APPROVED:
as mg J Karan
Hawaiian Electric Co., Inc. Date
7/6/78

HECo., Inc. Drawing Number
30-1035 SHEET NO. 2 OF 2 SHEETS


STATE OF HAWAII
DEPARTMENT OF TRANSPORTATION
LAND TRANSPORTATION FACILITIES DIVISION

STANDARD DETAILS
PLASTIC DUCTS
INSTALLATION DETAILS
UNDERGROUND STRUCTURES

Note: Cap will go over conduit or "plug" the coupling.

Scales: Not to Scale
SHEET No. OF SHEETS

FED. ROAD DIST. NO.	STATE	FED. AID PROJ. NO.	FISCAL YEAR	SHEET NO.	TOTAL SHEETS
HAWAII	HAW.	M-7600(1)	1978	129	198

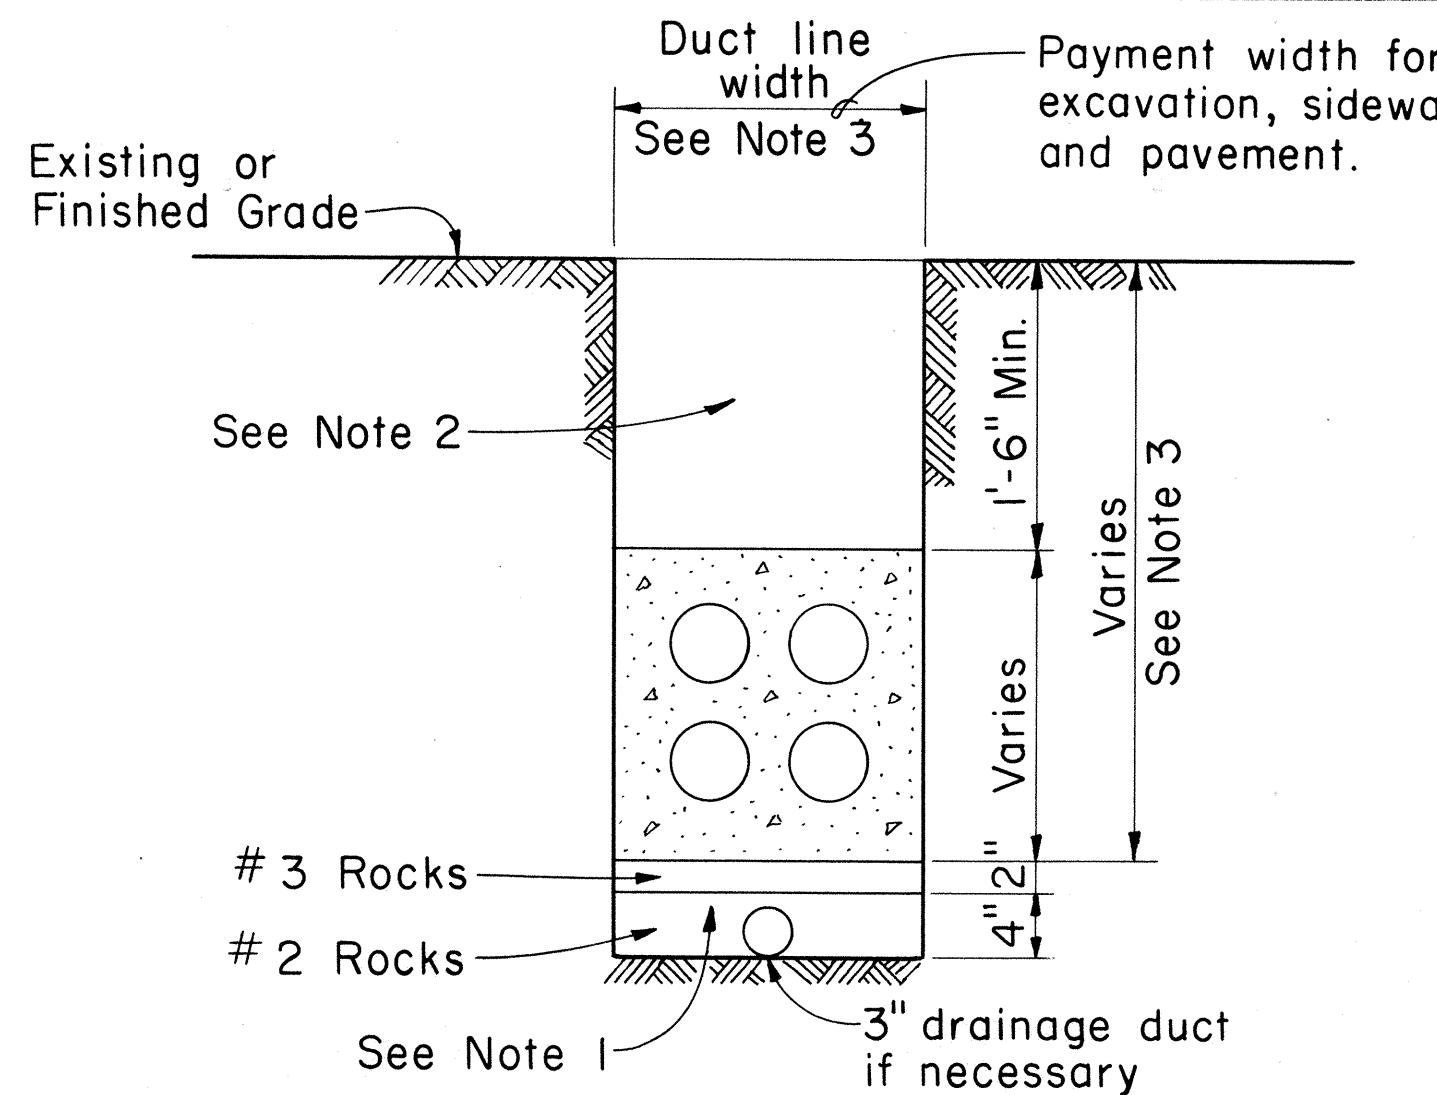



NOTES:

- If drainage is necessary, install 6" rockfill as shown. In extremely watery areas, install 3" drainage duct.
- Refer to H.E.Co. Specification CS7001-O (or equivalent) for backfill material requirements.
- Size of concrete envelope and depth of excavation to be determined by specific project.

EB EXCAVATION AND BACKFILL DETAILS

(TYPICAL)

Scale: $1\frac{1}{2}'' = 1'-0''$

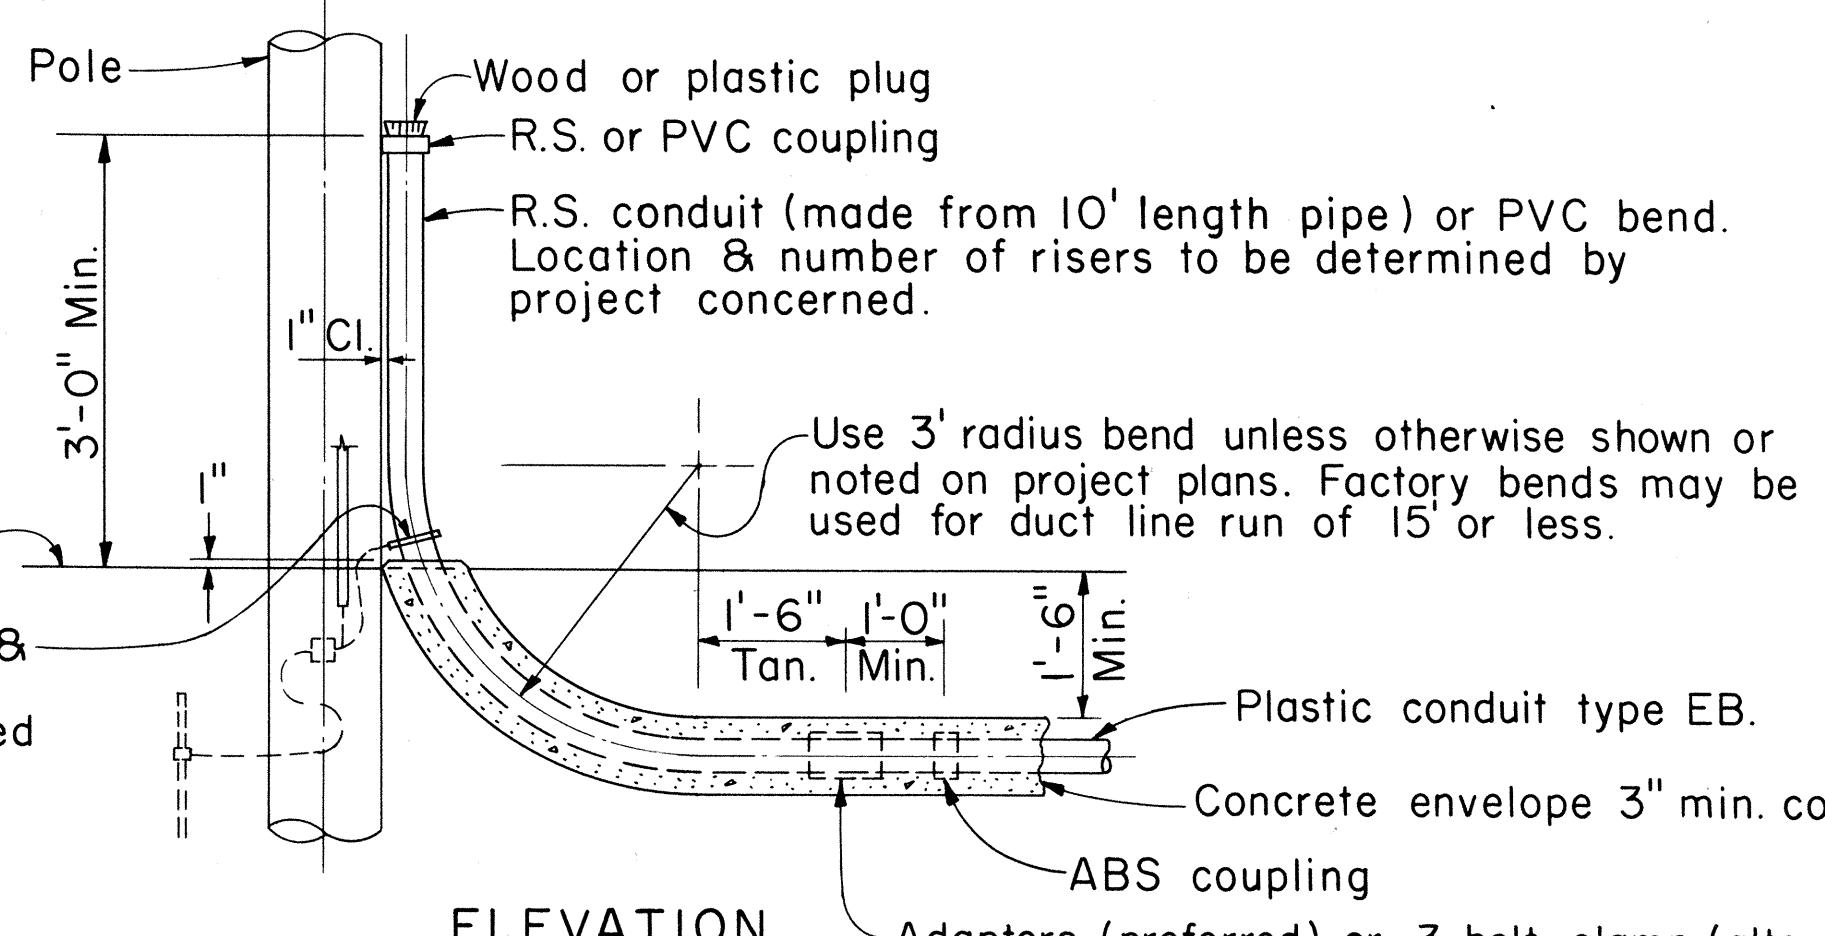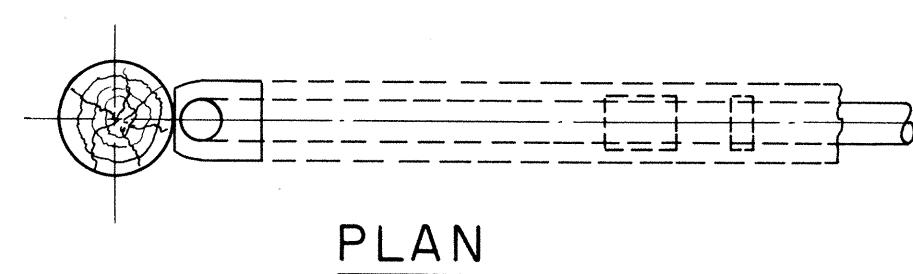


TYPICAL RISER DETAIL

(POLE RISER SHOWN)

Scale: $\frac{1}{2}'' = 1'-0''$

ORIGINAL SURVEY PLOTTED BY _____
DRAWN BY _____
TRACED BY _____
DESIGNED BY _____
QUANTITIES BY _____
CHECKED BY _____

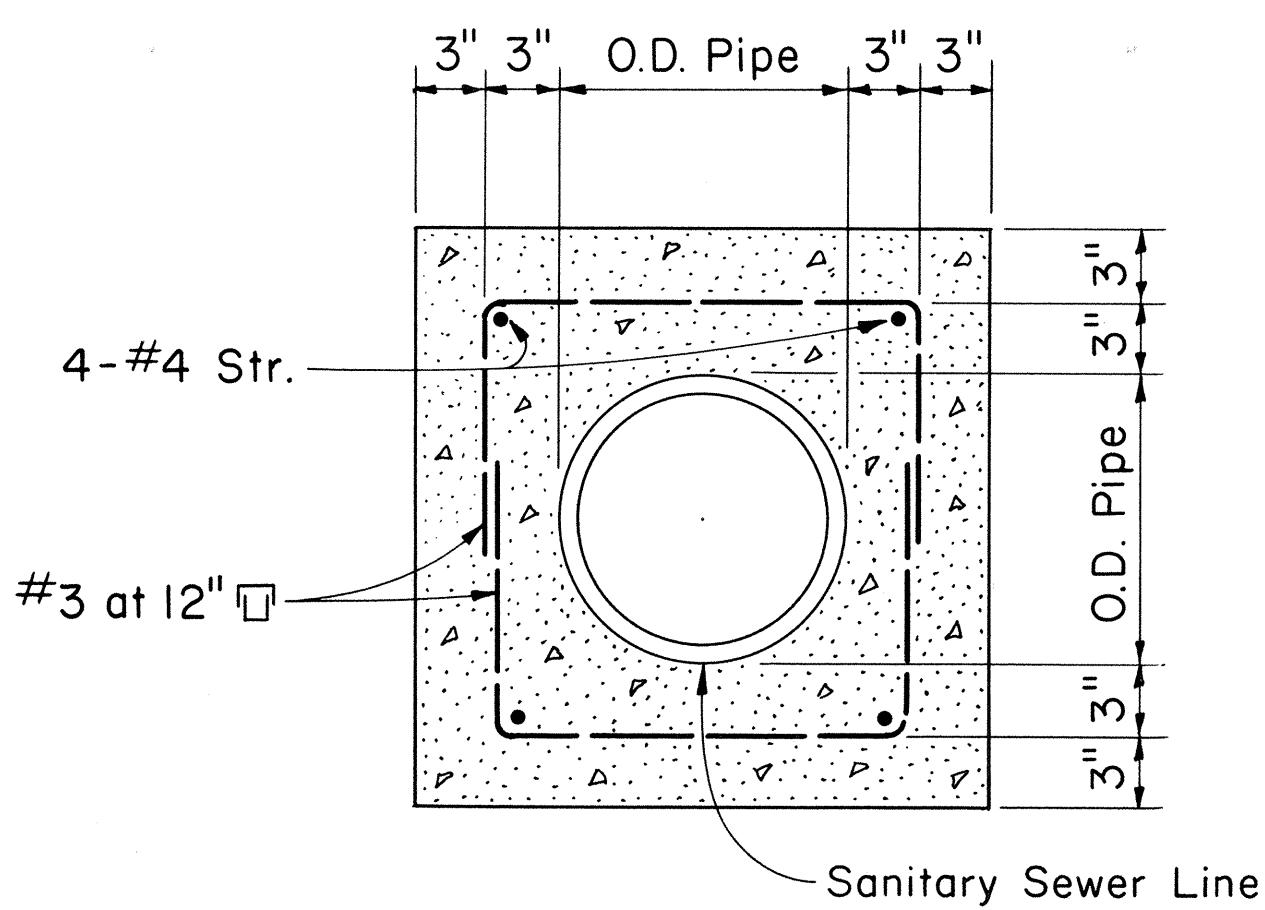

CROSS-SECTION OF SEWER LINE


NOTE:

Where duct line crosses sewer line, cover sewer line with concrete jacket as indicated in specification.

DUCT LINE WIDTH	LENGTH OF SEWER LINE TO BE COVERED
24" or less	5'
Greater than 24"	(Width of duct line) + (5')


SANITARY SEWER LINE CROSSING DETAIL

Scale: $1\frac{1}{2}'' = 1'-0''$

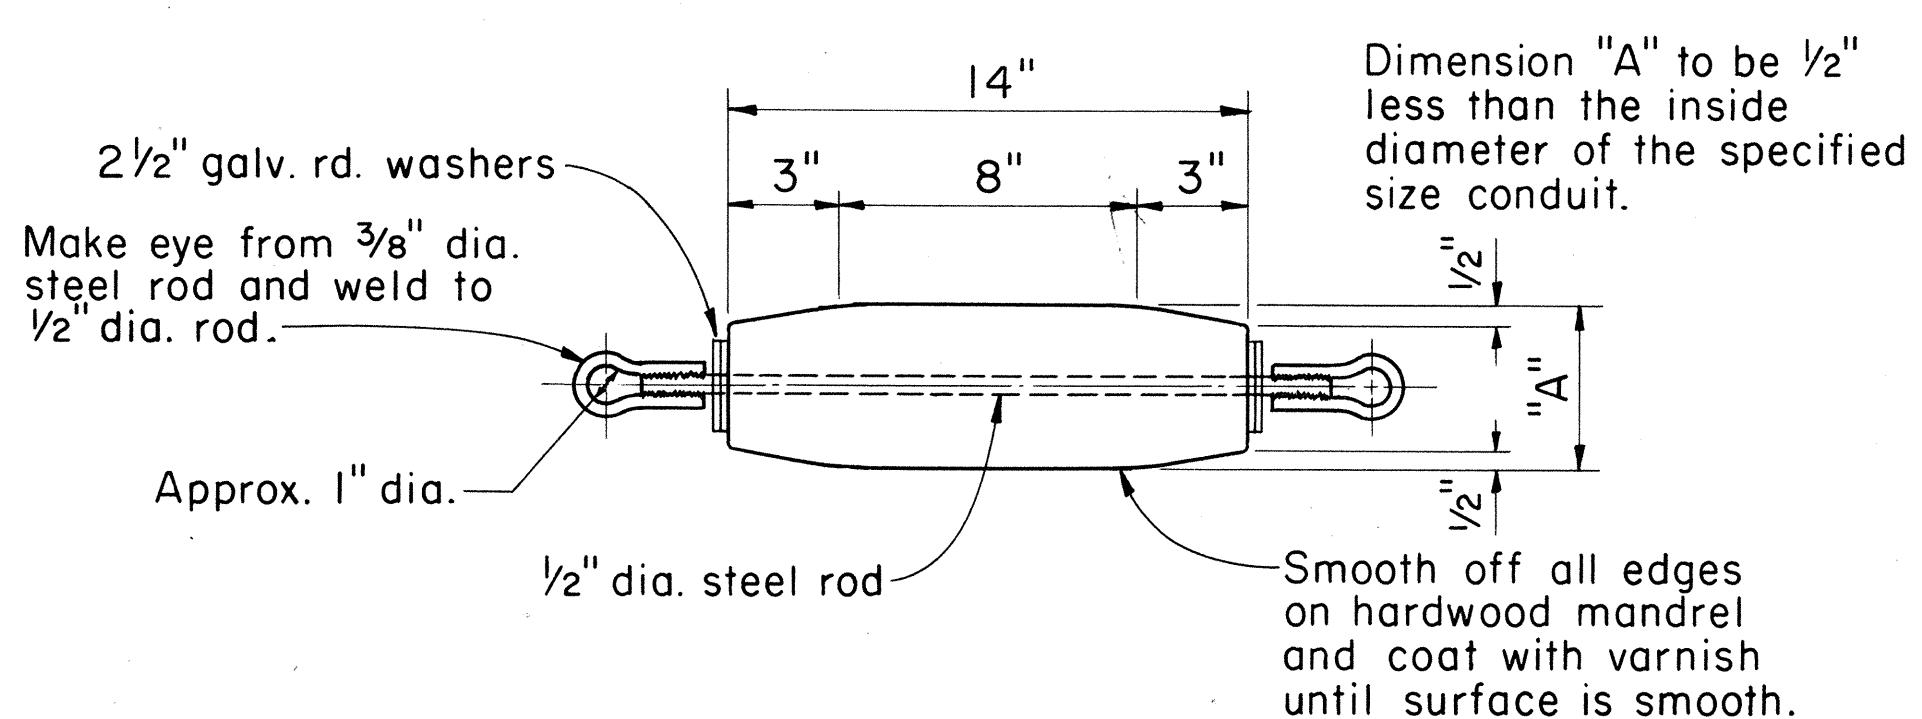

MANDREL DETAIL

Not To Scale

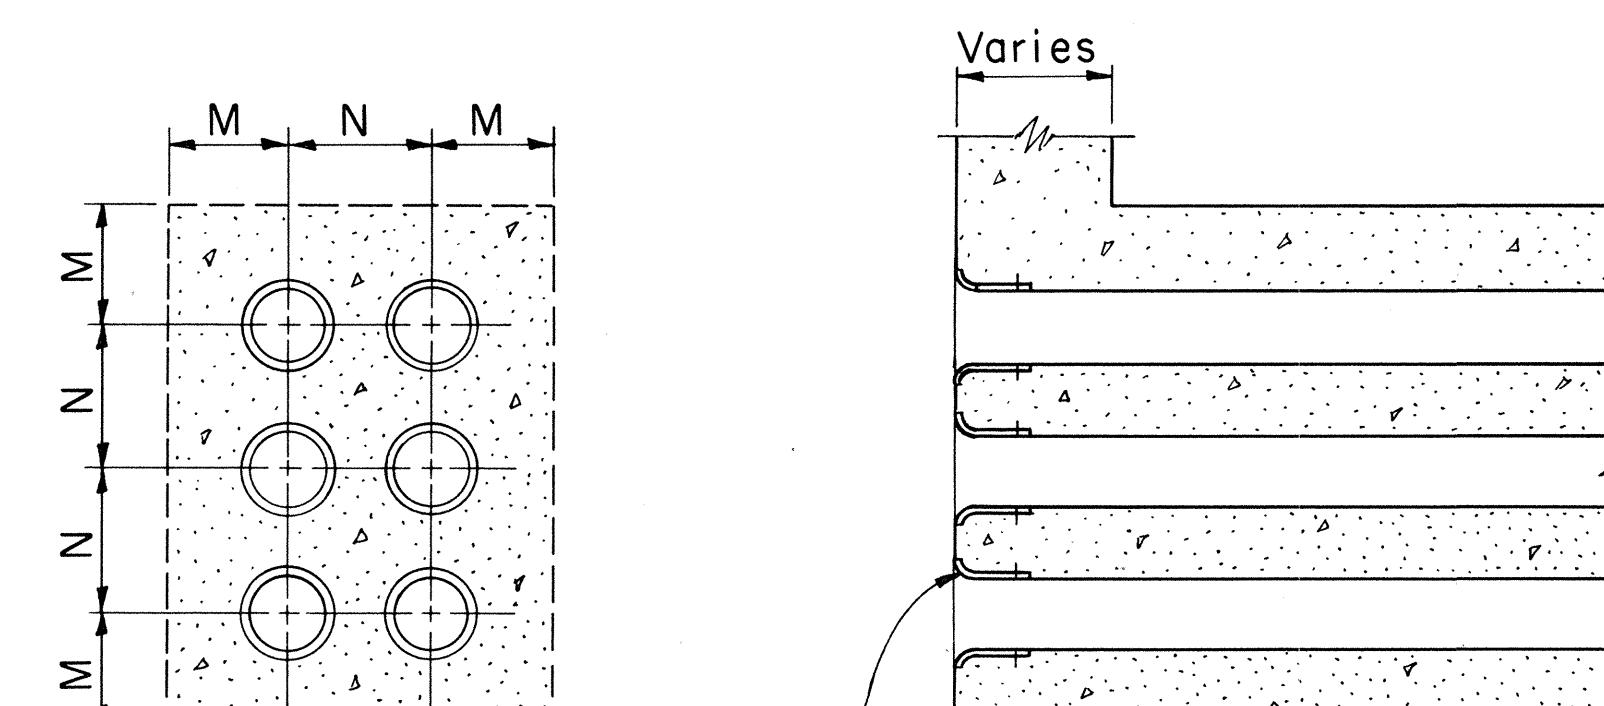

HAND SPADE

Scale: $3'' = 1'-0''$

DUCT SIZE	DIMENSIONS (INCHES)	
	M	N
2	4	5
3	5	6
4	5 1/2	7
5	6	8
6	6 5/16	9

APPROVED:
Les J. Karamatsu
Hawaiian Electric Co., Inc.

Date
7/6/78

HECo., Inc. Drawing Number

30-1030

STATE OF HAWAII
DEPARTMENT OF TRANSPORTATION
LAND TRANSPORTATION FACILITIES DIVISION


TYPICAL DUCT CONSTRUCTION
INSTALLATION DETAILS
UNDERGROUND DETAILS

Scale as noted
SHEET No. **129** OF SHEETS


TYPICAL CONDUIT ENTRANCE INTO HANDHOLE, MANHOLE OR VAULT WALLS

(6 WAY DUCT LINE SHOWN)


Scale: $1\frac{1}{2}'' = 1'-0''$

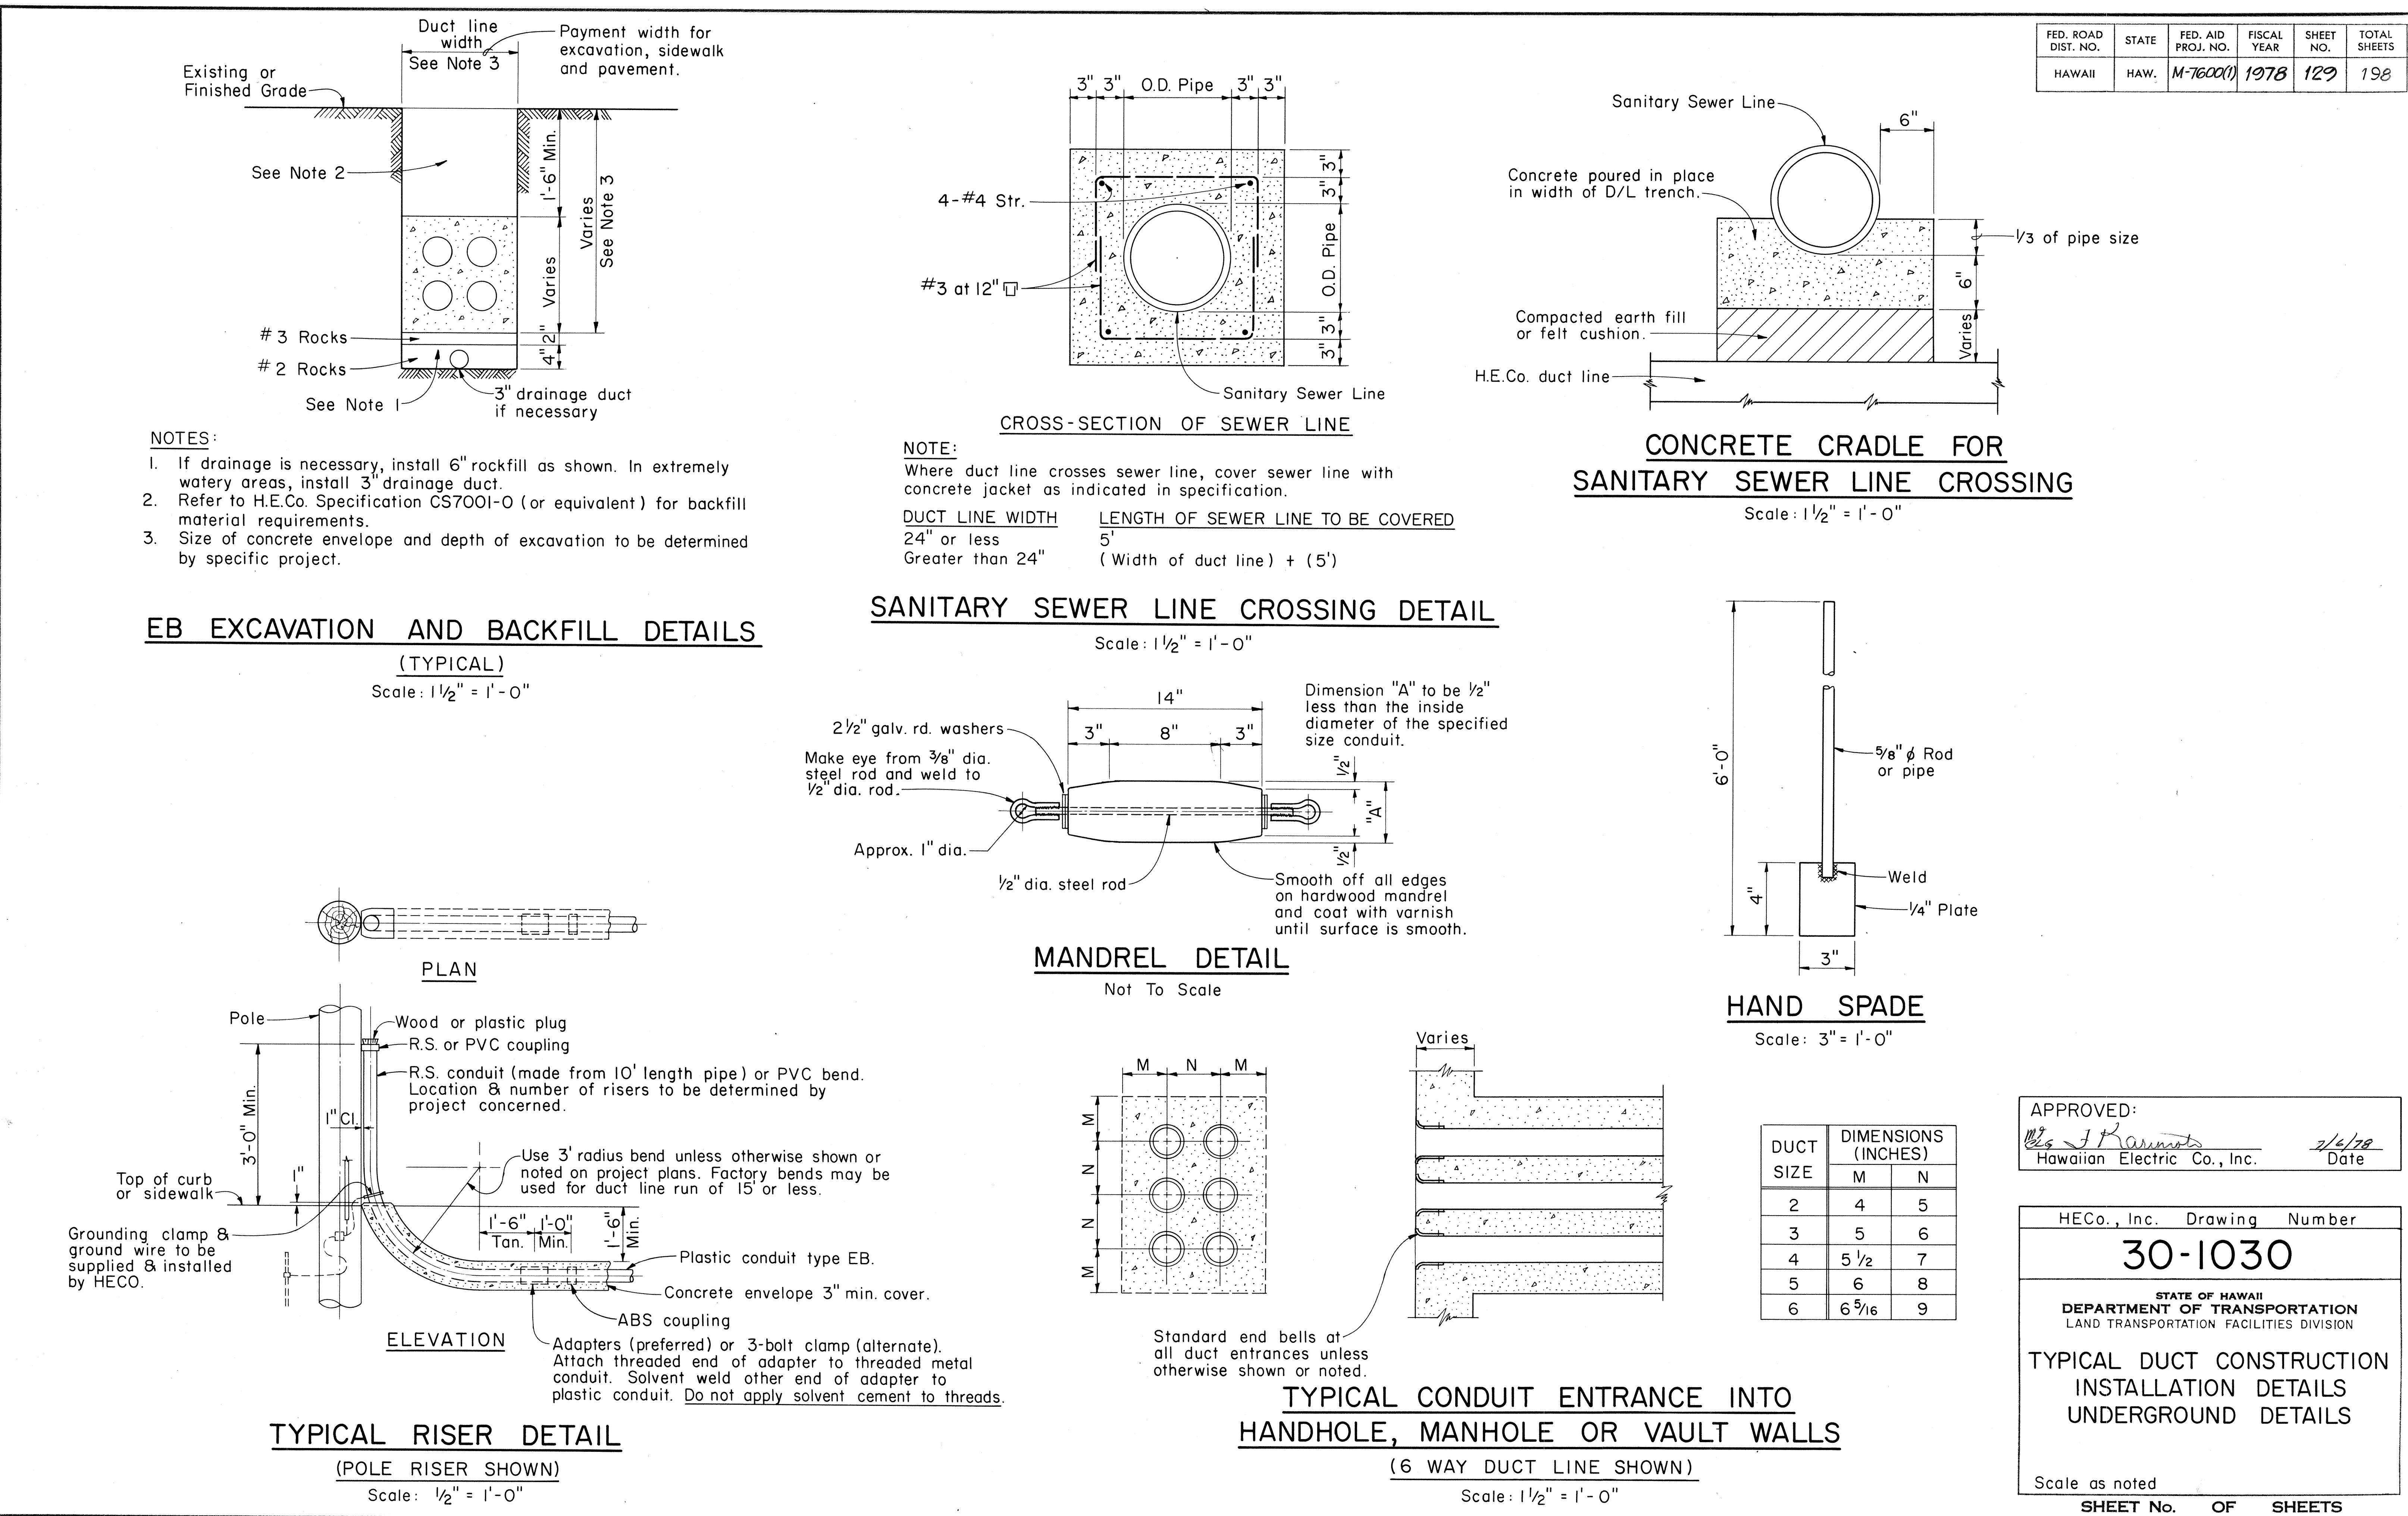


FED. ROAD DIST. NO.	STATE	FED. AID PROJ. NO.	FISCAL YEAR	SHEET NO.	TOTAL SHEETS
HAWAII	HAW.	M-7600(1)	1978	130	198

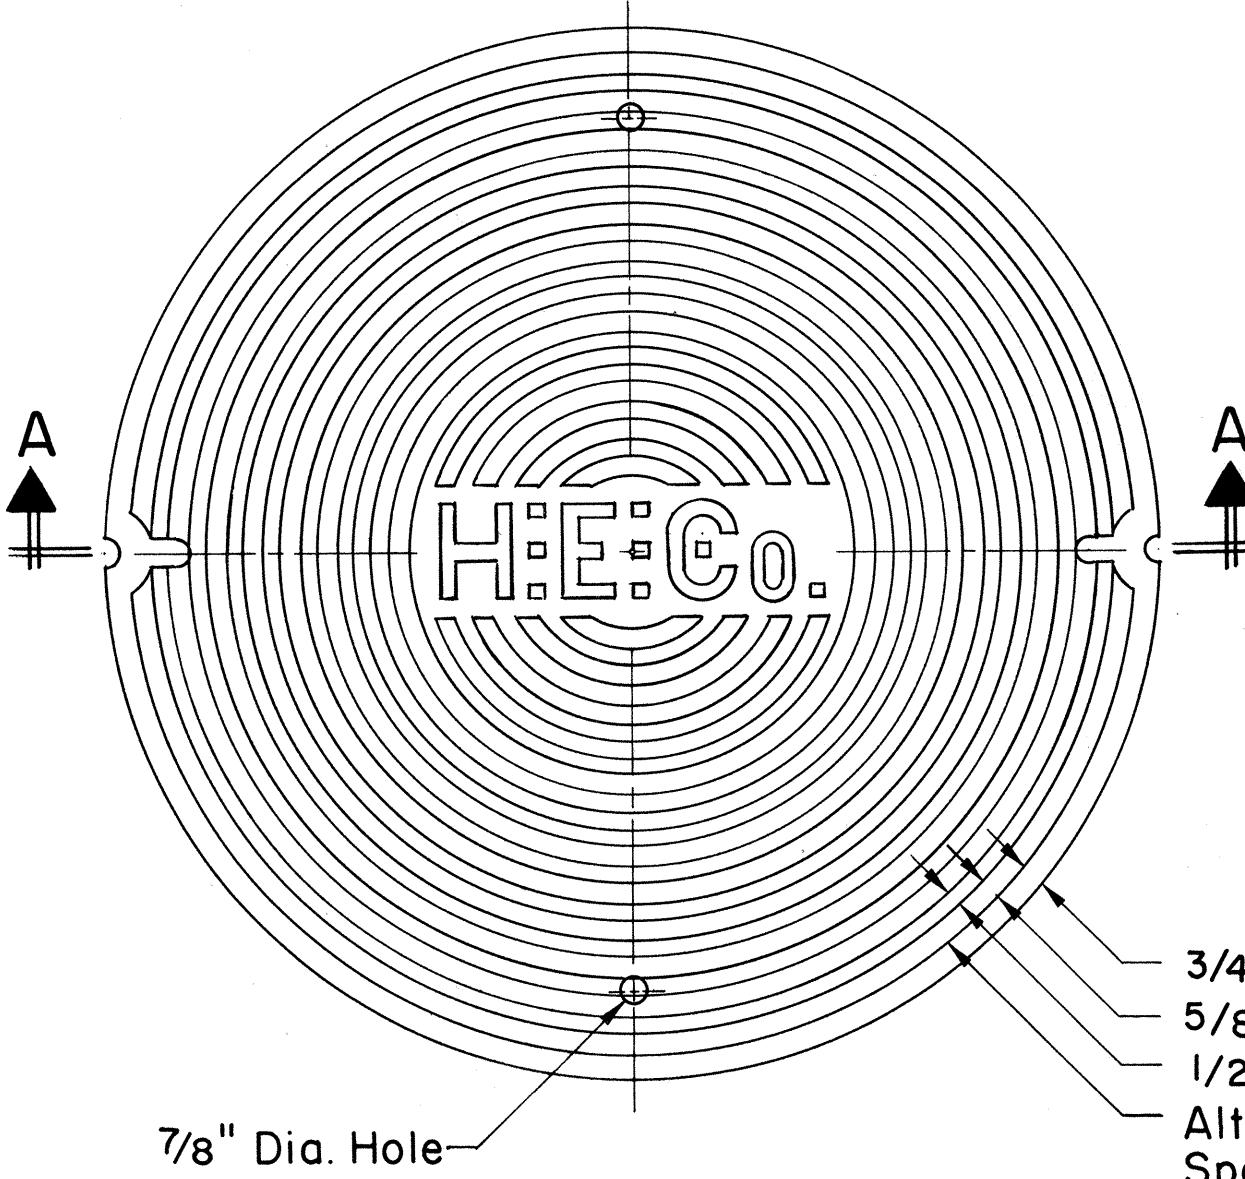

TOP VIEW

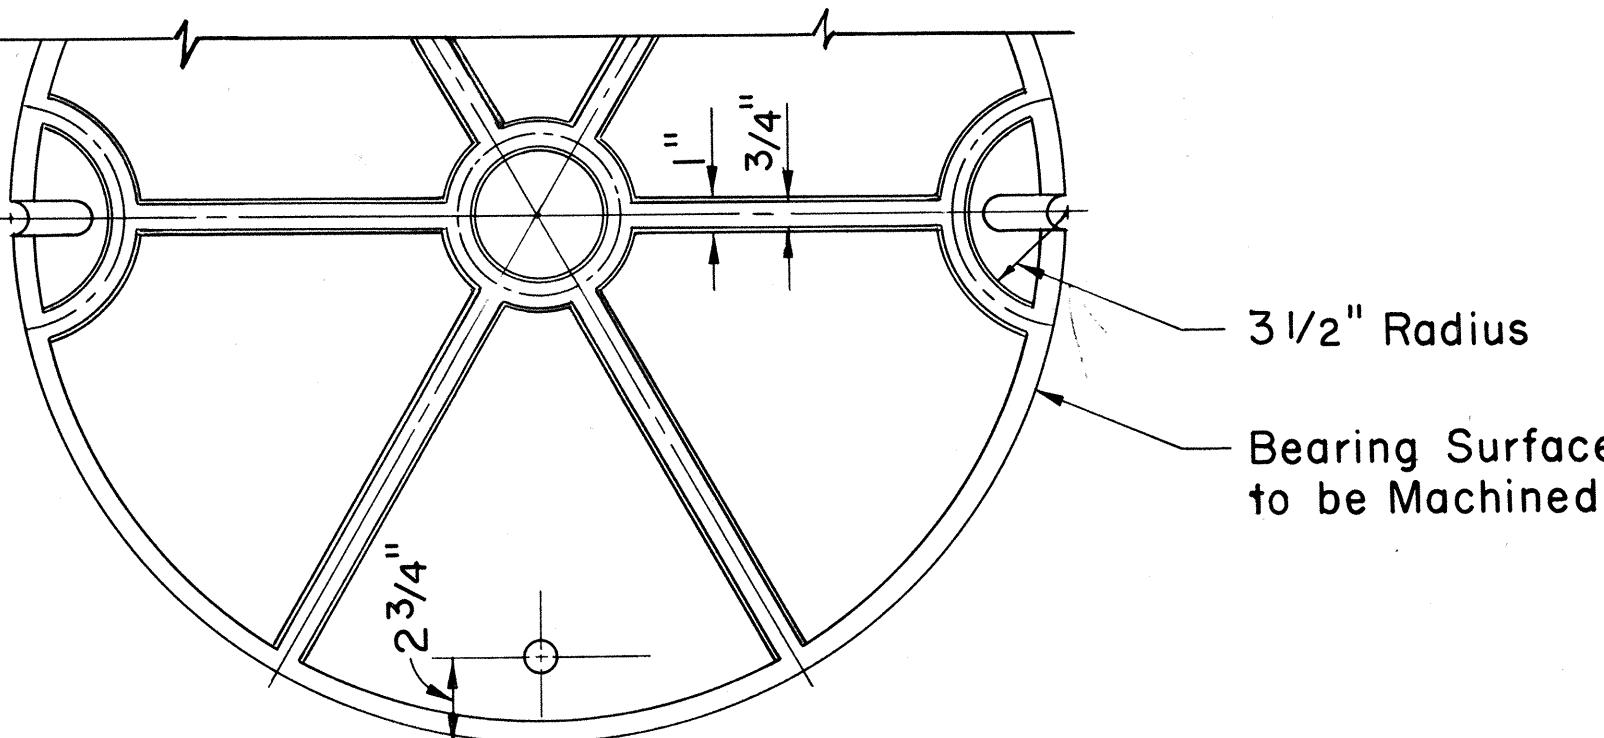

BOTTOM VIEW

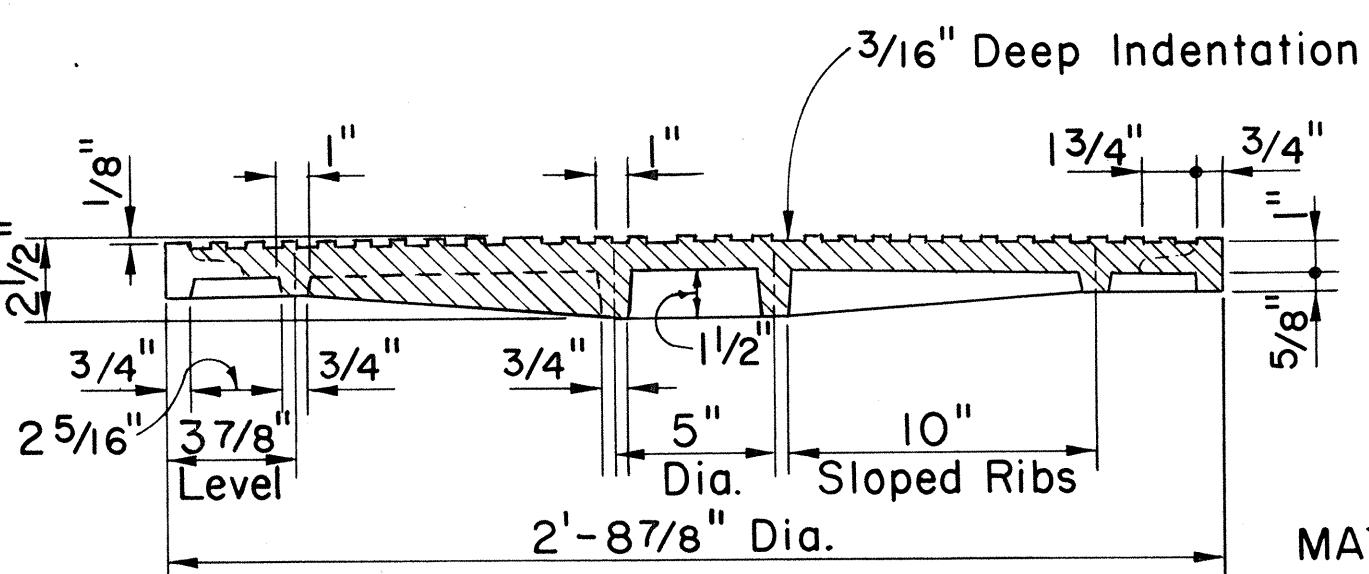

SECTION A-A

31" MANHOLE COVER


Scale: 2" = 1'-0"

MATERIAL:
Cast Iron per ASTM A48,
Class 30.

WEIGHT:
Approx. 262 lbs.


REFERENCE:
31" Manhole Frame -
Dwg. 011328.

011327

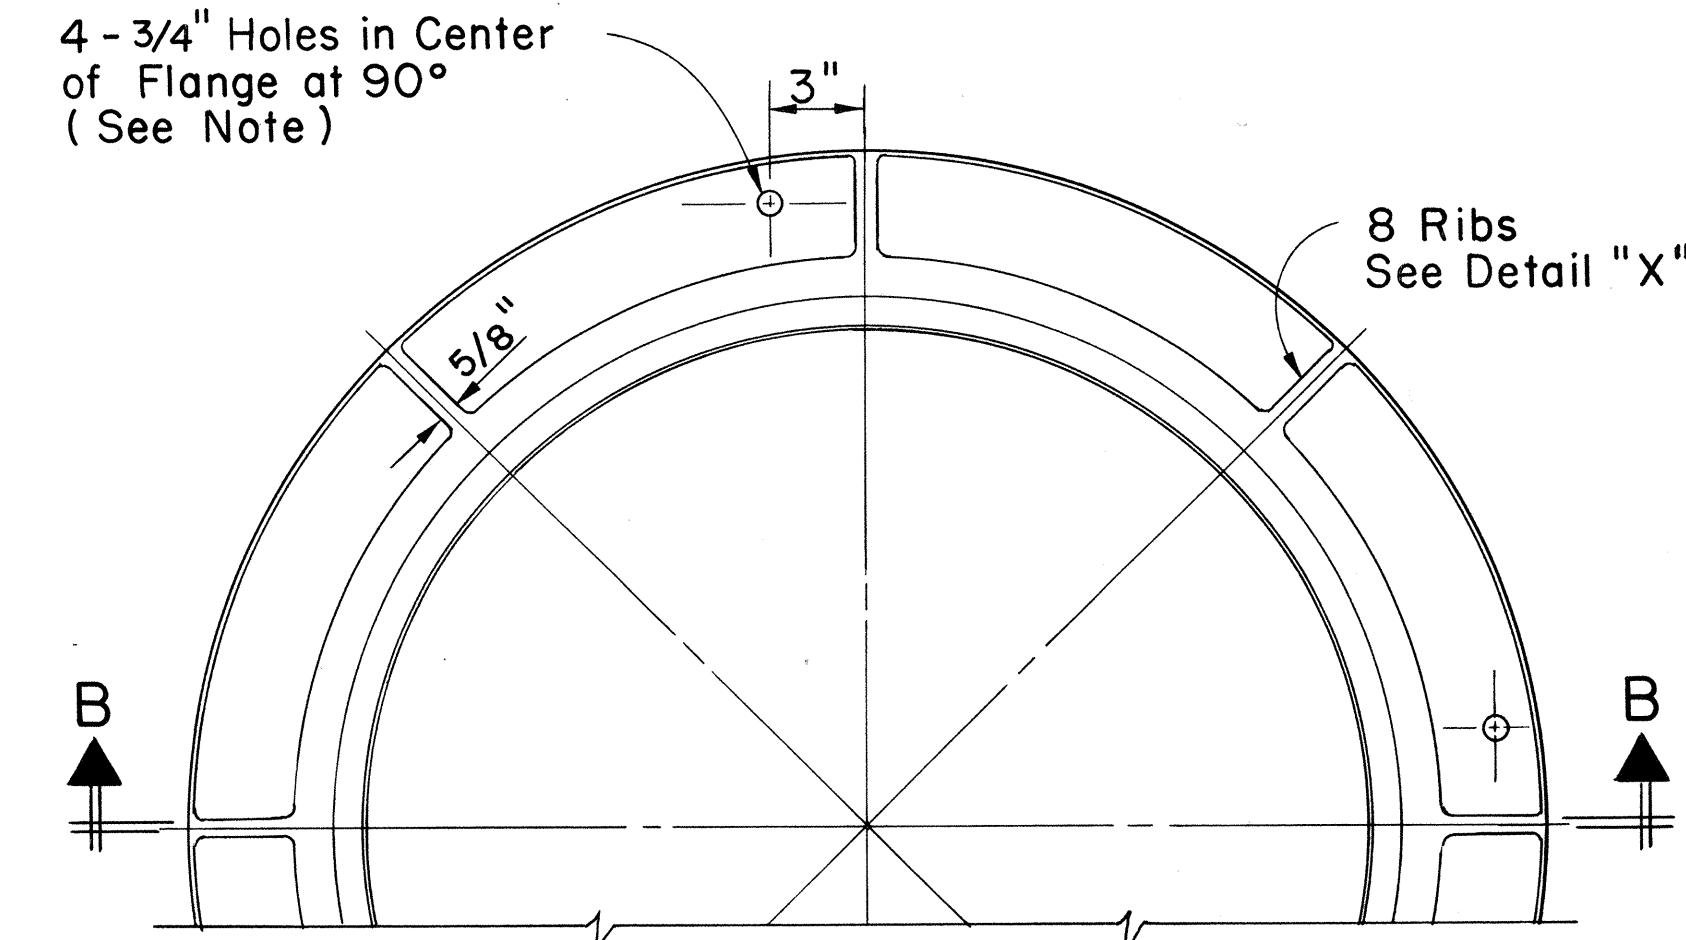

PARTIAL PLAN

Scale: 2" = 1'-0"

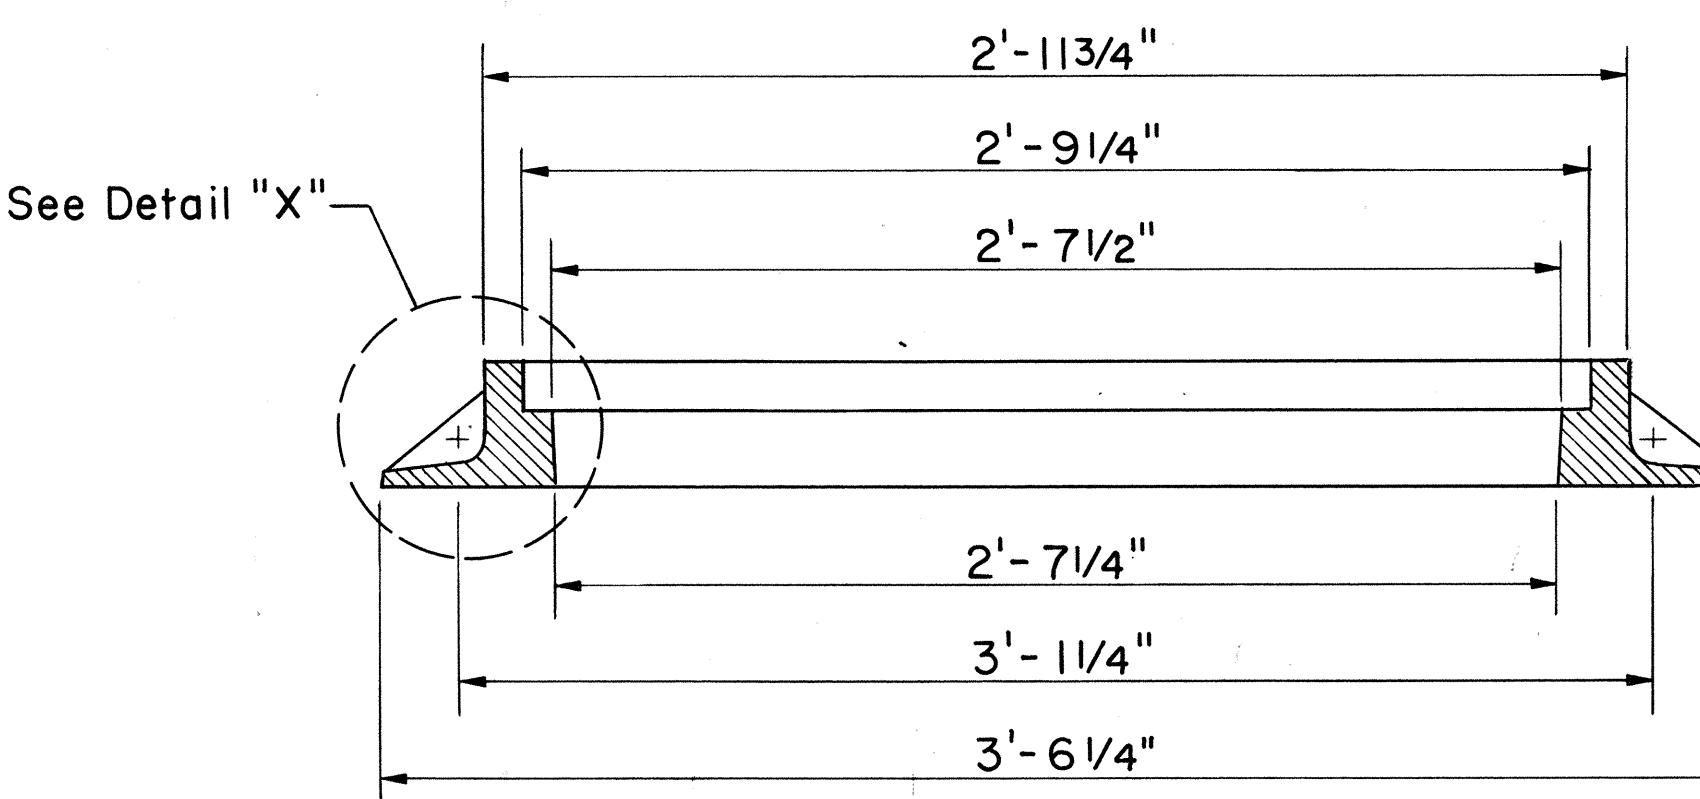

SECTION B-B

Scale: 2" = 1'-0"

INSTALLATION NOTE:

If frame is to be installed where heavy traffic will be on frame, insert 5/8" ϕ bolts thru holes in flange into concrete.

MATERIAL:


Cast Iron per ASTM A48,
Class 30.

WEIGHT:

Approx. 300 lbs.

REFERENCE:

31" Manhole Cover - Dwg. 011327.

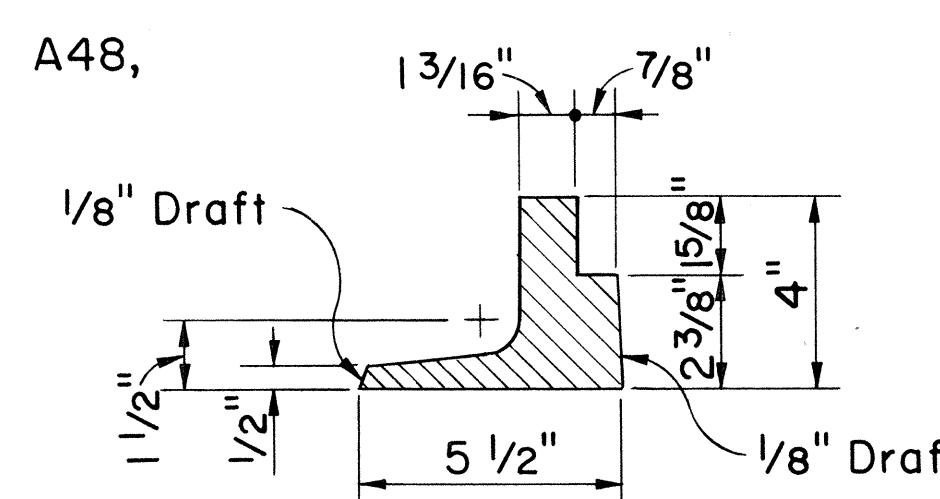

DETAIL "X"

Scale: 3" = 1'-0"

31" MANHOLE FRAME

Scale: As Shown

011328

APPROVED:


J. Karenot
HAWAIIAN ELECTRIC CO., INC.

7/6/78
DATE

HECo., Inc. Drawing Numbers					
011327 8 011328					
STATE OF HAWAII DEPARTMENT OF TRANSPORTATION LAND TRANSPORTATION FACILITIES DIVISION					
STANDARD DETAILS					
31 INCH MANHOLE FRAME AND COVER					
Scale: As Shown					
SHEET No. OF SHEETS					


130

FED. ROAD DIST. NO.	STATE	FED. AID PROJ. NO.	FISCAL YEAR	SHEET NO.	TOTAL SHEETS
HAWAII	HAWAII	M-7600(1)	1978	131	198

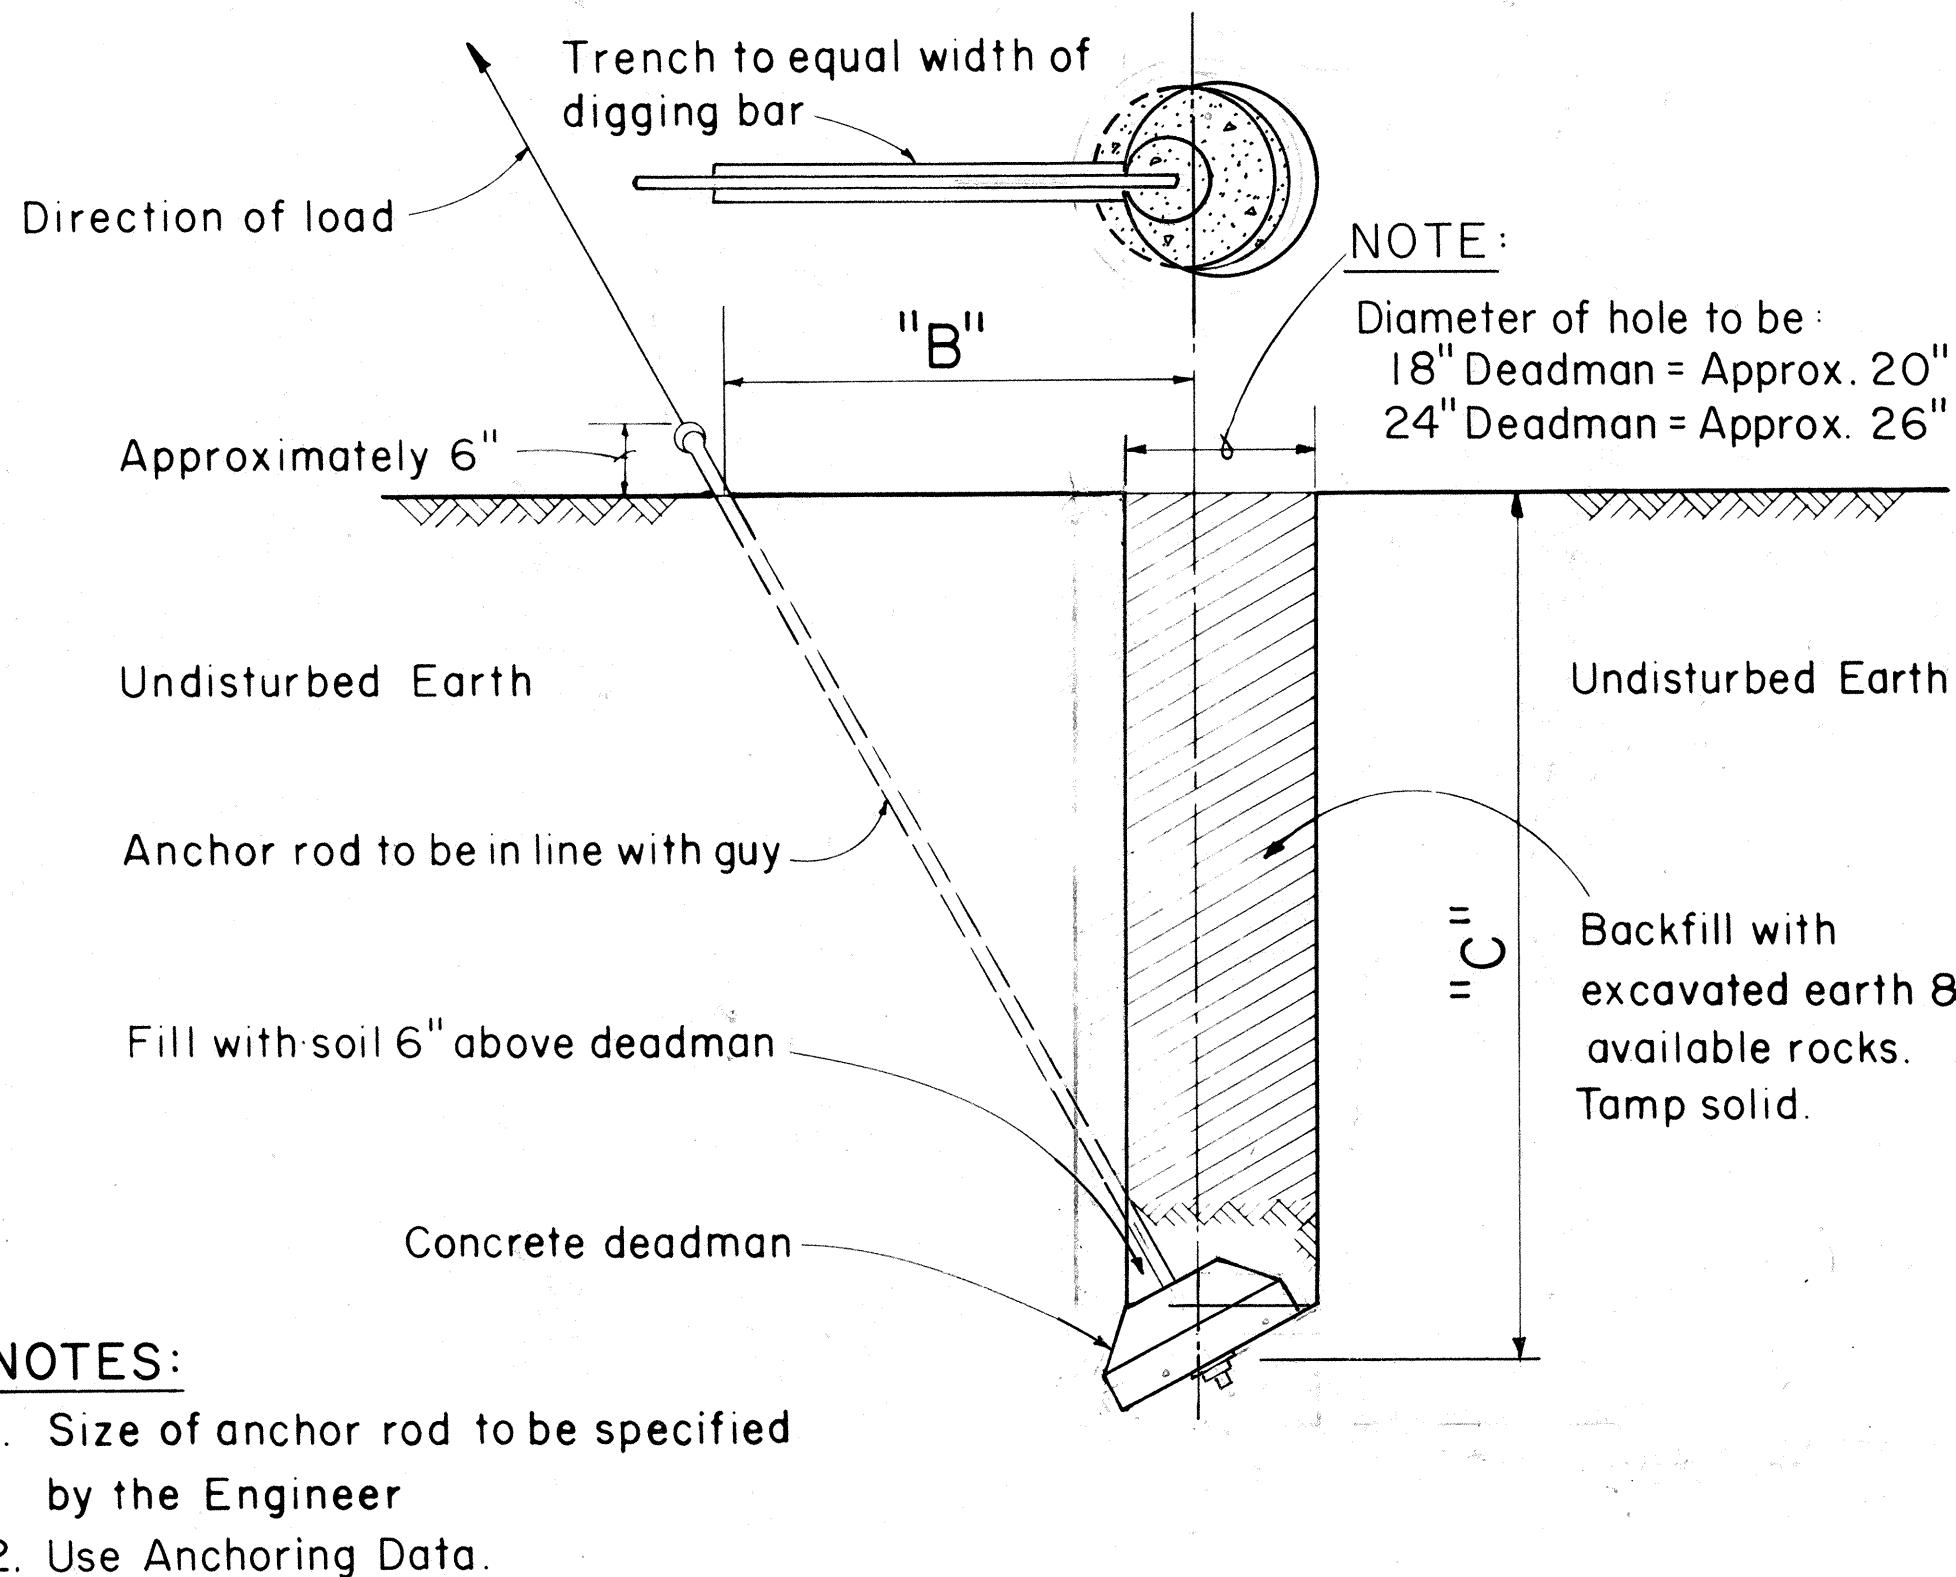


GUY ANCHOR DEADMAN

Scale: $\frac{3}{4}'' = 1' - 0''$

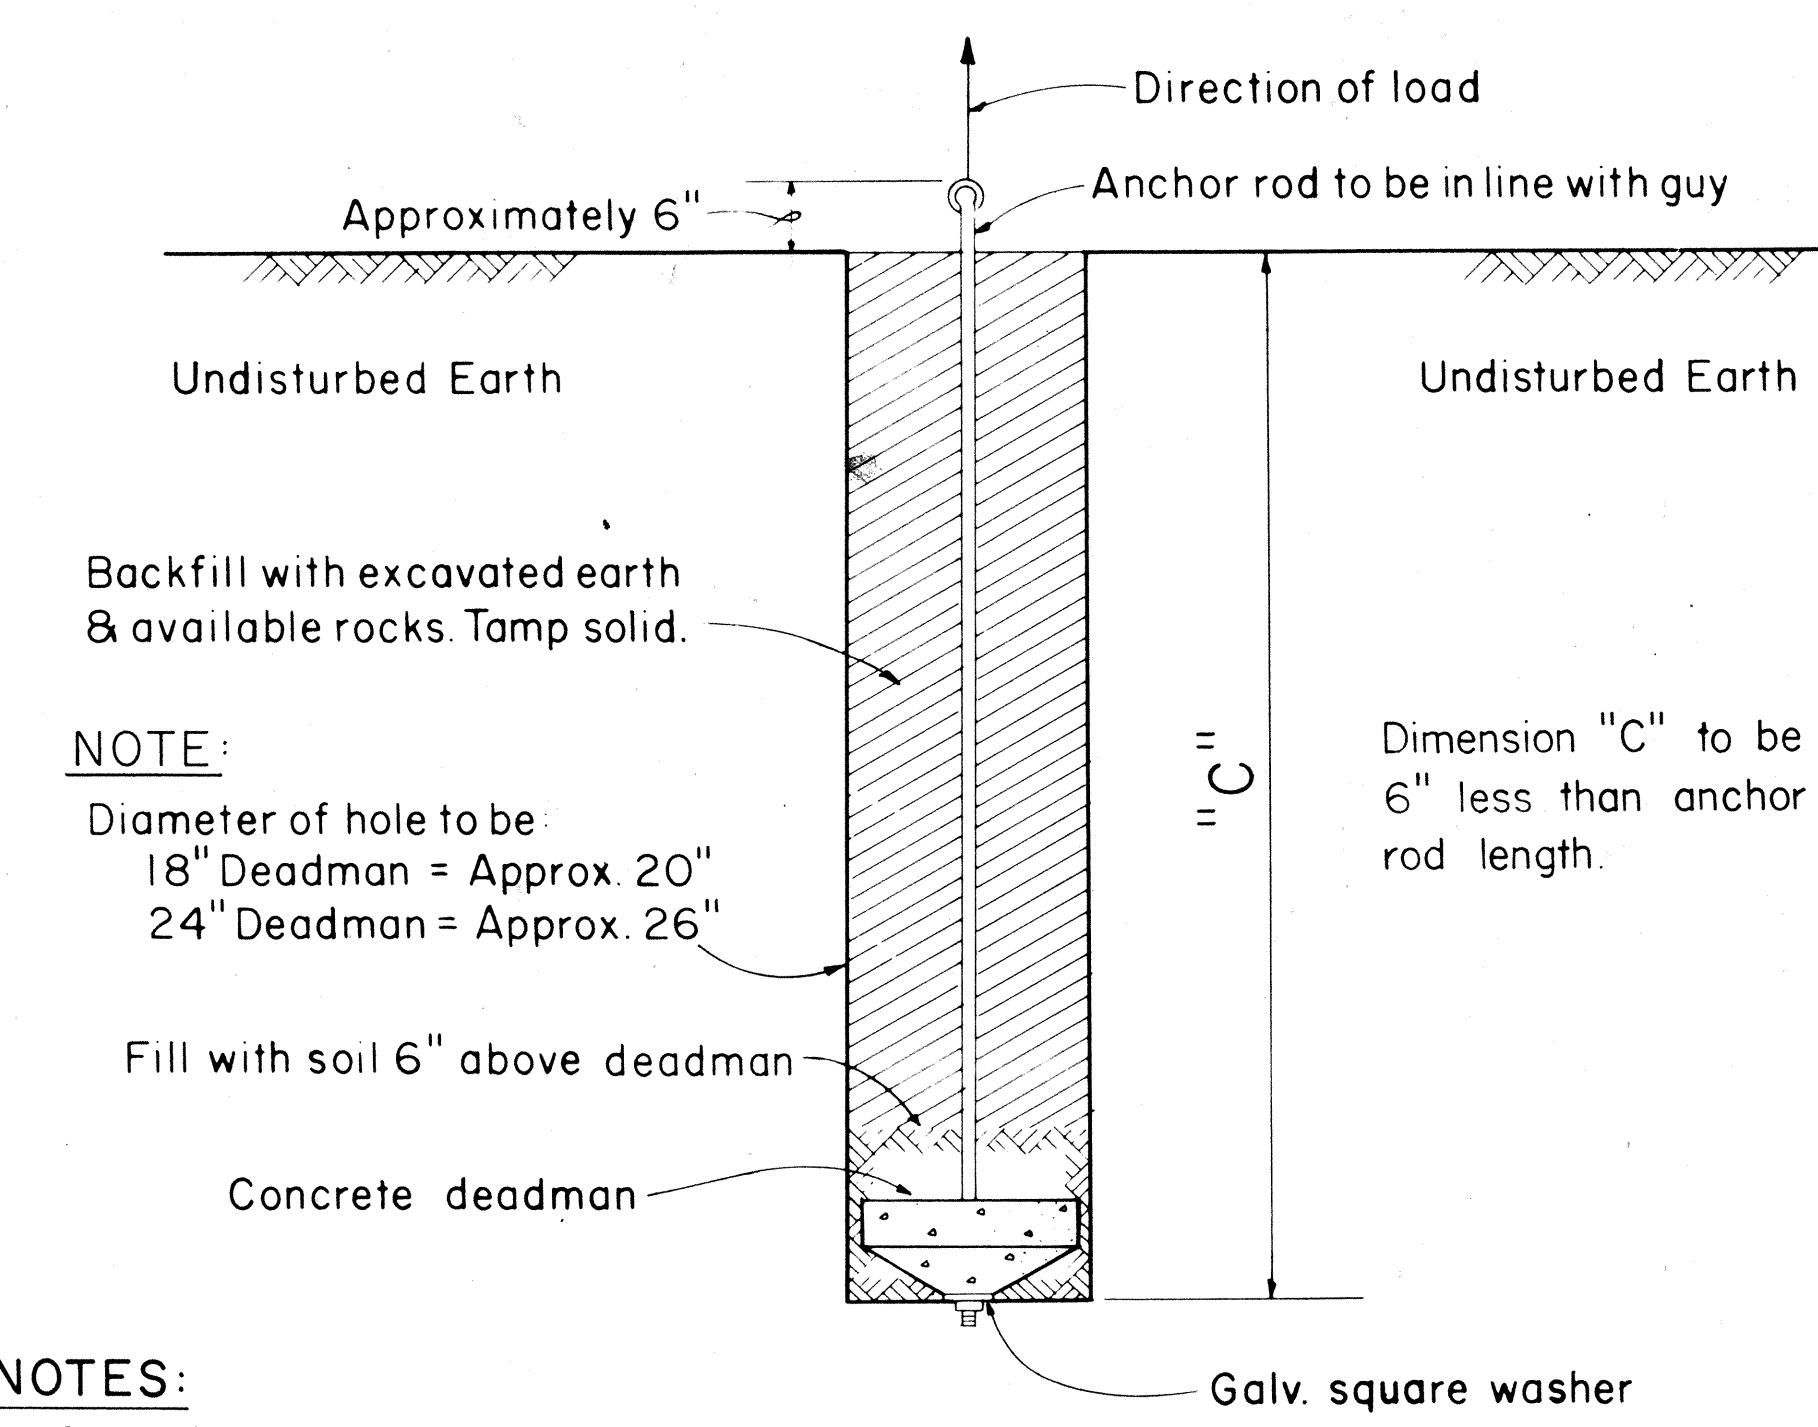


SIDE - WALK ANCHOR

Scale: $\frac{3}{4}'' = 1' - 0''$

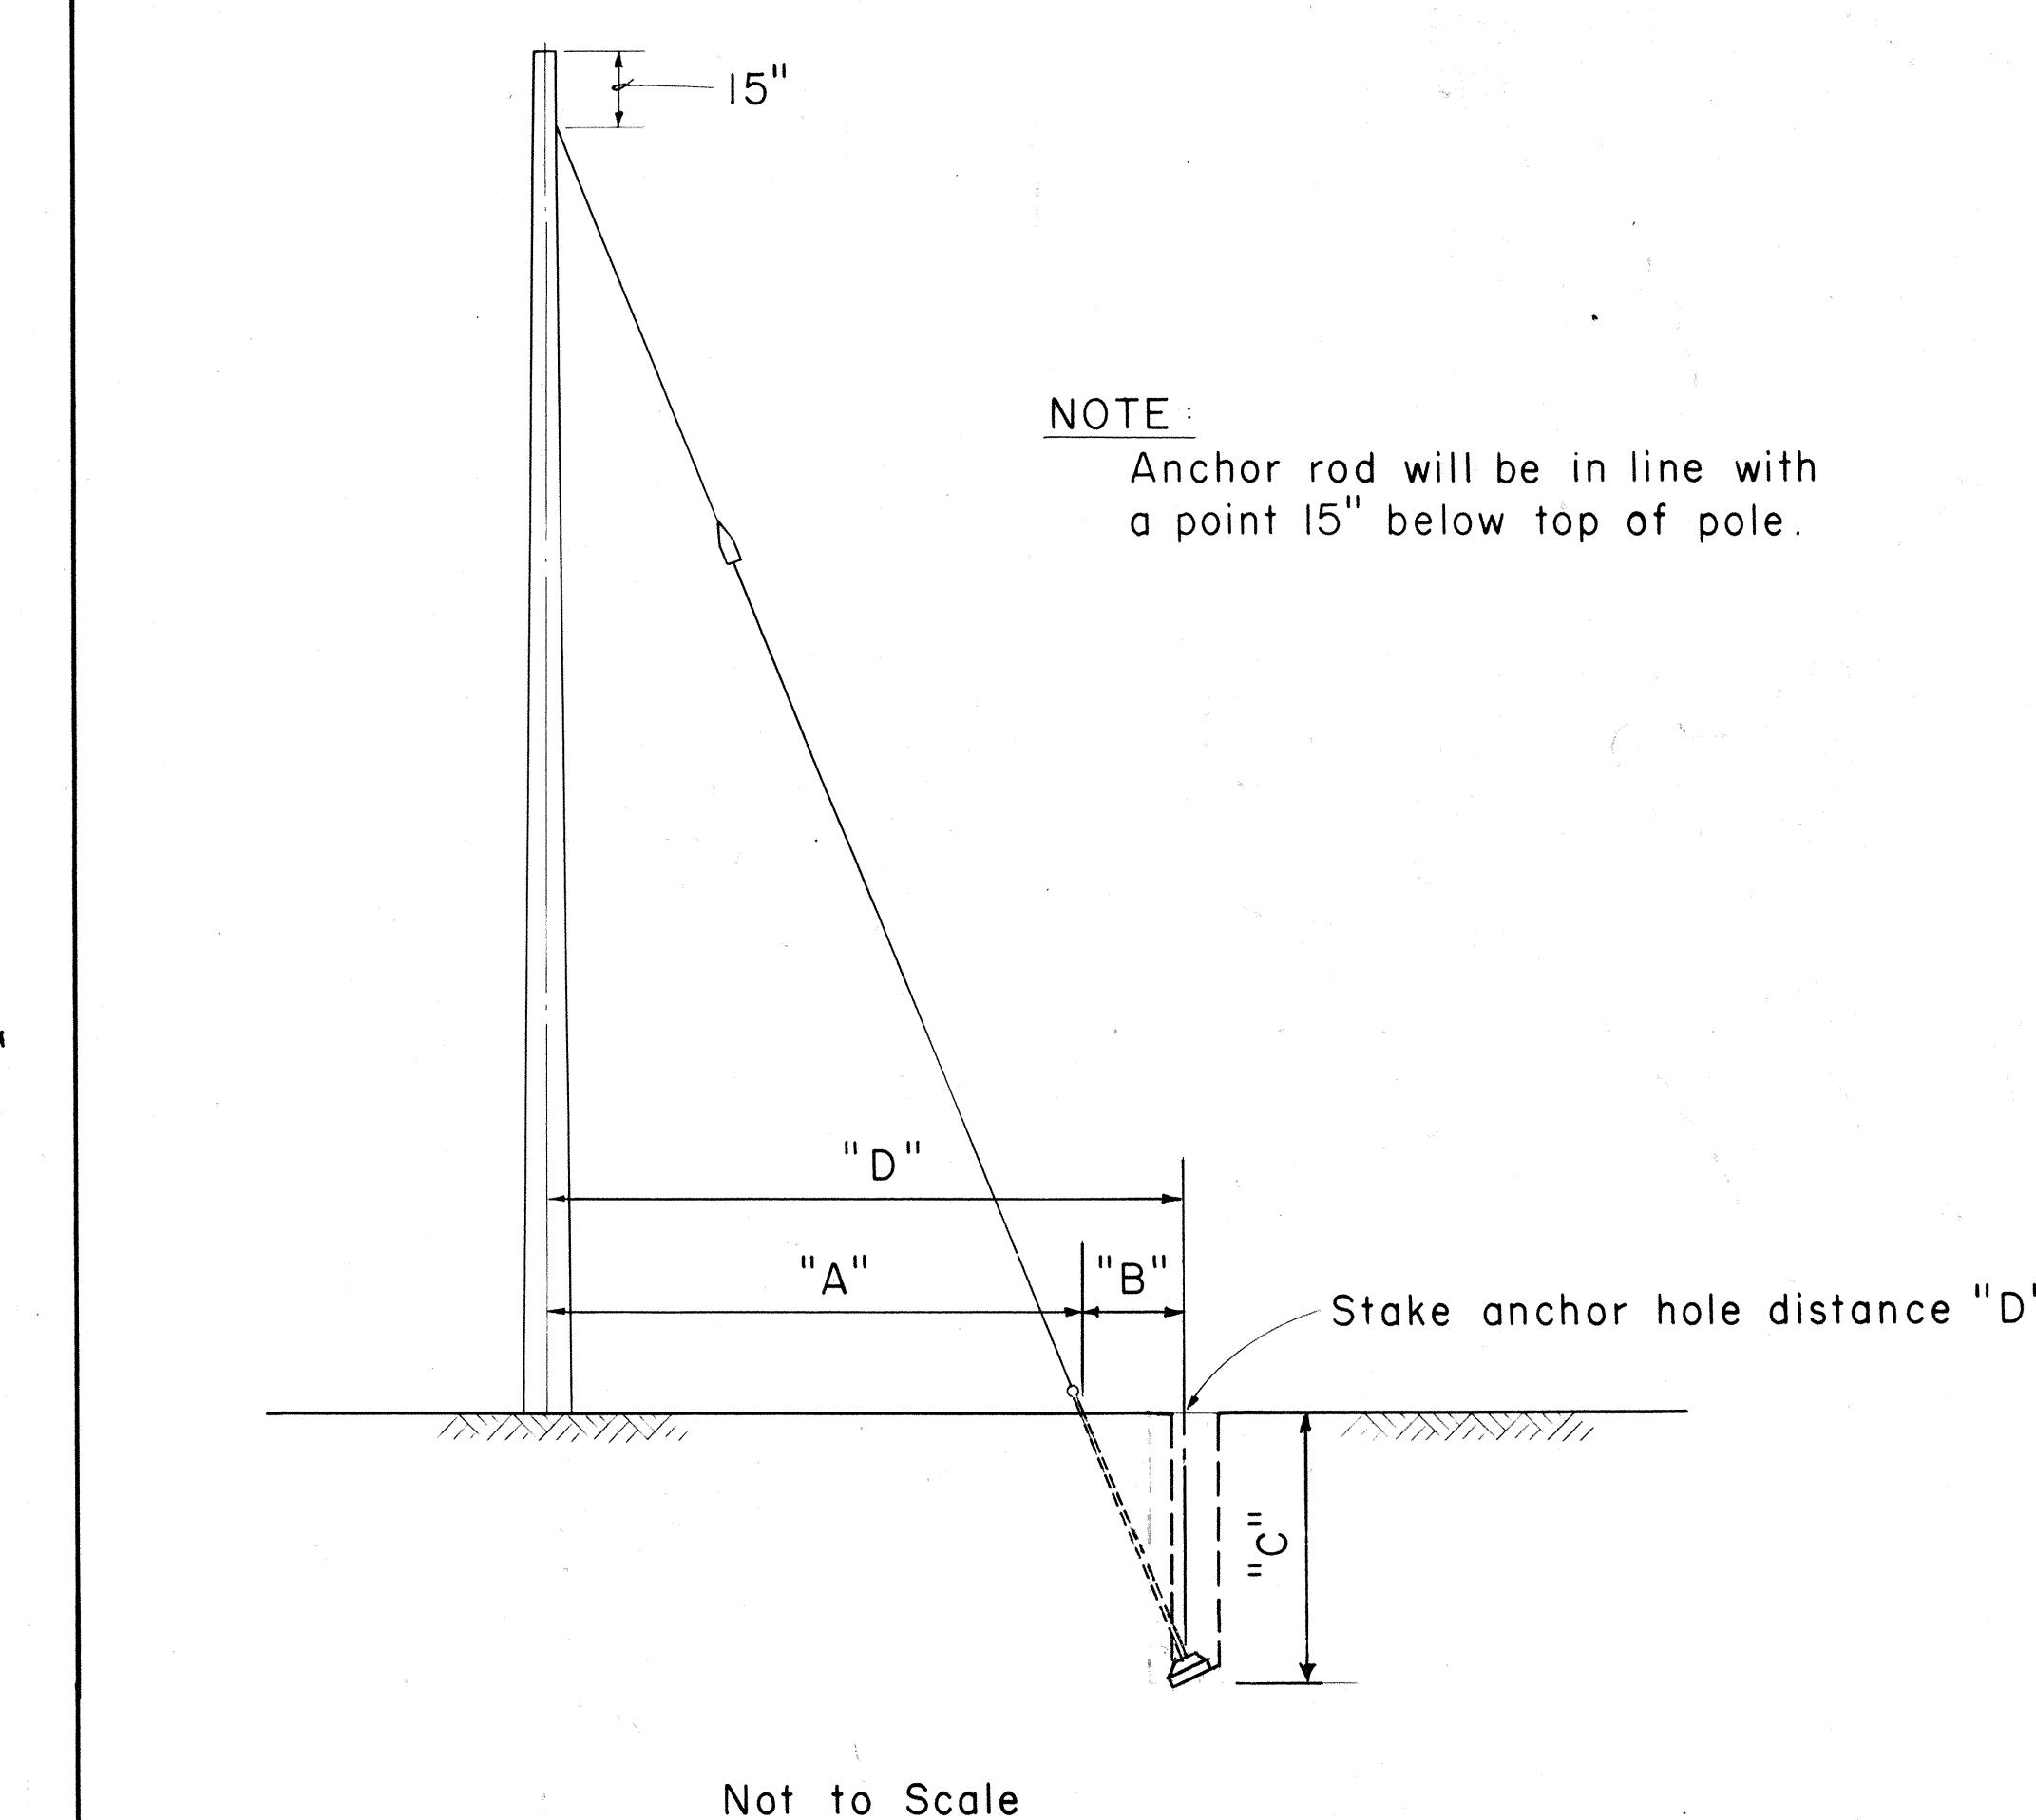

ROCK ANCHOR

Not to Scale

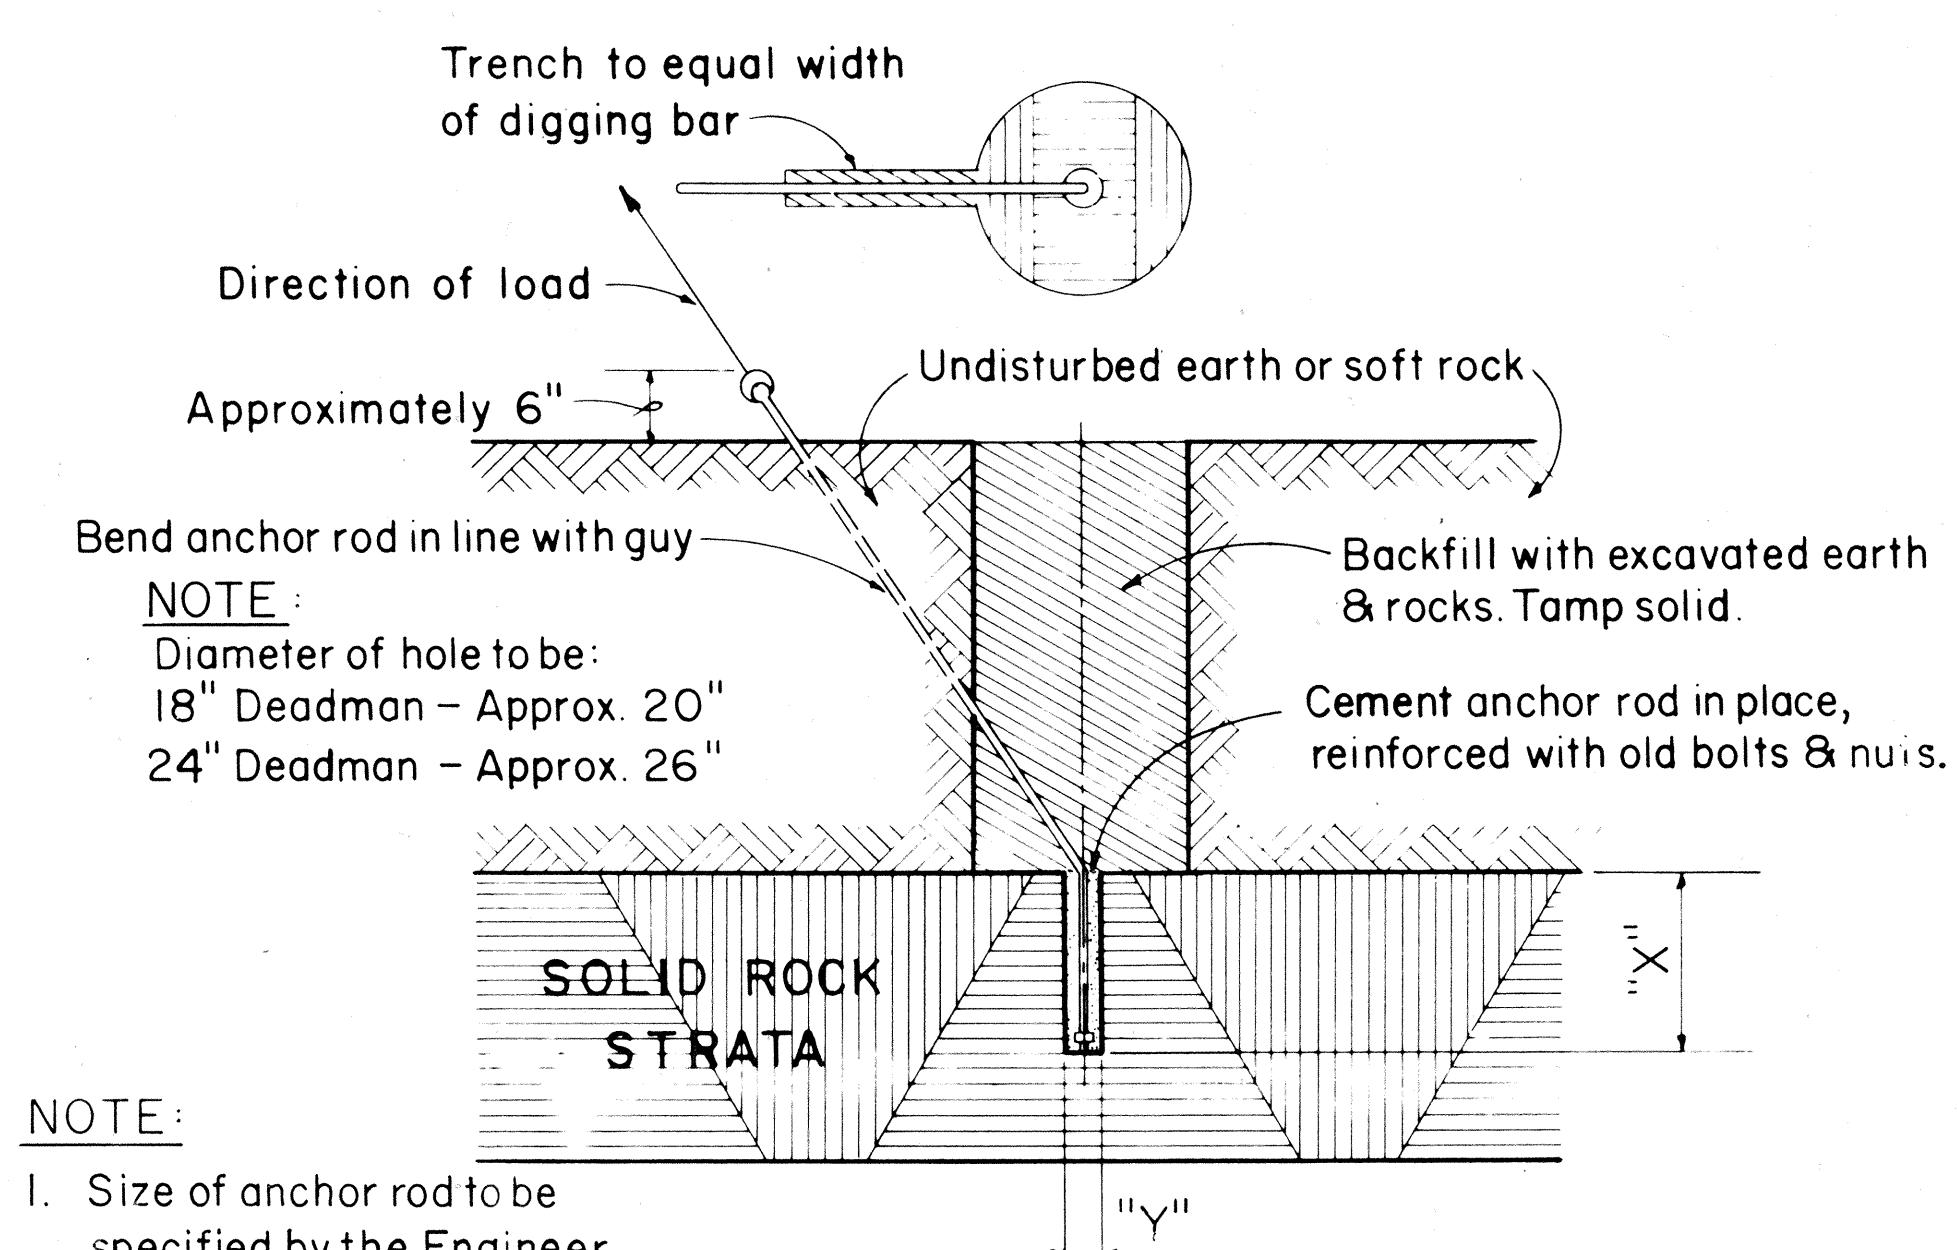

- 1. Size of anchor rod to be specified by the Engineer.
- 2. "X" Should not be less than 24". If "X" is less than 24" complete hole & install anchor.
- 3. "Y" 5/8" Anchor rod drill 2" hole
3/4" Anchor rod drill 2" hole
1" Anchor rod drill 2 1/2" hole
1 1/4" Anchor rod drill 3" hole
- 4. Use Anchoring Data.

FOR 25', & 30' POLES WITH 8'-0" ANCHOR RODS			
"A"	"B"	"C"	"D" = ("A" + "B")
LEAD-ANCHOR ROD TO $\frac{1}{4}$ OF POLE	ANCHOR ROD TO $\frac{1}{4}$ OF HOLE	VERTICAL DEPTH	TOTAL DISTANCE POLE TO HOLE
5' - 0"	1' - 8"	7' - 1"	7' - 4"
10' - 0"	3' - 0"	6' - 7"	7' - 0"
15' - 0"	4' - 0"	6' - 1"	6' - 6"
20' - 0"	4' - 8"	5' - 6"	5' - 10"
25' - 0"	5' - 2"	4' - 11"	5' - 4"
			30' - 2"

FOR 35' THRU 70' POLES WITH 8'-0" ANCHOR RODS			
"A"	"B"	"C"	"D" = ("A" + "B")
5' - 0"	1' - 0"	7' - 3"	7' - 4"
10' - 0"	1' - 11"	7' - 1"	7' - 3"
15' - 0"	2' - 8"	6' - 9"	7' - 1"
20' - 0"	3' - 3"	6' - 6"	6' - 10"
25' - 0"	3' - 10"	6' - 2"	6' - 7"
			28' - 10"

FOR 40' THRU 70' POLES WITH 1 1/4" x 10'-0" ANCHOR RODS			
"A"	"B"	"C"	"D" = ("A" + "B")
5' - 0"	1' - 7"	9' - 4"	6' - 7"
10' - 0"	3' - 0"	9' - 0"	13' - 0"
15' - 0"	4' - 2"	8' - 6"	19' - 2"
20' - 0"	5' - 3"	7' - 11"	25' - 3"
25' - 0"	6' - 2"	7' - 3"	31' - 2"

D. M. = Deadman

TABLE 2 ANCHOR ROD - ANCHOR SLUG - SQUARE WASHER COMBINATION							
H.E. CODE NO.	ANCHOR ROD	WORKING TENSION 1/2 ULT (LBS.)	H.E. CODE NO.	CONC. ANC. (IN.)	H.E. CODE NO.	WASHER SIZE	QTY.
617	5/8" x 8'-0" Steel	8,000	518	18	2320	4" x 4" x 3/16"	2
615	5/8" x 8'-0" Cu Cov Stl	9,250	518	18	* *	3" x 3" x 1/8"	2
618	3/4" x 8'-0" Steel	11,500	518	18	2330	6" x 6" x 3/8"	1
619	1" x 8'-0" Steel	18,000	524	24	2331	6" x 6" x 1/2"	1
616	1" x 8'-0" Cu Cov Stl	22,500	524	24	* *	4" x 4" x 3/16"	2
613	1 1/4" x 10'-0" Steel	29,000	524	24	2330	6" x 6" x 3/8"	2

* * Use bronze square washers included in anchor rod assembly on copper covered steel (Cu Cov Stl) anchor rods.

ANCHORING DATA

LOCATION & LENGTH OF ANCHORS			
POLE #	STATION	O/S	SIDE ANCHOR LEAD
106	37+93 O.B.	63' LT.	L = 12'-0"
107	36+26 O.B.	51' LT.	L = 12'-0"
108	34+61 O.B.	38' LT.	L = 10'-0"
109	32+96 O.B.	28' LT.	L = 10'-0"
109X	30+81 O.B.	29' LT.	L = 10'-0"
110	31+92 I.B.	29' RT.	
110X	32+81 I.B.	28' RT.	
III	EXISTING LOCATION		L = 10'-0"
II2	" "	47' RT.	L = 5'-0"
II0/IR	76+76 O.B.		

APPROVED:

J. Karanot
HAWAIIAN ELECTRIC Co., Inc. 7/16/78

K. Yamada
HAWAIIAN TELEPHONE Co. 6/26/78

STATE OF HAWAII
DEPARTMENT OF TRANSPORTATION
LAND TRANSPORTATION FACILITIES DIVISION
STANDARD DETAILS
H.E. Co. AND H.T. Co.
ANCHOR DETAILS AND
ANCHORING DATA

Scales: As Noted Date
SHEET No. OF SHEETS