
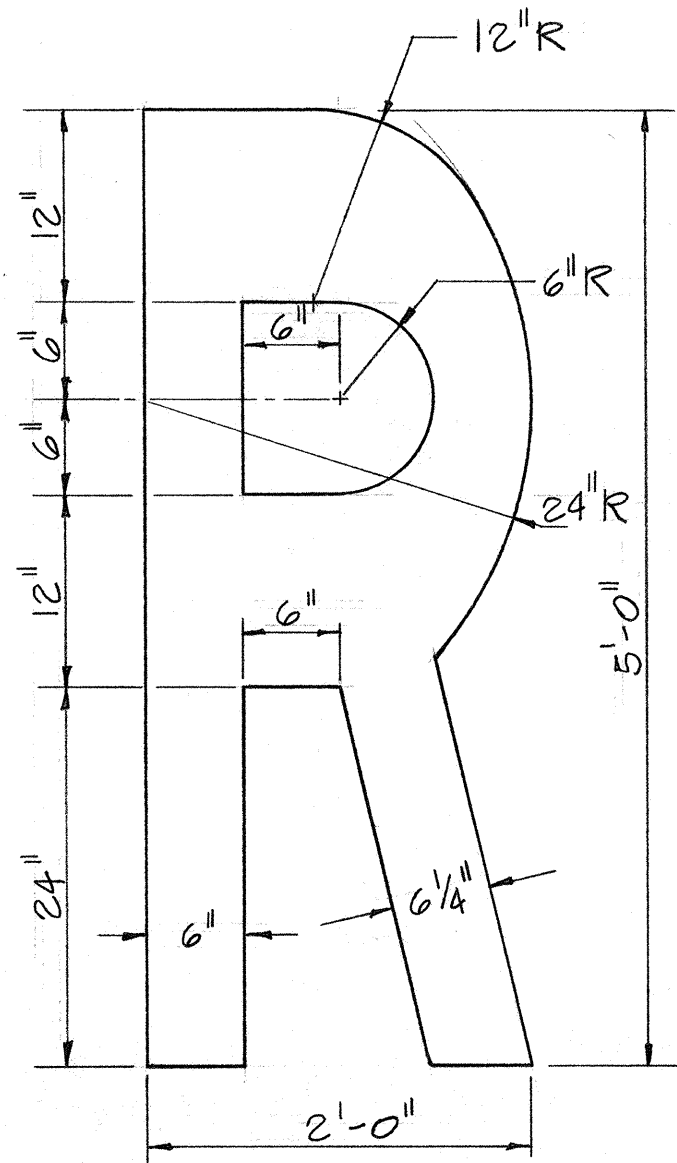
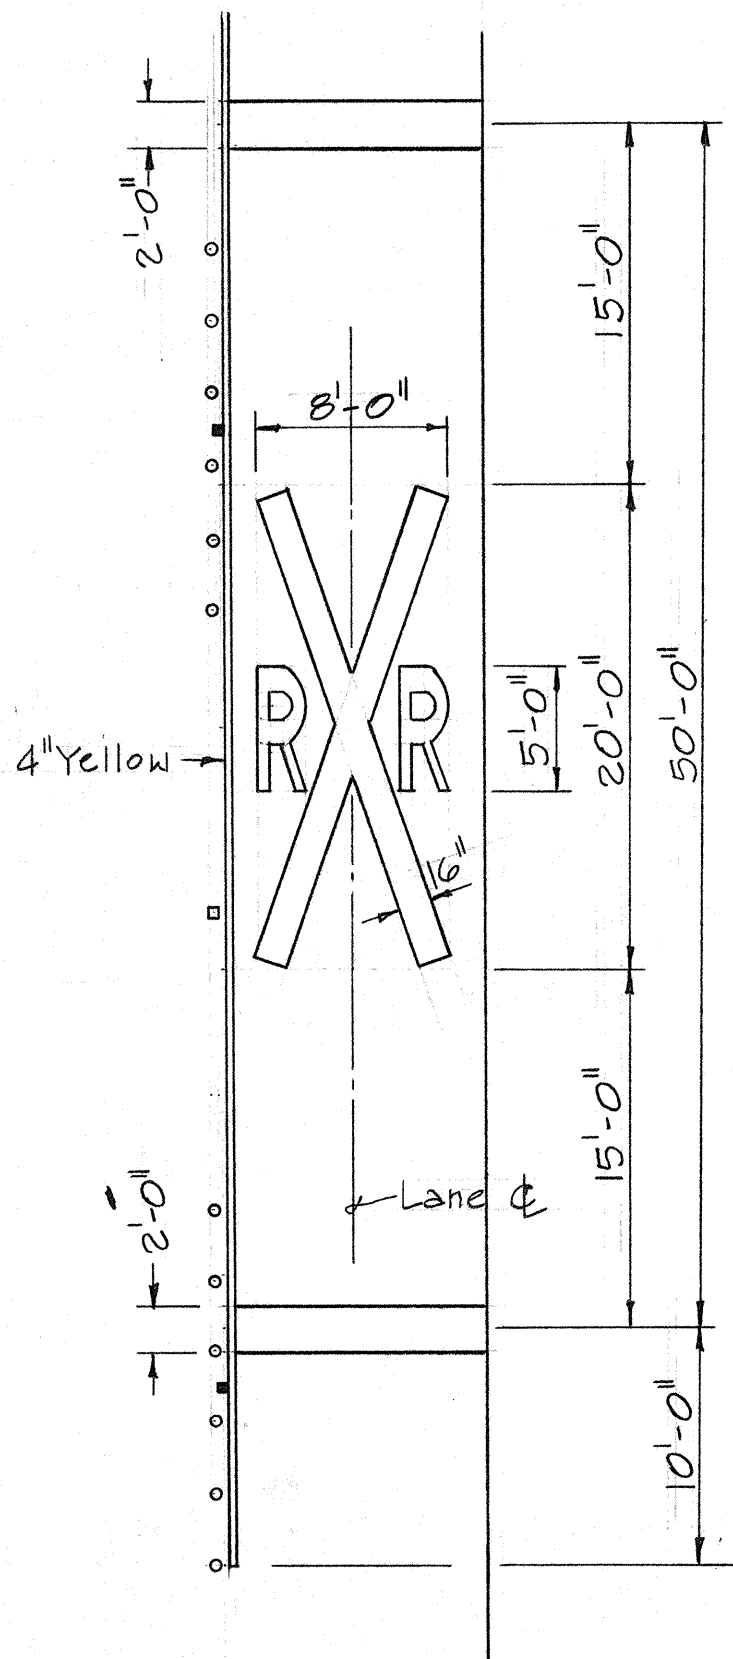
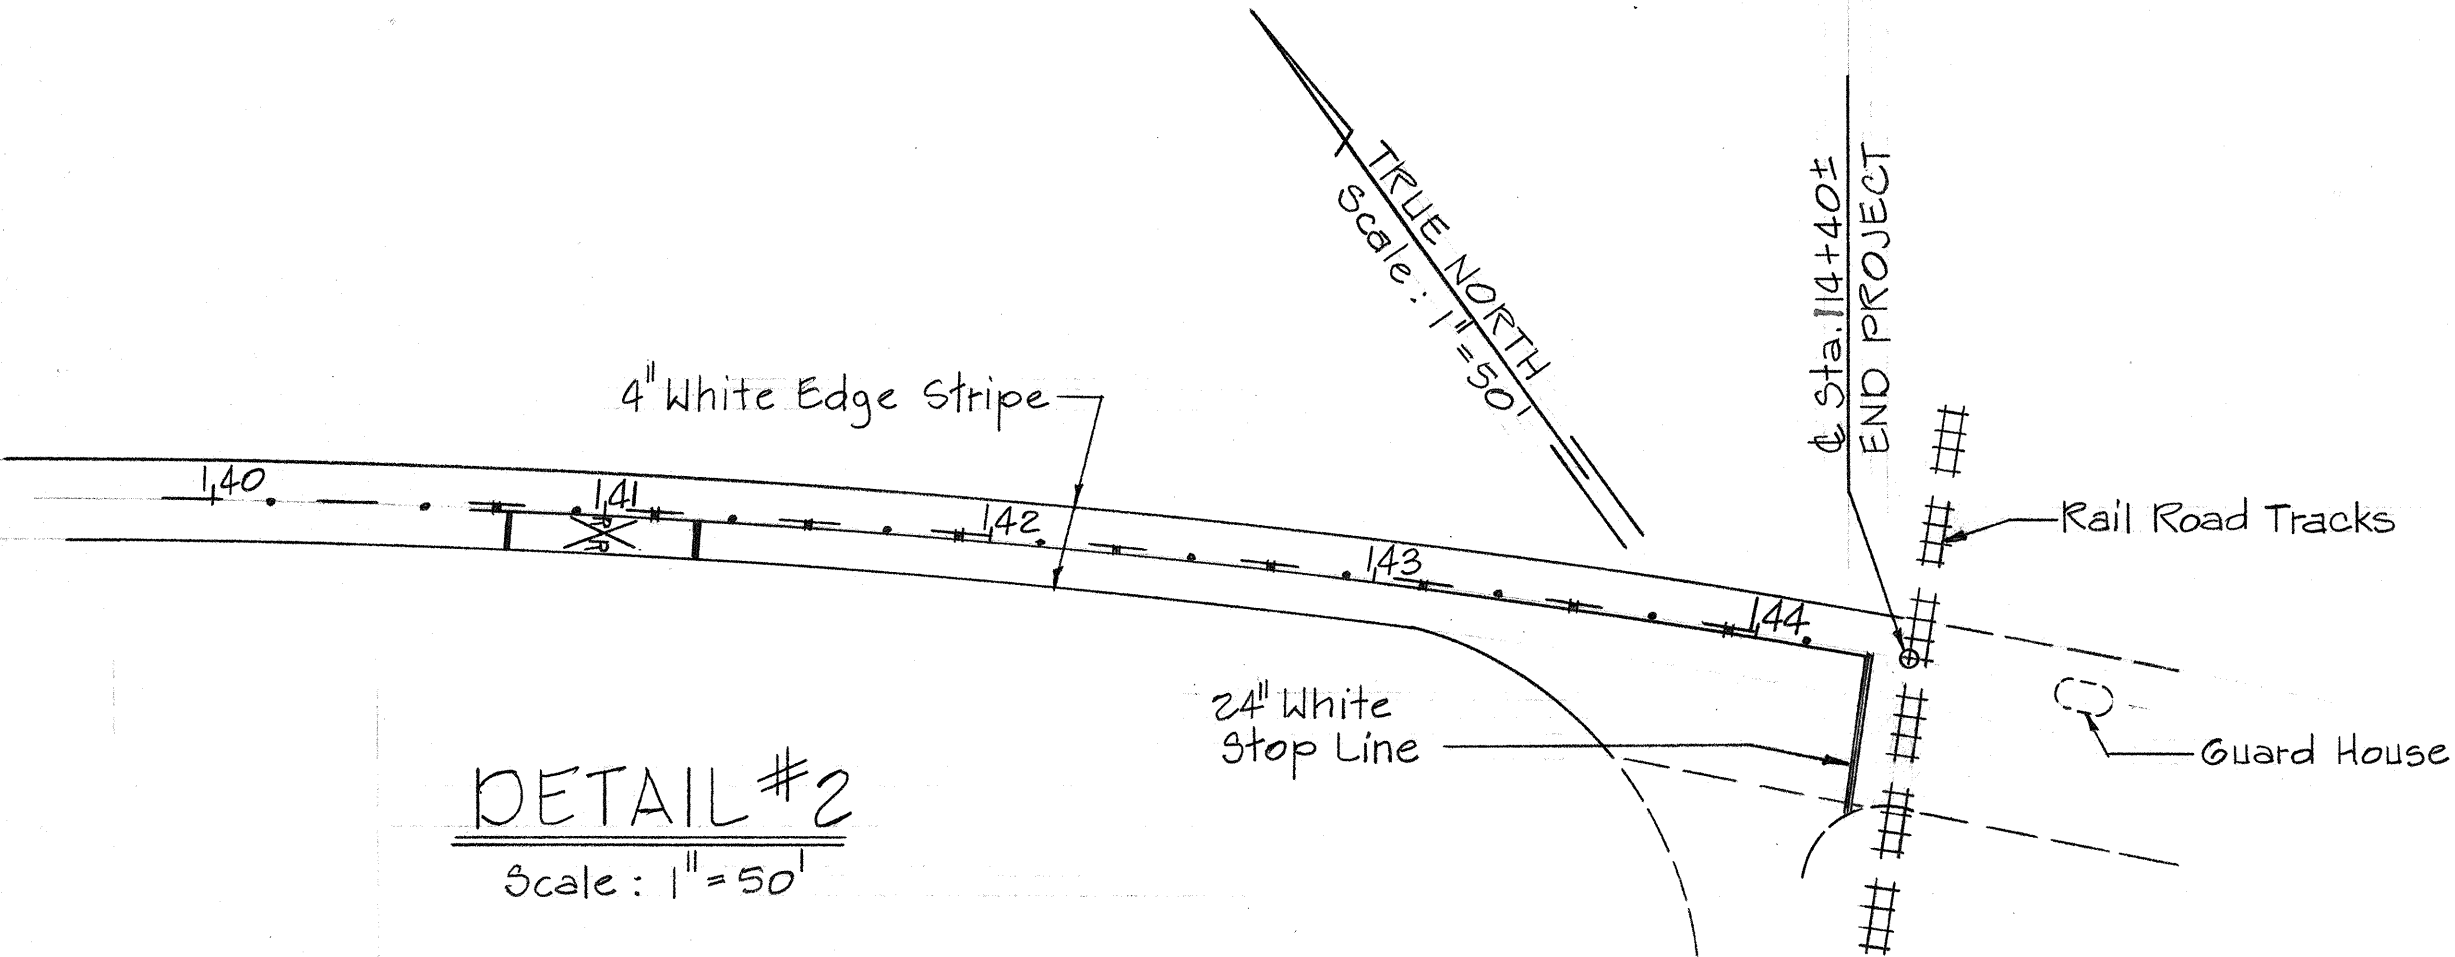
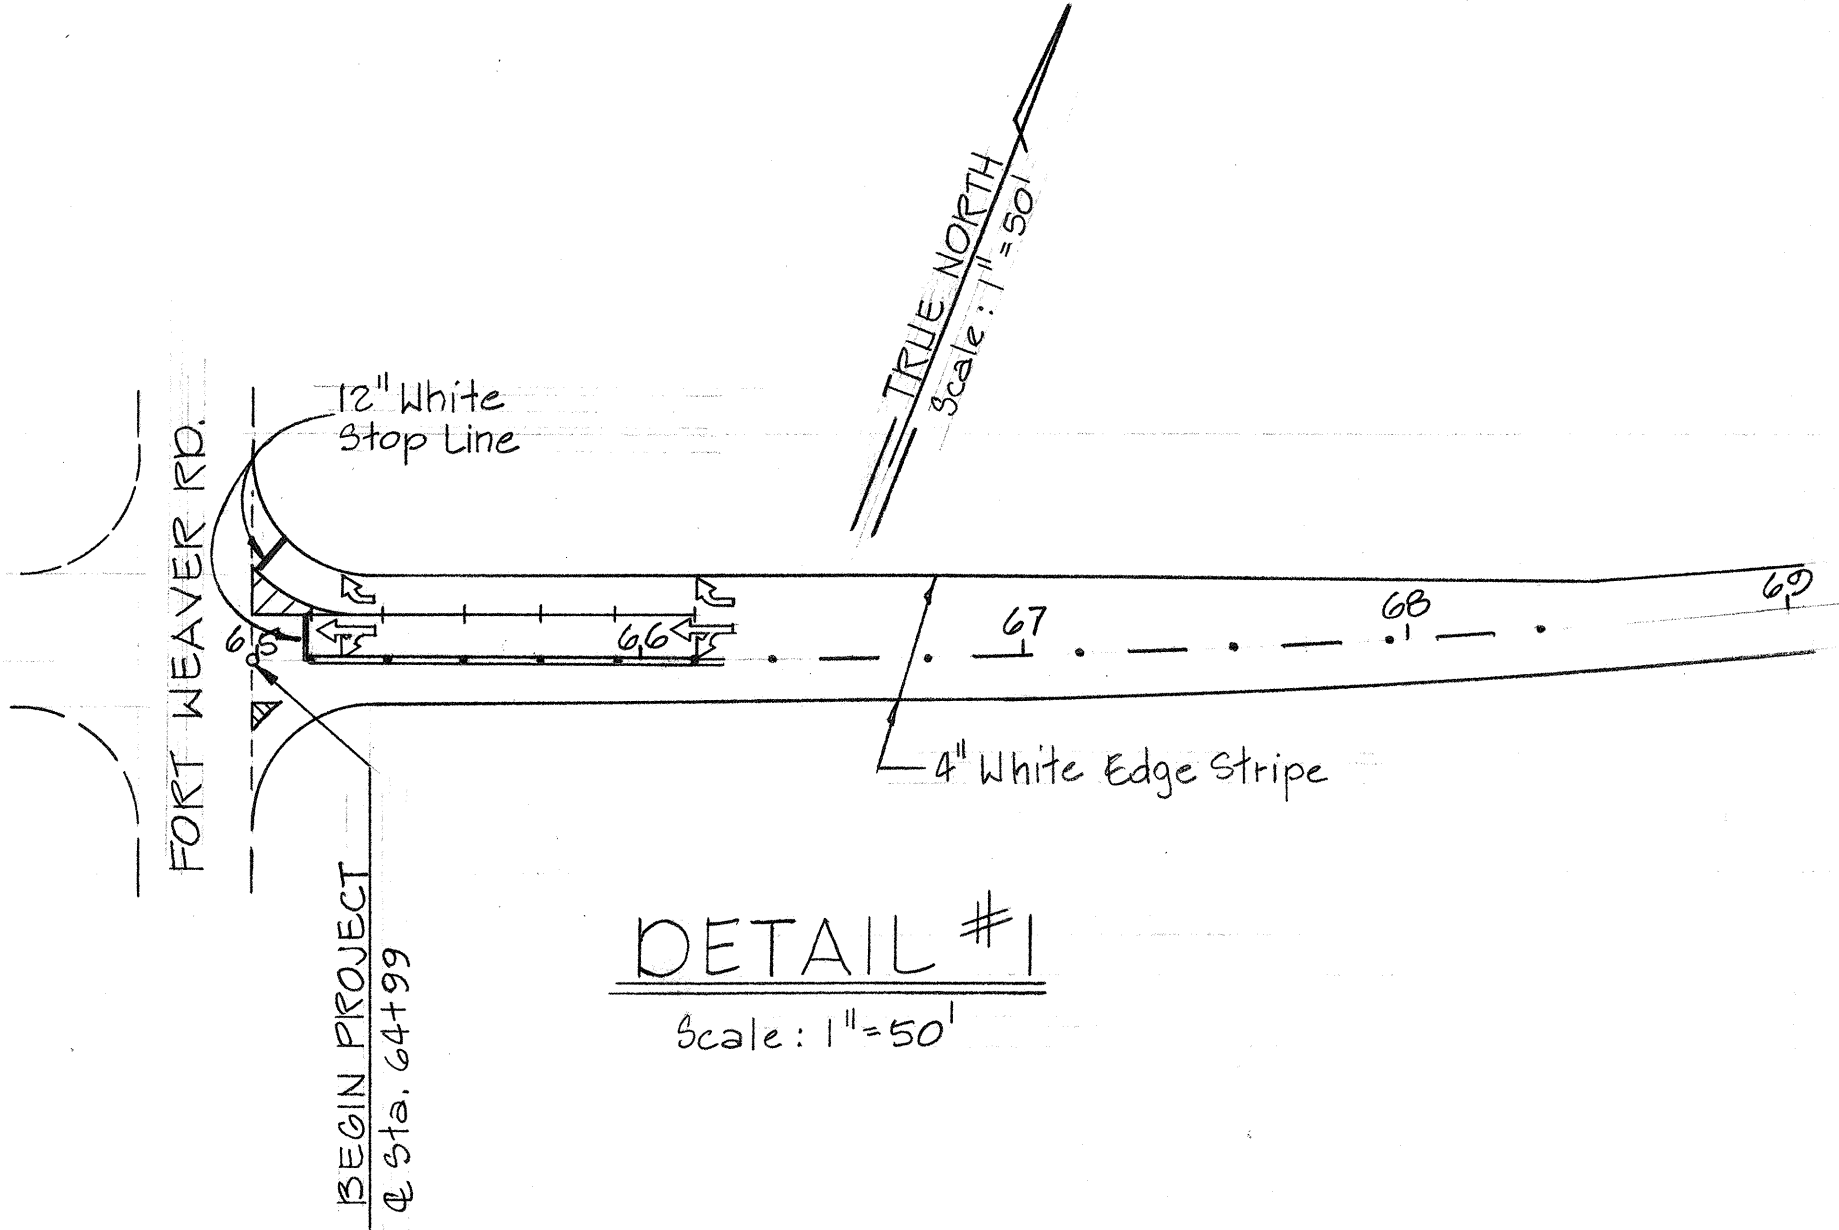


FED. ROAD DIST. NO.	STATE	PROJ. NO.	FISCAL YEAR	SHEET NO.	TOTAL SHEETS
HAWAII	HAW.	16AA-01-73	1974	3	4

SUMMARY OF PAVEMENT MARKING INSTALLATION								
LOCATION		DESCRIPTION	PAVEMENT MARKERS (EA.)				STRIPING (LIN. FT.)	MISC. (EA.)
FROM	TO		C	D	H	J		
Ft. Weaver Rd.	± Sta. 68+50	See Detail #1	6	12		30	1,050	4-Pav't Arrow
± Sta. 68+50	± Sta. 140+00	Two-Lane Passing Permitted 4" White Edge Line		180		1,080	14,300	
± Sta. 140+00	± Sta. 144+40	See Detail #2		10	9	60	500	1- R.R. Crossing
TOTAL			6	202	9	1,170	15,850	


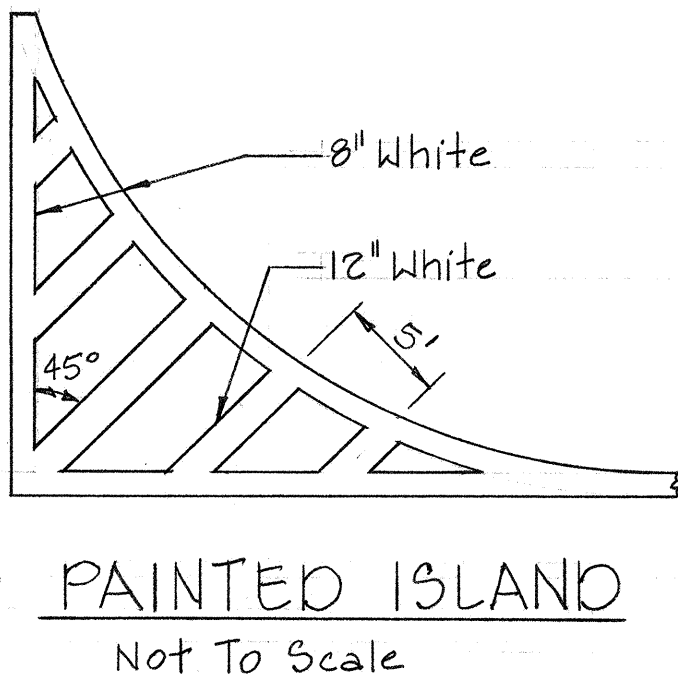


LEGEND

- Type "D" Raised Pavement Marker
- Type "H" Raised Pavement Marker
- Type "J" Raised Pavement Marker
- 8" White Stripe w/Type "C" Markers @ 20' O.C.
- Double 4" Yellow Stripe w/Type "D" Markers @ 20' O.C.
- Type "D" and "J" Markers

GENERAL NOTES

- Pavement markings shall conform to the "Manual On Uniform Traffic Control Devices For Streets & Highways", 1971, and as shown on the plans.
- Layout of pavement markings and striping shall be done by the Contractor. Approval of layout of markings and striping shall be obtained by the Contractor from the Engineer prior to performing work.

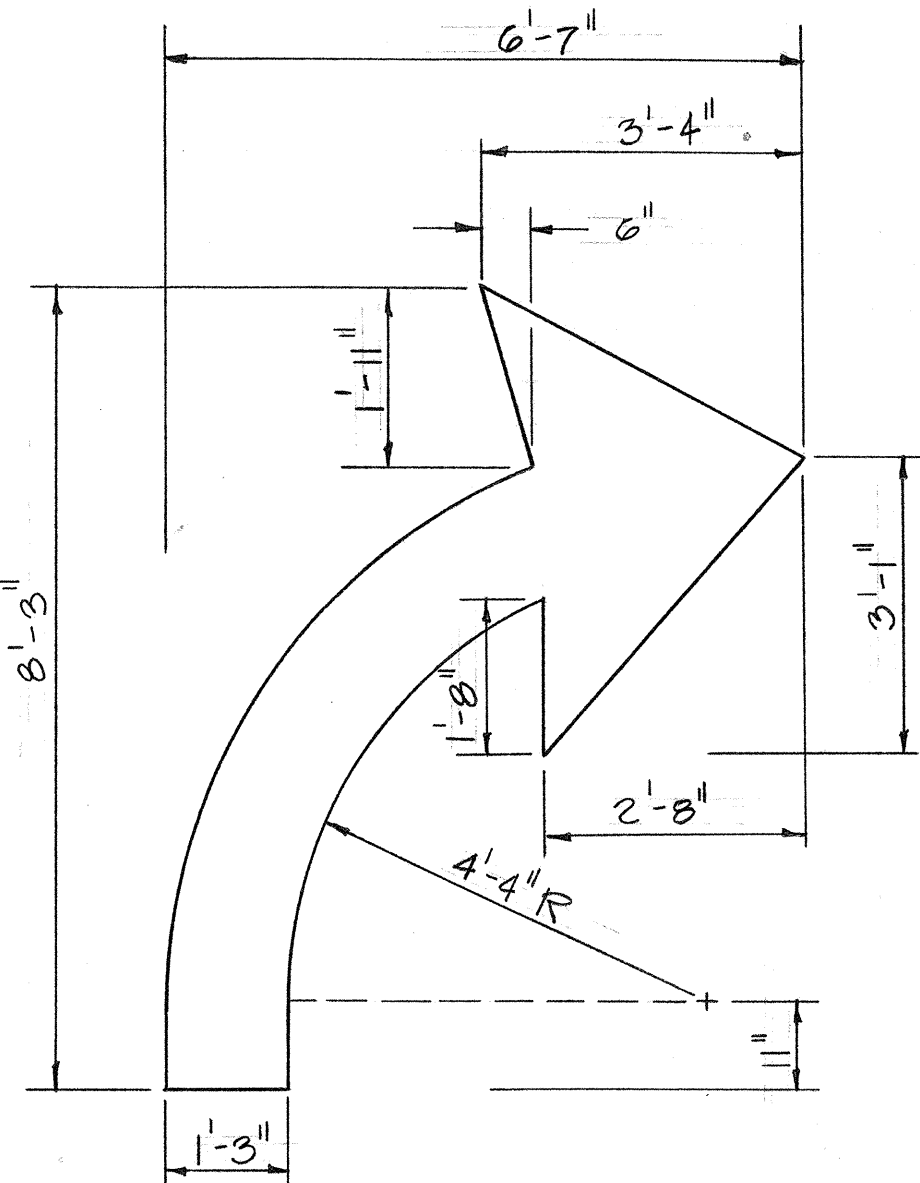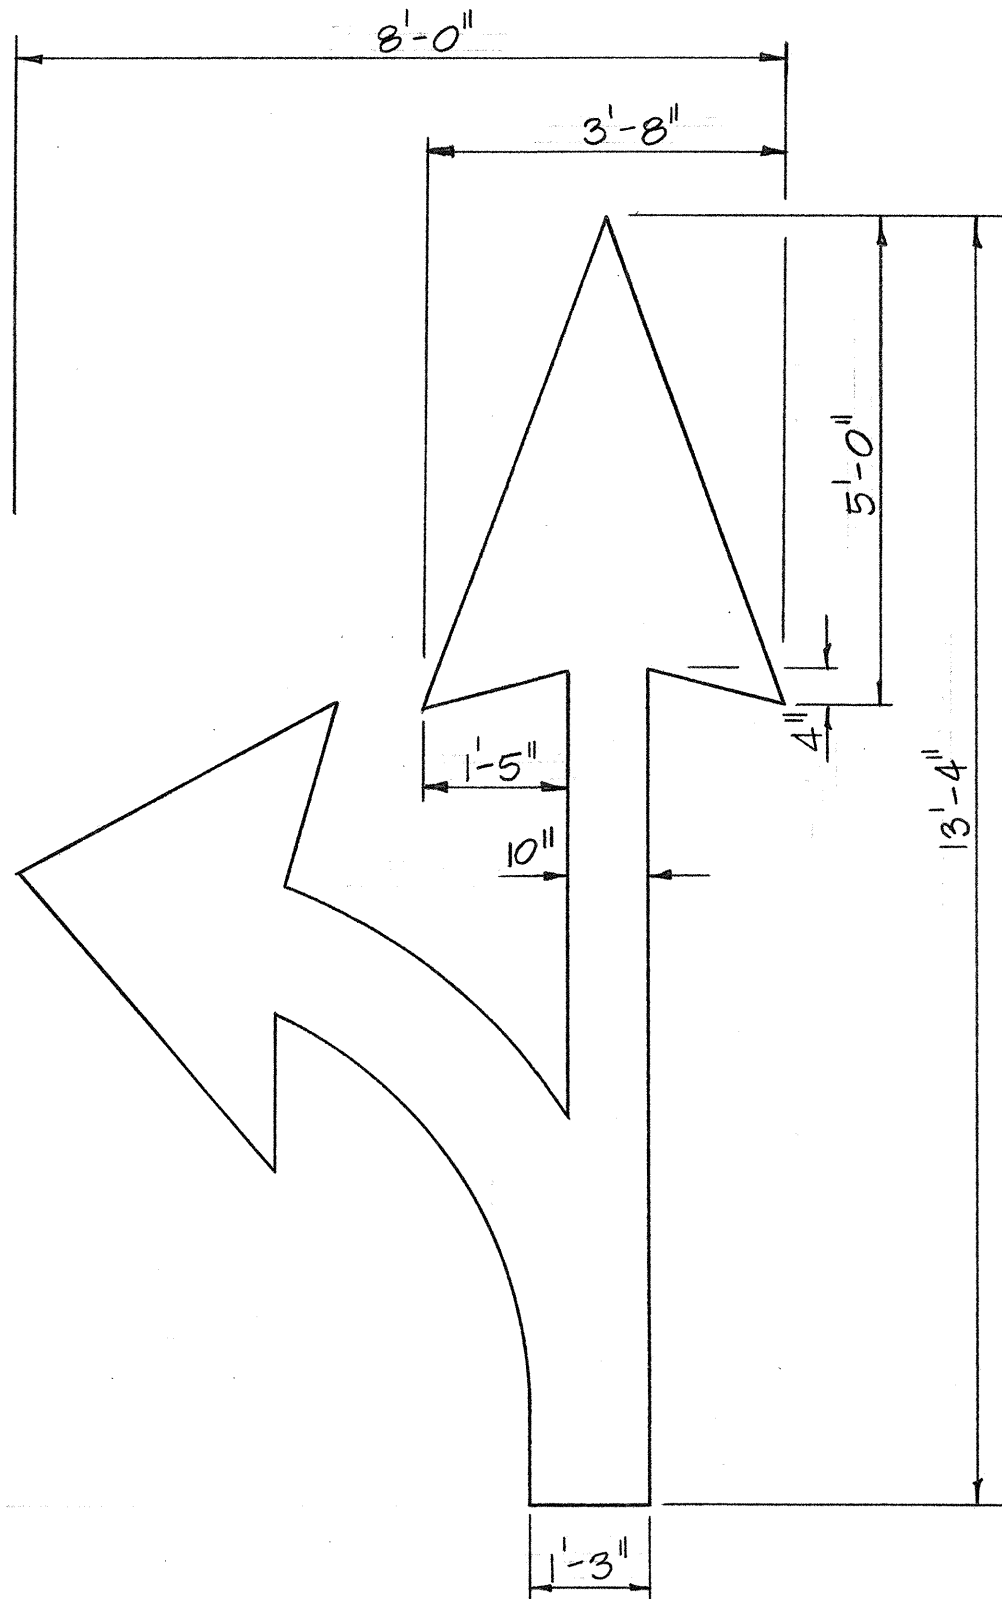

STATE OF HAWAII
DEPARTMENT OF TRANSPORTATION
HIGHWAYS DIVISION

PAVEMENT MARKINGS
IROQUOIS POINT ACCESS ROAD RESURFACING
Proj. No. 164A-01-73

Scale: As Shown
Date: Aug, 1973

SHEET No. 1 OF 1 SHEETS

ORIGINAL PLAN	DATE
DESIGNED BY	
QUANTITIES BY	
CHECKED BY	
NO.	