
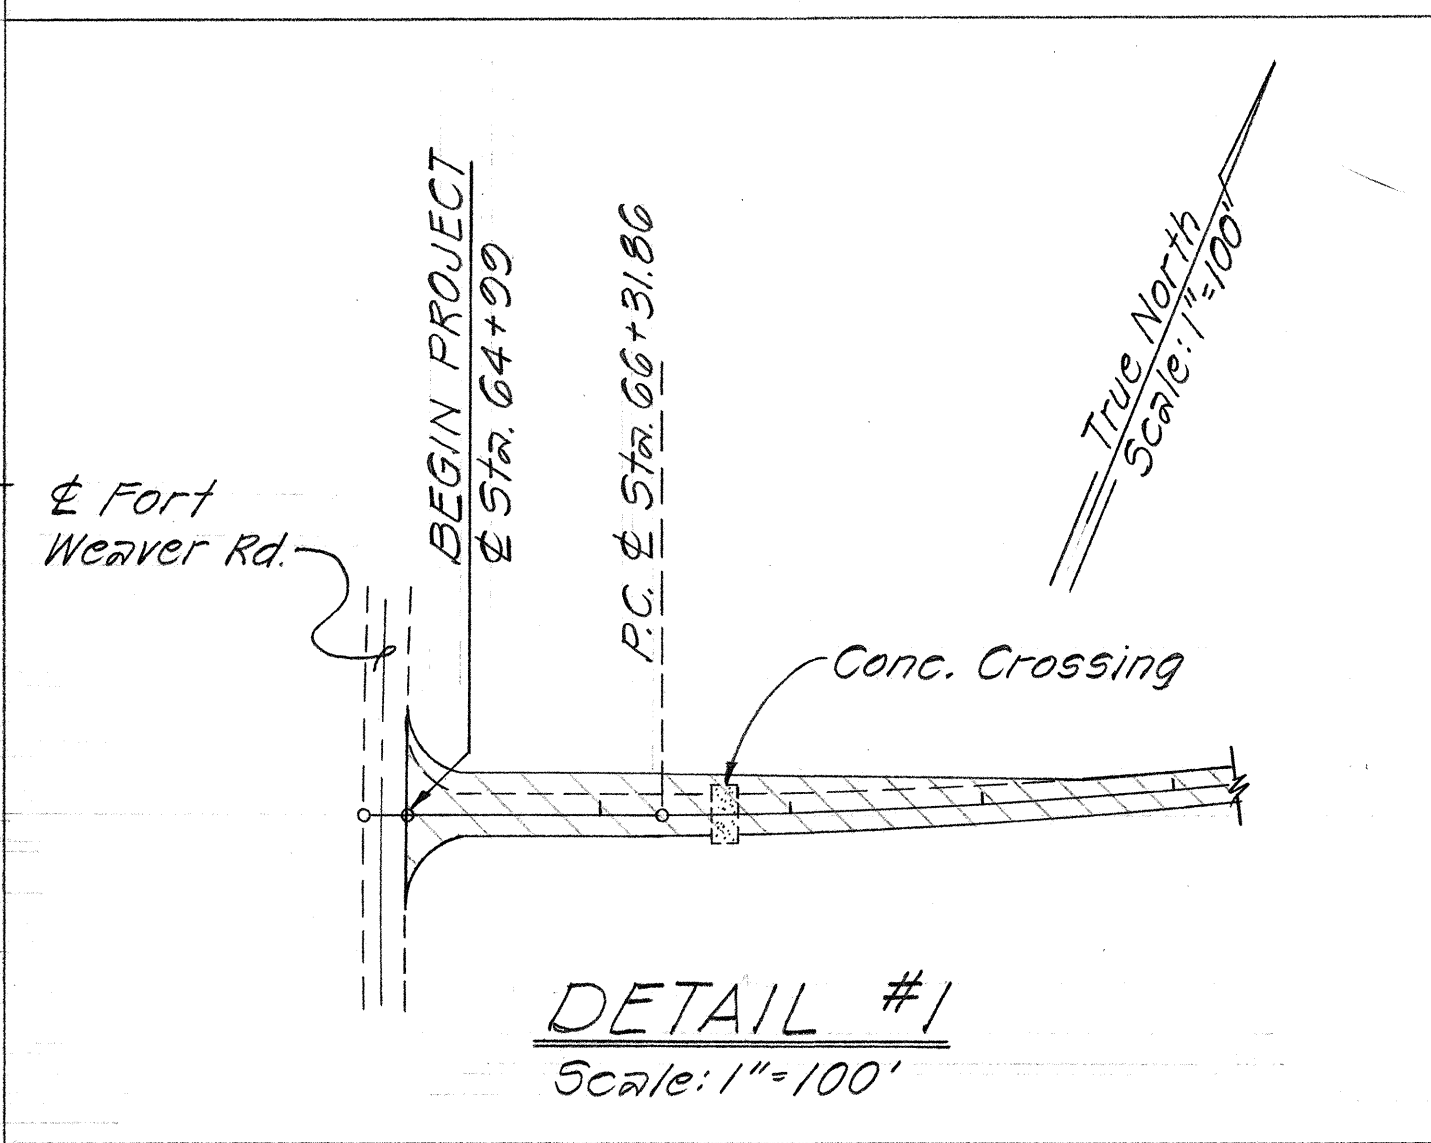
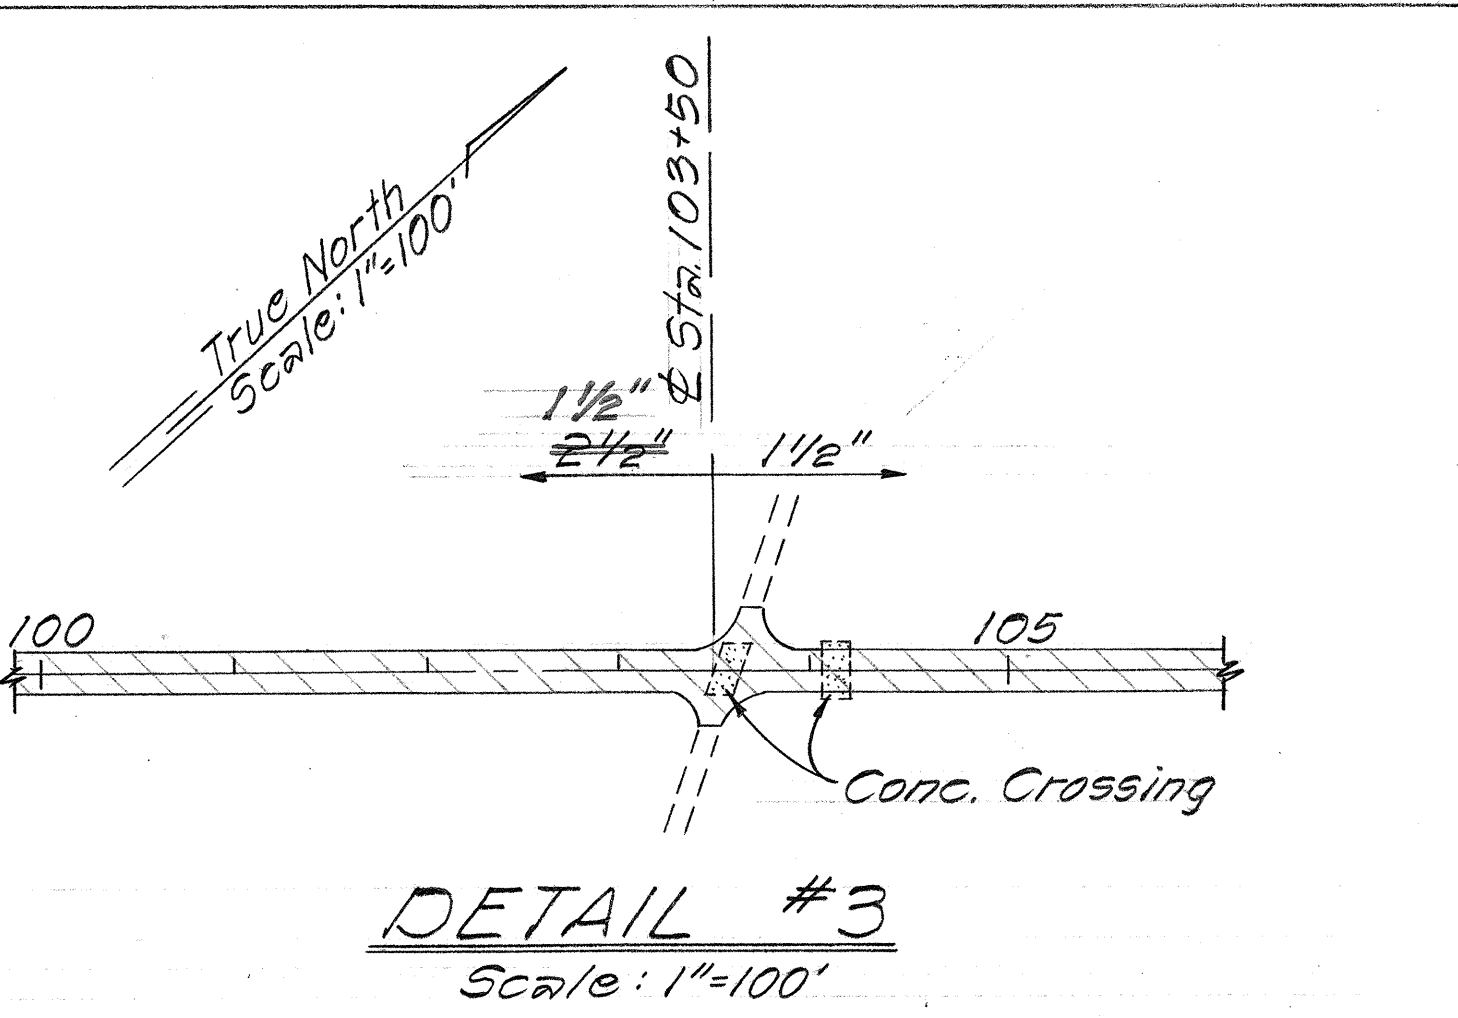
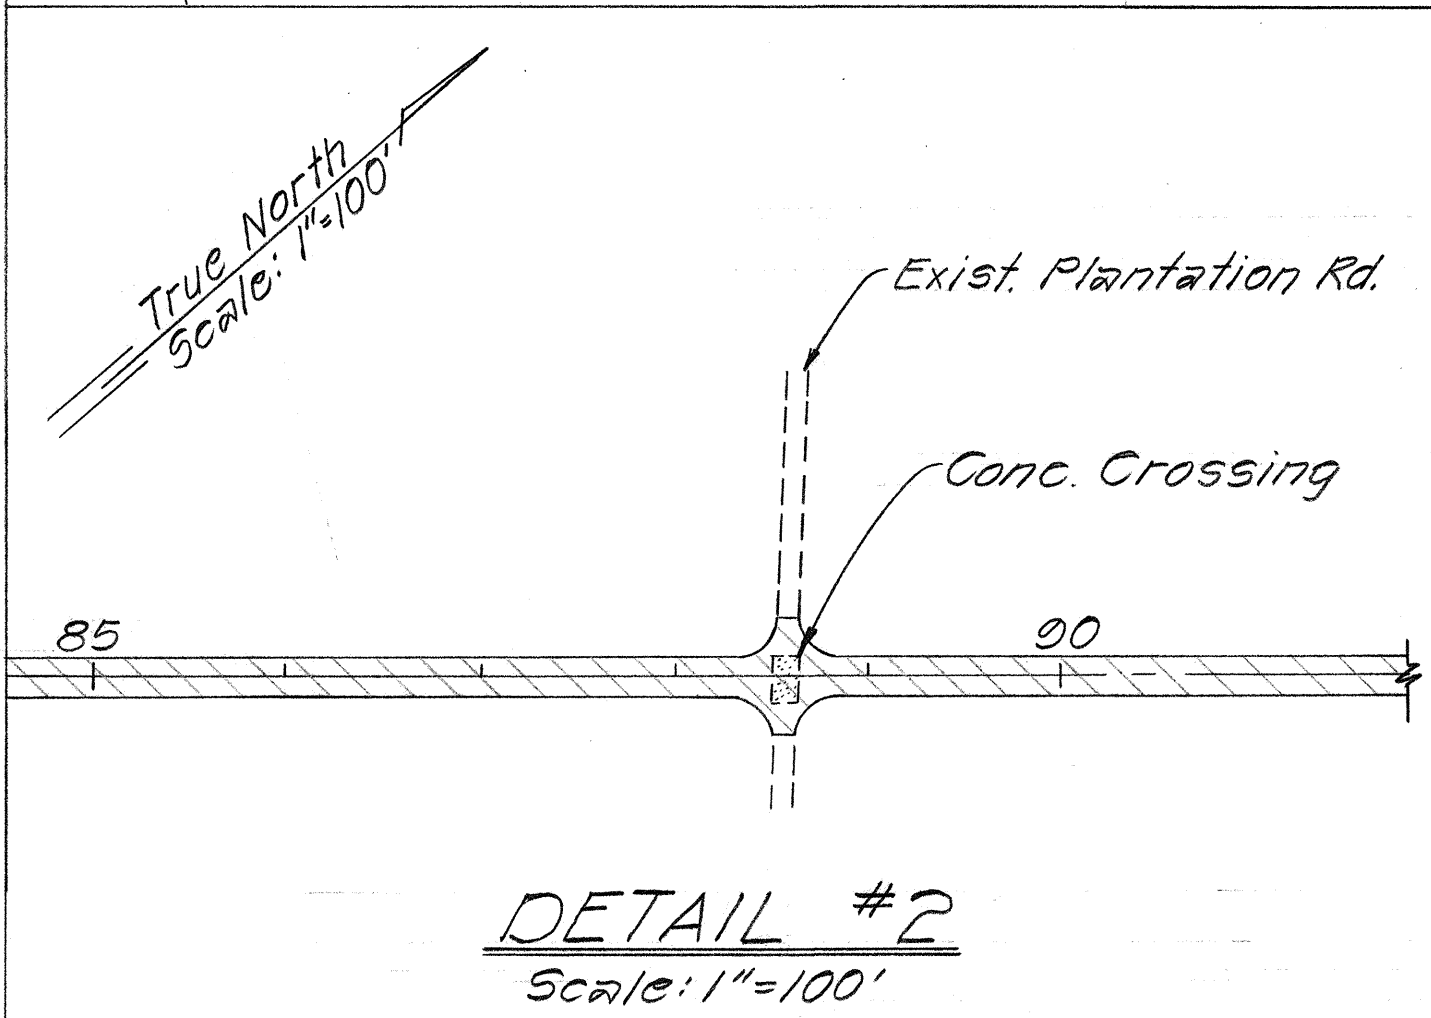


| FED. ROAD DIST. NO. | STATE | PROJ. NO.  | FISCAL YEAR | SHEET NO. | TOTAL SHEETS |
|---------------------|-------|------------|-------------|-----------|--------------|
| HAWAII              | HAW.  | 764A-01-73 | 1973        | 2         | 4            |

LEGEND

Areas to be Resurfaced

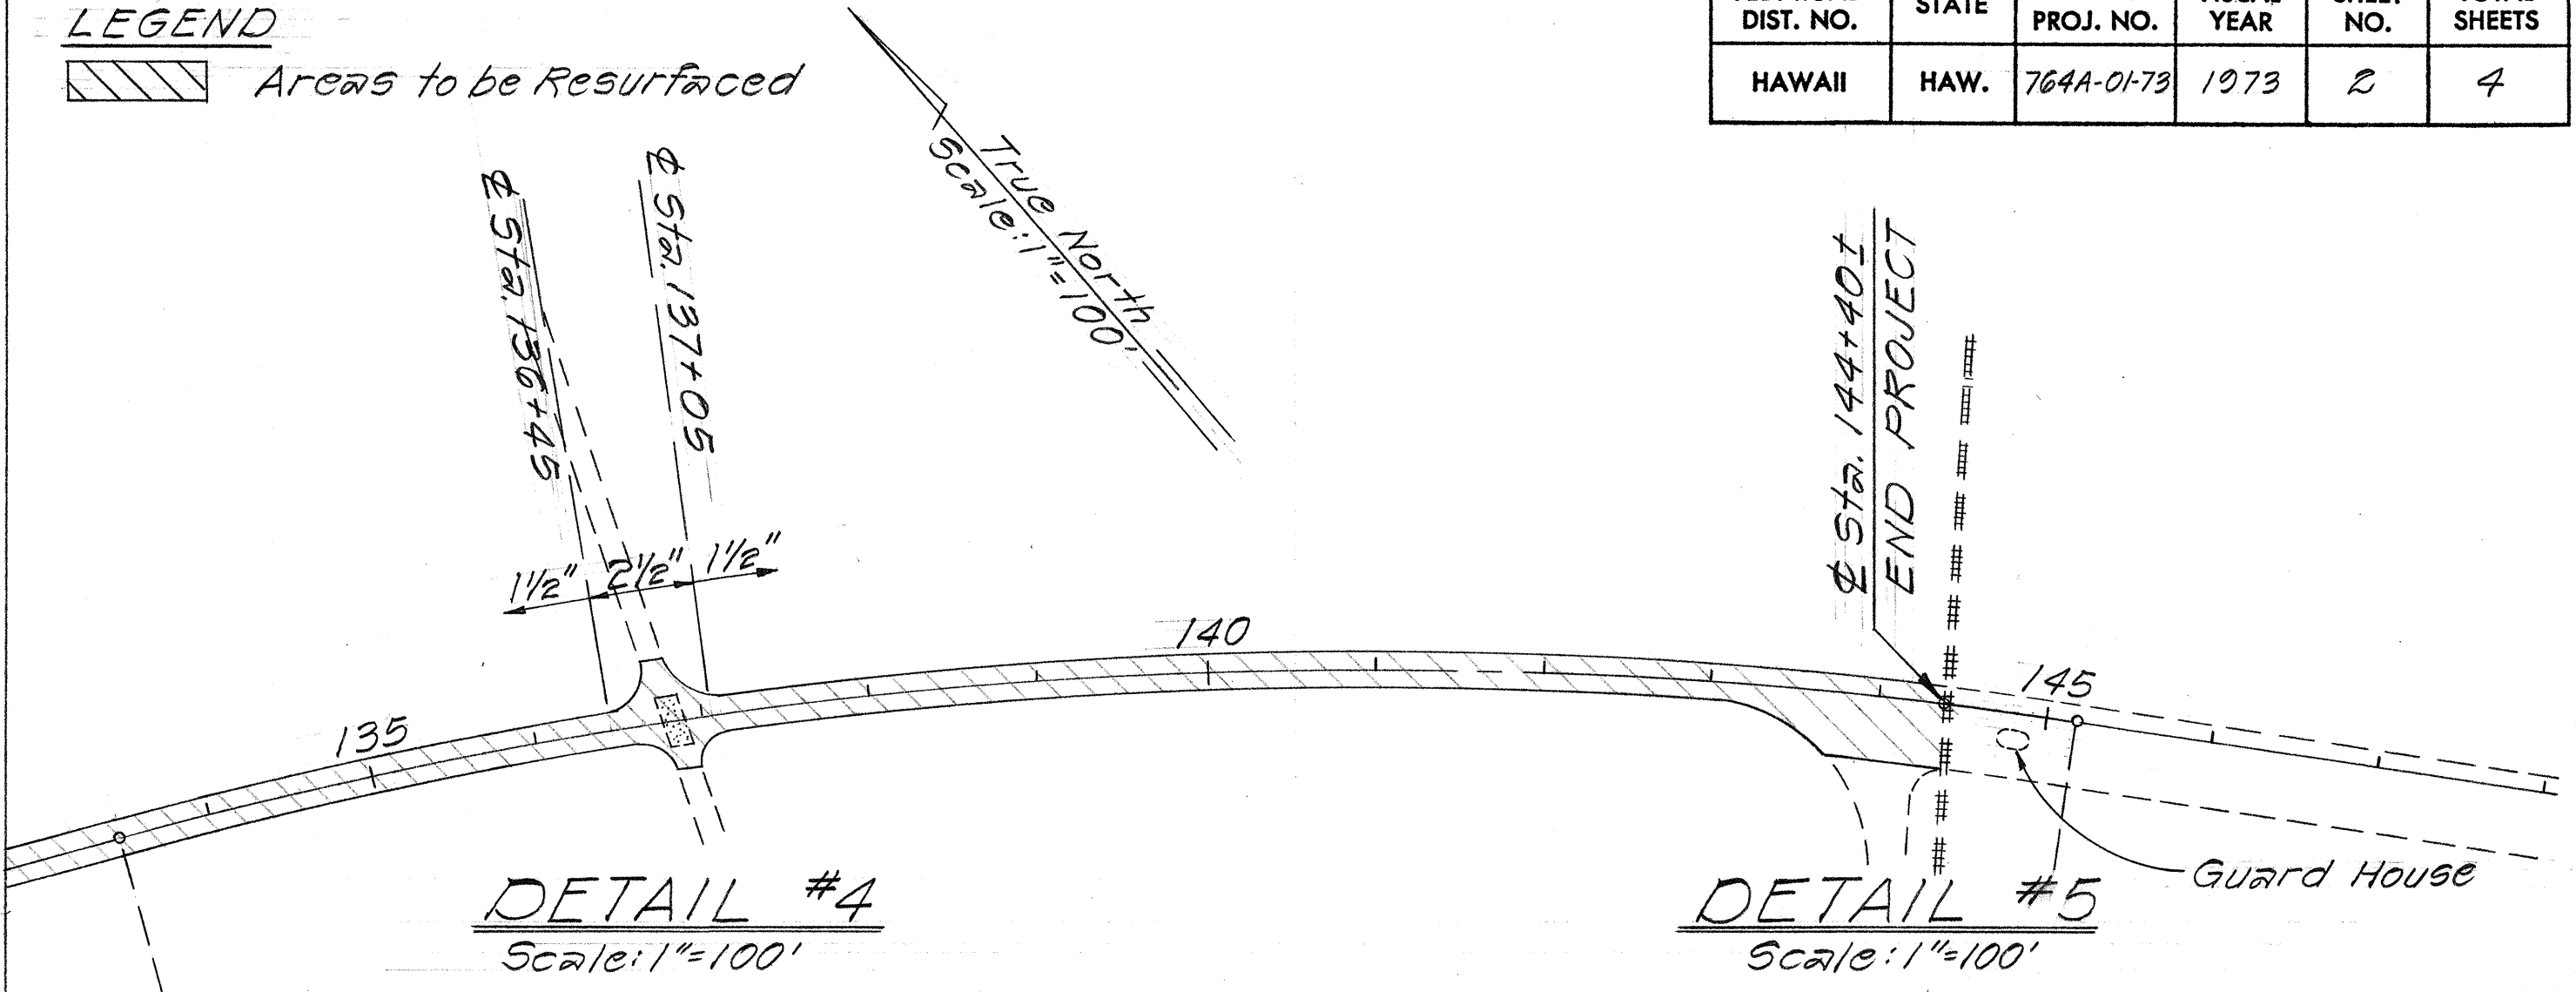


| RESURFACING SCHEDULE |                                             |
|----------------------|---------------------------------------------|
| * STATION            | A.C. PAVEMENT MIX NO. I OVERLAY THICKNESSES |
| 64+00 - 103+50       | 2 1/2" 1 1/2"                               |
| 103+50 - 136+45      | 1 1/2"                                      |
| 136+45 - 137+05      | 2 1/2"                                      |
| 137+05 - 144+40      | 1 1/2"                                      |

\* Exact Stationing will be determined by the Engineer.


TYPICAL SECTION ON TANGENT

Scale: 3/8"=1'-0"

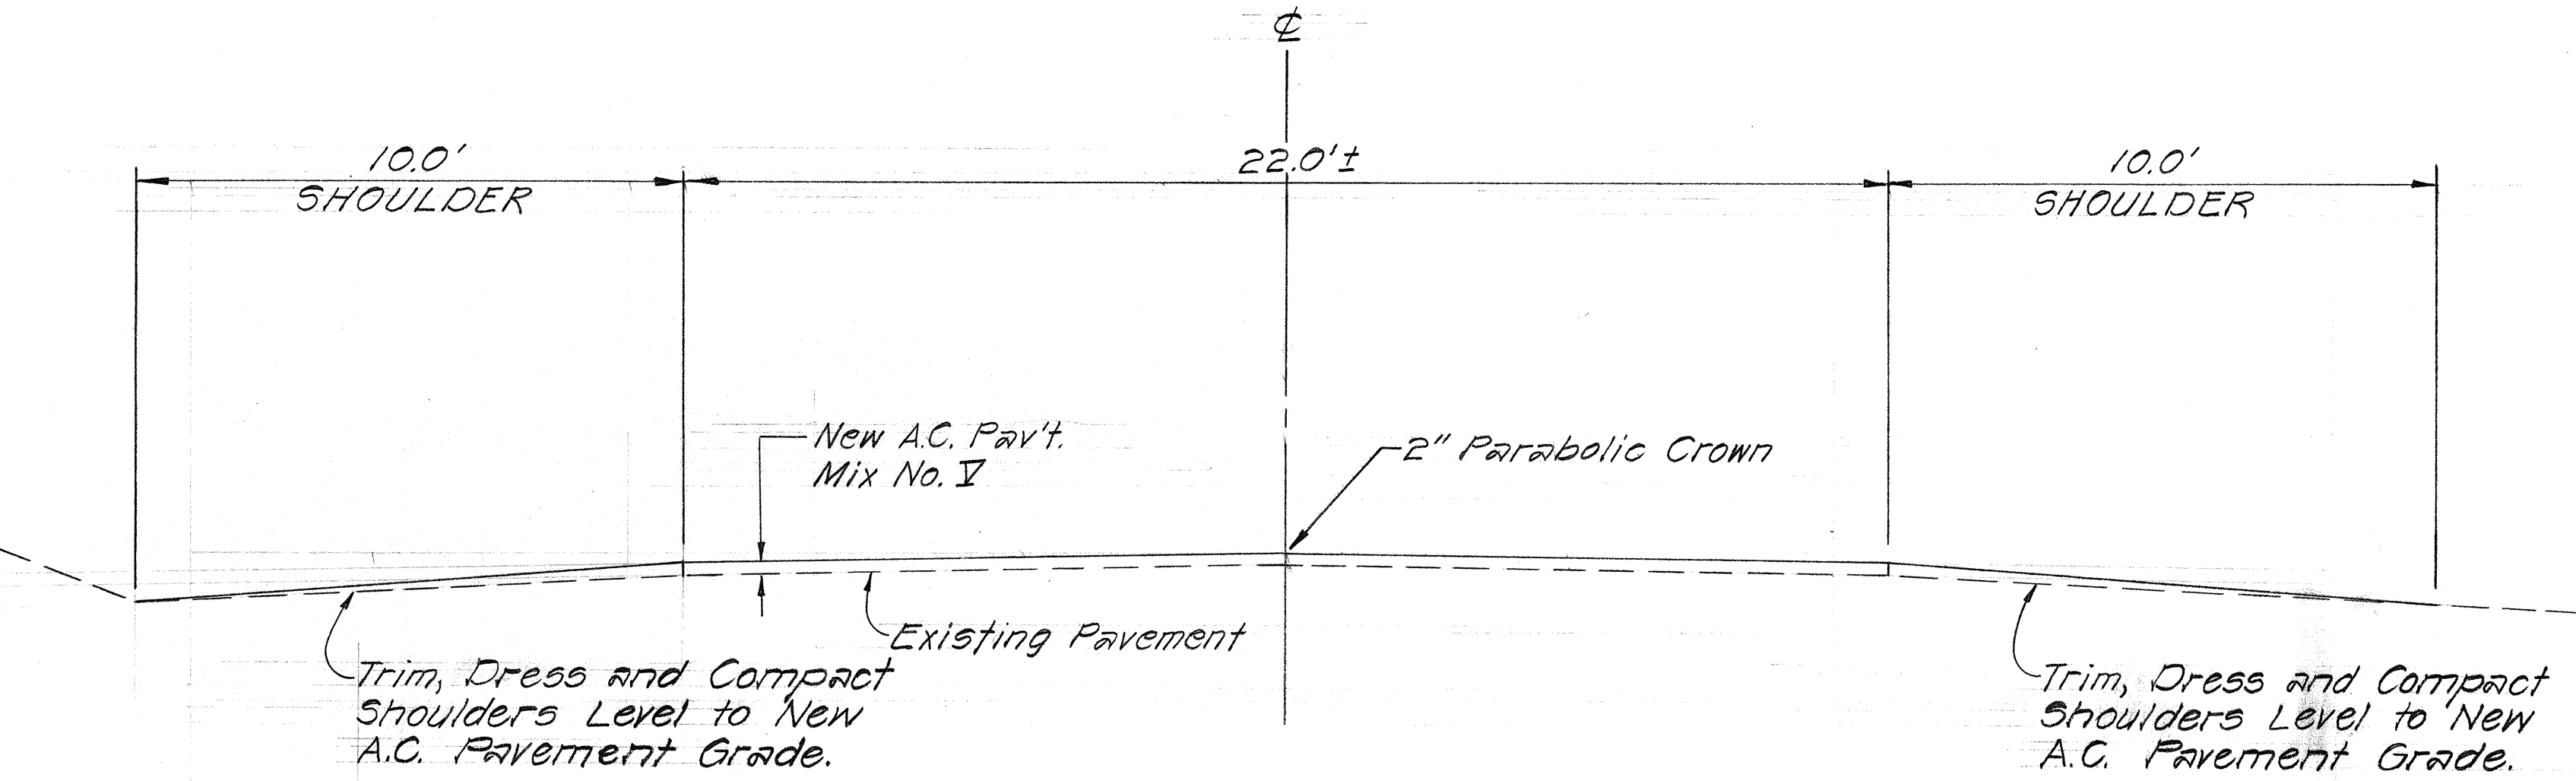

TYPICAL SECTION ON CURVE

Scale: 3/8"=1'-0"

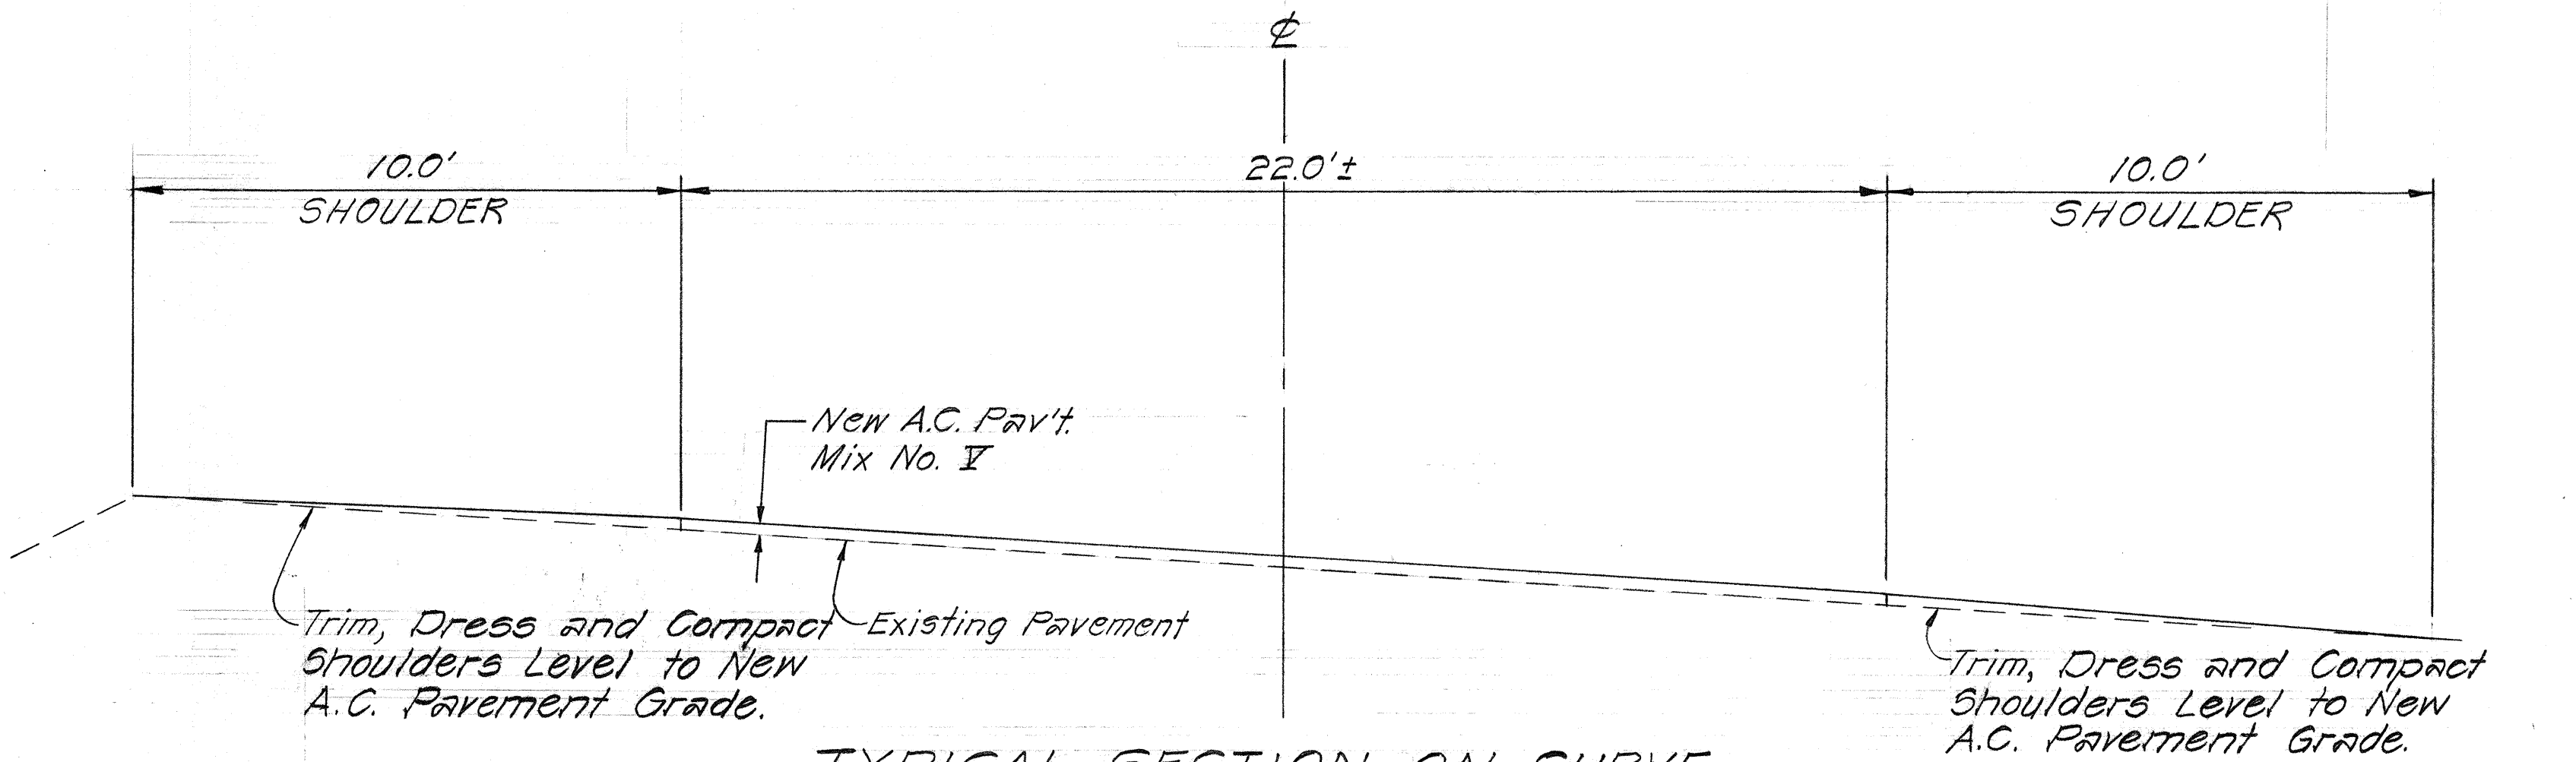

GENERAL NOTES

- All Stations referenced to Hawaii Project No. DA-NR-3(1)
- The existing pavement shall be cleaned according to Section 310 of the Standard Specifications. Payment incidental to A.C. Pavement.
- All holes, cracks and depressions encountered in the existing pavement shall be filled & compacted with A.C. Mix I prior to resurfacing. Payment incidental to A.C. Pavement.
- The prepared surface shall be tack coated and resurfaced to the thicknesses specified on the plans or as directed by the Engineer.
- Smooth riding transitions shall be provided at the beginning and end of the project, and at all connections and varying asphalt thicknesses.
- Existing concrete crossings shall be resurfaced by adjusting the resurfacing pavement thickness to provide as smooth and uninterrupted surface as possible as determined by the Engineer.
- Trimming & dressing of the shoulders shall include but not be limited to clearing, grubbing, grading and compacting the shoulder area as shown on the Typical Sections. Payment incidental to the various contract items.
- Pavement Markers shall be furnished and installed in accordance with the Special Provisions and as specified on the plans.

|             |  |
|-------------|--|
| DATE        |  |
| DESIGNED BY |  |
| CHECKED BY  |  |
| NO.         |  |

STATE OF HAWAII  
DEPARTMENT OF TRANSPORTATION  
HIGHWAYS DIVISION

TYPICAL SECTION, GENERAL NOTES  
AND MISCELLANEOUS DETAILS

IROQUOIS POINT ACCESS ROAD RESURFACING  
Proj. No. 764A-01-73

Scale: As Shown      Date: June, 1973  
SHEET NO. 1 OF 1 SHEETS