


FED. ROAD DIST. NO.	STATE	FED. AID PROJ. NO.	FISCAL YEAR	SHEET NO.	TOTAL SHEETS
HAWAII	HAW.	F-076-1(1)	1986	11	121


ORIGINAL SURVEYED BY DATE
 SURVEY PLOTTED BY
 NOTE BOOK NO. TEMP. DATE
 AREAS CHECKED

ORIGINAL SURVEYED BY DATE
 SURVEY PLOTTED BY
 NOTE BOOK NO. TEMP. DATE
 AREAS CHECKED

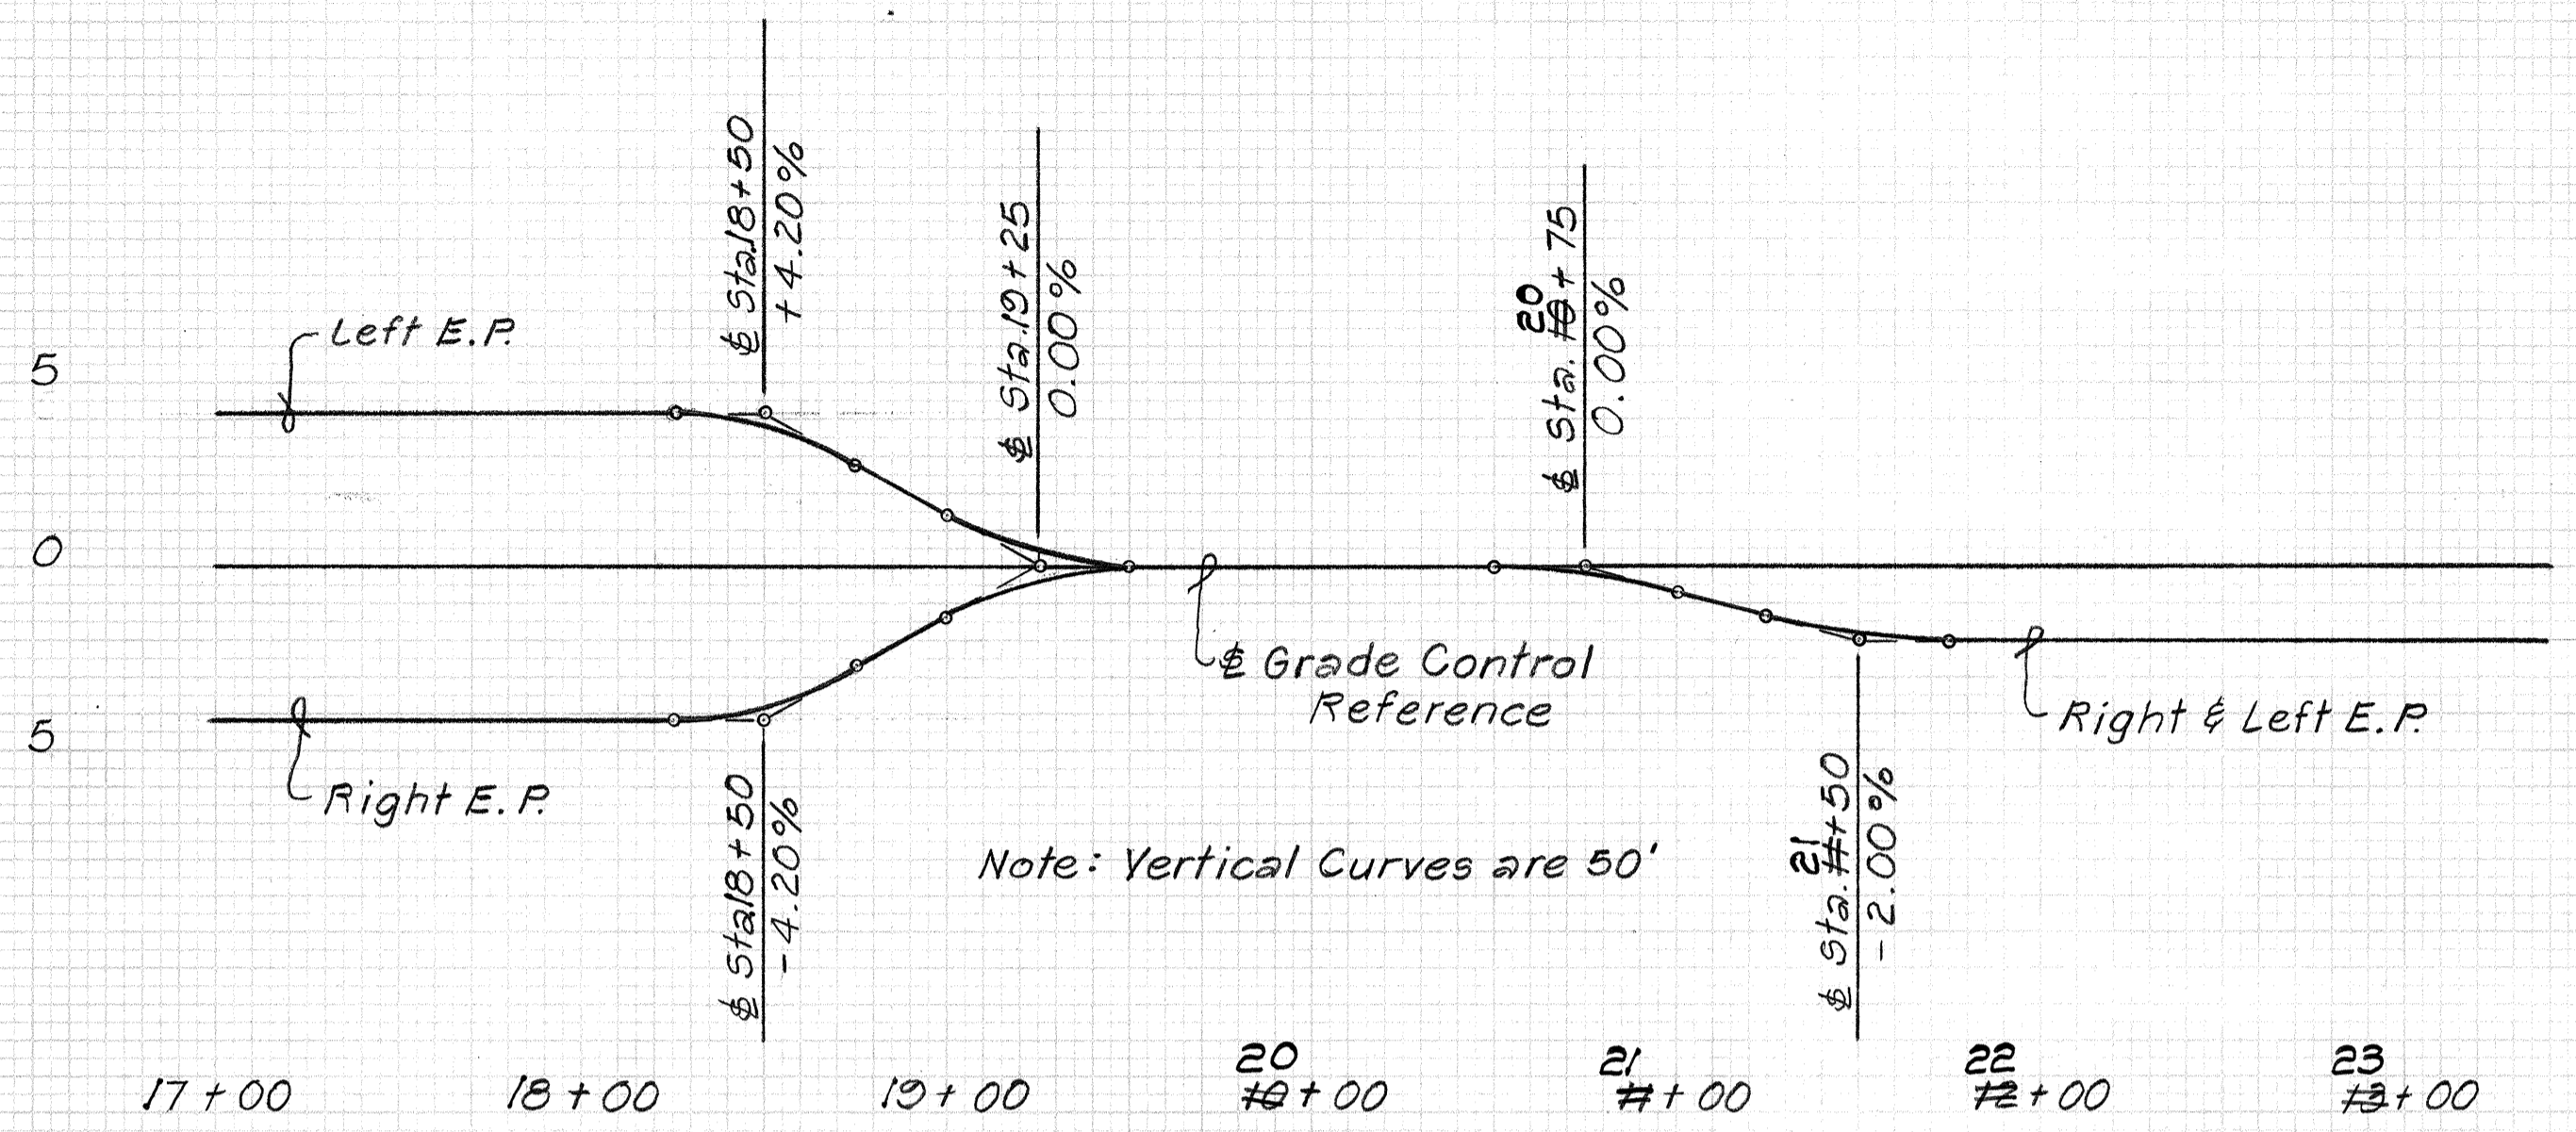

SUPERELEVATION OF RIGHT AND LEFT EDGE OF PAVEMENT
GEIGER ROAD

Scale: Horiz. 1" = 50'
 Vert. 1" = 5%

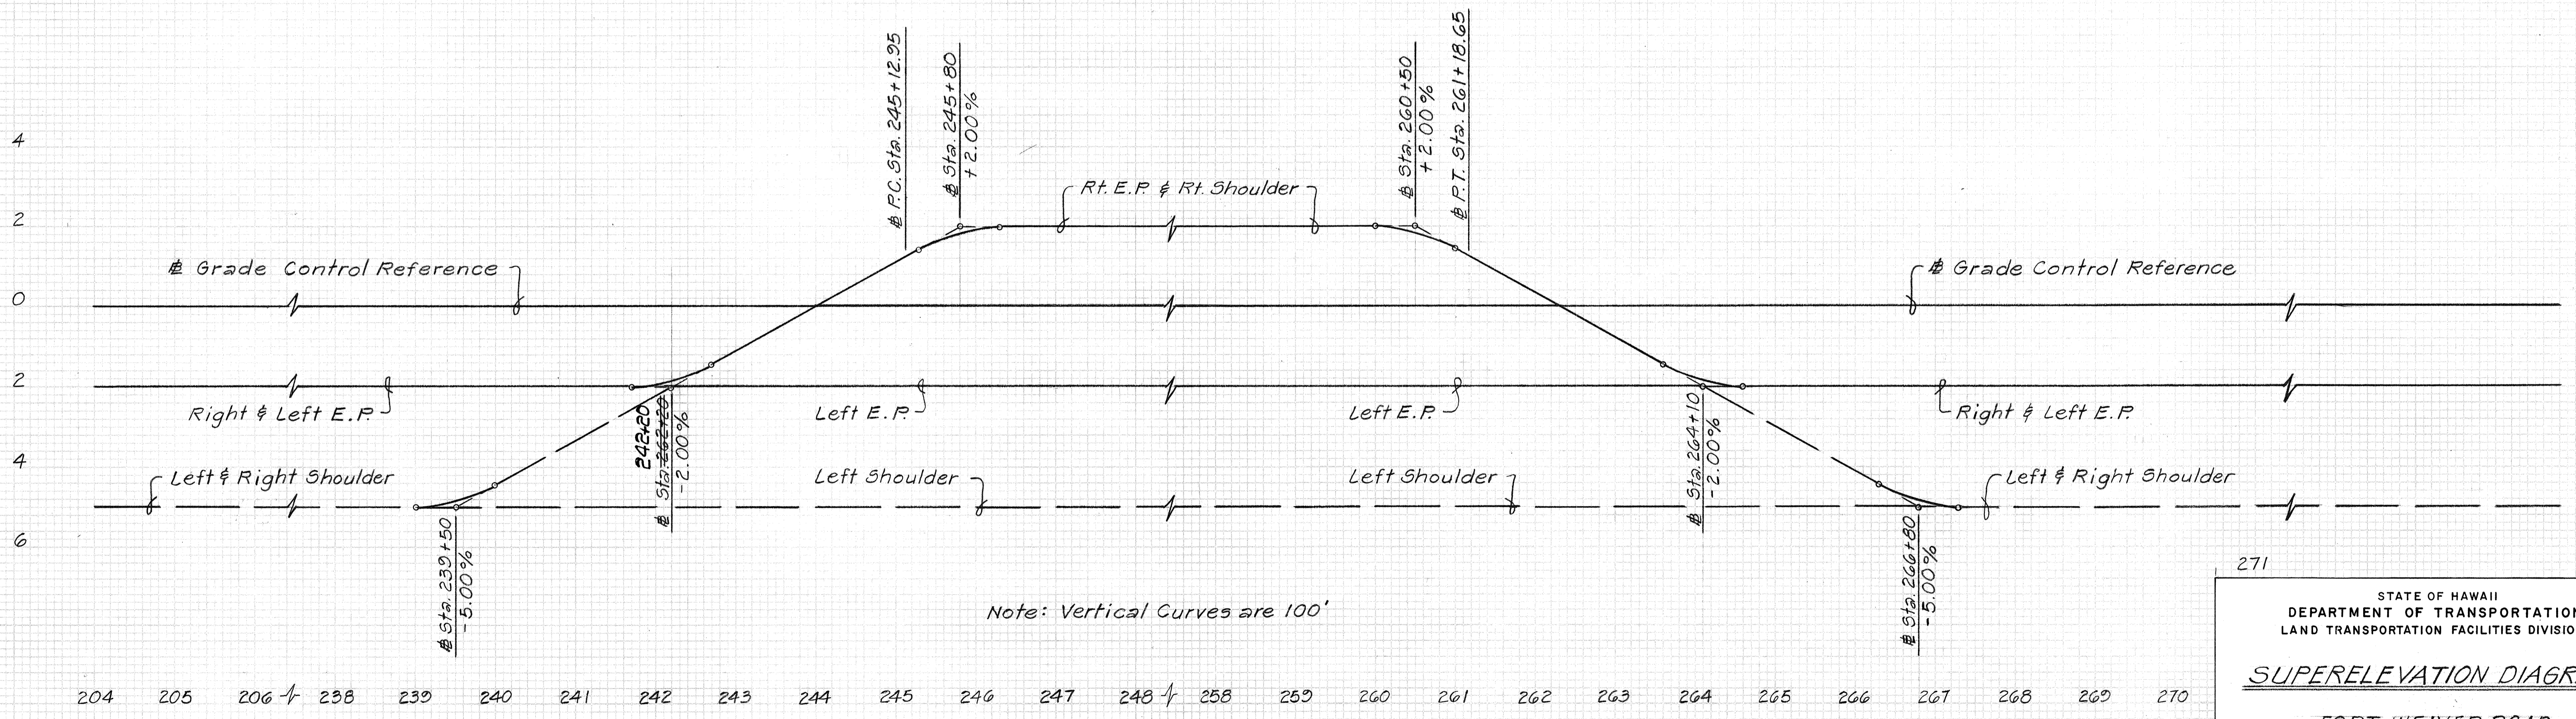

SUPERELEVATION OF RIGHT AND LEFT EDGE OF PAVEMENT AND SHOULDER
FORT WEAVER ROAD

Scale: Horiz. 1" = 100'
 Vert. 1" = 2%

271

STATE OF HAWAII
 DEPARTMENT OF TRANSPORTATION
 LAND TRANSPORTATION FACILITIES DIVISION

SUPERELEVATION DIAGRAM

FORT WEAVER ROAD
Renton Road to Hanakahi St.
F.A.P. Proj. No. F-076-1(1)

Scale: As Shown Date: Mar., 1979
 SHEET No. / OF / SHEETS