·	
	INDEX TO DRAWINGS
SHEET NO.	DESCRIPTION
	TITLE SHEET
2	STANDARD PLANS SUMMARY
. 3	GENERAL NOTES
secretary to a composition of the second constants.	TYPICAL SECTIONS
5 - 8	ROADWAY PLANS
9 - 12	SIGNING & PAVEMENT MARKINGS NOTES & DETAILS
Marie Control of the	
,	
,	

STATE OF HAWAII

DEPARTMENT OF TRANSPORTATION

HIGHWAYS DIVISION HONOLULU, HAWAII


"AS-BUILT"


PLANS FOR

IROQUOIS POINT ROAD RESURFACING

FORT WEAVER ROAD TO MILITARY GATE PROJECT NO. 7141A-01-88M

DISTRICT OF EWA

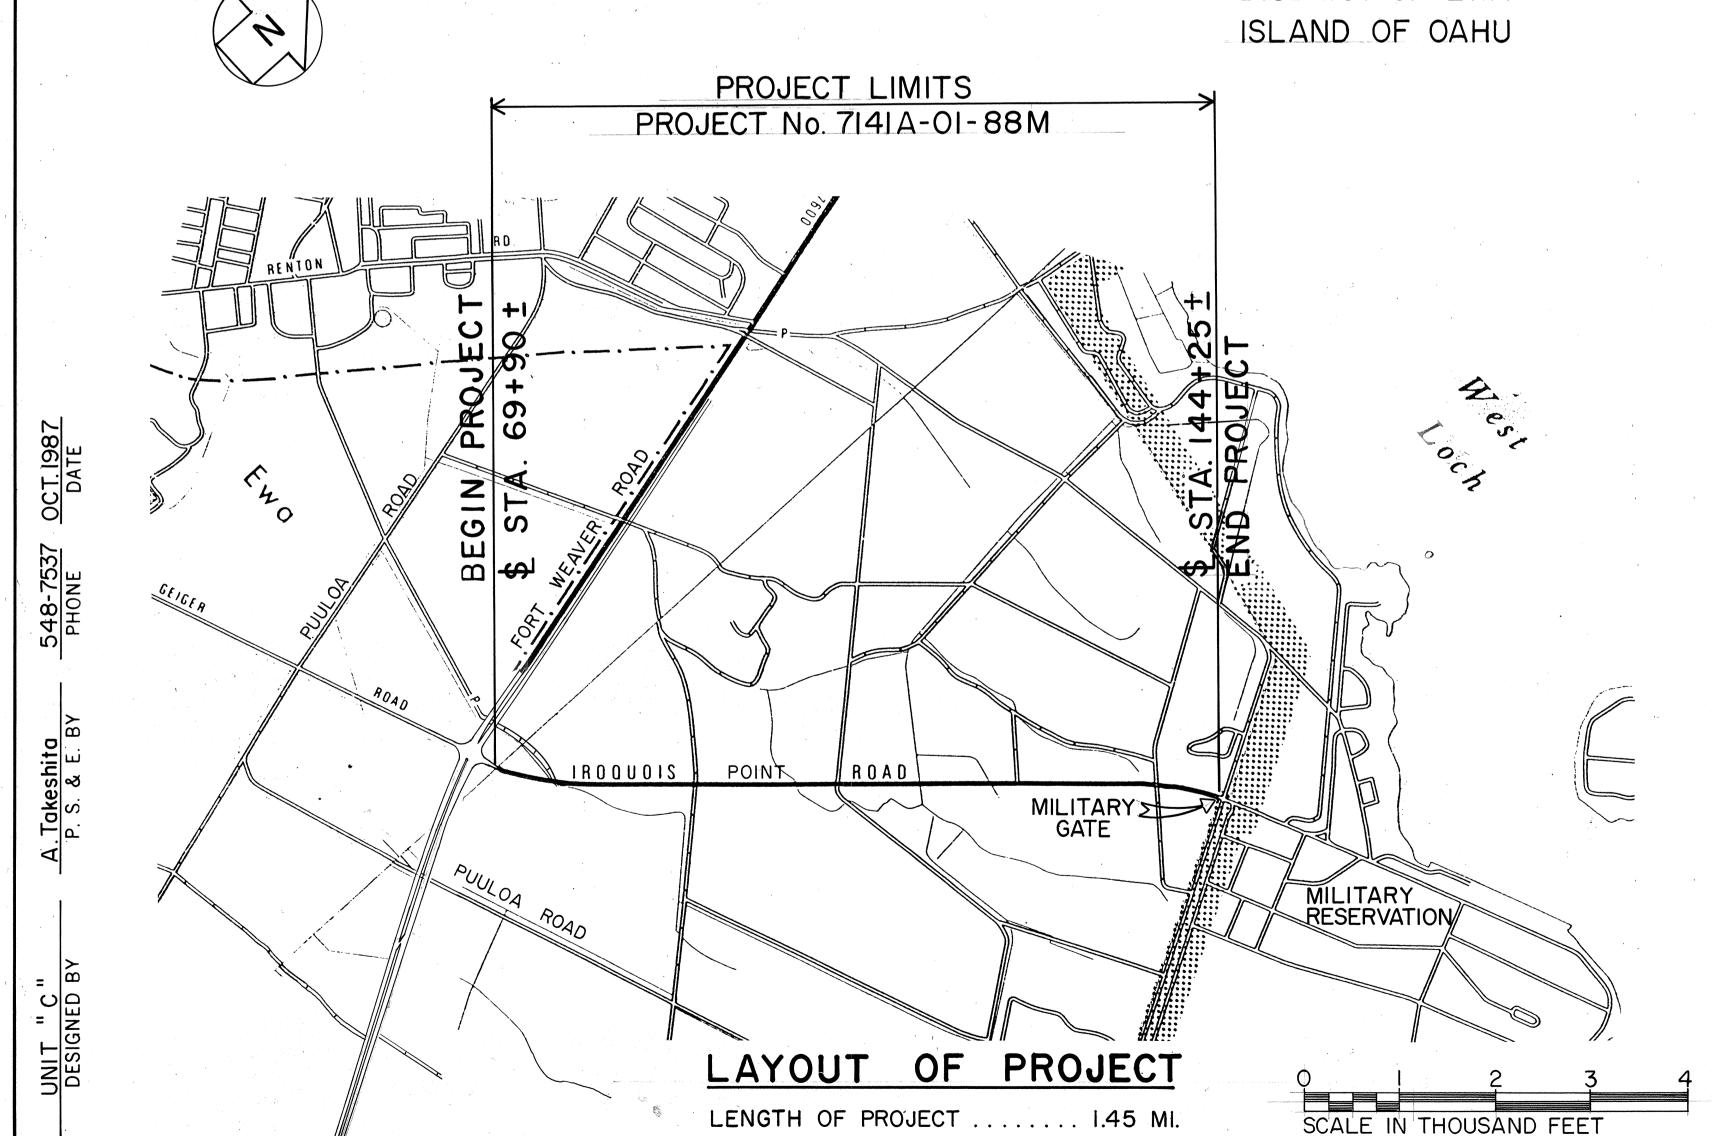

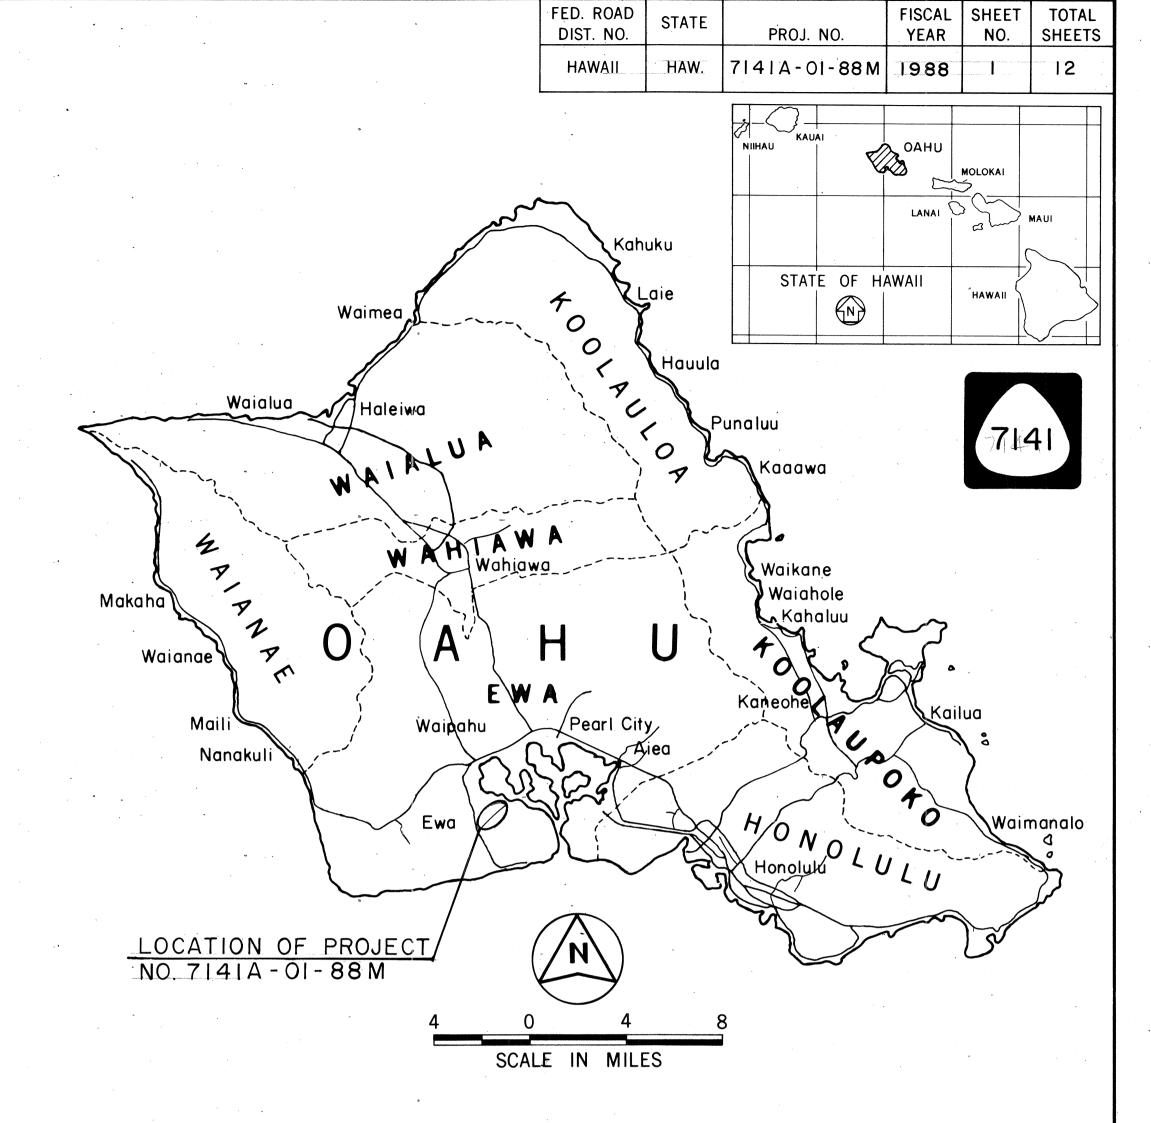

NO SIGNIFICANT CHANGES WERE MADE DURING CONSTRUCTION ON THE PLANS EXCEPT CHANGES IN THE ORIGINAL THEORETICAL QUANTITIES. FOR ACTUAL QUANTITIES, REFER TO PROJECT LEDGER AND/OR COMPUTATION BOOK.

DEPARTMENT OF TRANSPORTATION STATE OF HAWAII APPROVED: