

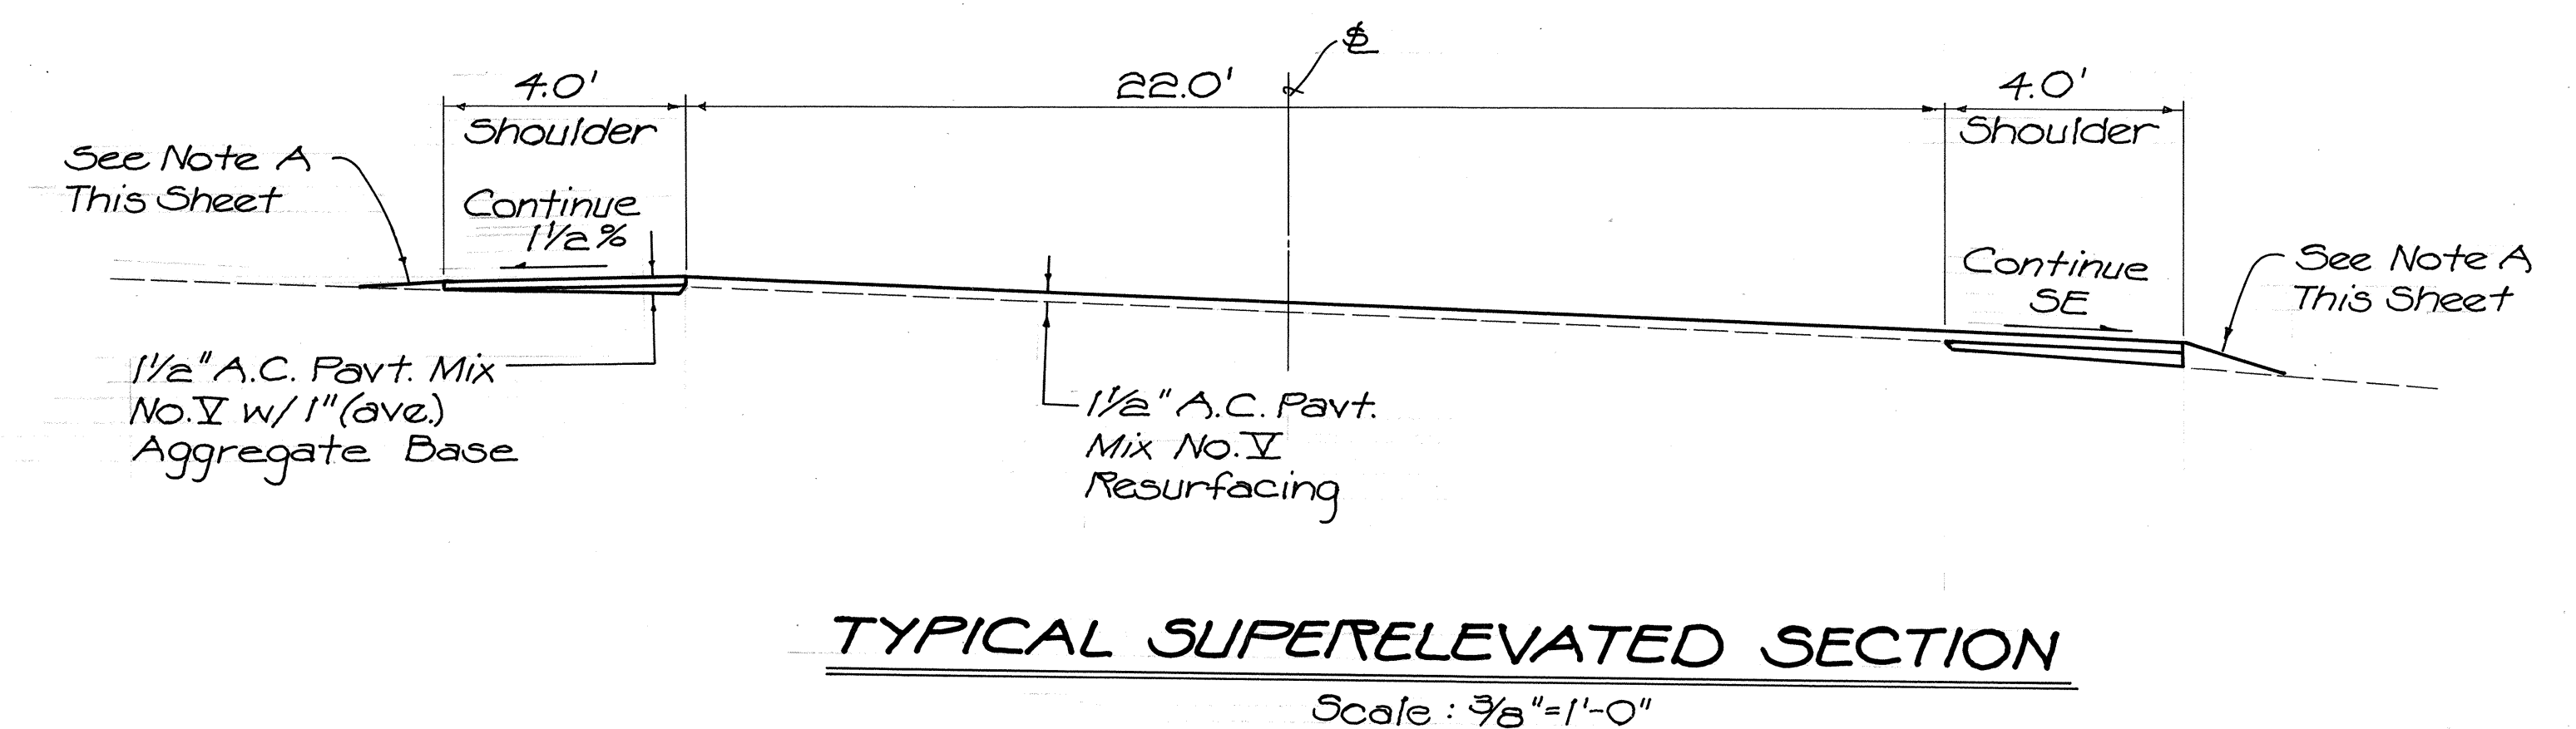
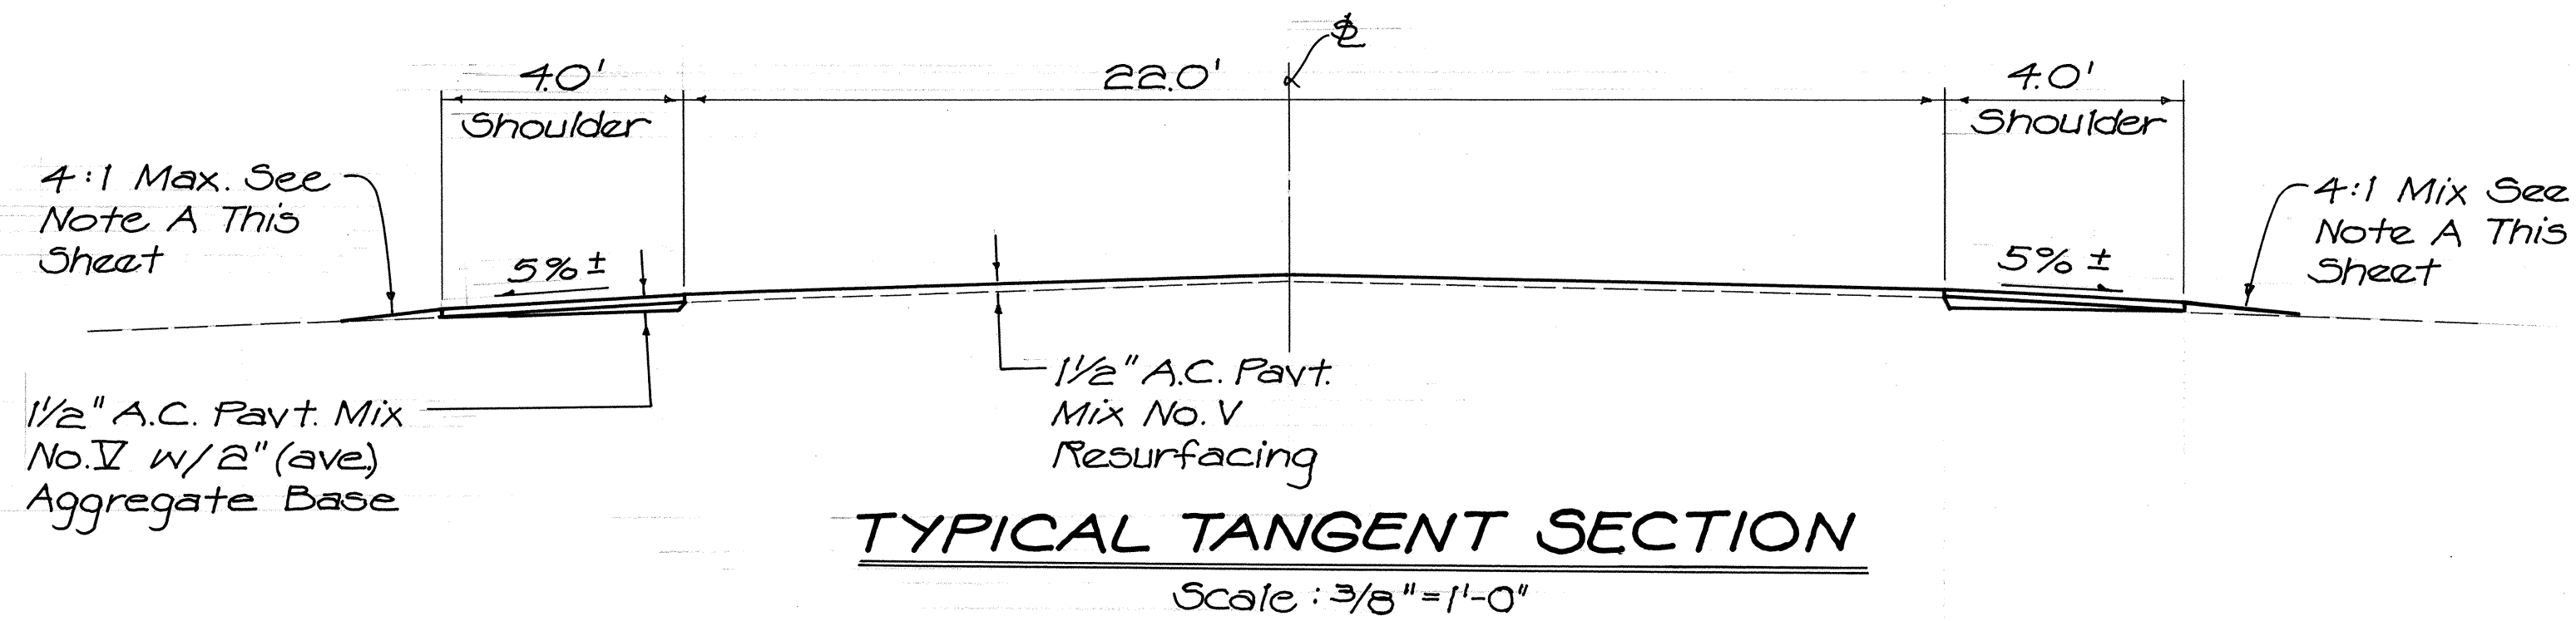
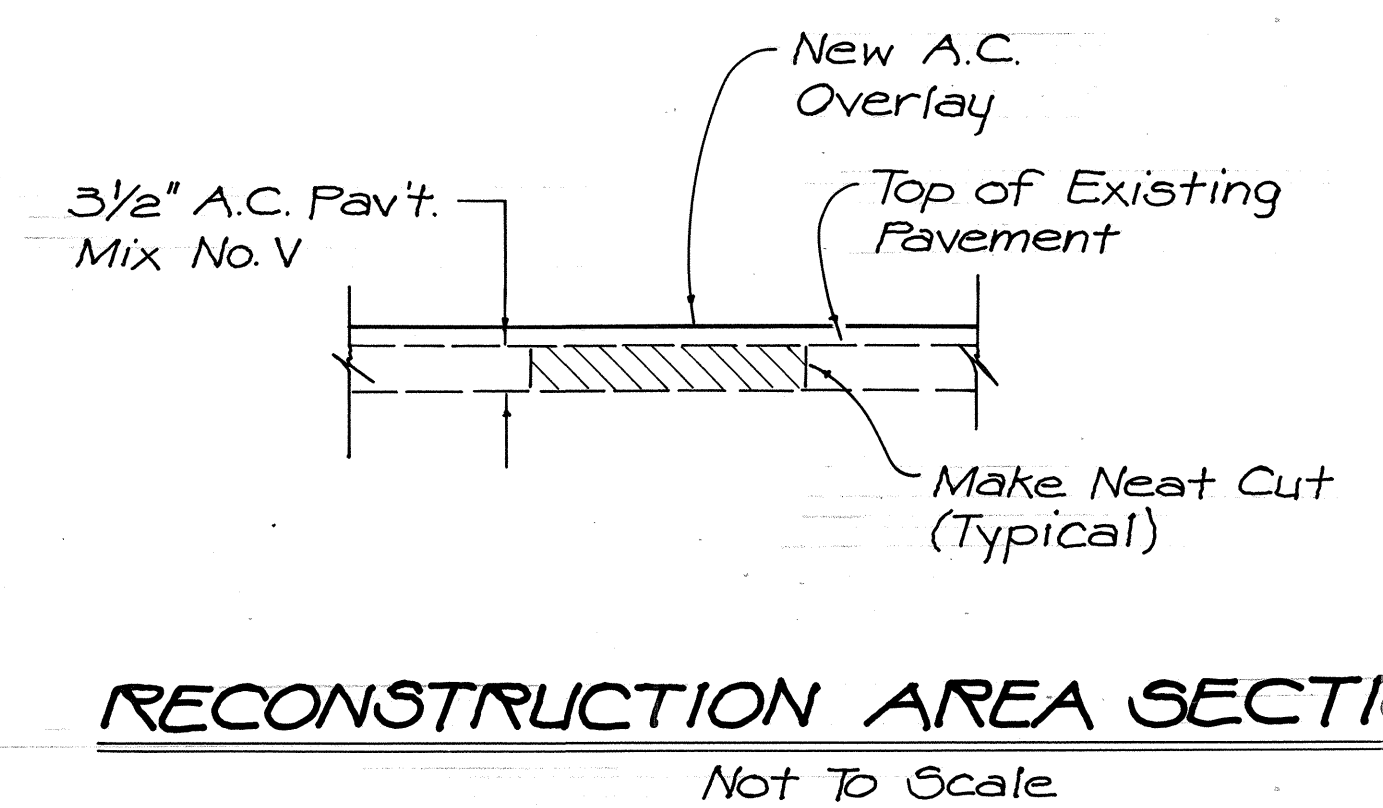
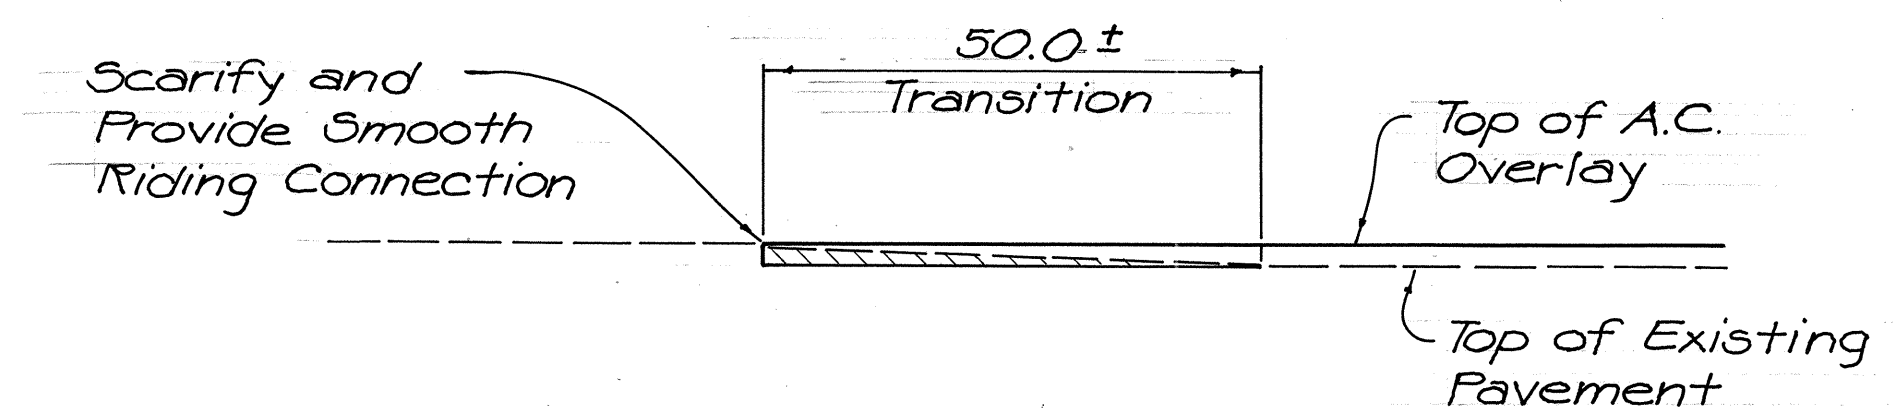


FED. ROAD DIST. NO.	STATE	FED. AID PROJ. NO.	FISCAL YEAR	SHEET NO.	TOTAL SHEETS
HAWAII	HAW.	7141A-01-88M	1988	4	12

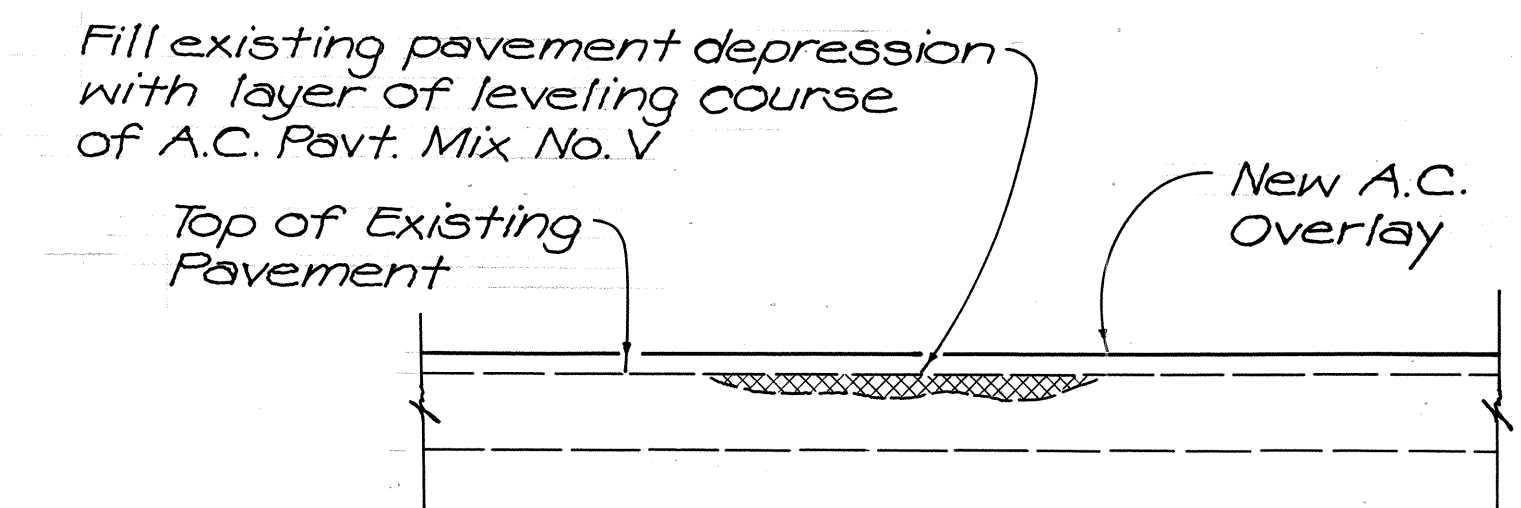

Note A:
Dress existing earthen shoulder by clearing and grubbing; and backfilling, grading and compacting with aggregate material as directed by the Engineer. Payment for this work will be considered incidental to the aggregate base item.

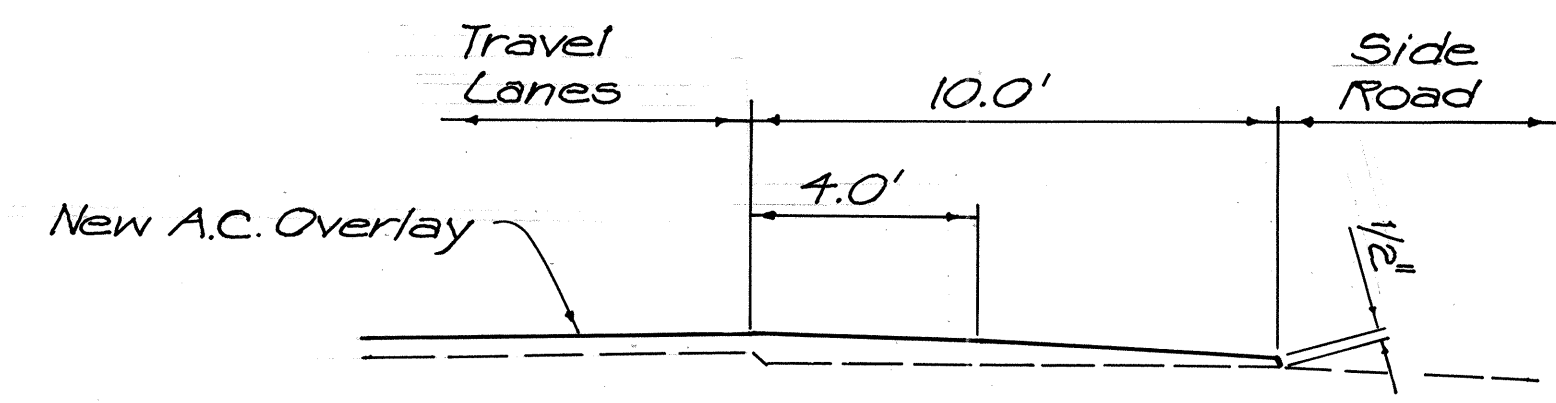

STATE OF HAWAII
DEPARTMENT OF TRANSPORTATION
HIGHWAYS DIVISION

TYPICAL SECTIONS
IROQUOIS POINT ROAD RESURFACING
Port Weaver Rd. To Military Gate
Proj No. 7141A-01-88M
Scale: As Shown Date: Nov., 1987
SHEET NO. 1 OF 1 SHEETS

SURVEY PLOTTED BY	DATE
DRAWN BY	
TRACED BY	
DESIGNED BY	
CHECKED BY	
NOTE BOOK	
NO.	