



FED. ROAD DIST. NO.	STATE	FED. AID PROJ. NO.	FISCAL YEAR	SHEET NO.	TOTAL SHEETS
HAWAII	HAW.	STP-0300(39)	1996	24	70

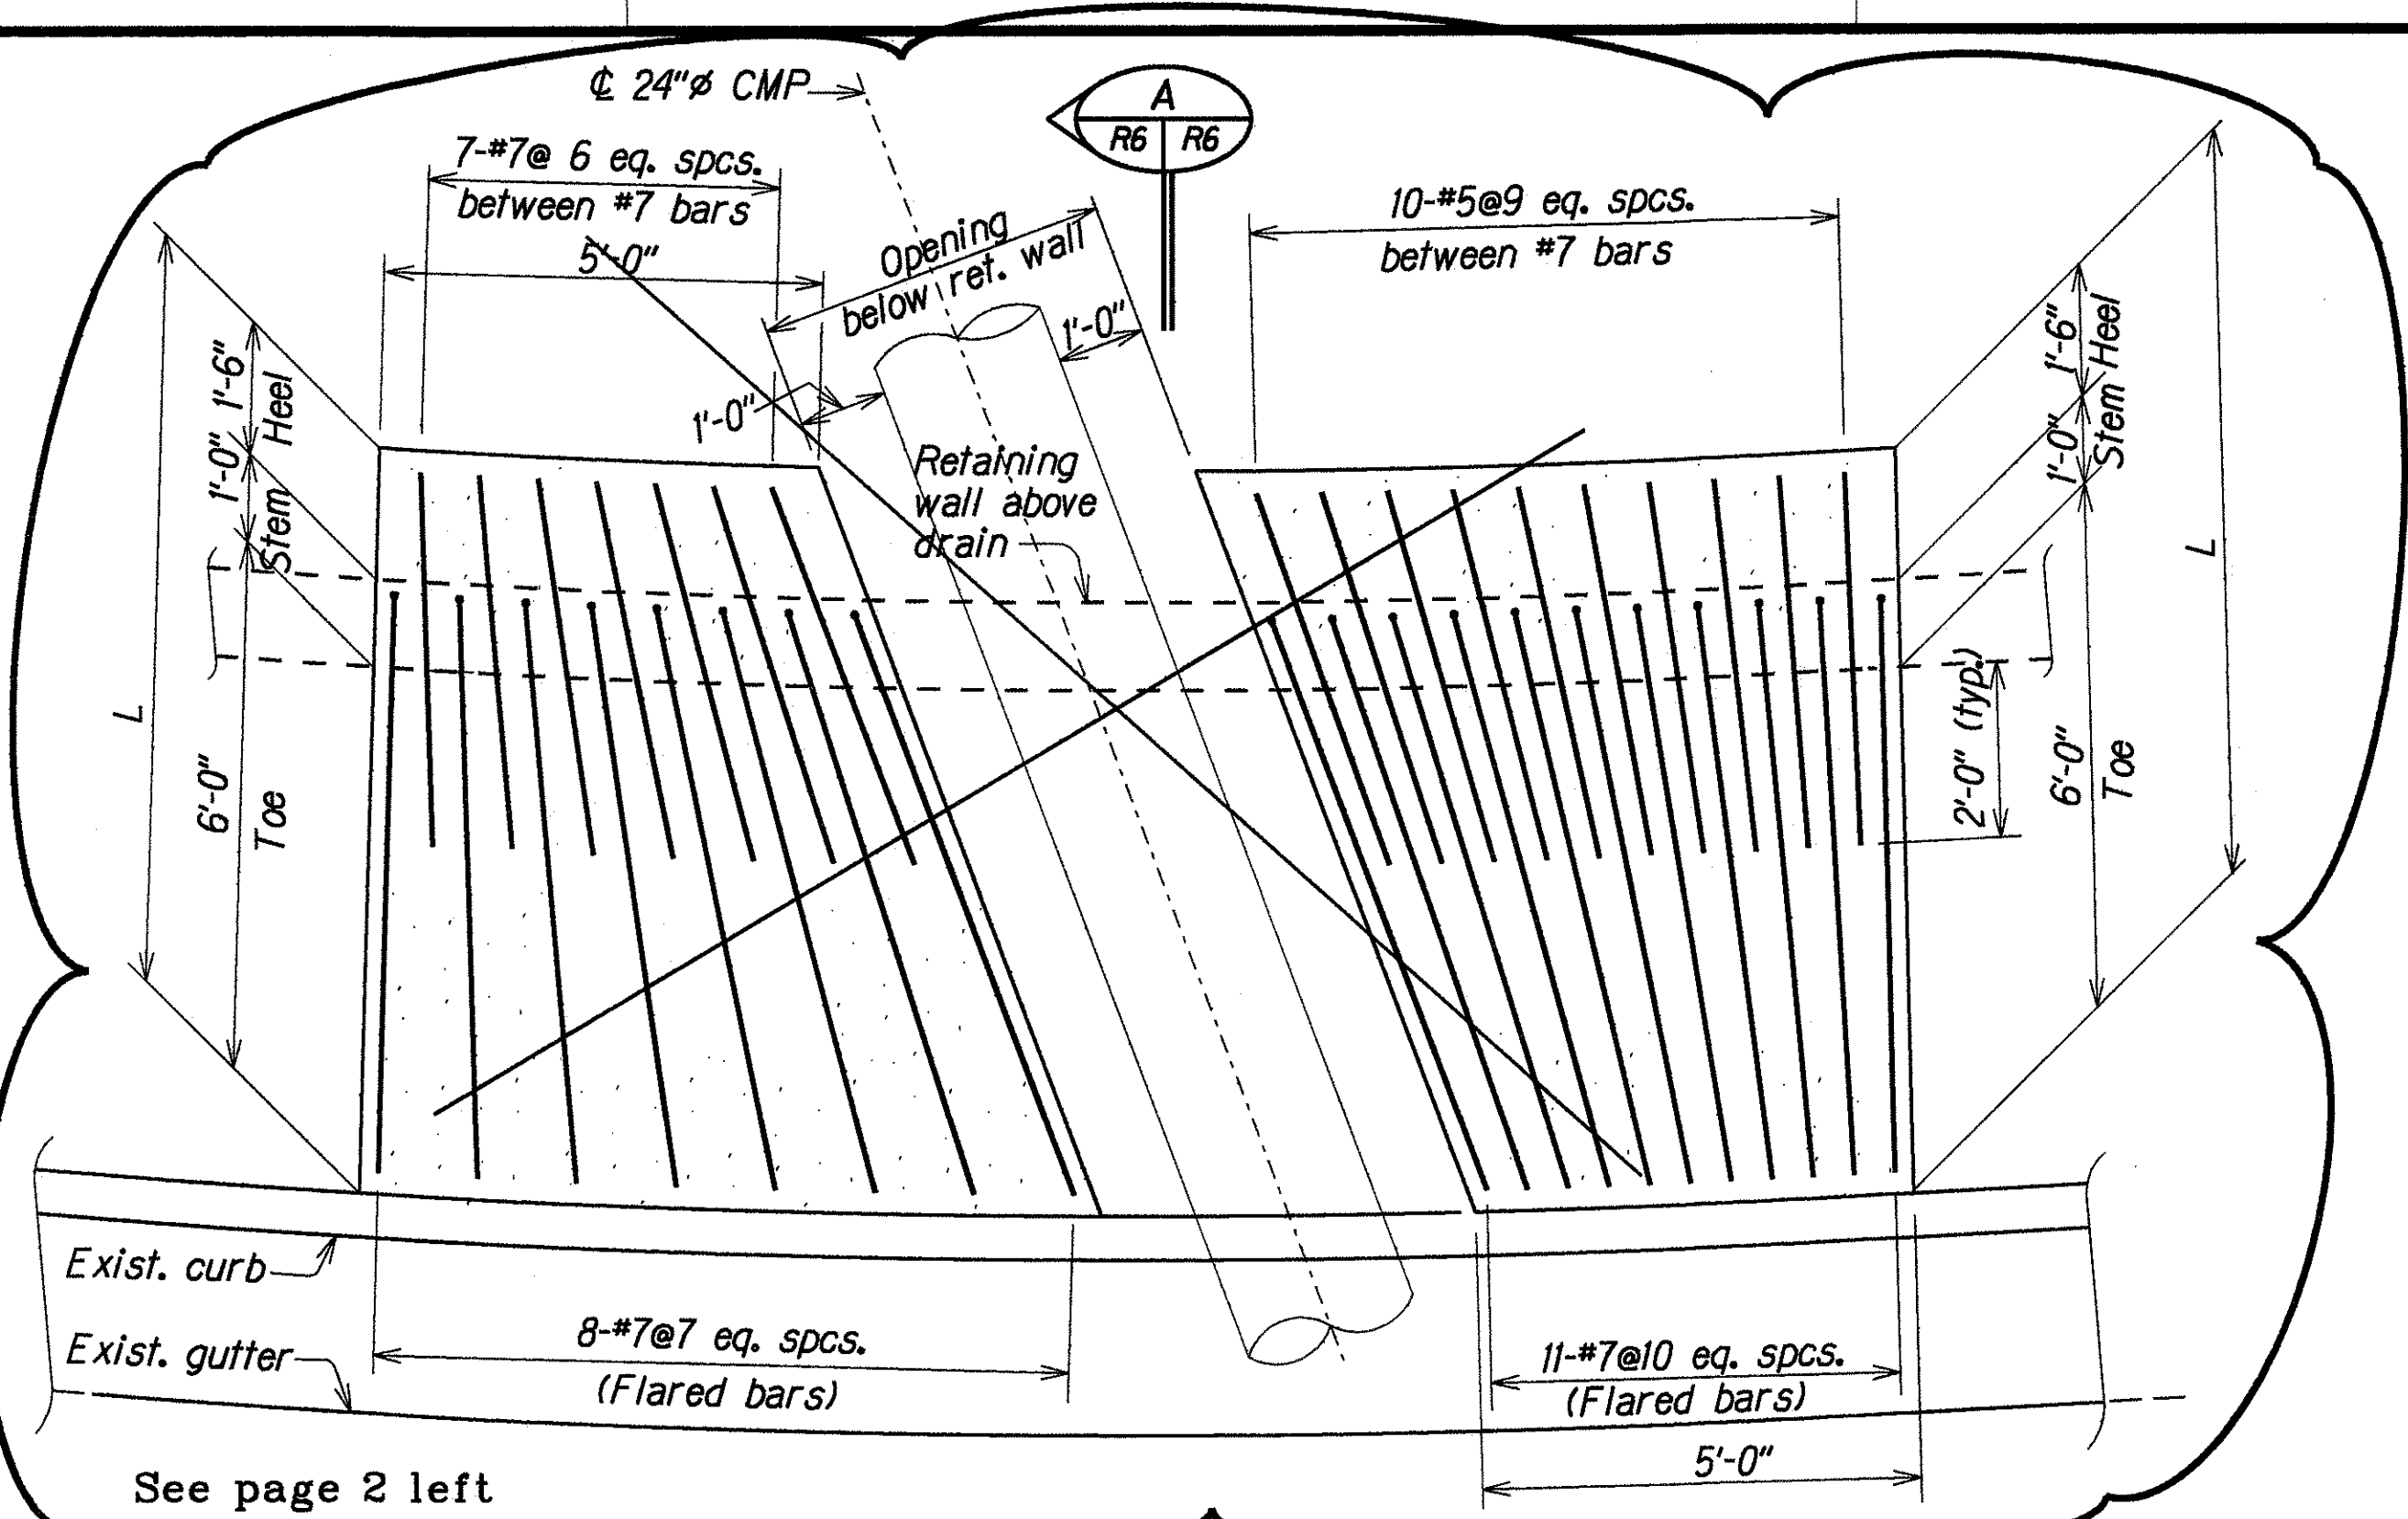


BOTTOM FOOTING REINFORCEMENT PLAN AT 24" C/C

Scale: 1/2" = 1'-0"

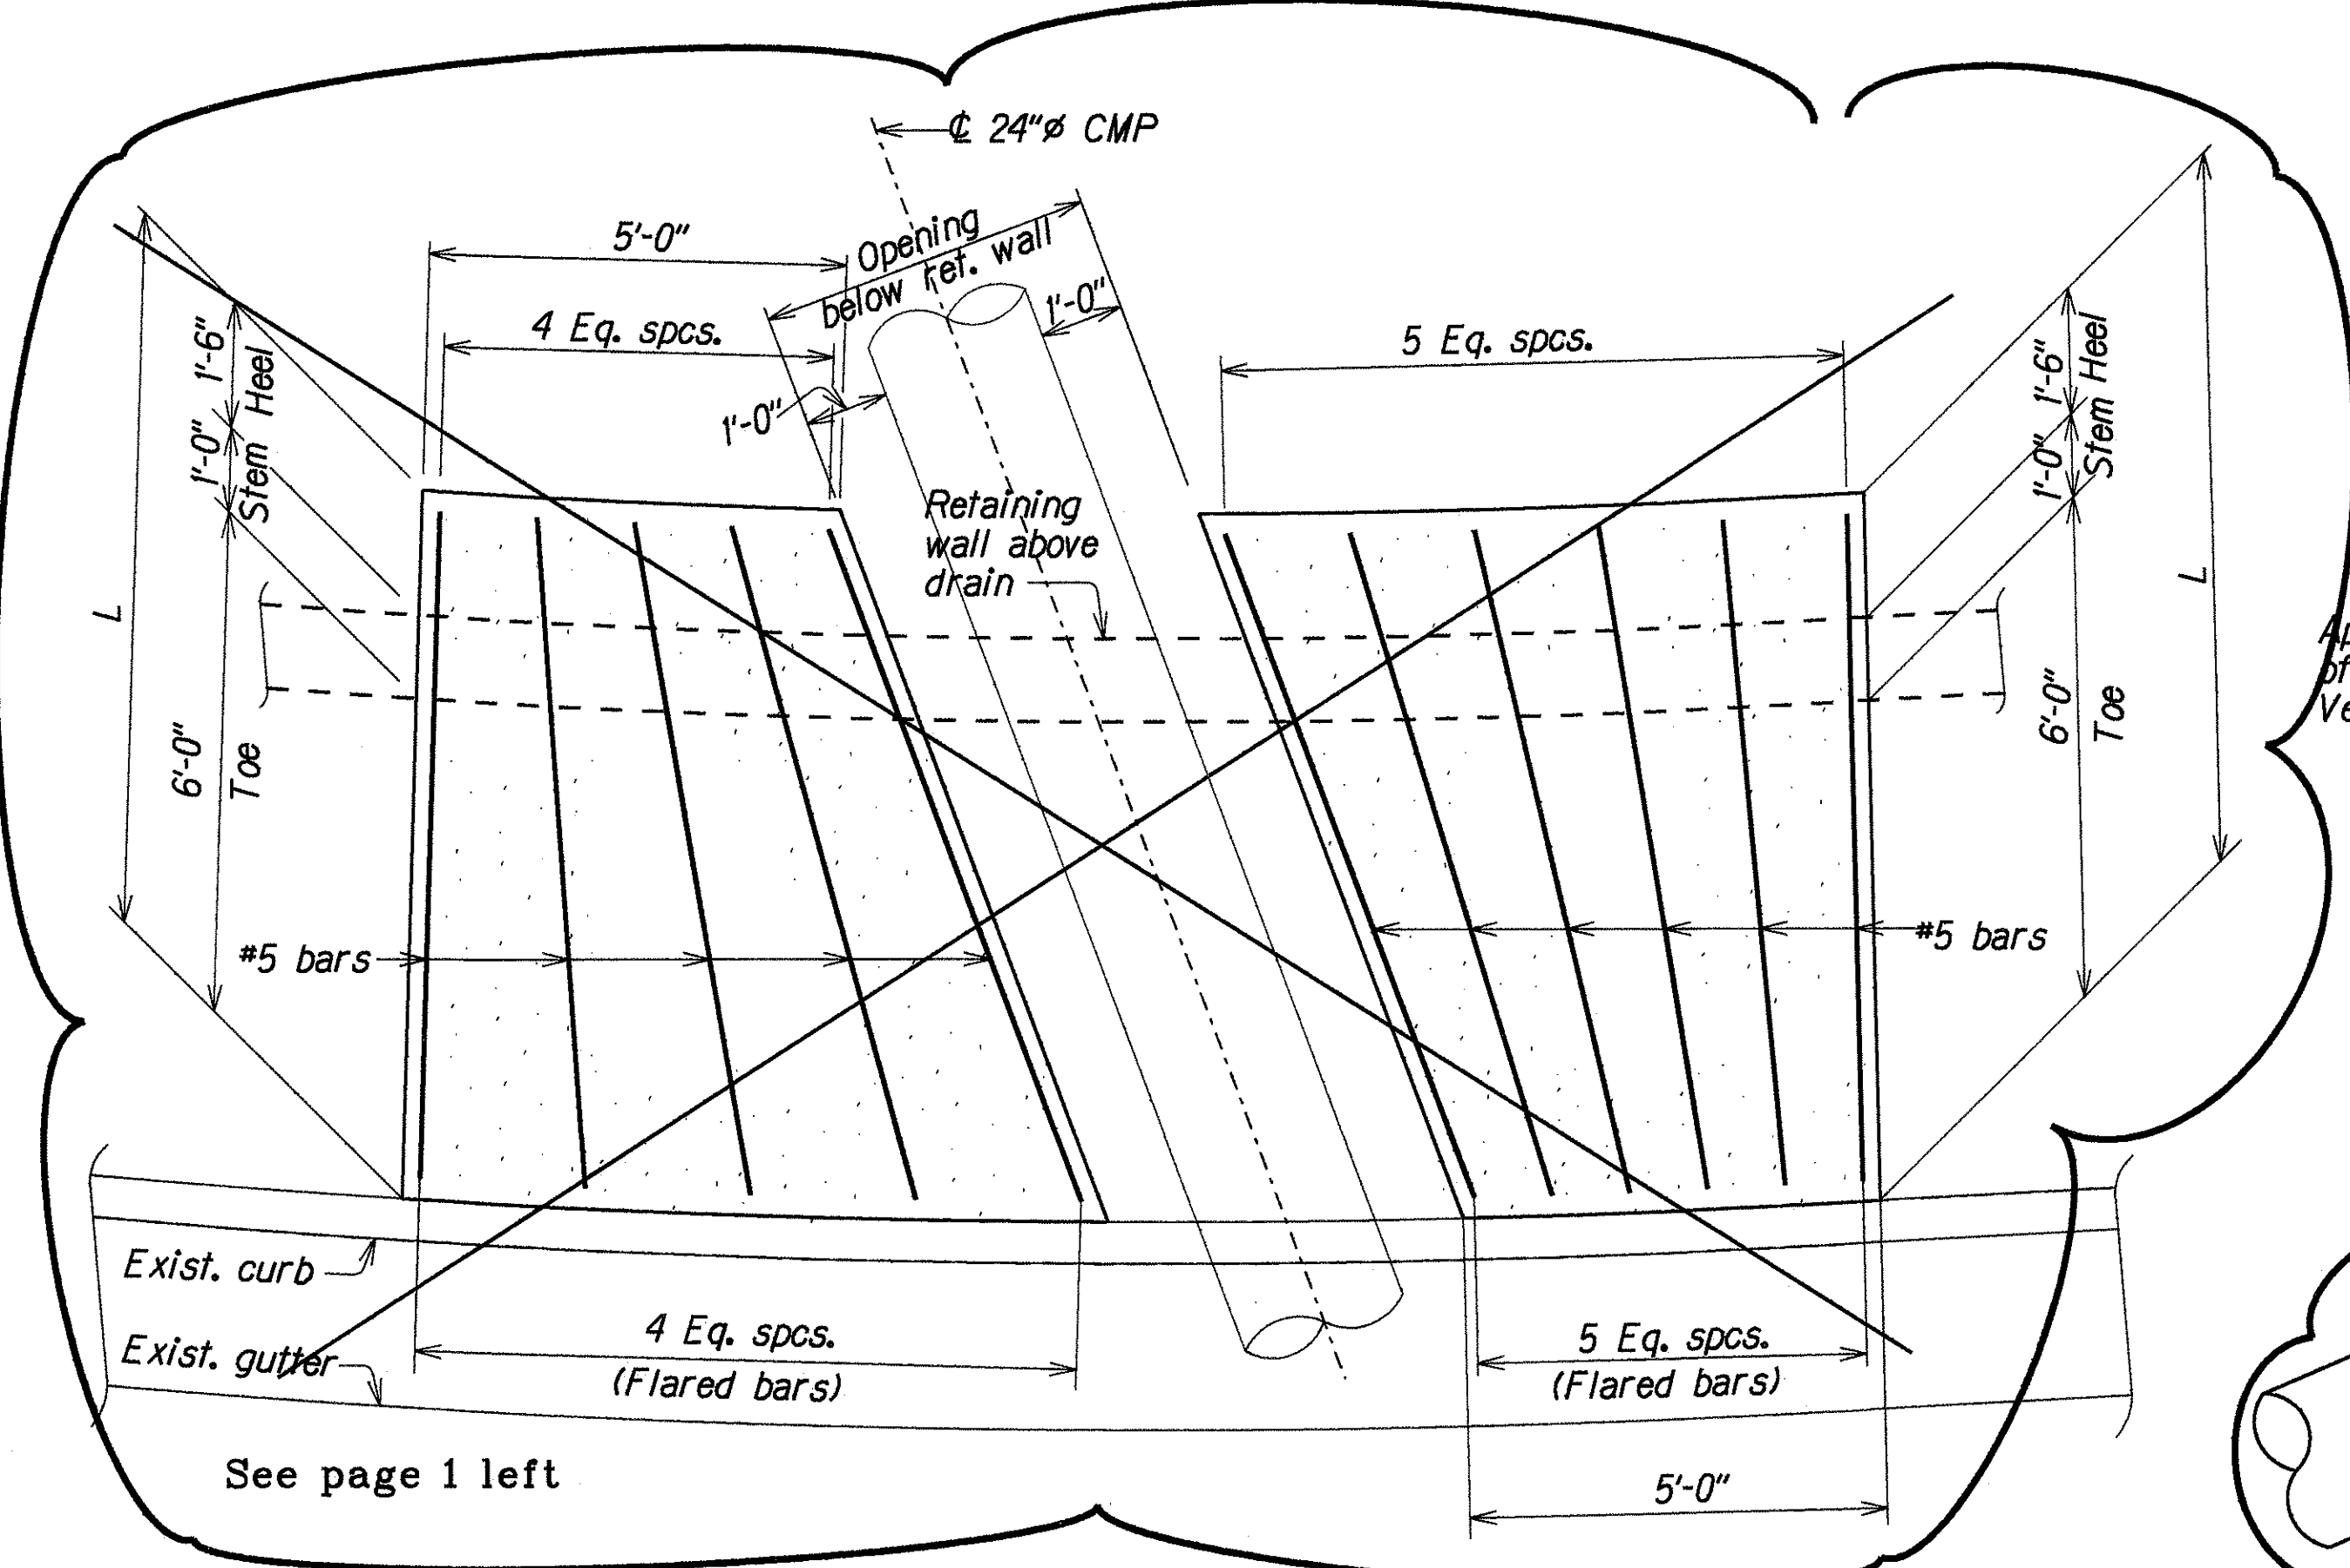


TOP FOOTING REINFORCEMENT PLAN AT 24" C/C

Scale: 1/2" = 1'-0"

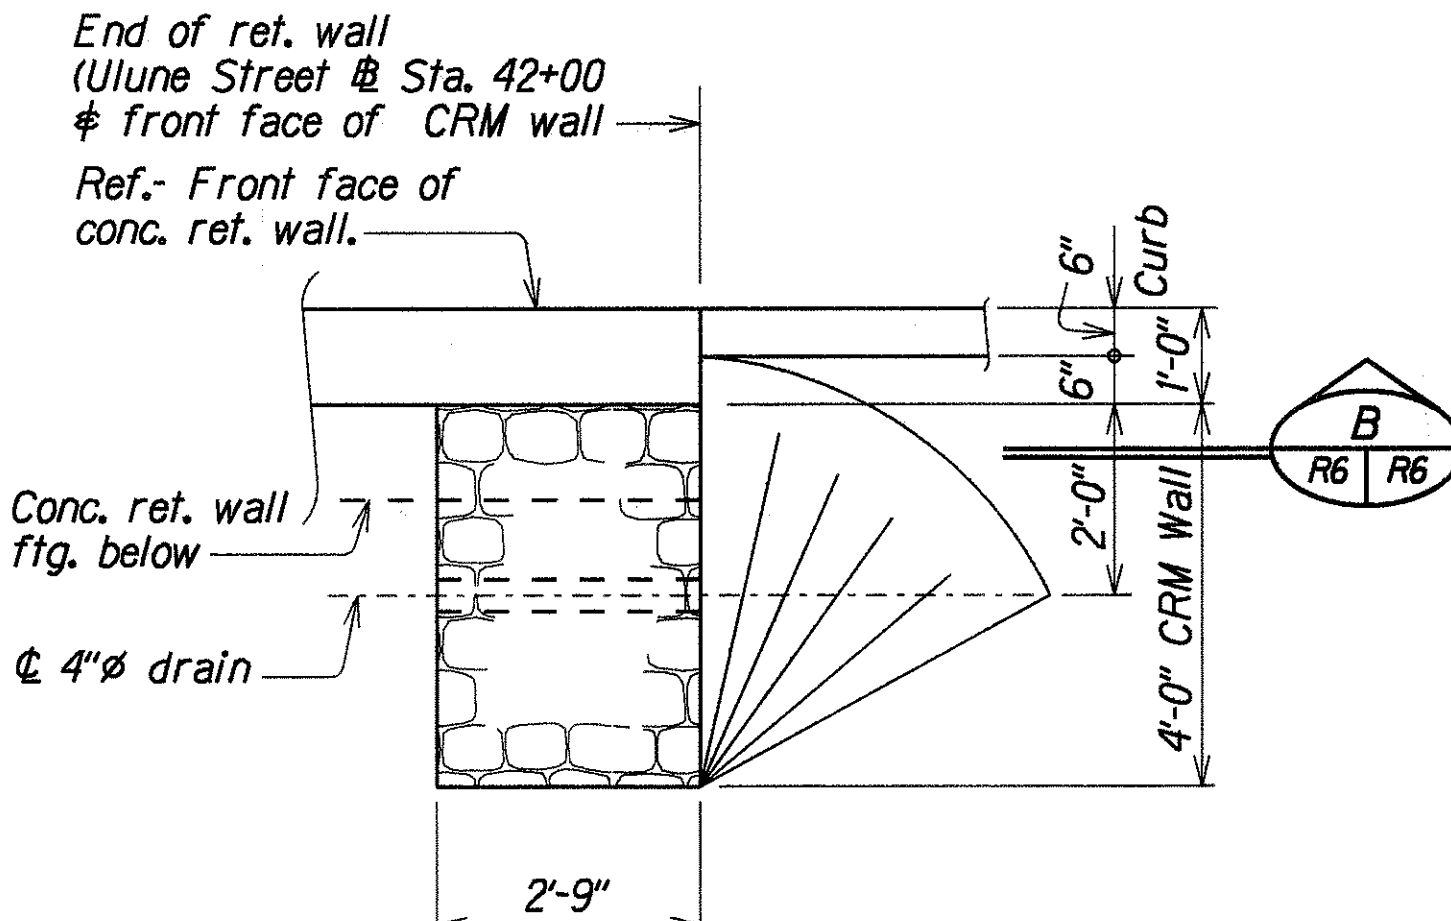

PLAN

Scale: 1/2" = 1'-0"

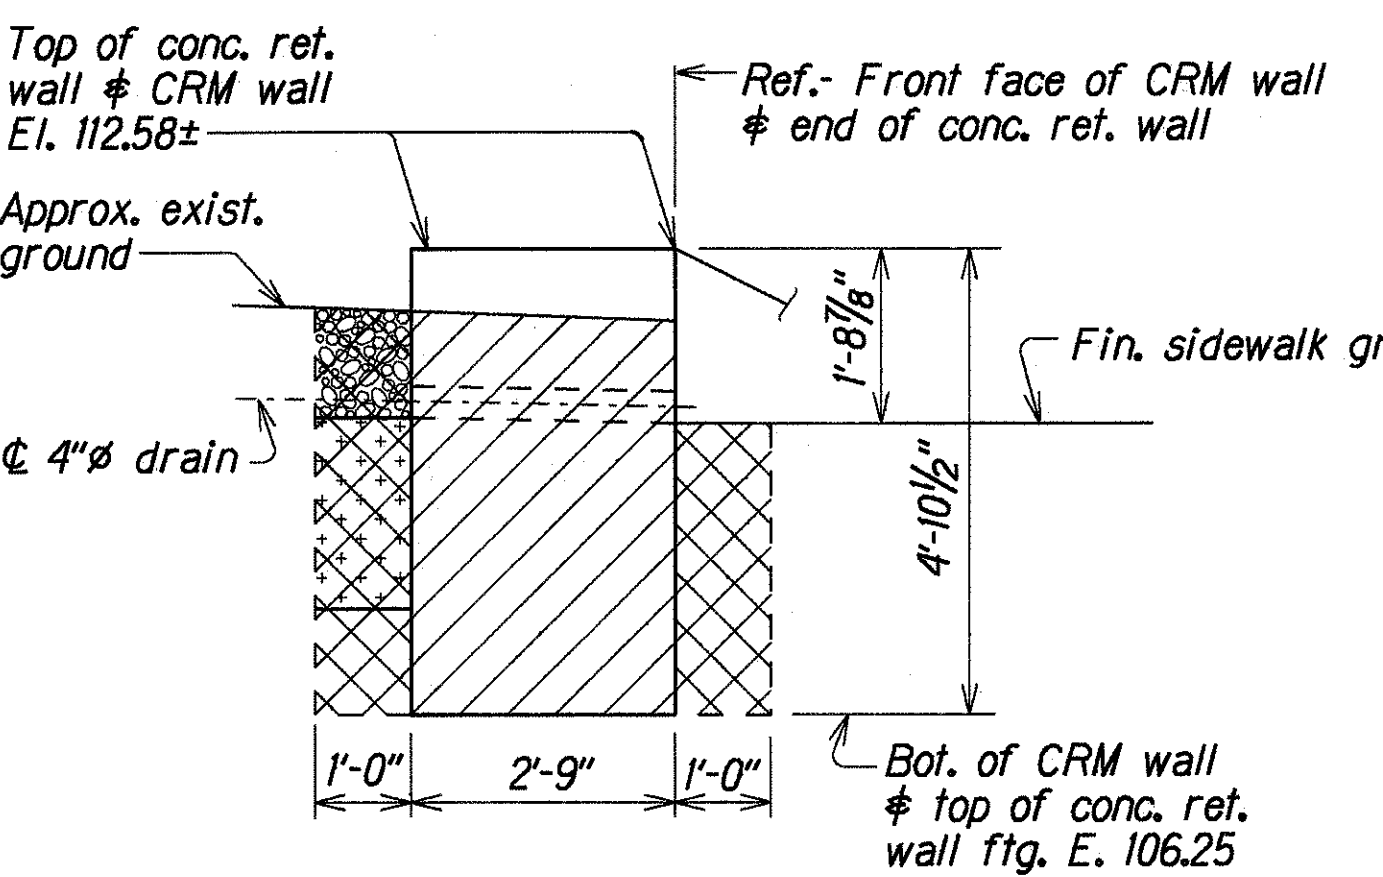


CRM WALL SECTION

Scale: 1/2" = 1'-0"

LEGEND FOR AS-BUILT POSTINGS

- Squiggly line for as-built deletion
- Double line for as-built deletion
- Roadway Text for as-built posting

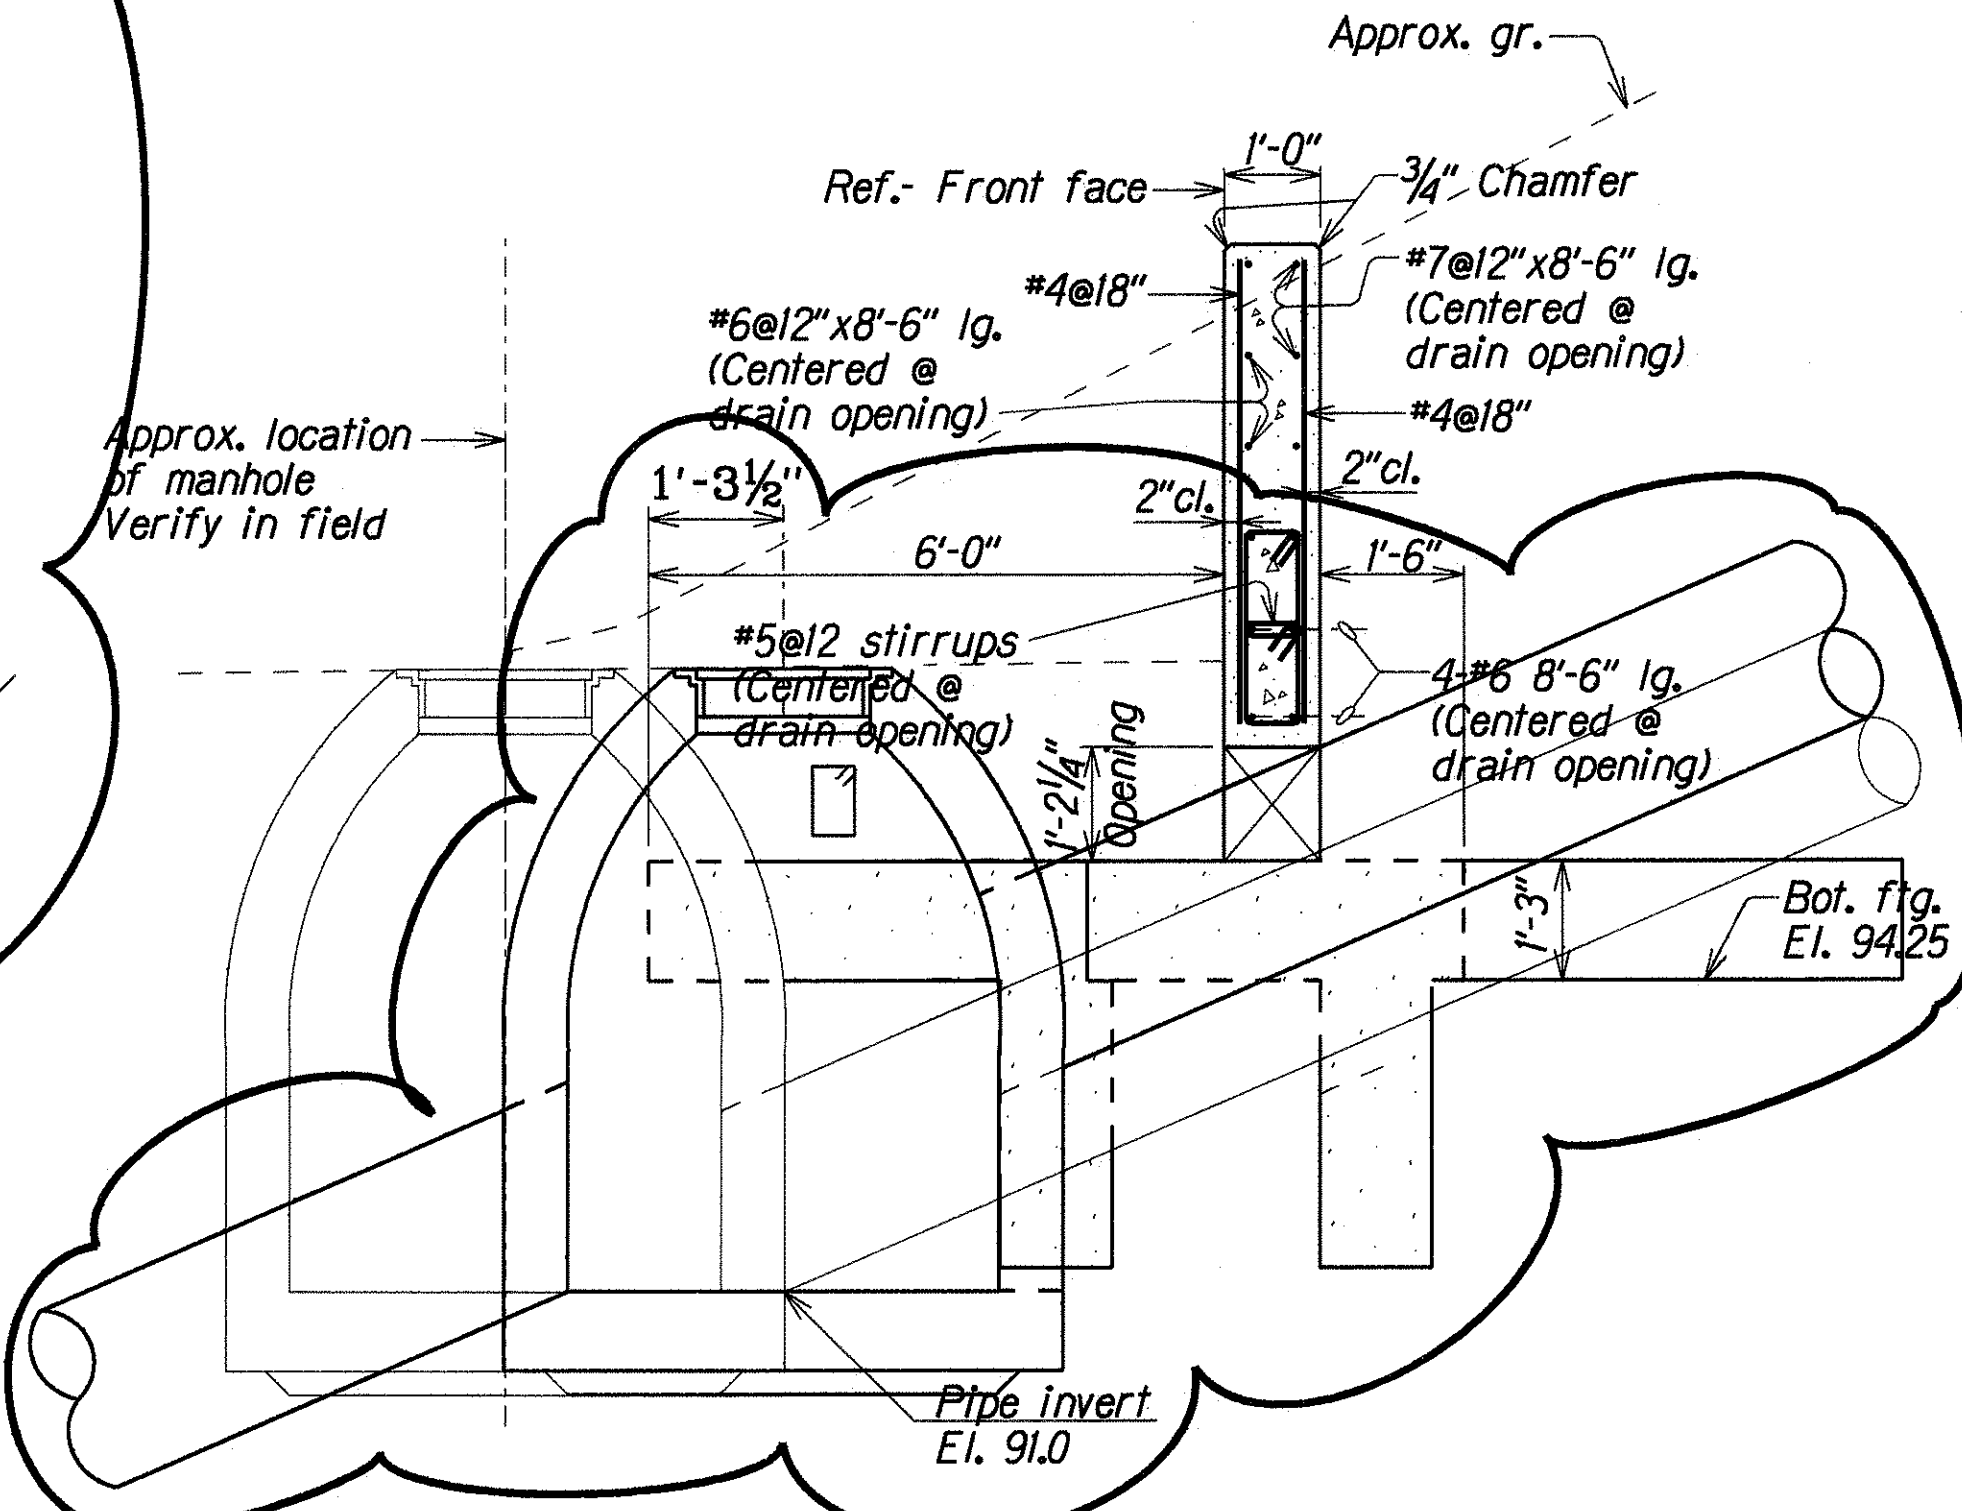

SECTION

Scale: 1/2" = 1'-0"

Note: This tracing prepared during "As-Built" posting.

"AS-BUILT"

STATE OF HAWAII
DEPARTMENT OF TRANSPORTATION
HIGHWAYS DIVISION
RETAINING WALL
DETAILS AT 24" C/C - HALAWA VALLEY ROAD @ STA. 15+11
CRM WALL DETAILS - ULUNE STREET @ STA. 42+00
Ulune Street And Halawa Valley Road Improvements
Halawa Heights Road To Halawa Valley Road
Ulune Street To Iwailua Street
Project No. STP-0300(39)
Scale: As Noted Date: Mar. 1996

SHEET No. R6 OF 9 SHEETS