



HWY-DD UNIT A JULIUS B. FRONDA 587-2246 MAY, 1996
DESIGNED BY P.S. & E.BY PHONE DATE

INDEX TO DRAWINGS	
SHEET NO.	DESCRIPTION
1	TITLE SHEET
2	STANDARD PLANS SUMMARY
3	GENERAL NOTES & LEGEND
4 - 9	TYPICAL SECTIONS & DETAILS
10 - 14	ROADWAY PLANS
15 - 18	CONSTRUCTION PHASING
19 - 23	RETAINING WALL
24	CRM WALL DETAILS
25	CULVERT RECONSTRUCTION
26 - 27	GUARDRAIL CONNECTION DETAILS
28	DRAINAGE PLAN
29	DRAINAGE PROFILE
30 - 35	DRAINAGE DETAILS
36 - 38	LANDSCAPING PLANS
39 - 43	IRRIGATION PLANS & DETAILS
44	TRAFFIC LEGEND, DETAILS & NOTES
45 - 50	PAVEMENT MARKING & SIGNING
51 - 54	TRAFFIC SIGNALS
55 - 62	HIGHWAY LIGHTING
63 - 70	CROSS SECTIONS

STATE OF HAWAII
DEPARTMENT OF TRANSPORTATION
HIGHWAYS DIVISION
HONOLULU, HAWAII
"AS-BUILT"
PLANS FOR
ULUNE STREET IMPROVEMENTS
HALAWA HEIGHTS RD. TO HALAWA VALLEY RD.
AND
HALAWA VALLEY RD. IMPROVEMENTS
ULUNE STREET TO IWAIIWA STREET
FEDERAL AID PROJECT NO. STP-0300(39)
DISTRICT OF EWA
ISLAND OF OAHU

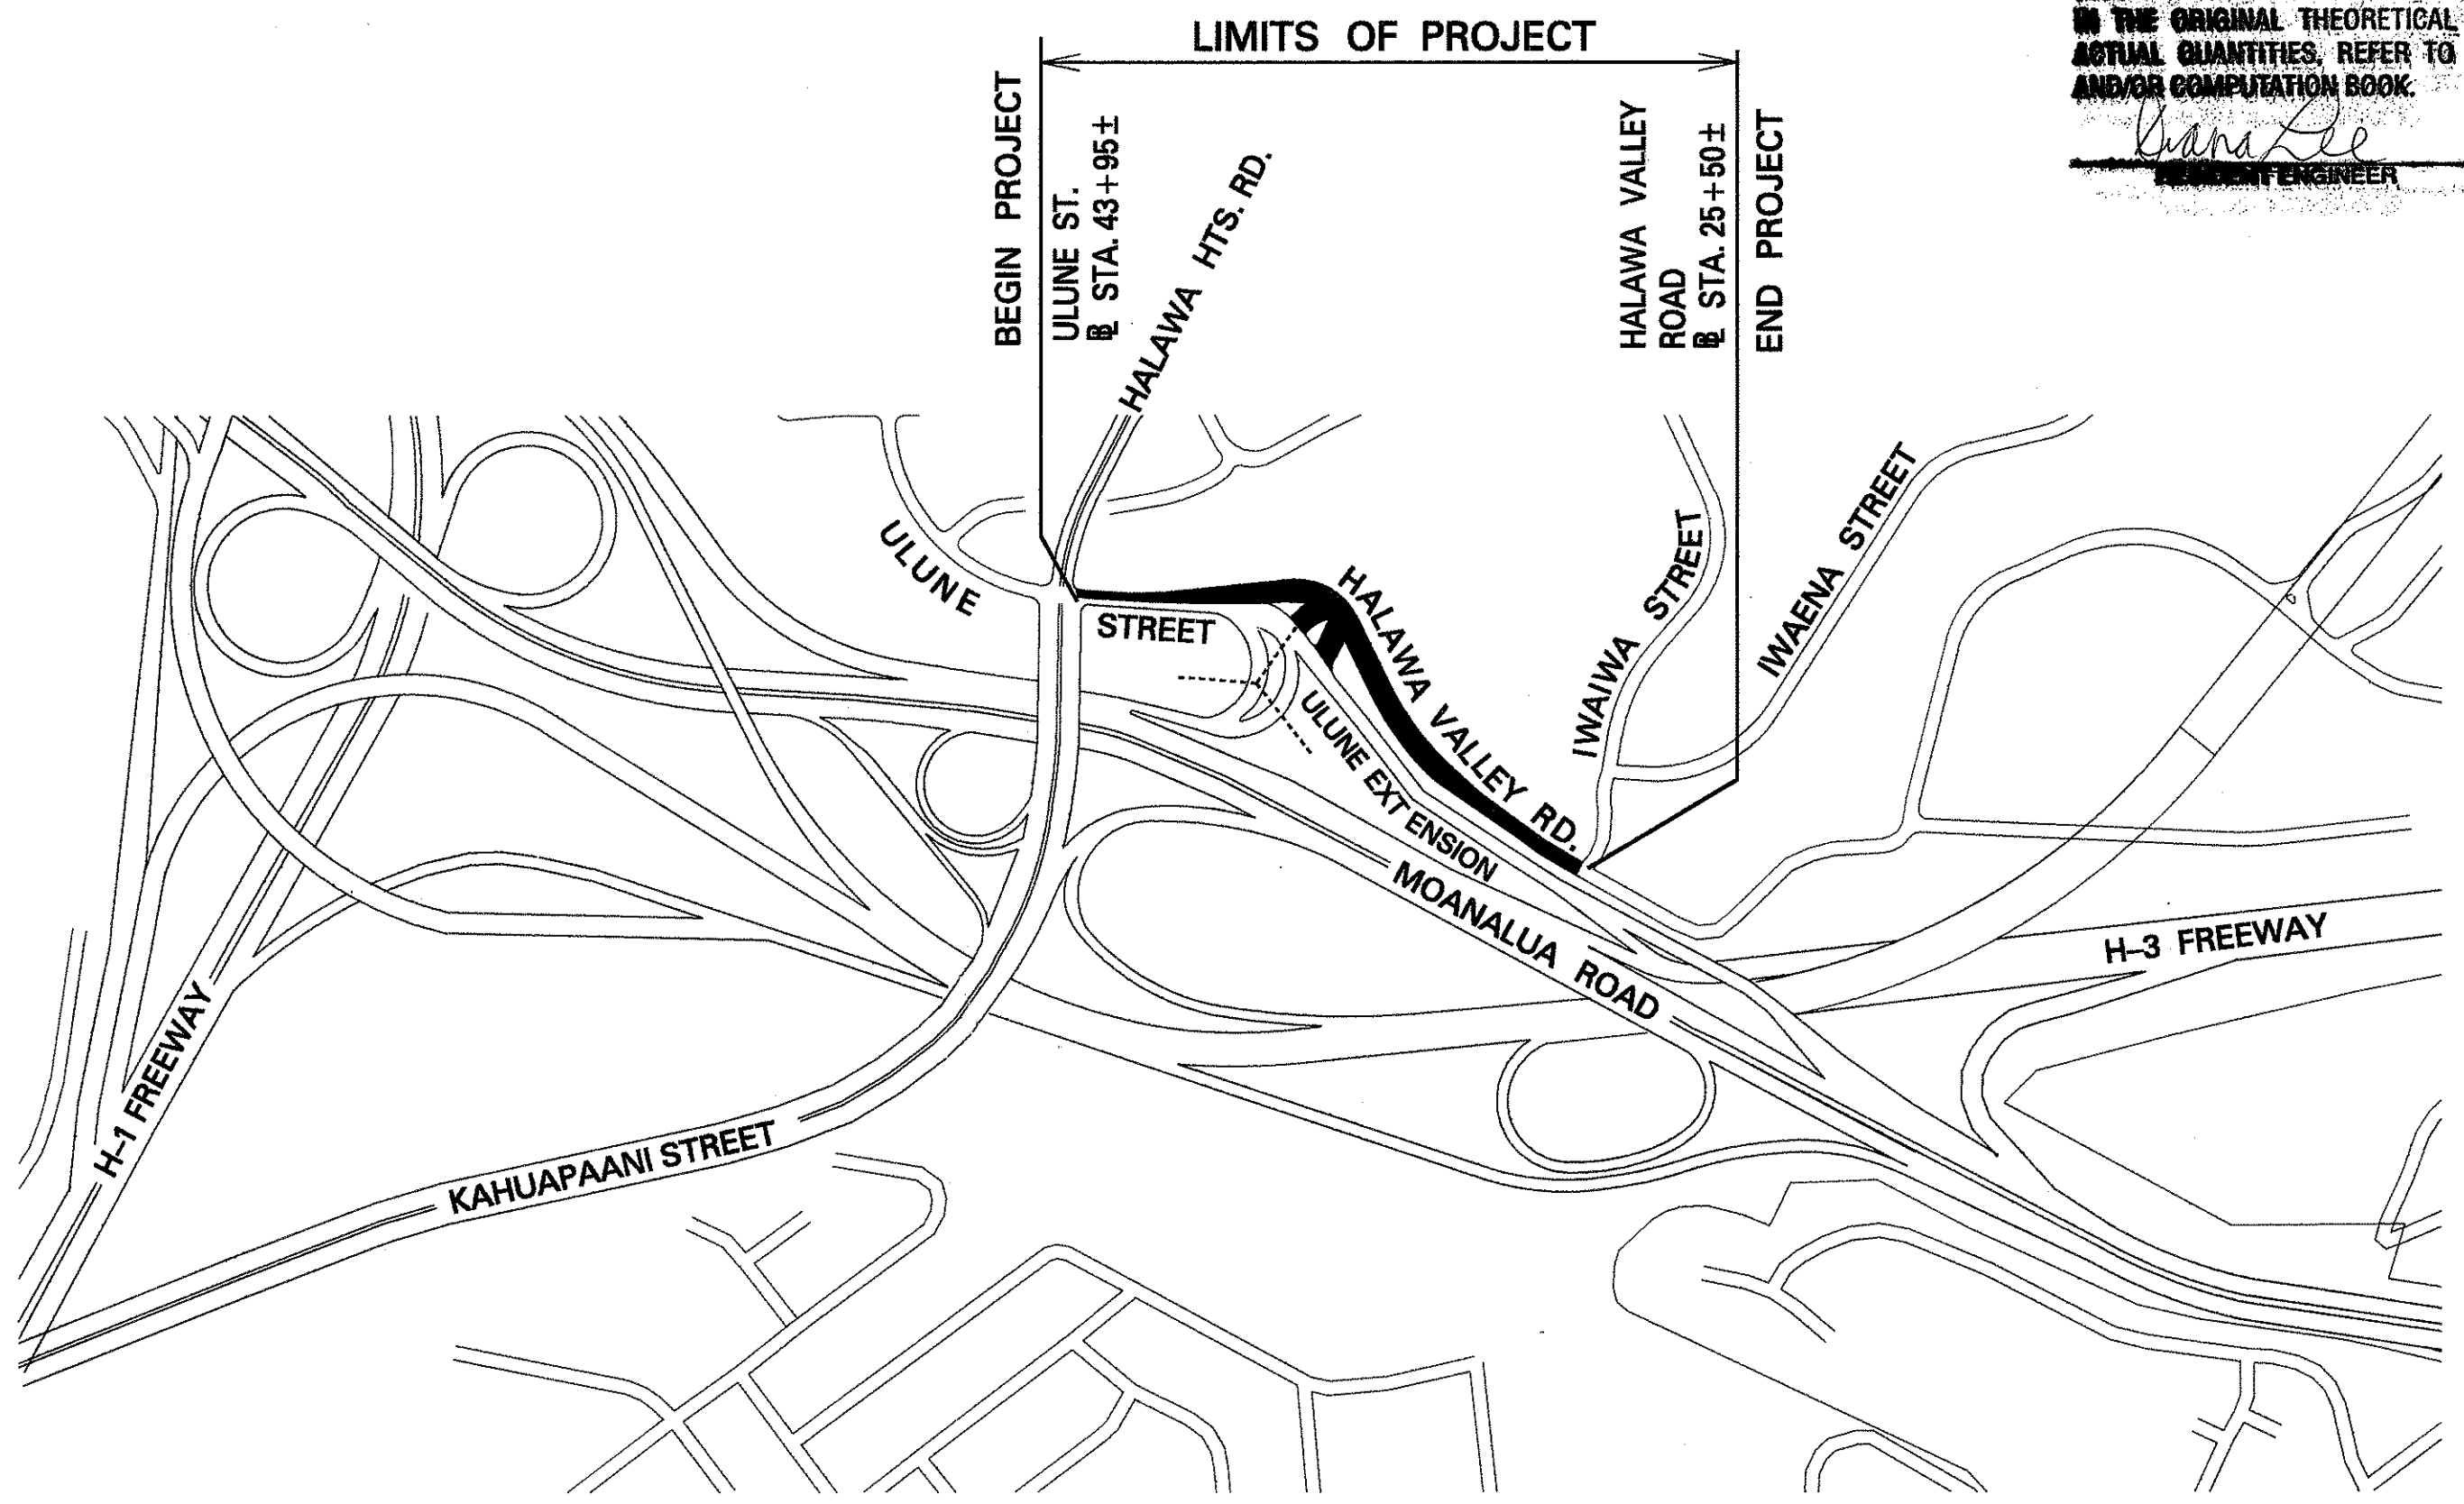

LAYOUT PLAN
LENGTH OF PROJECT..... 0.35 MILES

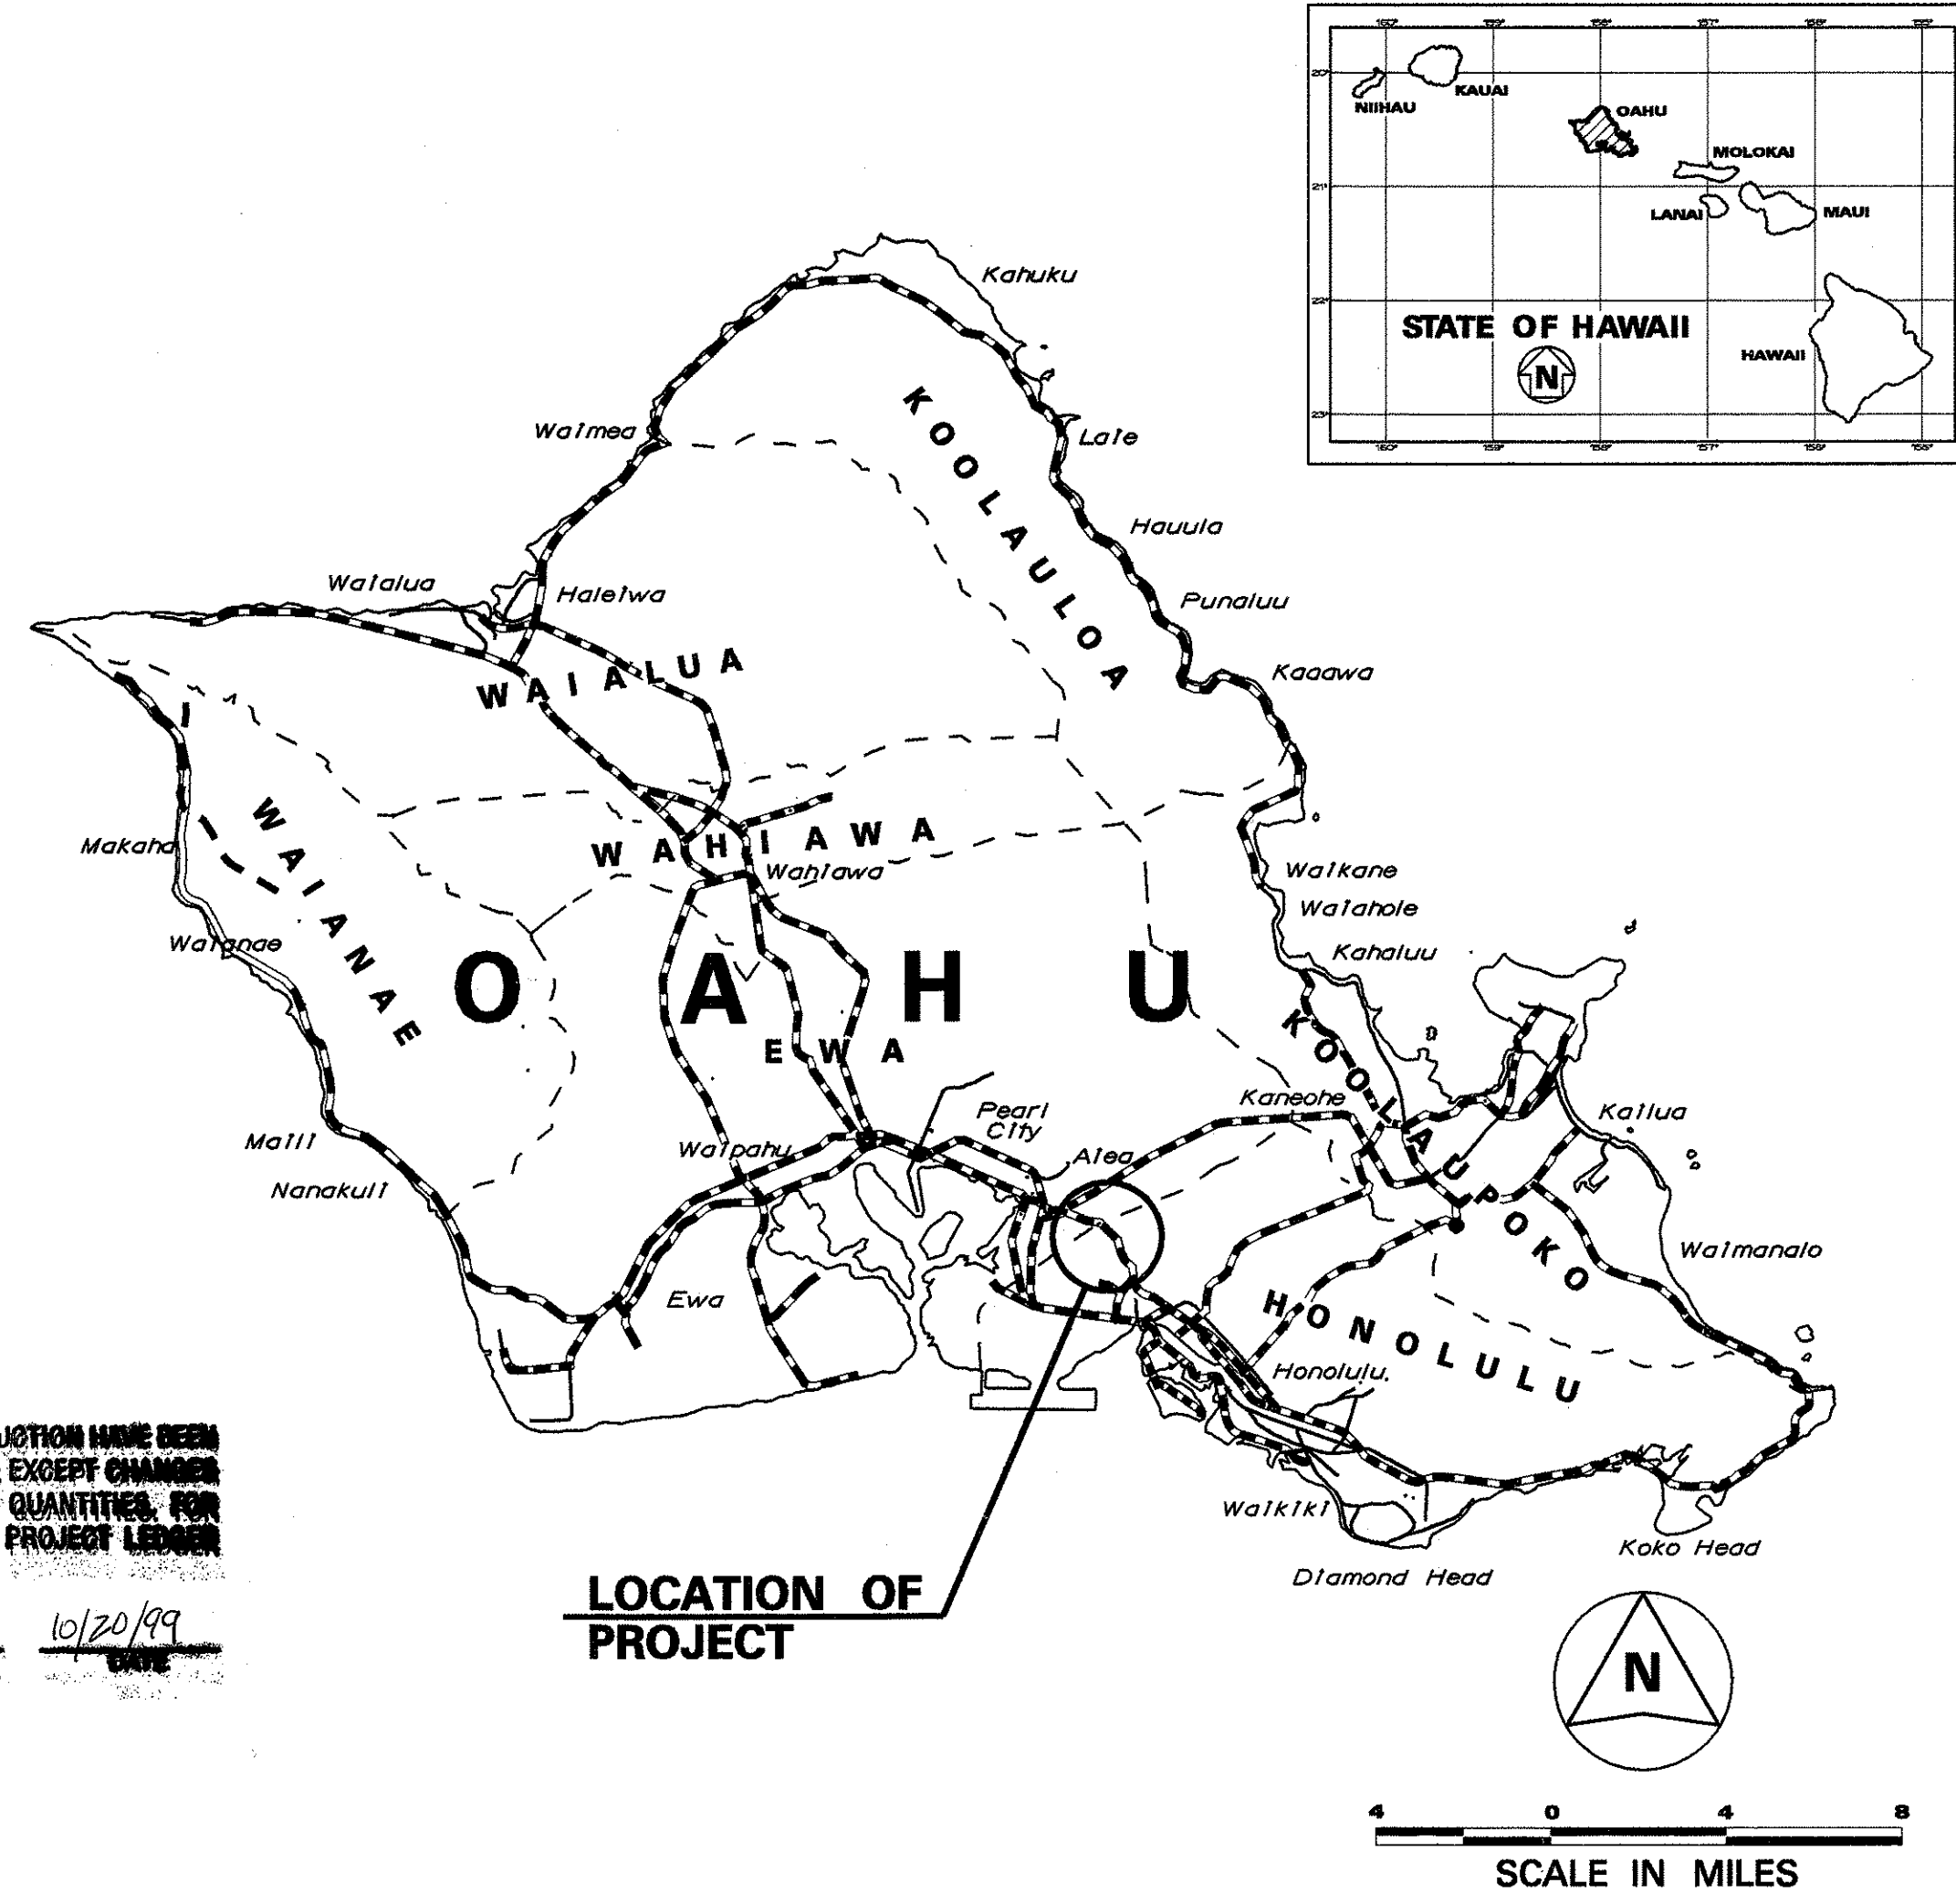

LOCATION OF PROJECT

----- FEDERAL AID PROJECTS PREVIOUSLY CONSTRUCTED OR UNDER CONSTRUCTION

DESIGN DESIGNATION

	ULUNE STREET	HALAWA VALLEY ROAD
ADT (1996).....	31,100	25,500
ADT (2006).....	38,700	31,700
DHV.....	3,590	2,940
D.....	70/30	70/30
T.....	1.5 %	1.5 %
T24.....	2.0 %	2.0 %

DEPARTMENT OF TRANSPORTATION
STATE OF HAWAII
APPROVED: *Raymond H. Yoshida* 5/20/96
DIR. OF TRANSPORTATION DATE