





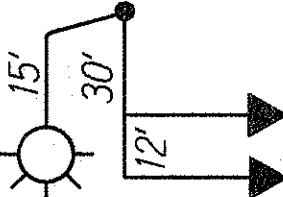








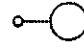
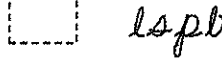
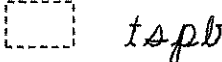
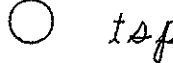
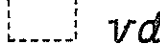




FED. ROAD DIST. NO.	STATE	FED. AID PROJ. NO.	FISCAL YEAR	SHEET NO.	TOTAL SHEETS
HAWAII	HAW.	STP-0300(39)	1996	51	70
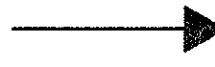
# TRAFFIC SIGNAL LEGEND

	Existing Traffic Signal Controller
	New Traffic Signal Controller
	New Traffic Signal Conduits & Cables
	New 12" RYG Traffic Signal Head
	New 12" RYU Traffic Signal Head
	New 12" RYL Traffic Signal Head
	New Type III Traffic Signal Standard (Mast Arm Length, Highway Lighting Bracket Arm Length, Signal Heads with Spacing as specified.)
	New Type I Traffic Signal Standard (Height-10') Signal Heads as specified
	New Pedestrian Signal Head
	New Type B Pullbox
	New Type C Pullbox (C&C Type) (For Details, See Sht. No. T10)
	New Type D Pullbox (C&C Type) (For Details, See Sht. No. T10)
	New Loop Detectors
	New Opticom Receiver
	New Pipe Guard
	Existing Lighting Standard
	Existing Lighting Standard Pullbox
	Existing Traffic Signal Pullbox to Remain
	Existing Traffic Signal Standard
	Existing Vehicle Detector

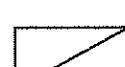TRAFFIC SIGNAL HEAD SCHEDULE				
Traffic Signal Head Type and Description				
	12" RYG Traffic Signal Head	12" RY↑ Traffic Signal Head	12" RY↘ Traffic Signal Head	Pedestrian Signal Head
Pole Letter Signal Head Number	D-2 E-1 E-2 F-3 F-4	C-1 D-1 F-1 F-2	* A-1 * A-2 * B-1	B-2 F-5 A-3 A-4
* Correct Orientation of Green Arrow shall be determined by City & County engineer/Inspector.				

TRAFFIC SIGNAL SYSTEM CONDUIT AND CABLE SCHEDULE										
	DELTA ITEM NO. (Δ)									
	1	2	3	4	5	6	7	8	9	10
QUANTITY OF 2" CONDUIT, SEE NOTE NO. 1	6*	4*	4*	4*	3*	2*	3*	3*	2*	1
QUANTITY OF 26/C #14 CONTROL CABLE	2	1	1	1	1	1				
QUANTITY OF 2/C #14 SHIELDED LOOP DETECTOR AND PEDESTRIAN PB CABLE	5	3	3	2	1		1	1		1
QUANTITY OF 3/C #20 SHIELDED OPTICAL DETECTOR CABLE	3	2	2	1						
QUANTITY OF 2/C #6 POWER CABLE	1							1	1	
NOTE: 1. ALL CONDUITS SHALL BE SCHEDULE 80 PVC, UNLESS OTHERWISE NOTED. * Spare conduit										

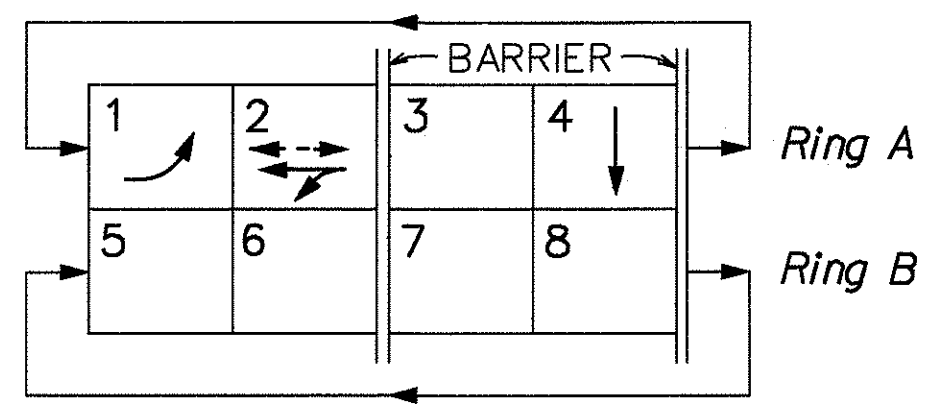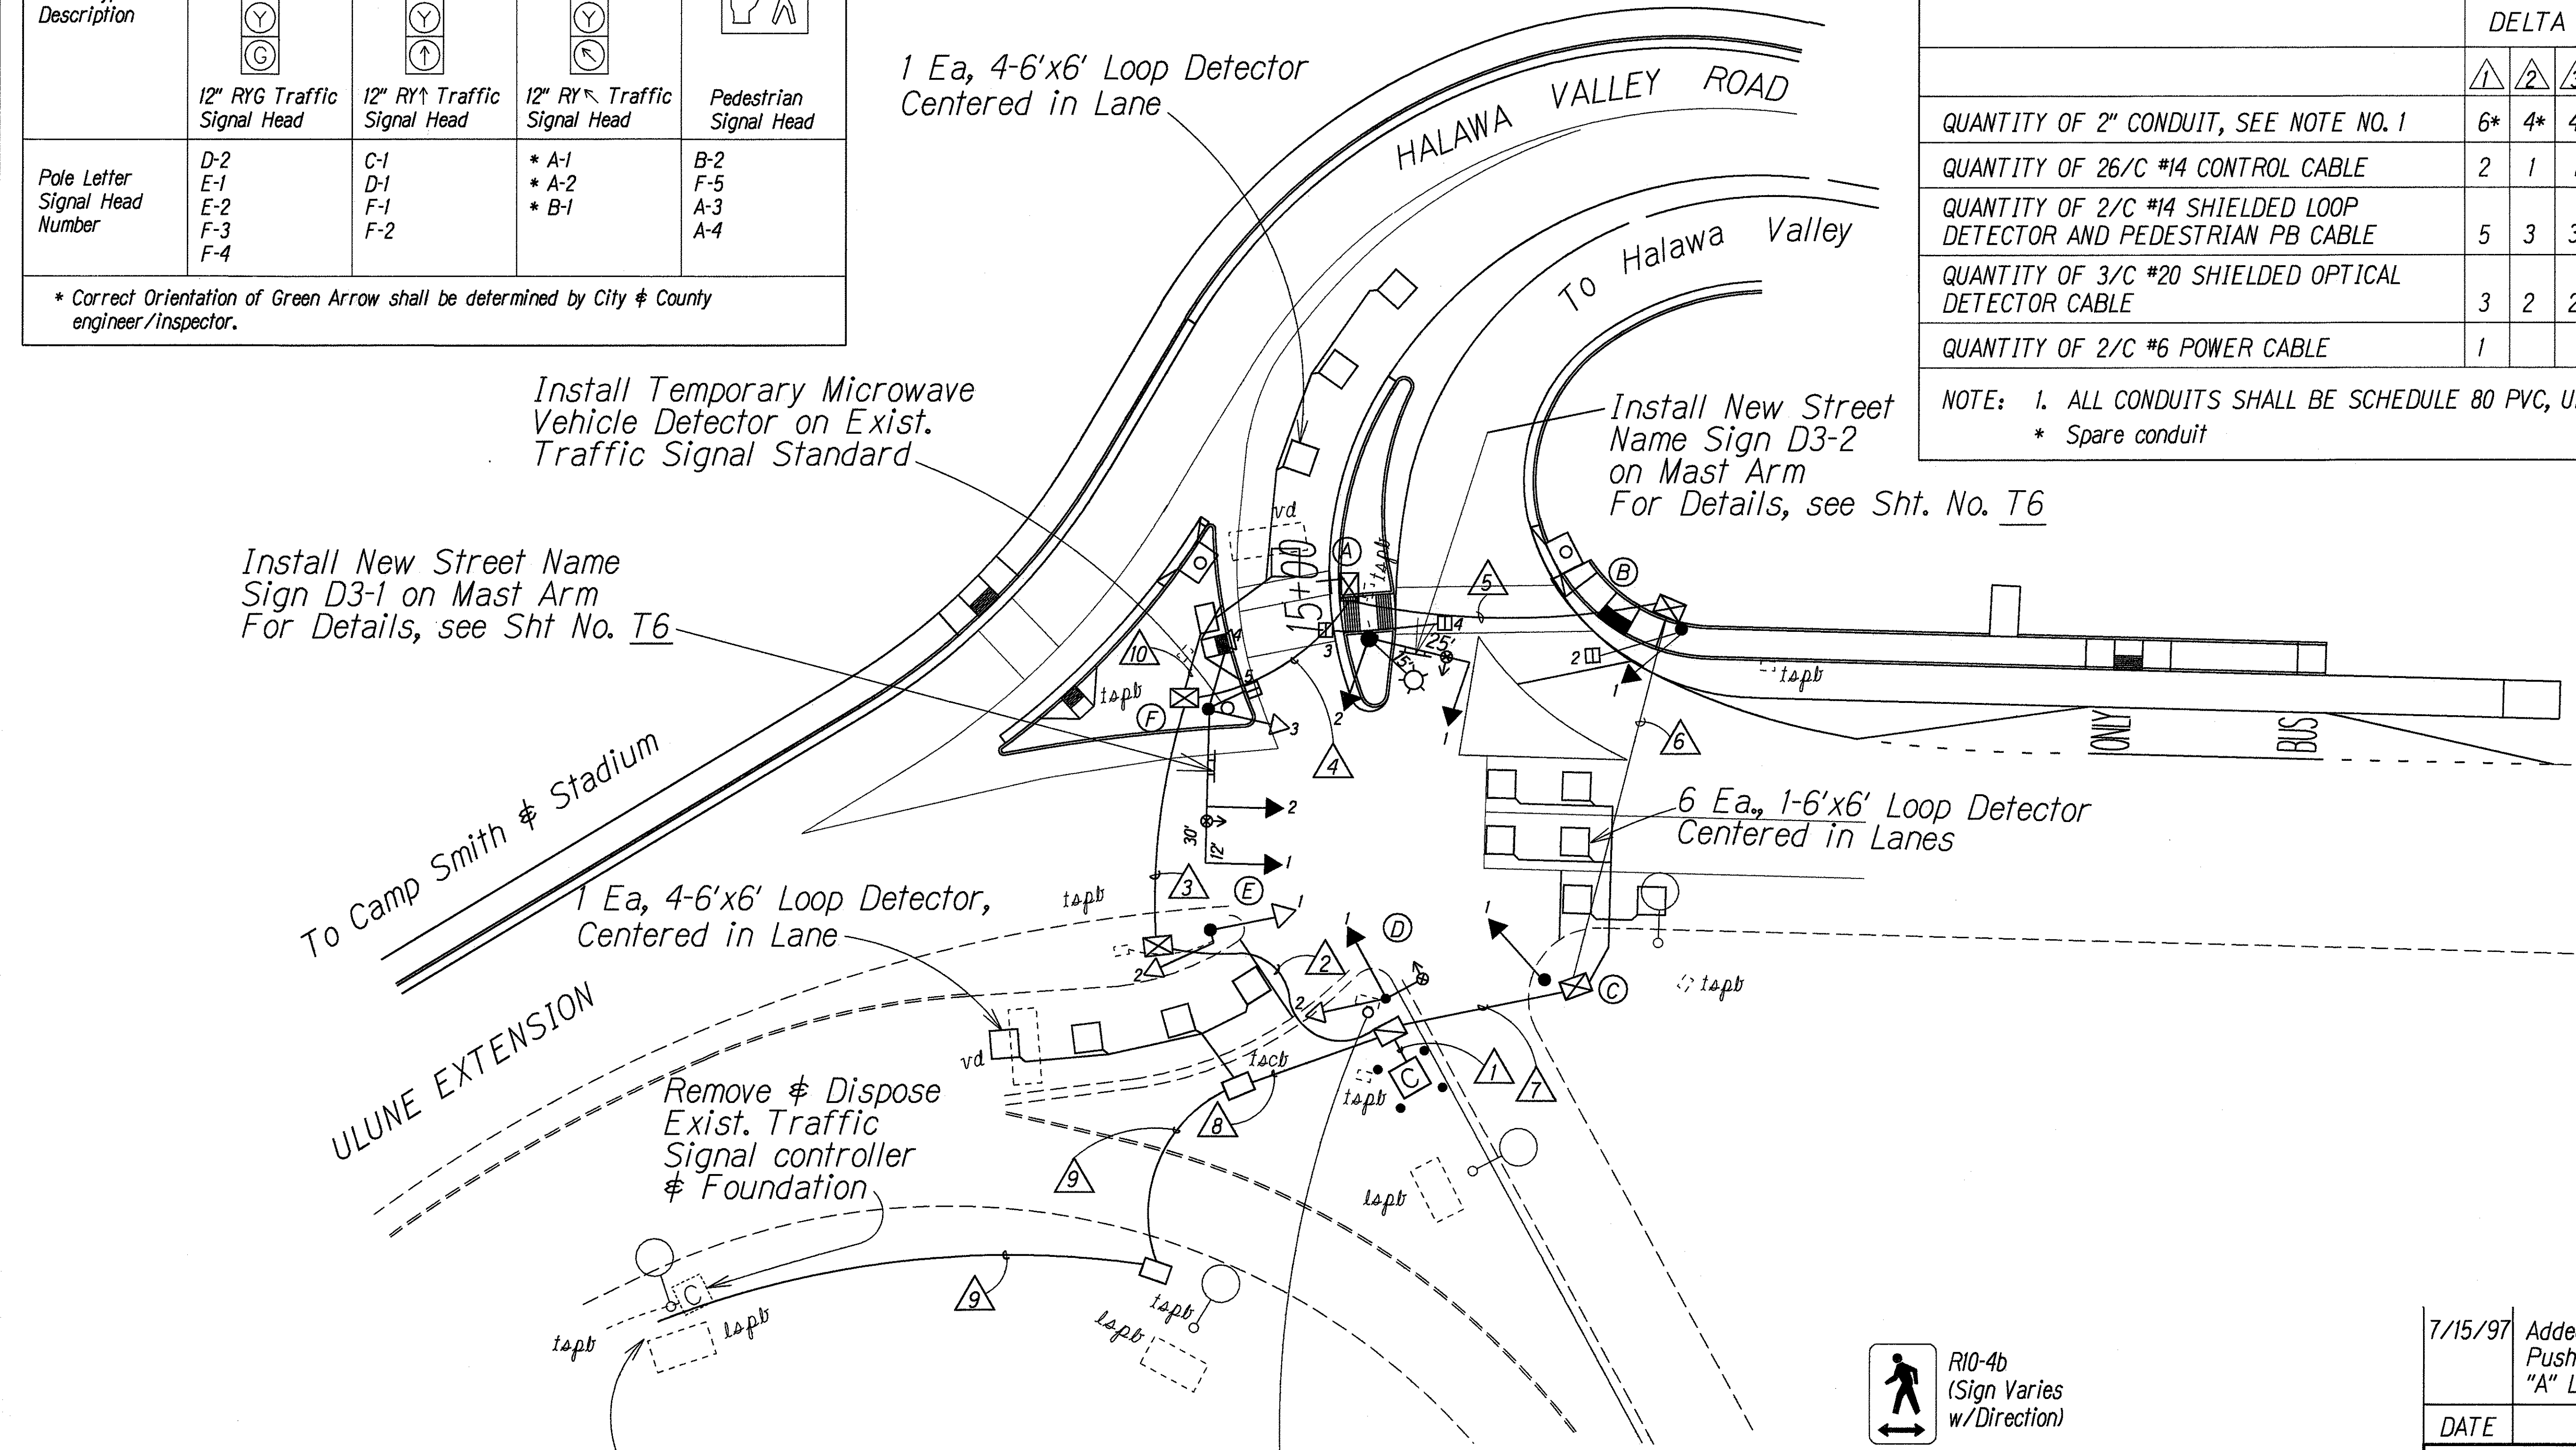

- R10-4b (Sign Varies w/Direction)
- (B) (←) R10-4b(L)
- (F) (←) R10-4b(L)
- (A) (↔) R10-4b(L&R)

PEDESTRIAN PUSH  
BUTTON W/SIGN (NEW)



7/15/97	Added Pedestrian Signal Heads and Push Button w/sign at Signal Post "A" Location
DATE	REVISION
STATE OF HAWAII DEPARTMENT OF TRANSPORTATION HIGHWAYS DIVISION <b>TRAFFIC SIGNAL PLAN</b> ULUNE STREET IMPROVEMENTS Halawa Hts. Rd. to Halawa Valley Rd. & HALAWA VALLEY RD. IMPROVEMENTS Ulune Street to Iwaiwa Street F.A. Project No. STP-0300(39) Scale: 1"=20' Date: Apr., 1996	
SHEET No. 79 OF 19 SHEETS	


DATE: 2/3/96  
DESIGNED BY: C. Abe  
CHECKED BY: J. H. H. H.  
NOTED BY: J. H. H. H.  
ORIGINAL PLAN: J. H. H. H.






FED. ROAD DIST. NO.	STATE	FED. AID PROJ. NO.	FISCAL YEAR	SHEET NO.	TOTAL SHEETS
HAWAII	HAW.	STP-0300(39)	1996	54	70

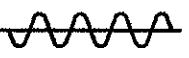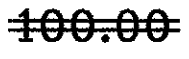LEGEND FOR AS-BUILT POSTINGS	
	Squiggly line for as-built deletion
	Double line for as-built deletion
Roadway	Text for as-built posting

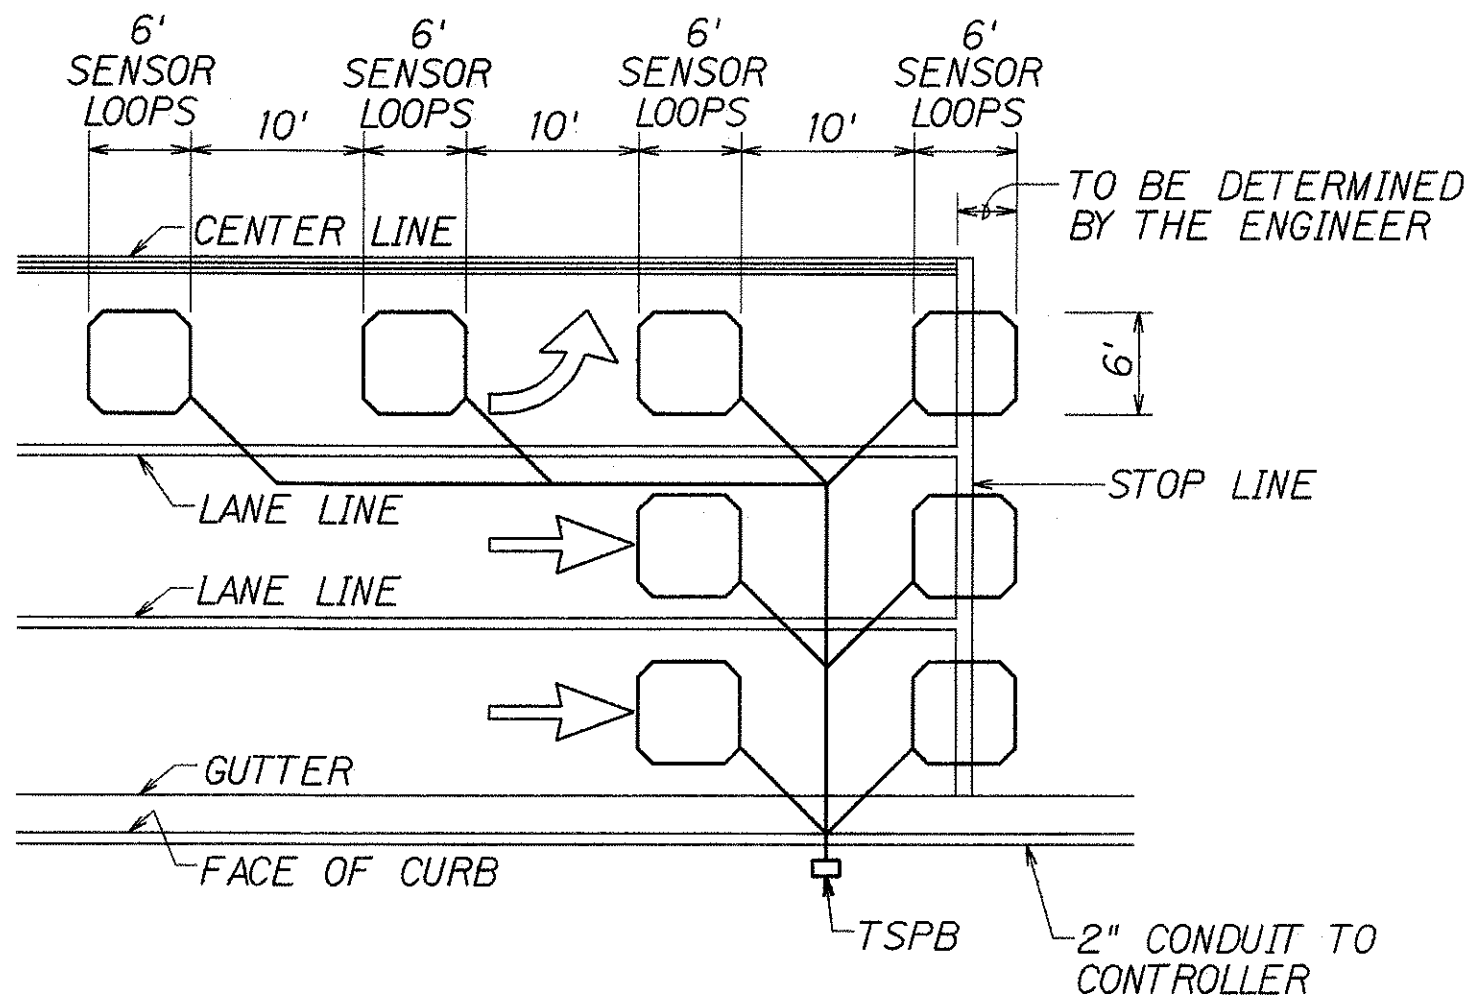


- NOTES:
1. Center sensor loops in lanes.
  2. Collector cables shall be twisted 2 turns per foot.
  3. Number of loops and locations vary. See project plans.
  4. Number and locations of collector sawcuts may be varied in the field to suit.


TYPICAL SENSOR LOOP LAYOUT

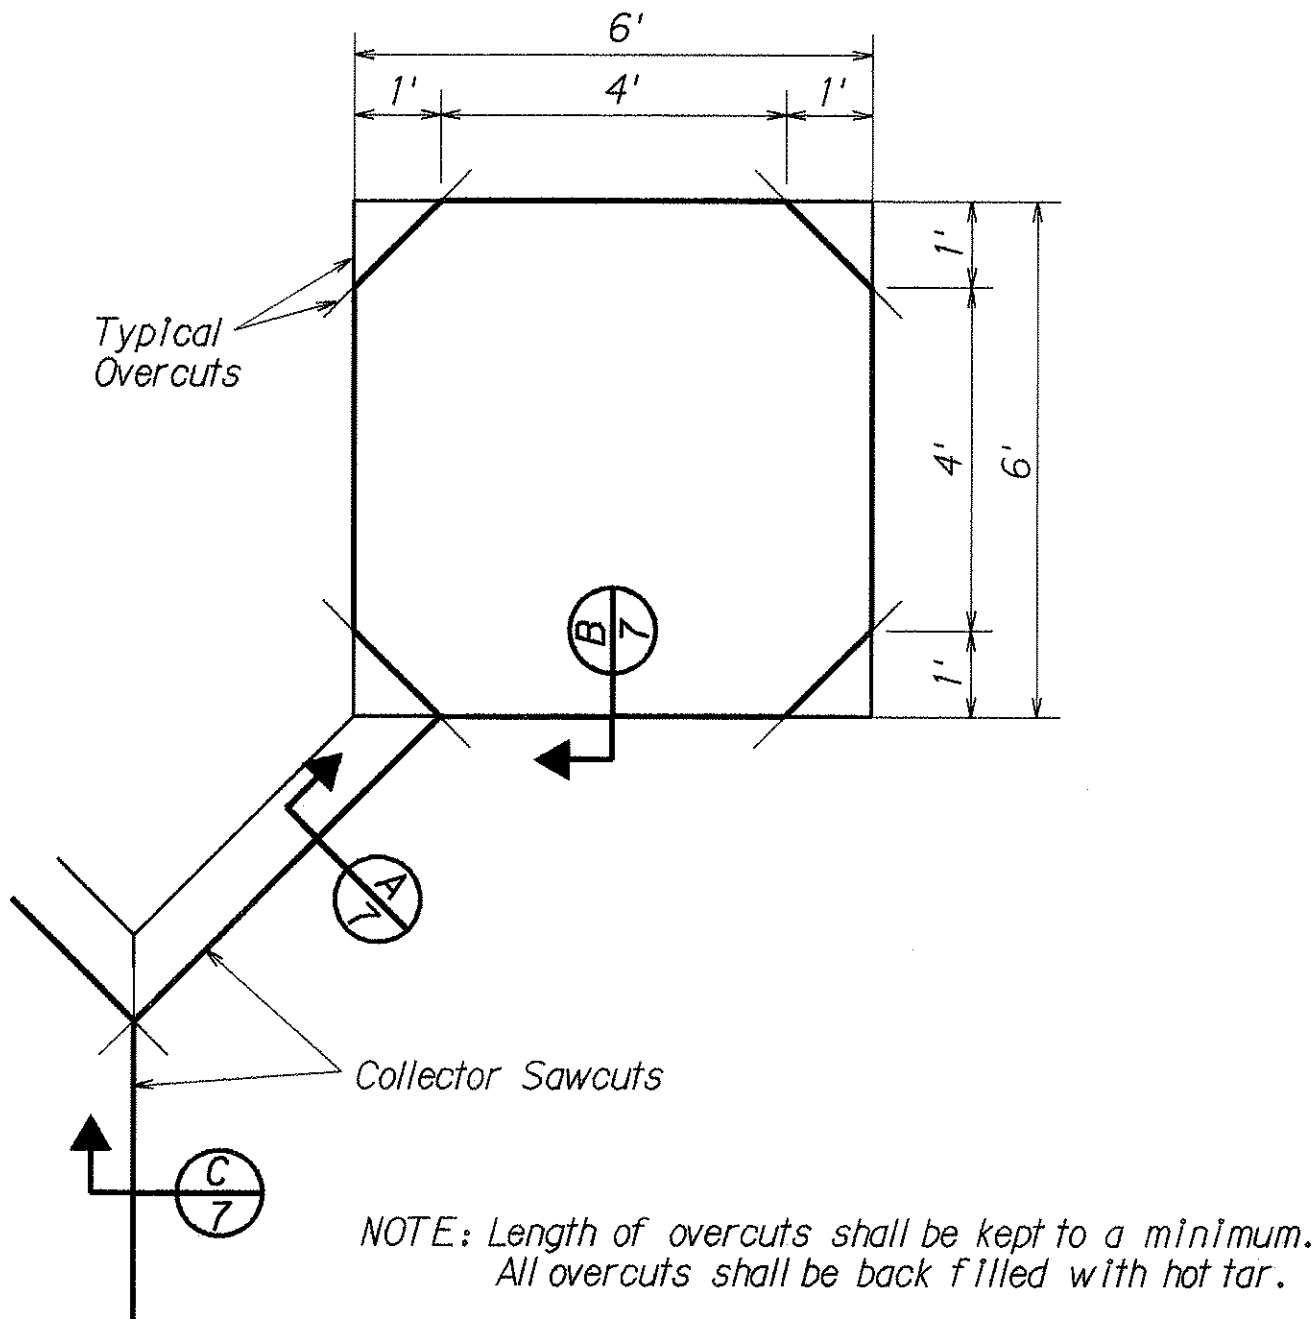

TYPICAL SENSOR LOOP SAWCUT DETAIL

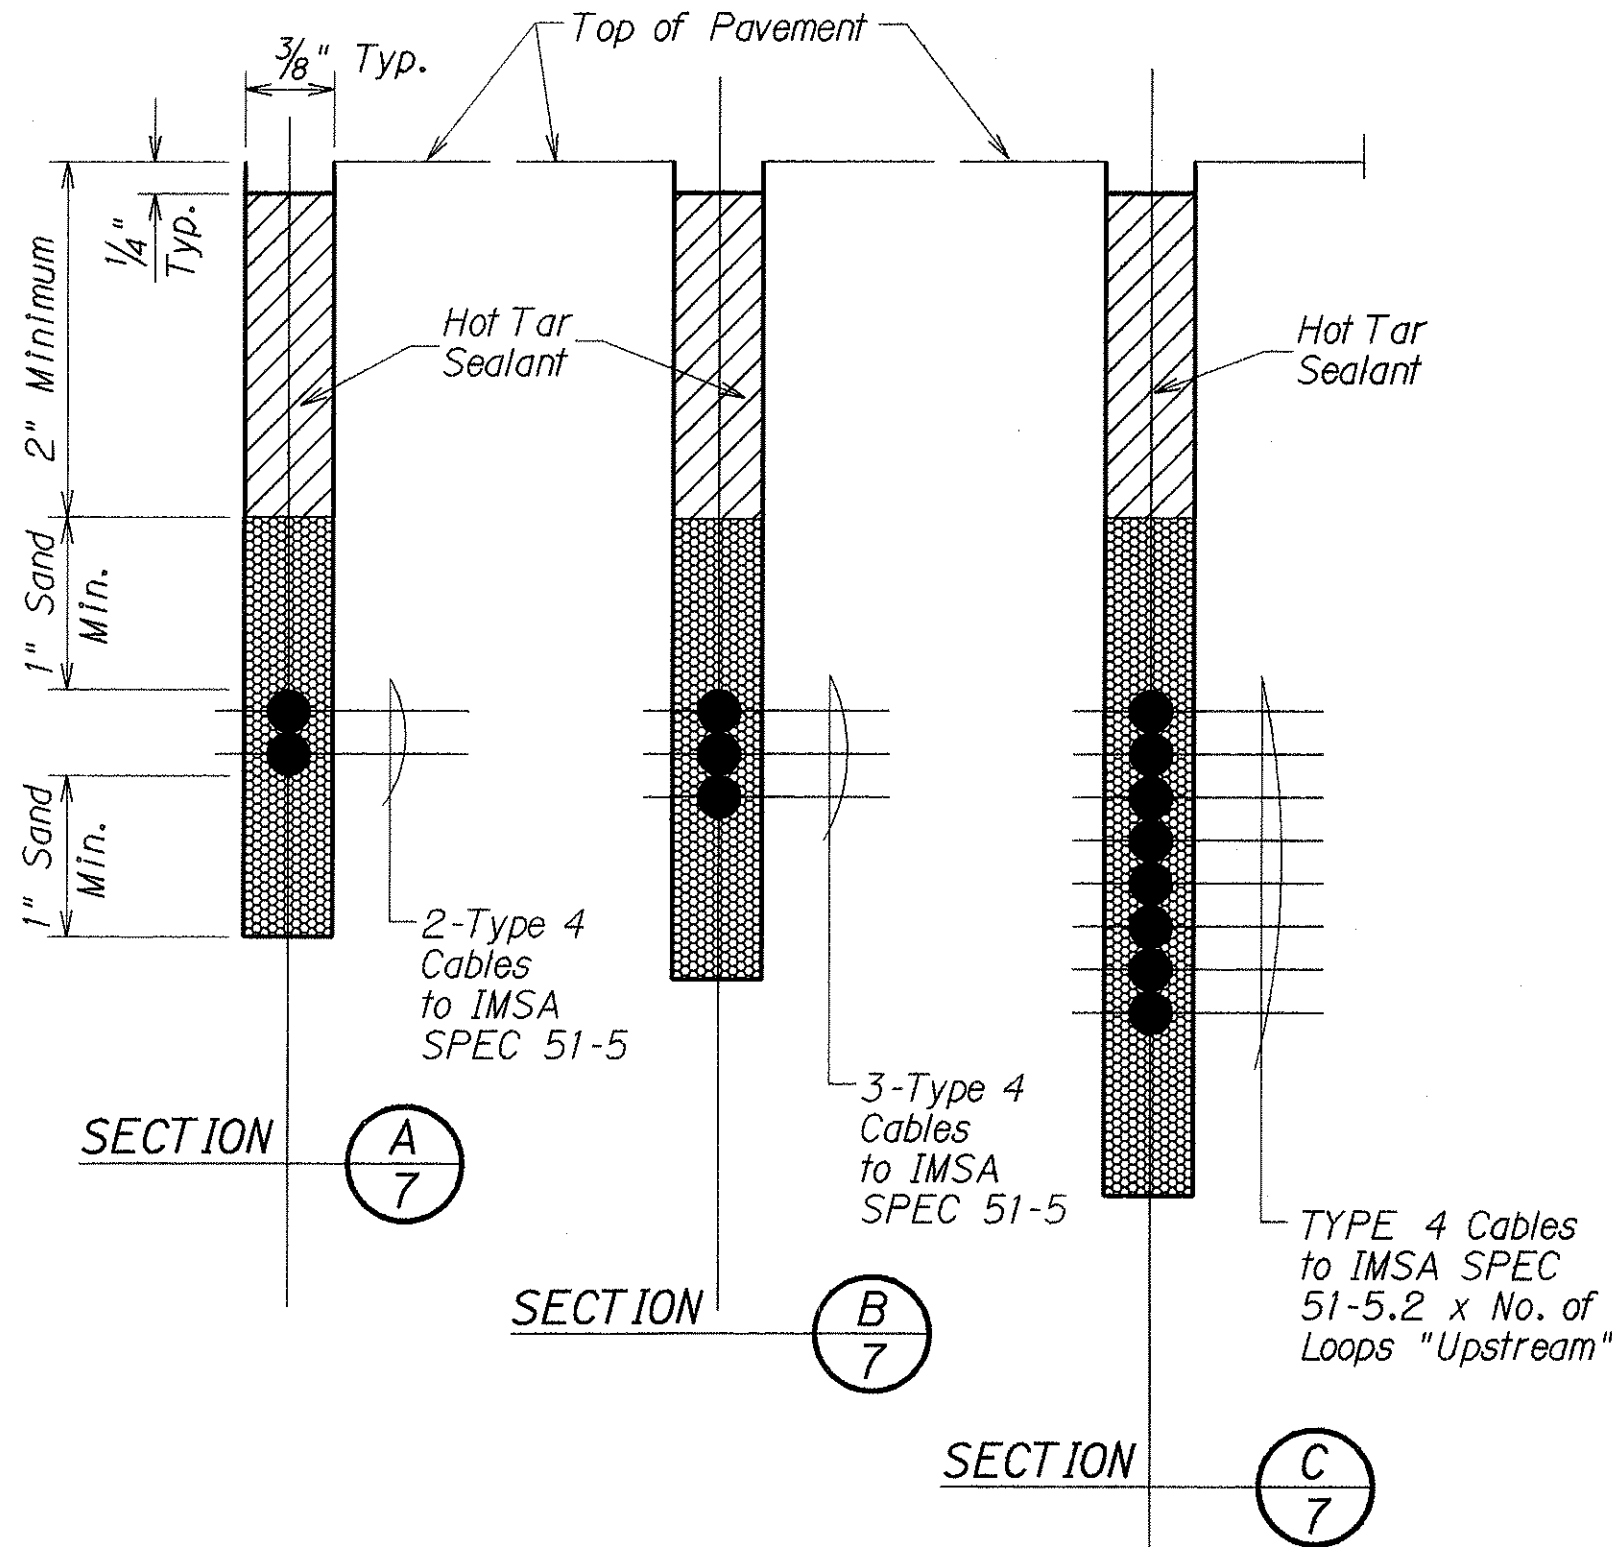


NOTE:  
REFER TO TE-40 OF THE STATE HIGHWAYS STANDARD PLANS FOR  
TYPICAL TRENCH SECTION FOR CONDUIT DETAIL.

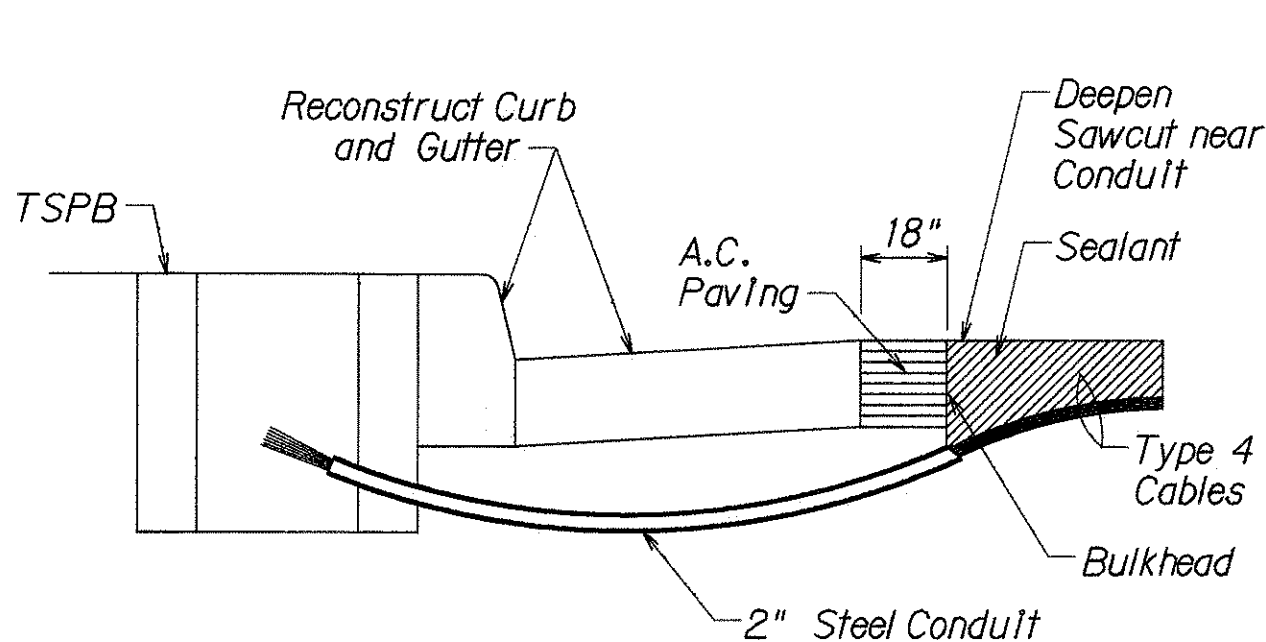

- NOTES ON CONSTRUCTION AT END OF SAWCUT
1. Seal roadway end of conduit after installation of conductors.
  2. Install bulkhead across conduit trench.
  3. Place hot tar in sawcut.
  4. Backfill over conduit with new A.C.
  5. Reconstruct curb and gutter as required.

DETAIL OF SENSOR LOOP INSTALLATION  
AT EDGE OF ROADWAY

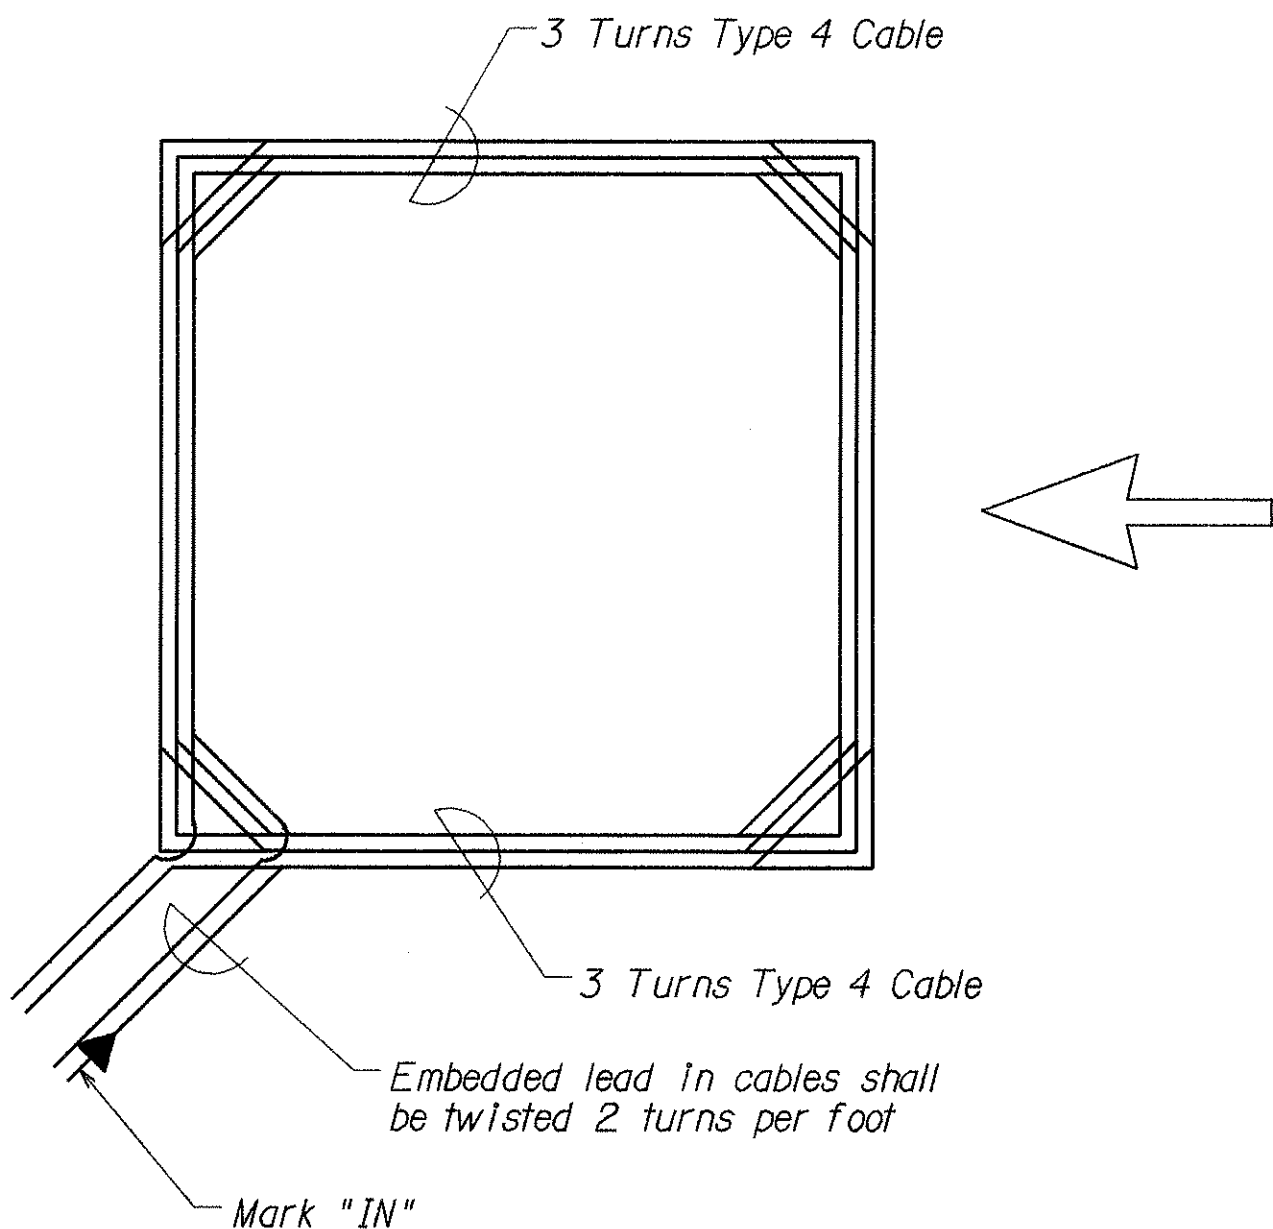

TYPICAL SENSOR LOOP WIRING DIAGRAM

#### TYPES OF CABLES

- |        |   |
|--------|---|
| TYPE 1 | Signal Loop Cable: Stranded No. 14, 26 conductors   |
| TYPE 2 | Detector Lead-In Cable and Pedestrian Push Button Circuit Cable: Stranded, No. 14, 2 Conductors |
| TYPE 3 | Interconnect Cable: Solid No. 20, 12 Pairs  |
| TYPE 4 | Loop Sensor Cable: Solid No. 12, Single Conductor to IMSA SPEC 51-5                             |
| TYPE 5 | Cable from Signal Loop to Signal Head: Stranded, No. 14, Single Conductor                       |
| TYPE 6 | Service Cable: Solid, No. 6, 3 Conductors   |

STATE OF HAWAII  
DEPARTMENT OF TRANSPORTATION  
HIGHWAYS DIVISION

**LOOP DETECTOR DETAILS**  
**ULUNE STREET IMPROVEMENTS**  
**Halawa Hts. Rd. to Halawa Valley Rd. #**  
**HALAWA VALLEY RD. IMPROVEMENTS**  
**Ulune Street to Iwaiwa Street**  
**F.A. Project No. STP-0300(39)**  
Not to Scale Date: Apr., 1996