
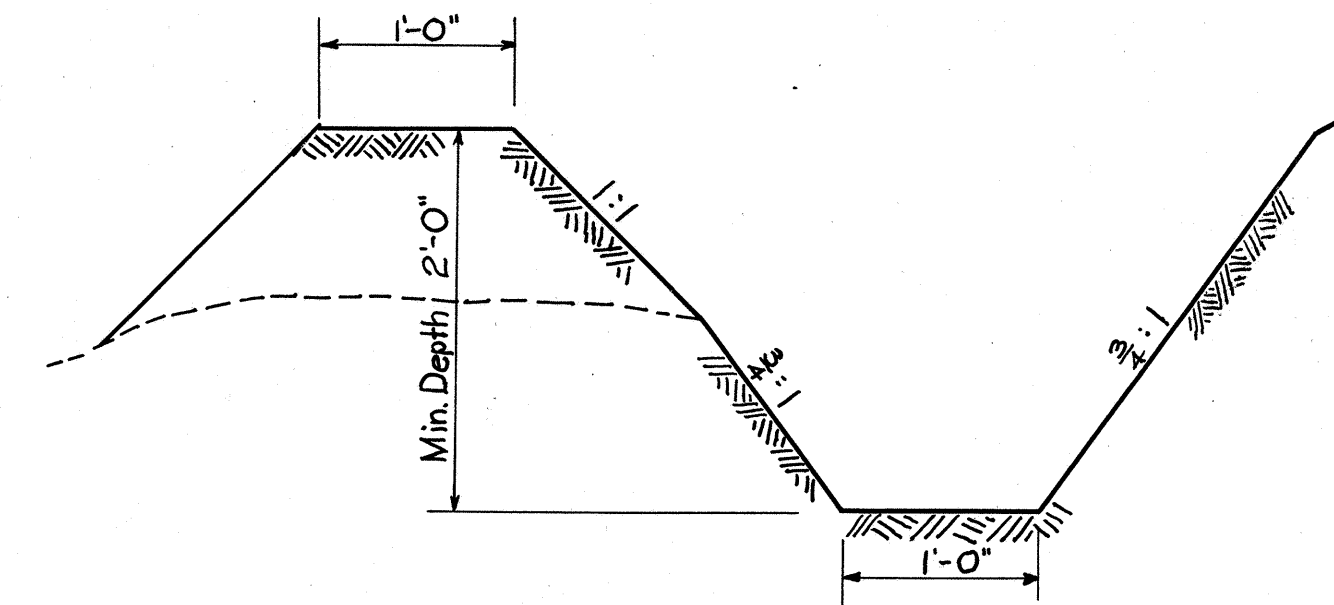


FED. ROAD DIST. NO.	STATE	FED. AID PROJ. NO.	FISCAL YEAR	SHEET NO.	TOTAL SHEETS
HAWAII	HAW	DA-NR-1	1942	2	27


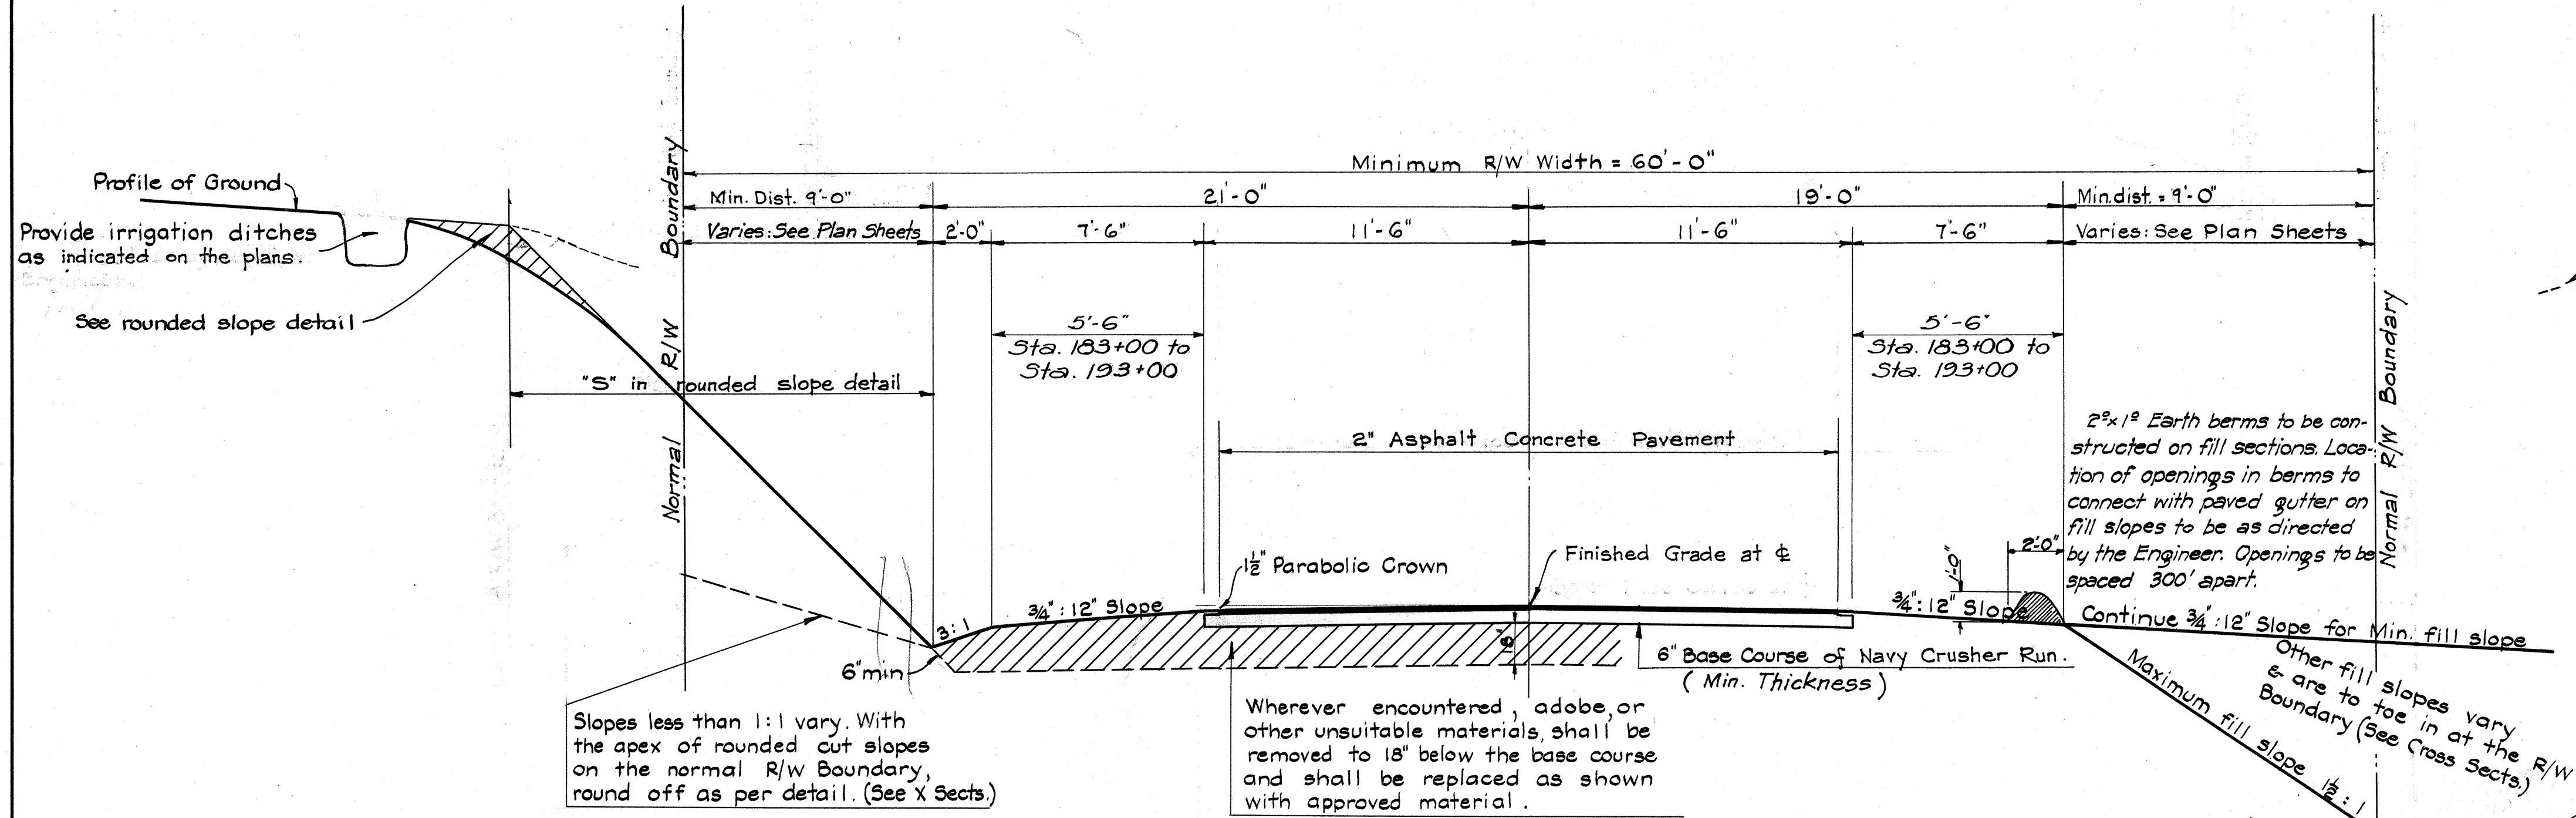


CUT SECTION

FILL SECTION

SECTIONS ON TANGENTS

Sections as shown are symmetrical about ϕ of Roadway

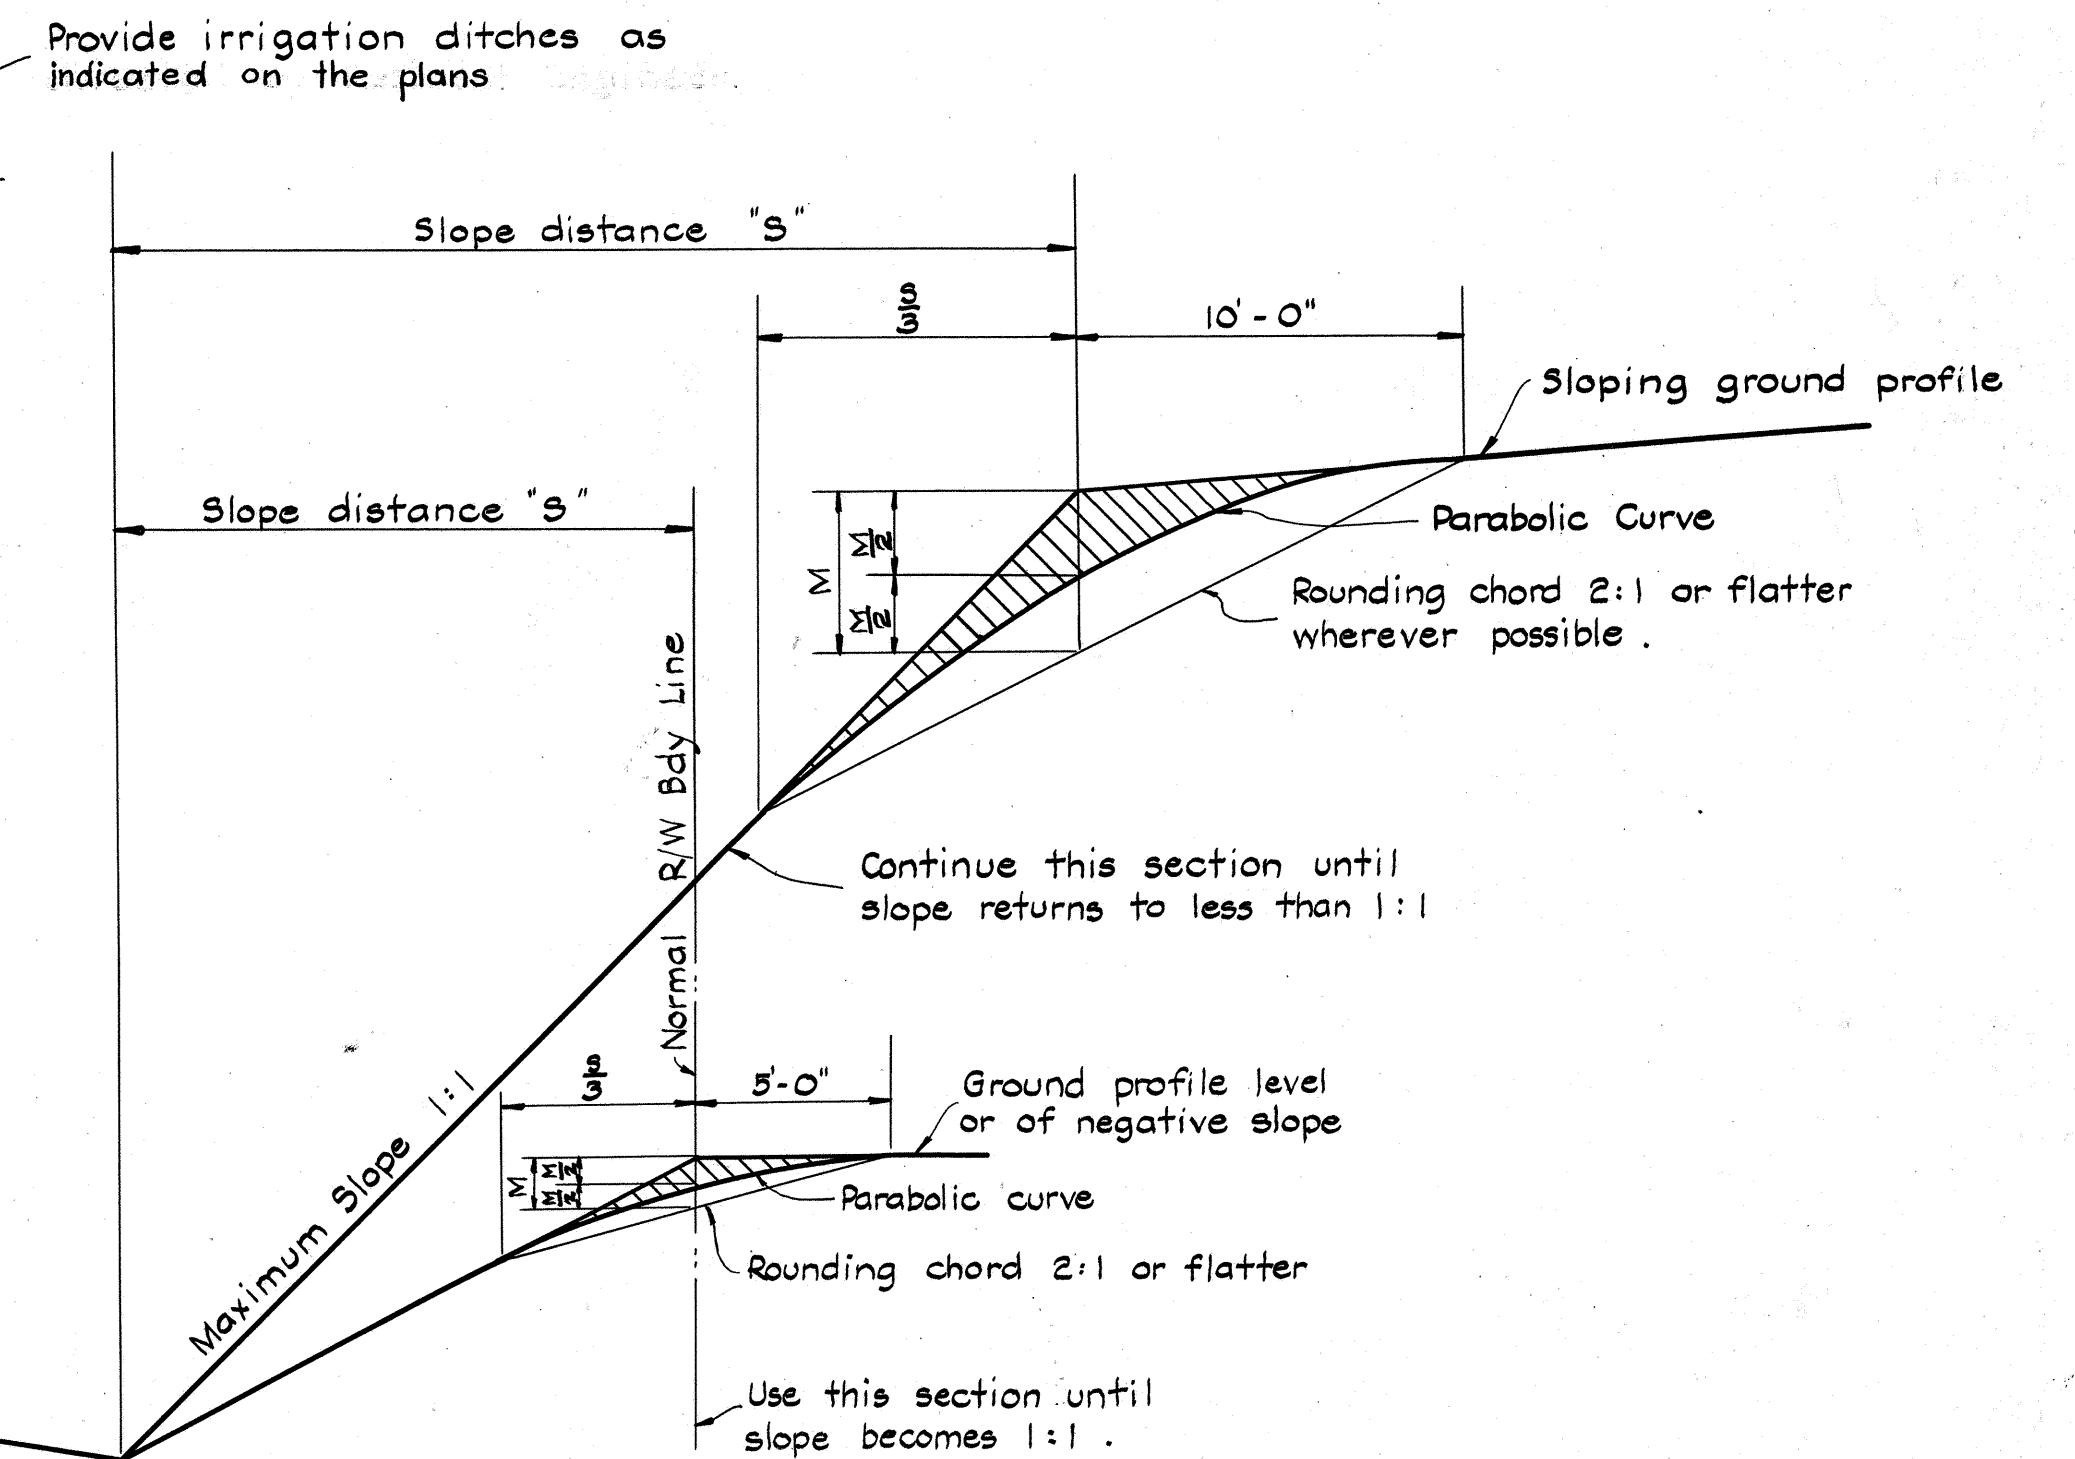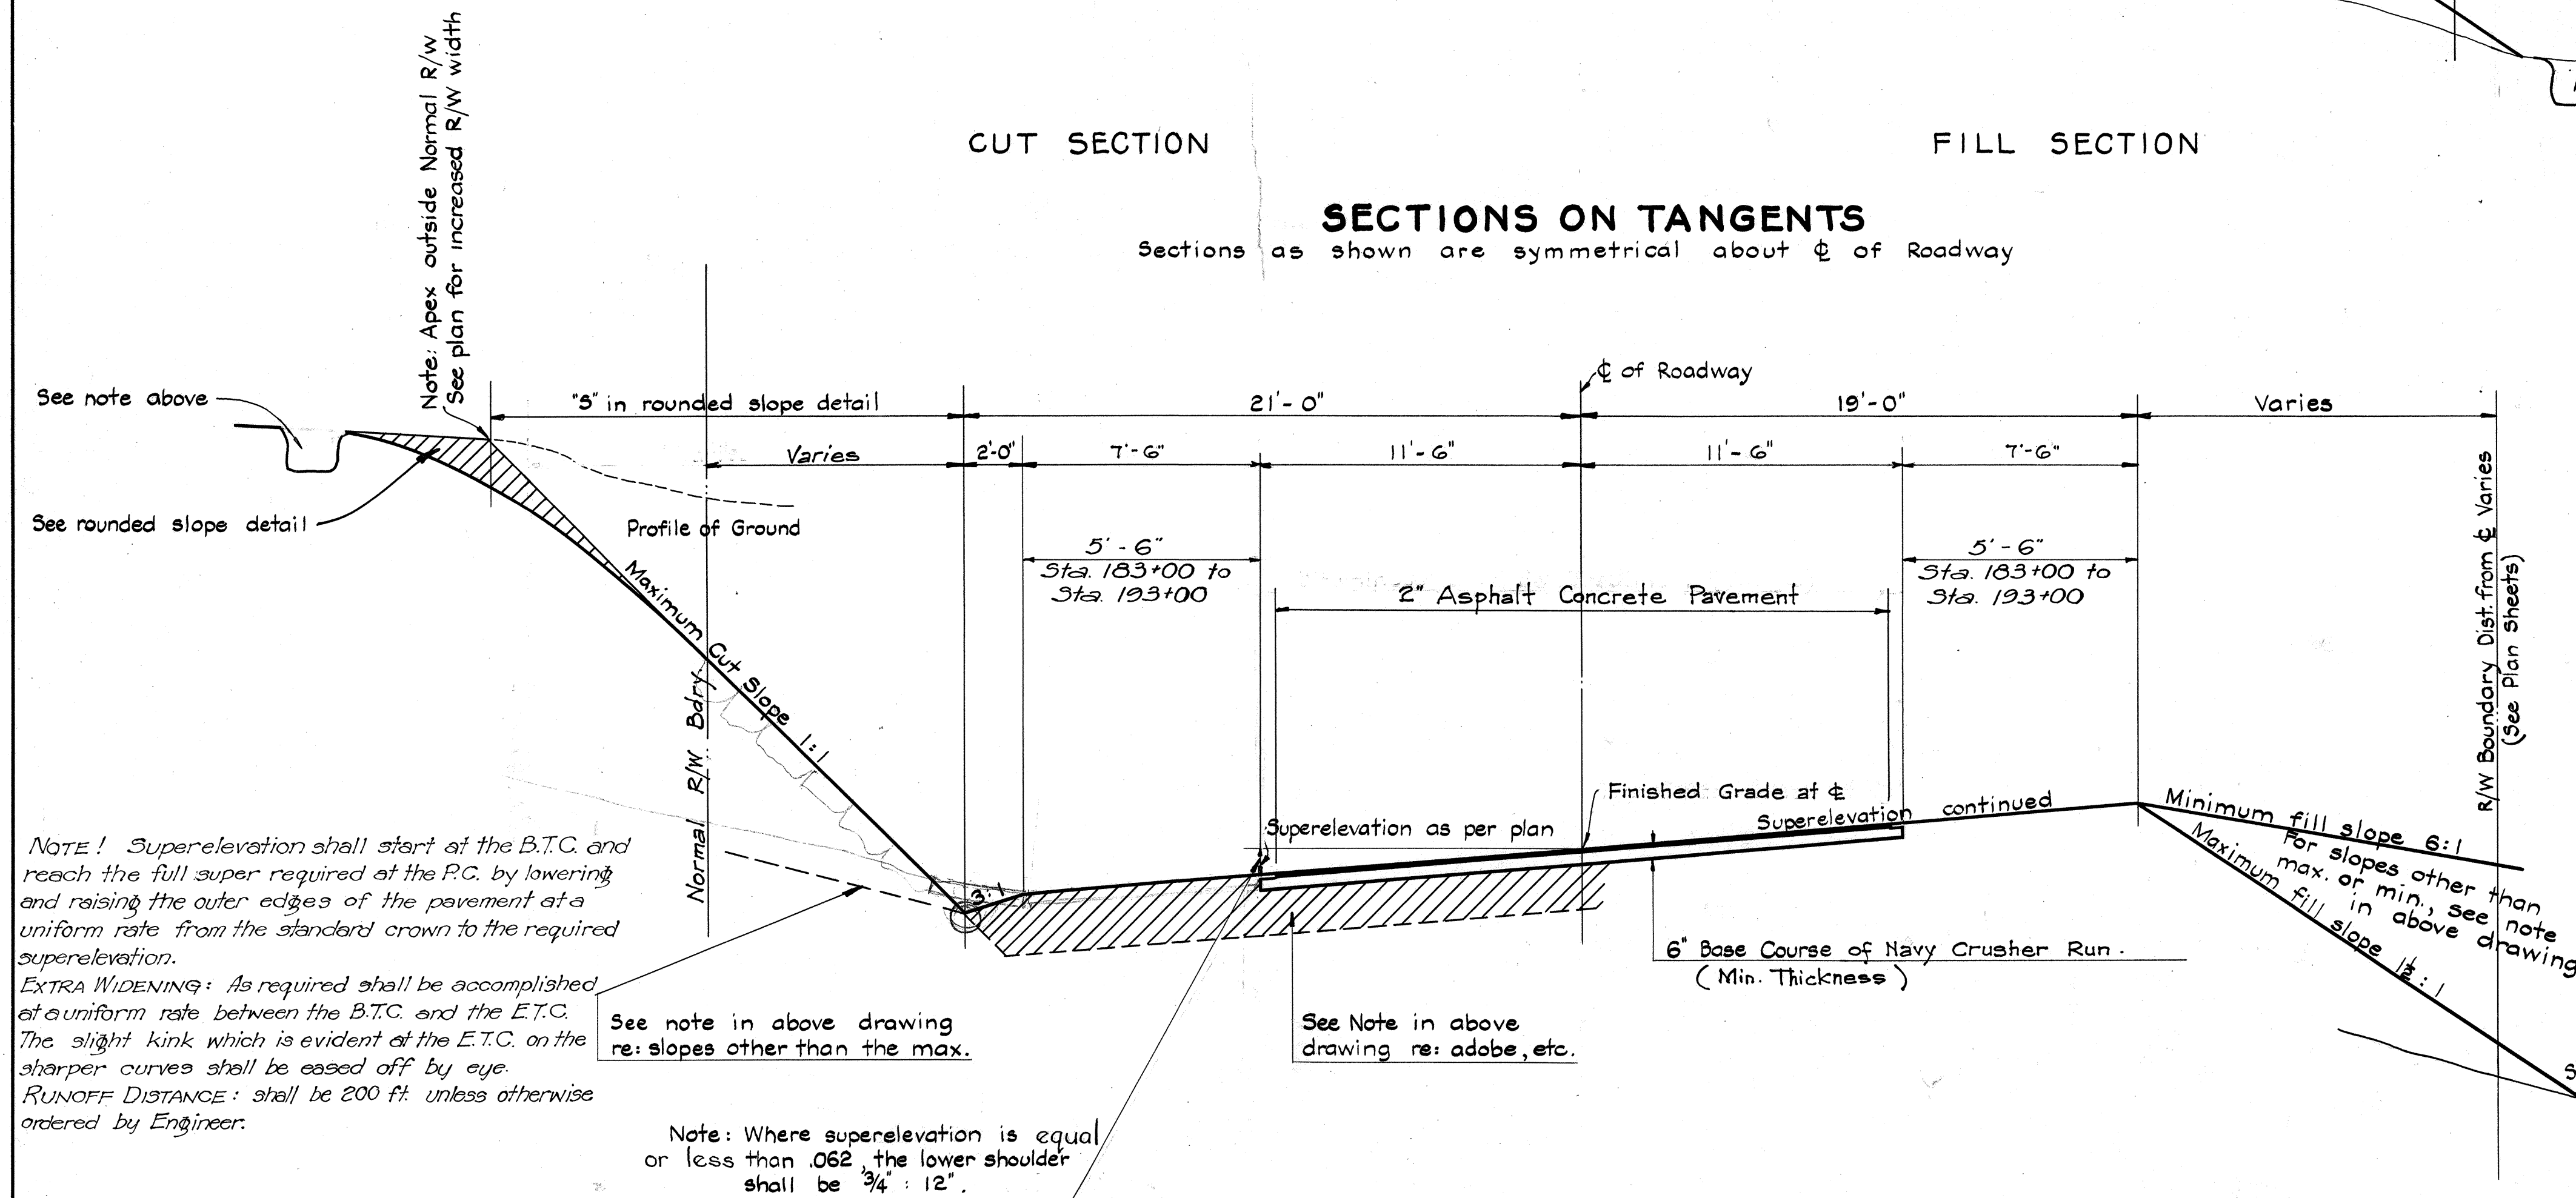

CUT SECTION

FILL SECTION

SECTIONS ON CURVES

Sections as shown are symmetrical about ϕ of Roadway

TYPICAL ROAD SECTIONS

TERRITORIAL HIGHWAY DEPARTMENT
TERRITORY OF HAWAII
TYPICAL SECTIONS
AIEA NAVAL HOSPITAL ACCESS
ROAD DA-NR-1

Scale: 1" = 4' Date: Jan. 19, 1942

SHEET NO. OF SHEETS

5103.2

NOTE! Earth Berms on Fill Sections Oct 2, 1942.

Note! Width of shoulder between Sta. 183+00 and Sta. 193+00 to be 5'-6". June 19, 1942.

DATE
SURVEY PLOTTED BY
DESIGNED BY
TRACED BY
QUANTITIES CHECKED BY
NOTE BOOK
No.