



FED. ROAD DIST. NO.	STATE	FED. AID PROJ. NO.	FISCAL YEAR	SHEET NO.	TOTAL SHEETS
HAWAII	HAW.	I-HI-1(87):13	1970	2	244

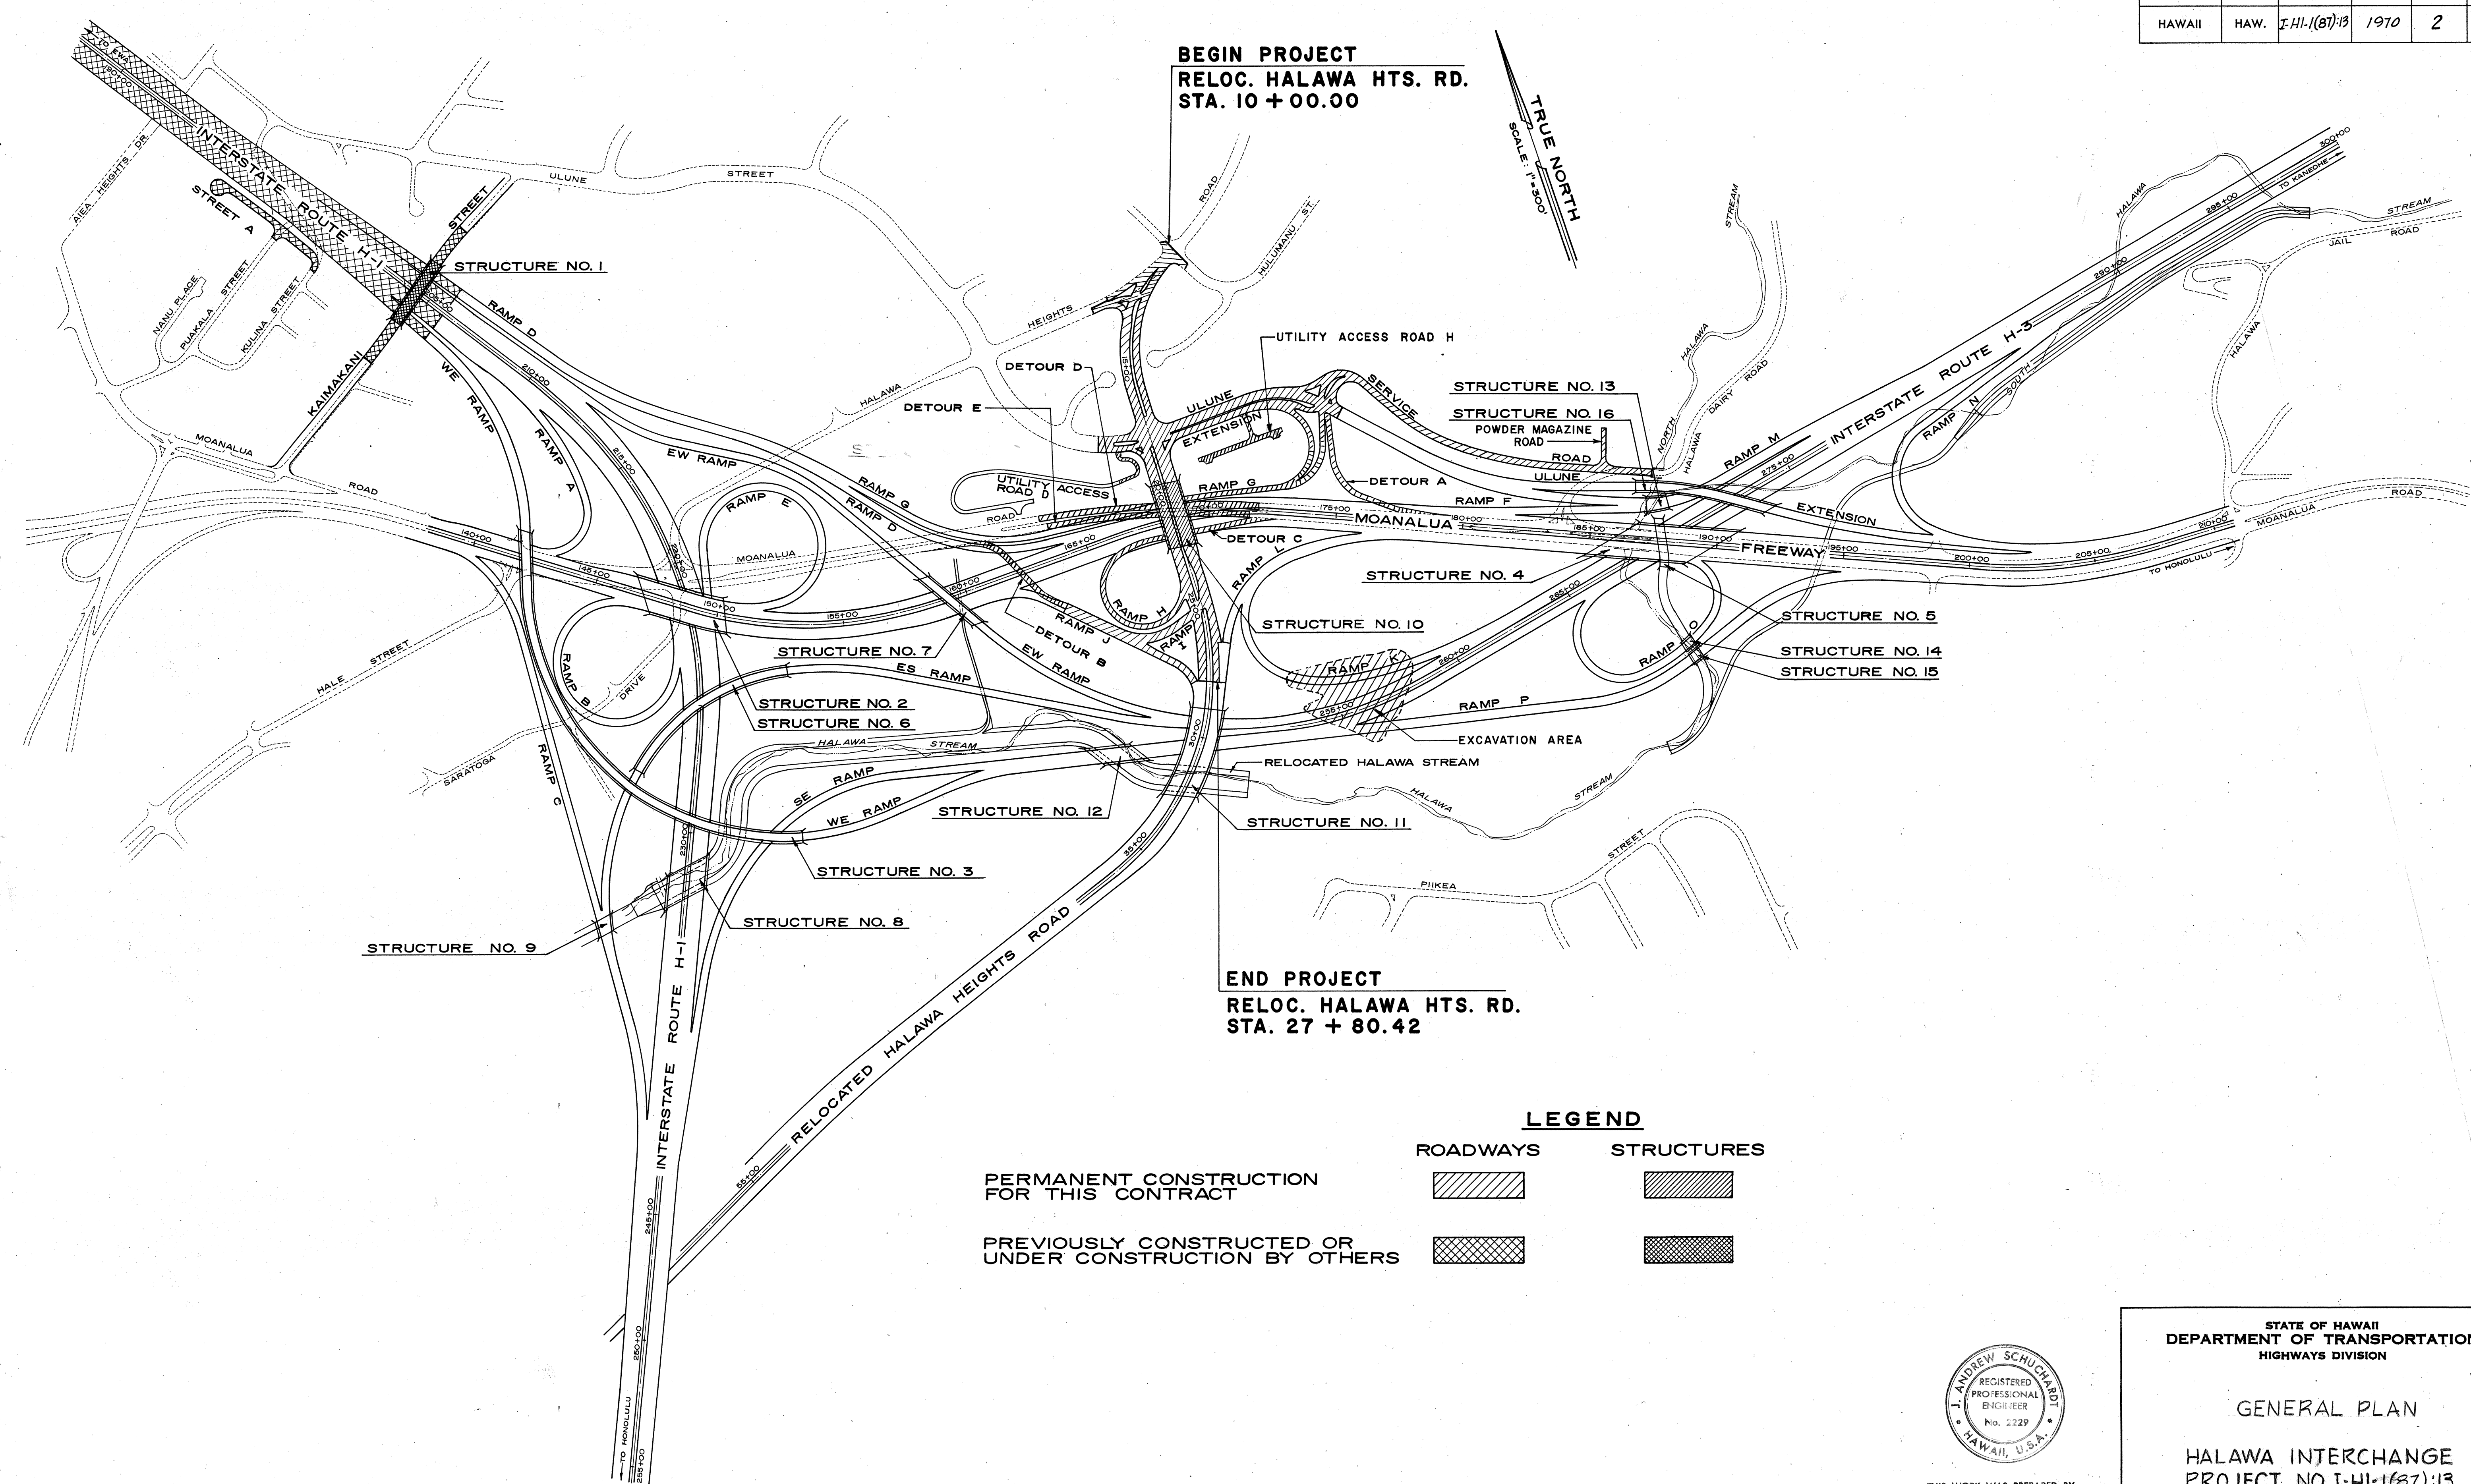

ORIGINAL PLAN	DATE
NOTED BY	
DESIGNED BY	
CHECKED BY	
DATE	

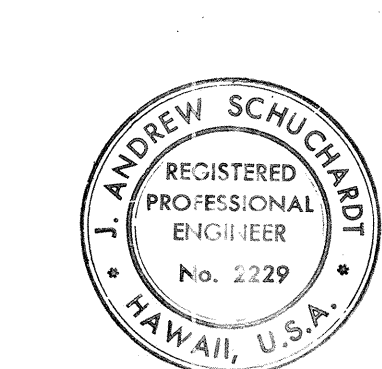

THIS WORK WAS PREPARED BY
ME OR UNDER MY SUPERVISION.
J. Andrew Schuchardt

STATE OF HAWAII
DEPARTMENT OF TRANSPORTATION
HIGHWAYS DIVISION

GENERAL PLAN

HALAWA INTERCHANGE
PROJECT NO I-HI-1(87):13

SCALE: 1"=300' DATE: 6/8/70

SHEET No. 1 OF 1 SHEETS