NDEX TO DRAWINGS			
INDEX TO DRAWINGS			
DESCRIPTION			
TITLE SHEET			
GENERAL PLAN			
TYPICAL SECTIONS			
ALIGNMENT PLANS			
ROADWAY PROFILES &			
S.E. DIAGRAMS			
RAMP TERMINAL DETAILS			
ROADWAY CONSTRUCTION			
PLANS & DETAILS			
DRAINAGE PLANS & DETAILS			
BORING LOCATION PLAN			
& BORING LOGS			
SOIL STABILIZATION DETAILS			
CONSTRUCTION SEQUENCE			
& TEMPORARY SIGNING			
SIGNING PLANS & DETAILS			
HIGHWAY LIGHTING &			
ELECTRICAL			
UTILITY PLANS & DETAILS			
ULUNE STREET BOX CULVERT			
PARK RETAINING WALL			
STRUCTURE NO 10 & DETAILS			
CROSS SECTION KEY SHEETS			
CROSS SECTIONS			

STATE OF HAWAII

DEPARTMENT OF TRANSPORTATION

HIGHWAYS DIVISION

HONOLULU, HAWAII
"AS BUILT"

PLANS FOR CONSTRUCTION OF A PORTION OF

HALAWA INTERCHANGE


HALAWA HEIGHTS ROAD SECTION

FEDERAL AID INTERSTATE PROJECT NO. I-HI-I(87):13

DISTRICT OF EWA

SCALES: DETOUR D BEGIN PROJECT RELOCATED HALAWA HEIGHTS ROAD B STA. 10+00.00 QUARRY ANIMAL QUARANTINE PROPOSED HONOLULU STADIUM STATION SITE RED HILL NAVAL RESERVATION WE RAMP END PROJECT RELOCATED HALAWA HEIGHTS ROAD B STA. 27+80.42 LAYOUT PLAN

SCALE: |" = 500

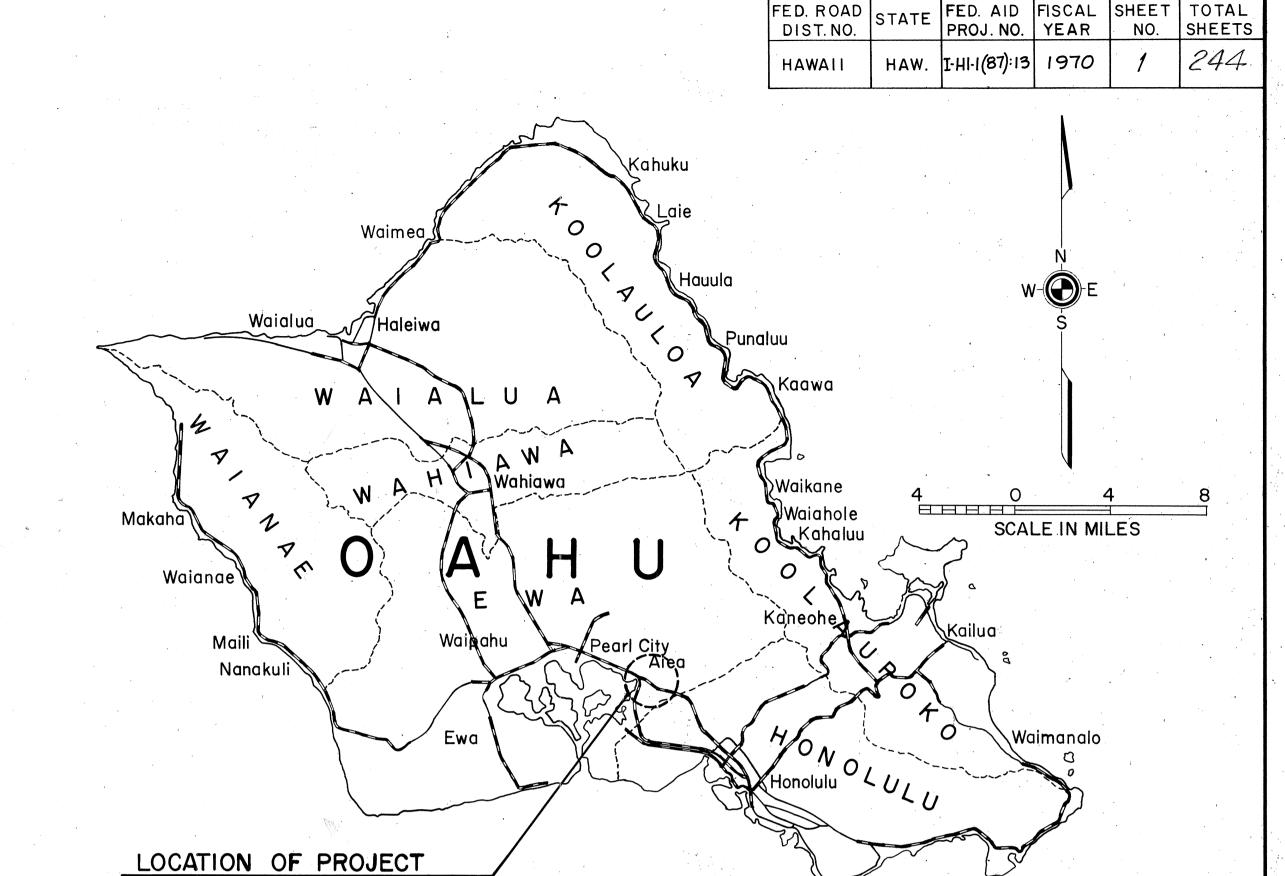

DESIGN CLASSIFICATION

ALL CHANGES MADE DURING CONSTRUCTION
HAVE BEEN INCORPORATED ON THESE PLANS
EXCEPT CHANGES IN THE ORIGINAL THEORETICAL
QUANTITIES.



	DEPARTMENT OF TRANSP	ORTATION
•	BUREAU OF PUBLIC	ROADS
	APPROVED:	
	J FWW DOD	1-13-71
٥	DIVISION ENGINEER	DATE

DEPARTMENT OF TRANSPORTATION STATE OF HAWAII			
APPROVED:	,		
A Martine	100/2000 76		
DIR. OF TRANSPORTATION	DATE		

Federal Aid Projects Previously Constructed or Under Construction

1.0.0.

6