


SUMMARY

FED. ROAD DIST. NO.	STATE	FED. AID PROJ. NO.	FISCAL YEAR	SHEET NO.	TOTAL SHEETS
HAWAII	HAW.	I-HI-1(90):13	1972	41	202

STRUCTURES			PIPE CULVERTS		ESTIMATED																	QUANTITIES																	REMARKS
INLET NUMBER	TYPE	STATION	ITEM	NO.	206.01	206.80	206.83	207.01	503.001	503.201	602.101		603.1020	603.6080	603.6200	603.6540	603.7200	603.7380	603.7520	603.7020	604.202	604.230	604.232	604.236	605.006	605.106	605.200		609.704	609.706	612.01	640.10	640.20	640.30					
			FROM	TO	STRUCTURAL EXCAVATION OTHER THAN IN BRIDGES	FILTER MATERIAL	FILTER MATERIAL FOR UNDERDRAINS	DITCH & CHANNEL EXCAVATION	CONCRETE OTHER THAN IN BRIDGES	CLASS B CONCRETE OTHER THAN IN BRIDGES	REINFORCING STEEL OTHER THAN IN BRIDGES		54" RCP CL III	48" CMP 0.1382" THK 42" RCP CL III	54" CMP 0.1382" THK 48" RCP CL III	48" RCP CL II 60" CMP 0.1681" THK	24" CMP 0.0785" THK 24" RCP CL III	24" ACP CL III	36" CMP 0.1084" THK 30" RCP CL III	30" ACP CL III	42" CMP 0.1382" THK 36" RCP CL III	36" ACP CL III	18" CMP 0.0785" THK 18" RCP CL III	18" ACP CL III	TYPE B CAST IRON FRAME & COVER	TYPE G1214 STEEL FRAME & GRATE	TYPE A-12 STEEL FRAME & GRATE	TYPE G1614 FRAME & GRATE	6" PERFORATED UNDERDRAIN PIPE	6" NON PERFORATED UNDERDRAIN PIPE	CLEANOUTS		BIT. GUTTER TYPE 7A	BIT. GUTTER TYPE 7B	GEOUTED ZOBBLE PAVING	LINED DRAINAGE DITCHES VEE SHAPED	LINED DRAINAGE DITCHES TRAP SHAPED	LINED DRAINAGE DITCHES RECT. SHAPED	
			UNIT	USE	CY	CY	CY	CY	CY	CY	LB		LF	LF	LF	LF	LF	LF	LF	LF	LF	EA	EA	EA	EA	LF	LF	EA		LF	LF	CY	LF	LF	LF				
1A	HEADWALL	MF 171+80, 84' RT			15					5	75																												
1B	DI TYPE A	L 14+25, 72' LT	L 14+25, LT.	K 20+62, 65' LT	195					5.5	345					290																							
2	HEADWALL	K 20+62, 65' LT.			15					5	75																												
3	DI TYPE A	K 19+63, 35' RT.	K 19+63, RT.	K 18+77, 60' LT	205					3.5	245							174																					
4	DI TYPE B	IR 256+40, 71' LT.	IR 256+40, LT	P 13+04, 66' RT.	485					6.5	415		240																										
5	DI TYPE G1214	K 13+50, 16' RT.	K 13+50, RT.	K 14+00, 13.5' RT.	45				2.3		35						50						1																
6	DI TYPE G1214	K 14+00, 13.5' RT.	K 14+00, RT.	K 14+40, 12.2' RT.	65				2.6		45							40					1																
7	DI TYPE G1214	K 14+40, 12.2' RT.	K 14+40 RT.	K 14+50, 12' RT.	30				3.3		240							10					1																
8	DI TYPE G1214	K 14+50, 12' RT.	K 14+50 RT.	P 15+00, 47' LT.	390				4.3		320								196				1																
9	DI TYPE B	P 15+00, 47' LT	P 15+00, LT.	P 15+00, 28' RT.	255					6	450			76																									
10	MH TYPE E	P 15+00, 28' RT.	P 15+00, RT.	P 13+04, 66' RT.	730					6.7	185				200						1																		
11	SPECIAL MH	P 13+04, 66' RT.			20				6.4		575																												
12	CB TYPE SA-2	IR 252+90 &	IR 252+90 &	IR 252+40 &	20				3.6		180						50						2																
13	CB TYPE SA-1	IR 252+40 &	IR 252+40 &	WE 252+13, 95 RT.	60				2.8		140						110						1																
	UNDERDRAINS	RAMP O & P			175		130																		1440	10	6												
	"	RAMP K & L			120		110																		1385	15	4												
	"	RAMP EW & WE			190		105																		1275	10	6												
	"	HALAWA HEIGHTS ROAD			5		5																																
	"	INTERSTATE ROUTE			190		170																																
	HALAWA STREAM CHANNEL UNDER STRUCTURE #11					105			47		1250															2200	20	6											
		SUBTOTAL SHEETS 2DA, 2D & 3D			271			3079	19.5	7.1	890						350			62	3			7						2455	2428	3.8	1251	1885	185				
		TOTAL			3481	105	520	3079	91.8	49.3	5465		240	76	200	290	560	224	196	62	4	4	3	7	6300	55	22		2455	2428	3.8	1251	1855	185					
		ROUNDED TOTAL			3483	105	520	3080	92	45	5465		240	76	200	290	560	224	196	62	4	4	3	7	6300	55	22		2455	2430	4	1255	1855	185					

SEE HALAWA STREAM STRUCTURE PLANS FOR QUANTITIES

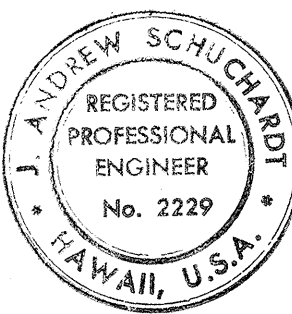

STATE OF HAWAII
DEPARTMENT OF TRANSPORTATION
HIGHWAYS DIVISION

DRAINAGE ESTIMATED QUANTITIES

INTERSTATE ROUTE H-1
PROJECT NO. I-H1-1(90):13

DATE: DEC 24, 1970

SHEET No. 10 OF 25 SHEETS

ORIGINAL PLAN	SURVEY PLOTTED BY _____	DATE _____
NOTE BOOK	DRAWN BY _____	_____
	TRACED BY _____	_____
	DESIGNED BY _____	_____
	QUANTITIES BY _____	_____
No. _____	CHECKED BY _____	_____

LOCATION	TYPE	BITUMINOUS GUTTER TYPE 7A	LINED DITCHES (FEET)	LINED DITCHES (TRAPEZOIDAL)	DITCH & CHANNEL EXCAVATION
L Sta. 19+91, 16' Rt. To L Sta. 17+00, 28' Rt.	7A	285			
L Sta. 17+00, 28' Rt. To L Sta. 16+13, 50' Rt.	7A-3		80		23
L Sta. 16+13, 50 Rt. To K Sta. 19+82, 46' Rt.	3		337		121
K Sta. 19+82, 46' Rt. To K Sta. 19+63, 35' Rt.	3-14		20		5
L Sta. 17+80, 49' Lt. To L Sta. 15+65, 101' Lt.	4			252	71
MF Sta. 171+80, 84' Rt. To L Sta. 14+41, 72' Lt.	6			230	233
L Sta. 14+41, 72' Lt. To L Sta. 14+23, 72' Lt.	6-11		20		68
K Sta. 20+62, 65' Lt. To IR Sta. 255+98, 75' Lt.	6			500	508
IR Sta. 255+98, 75' Lt. To IR Sta. 256+40, 71' Lt.	6-12			42	44
P Sta. 13+04, 66' Rt. To P Sta. 12+84, 67' Rt.	13-8			20	37
P Sta. 12+84, 67' Rt. To HS Sta. 41+00, 46' Lt.	8			455	998
K Sta. 19+00, 12' Rt. To K Sta. 14+50, 12' Rt.	7A	445			
IR Sta. 265+38, 65' Lt. To K Sta. 14+50, 12' Rt.	7A	740			
IR Sta. 258+50, 53' Lt. To EW Sta. 148+50, 16' Lt.	7A	985			
EW Sta. 184+50, 16' Lt. To EW Sta. 147+13, 33' Lt.	15		140		172
IR Sta. 257+00, 64' Lt. To IR Sta. 256+40, 71' Lt.	2		55		6
P Sta. 16+34, 89' Lt. To P Sta. 15+19, 53' Lt.	5			120	45
P Sta. 15+19, 53' Lt. To P Sta. 15+00, 47' Lt.	5-10			20	8
SHS Sta. 1+06, 215' Rt. To SHS Sta. 0+38, 29' Rt.	9			226	617
P Sta. 28+50, 31' Lt. To NHS Sta. 4+09, 17.5' Rt.	1		179		18

CHANNEL A	3.1 CY
-----------	--------

GRP ITEM 612.01 3.1 CY

2455

811	18
-----	----

5

2974

LF	
----	--

LF	
----	--

CY


ITEM NO.

609.704


640 . 10	64
----------	----

20	
----	--


207.01

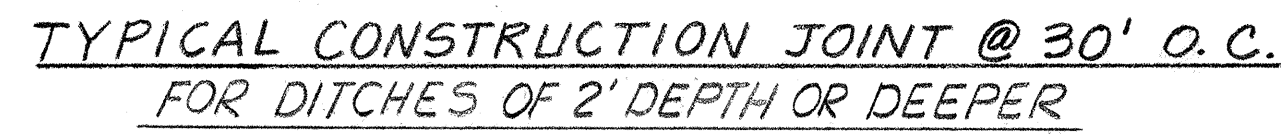

Scale $\frac{3}{4}" = 1'-0"$

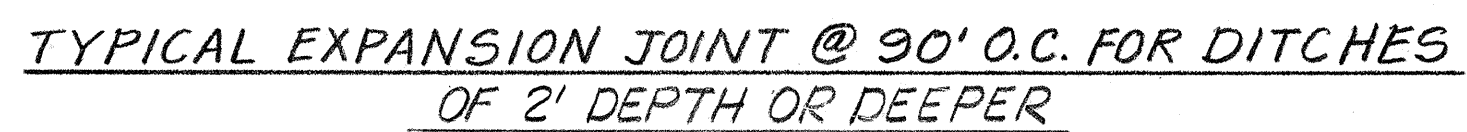

Scale: $\frac{3}{4}" = 1'-0"$

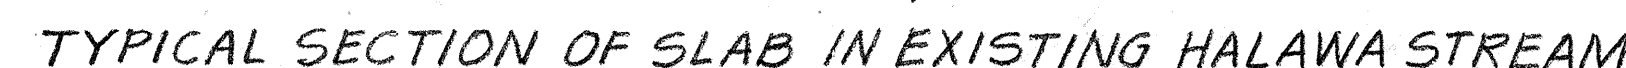


Scale: $\frac{3}{4}" = 1'-0"$



Detail Shows Expansion Joint; Contraction Joint Similar Except For Preformed Joint Filler and Roofing Paper.
Scale: 3" = 1'-0"

NOTES FOR HALAWA STREAM CHANNEL

1. All Concrete shall be Class A.
2. Stop Reinforcement at All Joints As Shown.
3. Match Existing Joints of Existing Slab.
4. Removal of Asphalt Pavement and Excavation Shall be Paid Under Structure Excavation.

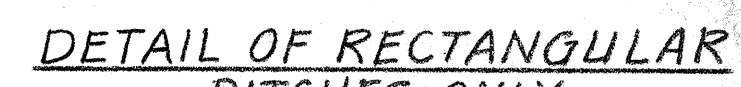

DITCHES ONLY
(Depth $A \geq 3'-0"$)

4" ϕ Drain @ 10'-0" o.c.
For Ditches 2' Deep or Greater

[illegible]

Scale: $\frac{1}{2}" = 1'-0"$

GENERAL DITCH & CHANNEL NOTES

1. Contractor may substitute ditches of other shapes & of greater capacities if approved by the Engineer. Payment will be on the original ditch as shown on the plans.
2. Expansion & Construction Joints are incidental to Lined Drainage Ditches.
3. Transitions between Ditch or Gutter Types are denoted by two Digits and are paid for under the Lined Ditch Type or the Gutter Type which is the most expensive.

THIS WORK WAS PREPARED BY
ME OR UNDER MY SUPERVISION.

J. Andrew Schuchart

**STATE OF HAWAII
DEPARTMENT OF TRANSPORTATION
HIGHWAYS DIVISION**

DRAINAGE ESTIMATED QUANTITIES

INTERSTATE ROUTE H-1
PROJECT NO. I-H1-1(90):13

SCALE: AS SHOWN

DATE: DEC 24, 1970

SHEET No. 2D OF 25 SHEETS

412

FED. ROAD DIST. NO.	STATE	FED. AID PROJ. NO.	FISCAL YEAR	SHEET NO.	TOTAL SHEETS
HAWAII	HAW.	I-HI-1(90):13	1972	42A	202

ORIGINAL PLAN	SURVEY PLOTTED BY _____	DATE _____
NOTE BOOK	DRAWN BY _____	" _____
	TRACED BY _____	" _____
	DESIGNED BY _____	" _____
	QUANTITIES BY _____	" _____
No. _____	CHECKED BY _____	" _____
	_____	_____

4 2 A

SCHEDULE OF ROADWAY LINED SWALES & DITCHES								
LOCATION	TYPE	BITUMINOUS GUTTER TYPE 7A	BITUMINOUS GUTTER TYPE 7B		LINED DITCHES (VEE)	LINED DITCHES (TRAPEZOIDAL)	LINED DITCHES (RECTANGULAR)	DITCH & CHANNEL EXCAVATION
EW STA 139+72, 12' Lt. To EW STA 147+25, 12' Lt.	7B		753					
EW STA 147+25, 12' Lt. To EW STA 147+50, 12' Lt.	7B *		25					
L STA 11+75, 12' Rt. To L STA 13+64, 12' Rt	7B		199					
K STA 21+72, 20' Lt. To K STA 20+62, 65' Lt.	16						110	18
P STA 33+58, 24' Rt. To P STA 28+96, 24' Rt.	7B		462					
0 STA 10+95, 10' Rt. To 0 STA 14+15, 8' Rt.	7B		320					
0 STA 15+62, 8' Rt. To 0 STA 17+50, 8' Rt.	7B		188					
0 STA 17+50, 8' Rt. To 0 STA 18+06, 24' Rt	7B-2				56			7
0 STA 18+06, 24' Rt. To 0 STA 18+49, 105' Rt	2				94			11
0 STA 21+57, 9' Rt. To 0 STA 20+20, 8' Rt.	7B		137					
0 STA 20+20, 8' Rt. To 0 STA 19+65, 22' Rt.	7B-17				43			10
0 STA 19+65, 22' Rt. To NHS STA 4+86, 17.5' Lt	17				247			47
P STA 25+90, 18' Lt. To P STA 22+46, 18' Lt	7B		344					
H-3 STA 265+20, 70' Lt. To IR STA 265+00, 65' Lt.	16						20	3
MF STA 171+15 90' Rt. To L STA 15+80, 115' Lt.	16						55	9
SUBTOTAL SHEET 2D		2455			811	1885		2974
SUBTOTAL SHEETS 2D & 3D		2455	2428		1251	1885	185	3079
		LF	LF		LF	LF	LF	CY
ITEM NO.		609.704	609.706		640.10	640.20	640.30	207.01

Shoulder

2'-0"

5'-0"

Bituminous Gutter

2'-0" Min.

Guard Rail where shown on Plans

2"x4" Redwood Header Incidental to Gutter

4" Min.

6:1

4' Rounding

2:1 Fill (Max.)

RS-1 Seal

1:1

A.C.

Aggregate Base

A.C. Mix V

Aggregate Subbase Course

1:1

Note: A.C. Mix V thickness to conform to Shoulder A.C. thickness.

BITUMINOUS GUTTER TYPE 7B

Scale: 1/2" = 1'-0"

FED. ROAD DIST. NO.	STATE	FED. AID PROJ. NO.	FISCAL YEAR	SHEET NO.	TOTAL SHEETS
HAWAII	HAW.	I-HI-(90):13	1972	43	202



THIS WORK WAS PREPARED BY
ME OR UNDER MY SUPERVISION.
J. Andrew Schuchard

**STATE OF HAWAII
DEPARTMENT OF TRANSPORTATION
HIGHWAYS DIVISION**

DRAINAGE ESTIMATED QUANTITIES

INTERSTATE ROUTE H-1
PROJECT NO. I-HI-1 (90):13

SCALE: AS SHOWN

DATE: DEC. 24, 1970

SHEET No. 3D OF 25 SHEETS

FED. ROAD DIST. NO.	STATE	FED. AID PROJ. NO.	FISCAL YEAR	SHEET NO.	TOTAL SHEETS
HAWAII	HAW.	I-H1-1(90):13	1972	44	202



GRADING & DRAINAGE LEGEND

- Storm Drain Pipe
- Underdrain Pipe
- Swailes
- Filter Material in 2' Wide Trenches @50' Intervals
- Paved Ditches & Channels
- Cleanouts
- Grouted Rubble Pavement (9" Thick)
- PVC Pipe in Concrete Jacket for Sprinkler System control wiring (See Drainage Details Sheet)
- PVC 160 PSI Pipe or ACP 150 Pound Pressure Pipe within ACP Class II and CMP 0.079" thick Sleeve for Sprinkler System

GENERAL NOTES

- All Paved Ditch & Channel Excavation is limited to the Width and Depth of Paved Area.
- All Pipes Exiting Inlets are to be Groove Ended or Rounded.
- All Paved Ditches Paralleling & Adjacent to Roadways are to be Bituminous Gutters, all other Ditches & Channels are Reinforced Concrete unless otherwise noted.
- All Regraded Areas are to have Slope Control Planting.
- The pipes and sleeves for the Sprinkler System shall be placed under proposed roadways at a minimum of 12" below sub-base. PVC Pipe within sleeves shall project a minimum of 2 feet from each end of sleeve. All pipes shall be plugged. Plugs shall be approved by the Engineer and shall be incidental to the cost of the pipe. Locations of pipes shall be marked in a fashion approved by the Engineer. PVC Pipe shall be PVC 1120 (SDR 26) 160 PSI Ring Type 8" Water Pipe shall be Asbestos Cement Pressure Pipe, Class 150, Type II conforming to ASTM Designation C 296. 12" and 15" Pipe Sleeves shall be Corrugated Metal Pipe, No. 16 gage. All pipes and sleeves shall be installed in accordance with the Manufacturers recommendation.
- North and South Halawa Stream Flow is to be maintained at all times during construction. Contractor is to furnish materials, equipment, labor, tools and incidentals necessary to accomplish maintenance of flow, the cost of which shall be incidental to construction of the respective stream channels and culverts.
- Pipe Abbreviations
RCP.....Reinforced Concrete Pipe
ACP.....Asbestos Cement Pipe
CMP.....Corrugated Metal Pipe

DATE	_____
DESIGNED BY	_____
TRACED BY	_____
NOTED BY	_____
CHECKED BY	_____
ORIGINAL PLAN	_____
NOTE BOOK	_____
No.	_____

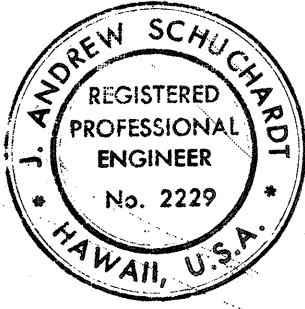
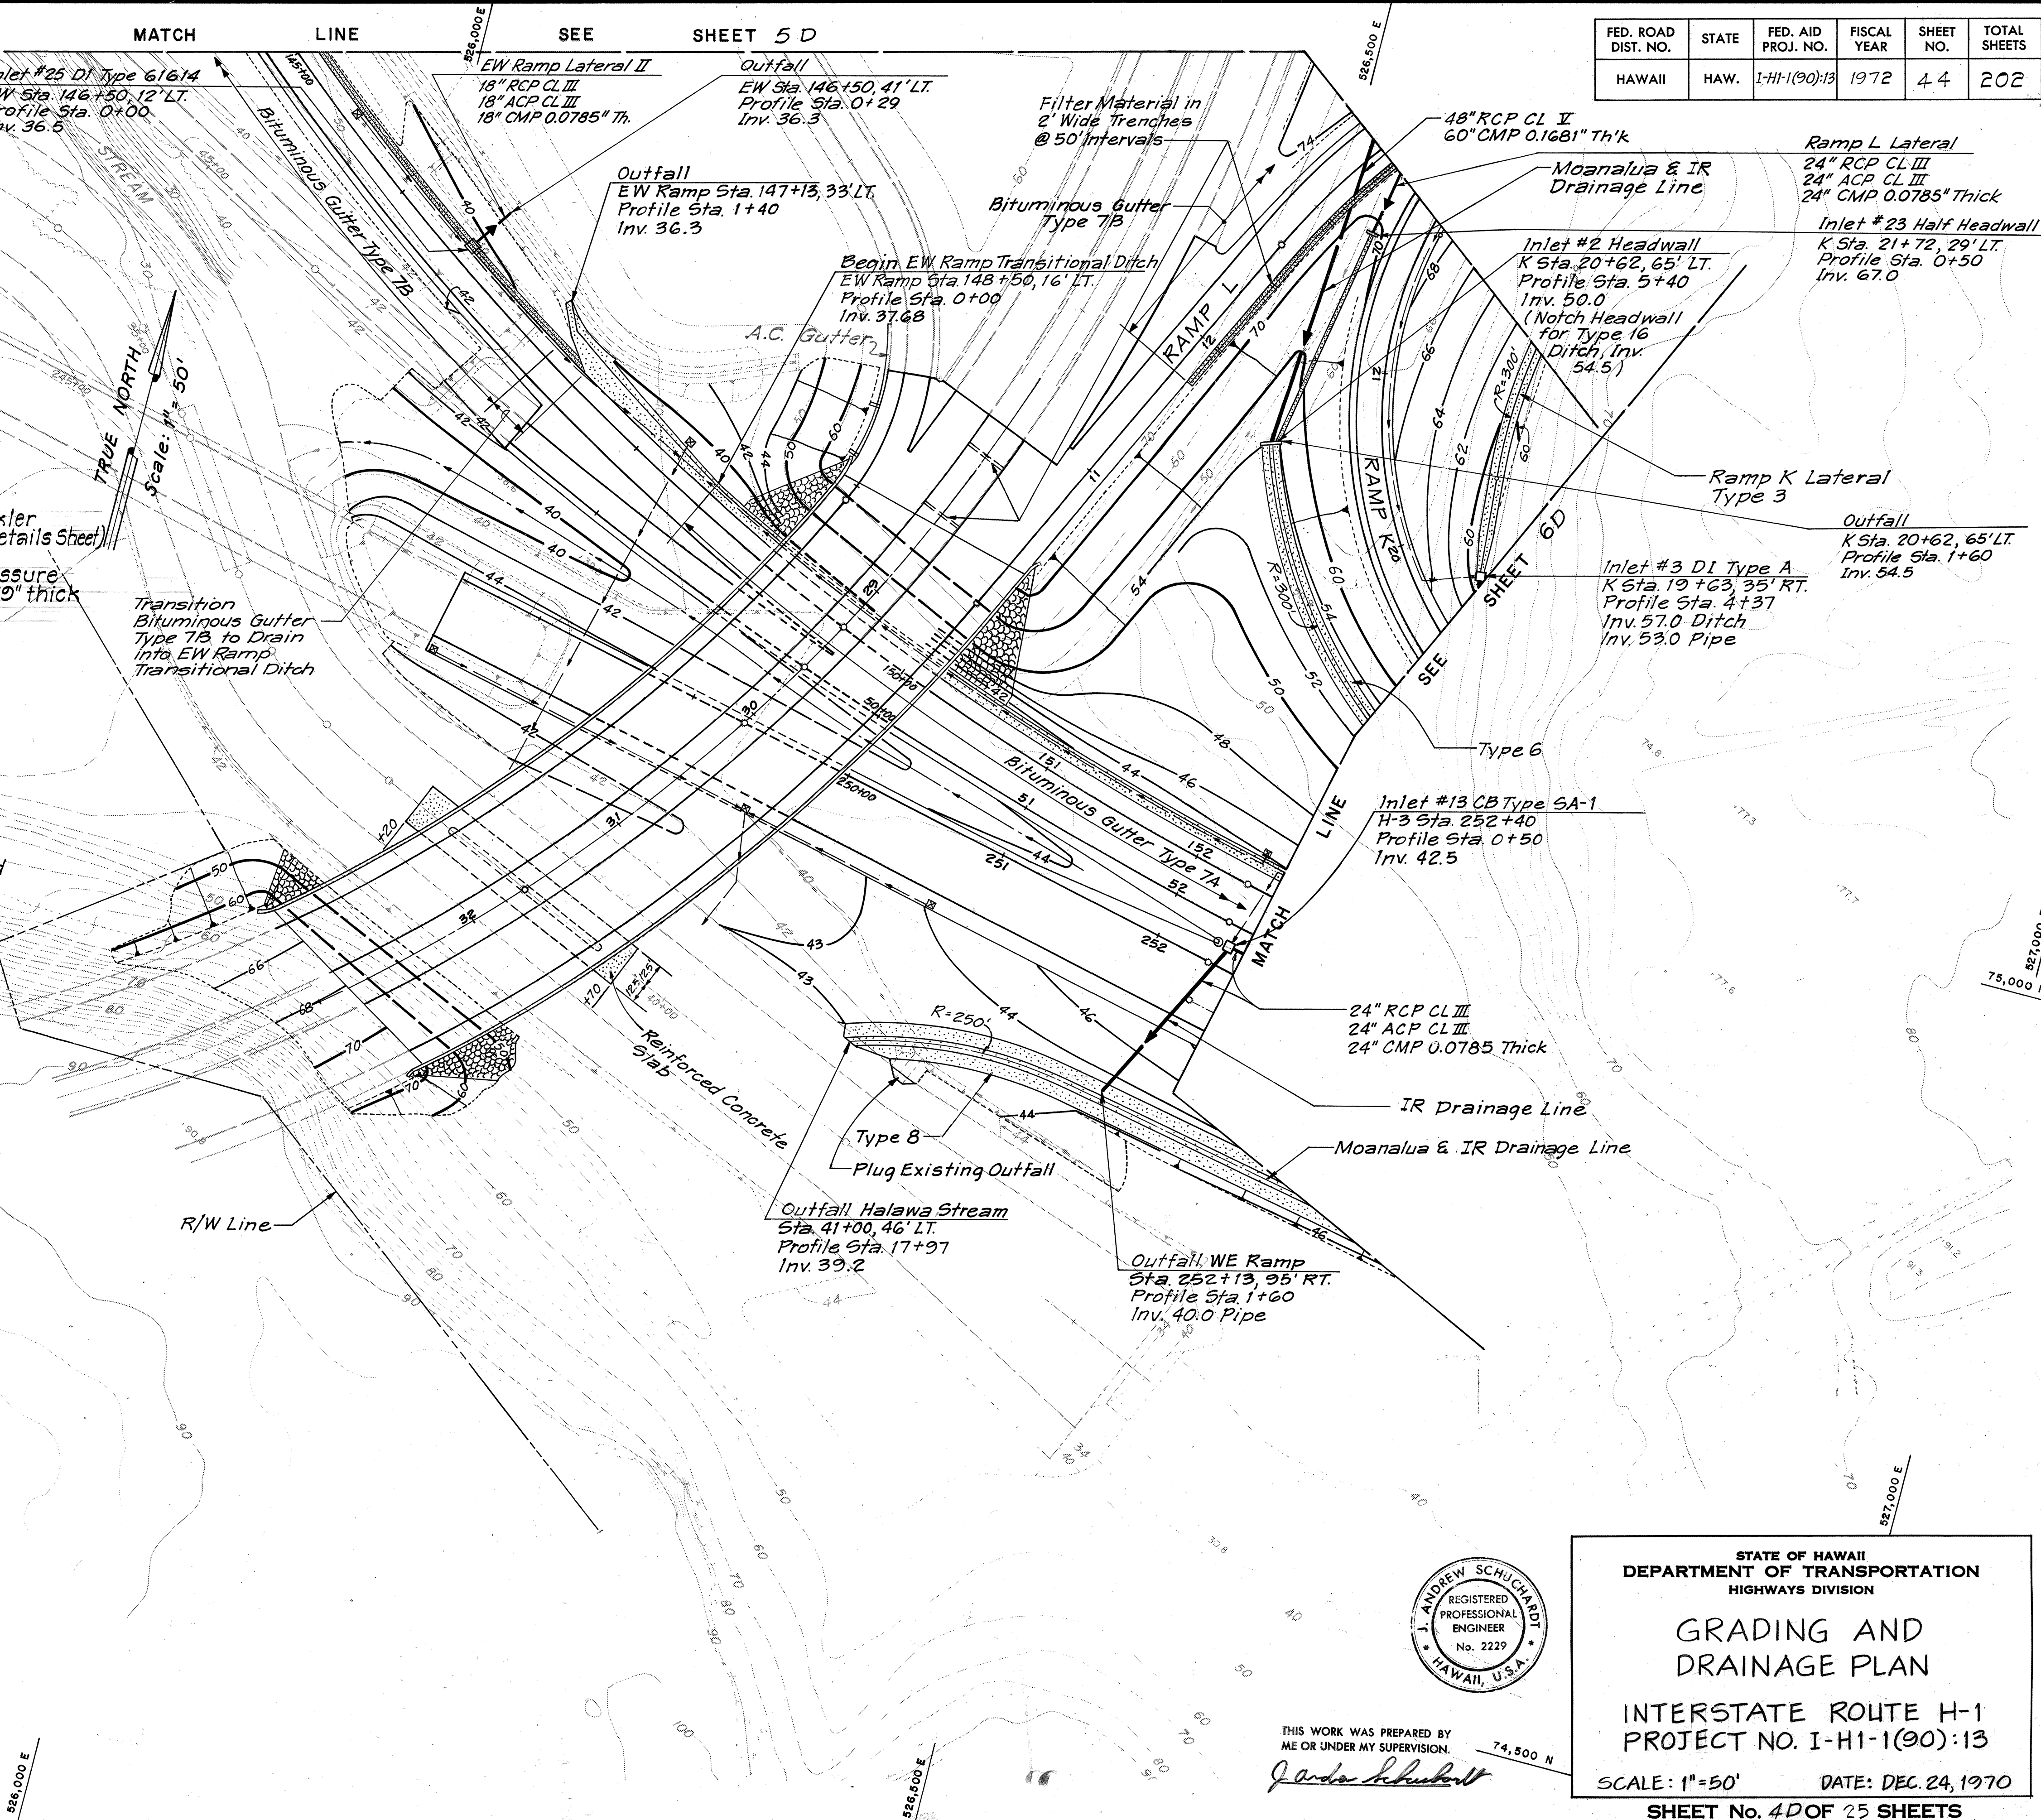


THIS WORK WAS PREPARED BY
ME OR UNDER MY SUPERVISION.
J. Andrew Schuchardt

STATE OF HAWAII
DEPARTMENT OF TRANSPORTATION
HIGHWAYS DIVISION

GRADING AND
DRAINAGE PLAN
INTERSTATE ROUTE H-1
PROJECT NO. I-H1-1(90):13
SCALE: 1"=50' DATE: DEC. 24, 1970
SHEET No. 4D OF 25 SHEETS

FED. ROAD DIST. NO.	STATE	FED. AID PROJ. NO.	FISCAL YEAR	SHEET NO.	TOTAL SHEETS
HAWAII	HAW.	I-HI-(90):13	1972	45	202

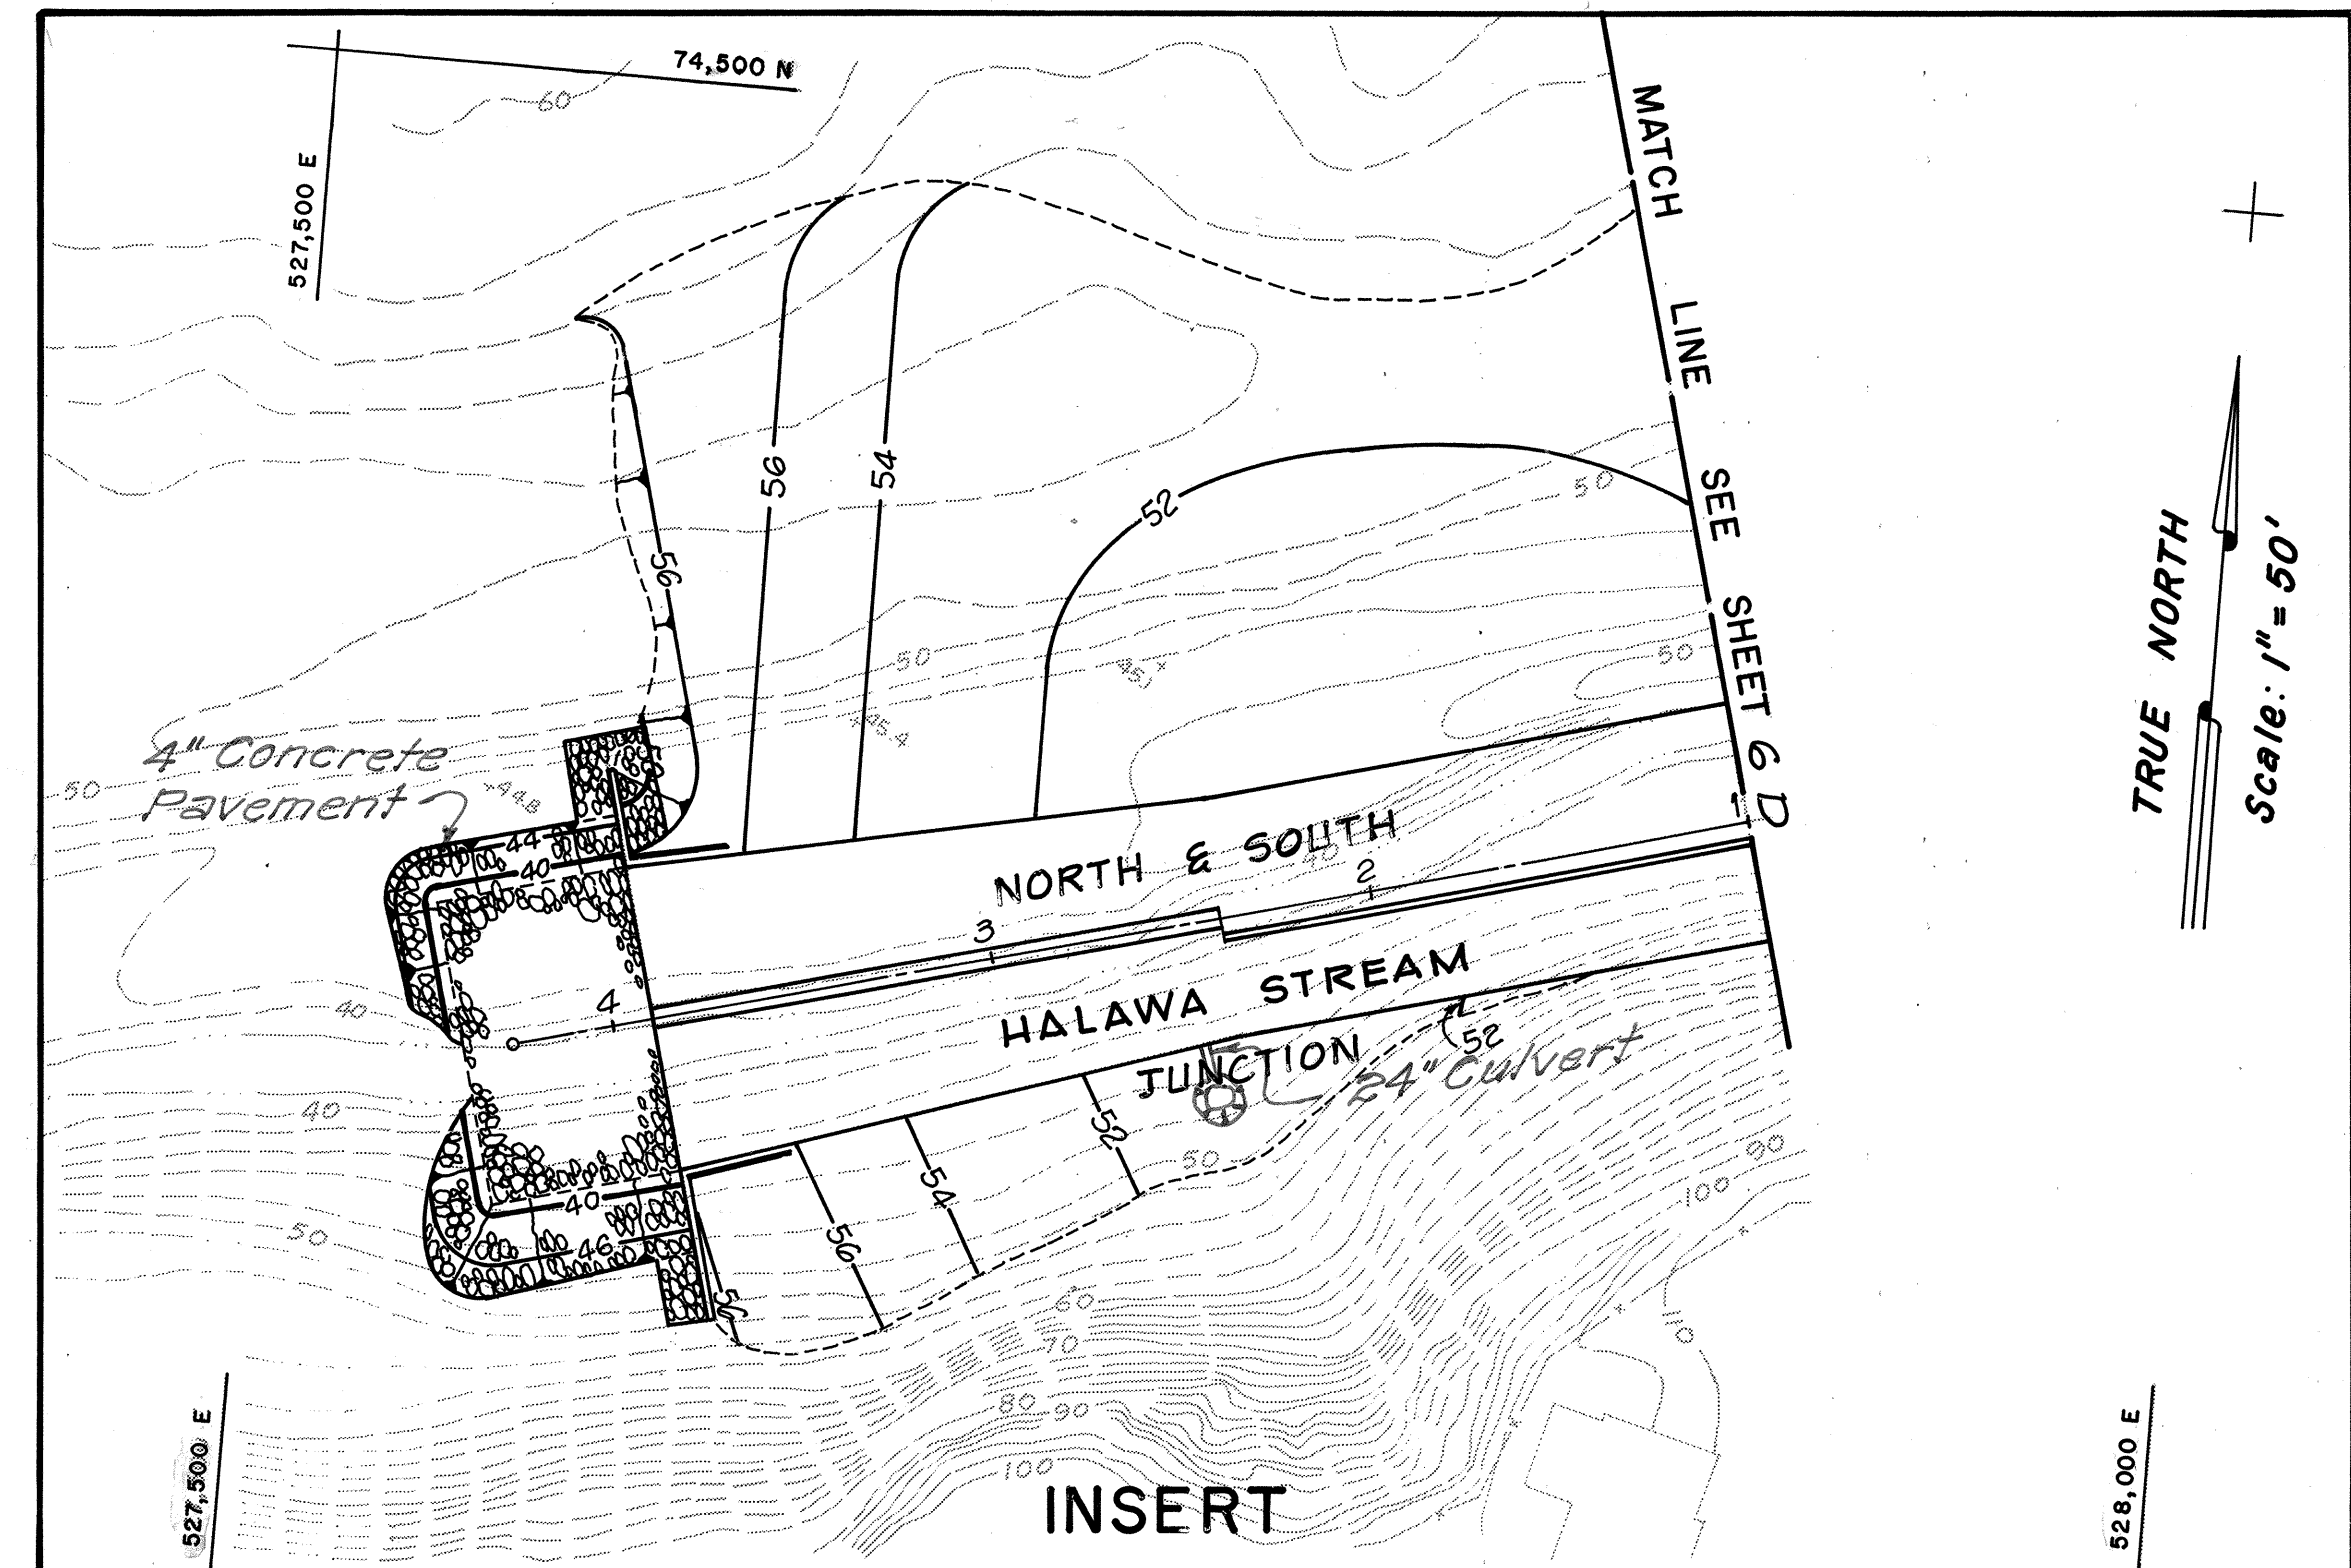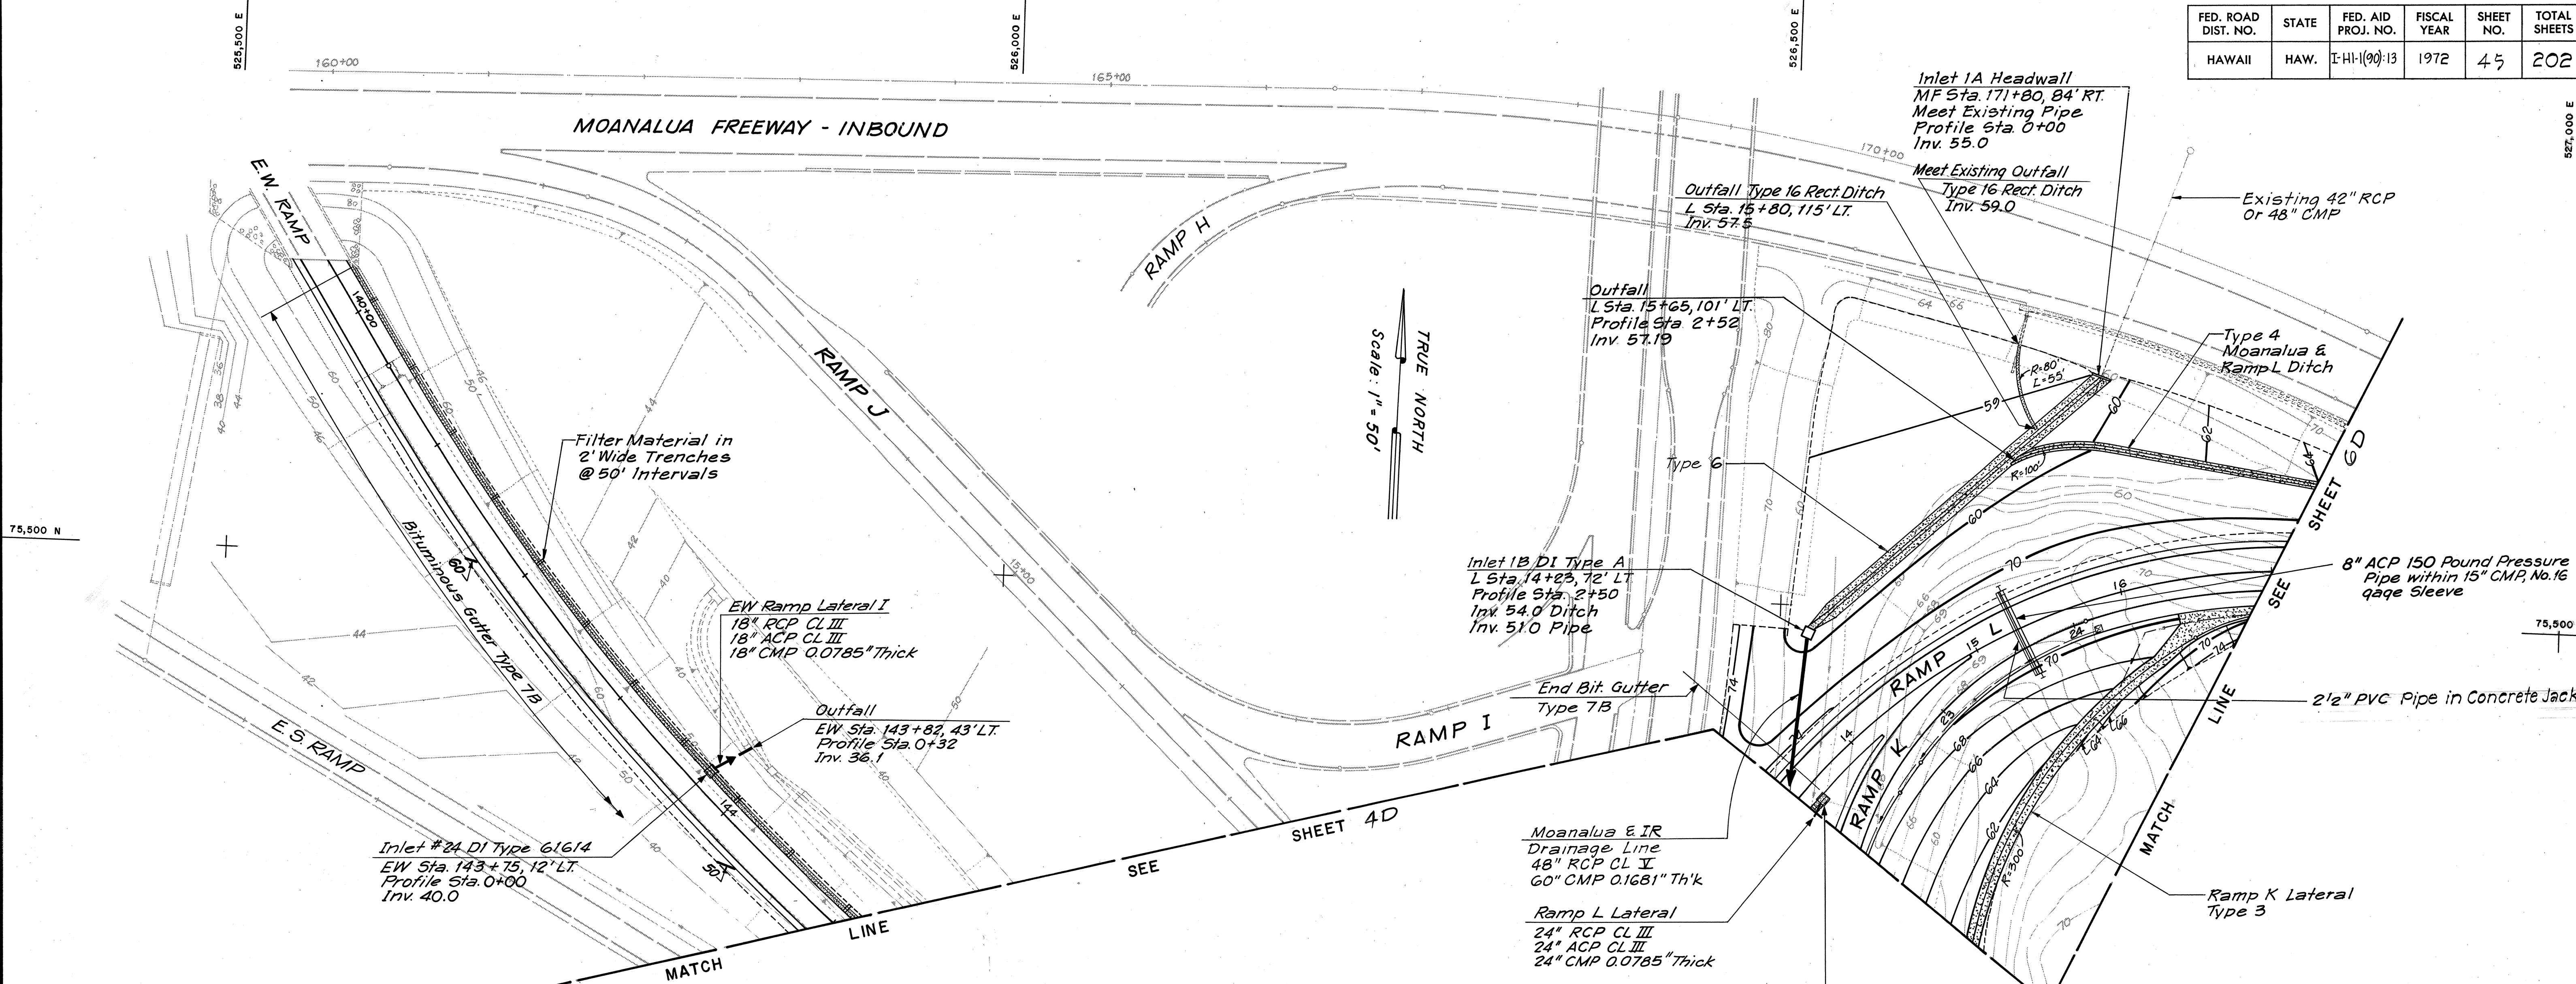

SURVEY PLOTTED BY	DATE
DRAWN BY	
CHECKED BY	
NOTED BY	
QUANTITIES BY	
CHECKED BY	



THIS WORK WAS PREPARED BY
ME OR UNDER MY SUPERVISION.
J. Andrew Schuchardt

STATE OF HAWAII
DEPARTMENT OF TRANSPORTATION
HIGHWAYS DIVISION


GRADING AND DRAINAGE PLANS

INTERSTATE ROUTE H-1
PROJECT NO. I-HI-(90):13

SCALE: 1" = 50' DATE: DEC. 24, 1970


SHEET No. 5 D OF 25 SHEETS

FED. ROAD DIST. NO.	STATE	FED. AID PROJ. NO.	FISCAL YEAR	SHEET NO.	TOTAL SHEETS
HAWAII	HAW.	I-HI-1(90):13	1972	46	202

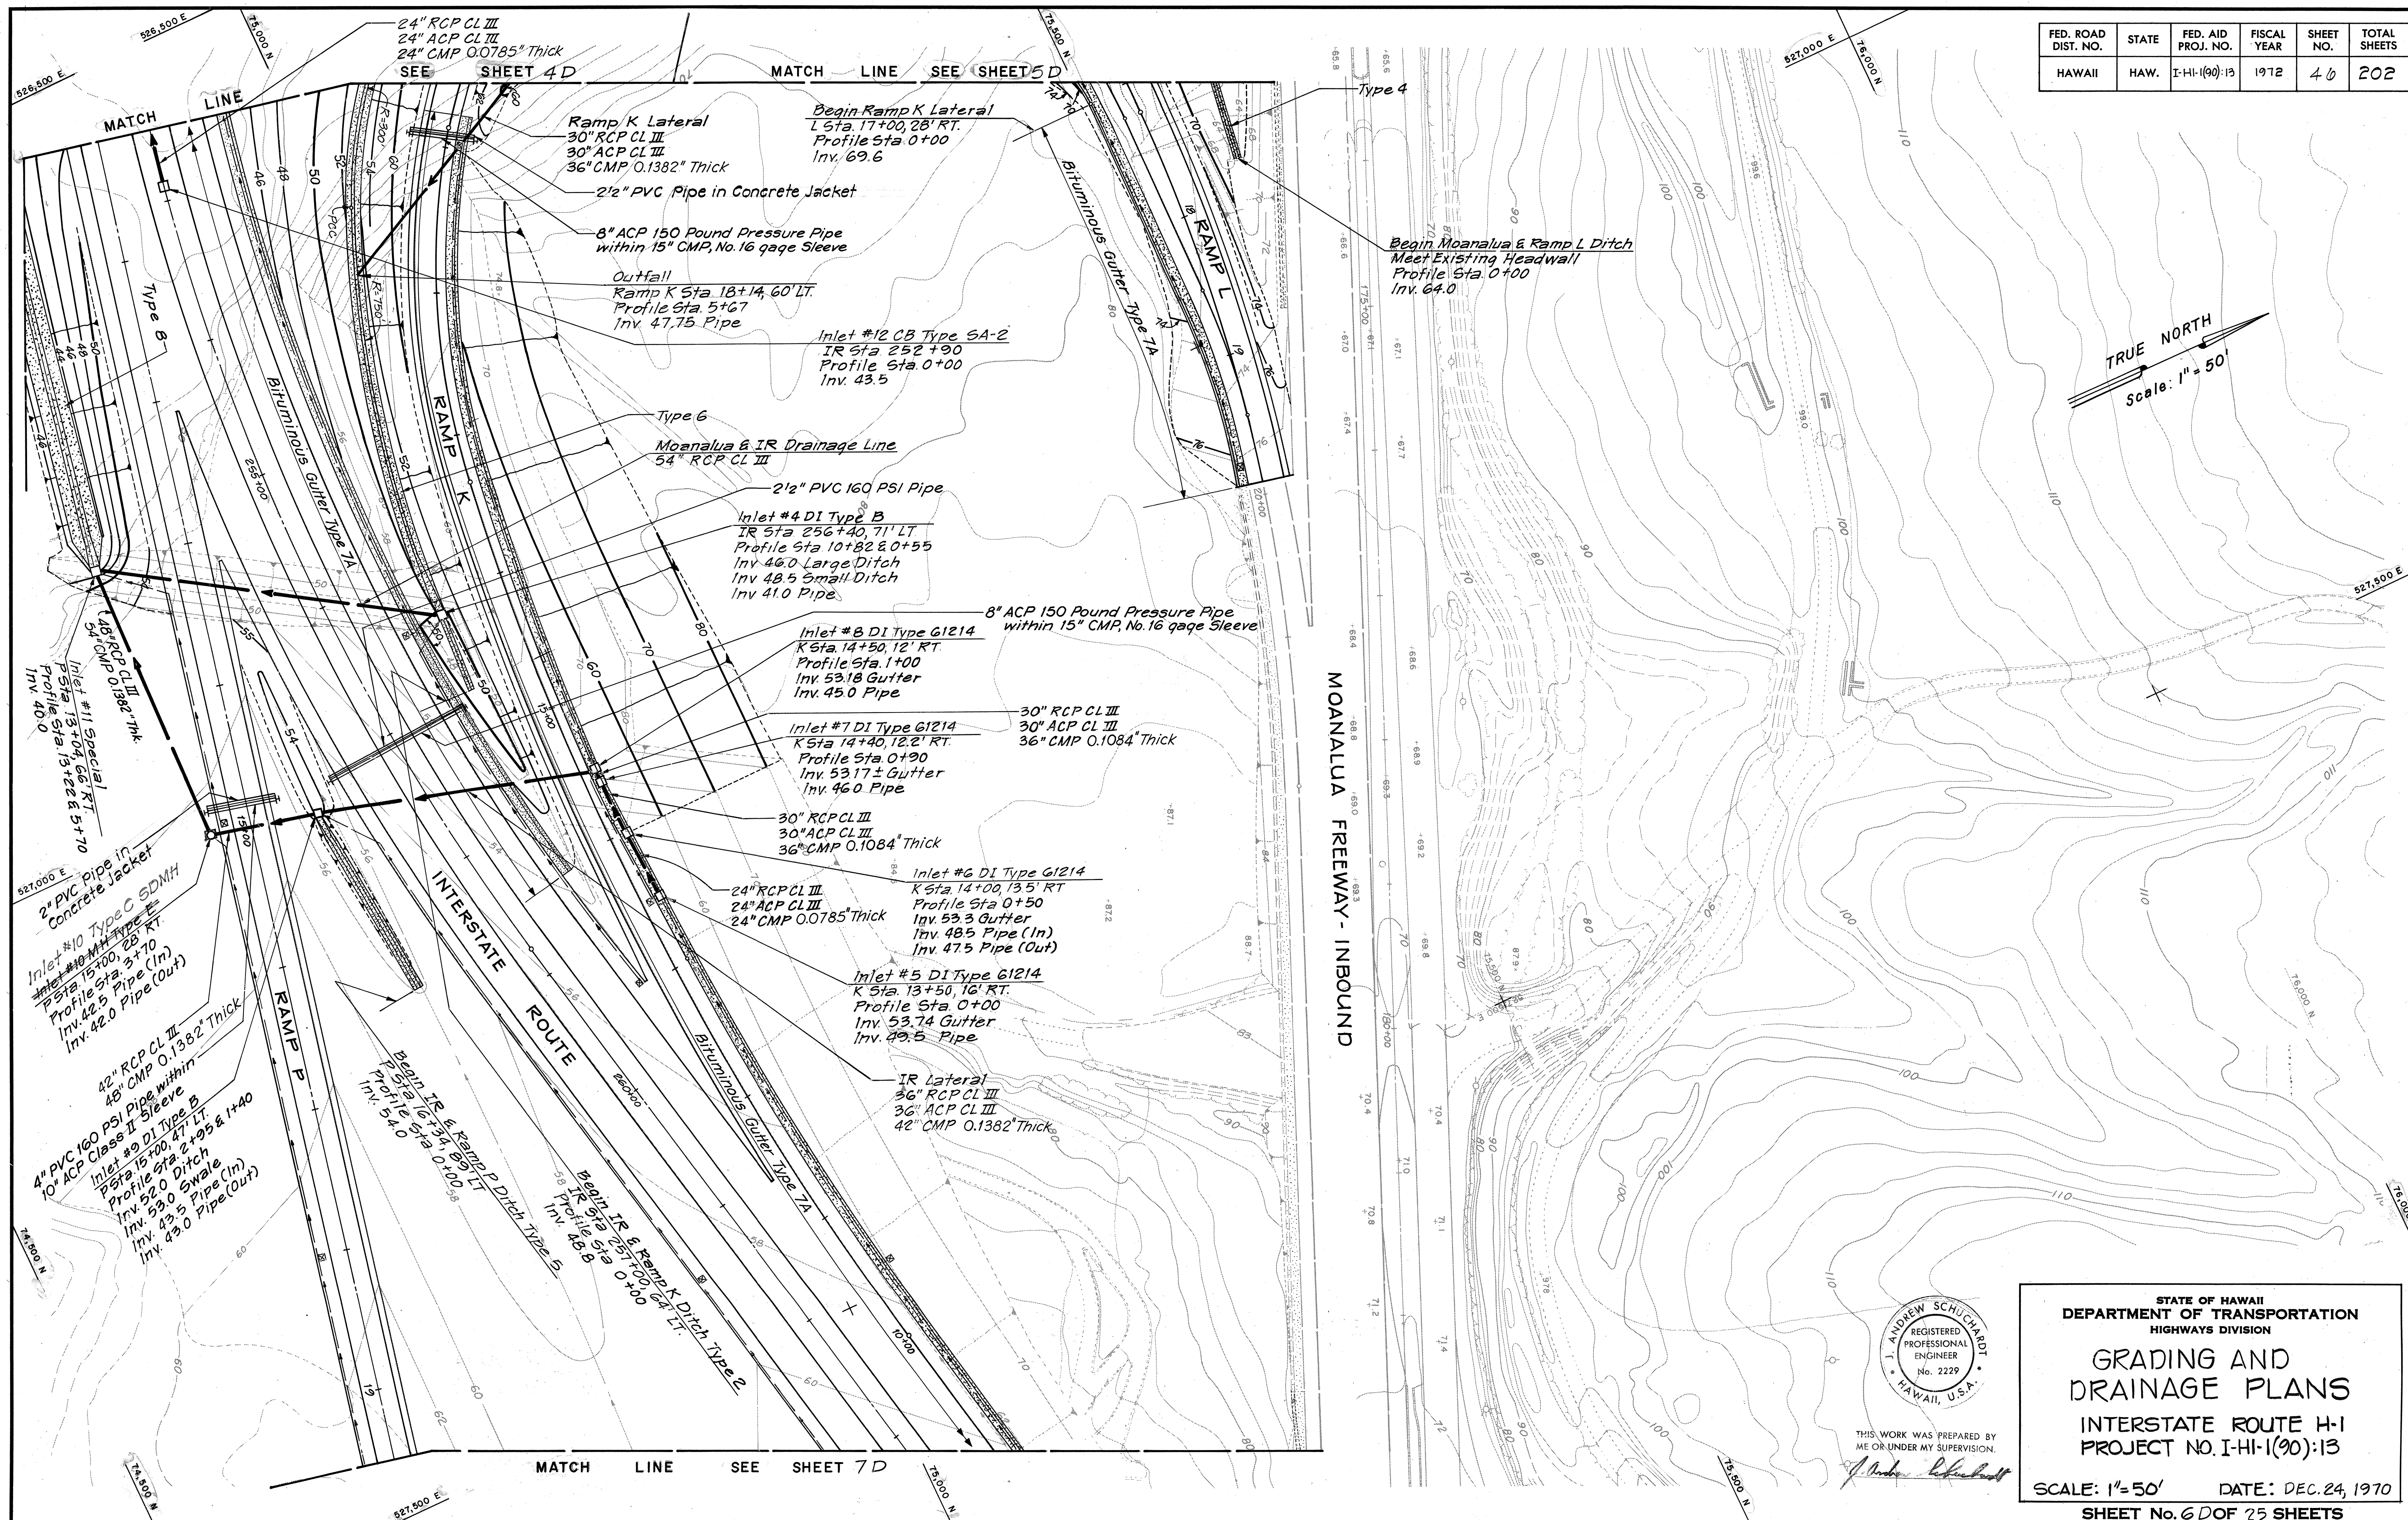


41 (

FED. ROAD DIST. NO.	STATE	FED. AID PROJ. NO.	FISCAL YEAR	SHEET NO.	TOTAL SHEETS
HAWAII	HAW.	I-H1-1(90):13	1972	48	202

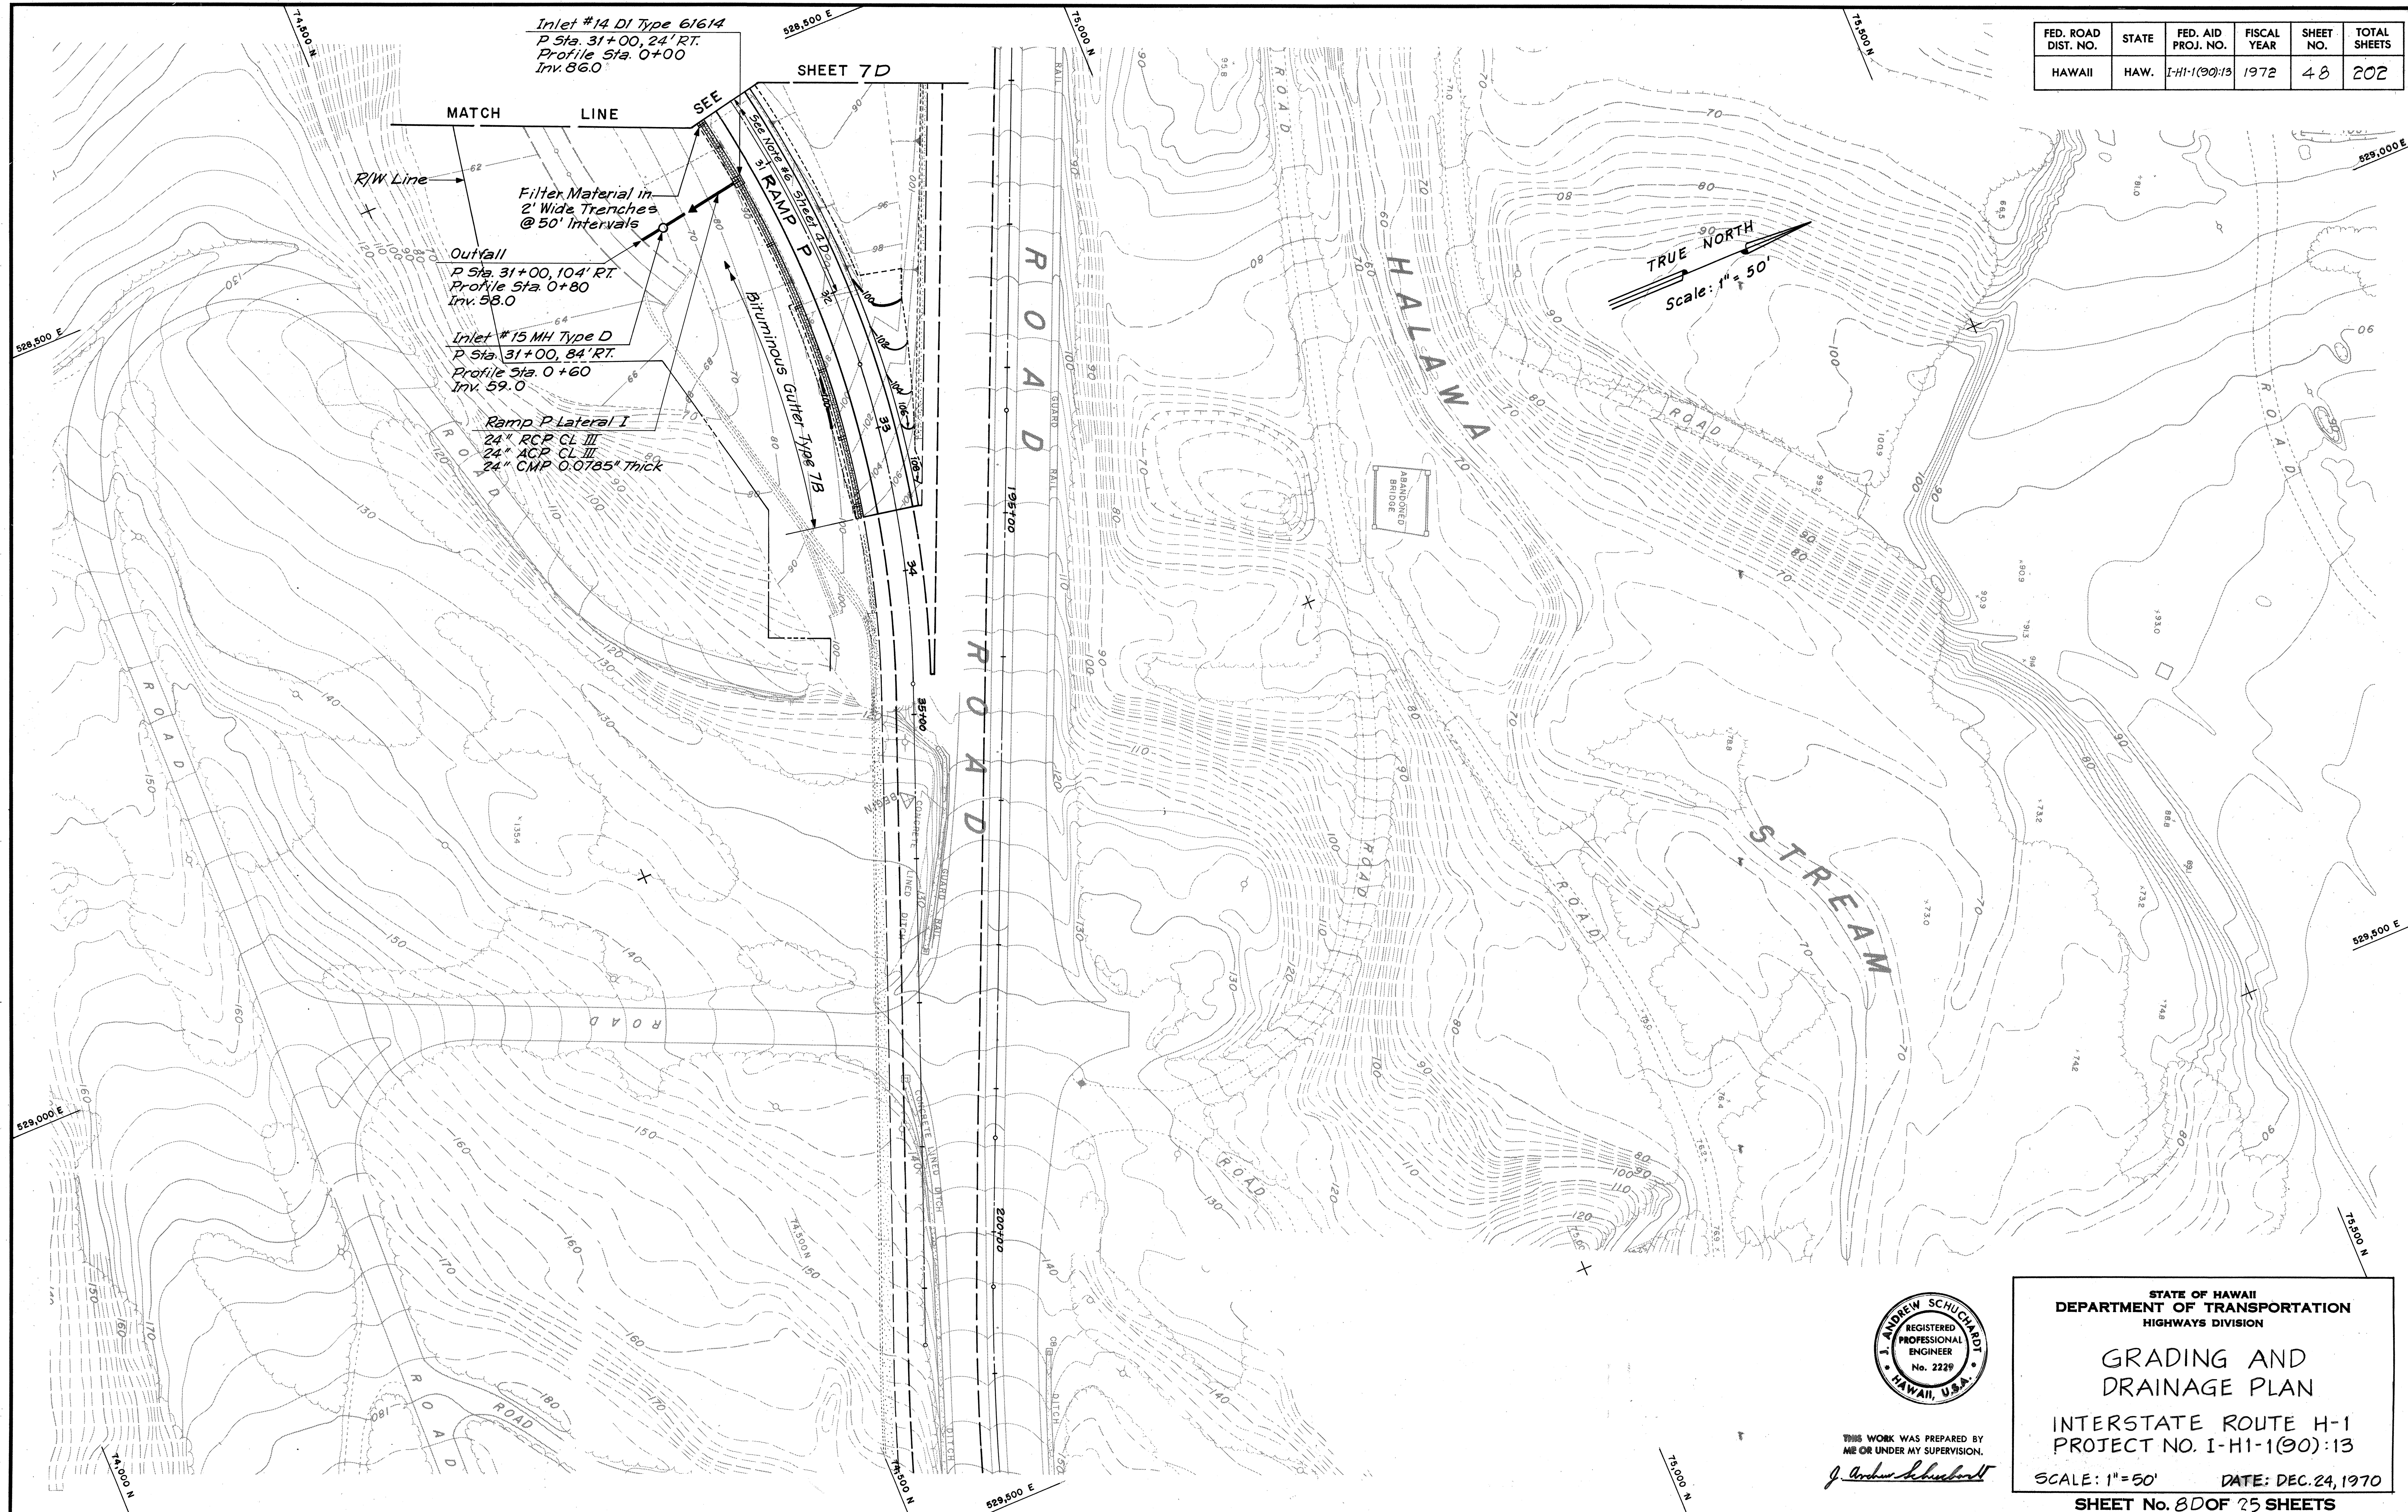

ORIGINAL PLAN	DATE
SURVEY PLOTTED BY	
DRAWN BY	
DESIGNED BY	
NOTE BOOK	
QUANTITIES BY	
CHECKED BY	

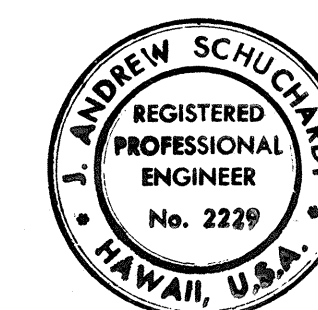

THIS WORK WAS PREPARED BY
ME OR UNDER MY SUPERVISION.
J. Andrew Schuchardt

STATE OF HAWAII
DEPARTMENT OF TRANSPORTATION
HIGHWAYS DIVISION


GRADING AND
DRAINAGE PLAN

INTERSTATE ROUTE H-1
PROJECT NO. I-H1-1(90):13


SCALE: 1"=50' DATE: DEC. 24, 1970

SHEET No. 8 OF 25 SHEETS


FED. ROAD DIST. NO.	STATE	FED. AID PROJ. NO.	FISCAL YEAR	SHEET NO.	TOTAL SHEETS
HAWAII	HAW.	I-HI-1(90)13	1972	48A	202

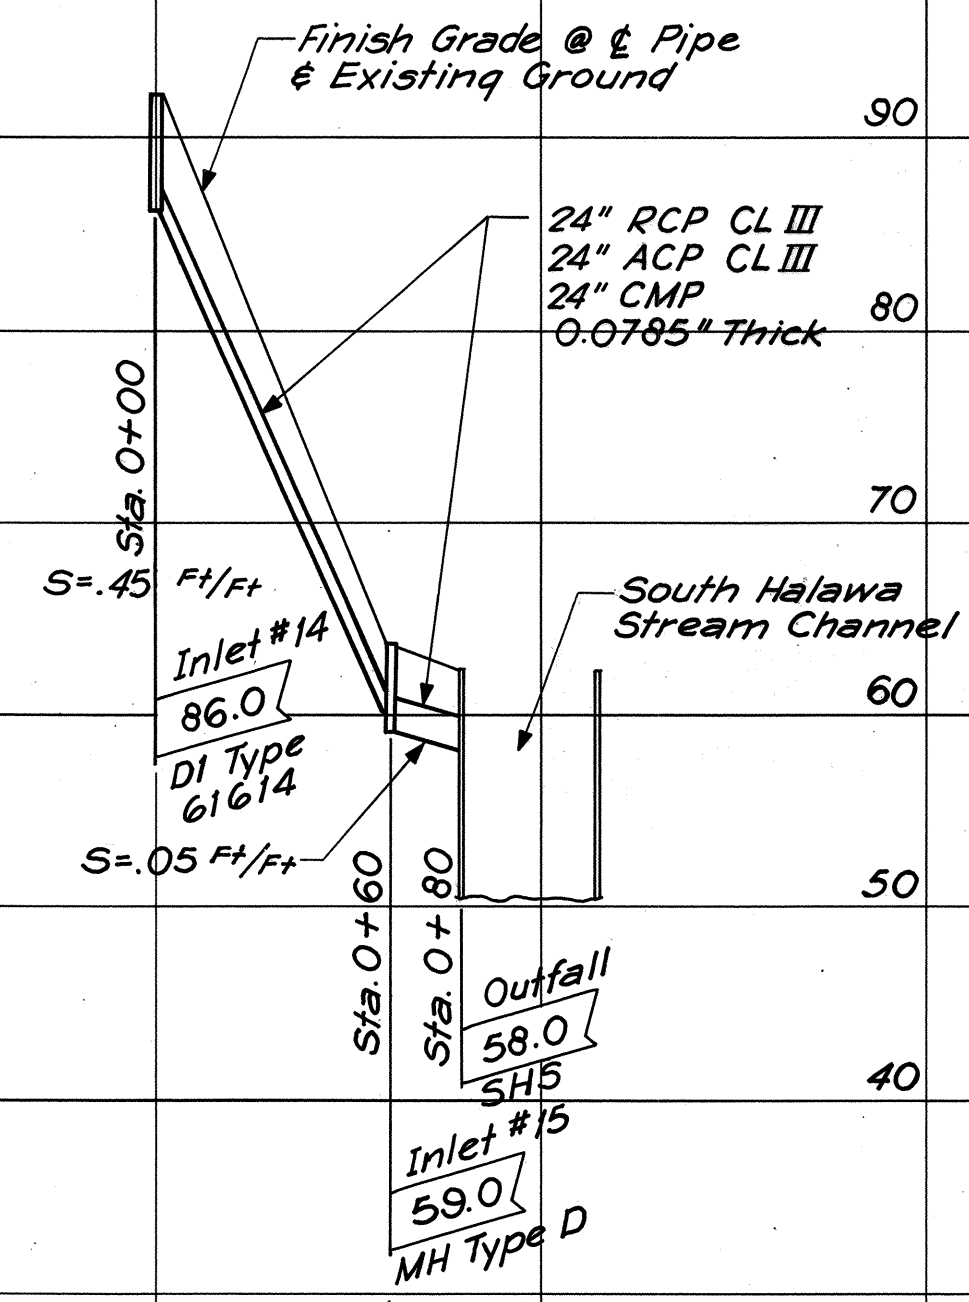


RAMP P LATERAL I

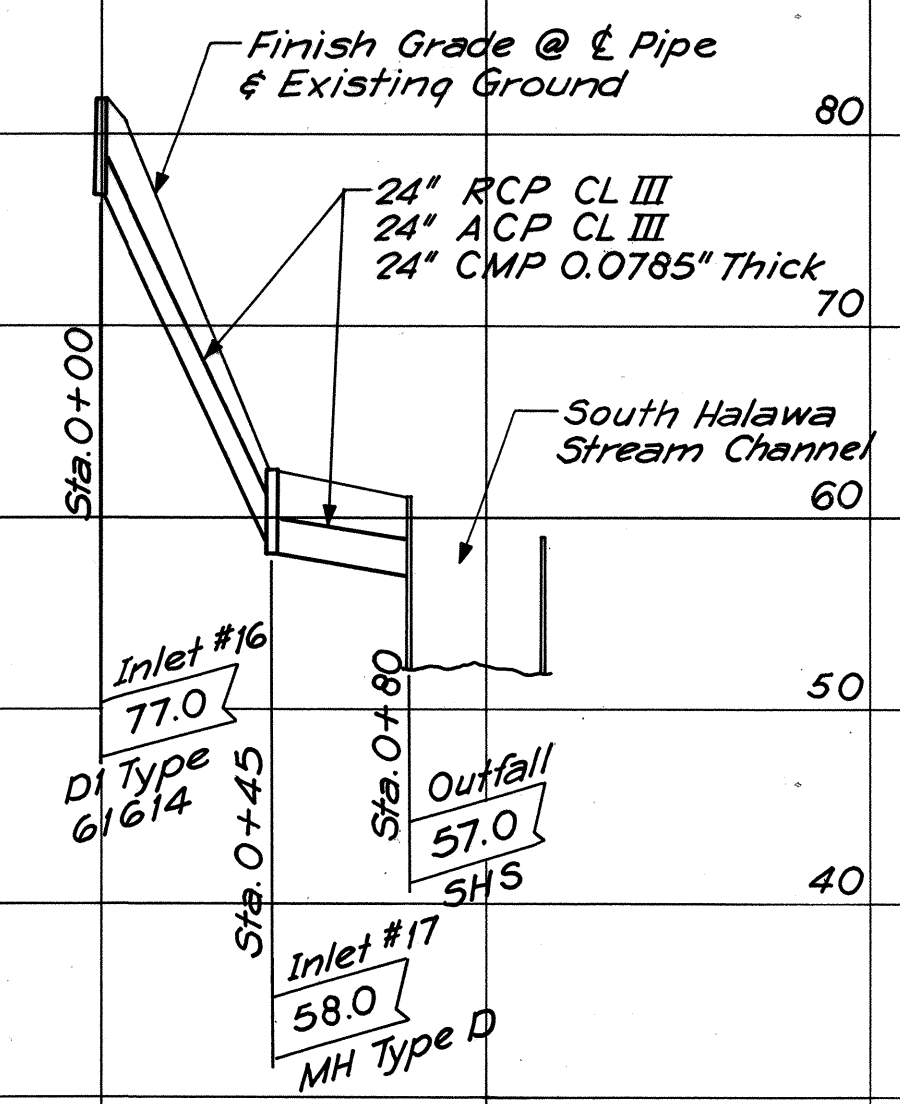


RAMP P LATERAL II

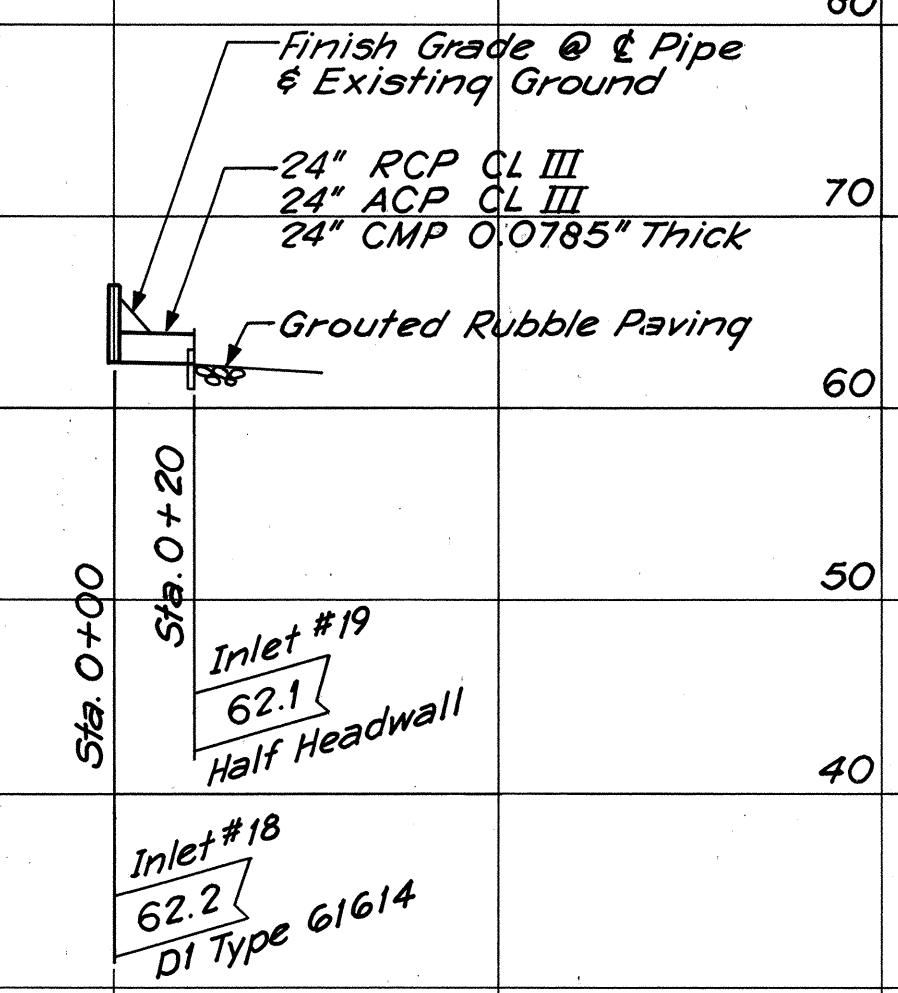


RAMP P LATERAL III

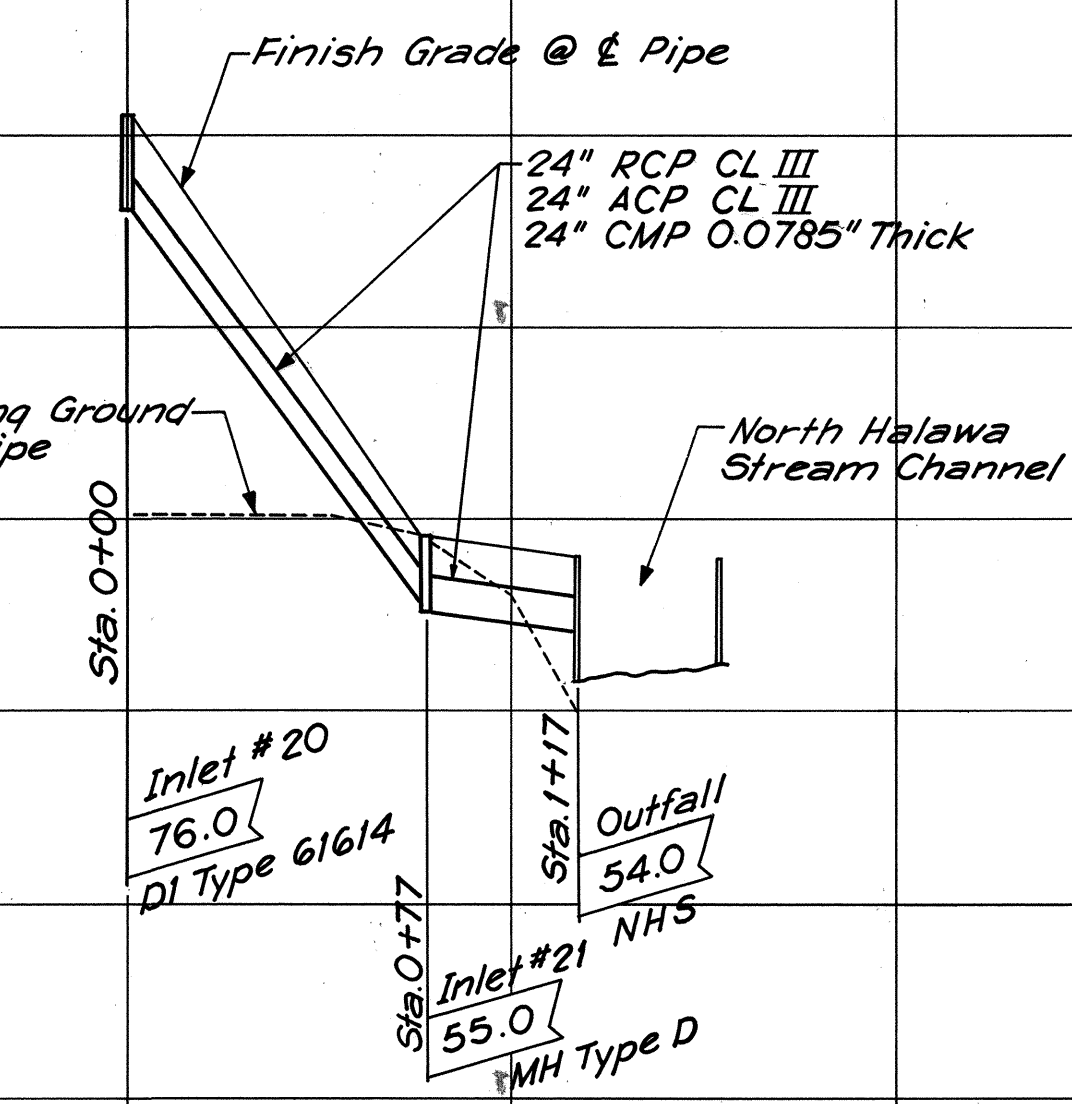


RAMP O LATERAL

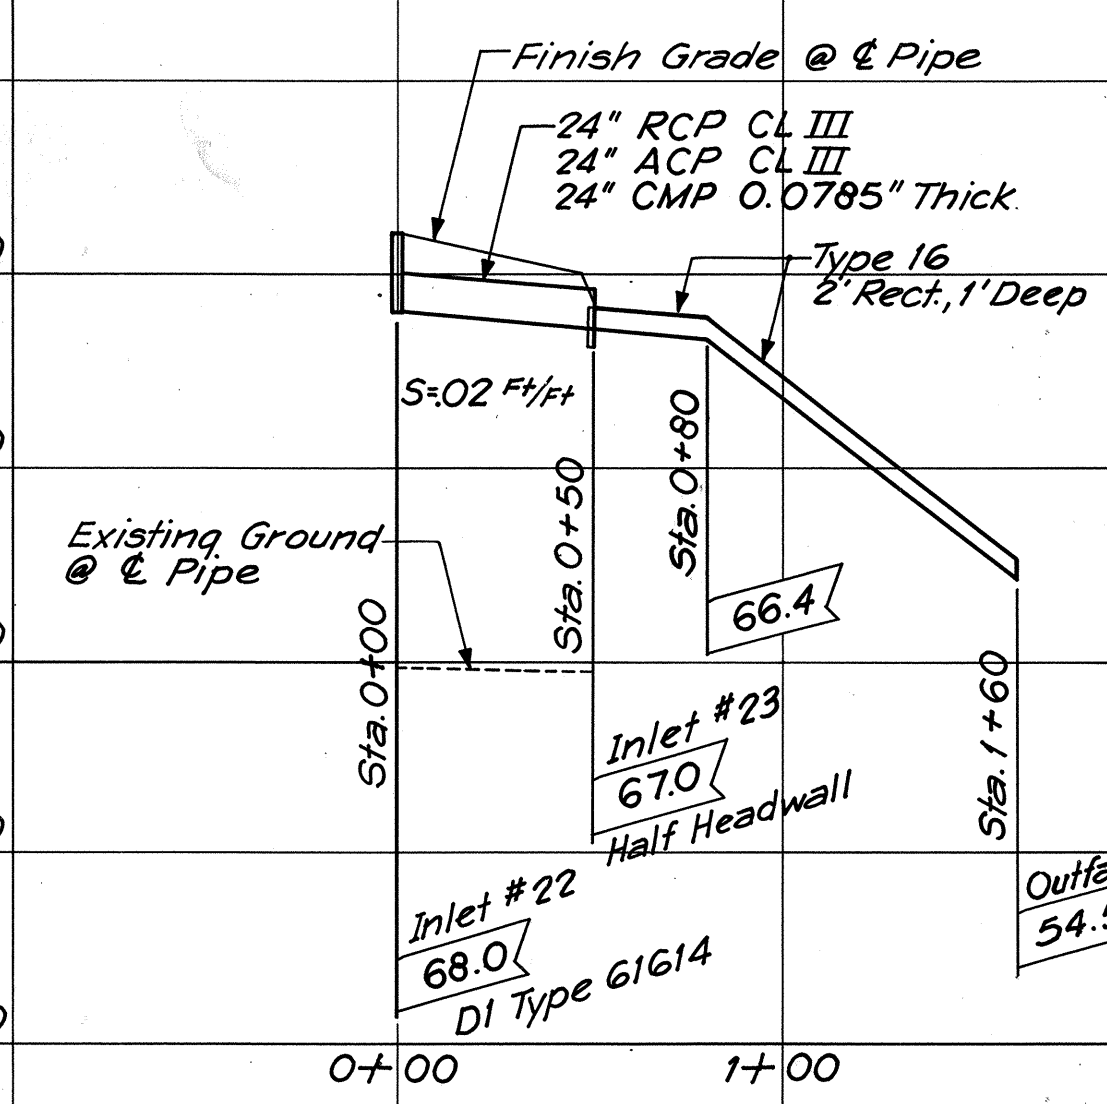


RAMP L LATERAL

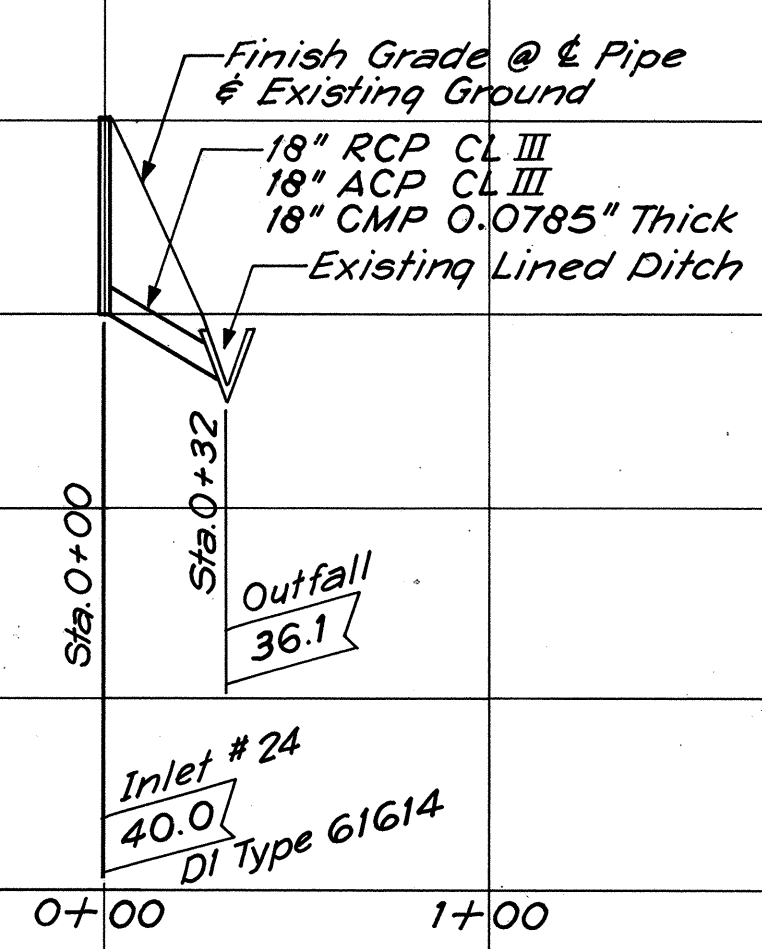

EW RAMP LATERAL I

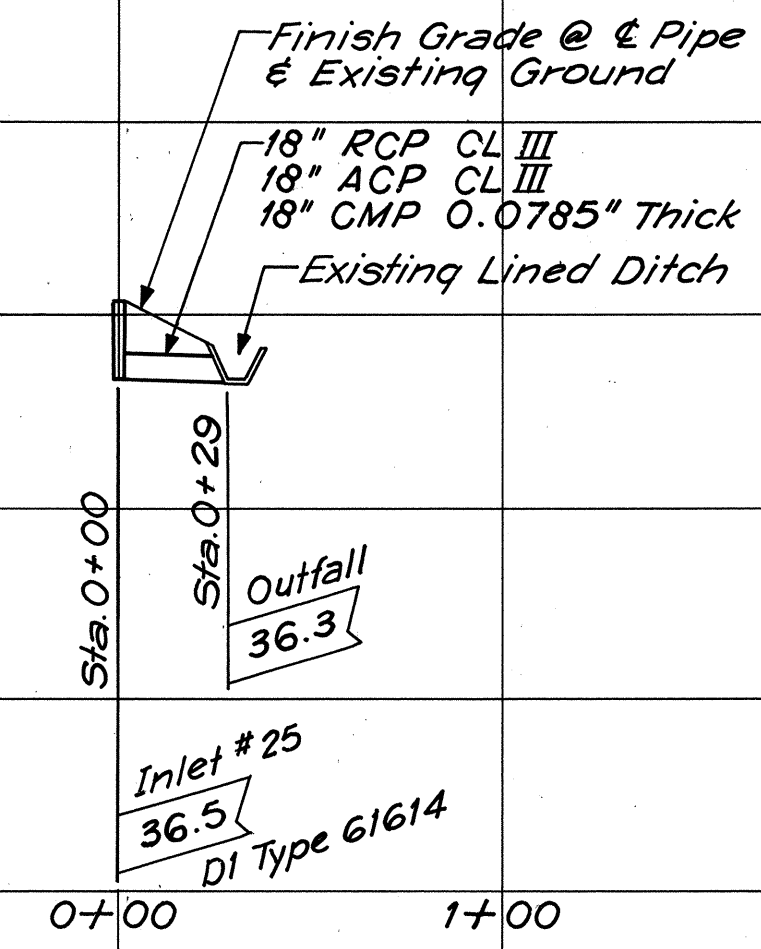

EW RAMP LATERAL II

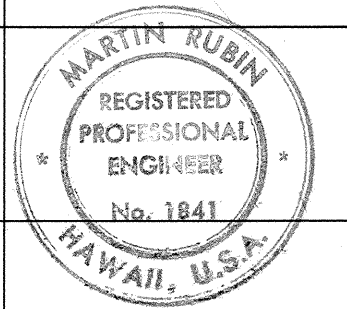

THIS WORK WAS PREPARED BY
ME OR UNDER MY SUPERVISION
Martin Rubin

STATE OF HAWAII
DEPARTMENT OF TRANSPORTATION
HIGHWAYS DIVISION

DRAINAGE PROFILES


INTERSTATE ROUTE H-1
PROJ. NO. I-HI-1(90)13

SCALES: Horiz. 1" = 50'
Vert. 1" = 10' DATE:


SHEET No. 8DAOF 25 SHEETS

DATE	_____
SURVEY PLOTTED BY	_____
DRAWN BY	_____
CHECKED BY	_____
ORIGINAL PLAN	_____
NOTE BOOK	_____
No.	_____

FED. ROAD DIST. NO.	STATE	FED. AID PROJ. NO.	FISCAL YEAR	SHEET NO.	TOTAL SHEETS
HAWAII	HAW.	I-HI-1(90)13	1972	49	202

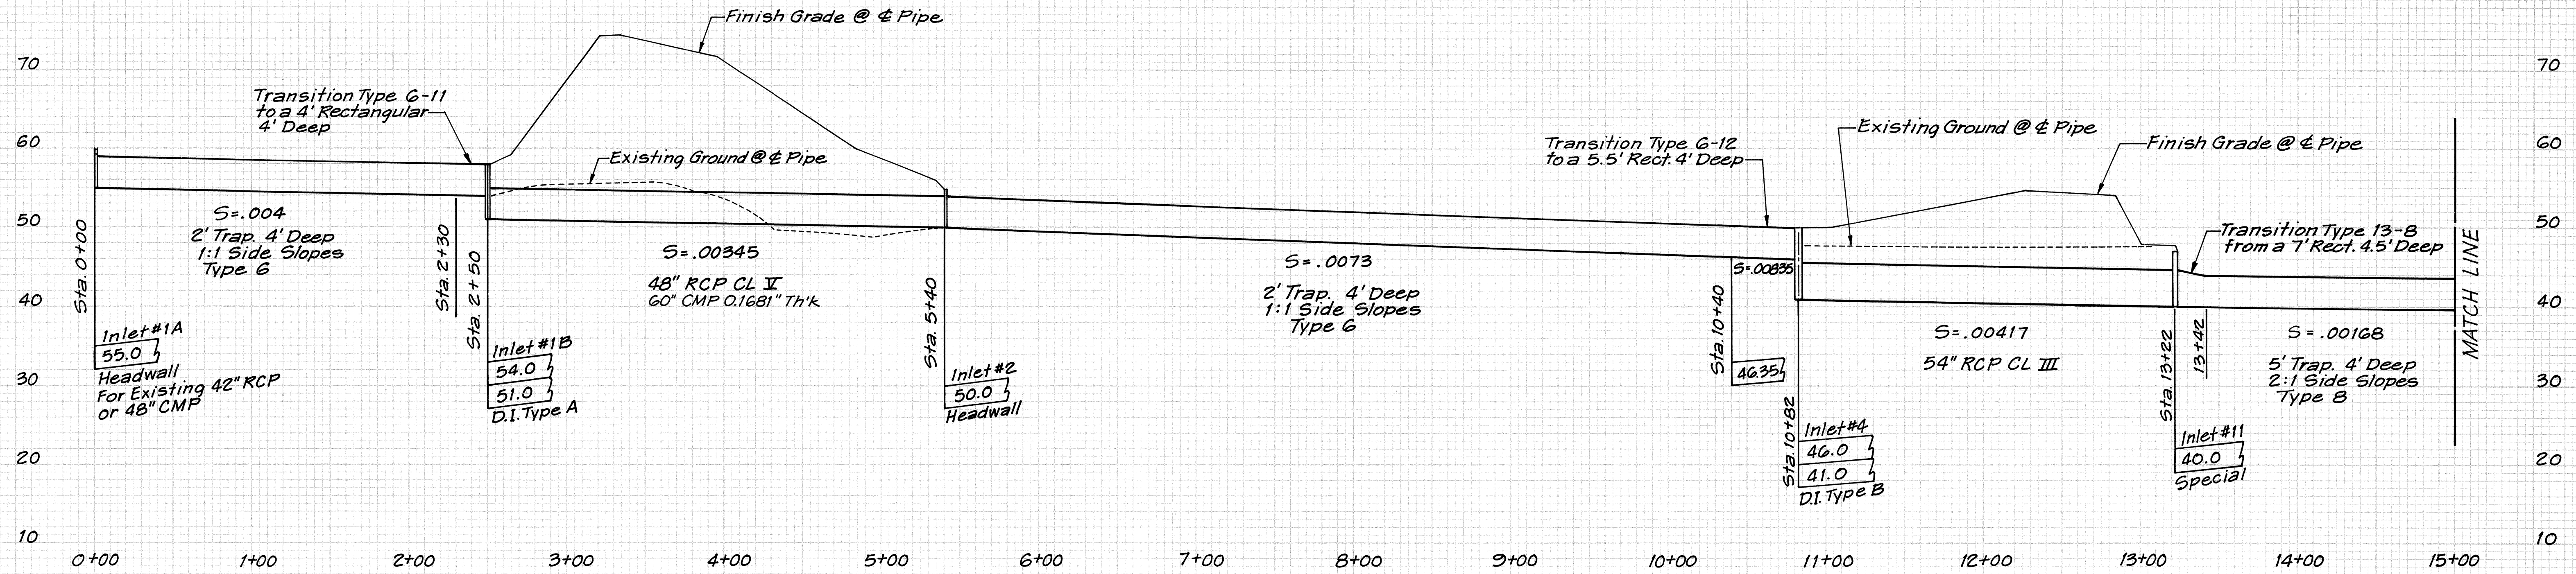

MOANALUA & IR DRAINAGE LINE

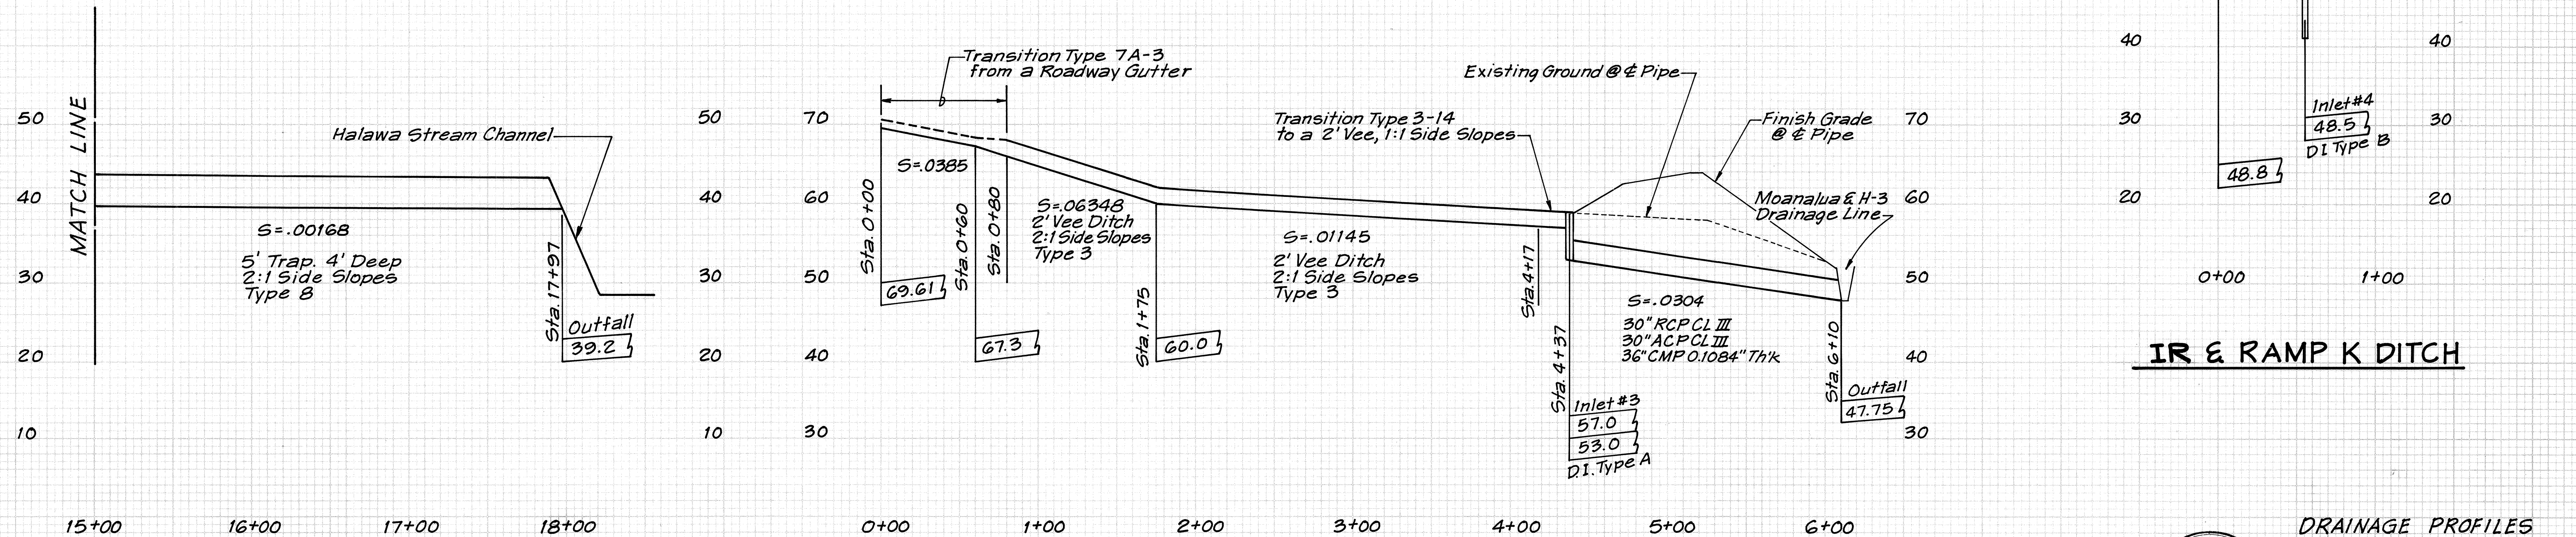


MOANALUA & IR DRAINAGE LINE

RAMP K LATERAL

IR & RAMP K DITCH


DRAINAGE PROFILES

Scales: Horiz. 1" = 50'
Vert. 1" = 10'
Slope in $\frac{F}{T}$

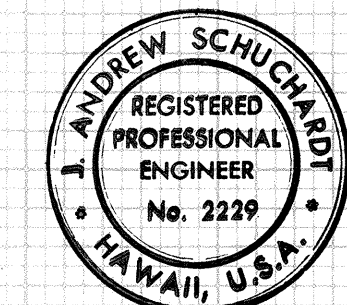


THIS WORK WAS PREPARED BY
ME OR UNDER MY SUPERVISION


FED. ROAD DIST. NO.	STATE	FED. AID PROJ. NO.	FISCAL YEAR	SHEET NO.	TOTAL SHEETS
HAWAII	HAW.	1-H1-1(20)-13	1972	50	202

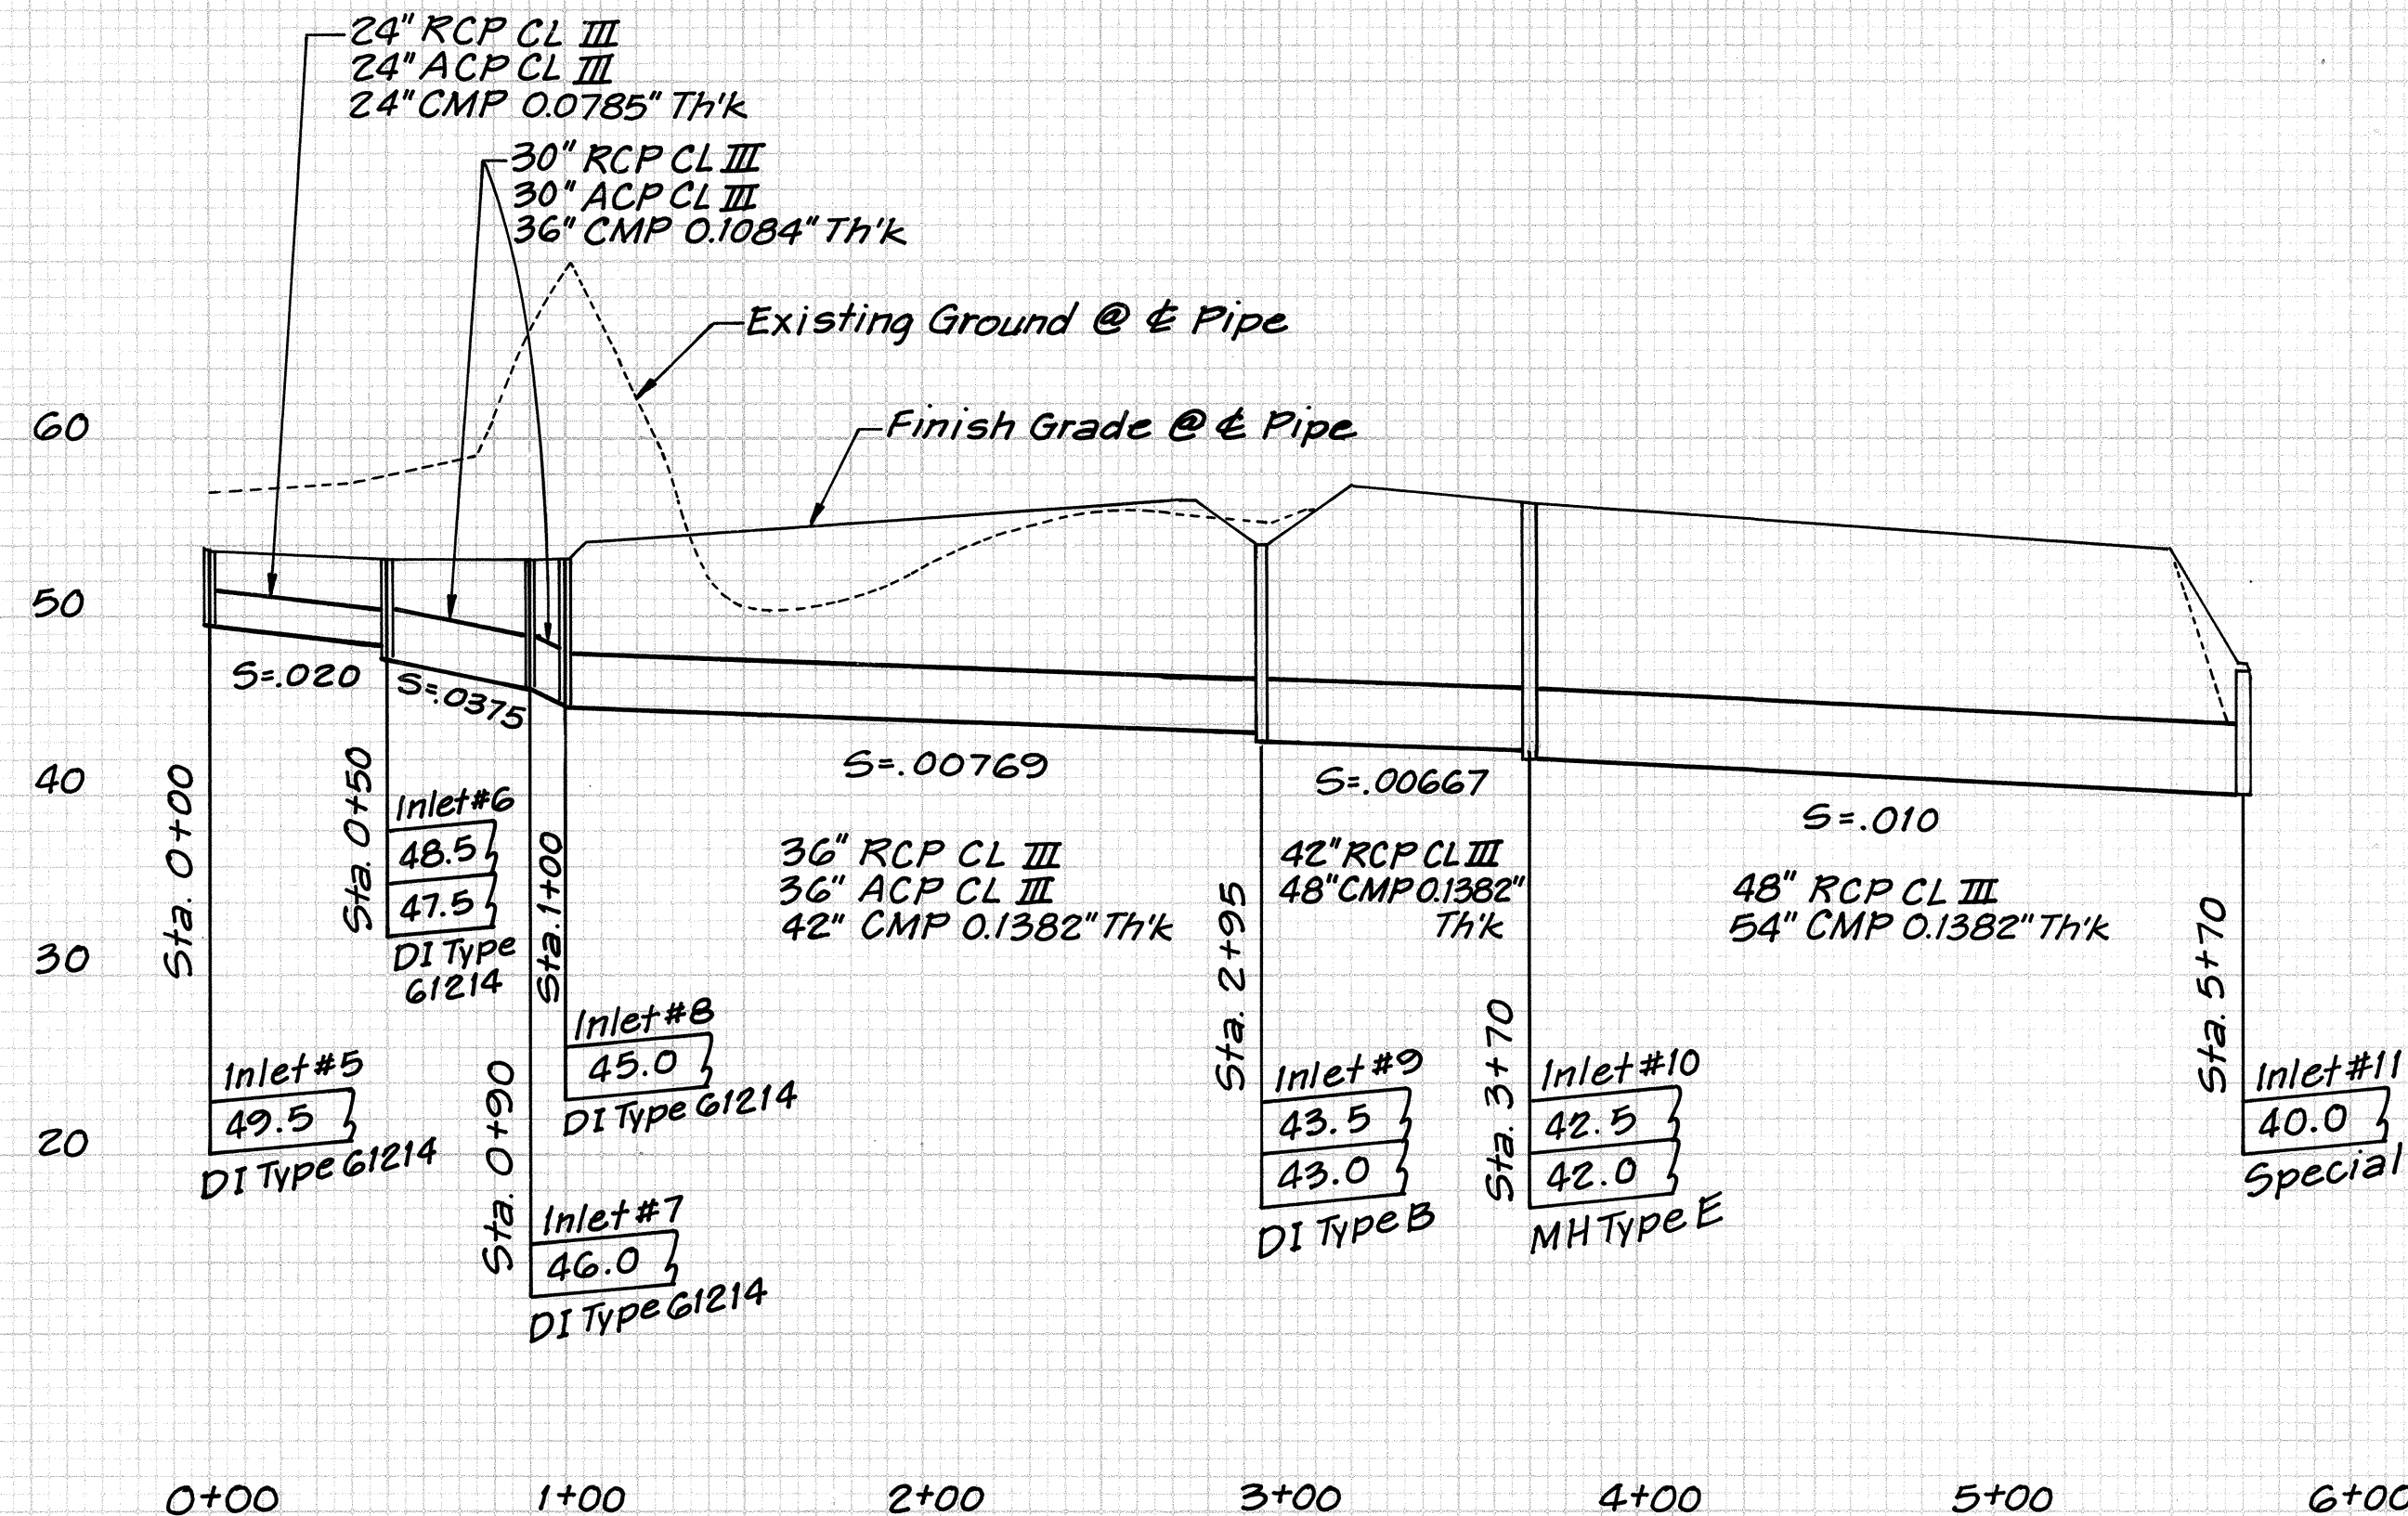


IR LATERAL

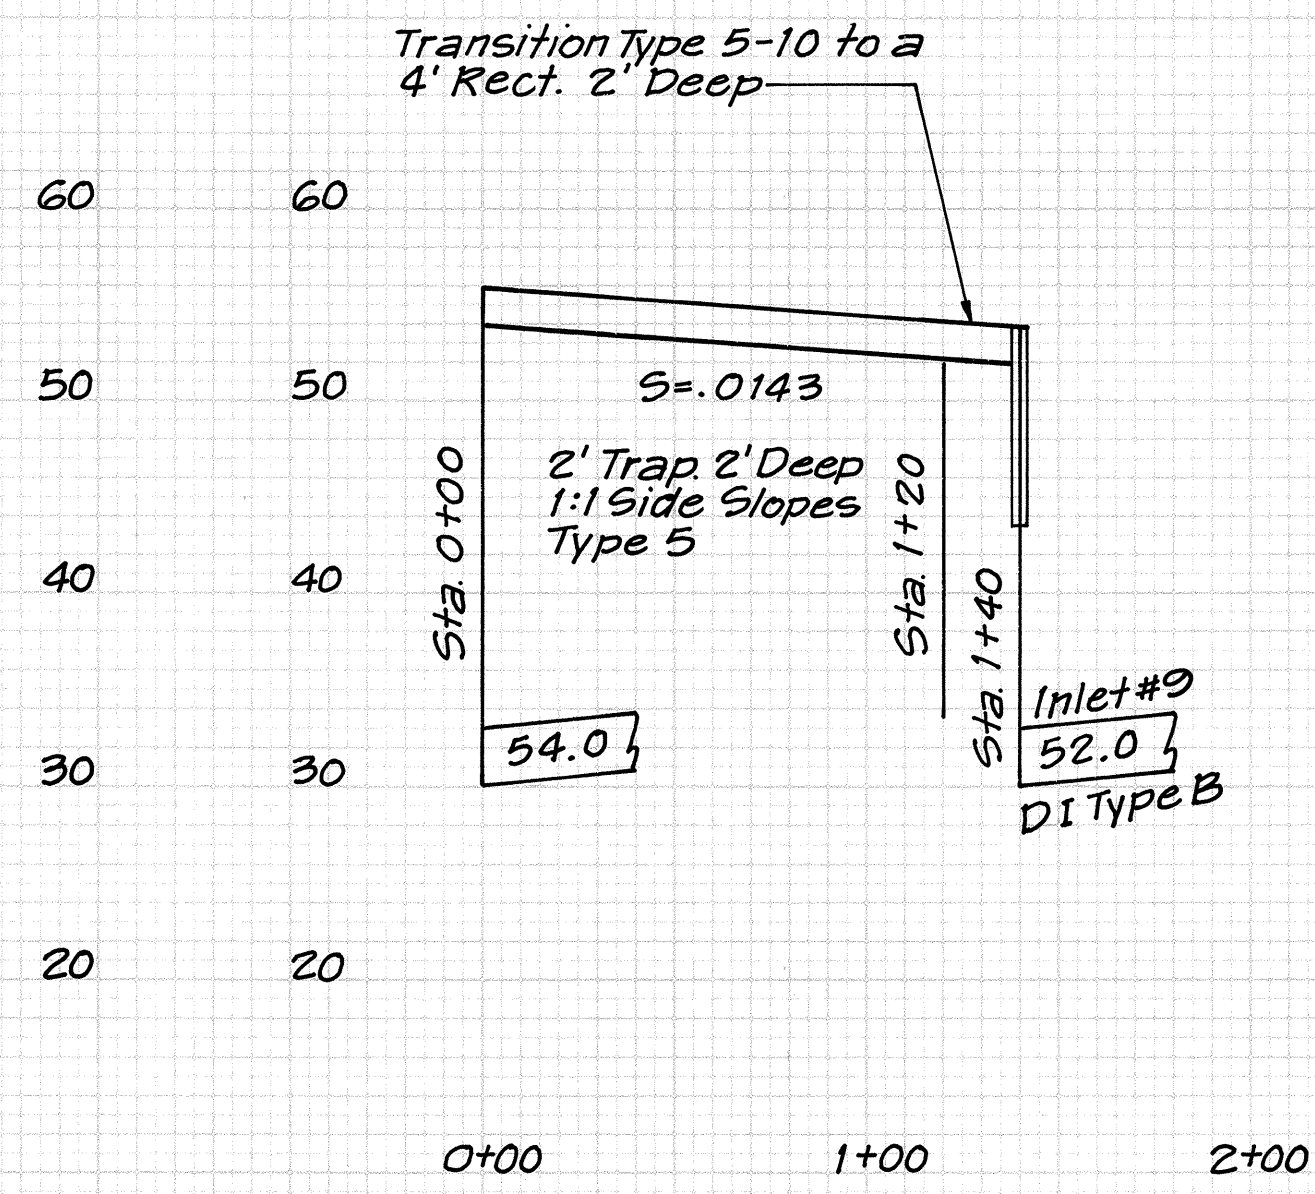


IR & RAMP P DITCH

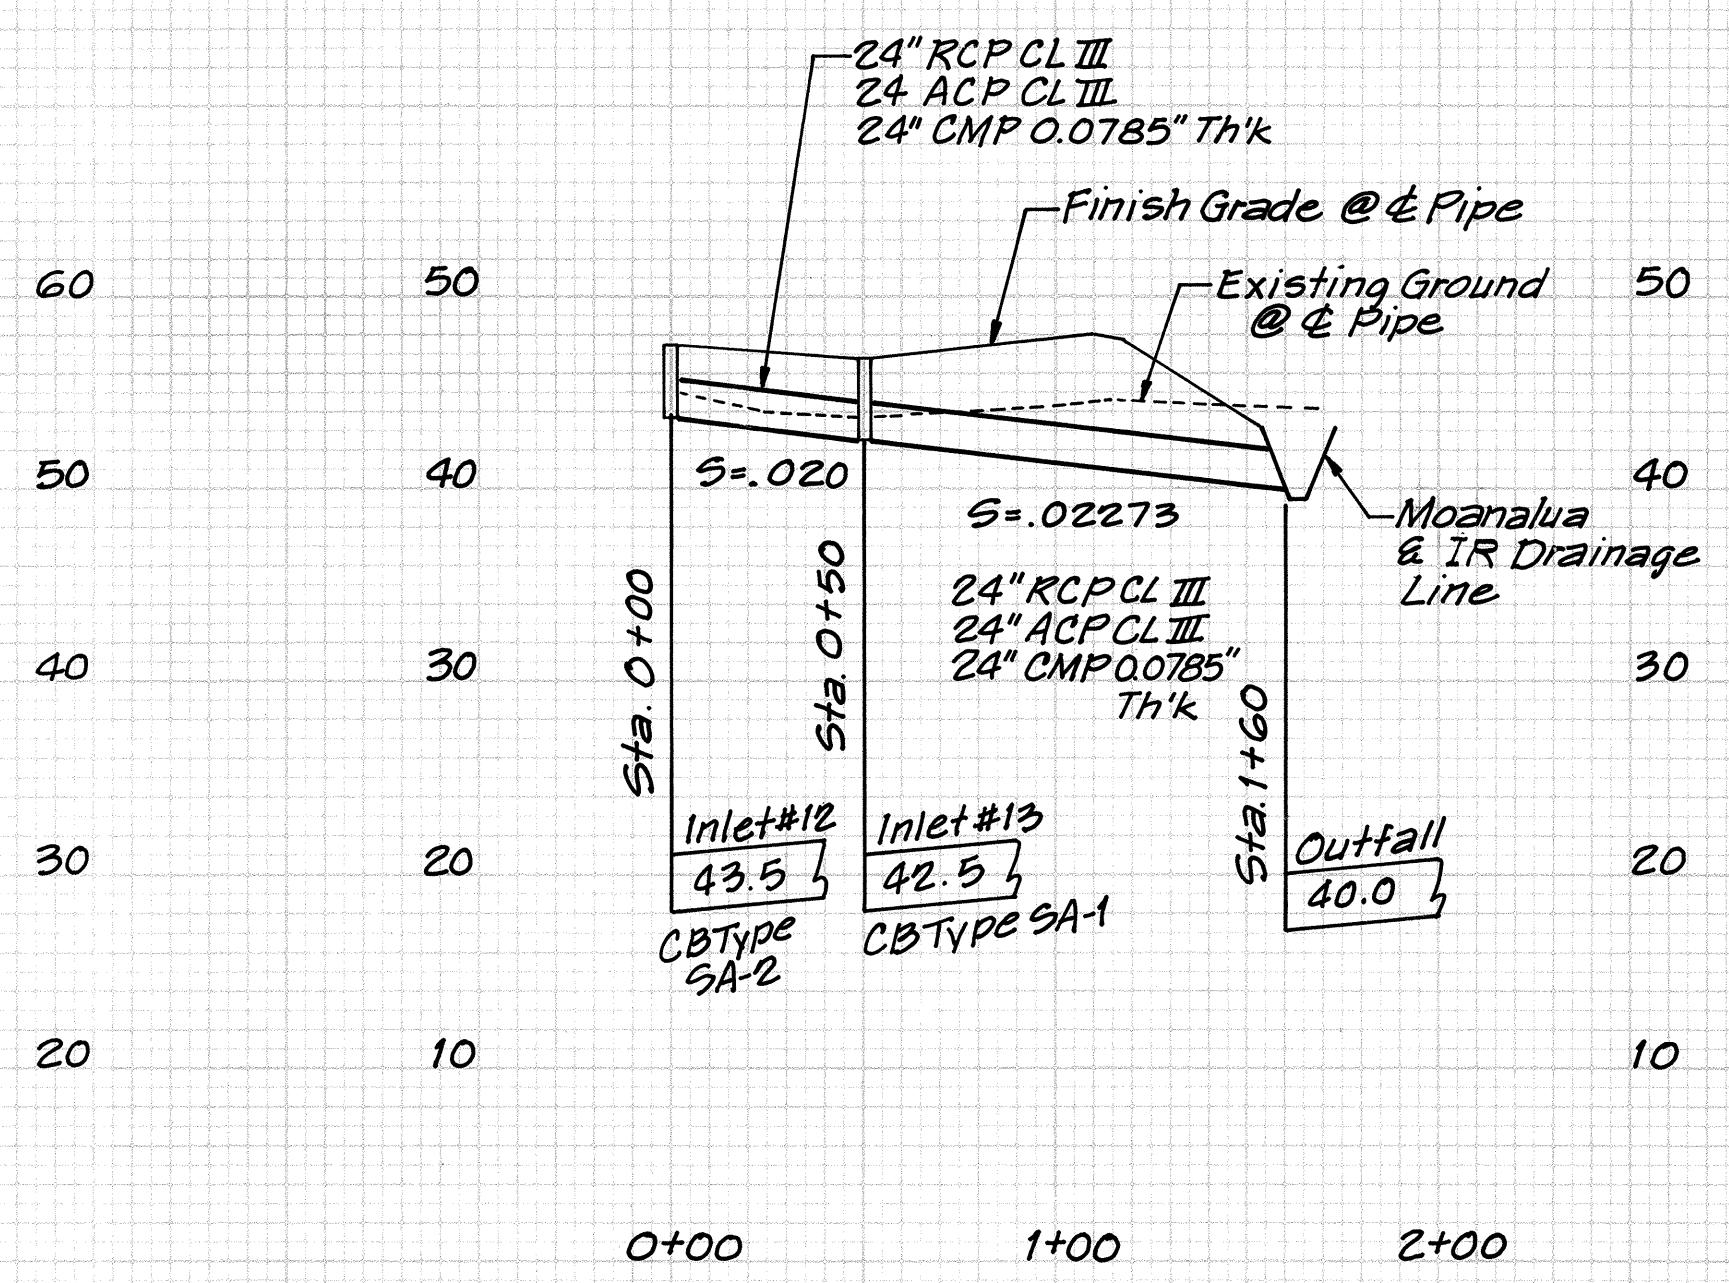


IR DRAINAGE LINE

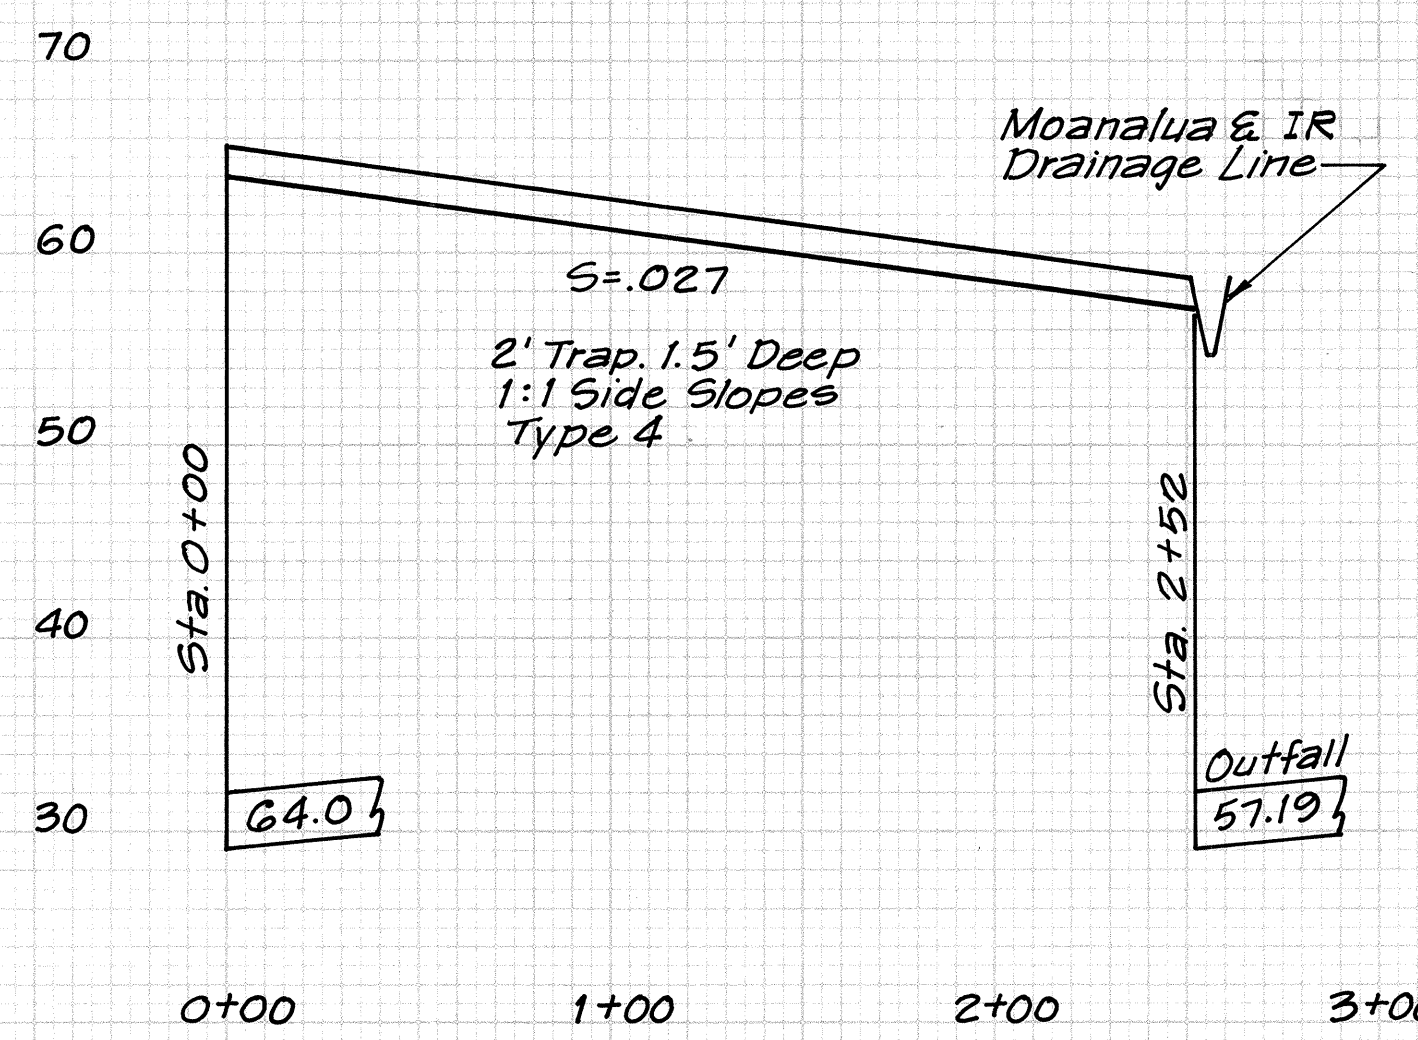


MOANALUA & RAMP L DITCH

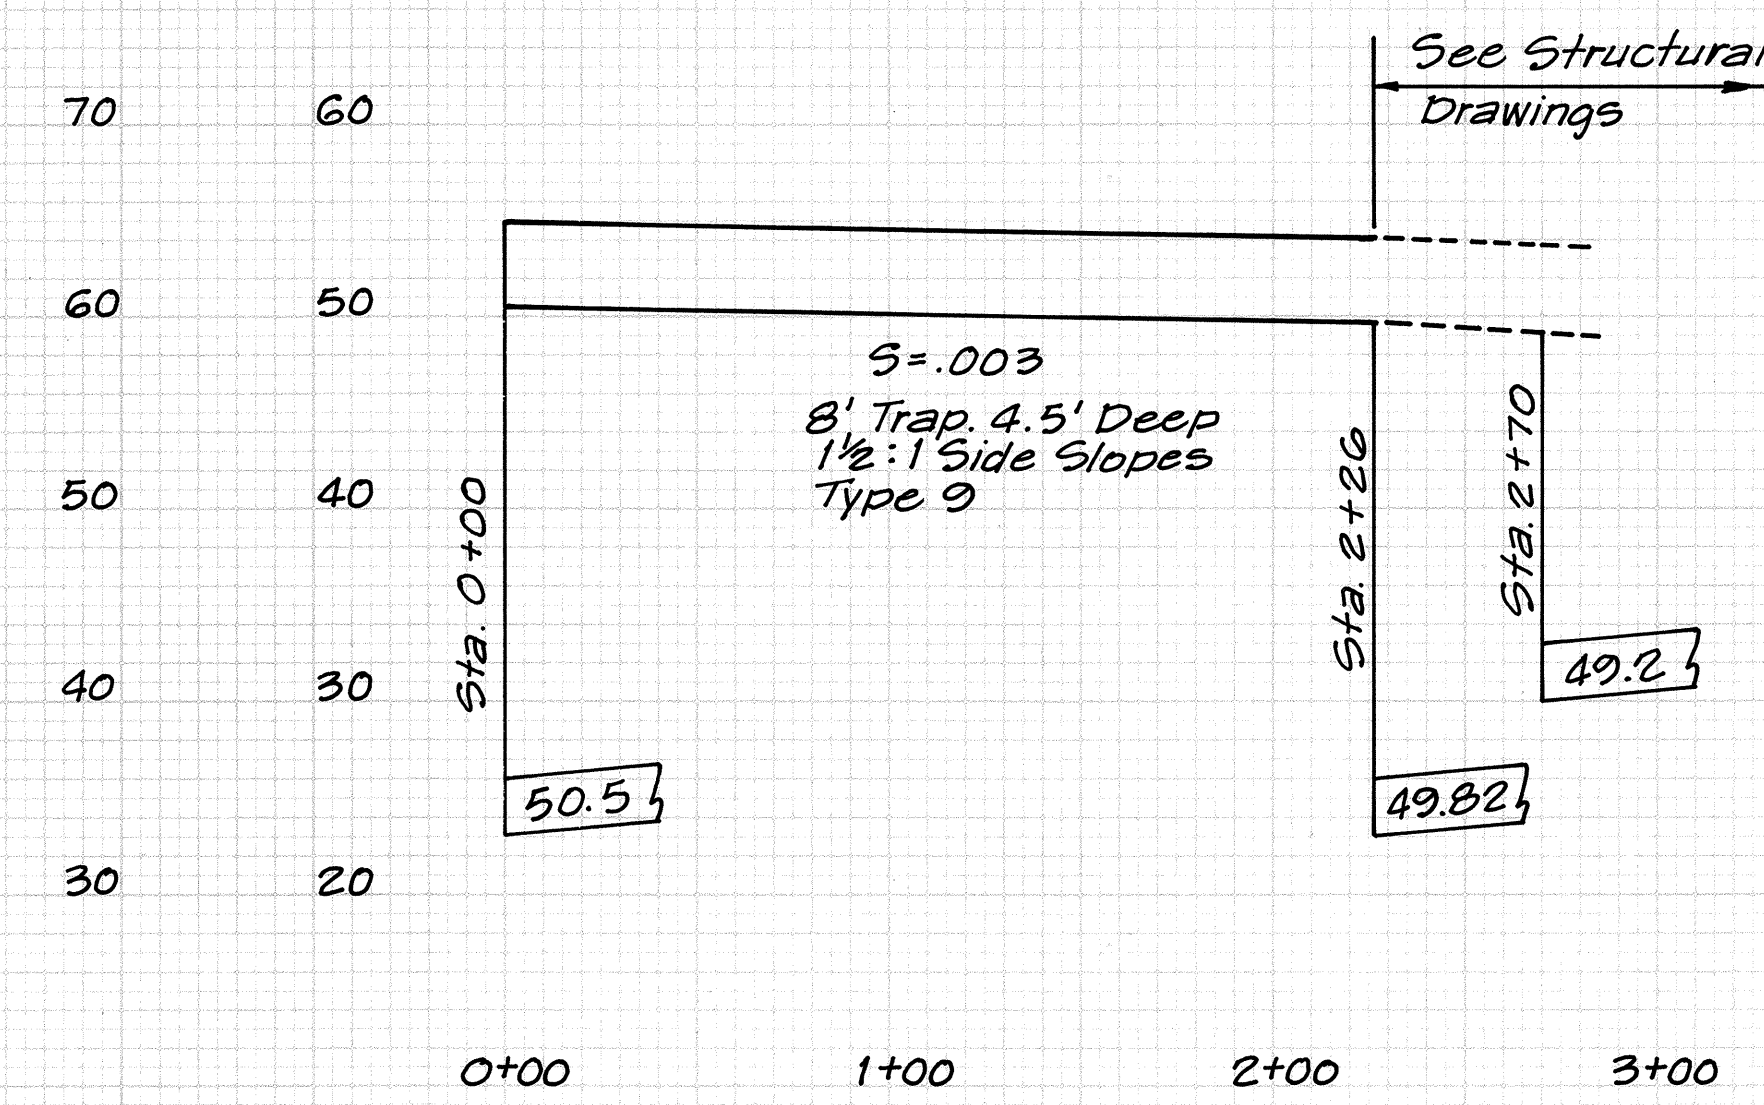

CHANNEL A

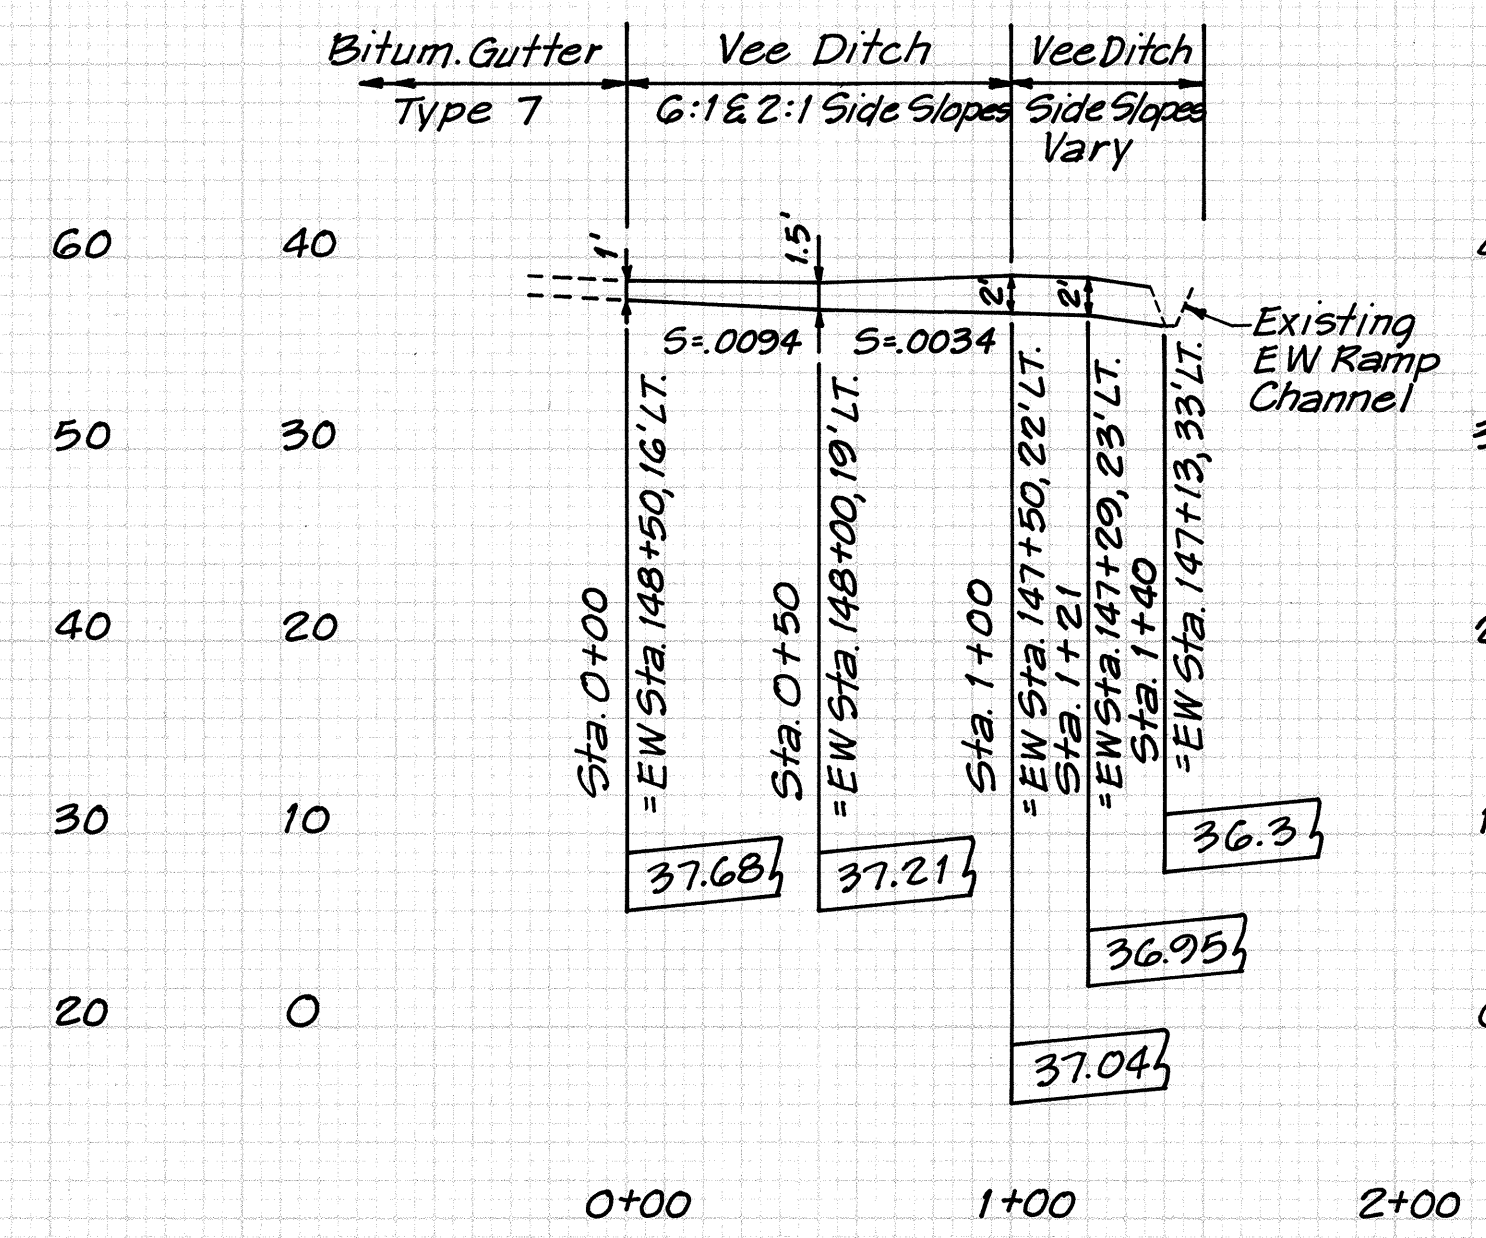

EW RAMP TRANSITIONAL DITCH

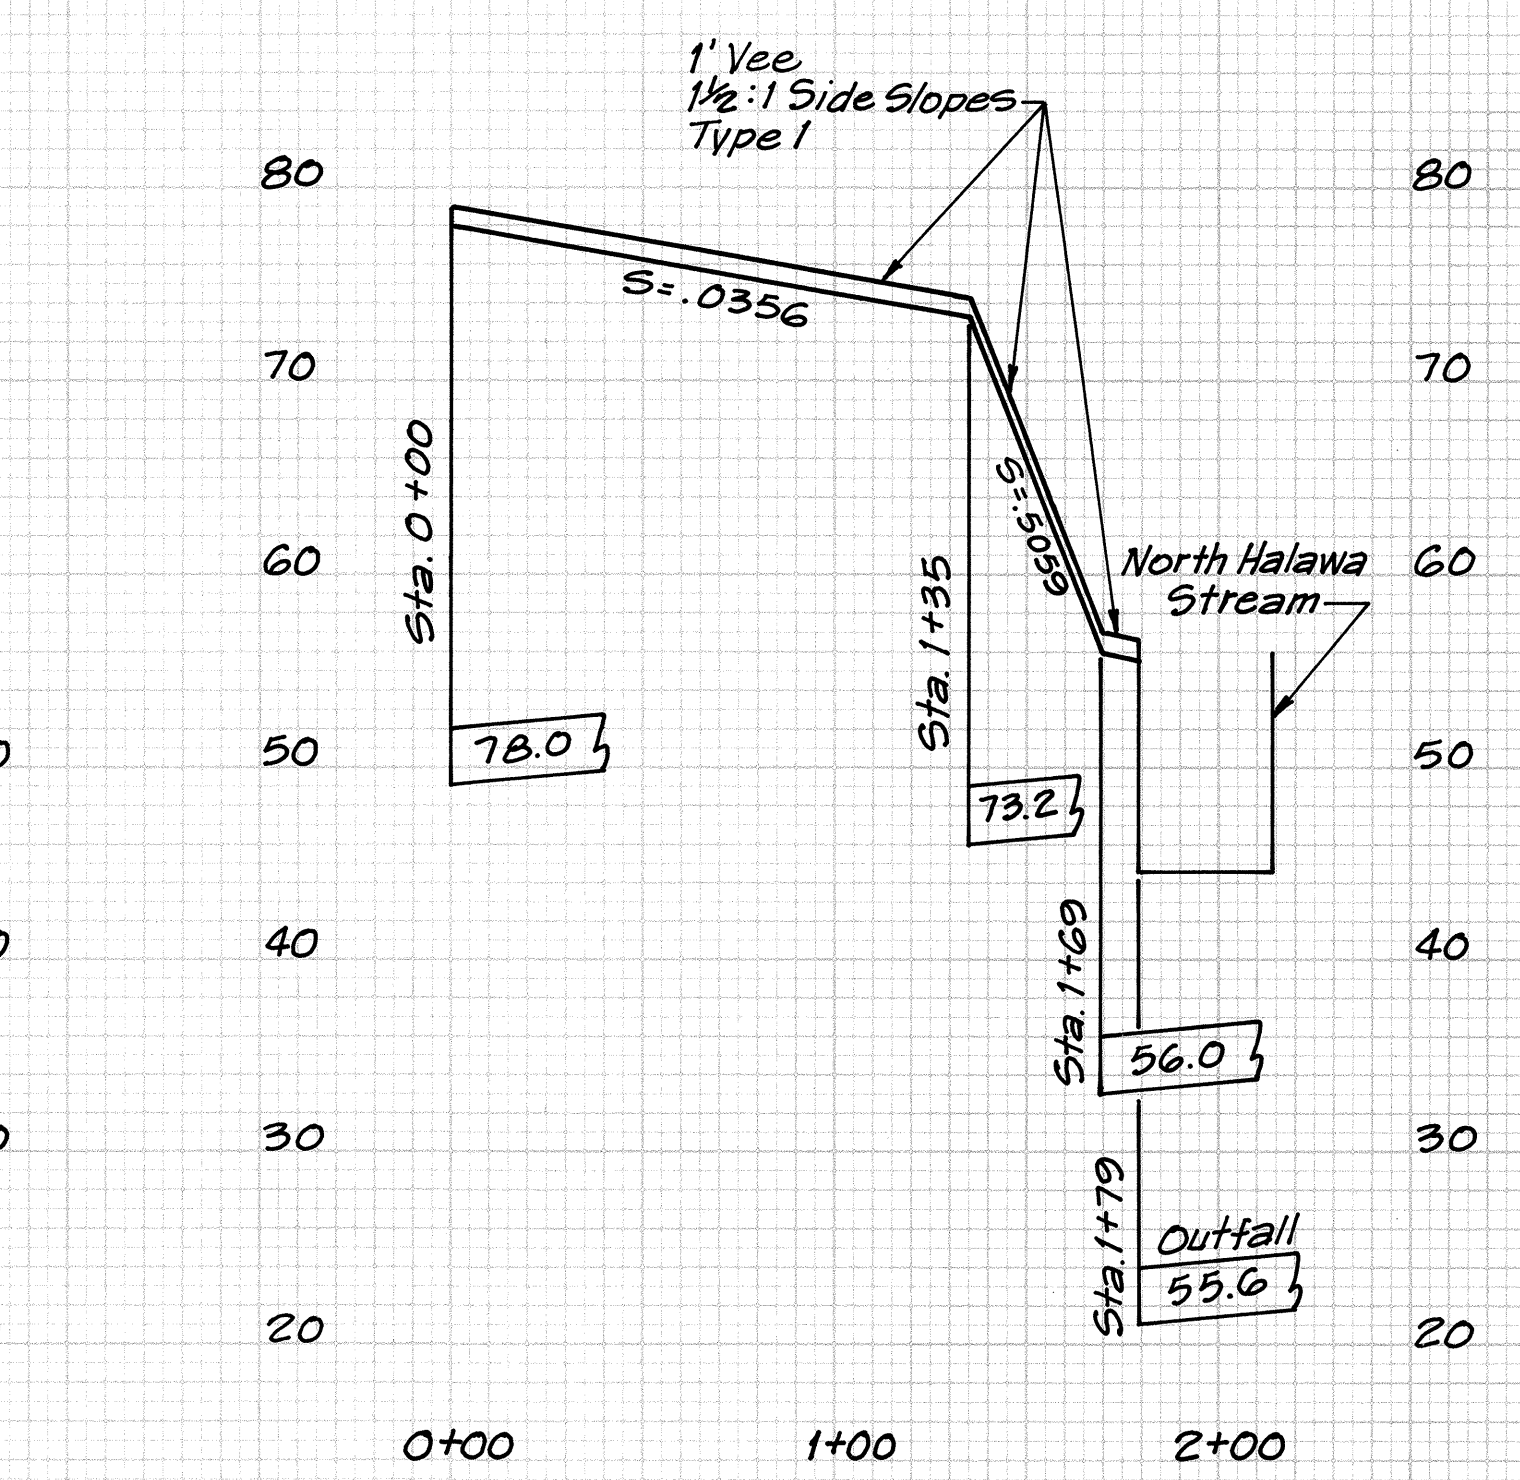


RAMP O & RAMP P DITCH

DRAINAGE PROFILES

Scales: Horiz. 1"=50'
Vert. 1"=10'
Slopes in F/T

THIS WORK WAS PREPARED BY
ME OR UNDER MY SUPERVISION.

Andrew Schuchert

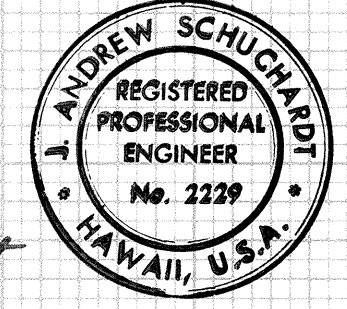


FED. ROAD DIST. NO.	STATE	FED. AID PROJ. NO.	FISCAL YEAR	SHEET NO.	TOTAL SHEETS
HAWAII	HAW.	I-HI-1(90)13	1972	51	202

FINAL SURVEY	DATE
DESIGNED	BY
PLOTTED	BY
NOTED	BY
REVISIONS	DATE
NO.	DATE


ORIGINAL SURVEY	DATE
DESIGNED	BY
PLOTTED	BY
NOTED	BY
REVISIONS	DATE
NO.	DATE

Rectangular Channel Stems See Standard Retaining Walls Type T1 Sheet 155 and Typical Section Sheet 151

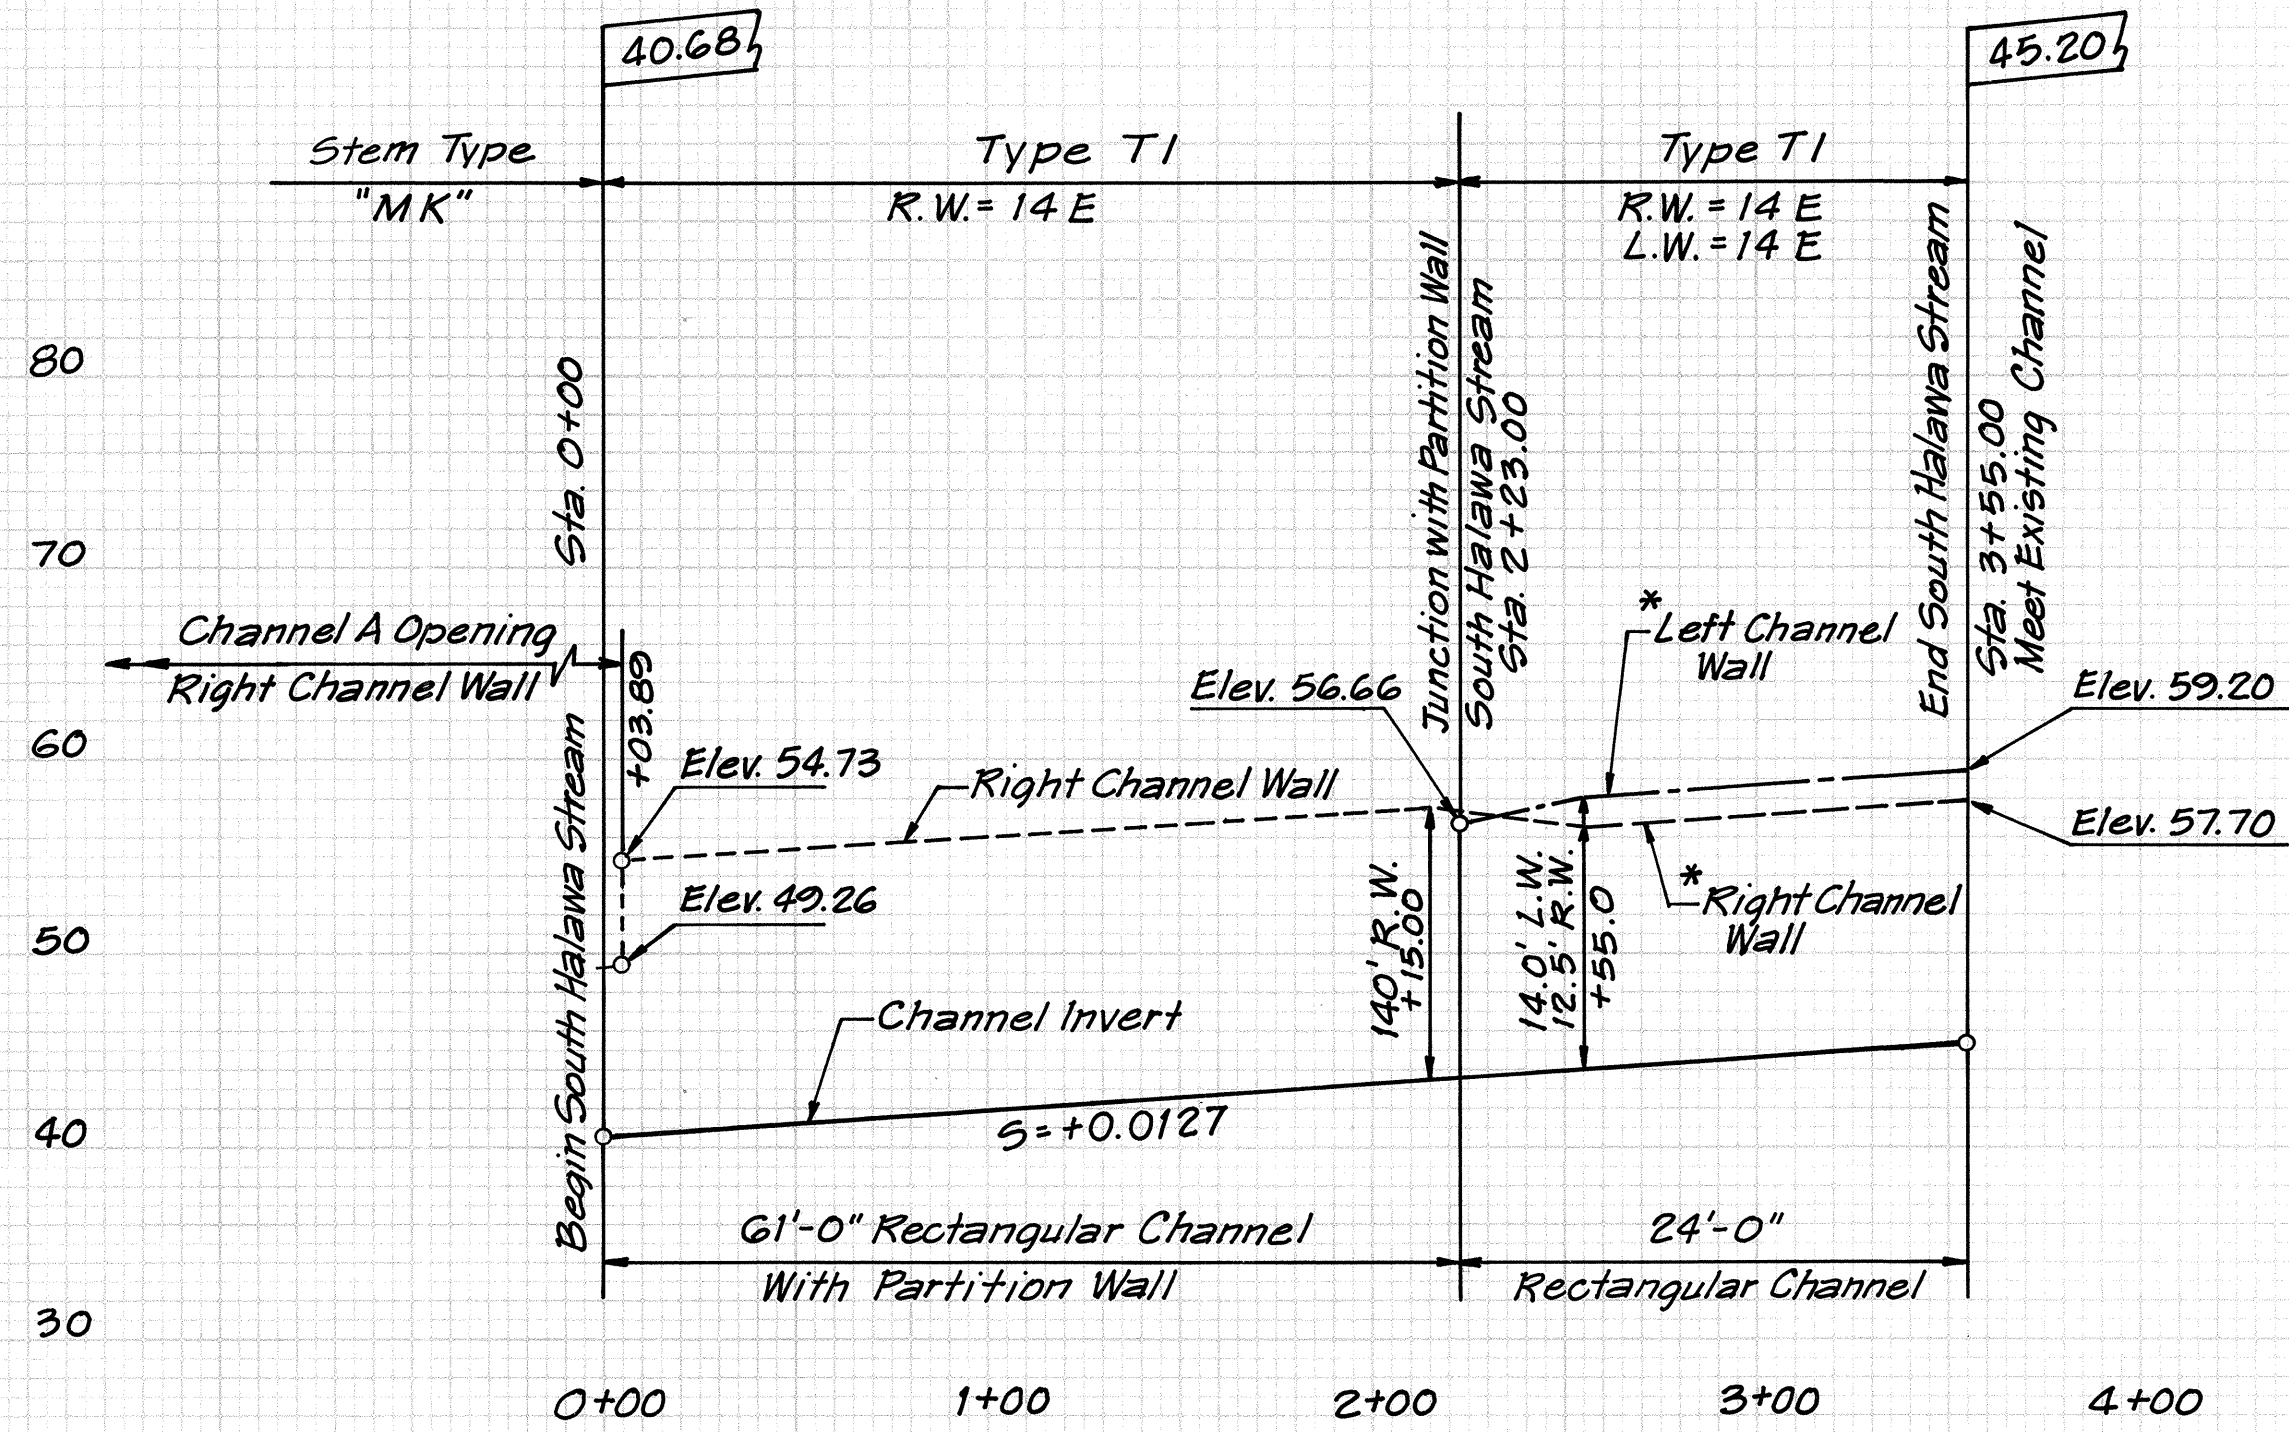


SOUTH HALAWA STREAM


*NOTE: Right & Left Channel Wall is Determined by Looking Up Stream in All Stream Profiles.
R.W. = Right Wall
L.W. = Left Wall

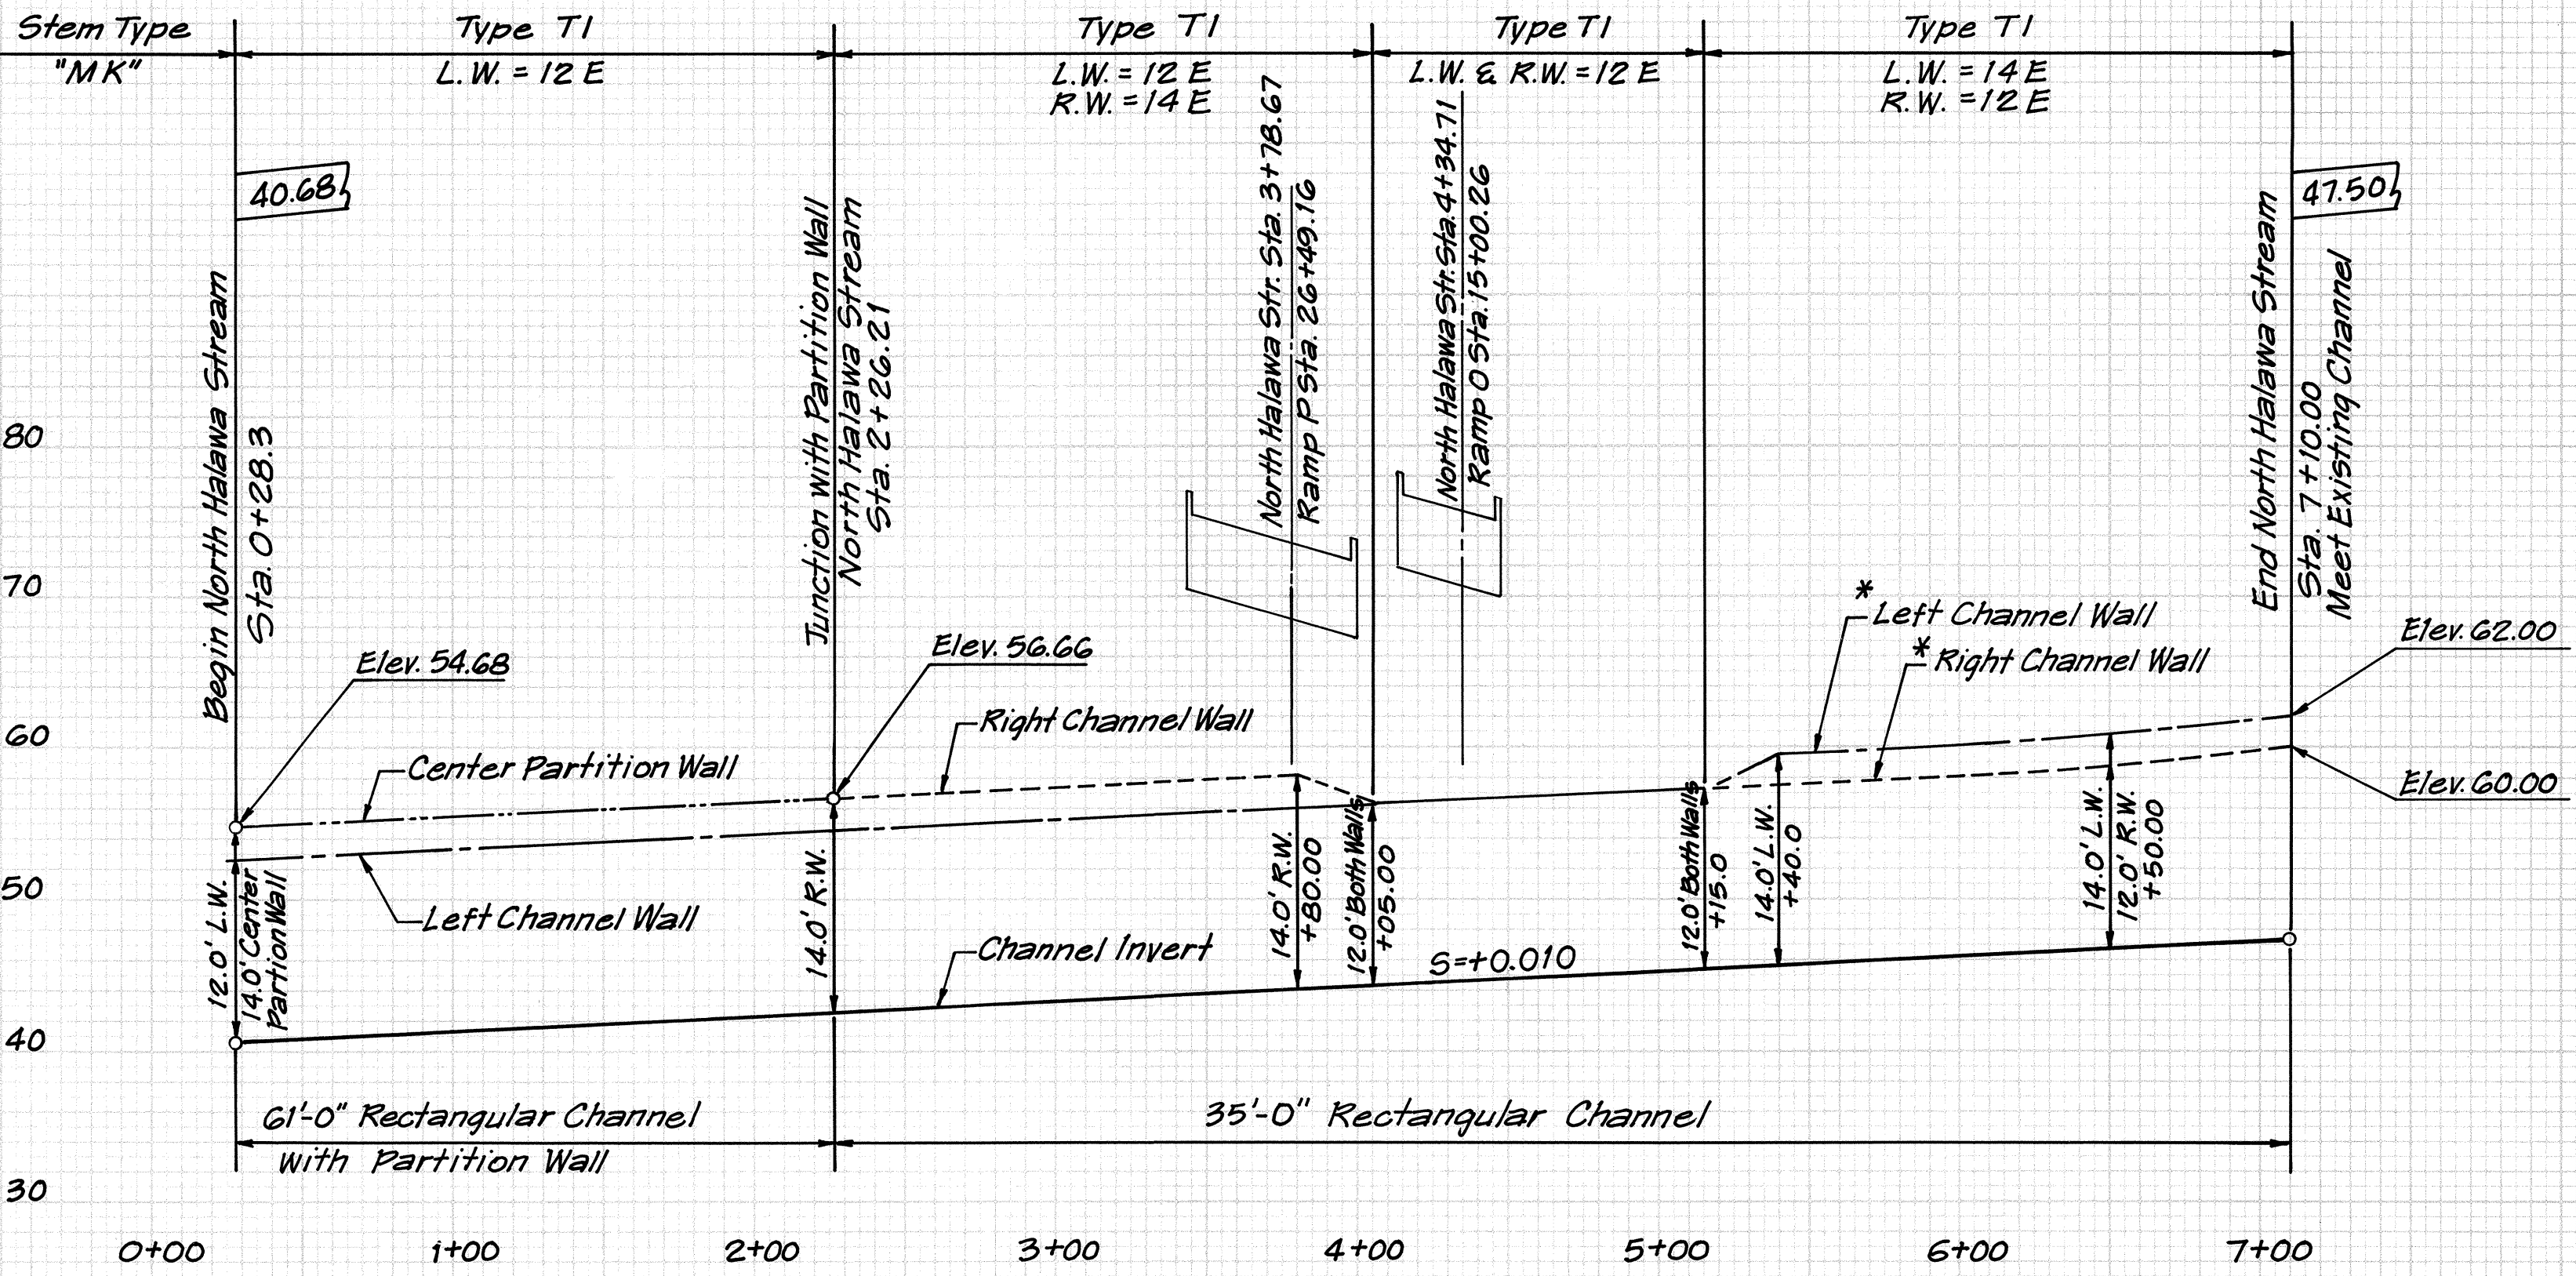

NORTH HALAWA STREAM

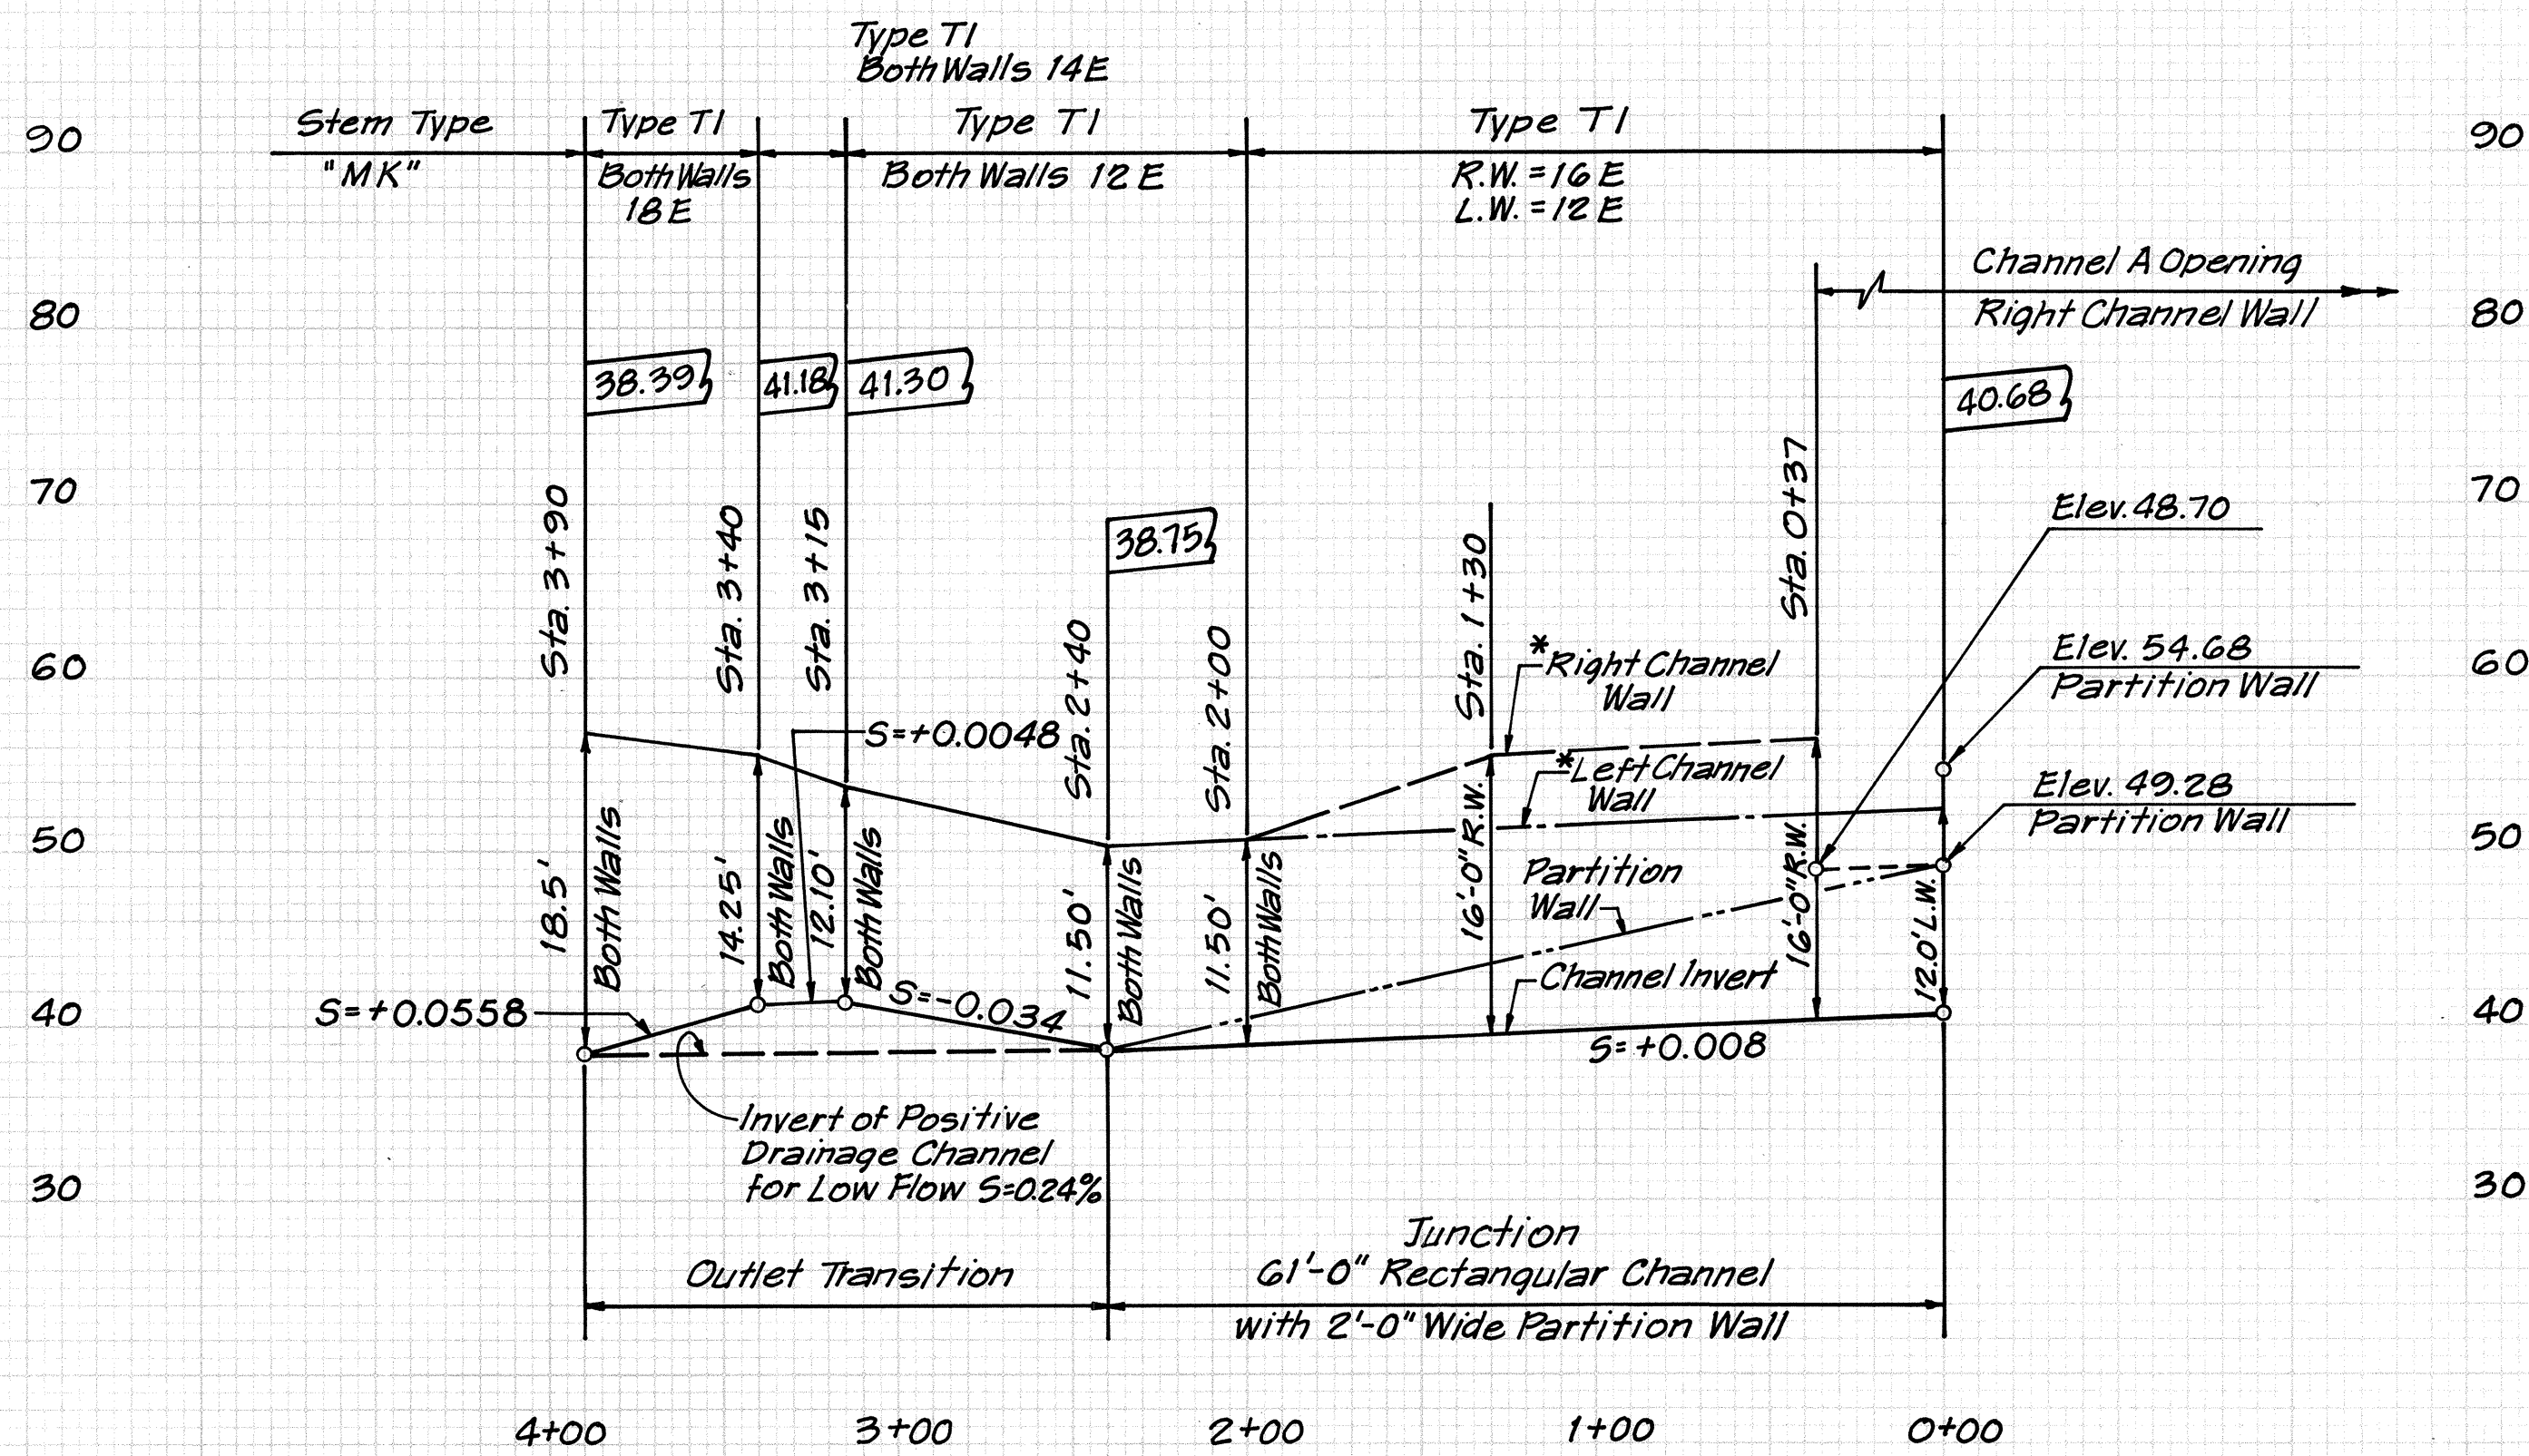

NORTH & SOUTH HALAWA STREAM JUNCTION AND OUTLET TRANSITION


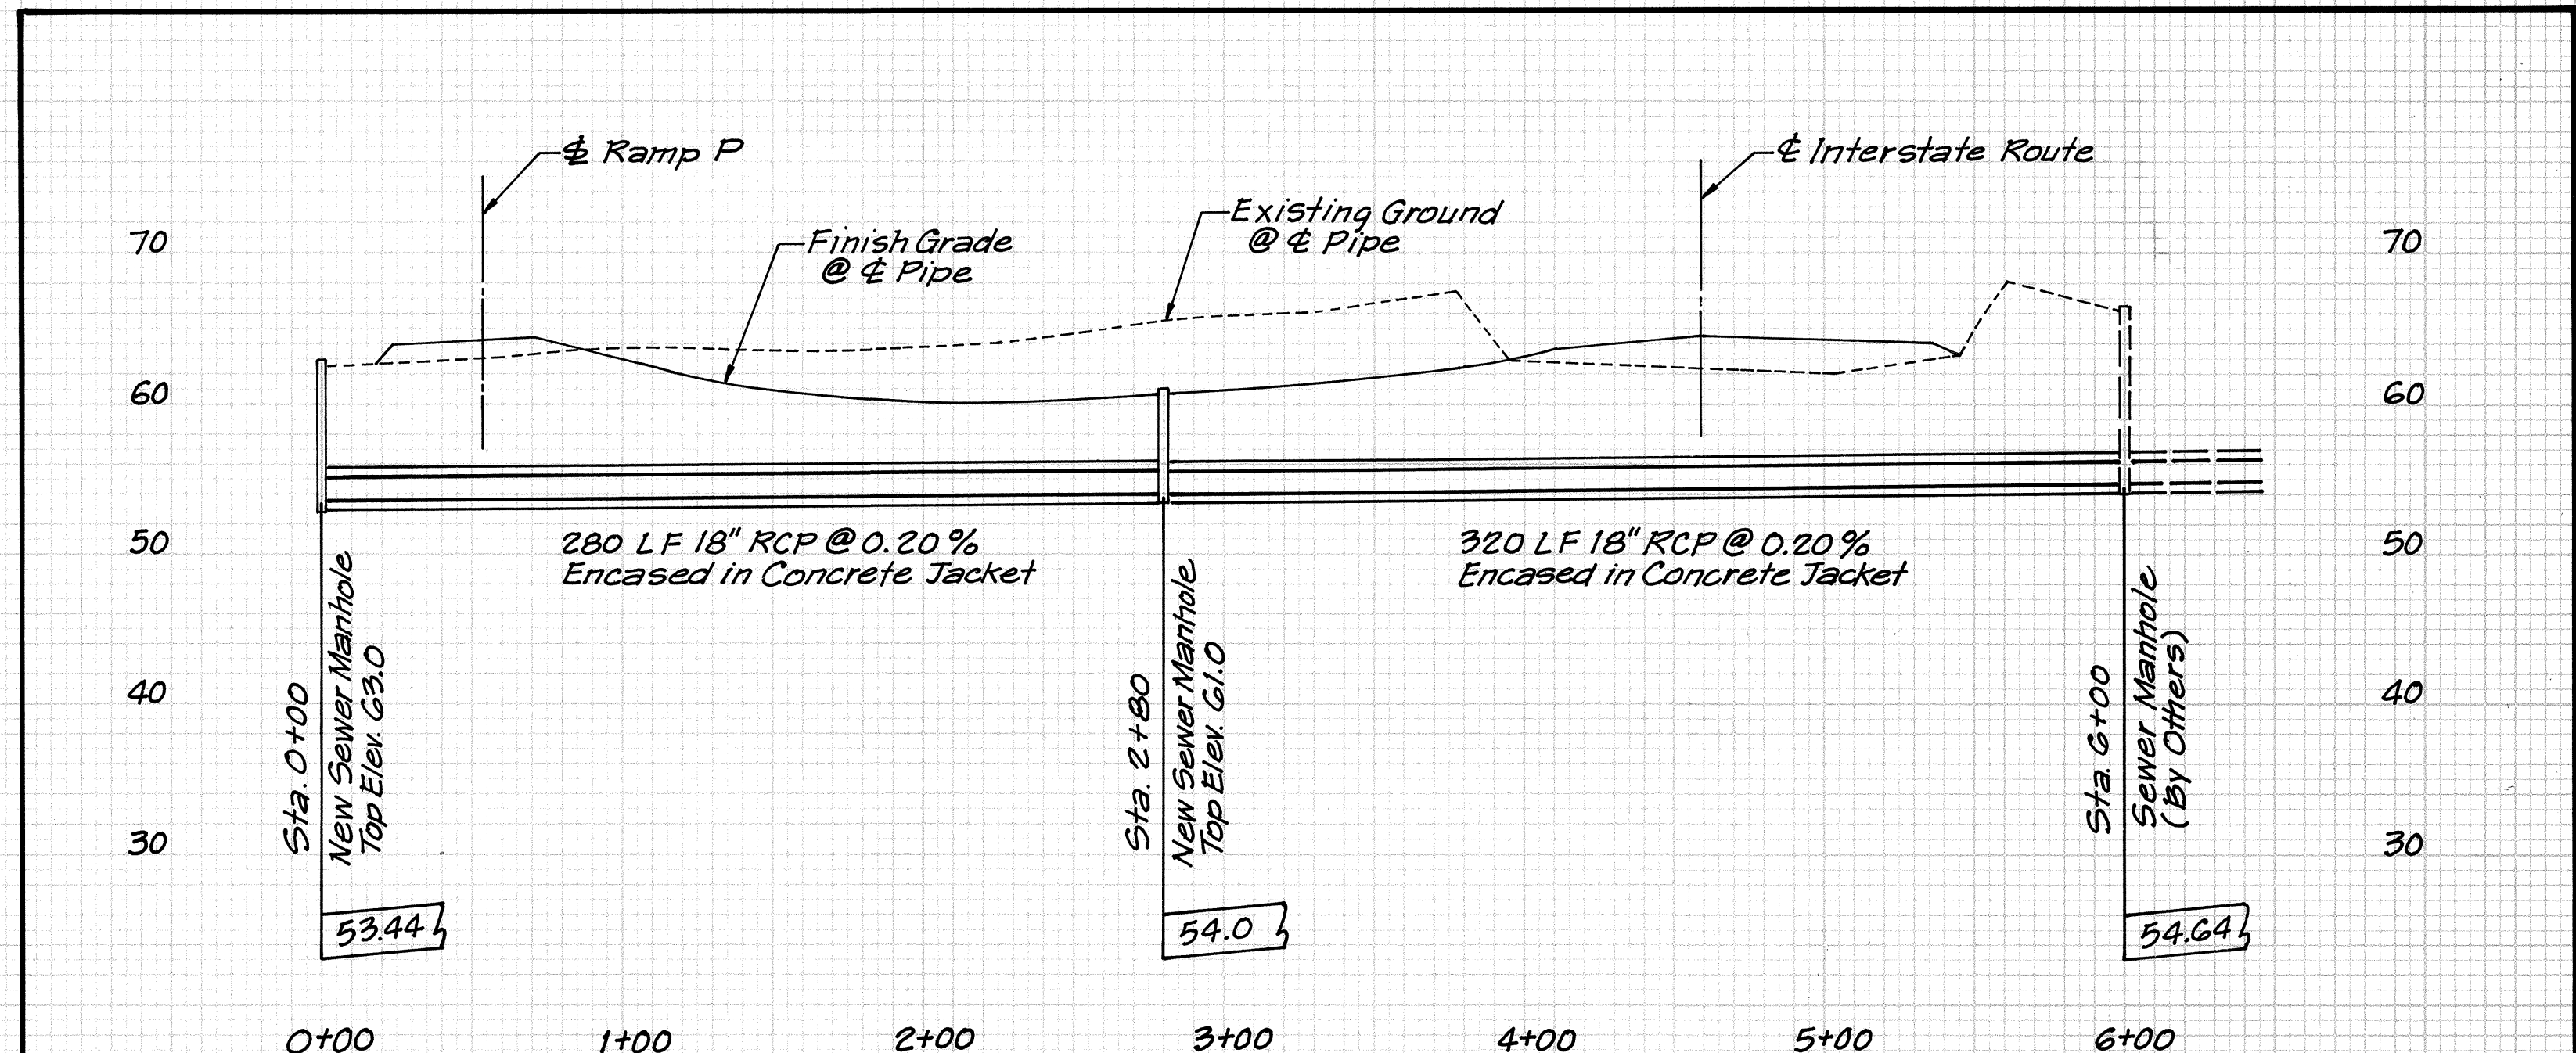


PROFILE - SANITARY SEWER (CITY)


APPROVED
Chief, Division of Sewers
Date

DRAINAGE & UTILITY PROFILES
Scale: Horiz. 1"=50'
Vert. 1"=10'
Slopes in Ft./Ft.

FED. ROAD DIST. NO.	STATE	FED. AID PROJ. NO.	FISCAL YEAR	SHEET NO.	TOTAL SHEETS
HAWAII	HAW.	I-HI-1(90):13	1972	52	202

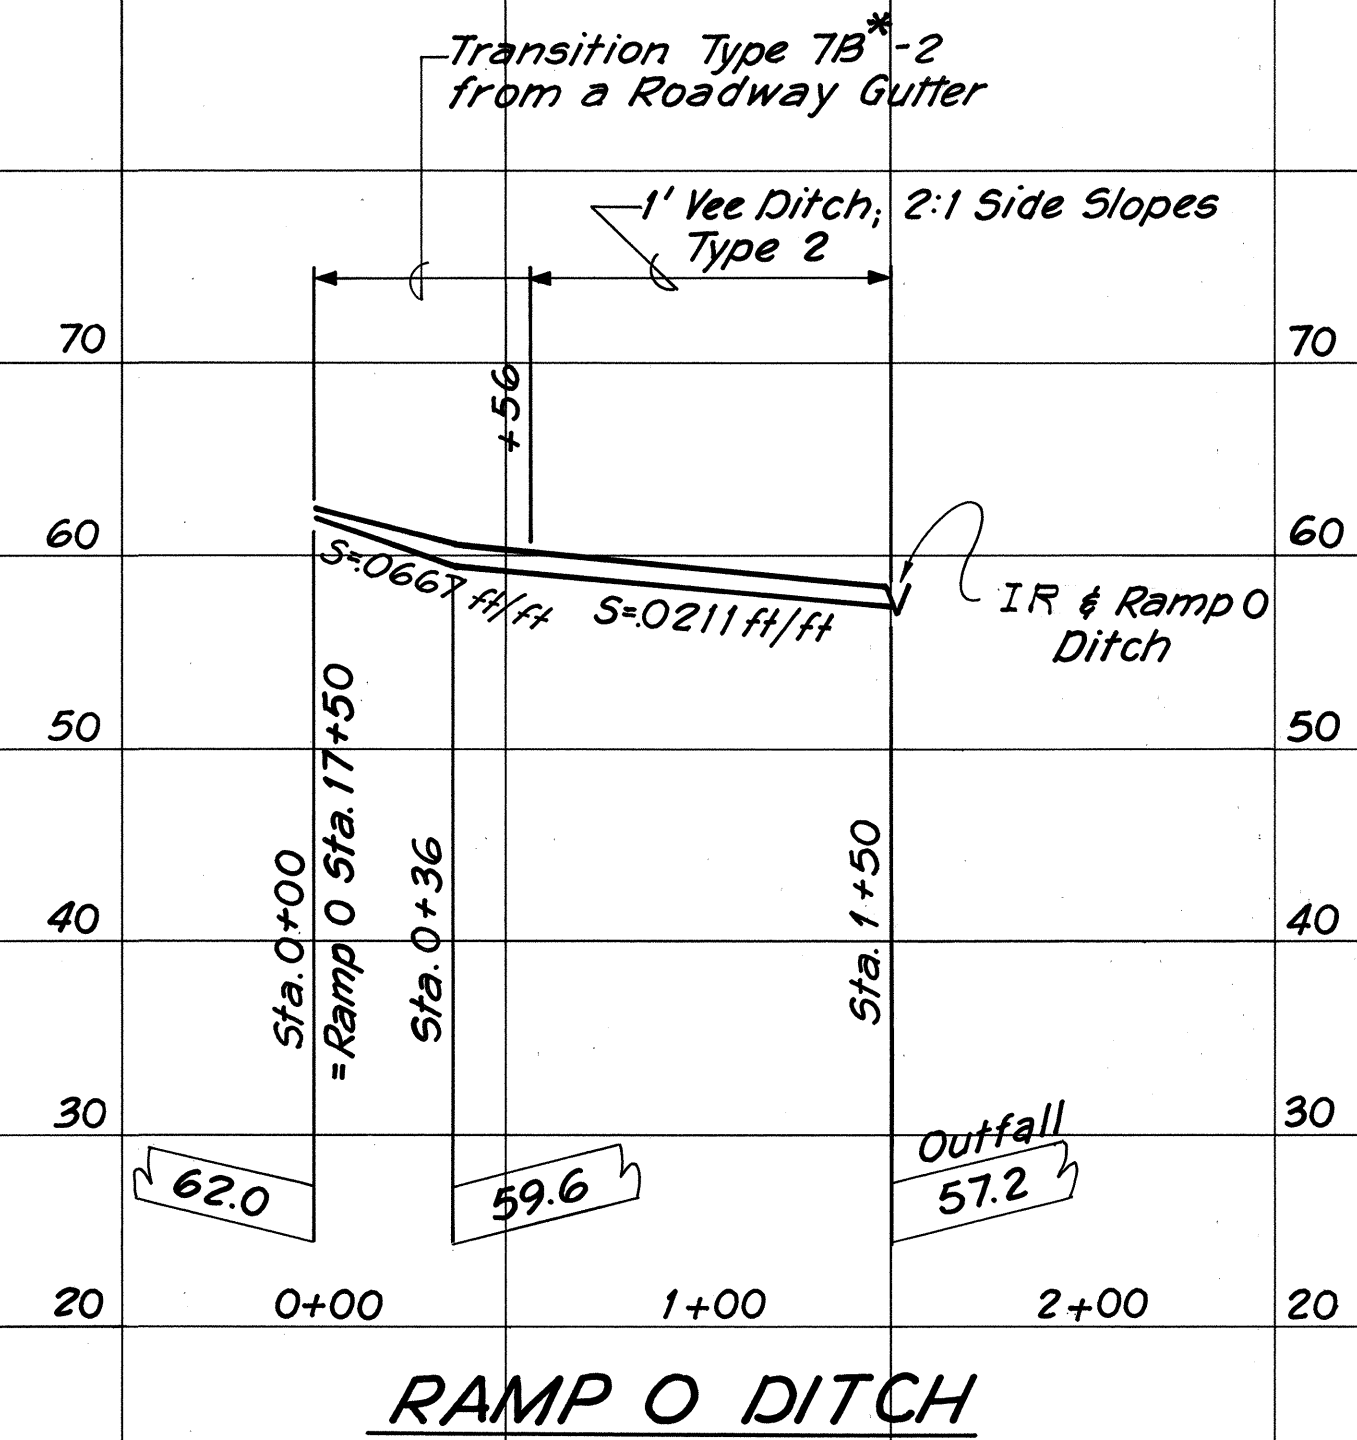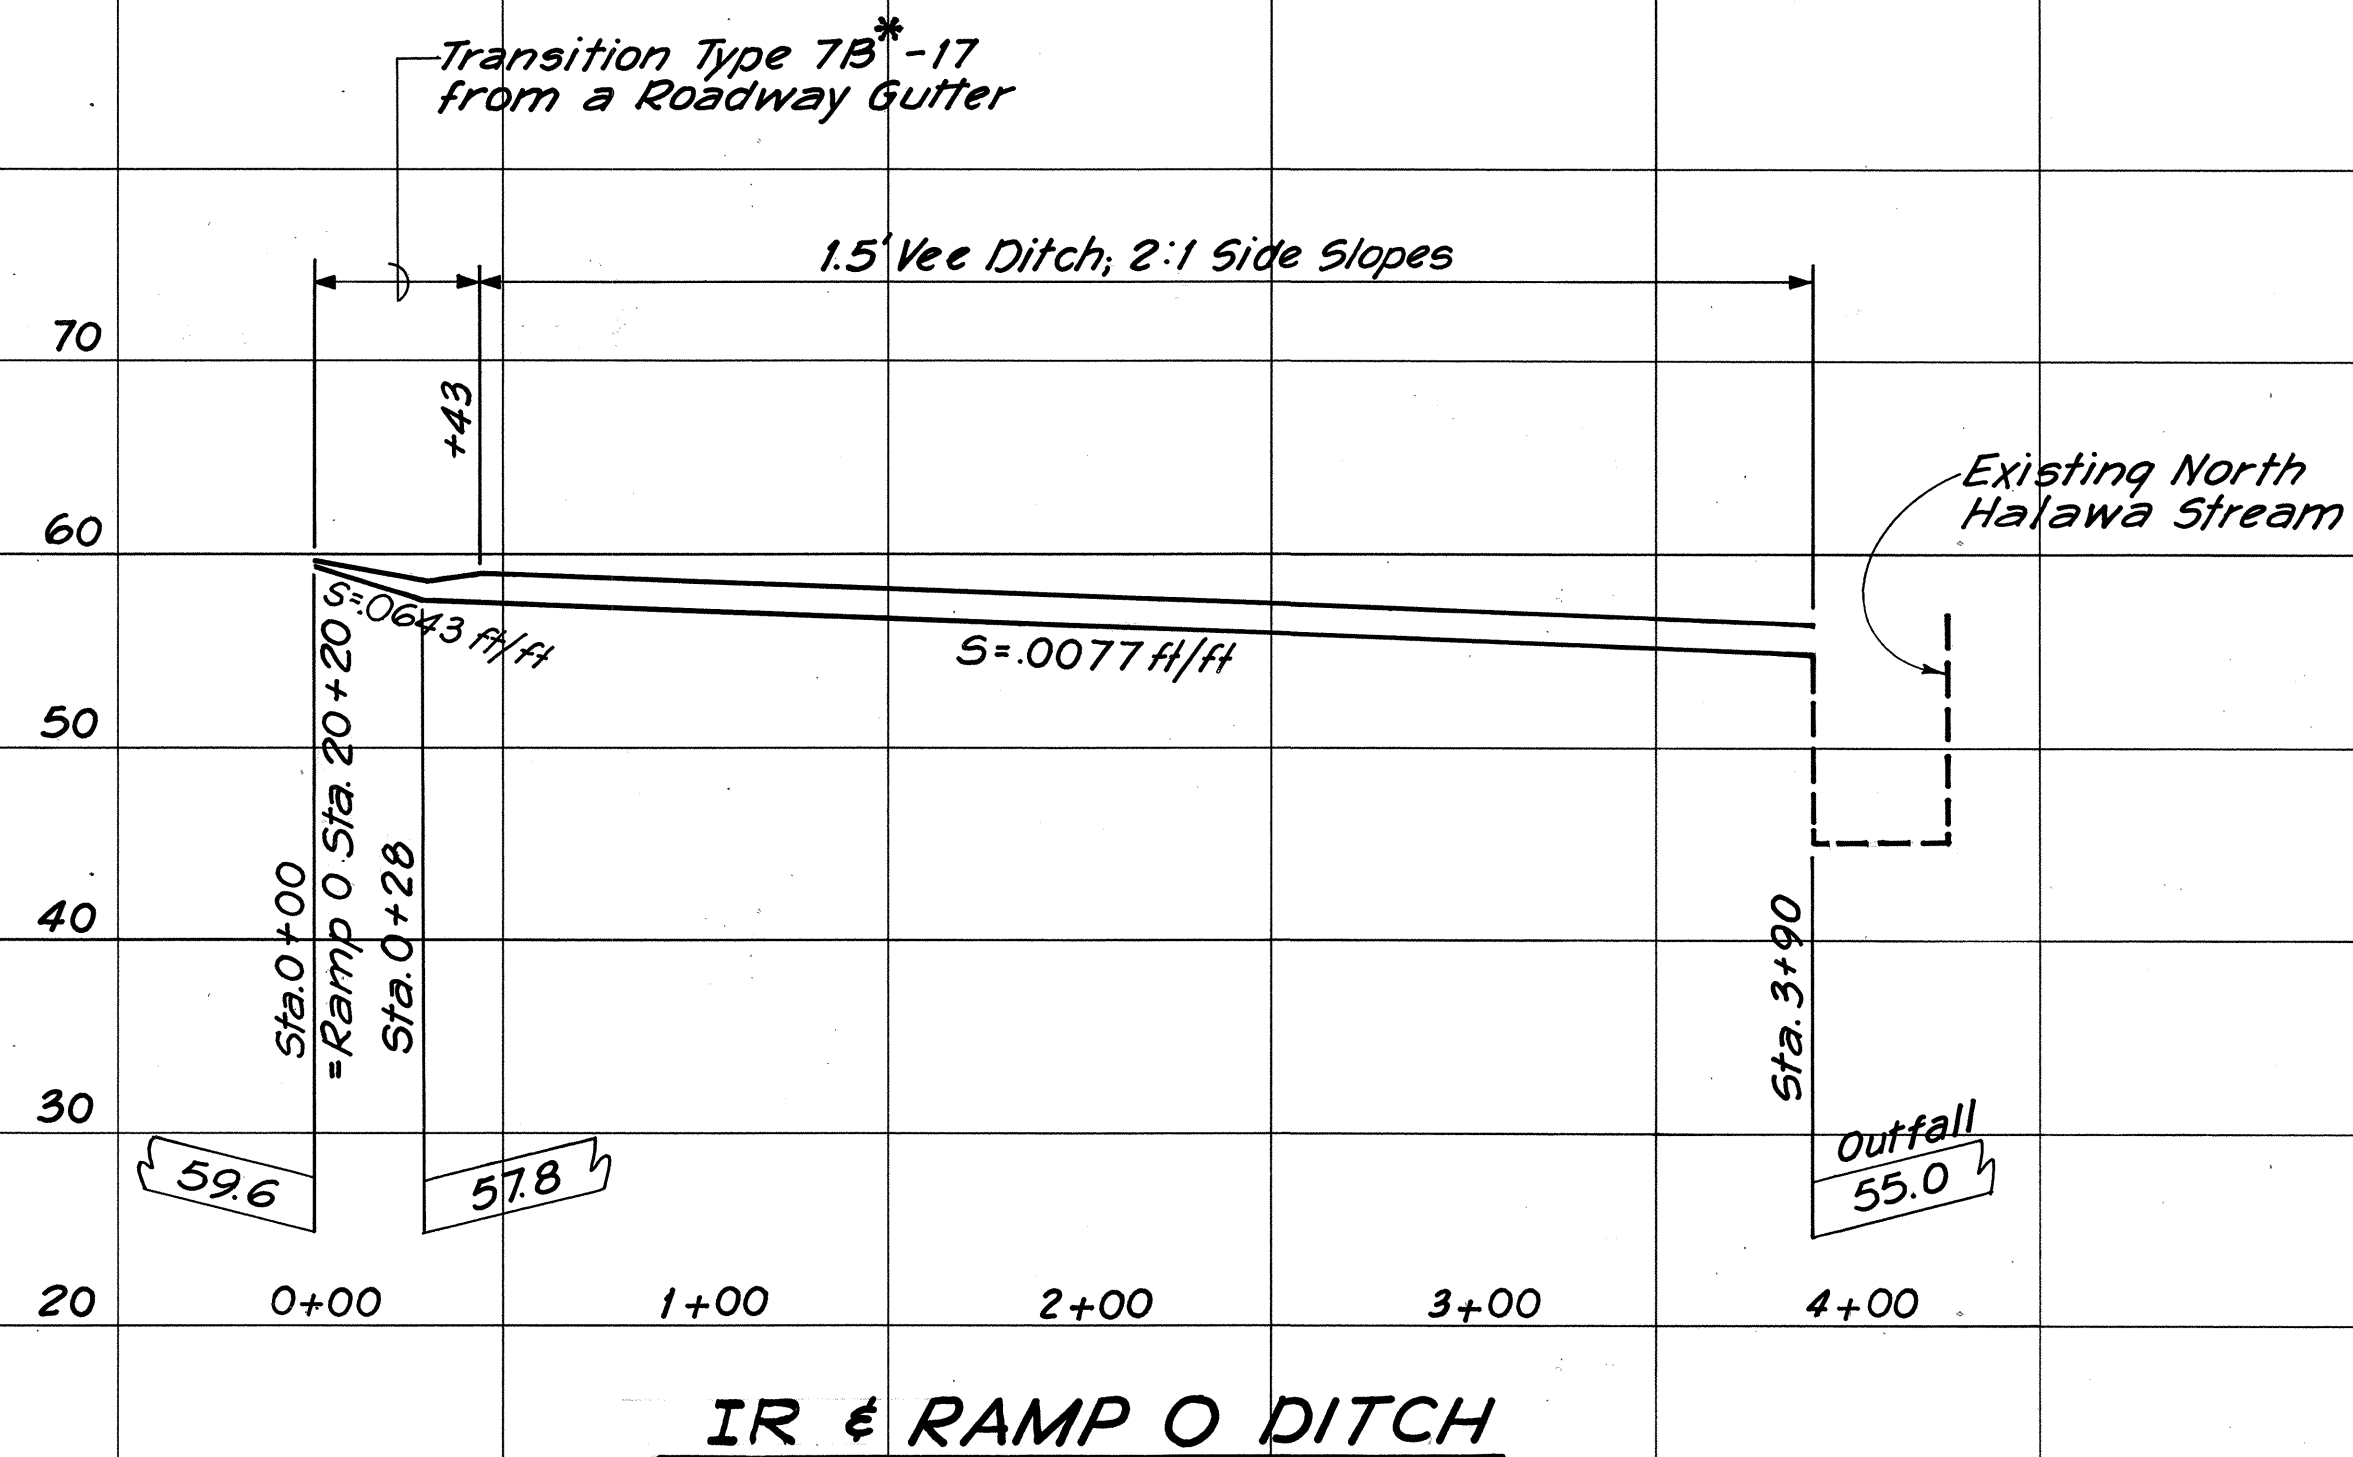

ORIGINAL PLAN	DATE
SURVEY PLOTTED BY	
DRAWN BY	
DESIGNED BY	
CHECKED BY	
NOTE BOOK	
No.	

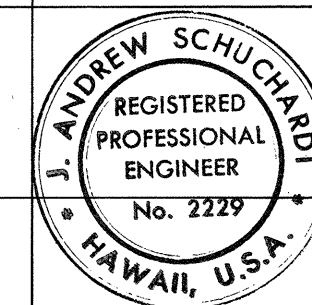

THIS WORK WAS PREPARED BY
ME OR UNDER MY SUPERVISION.
Andrew Schuchardt

STATE OF HAWAII
DEPARTMENT OF TRANSPORTATION
HIGHWAYS DIVISION

DRAINAGE PROFILES

INTERSTATE ROUTE H-1
PROJECT NO. I-HI-1(90):13


SCALE: Horiz. 1" = 50'
Vert. 1" = 10'

DATE: DEC. 24, 1970


SHEET No. 12D OF 25 SHEETS

52


FED. ROAD DIST. NO.	STATE	FED. AID PROJ. NO.	FISCAL YEAR	SHEET NO.	TOTAL SHEETS
HAWAII	HAW.	I-H1-1(90):13	1972	53	202

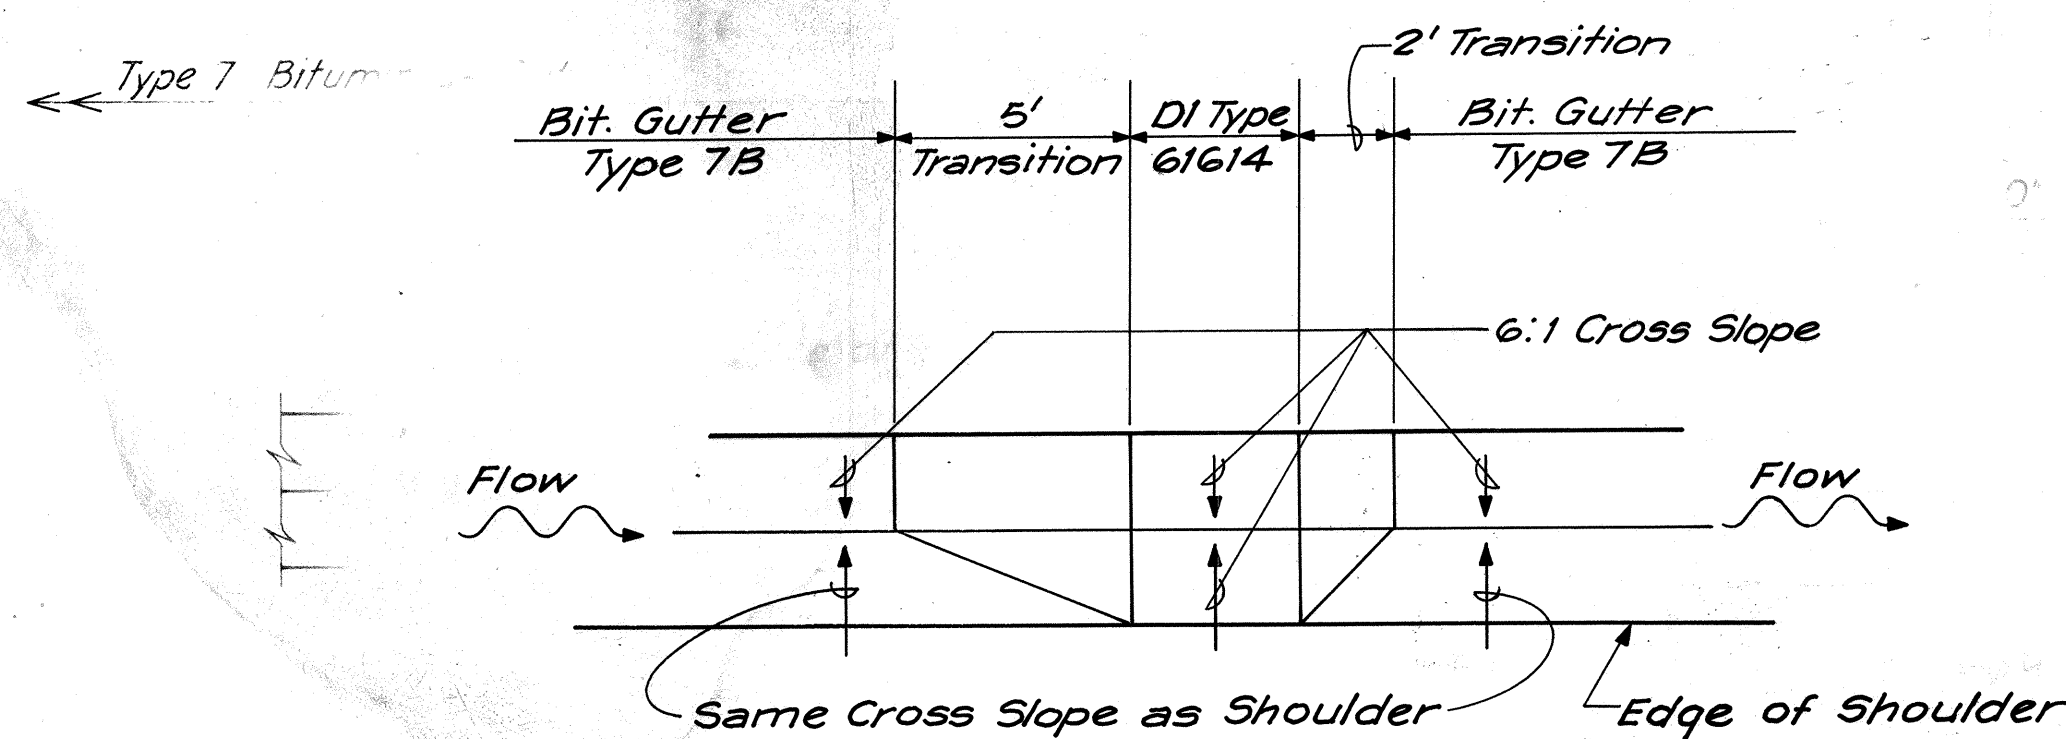


**GUTTER TRANSITION DETAIL
FOR DI TYPE 61614**
Scale: 1" = 4'-0" or 1" = 3'-0"

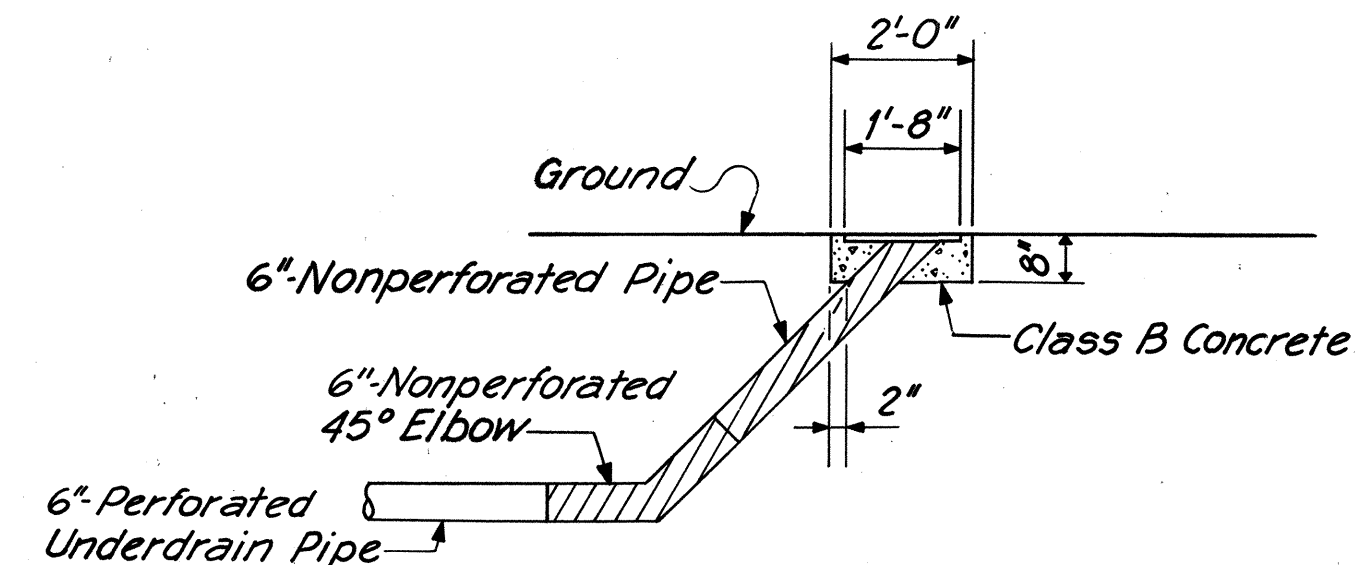

ELEVATION

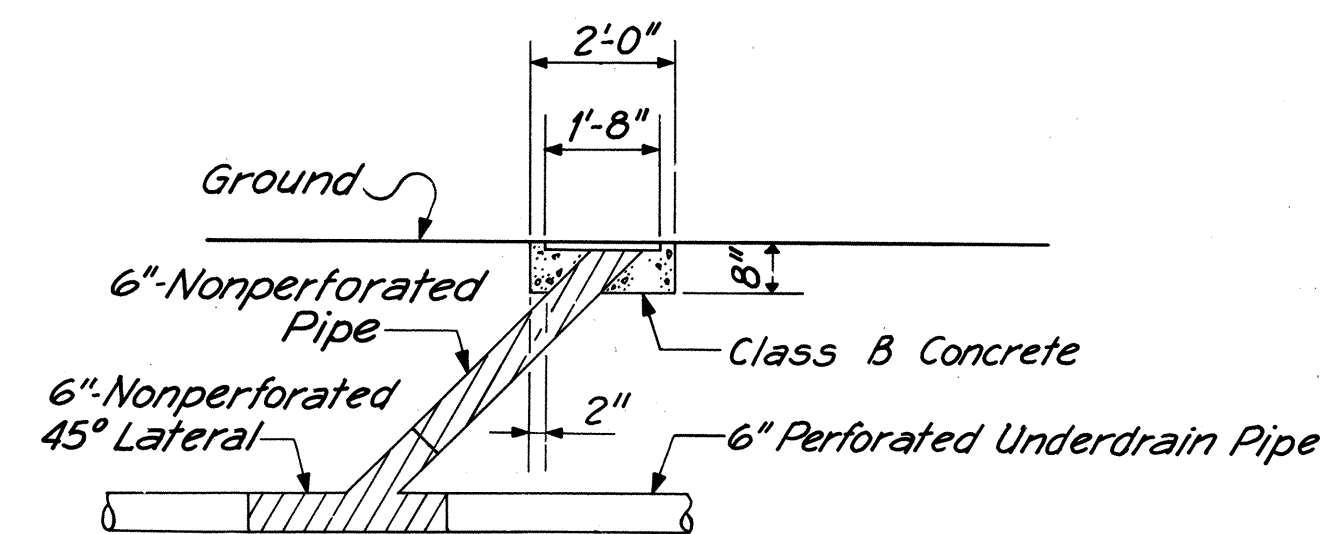


ELEVATION

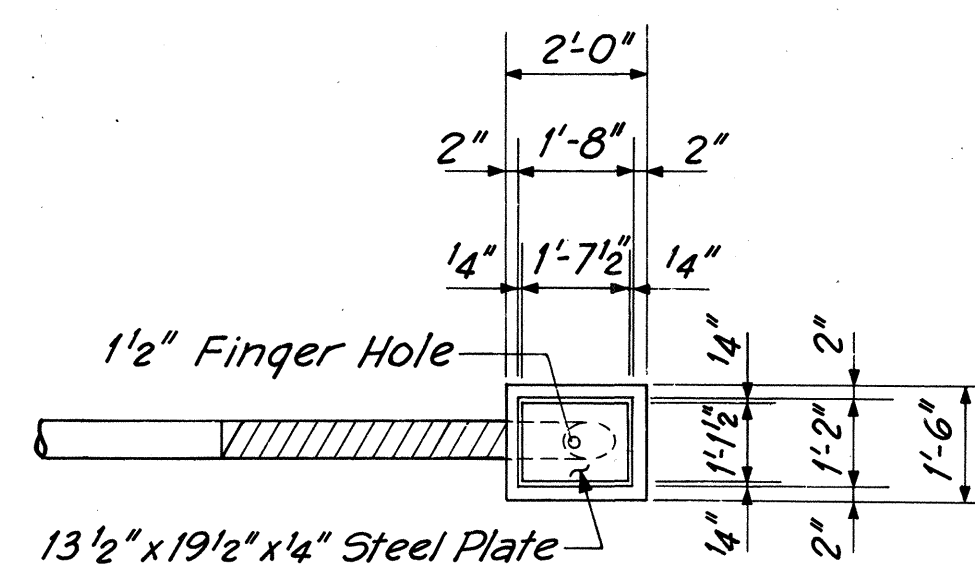


PLAN


UNDERDRAIN CLEANOUT DETAILS
Scale: 3/8" = 1'-0"

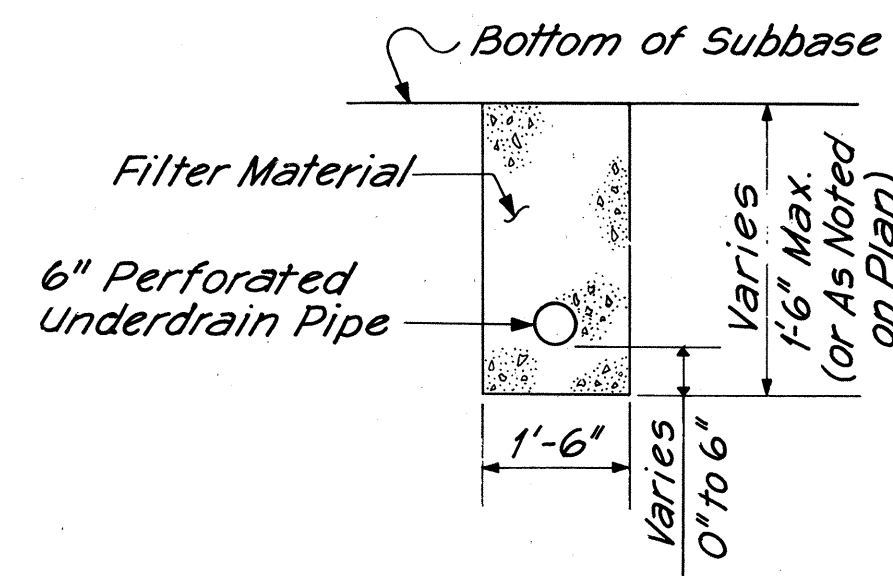

TYPICAL UNDERDRAIN SECTION
Scale: 1/2" = 1'-0"

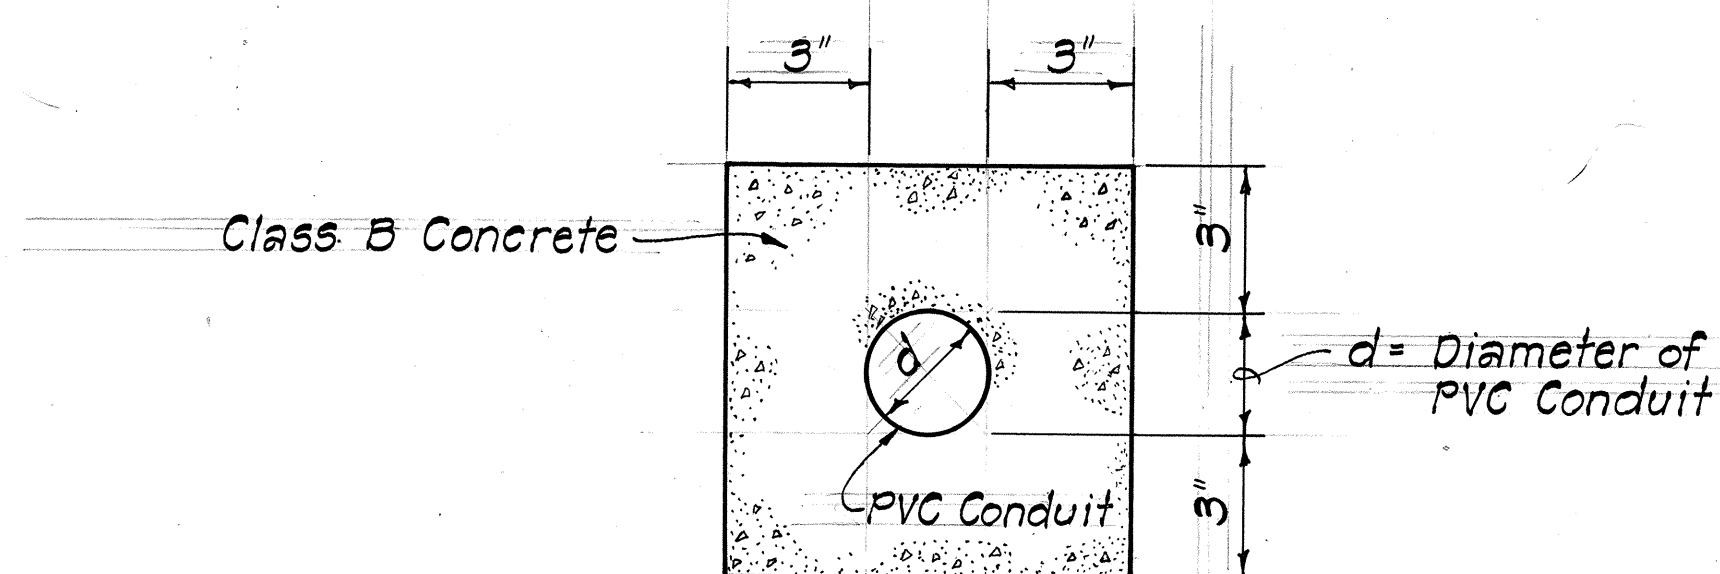

**CONDUIT IN CONCRETE
JACKET FOR SPRINKLER SYSTEM**

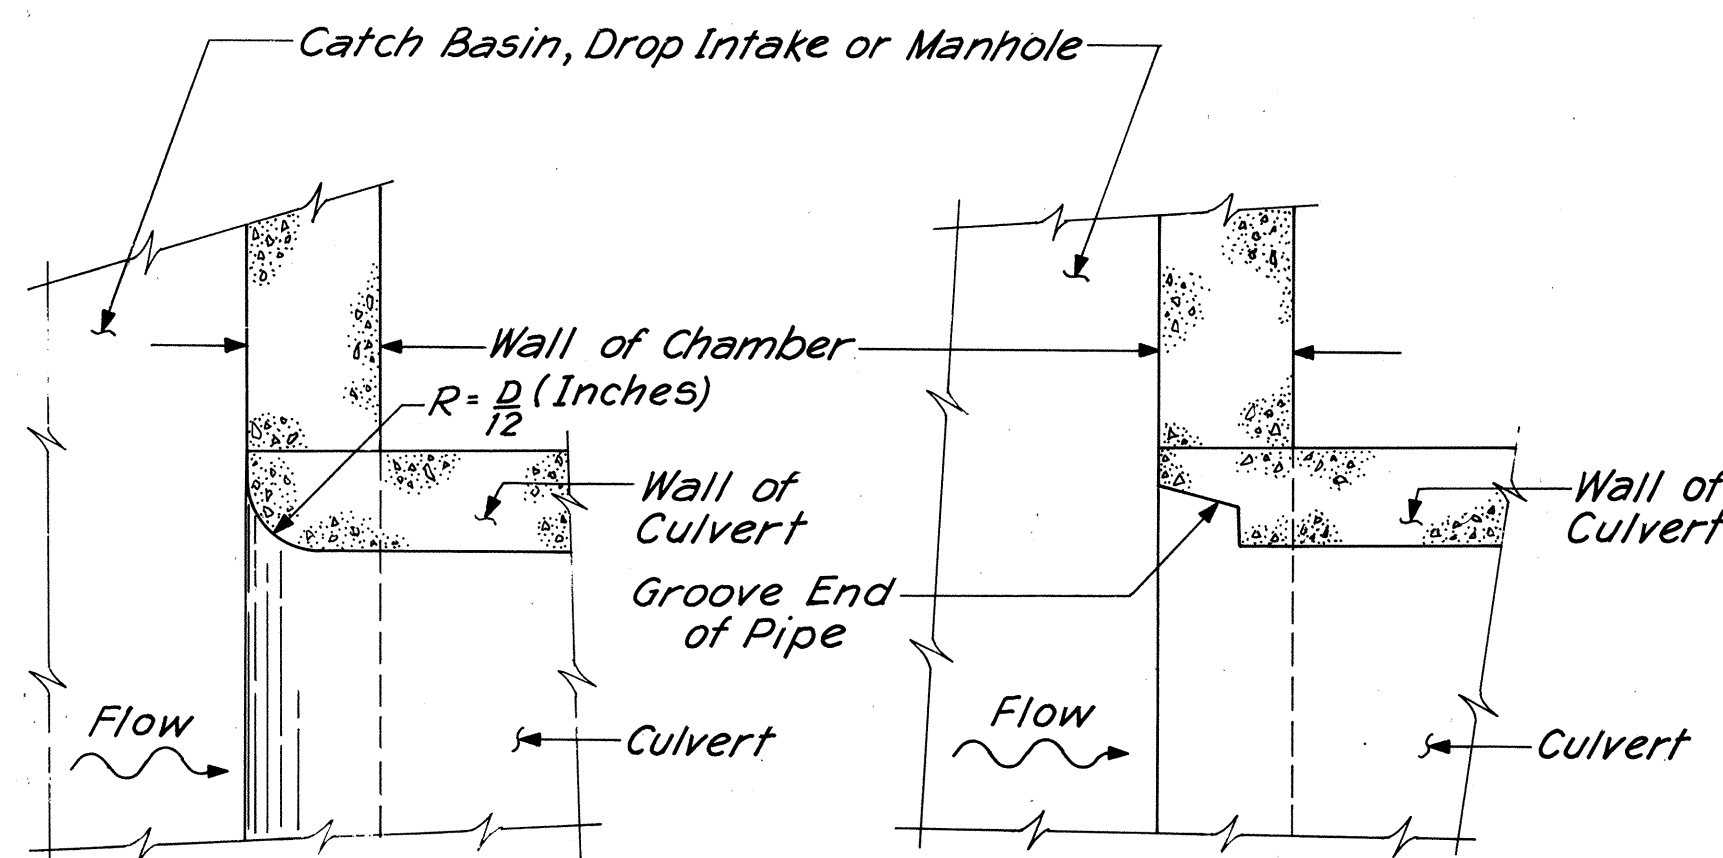

**TYPICAL DETAILS FOR CULVERTS EXITING
A CATCH BASIN, DROP INTAKE OR MANHOLE**
N.T.S.



THIS WORK WAS PREPARED BY
ME OR UNDER MY SUPERVISION.

J. Andrew Schuchard

STATE OF HAWAII
DEPARTMENT OF TRANSPORTATION
HIGHWAYS DIVISION

DRAINAGE DETAILS


INTERSTATE ROUTE H-1
PROJ. NO. I-H1-1(90):13

SCALE: AS SHOWN DATE:


SHEET No. 13 OF 25 SHEETS

SURVEY PLOTTED BY	DATE
DRAWN BY	
CHECKED BY	
NOTED BY	
QUANTITIES BY	
CHECKED BY	
ORIGINAL PLAN	
NOTE BOOK	
No.	

FED. ROAD DIST. NO.	STATE	FED. AID PROJECT	FISCAL YEAR	SHEET NO.	TOTAL SHEETS
HAWAII	HAWAII	I-H-1(90)13	1972	54	202

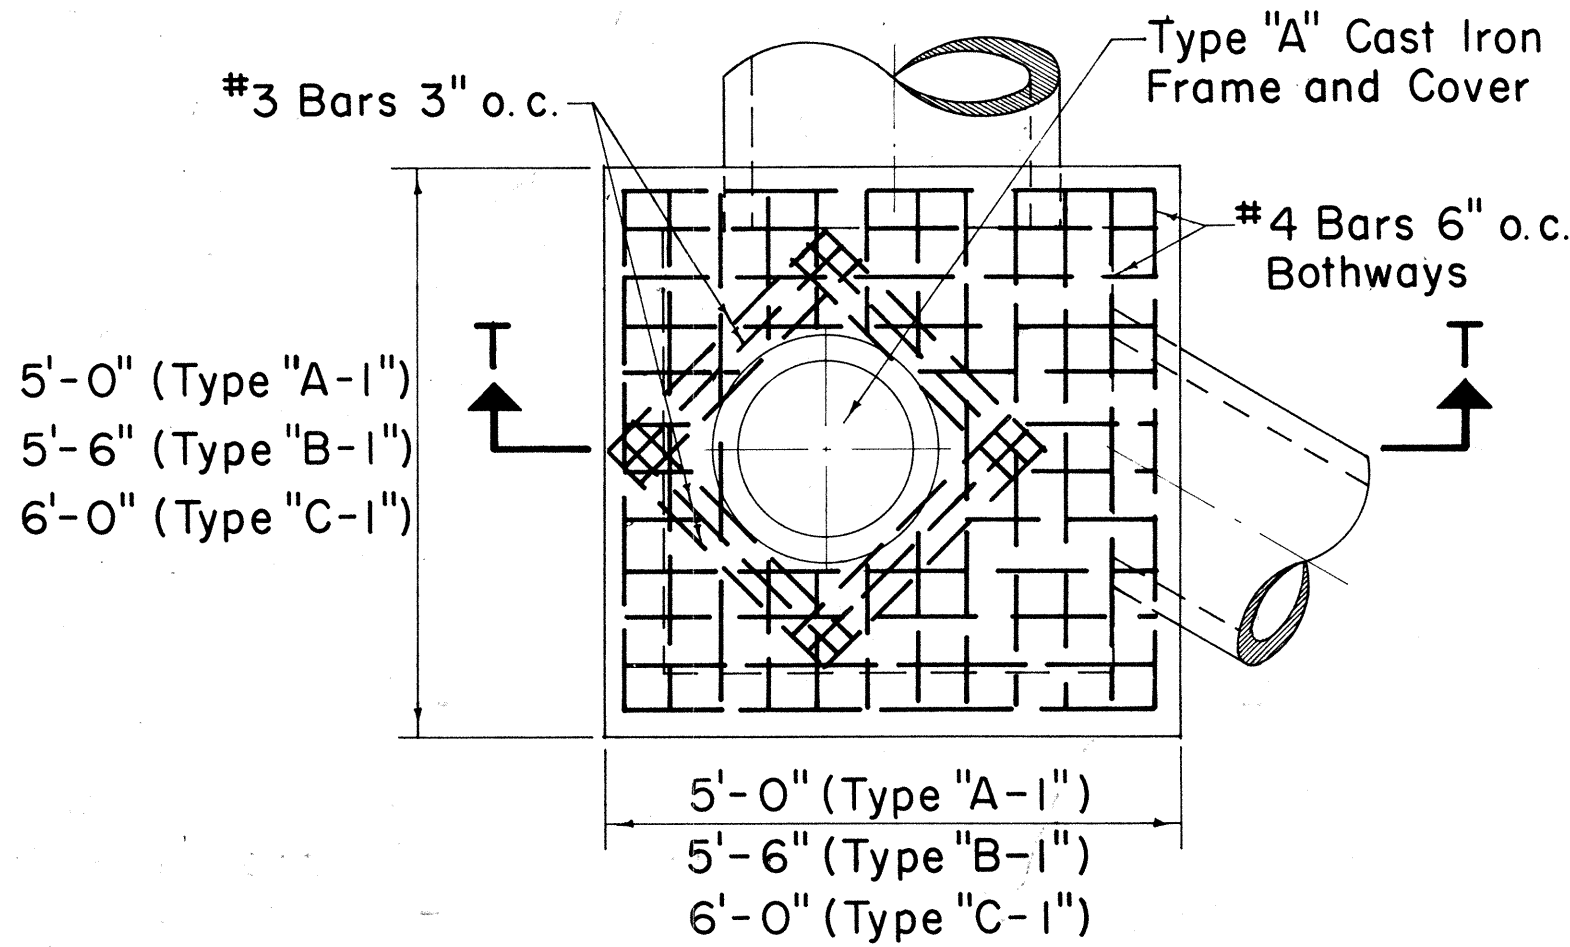

PLAN

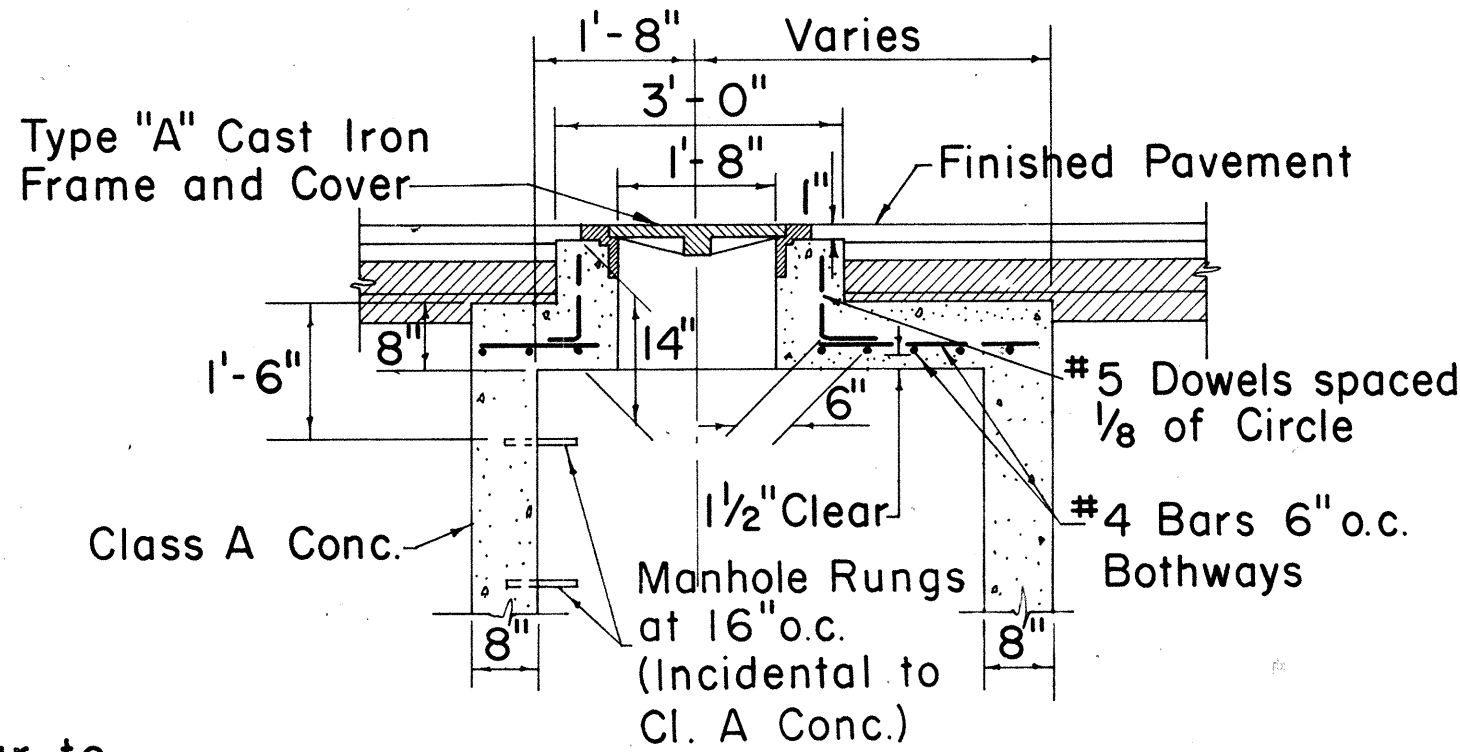

SECTION T-T


TYPE "A-I", "B-I", & "C-I"
STORM DRAIN MANHOLE
TOP DETAIL UNDER PAVEMENT

Scale: 1/2" = 1'-0"


Note:
Bottom detail similar to
Type "A", "B", & "C"

GENERAL NOTES


1. Culvert shall enter and leave S.D.M.H. from any position and in the direction indicated by the plans or ordered by the Engineer.
2. Manhole Rungs (16" o.c.) are required when "H" is greater than 4'-6". Only one rung (12" from the bottom) is required if "H" is 4'-6" or less. Type "A" C.I. Frame and Cover and Manhole Rungs may be placed at any location as ordered by the Engineer.

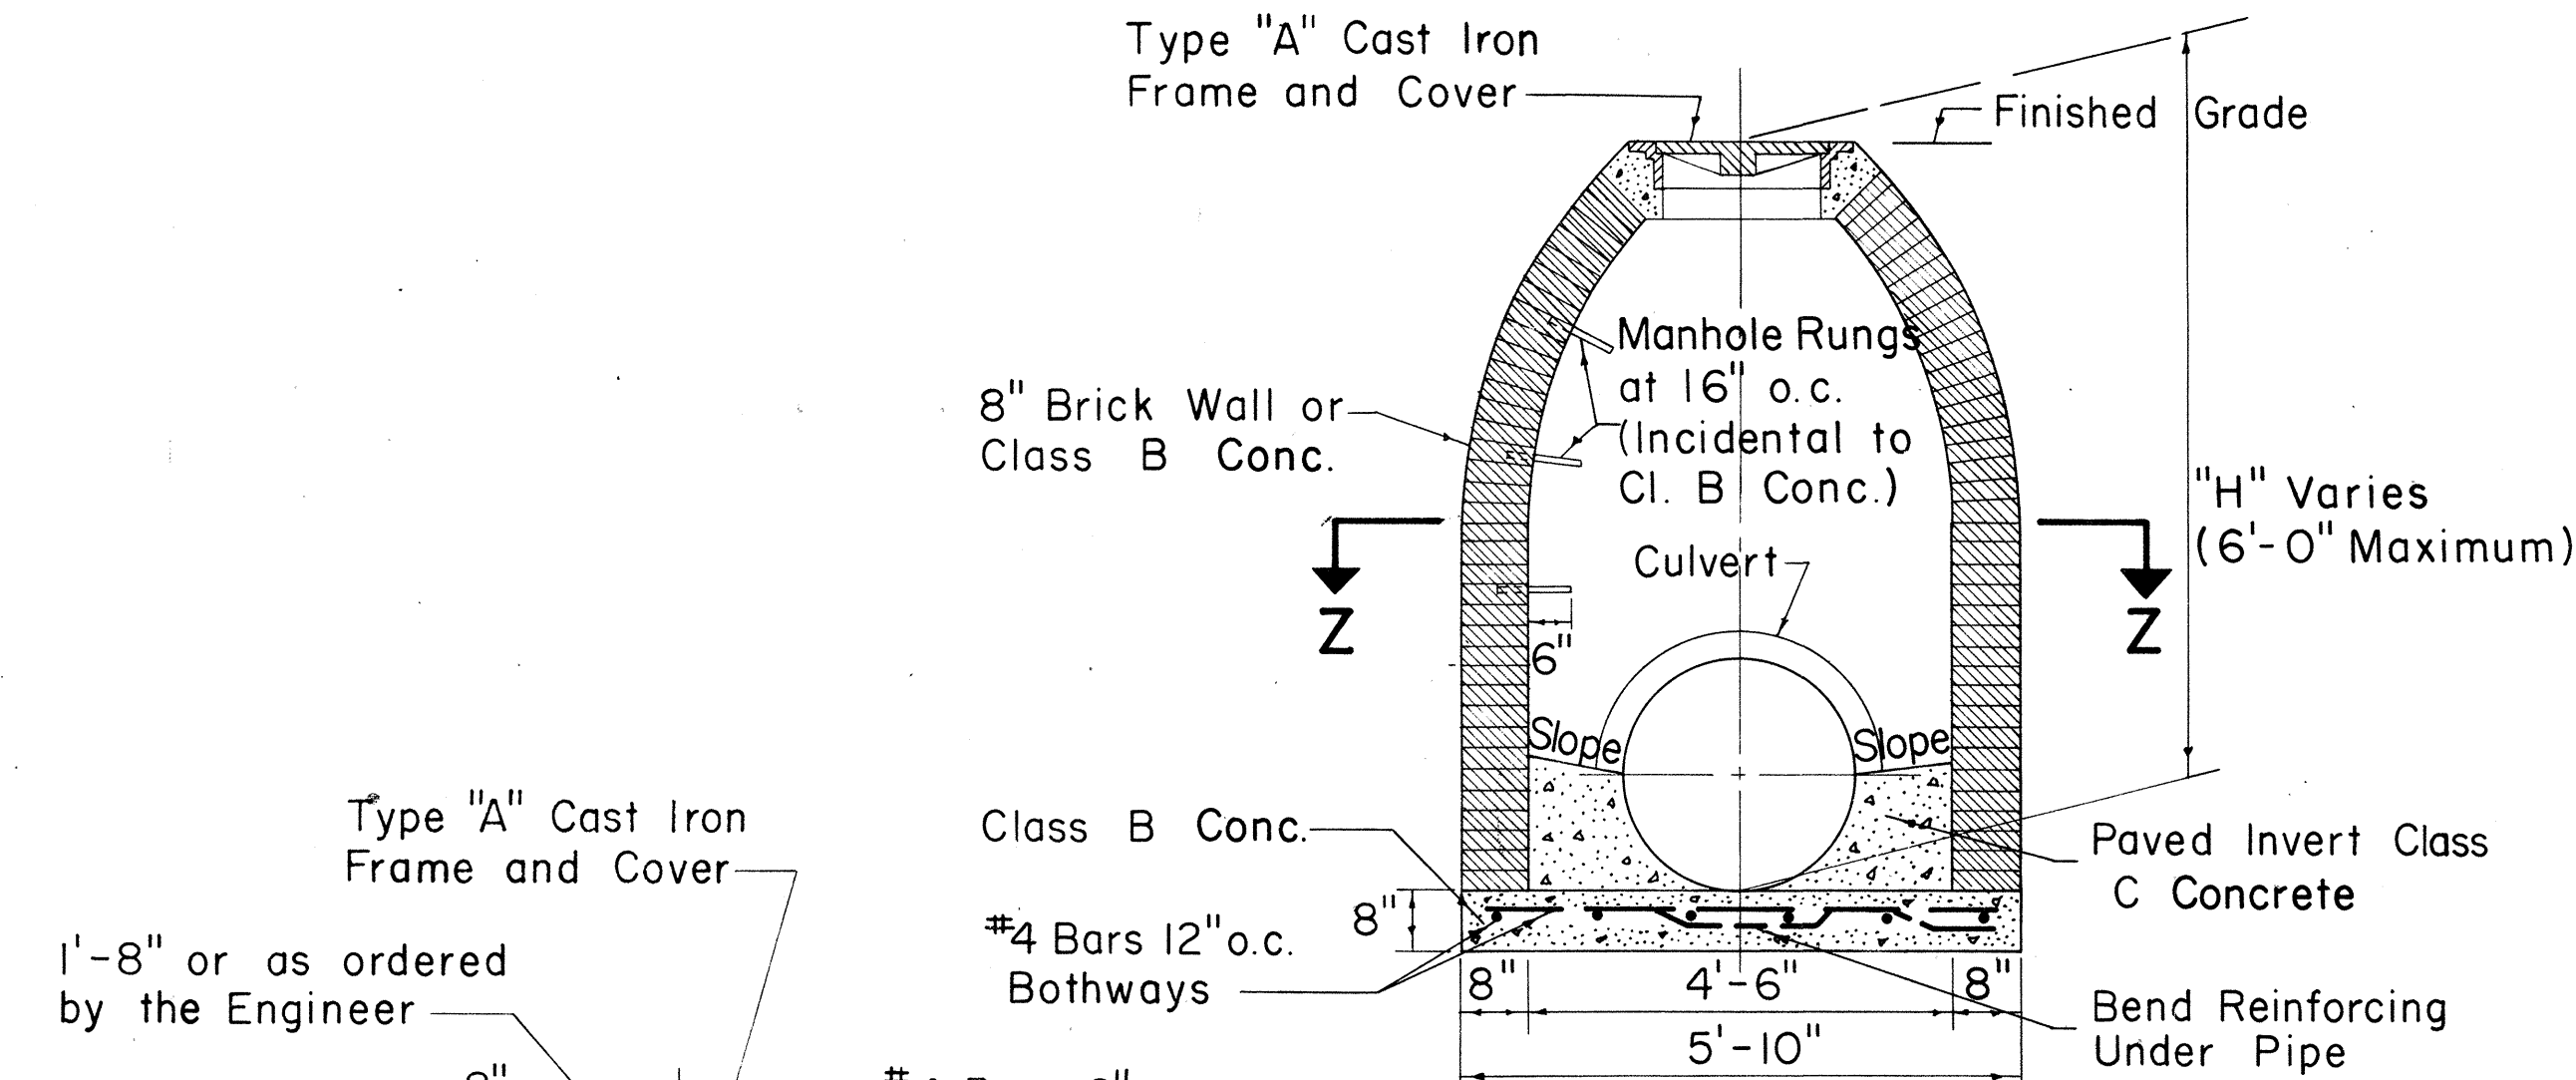

SECTION Y-Y

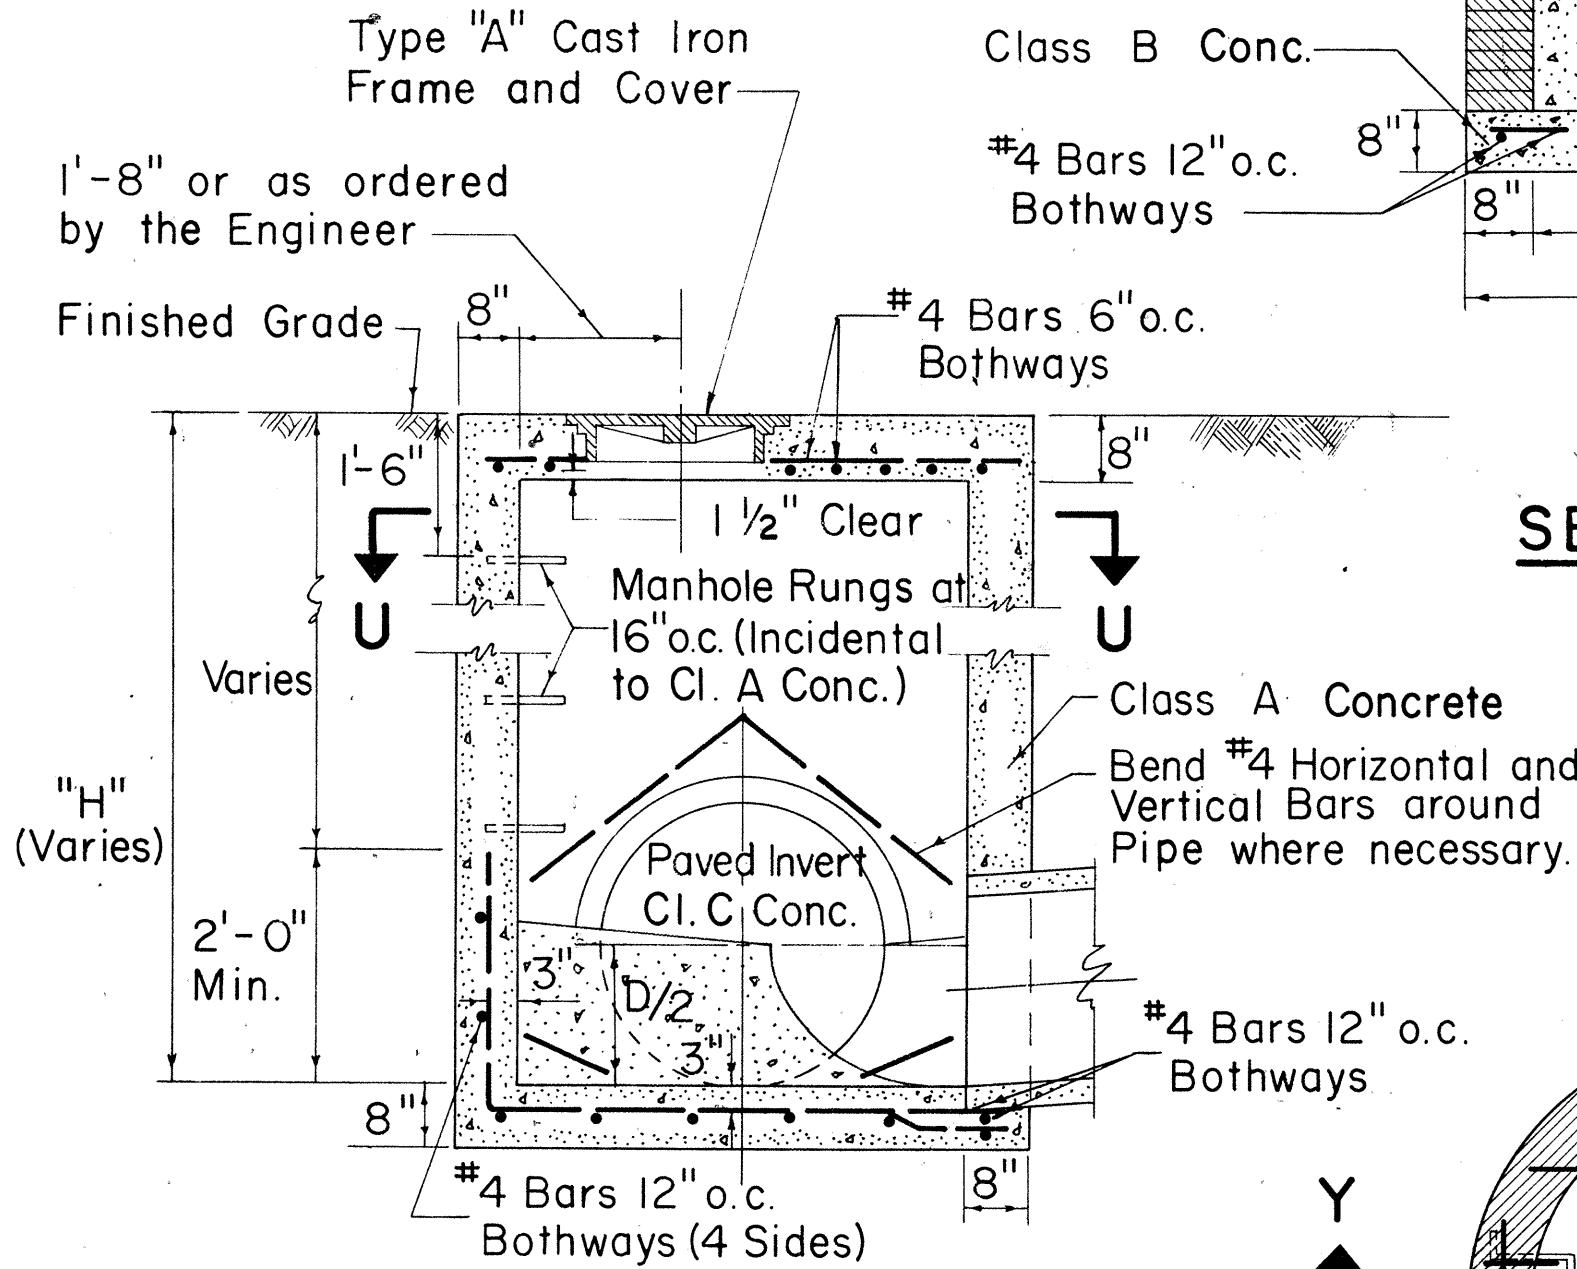

SECTION V-V

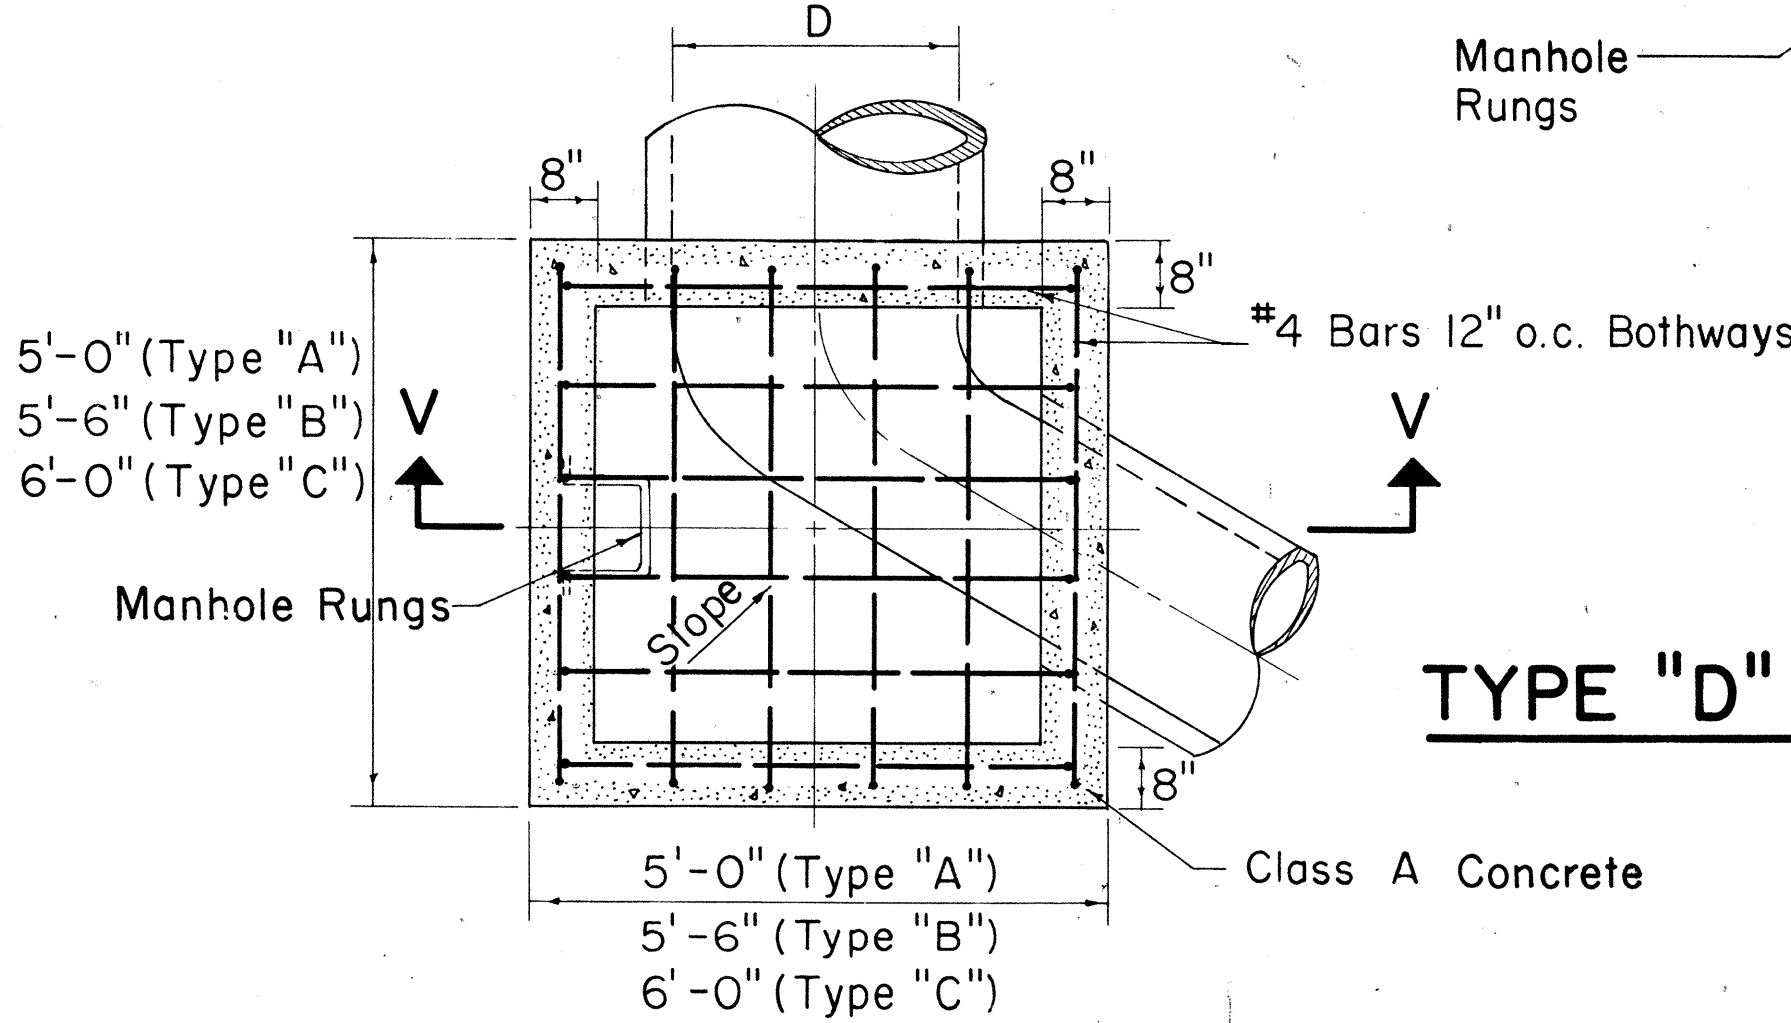


SECTION U-U

TYPE "A", "B", & "C"

S.D.M.H.


Scale: 1/2" = 1'-0"

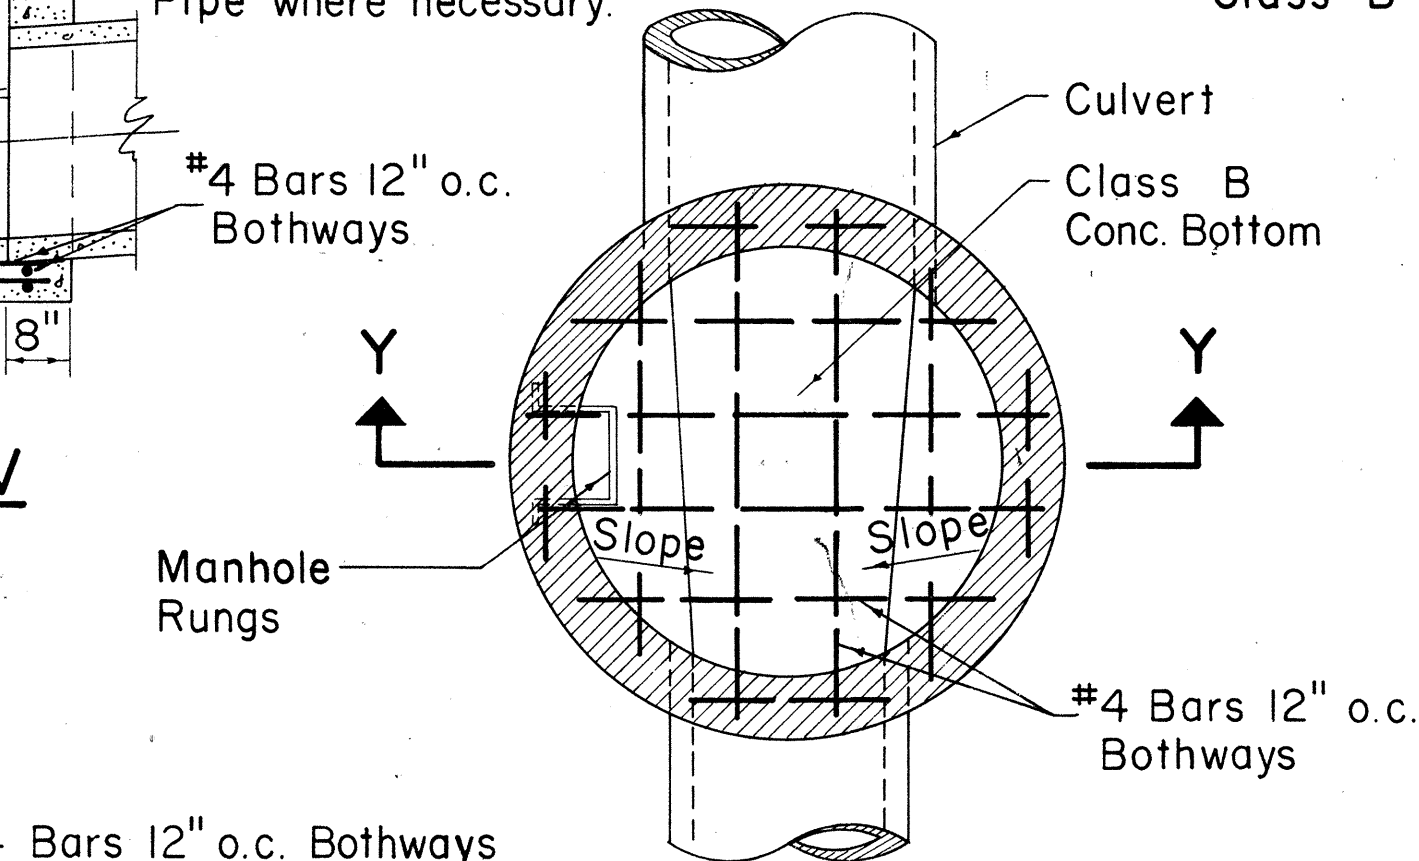


SECTION Z-Z

TYPE "D" STORM DRAIN MANHOLE

Scale: 1/2" = 1'-0"

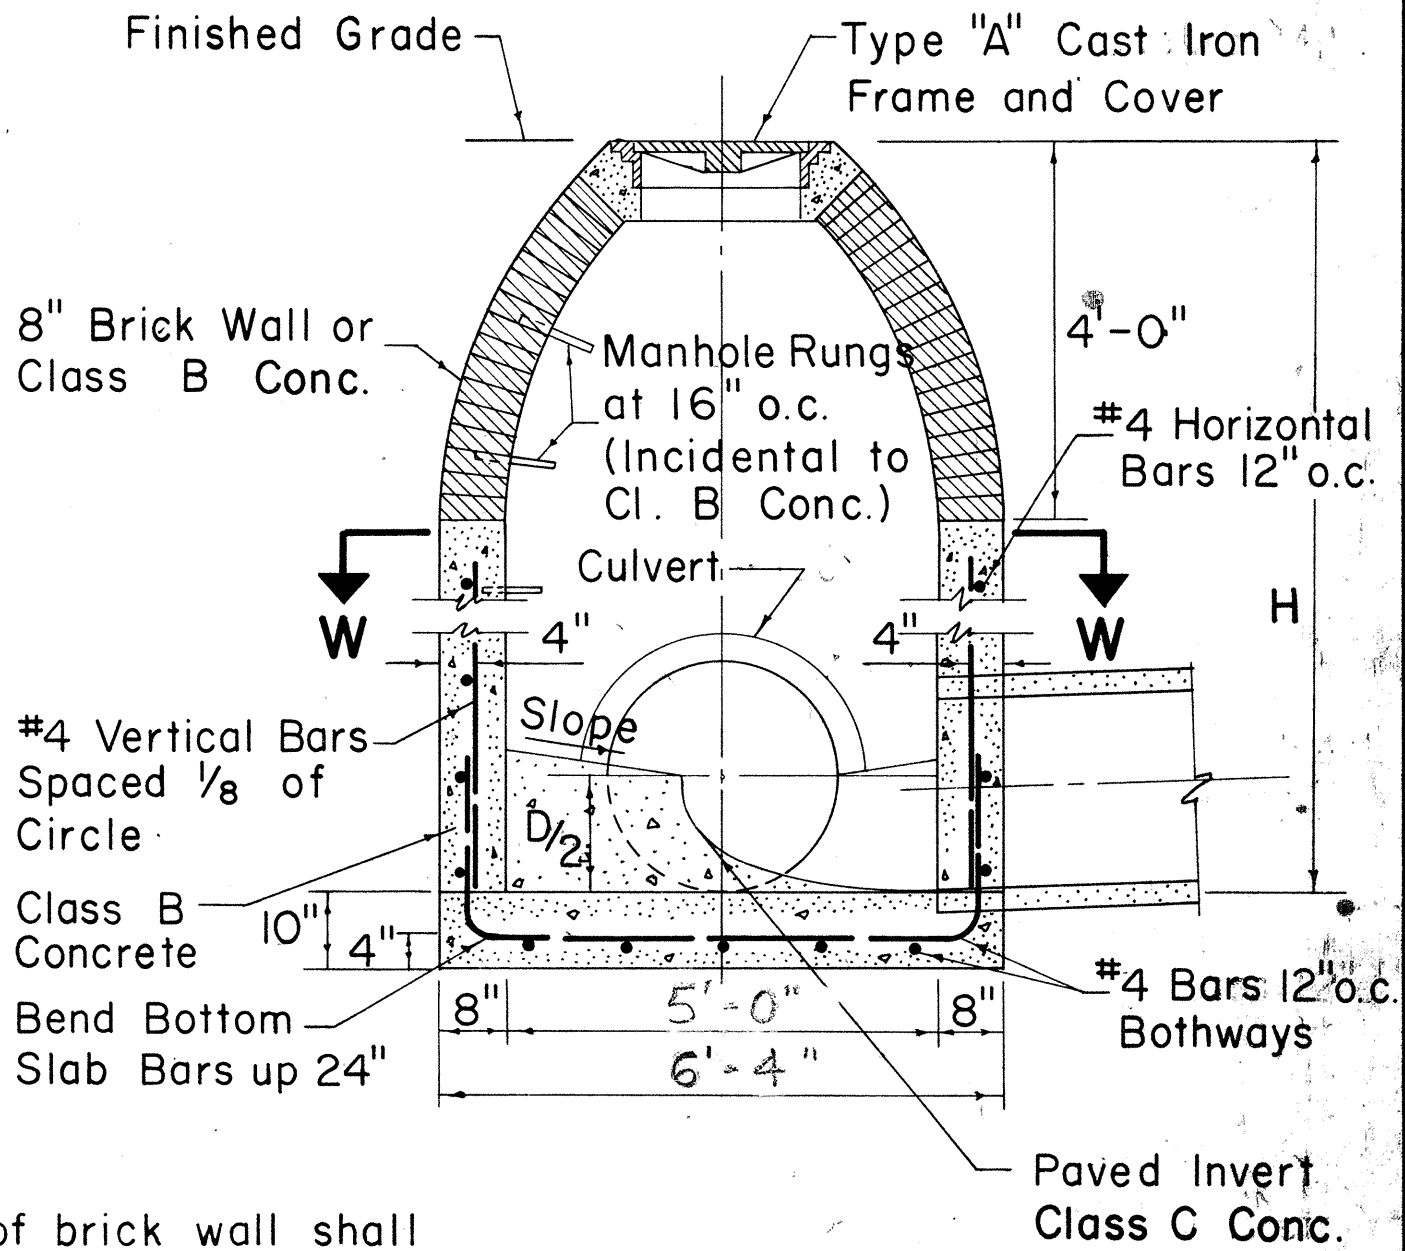


SECTION X-X

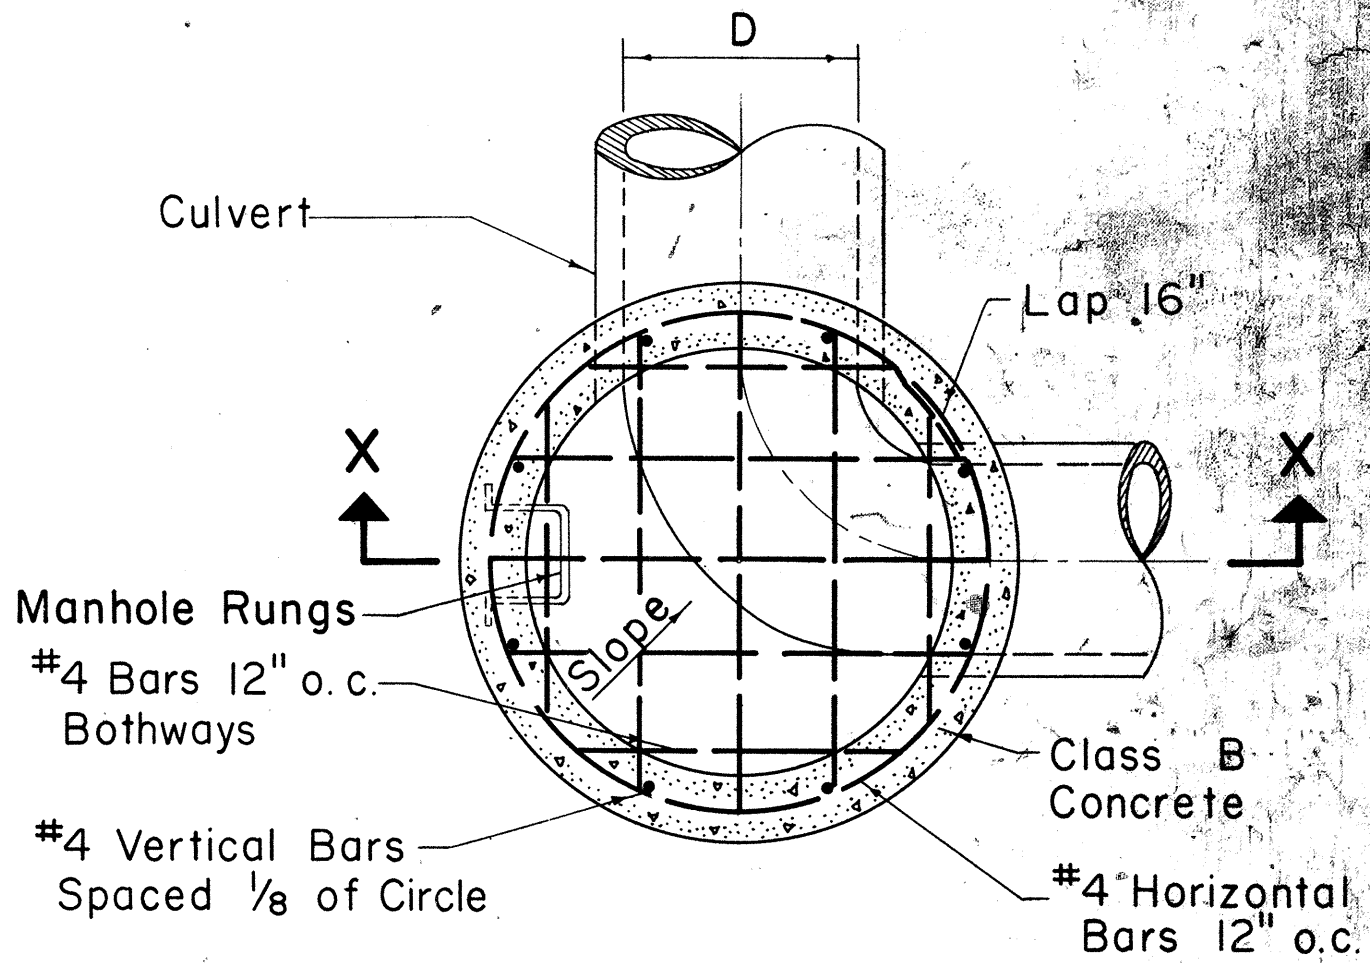

SECTION W-W

TYPE "E" STORM DRAIN MANHOLE

Scale: 1/2" = 1'-0"

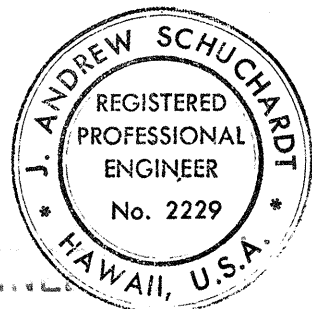

THIS WORK WAS PREPARED BY
ME OR UNDER MY SUPERVISION.

NO.	REVISION	APPROVED BY	DATE


STATE OF HAWAII
DEPARTMENT OF TRANSPORTATION
HIGHWAYS DIVISION

STORM DRAIN MANHOLES


Scales: As Noted Date: July 1, 1969

SHEET NO. 14 OF 25 SHEETS DH 5


FED. ROAD DIST. NO.	STATE	FED. AID PROJ. NO.	FISCAL YEAR	SHEET NO.	TOTAL SHEETS
HAWAII	HAW.	I-H-1(90):13	1972	55	202

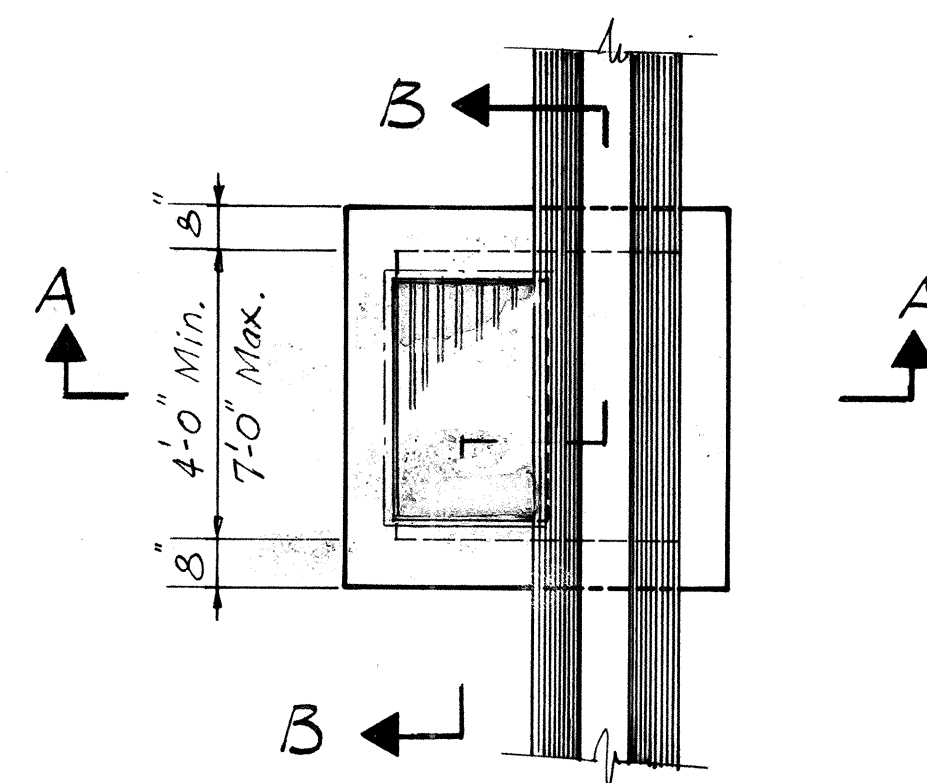

PLAN
3' = 1'-0"

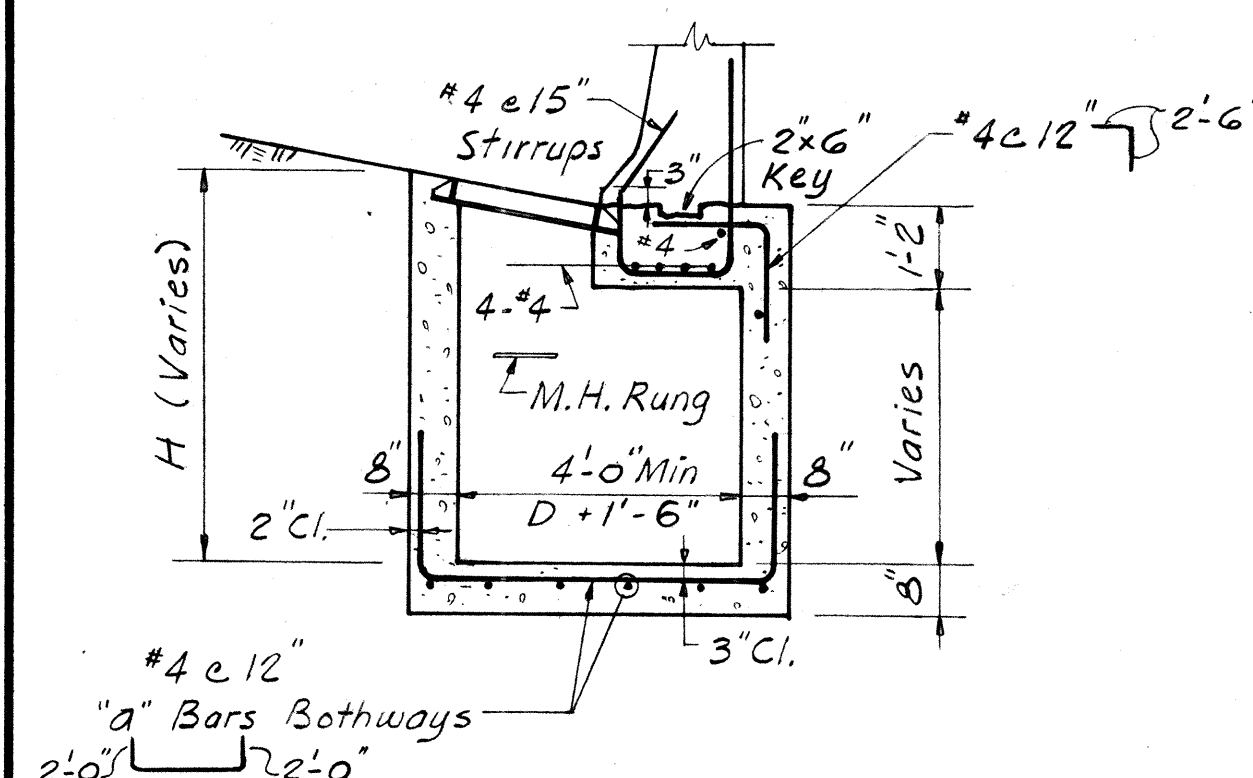


SECTION A-A
3' = 1'-0"

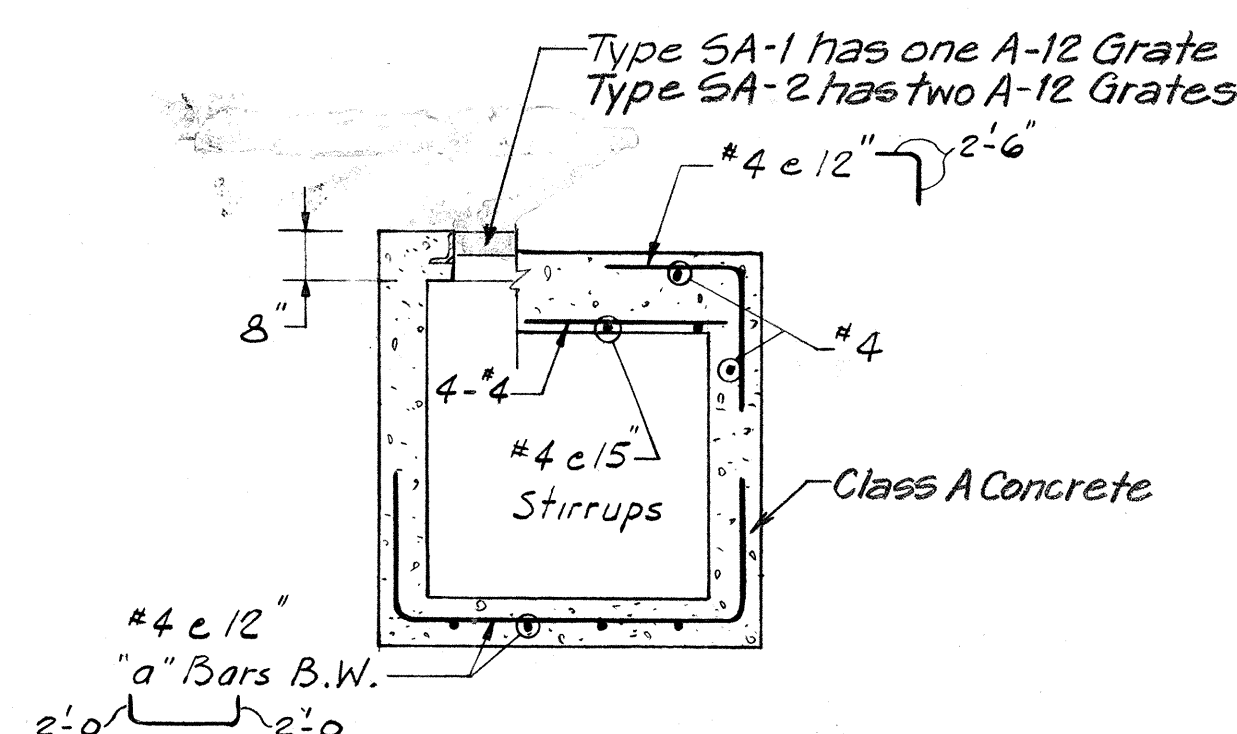


SECTION B-B
3' = 1'-0"


CATCH BASIN TYPE SA

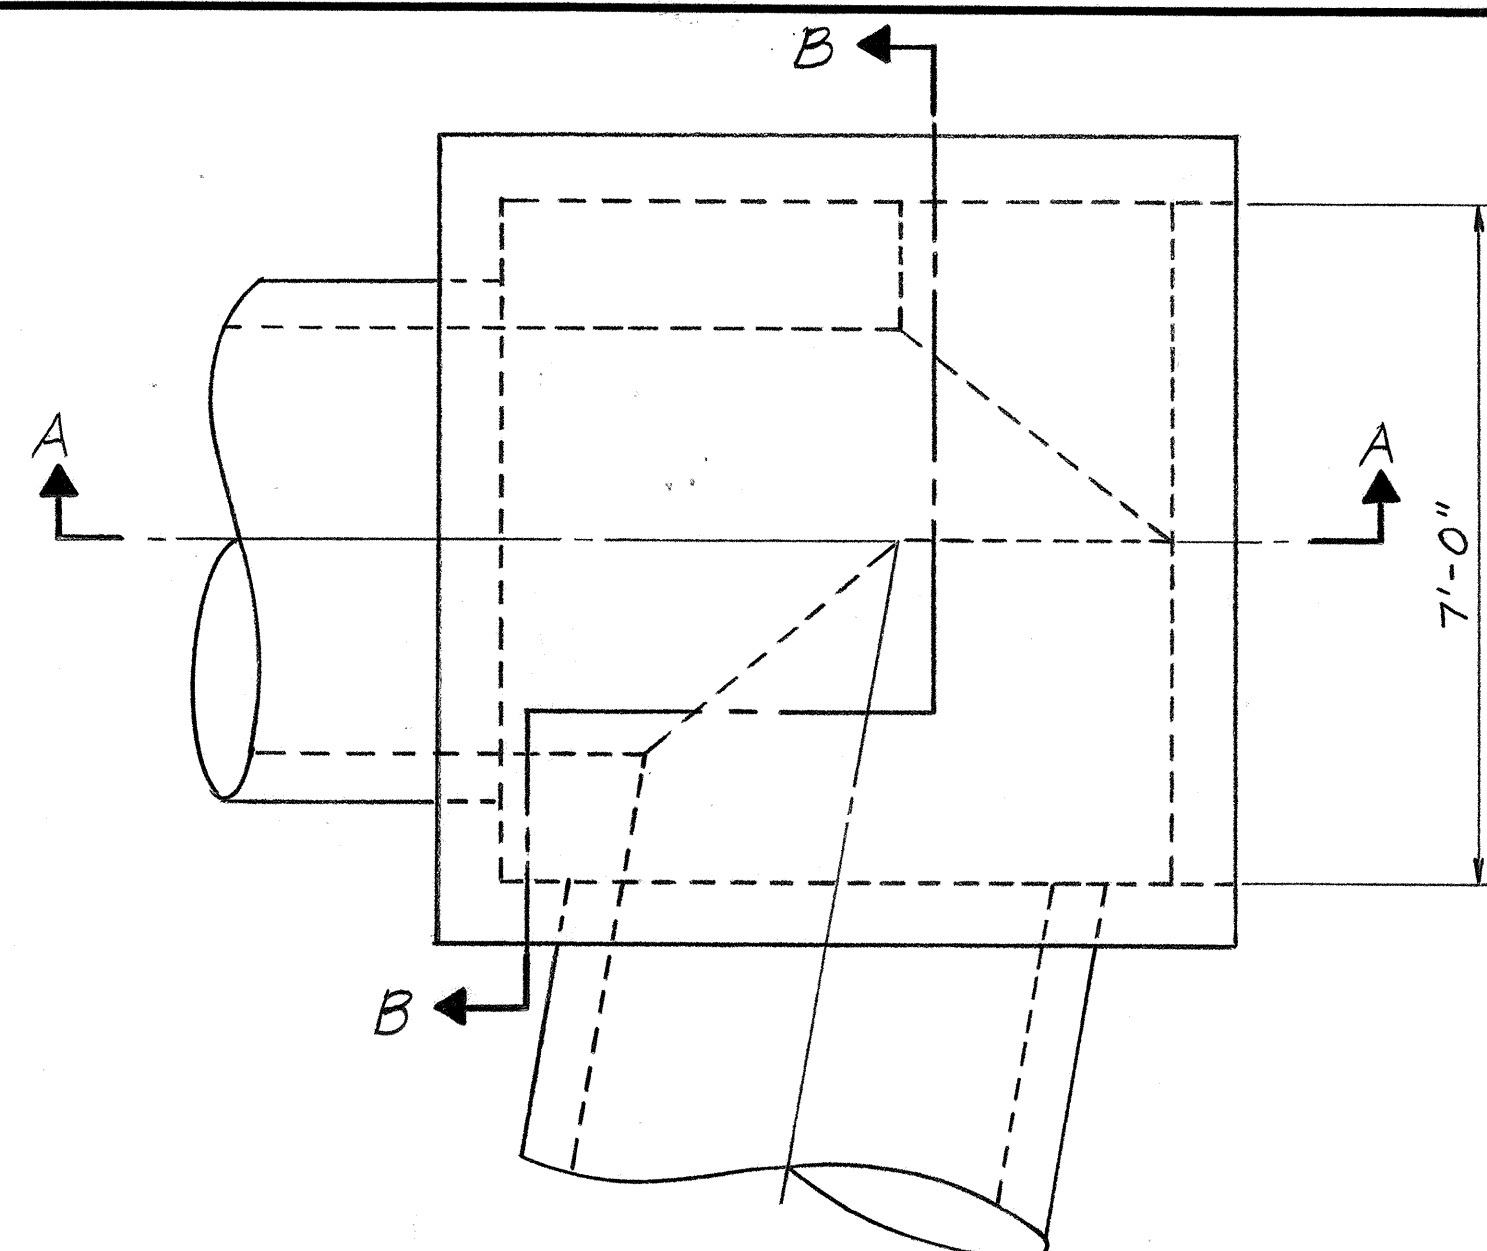

PLAN
1/2" = 1'-0"

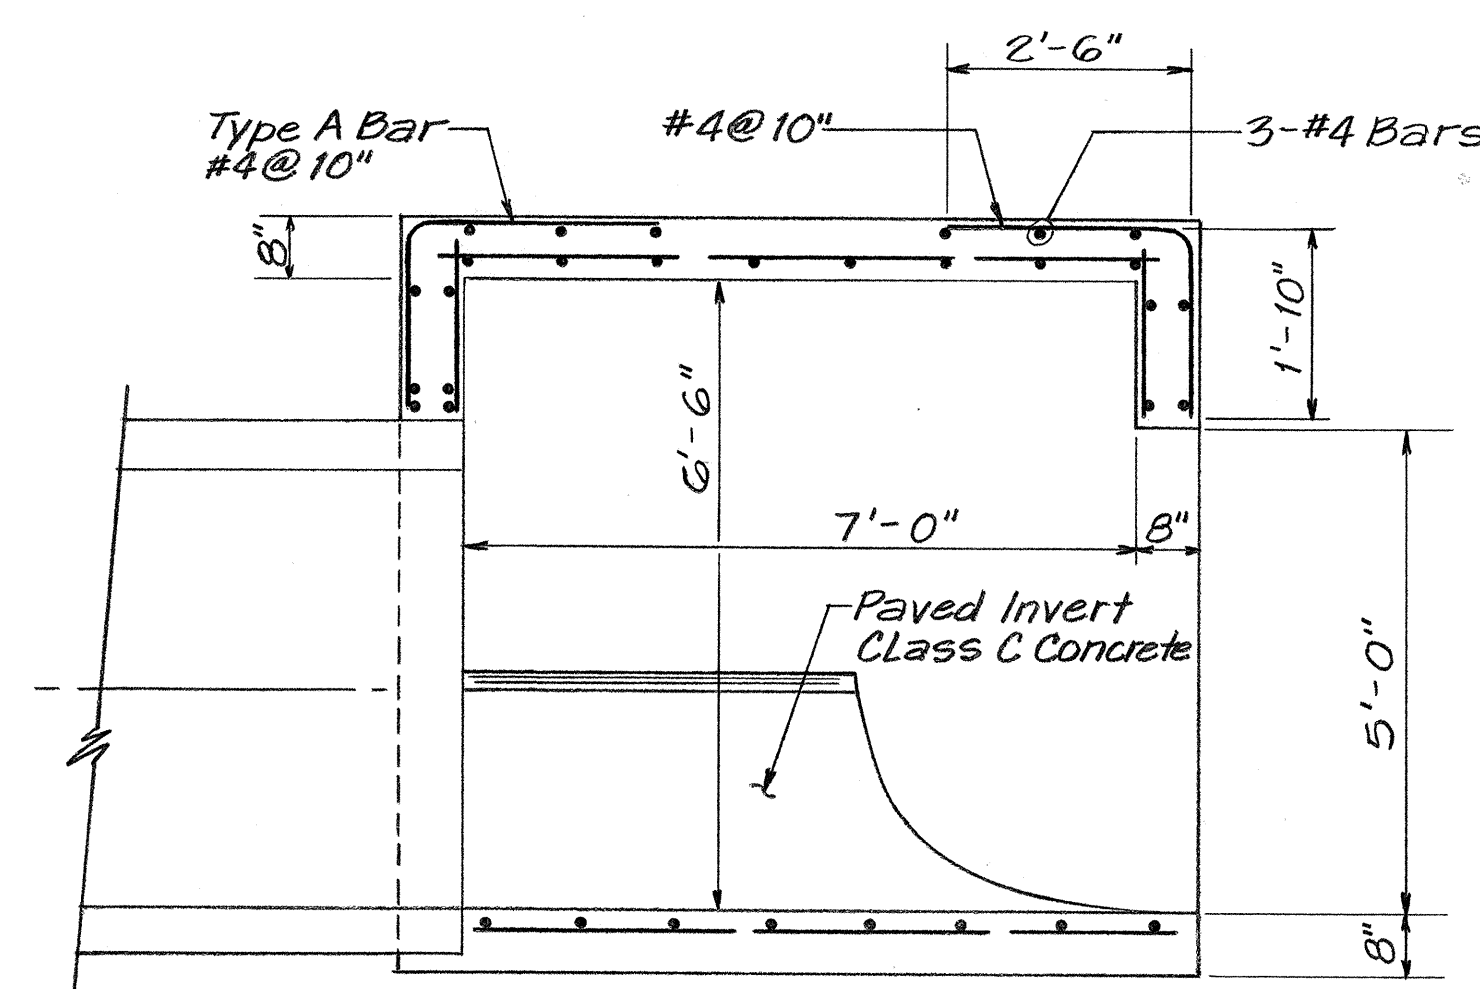


SECTION A-A
1/2" = 1'-0"

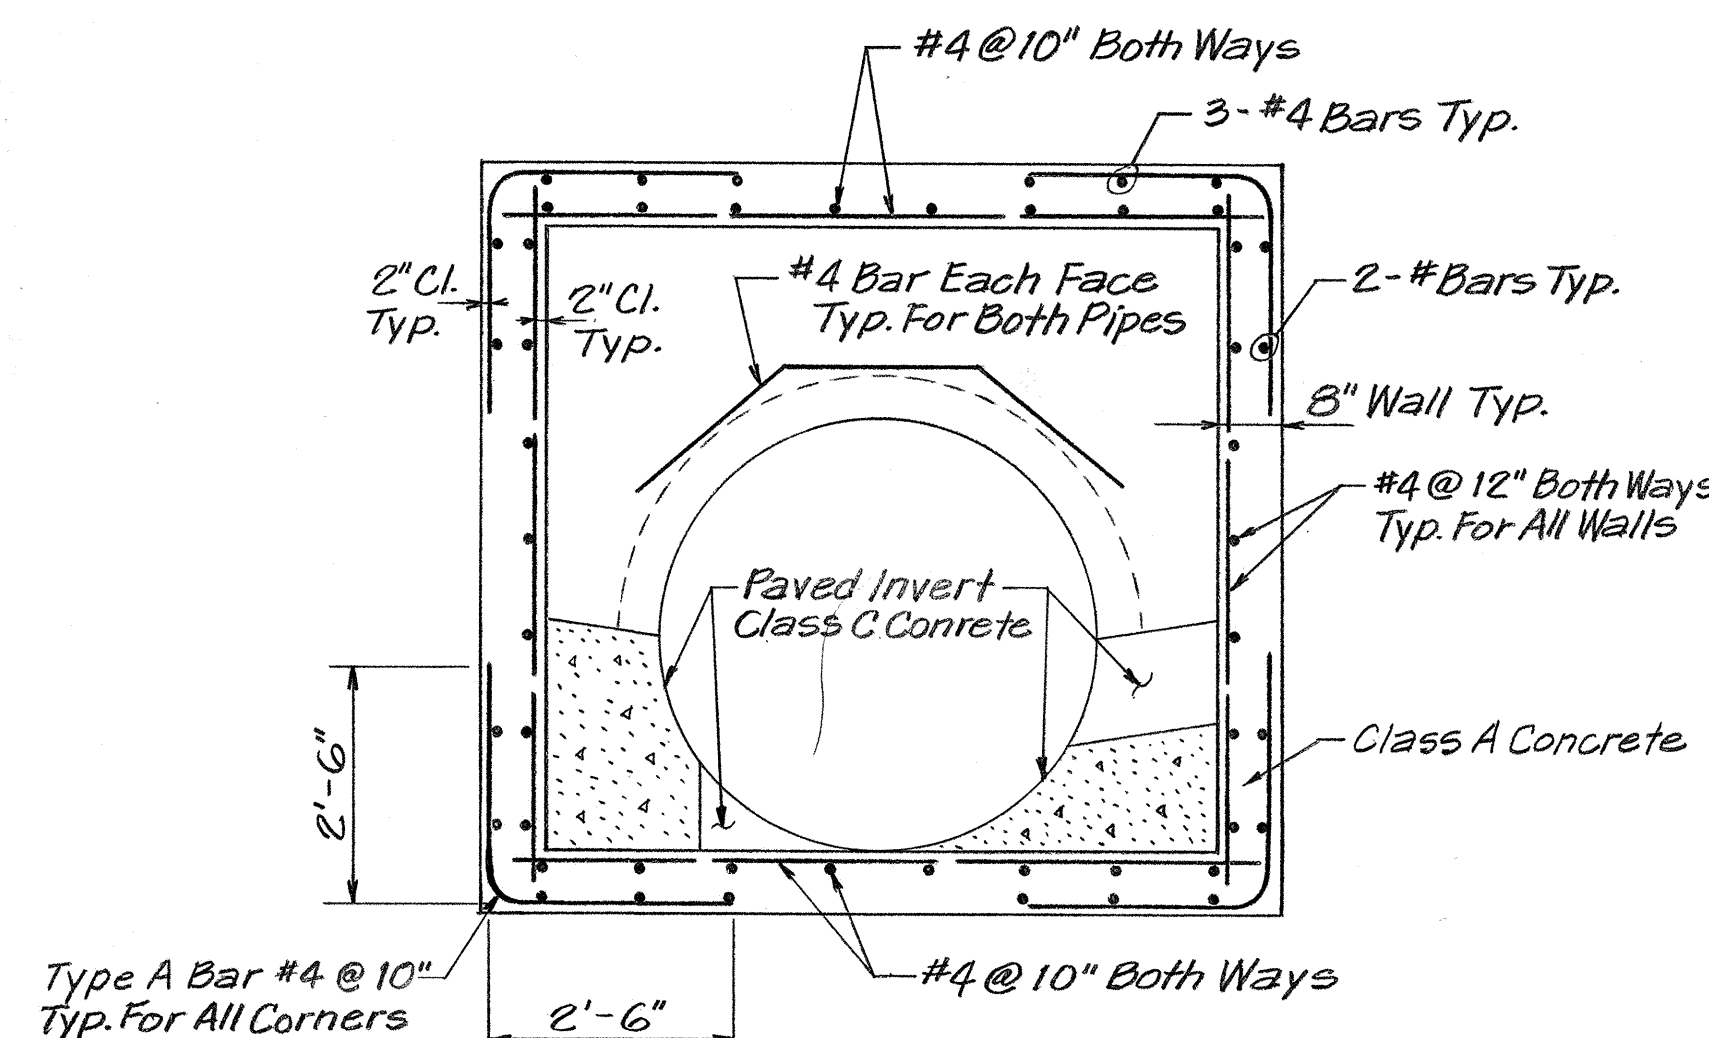


SECTION B-B
1/2" = 1'-0"

SPECIAL INLET #11

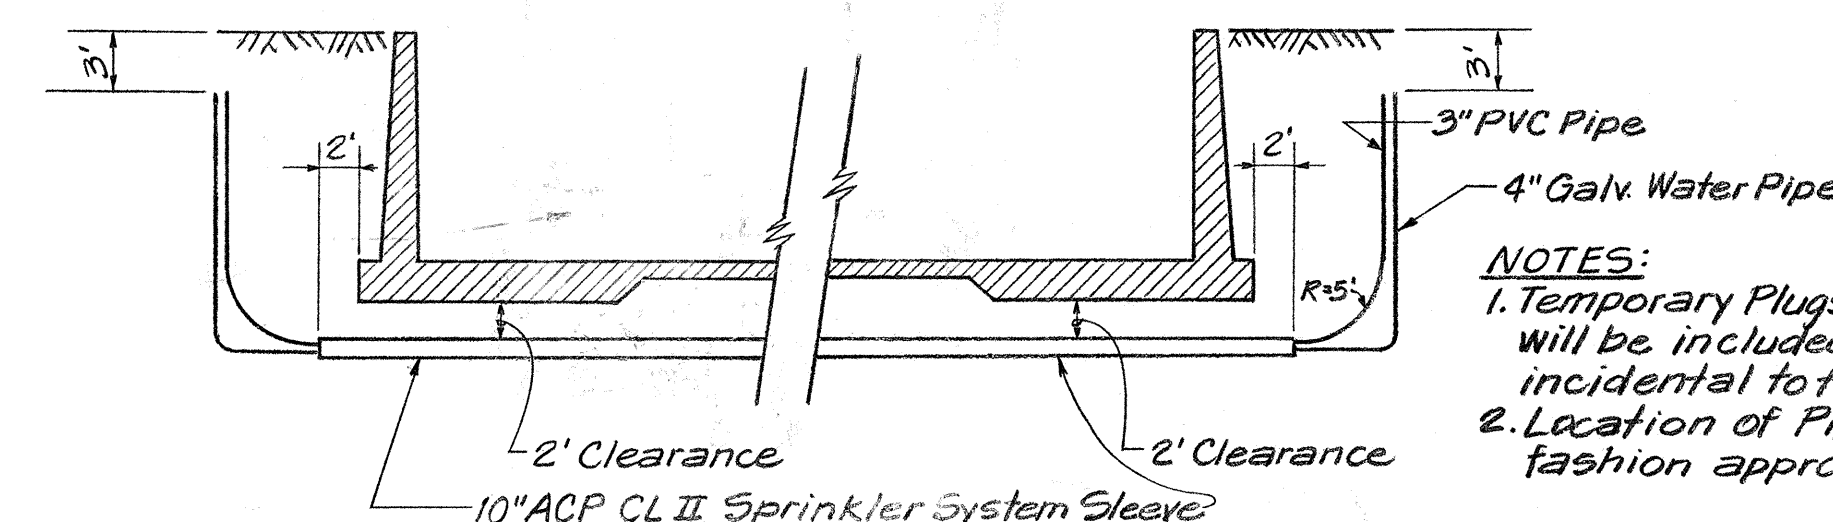


TYPICAL PROFILE FOR SPRINKLER SYSTEM SLEEVE UNDER CHANNELS & DITCHES
NOT TO SCALE

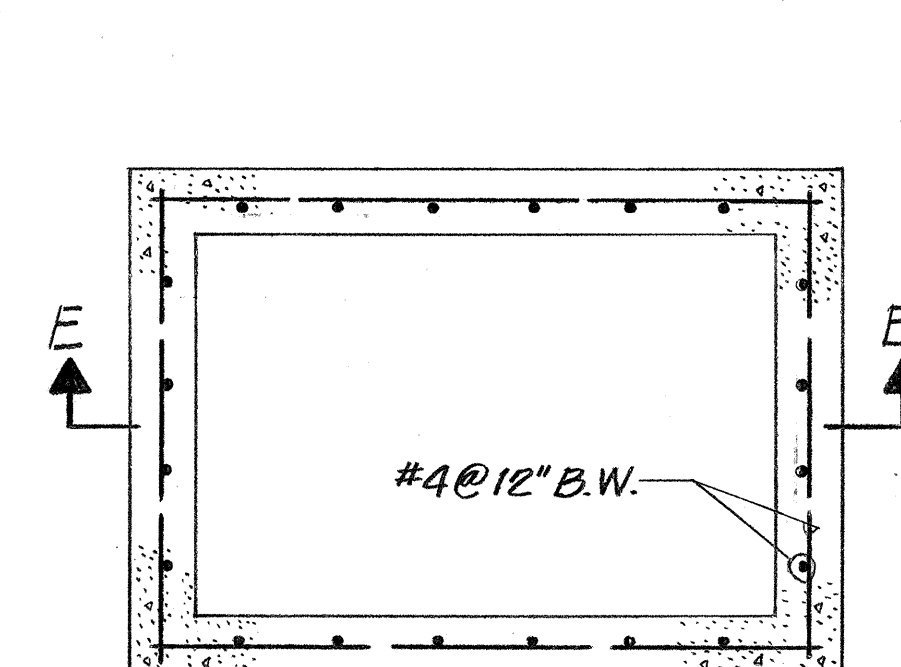

PLAN SECTION
1/2" = 1'-0"

TYPICAL WALL REINFORCING FOR CATCH BASIN AND DROP INTAKES WHEN "H" EXCEEDS 6'-0"

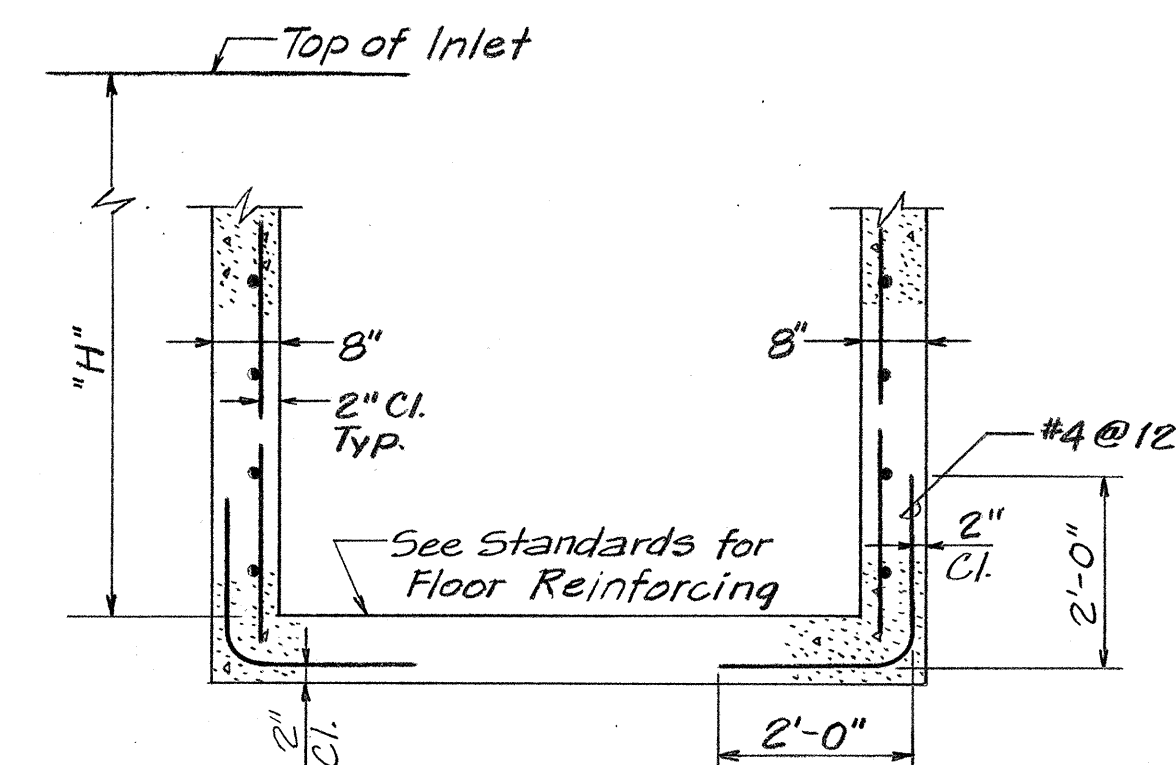


SECTION E-E
1/2" = 1'-0"

GENERAL NOTES

1. The lateral limits for Payment of Structural Excavation for Drainage Structures shall be the vertical surface one foot outside the exterior face of walls.
2. Manhole Rungs (16" o.c.) are required when "H" is greater than 4 feet 6 inches. Only one rung (12 inches from the bottom) is required if "H" is 4 feet 6 inches or less. The Manhole Rungs may be placed at any location as ordered by the Engineer.
3. Provide 2-#4 bent bars each face, top & bottom around culvert pipes.
4. All Class C Concrete to be incidental to Class A Concrete.

- NOTES:
1. Temporary Plugs approved by the Engineer will be included and installed and be incidental to the cost of the pipes.
 2. Location of Pipes are to be marked in a fashion approved by the Engineer.

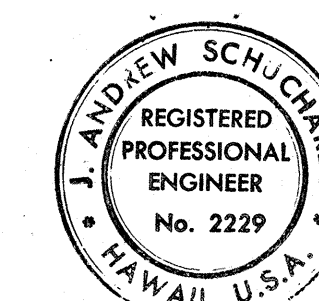

THIS WORK WAS PREPARED BY
ME OR UNDER MY SUPERVISION
Andrew Schuchardt

STATE OF HAWAII
DEPARTMENT OF TRANSPORTATION
HIGHWAYS DIVISION

DRAINAGE DETAILS











INTERSTATE ROUTE H-1
PROJECT No. I-H-1 (90):13

SCALE: AS SHOWN DATE: DEC. 24, 1970

SHEET No. 150 OF 25 SHEETS

55

FED. ROAD DIST. NO.	STATE	FED. AID PROJ. NO.	FISCAL YEAR	SHEET NO.	TOTAL SHEETS
HAWAII	HAW.	1-11-1(70)13	1972	56	202

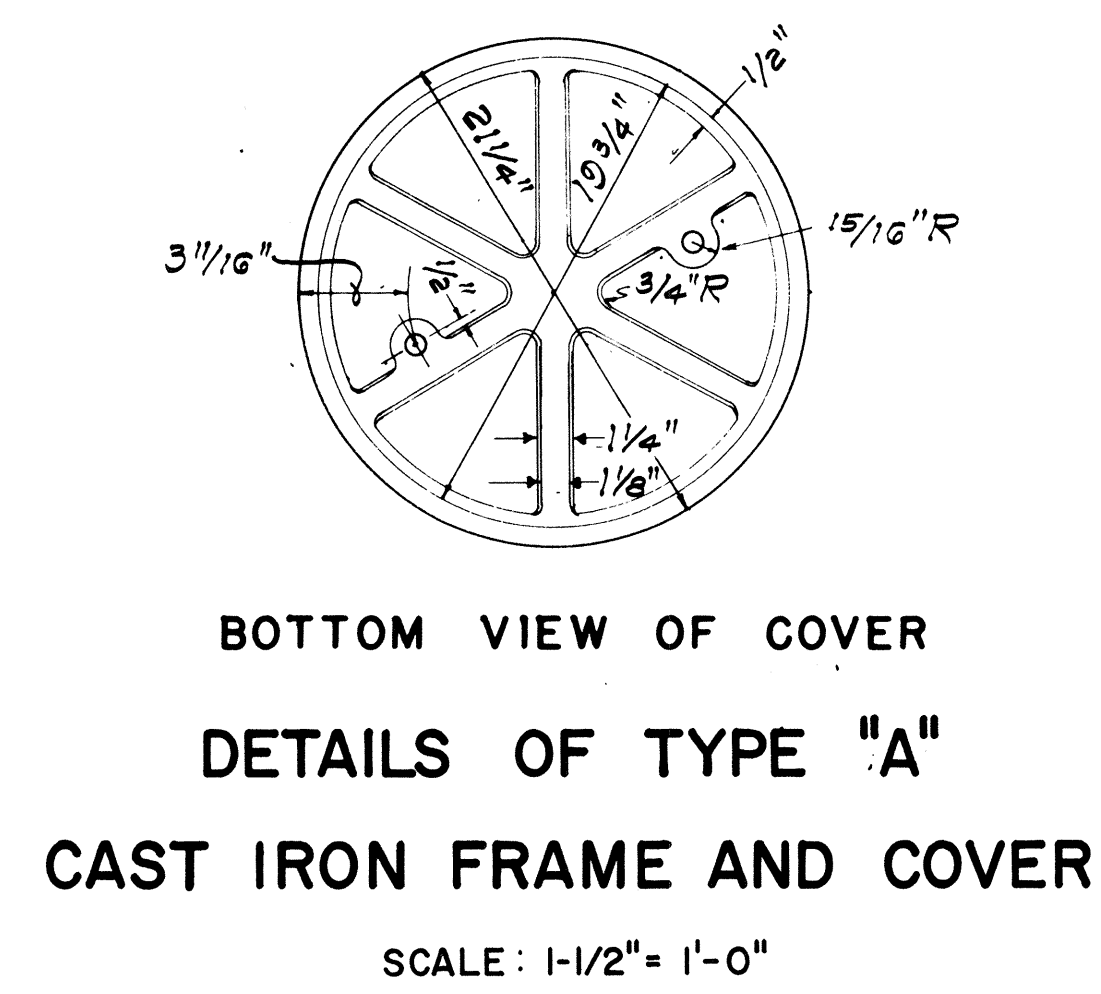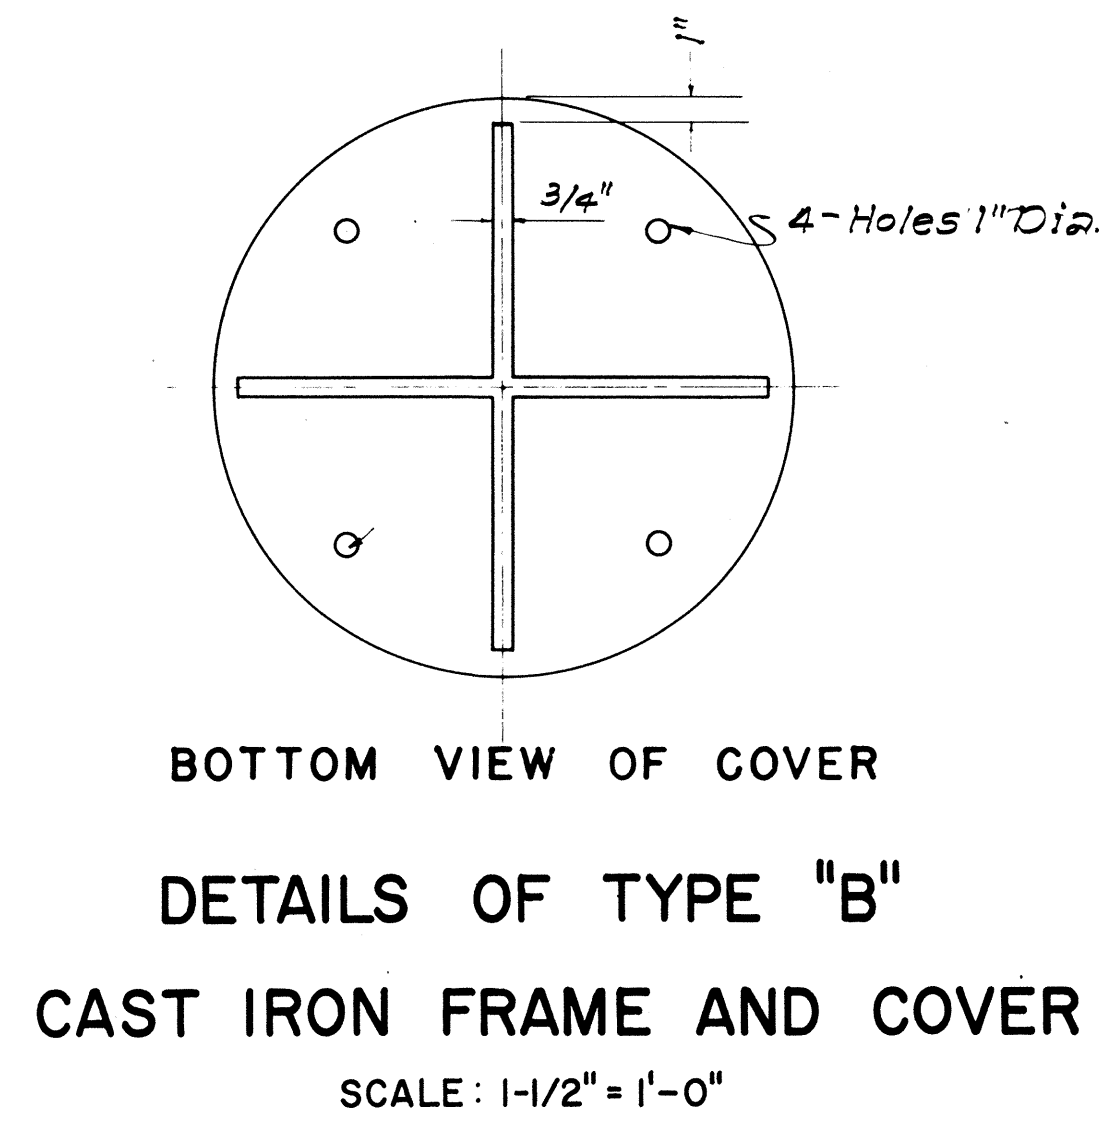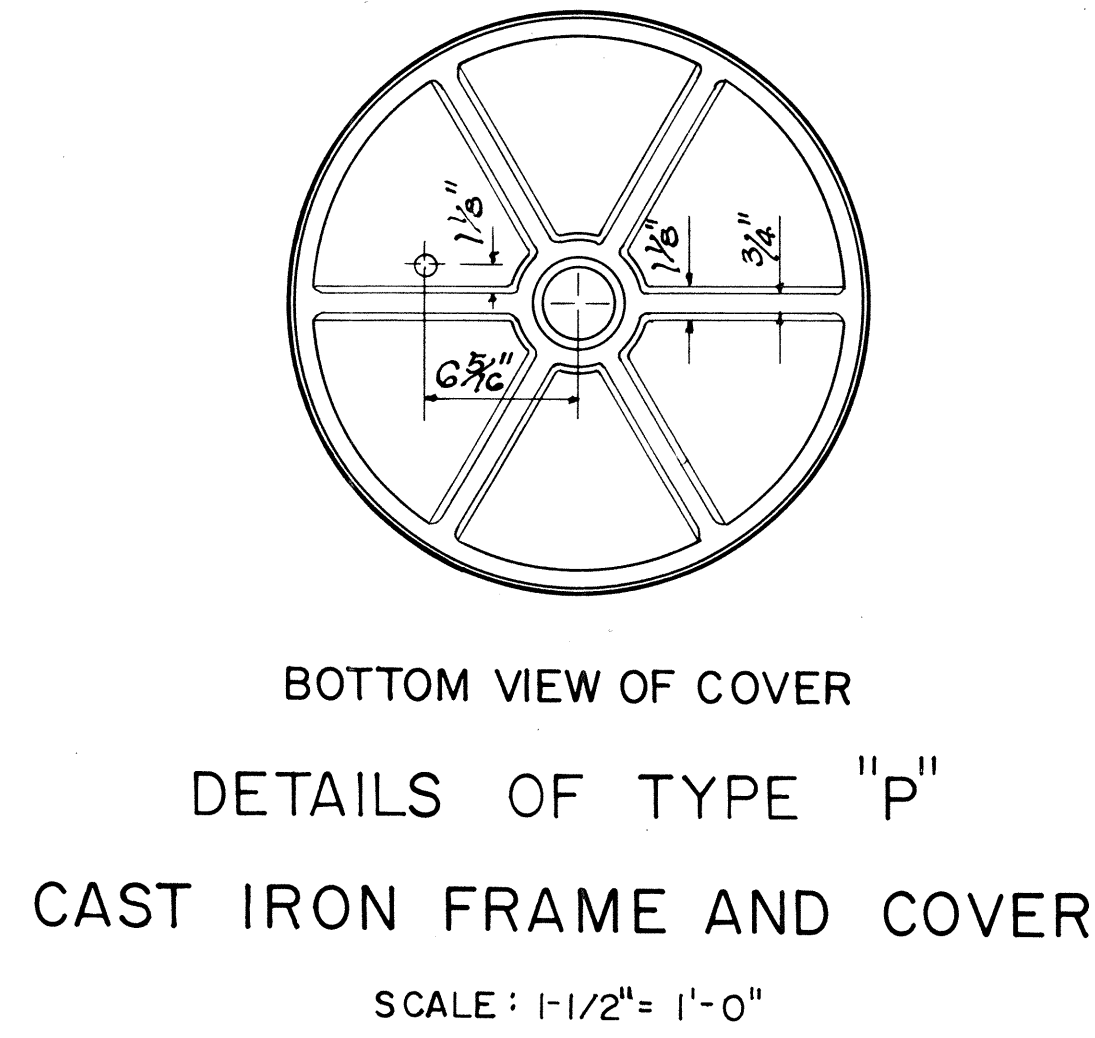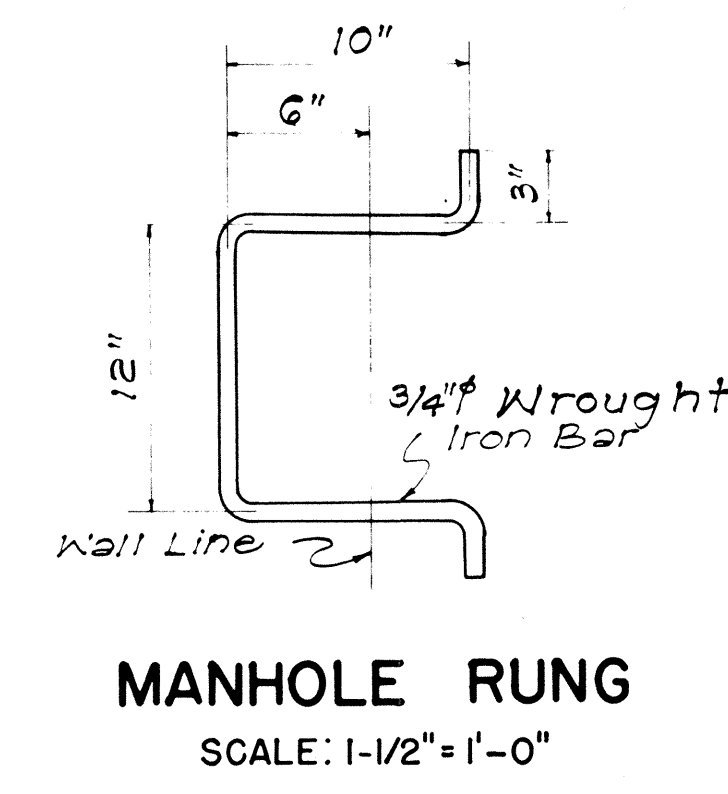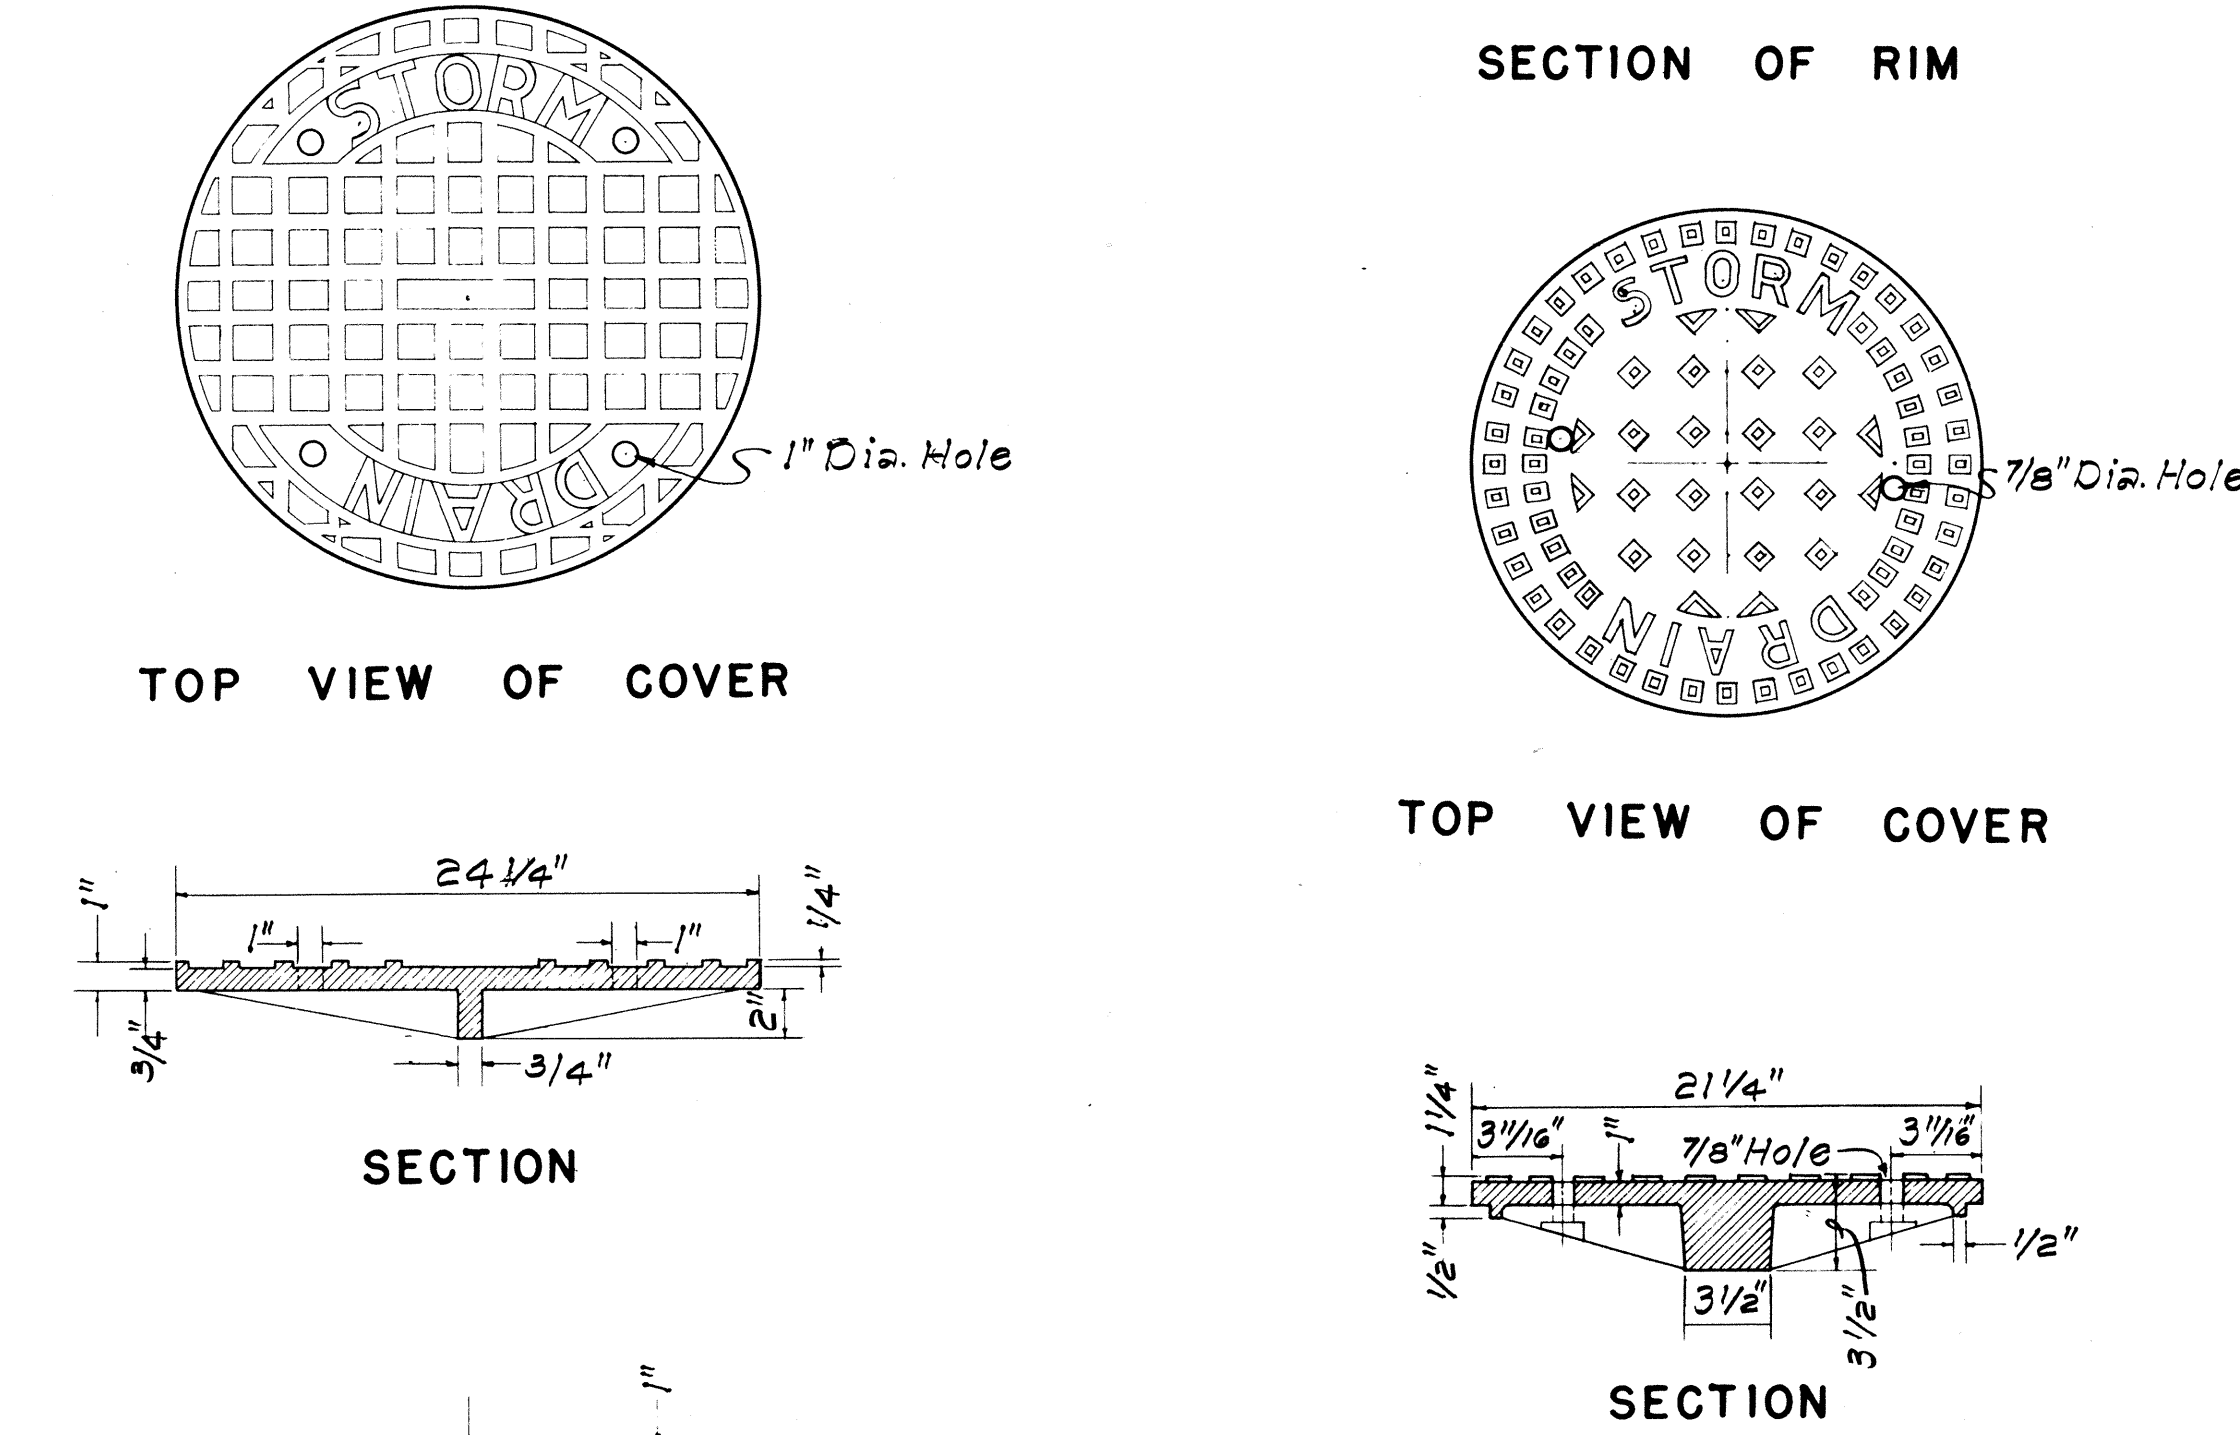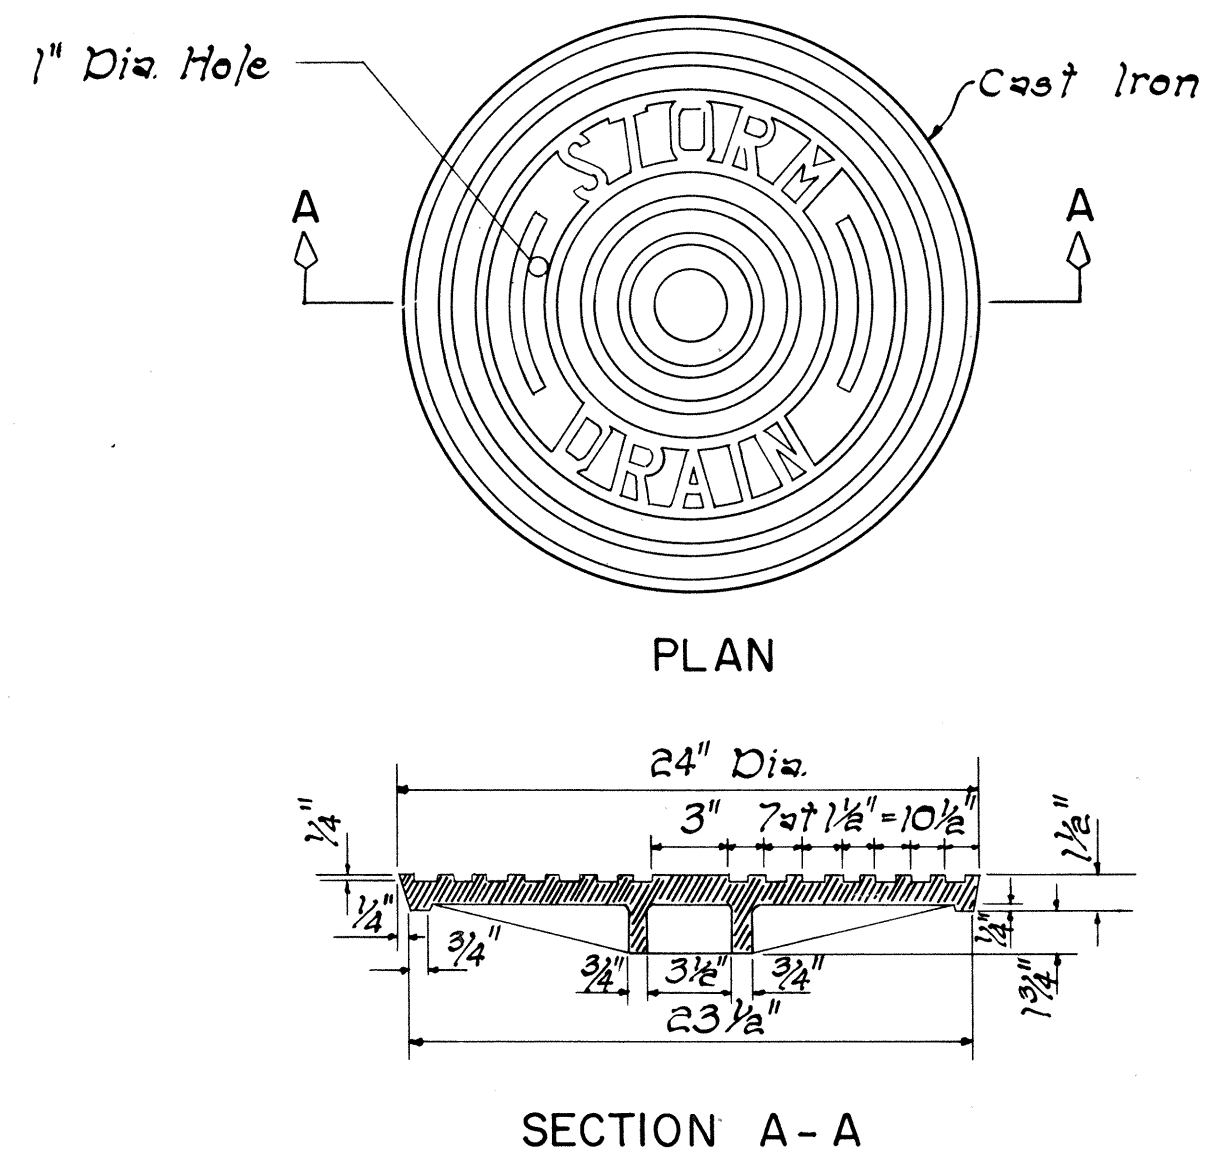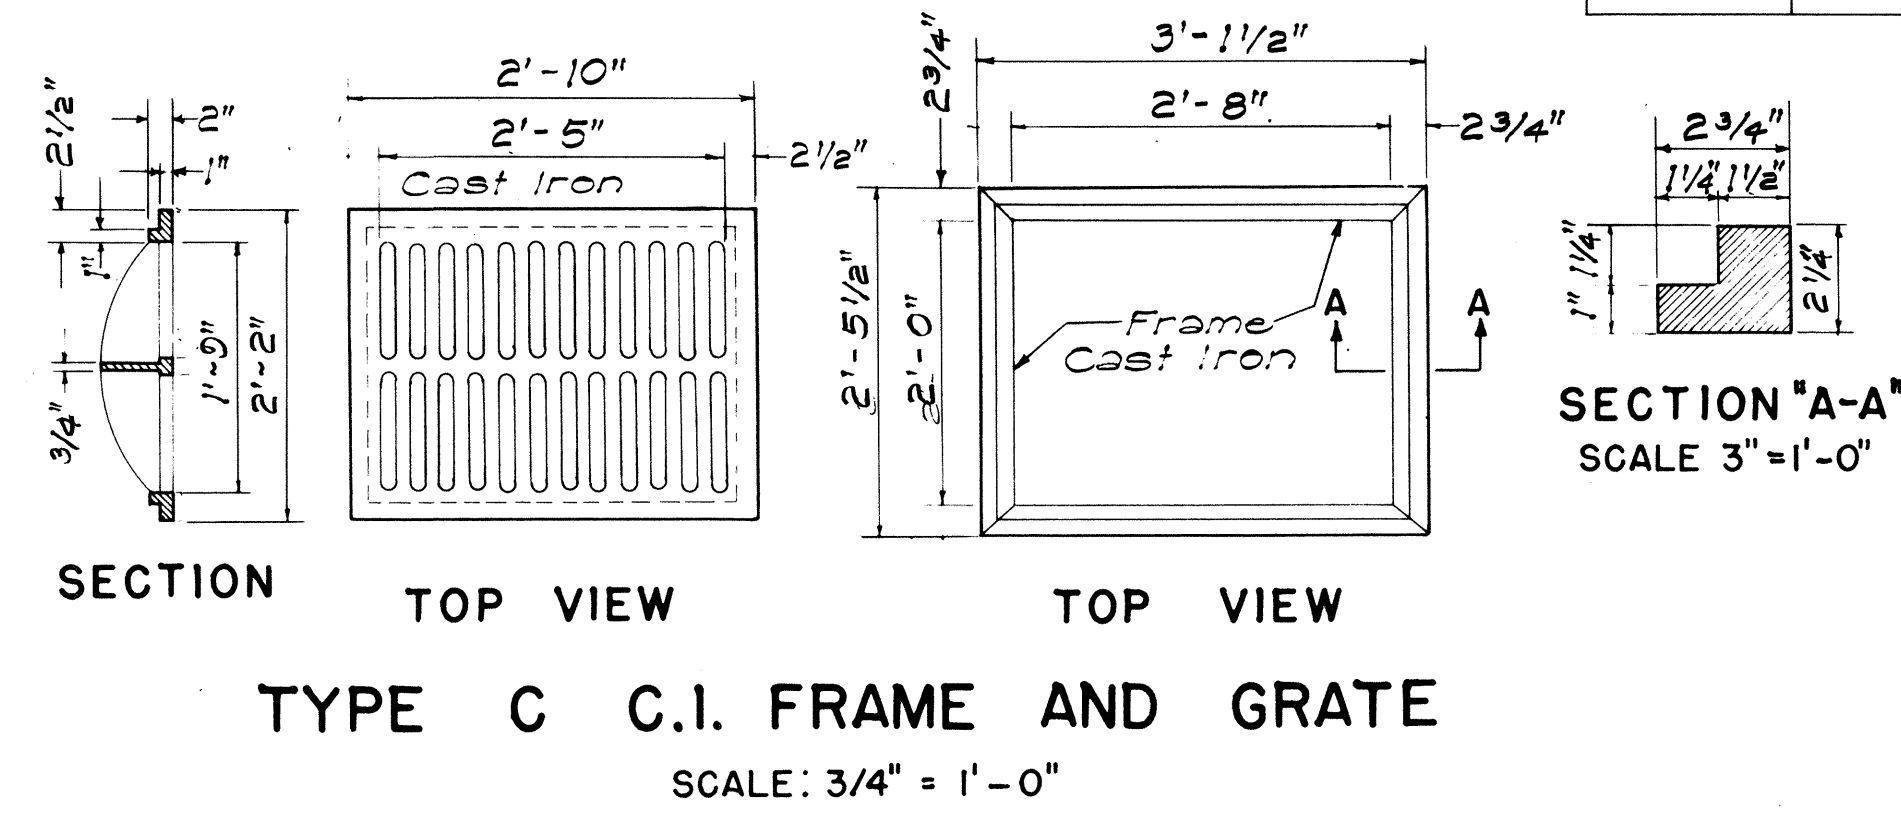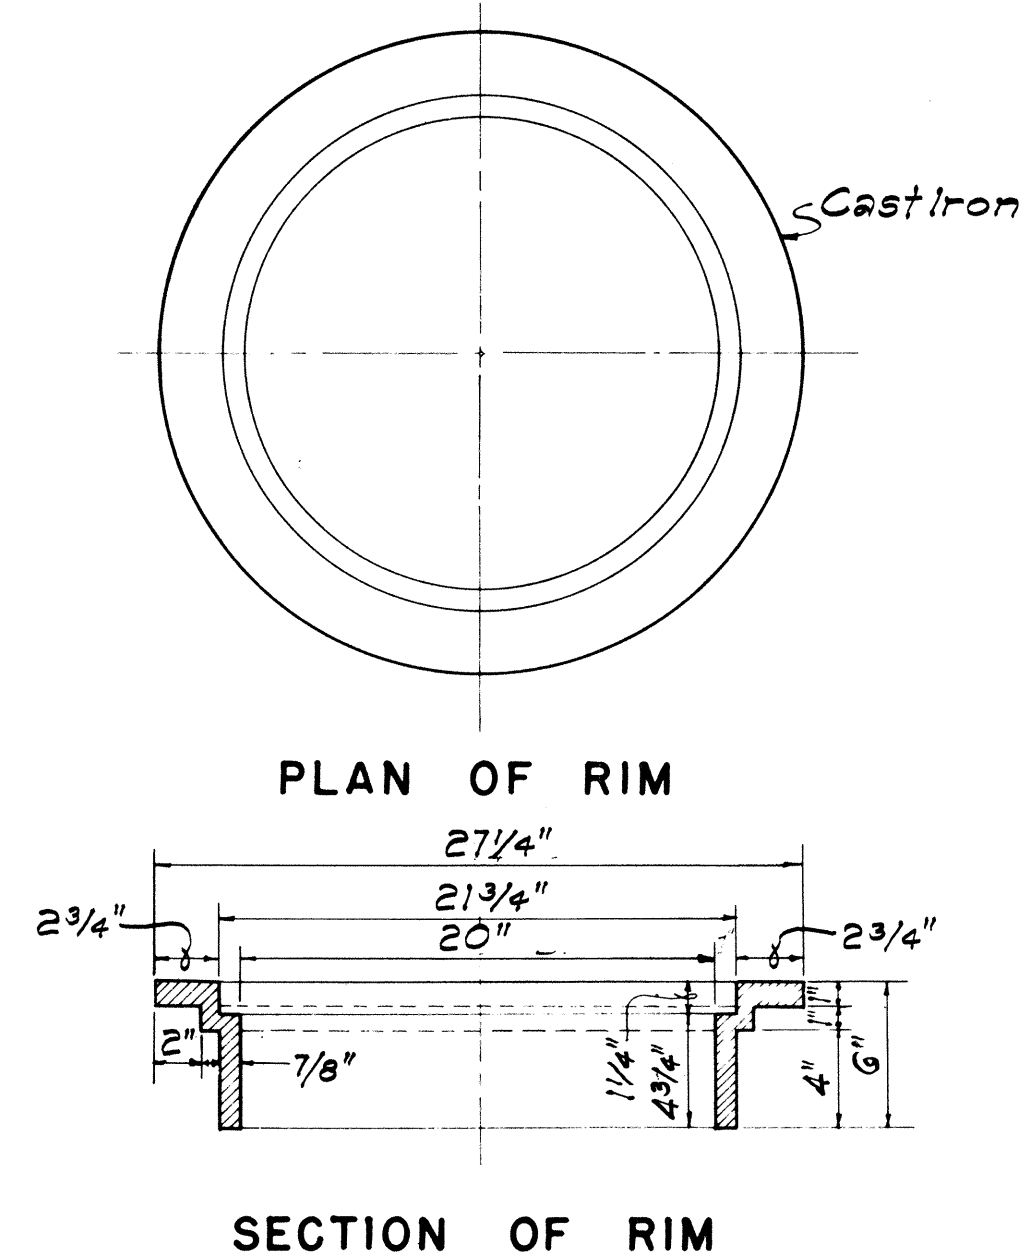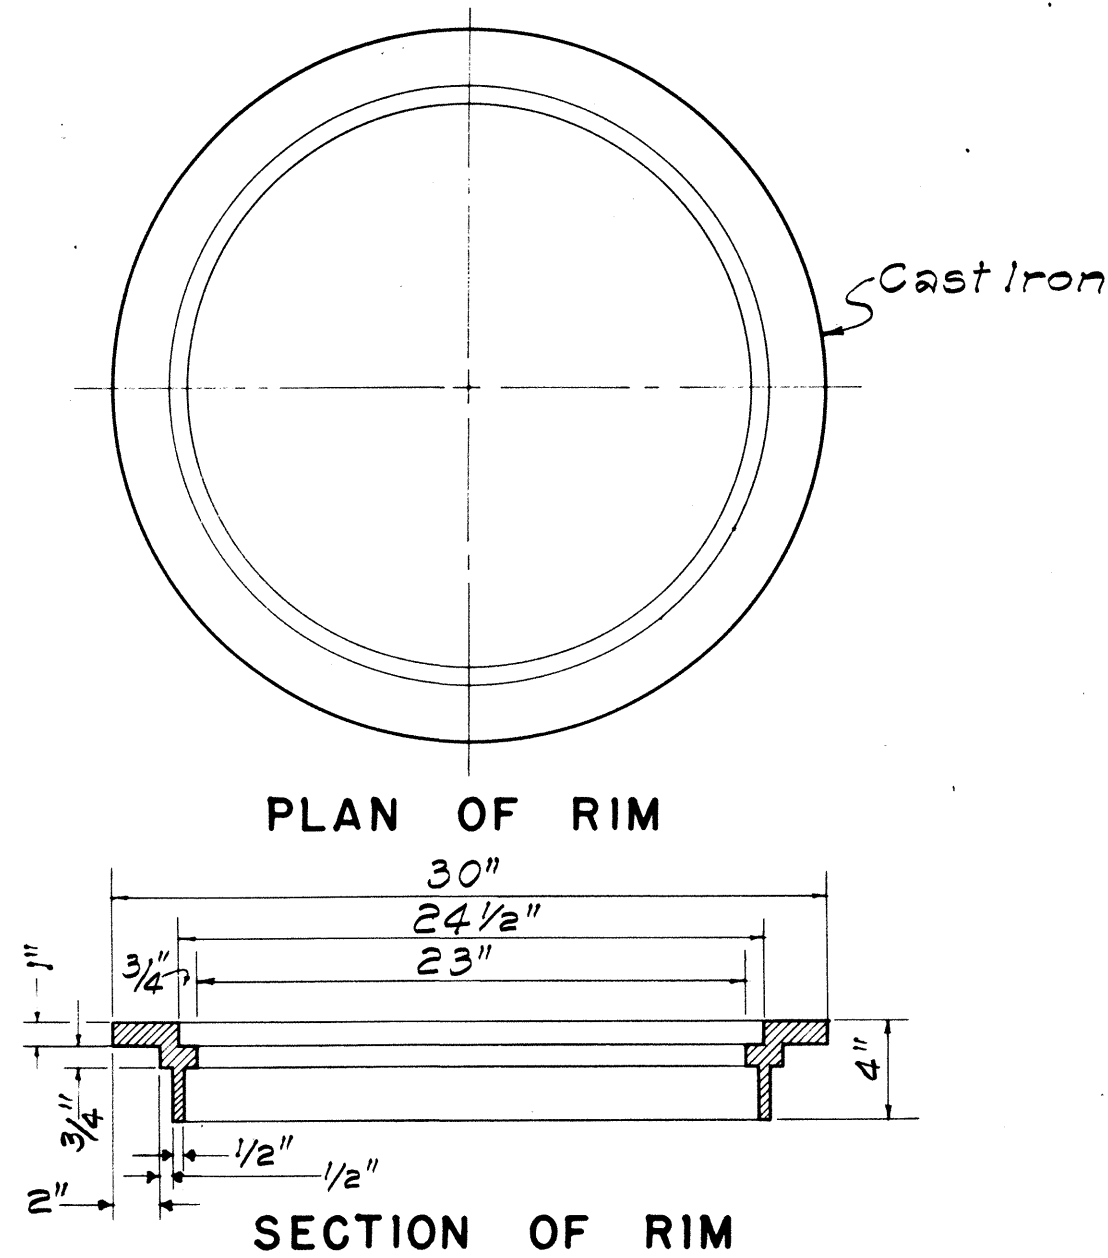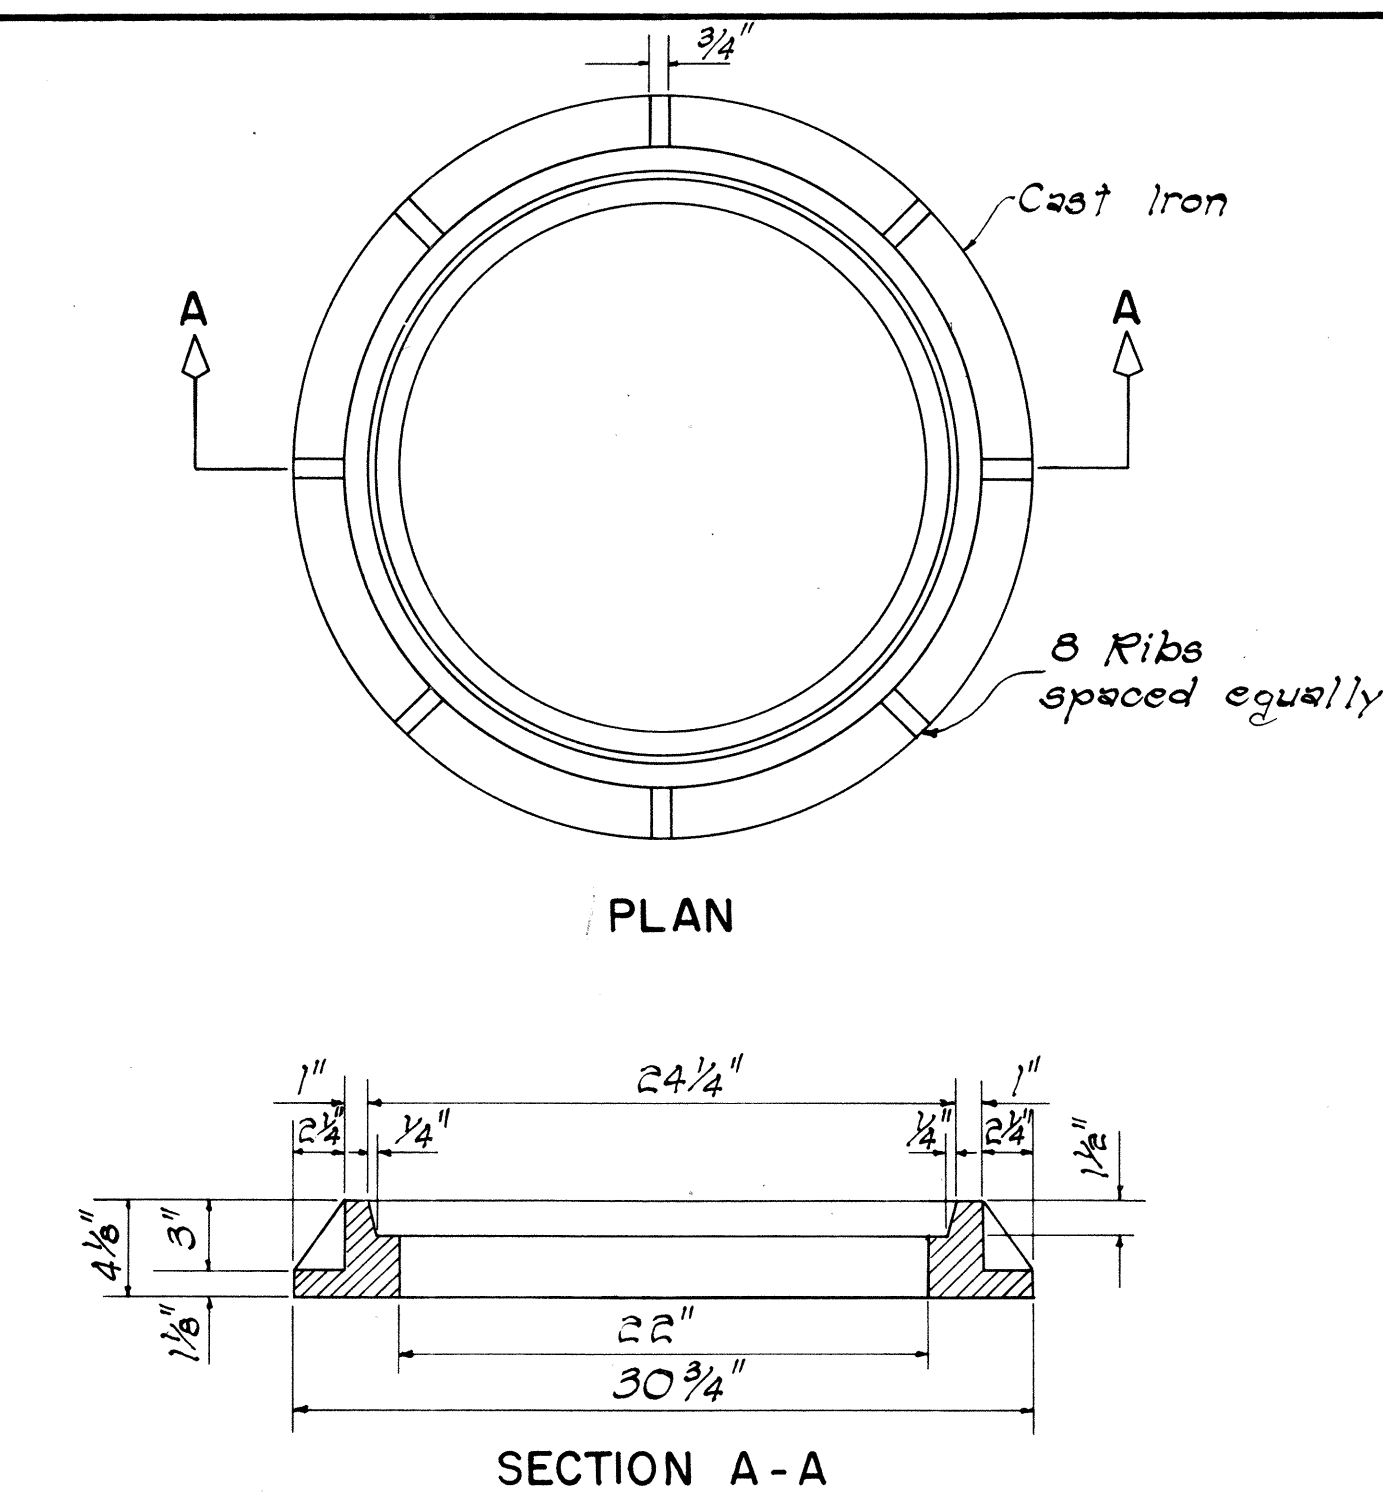

APPROVAL RECOMMENDED:
 HYDRAULIC DESIGN ENGINEER
 DATE 12-17-69

APPROVED:
 ASSISTANT CHIEF, ENGINEERING
 DATE 12-17-69

NO.	REVISION	APPROVED BY	DATE
1.	Detail of Type "P" Cast Iron Frame and Cover	H.T.	1-6-71

STATE OF HAWAII
 DEPARTMENT OF TRANSPORTATION
 HIGHWAYS DIVISION

STANDARD DETAILS
 CATCH BASIN AND
 MANHOLE CASTINGS

Scale: As Noted Date: July, 1969
 SHEET No 166 OF 25 SHEETS DH 6

ORIGINAL PLAN
 DESIGNED BY: A. Calistro
 DRAWN BY: A. Calistro
 NOTE BOOK
 CHECKED BY: A. Calistro
 No. 1

FED. ROAD DIST. NO.	STATE	FED. AID PROJ. NO.	FISCAL YEAR	SHEET NO.	TOTAL SHEETS
HAWAII	HAW.	1-H-1(90)13	1972	57	202

GENERAL NOTES

- Contractor has the option of using cast malleable iron, cast steel, welded, bolted, cast malleable iron end block or cast steel end block grate.
- Grates and Frames shall be hot dip galvanized after fabrication, see specifications.
- All welds $\frac{3}{8}$ " unless otherwise noted.
- Center support assembly shall be used when two or more grates are specified. Incidental to Types A-9 or A-12 Frame and Grates.
- Refer to "Grate Bar Spacing Table" for Types A-9 and A-12 Grate dimensions.
- The various materials shall conform to the specifications of ASTM as listed in the following tabulation and the Std. Specifications.

Material	ASTM Designation
Structural Steel	A283, Grade D
Cast Steel	A27, Grade 65-35
Malleable Iron Casting	A47, Gr. No. 35018

GRATE BAR SPACING TABLE

TYPE	NO. BARS	CLEAR BAR SPACING - W	X
A-9	9	2"	$1\frac{9}{16}$ "
A-12	12	$1\frac{3}{8}$ "	$1\frac{1}{4}$ "

NOTE:

- Type A-9 - Use in locations off the roadbed on all types of highways.
- Type A-12 - Use within the roadbed on all types of highways.

APPROVAL RECOMMENDED:

9. *Pakano* 12-17-69
 HYDRAULIC DESIGN ENGINEER DATE

APPROVED:

Shelton 12-17-69
 ASSISTANT CHIEF, ENGINEERING DATE


STATE OF HAWAII
 DEPARTMENT OF TRANSPORTATION
 HIGHWAYS DIVISION

STANDARD DETAILS


TYPE A-9 AND A-12 FRAMES AND GRATES

Scales: As Noted Date: Aug. 1968

SHEET No. 170 OF 25 SHEETS

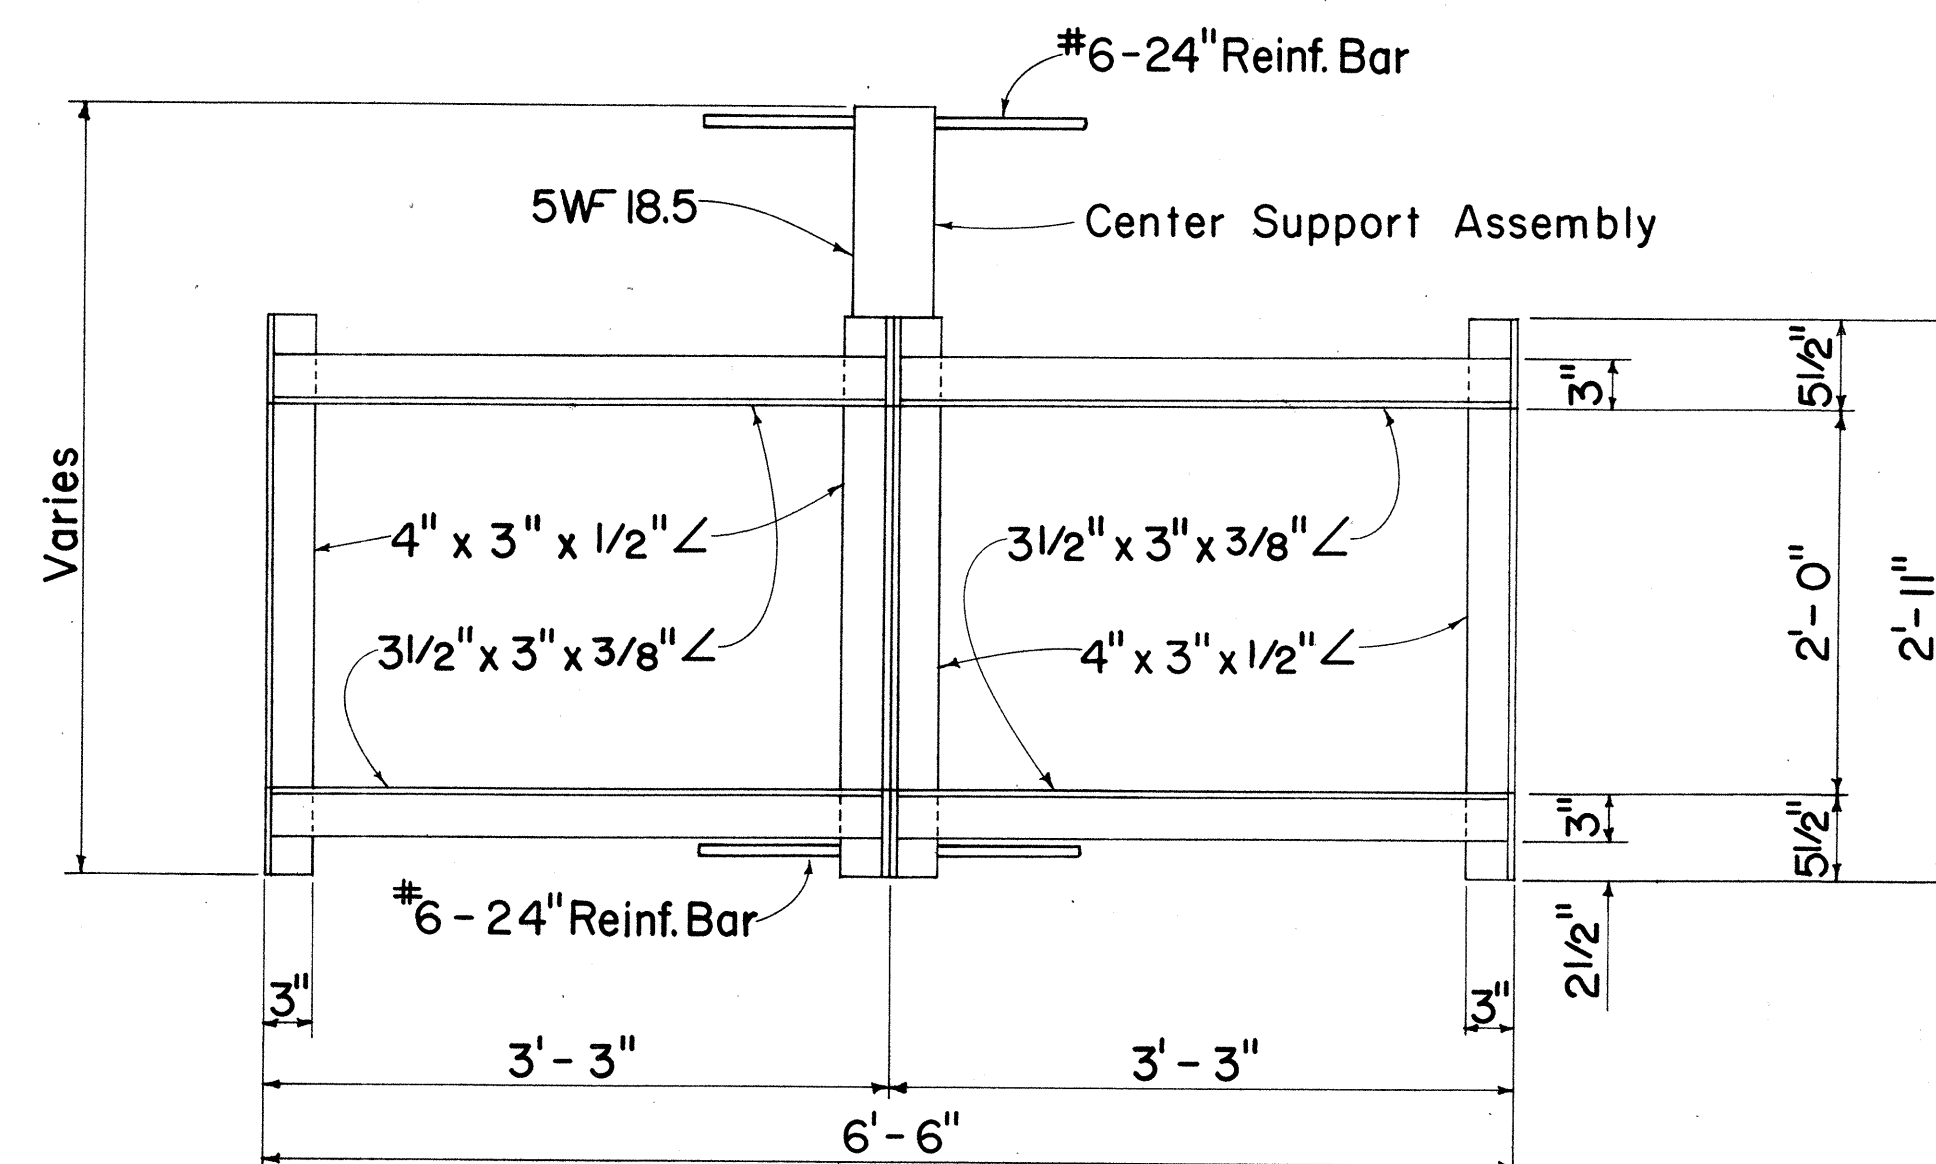


PLAN
 (Two or More Grates)

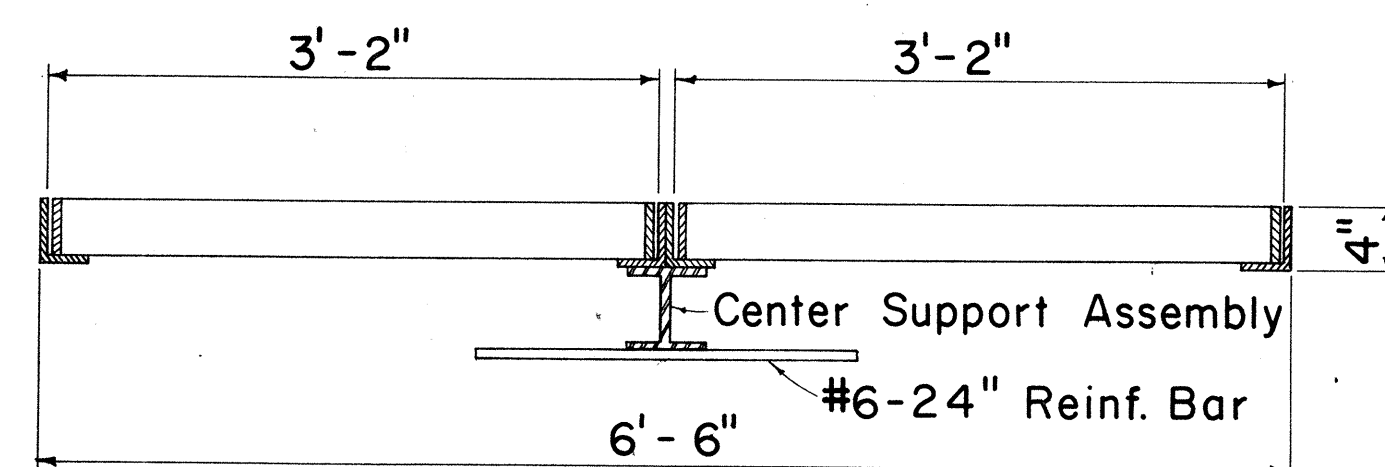

LONGITUDINAL SECTION
 (Thru Frame & Grate)


FRAME DETAILS

Scale: 1" = 1' - 0"

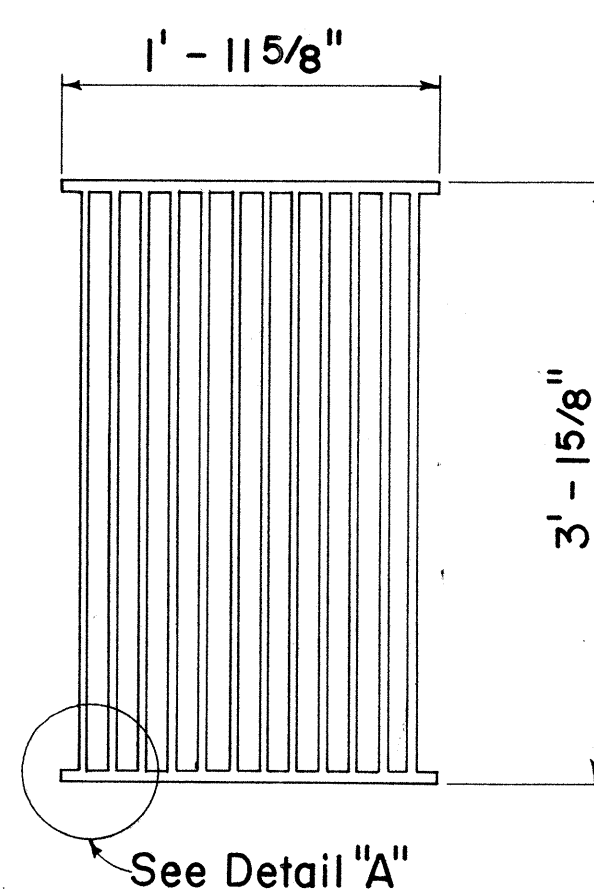


PLAN

Scale: 1" = 1' - 0"

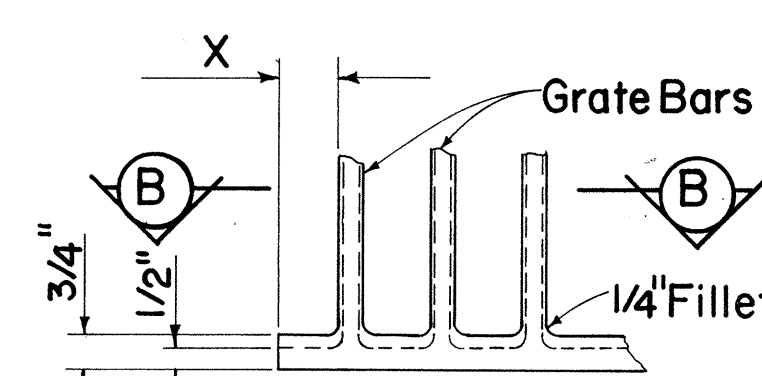

DETAIL "A"


Scale: 3" = 1' - 0"

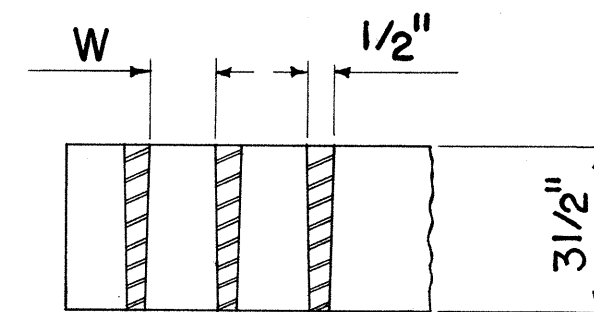


SECTION "B-B"

Scale: 3" = 1' - 0"


ALTERNATIVE CAST MALLEABLE IRON OR CAST STEEL GRATE

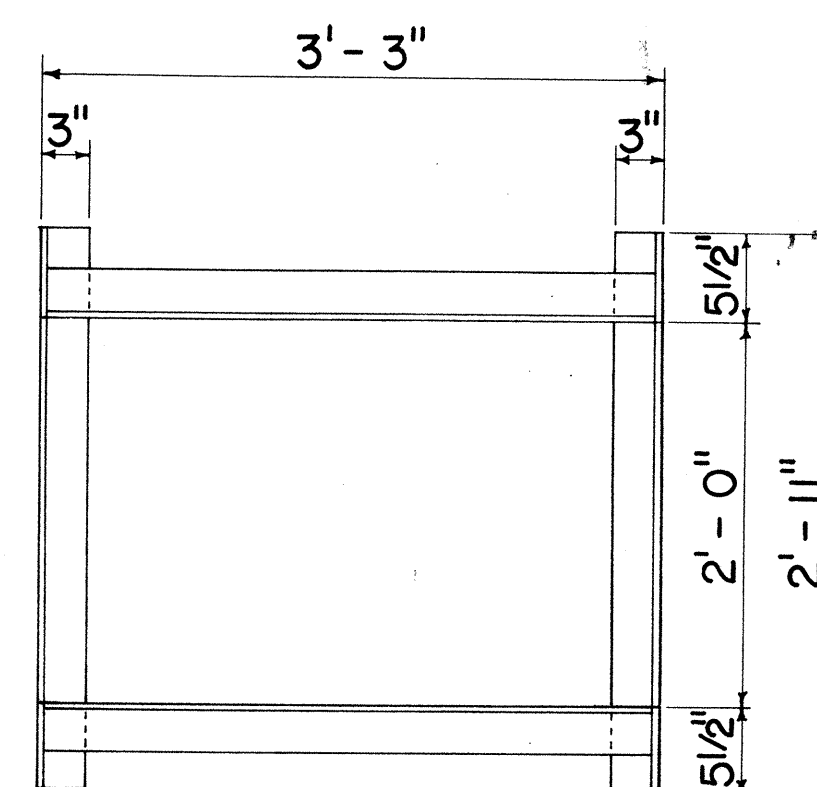

PLAN
 (Single Grate)

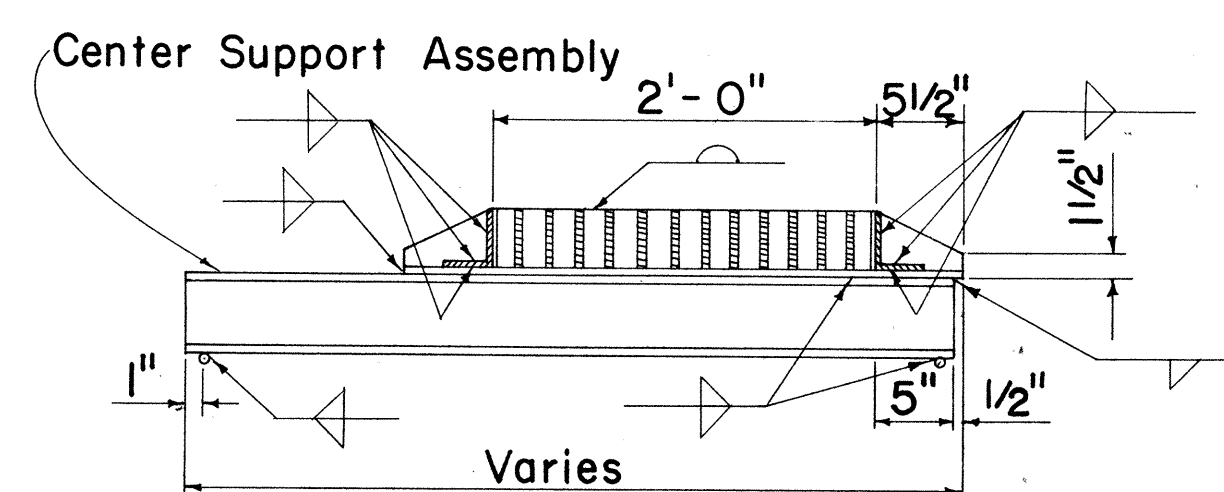


CROSS SECTION
 (Thru Frame & Grate)

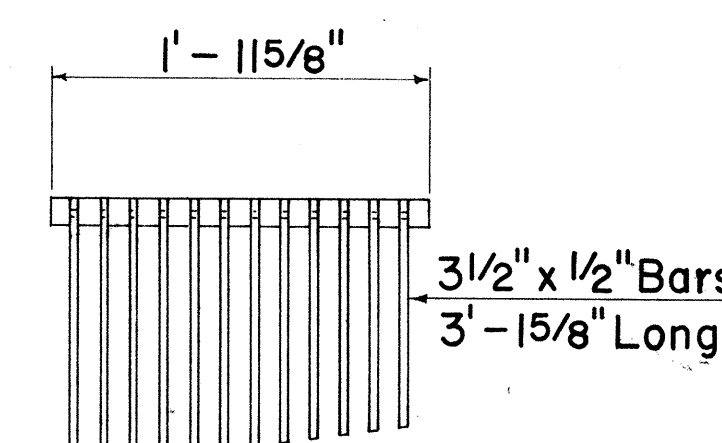

CAST END BLOCK


Scale: 1" = 1' - 0"

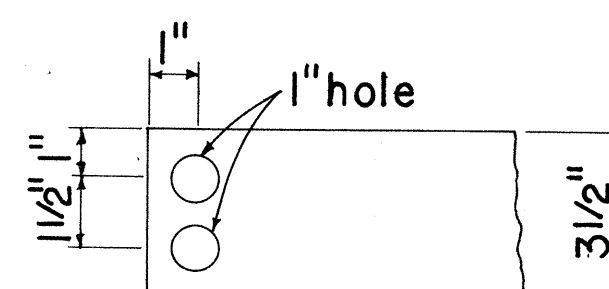

END OF BAR


Scale: 3" = 1' - 0"

ALTERNATIVE CAST MALLEABLE IRON OR CAST STEEL END BLOCK GRATE

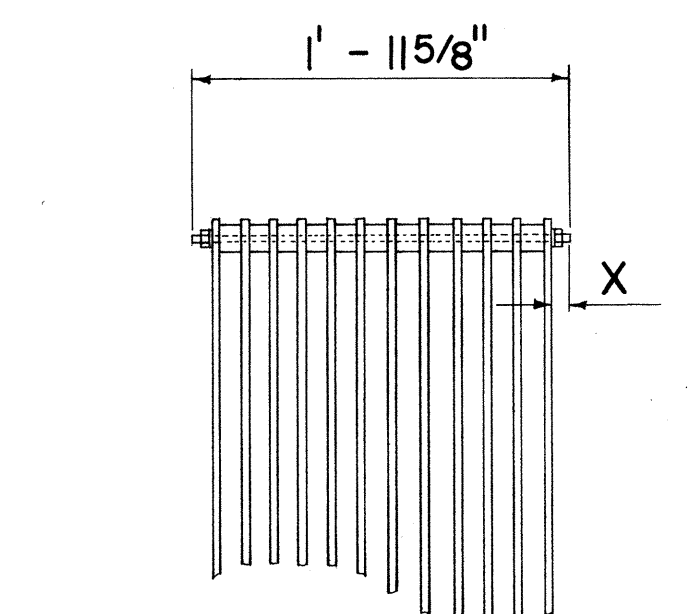

BOLTED END BLOCK


Scale: 1" = 1' - 0"

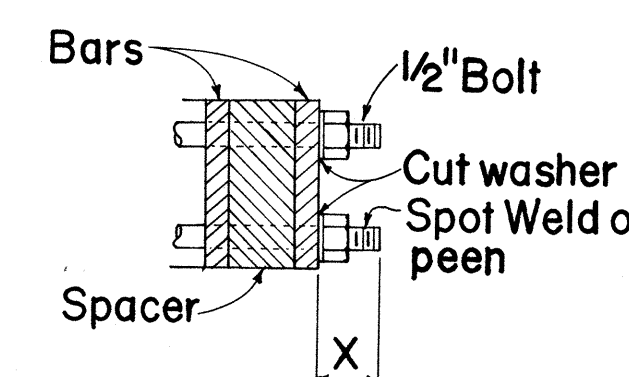

BOLTING DETAIL

Scale: 3" = 1' - 0"


ALTERNATIVE BOLTED GRATE

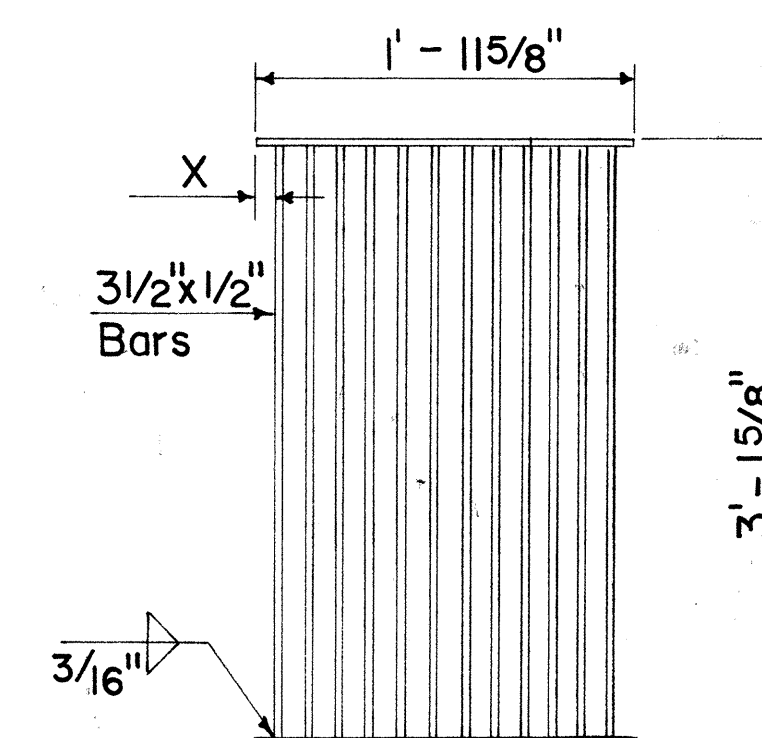

PLAN

ALTERNATIVE WELDED GRATE

Scale: 1" = 1' - 0"

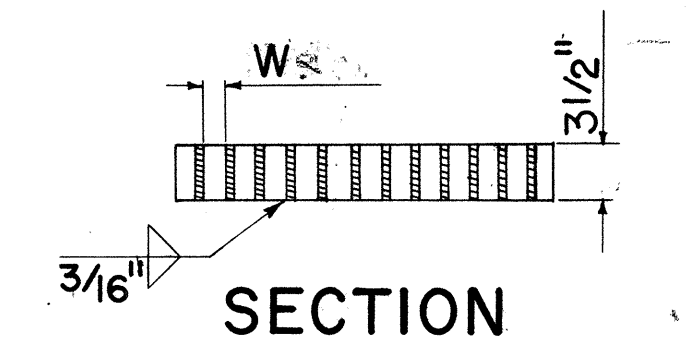

SECTION

NO.	REVISION	APPROVED BY	DATE


DESIGNED BY	DATE
7/68	7/68
TRACED BY	DATE
7/68	7/68
QUANTITIES BY	DATE
7/68	7/68
CHECKED BY	DATE
7/68	7/68

ORIGINAL PLAN	DATE
7/68	7/68
NOTE BOOK	DATE
7/68	7/68

FED. ROAD DIST. NO.	STATE	FED. AID PROJ. NO.	FISCAL YEAR	SHEET NO.	TOTAL SHEETS
HAWAII	HAW.	I-H-1(90)13	1972	58	202


GENERAL NOTES

- Grates and Frames shall be hot dip galvanized after fabrication, see specifications.
- All welds $\frac{3}{8}$ " unless otherwise noted.
- The Frame & Grate materials shall conform to the specifications of ASTM Designation Structural Steel A283, Grade D and the Standard Specifications.
- Culvert shall leave Drop Intake from any position and any direction indicated by plans or ordered by the Engineer. Culverts may both enter and leave Drop Intake so that Drop Intake will act as manhole.
- Manhole Rungs (16"o.c.) are required when "H" is greater than 4 feet 6 inches. Only one rung (12 inches from the bottom) is required if "H" is 4 feet 6 inches or less. The Manhole Rungs may be placed at any location as ordered by the Engineer.

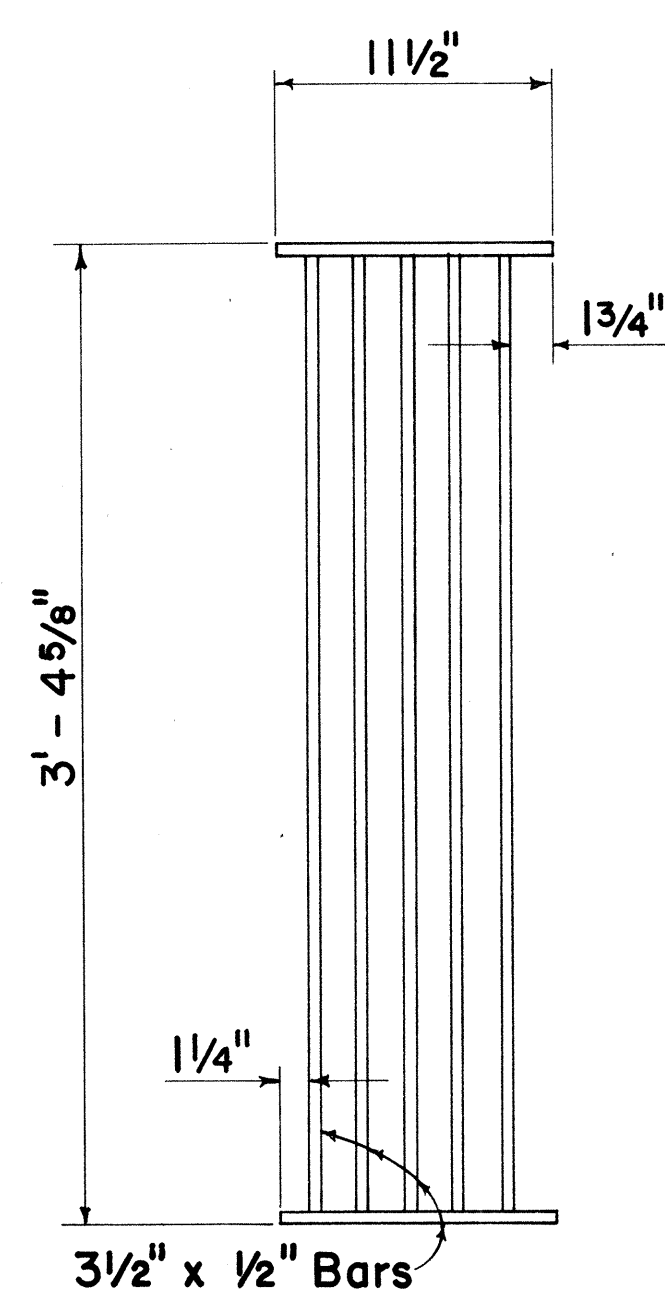


PLAN

Scale: 1 1/2" = 1' - 0"

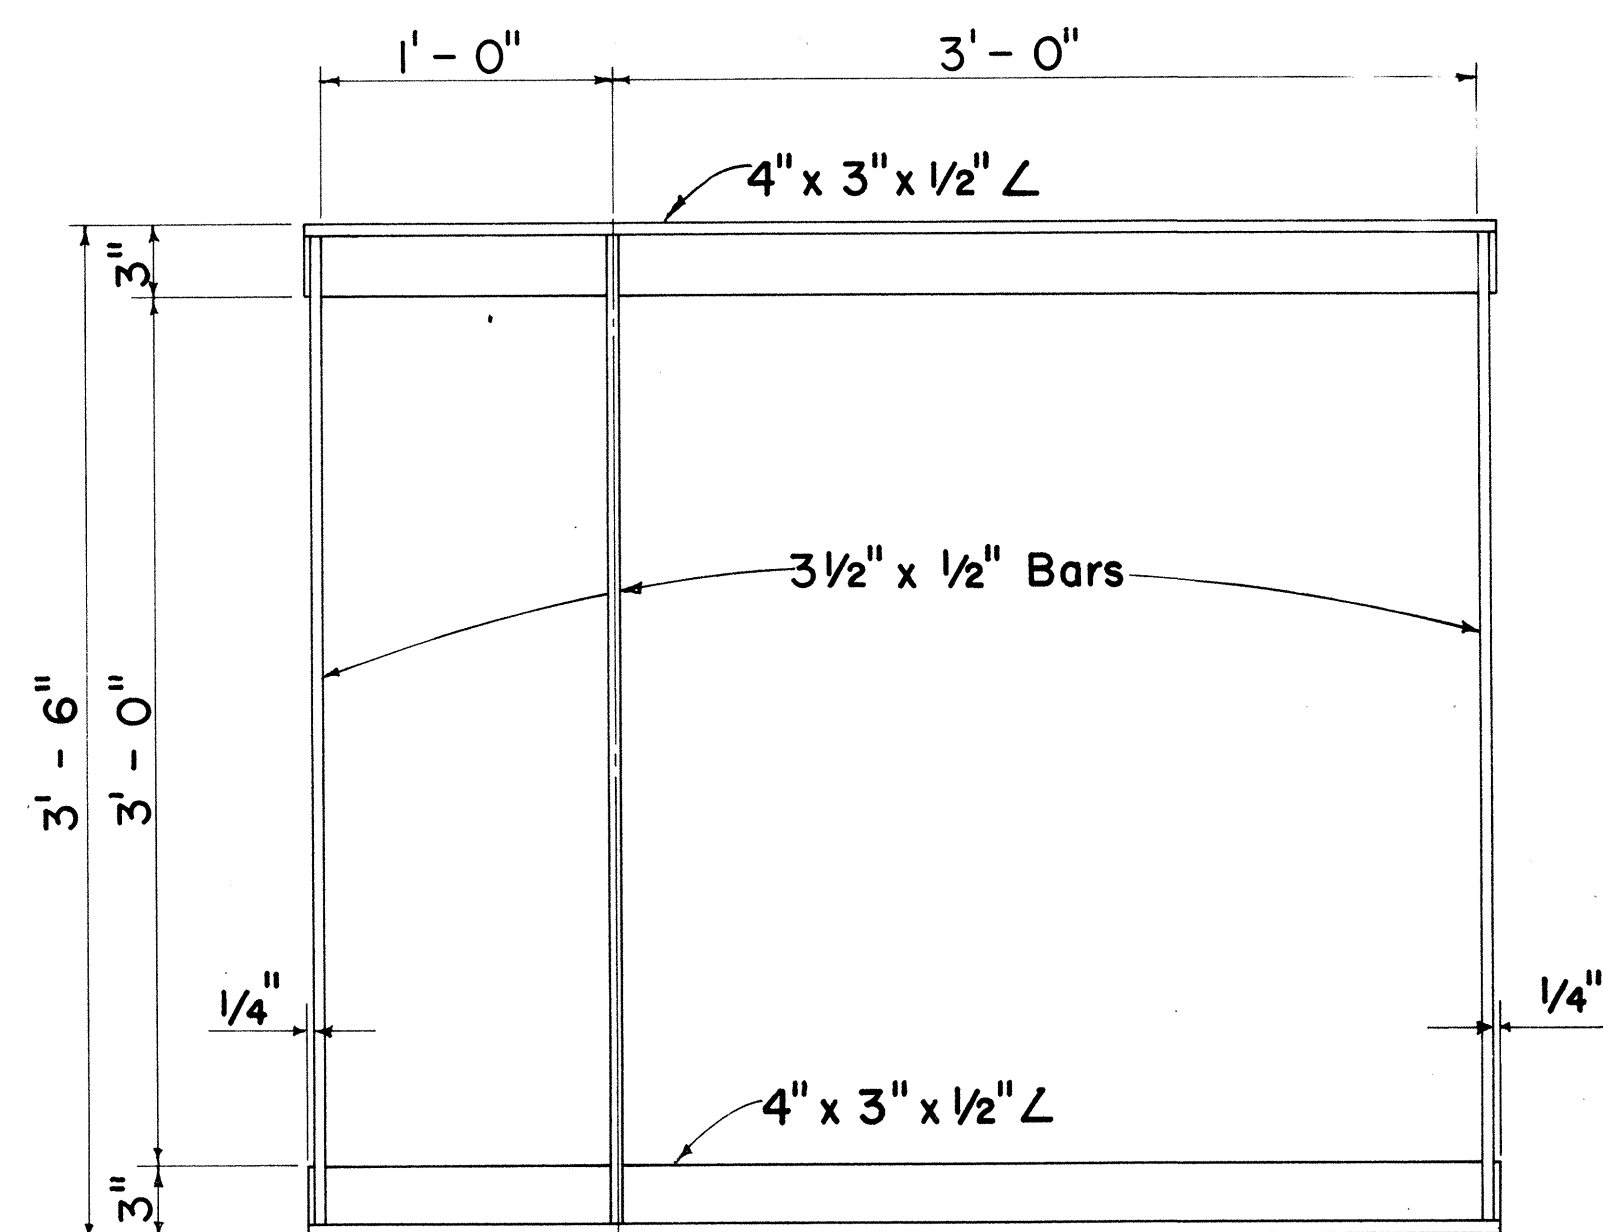


PLAN

Scale: 1 1/2" = 1' - 0"

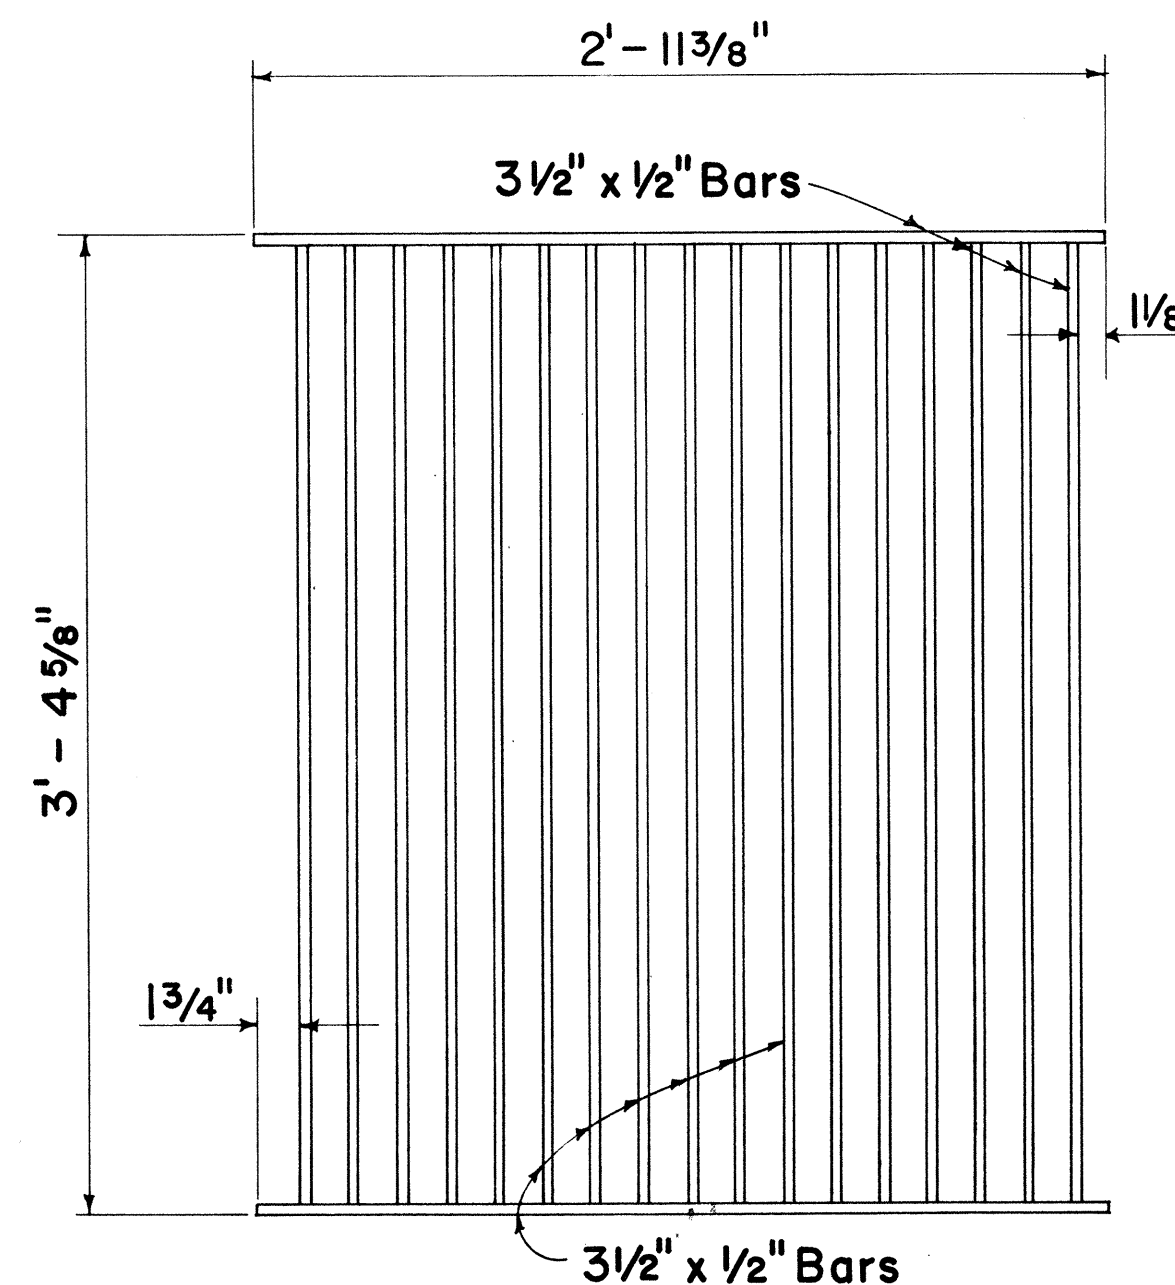


PLAN

Scale: 1 1/2" = 1' - 0"

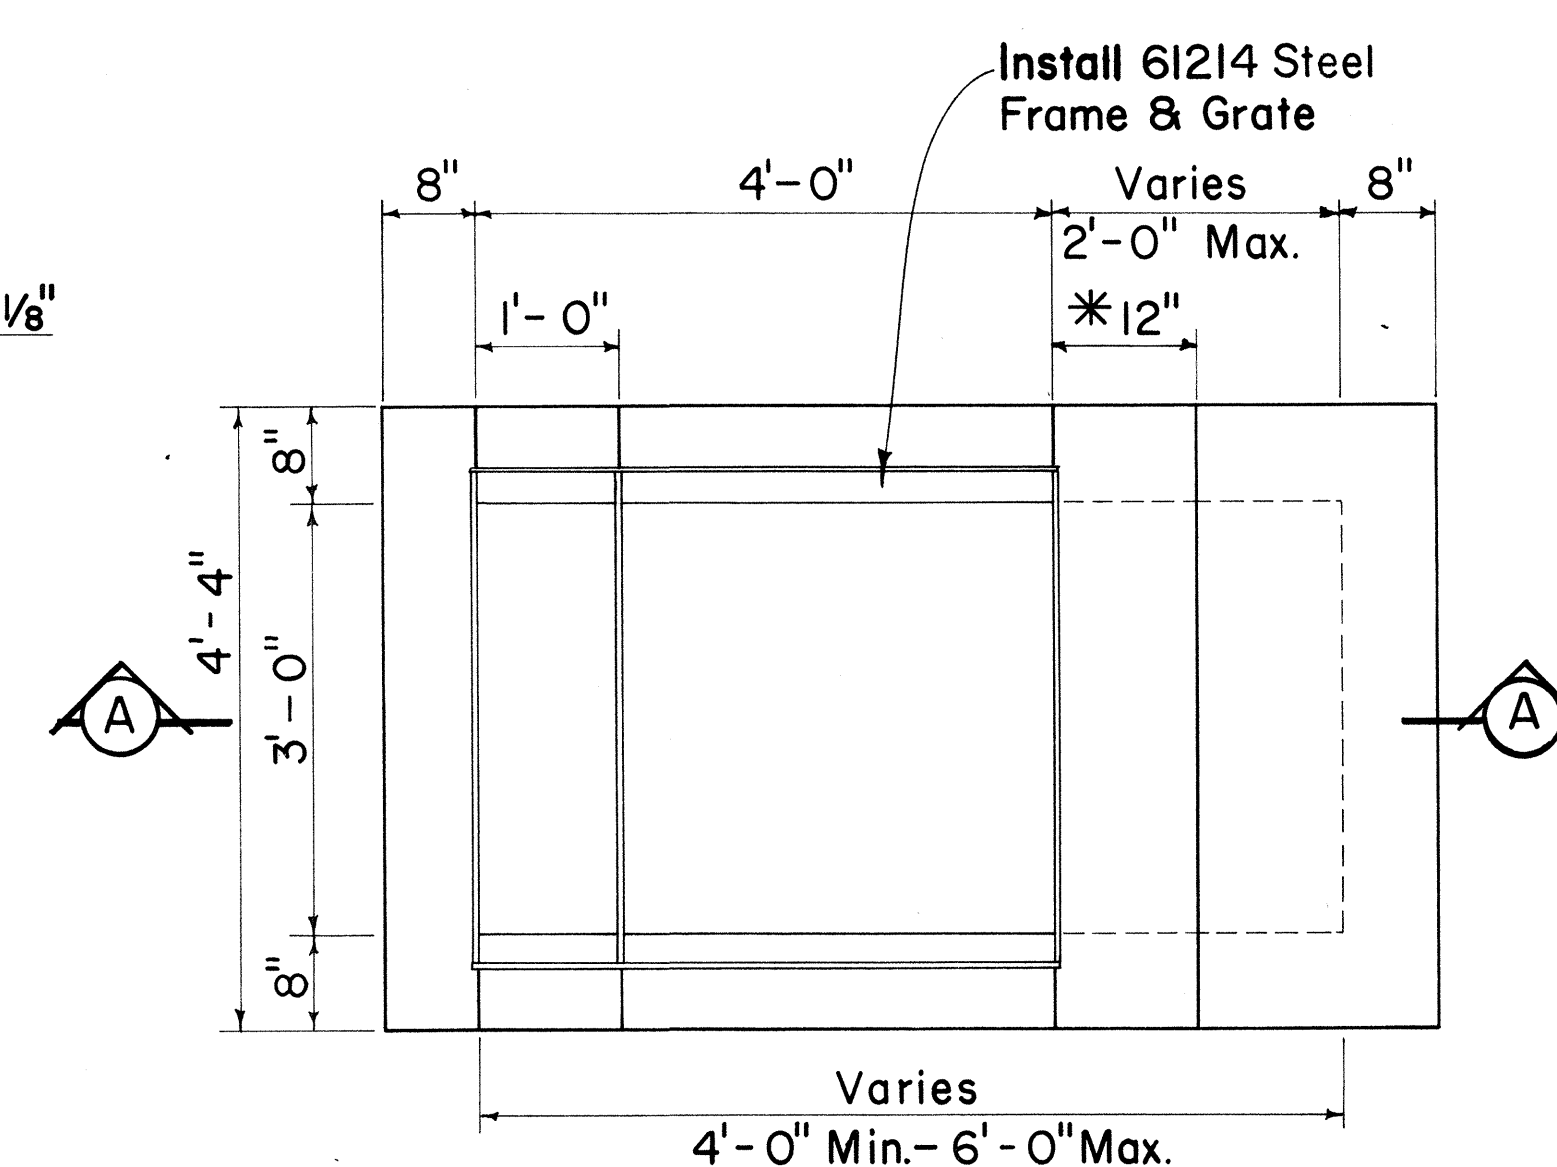


PLAN

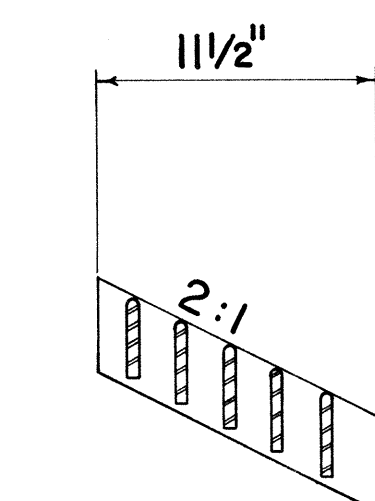


SECTION

Scale: 1 1/2" = 1' - 0"

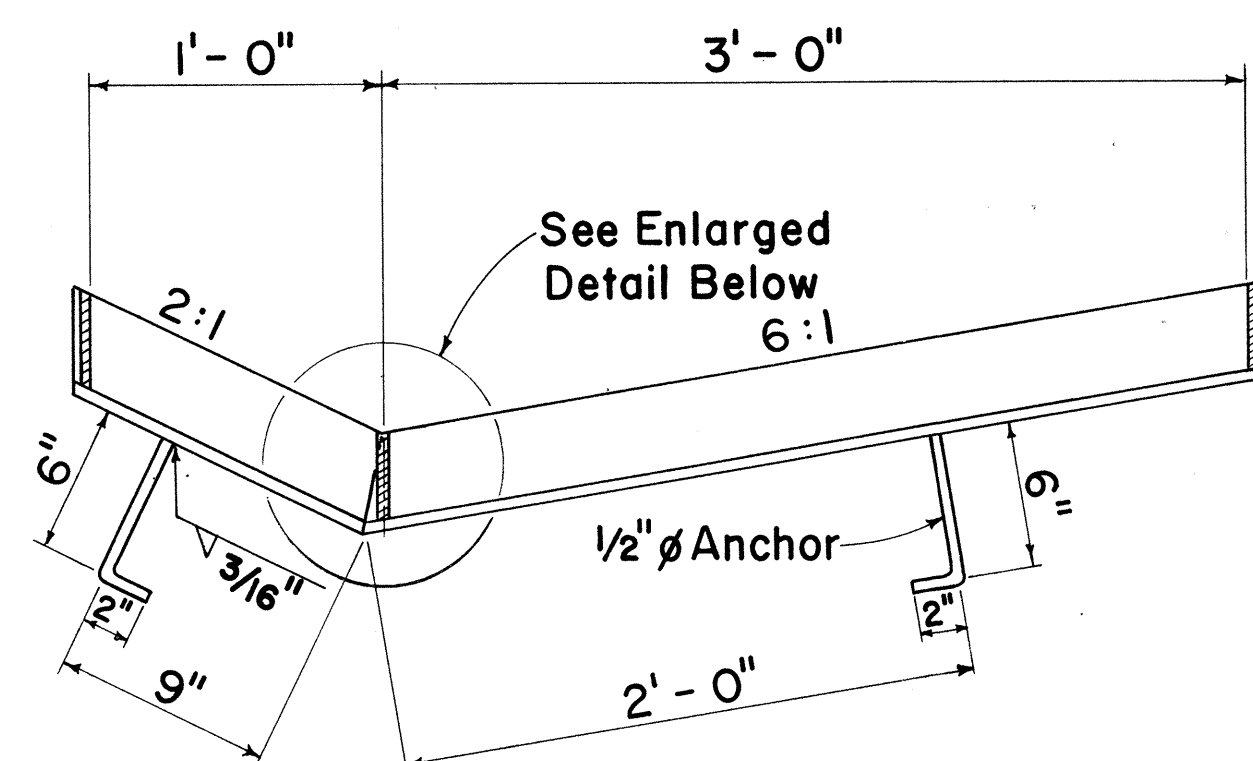


SECTION

Scale: 1 1/2" = 1' - 0"

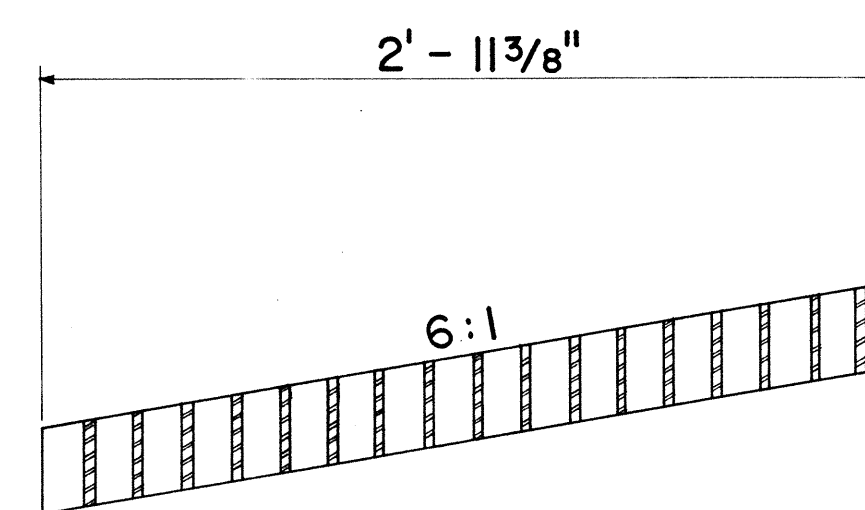


SECTION

Scale: 1 1/2" = 1' - 0"

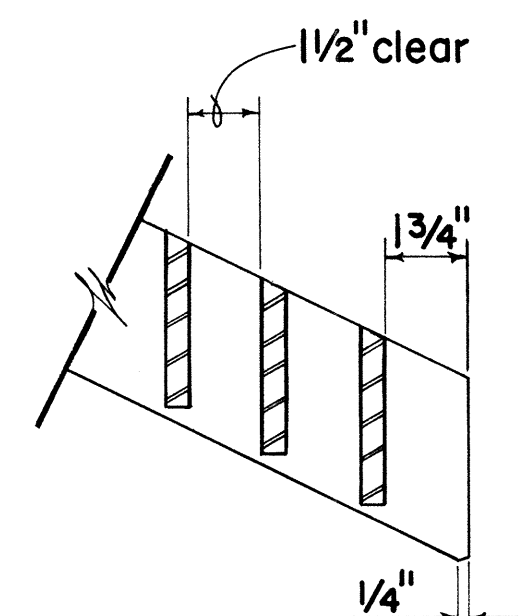


GRATE

Scale: 3" = 1' - 0"

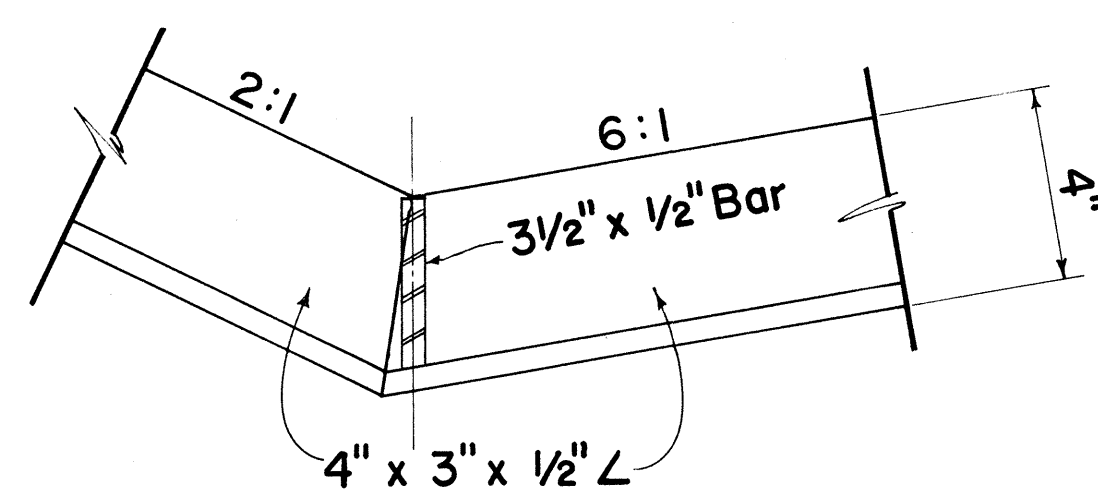


FRAME

Scale: 3" = 1' - 0"

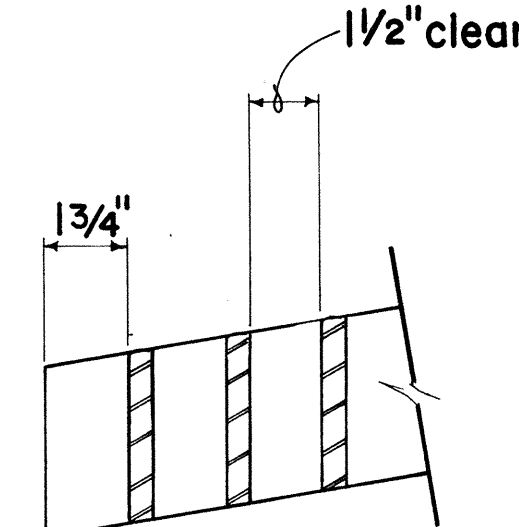

GRATE

Scale: 3" = 1' - 0"

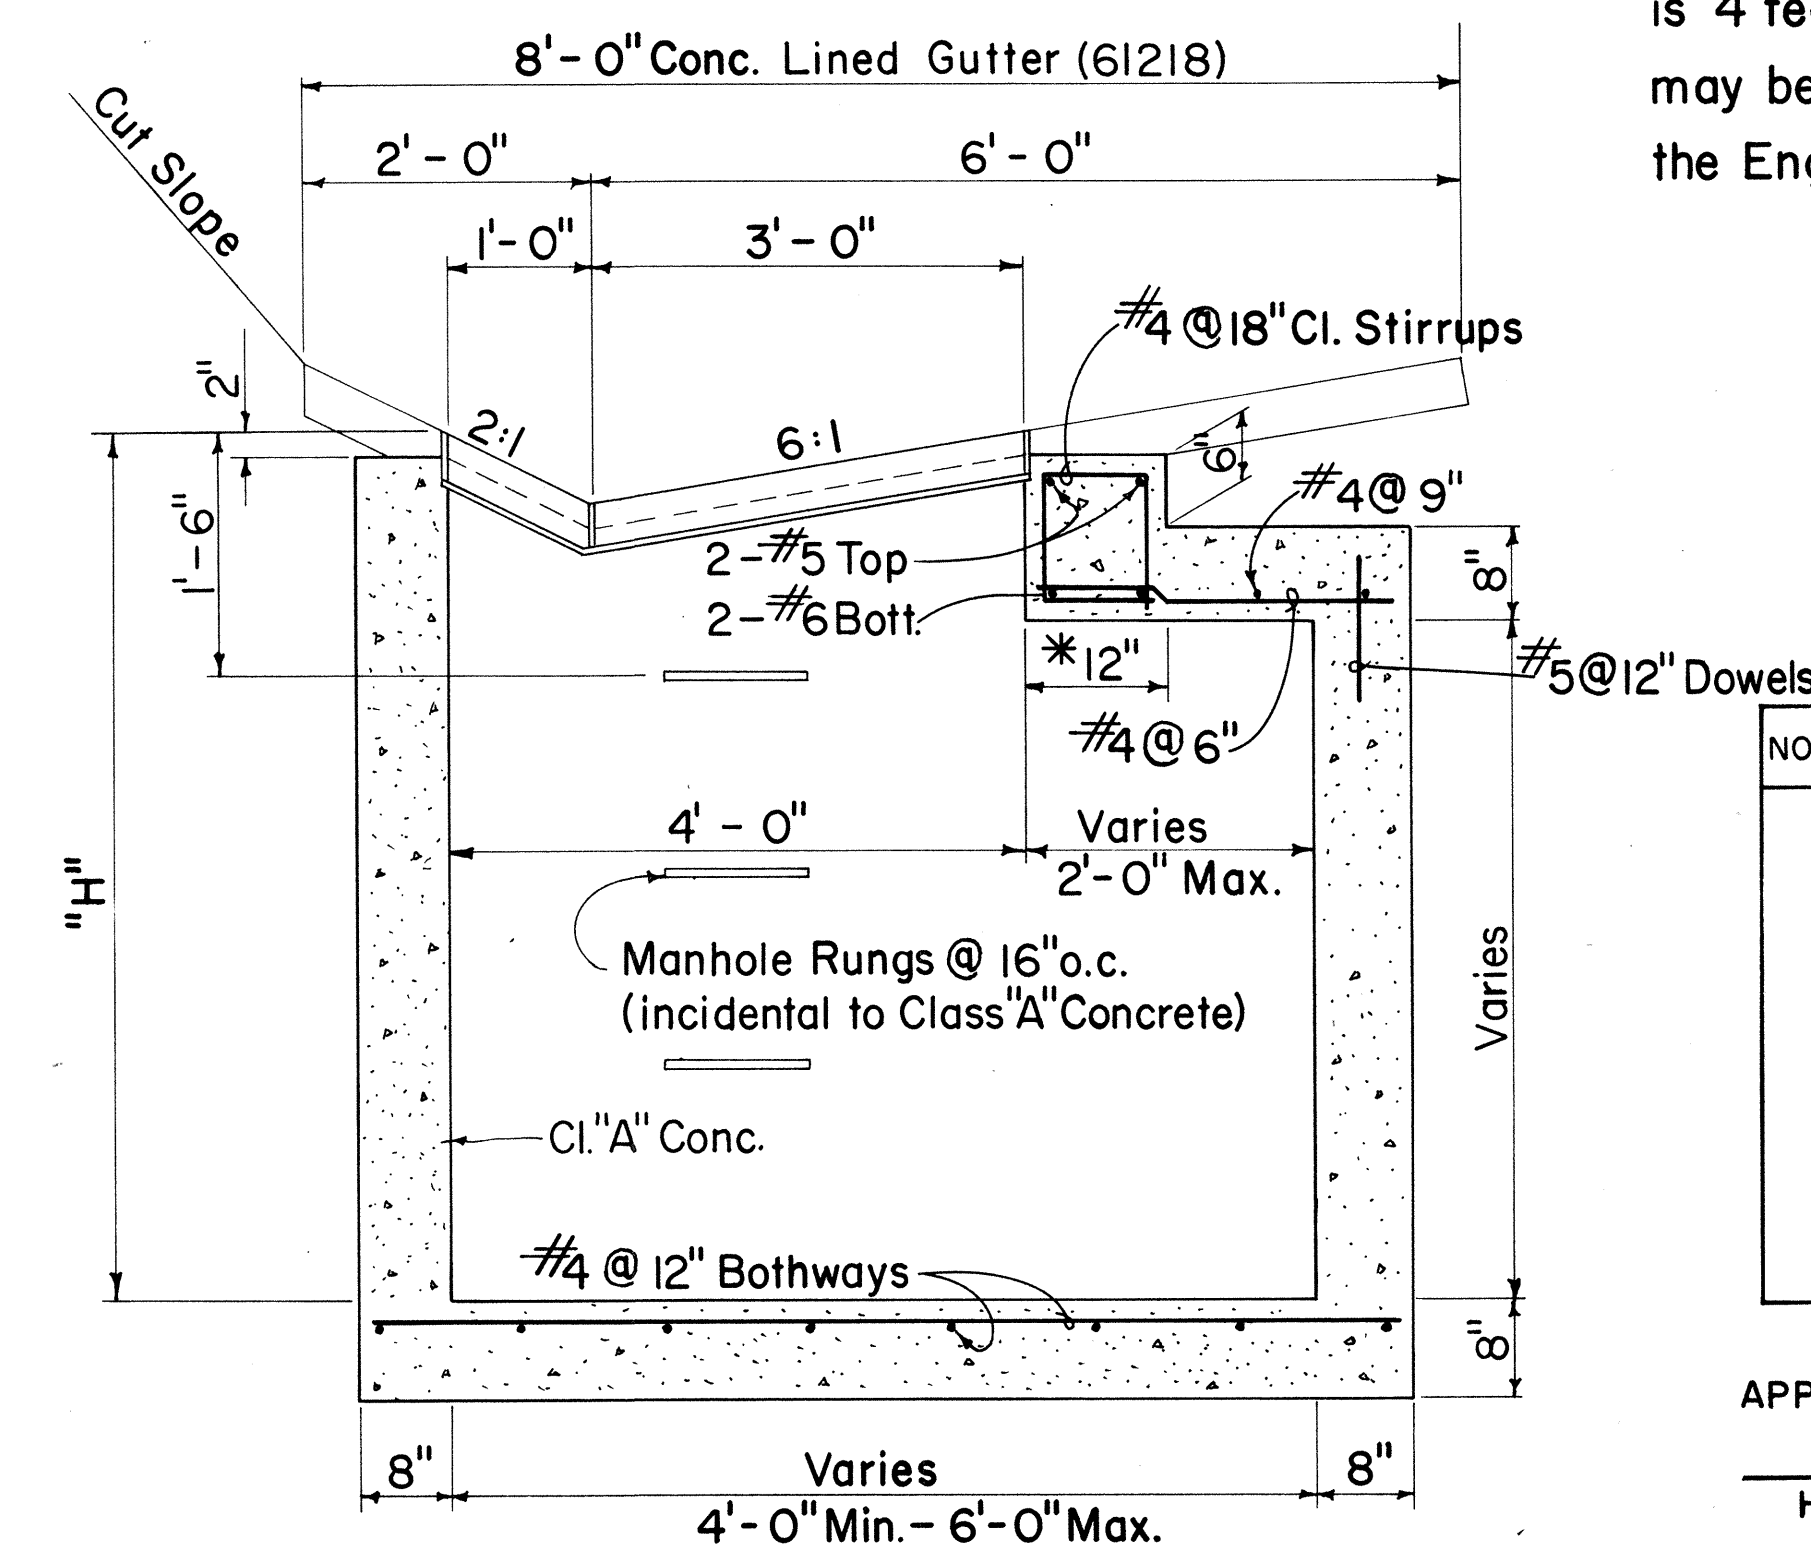

SECTION A - A

DETAIL OF 61214 DROP INTAKE

Scale: 3/4" = 1' - 0"

*For Minimum size box of 4' - 0" only, use 8" and eliminate reinforcing steel shown in top portion.

NO.	REVISION	APPROVED BY	DATE

APPROVAL RECOMMENDED:

HYDRAULIC DESIGN ENGINEER

12-17-69
DATE

APPROVED:

ASSISTANT CHIEF, ENGINEERING

12-17-69
DATE

STATE OF HAWAII
DEPARTMENT OF TRANSPORTATION
HIGHWAYS DIVISION
STANDARD DETAILS
TYPE 61214
GRATED DROP INTAKE

Scales: As Noted


Date: July 1969

SHEET No. 18 OF 25 SHEETS DH 9

DETAILS OF TYPE 61214 STEEL FRAME AND GRATES




ORIGINAL	DATE
PLAN	
NOTE BOOK	
QUANTITIES BY	
CHECKED BY	
No.	

FED. ROAD DIST. NO.	STATE	FED. AID PROJ. NO.	FISCAL YEAR	SHEET NO.	TOTAL SHEETS
HAWAII	HAW.	I-HI-1(90)13	1972	57	202

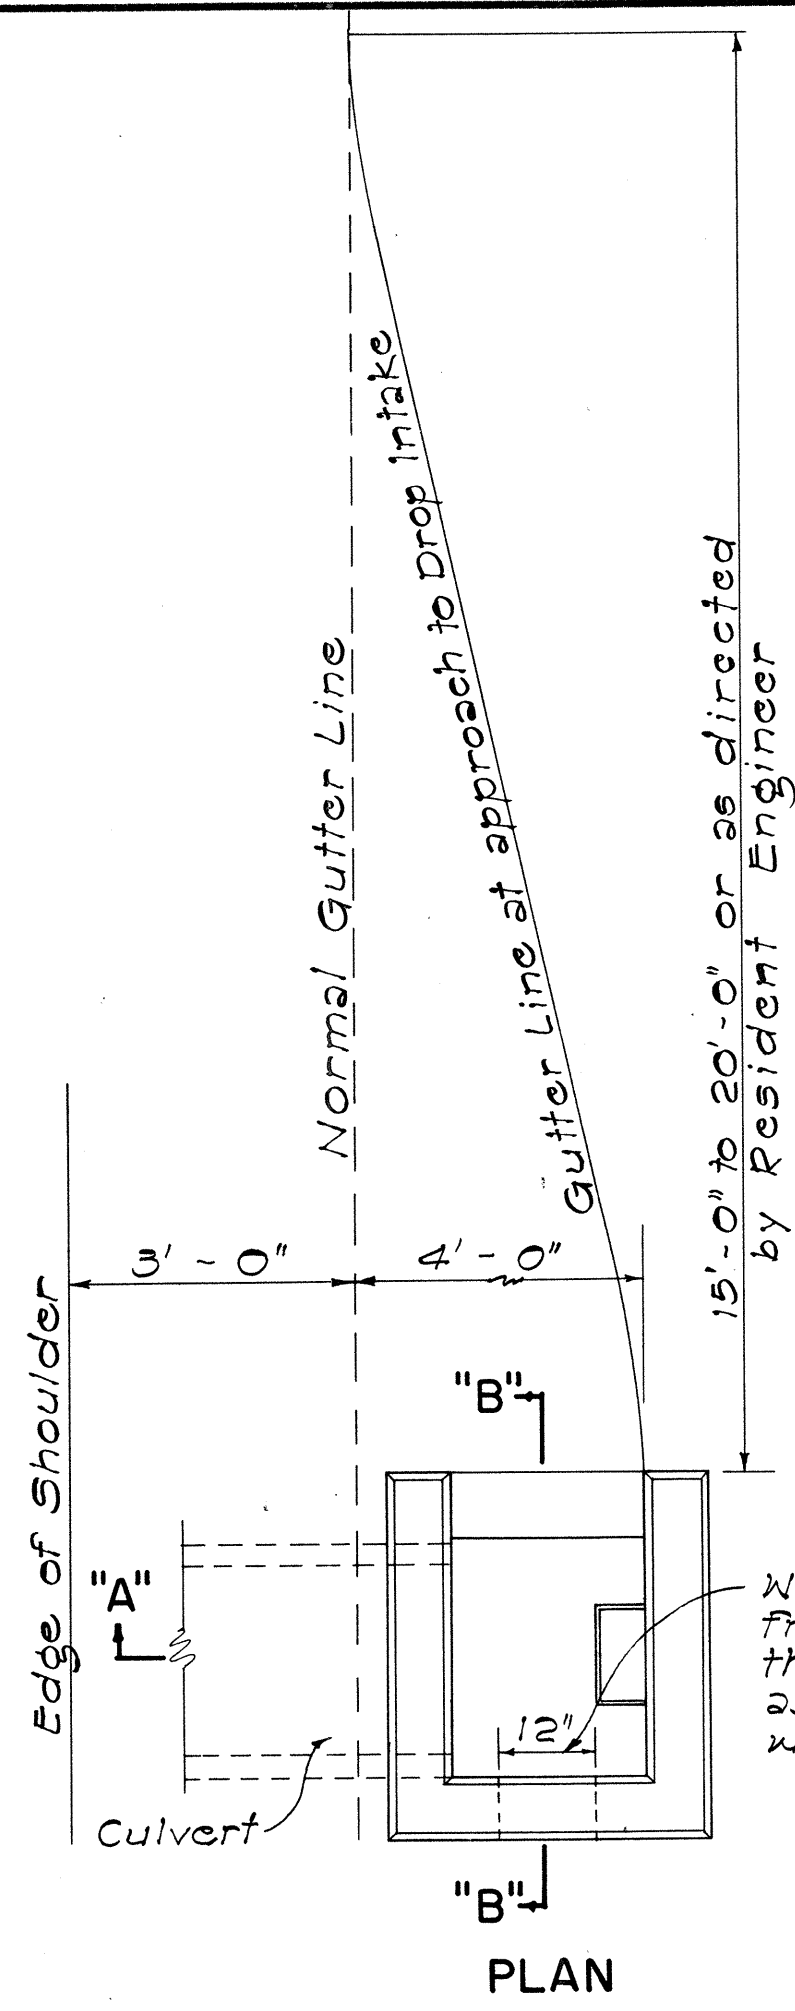

DATA - CONC. DROP INTAKE						Where Variable Equals
D"	D'	L'-D'+6"	S	Cu. Yds.		
23"	18"	2'-5"	8"	1.41	4'-6"	
30"	24"	3'-0"	8"	1.72	5'-0"	
37"	30"	3'-7"	9"	2.32	5'-6"	
44"	36"	4'-2"	9"	2.73	6'-0"	
51"	42"	4'-9"	10"	3.54	6'-6"	
58"	48"	5'-4"	10"	4.01	7'-0"	


Note: Dimension "X" is assumed as 2'-4" in figuring the above quantities.

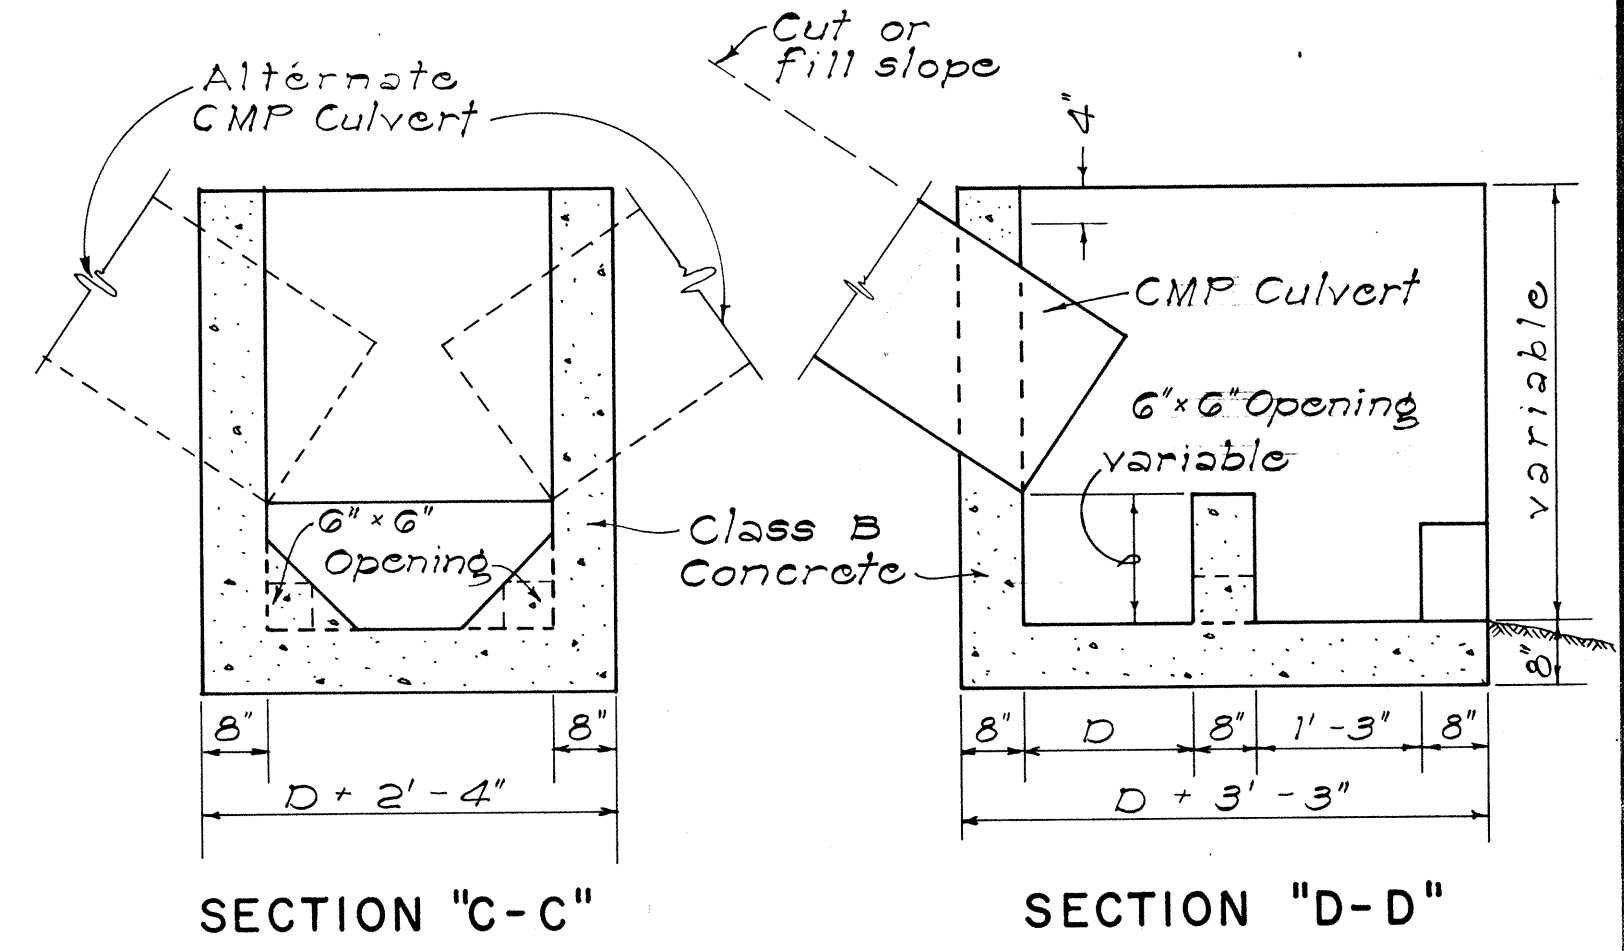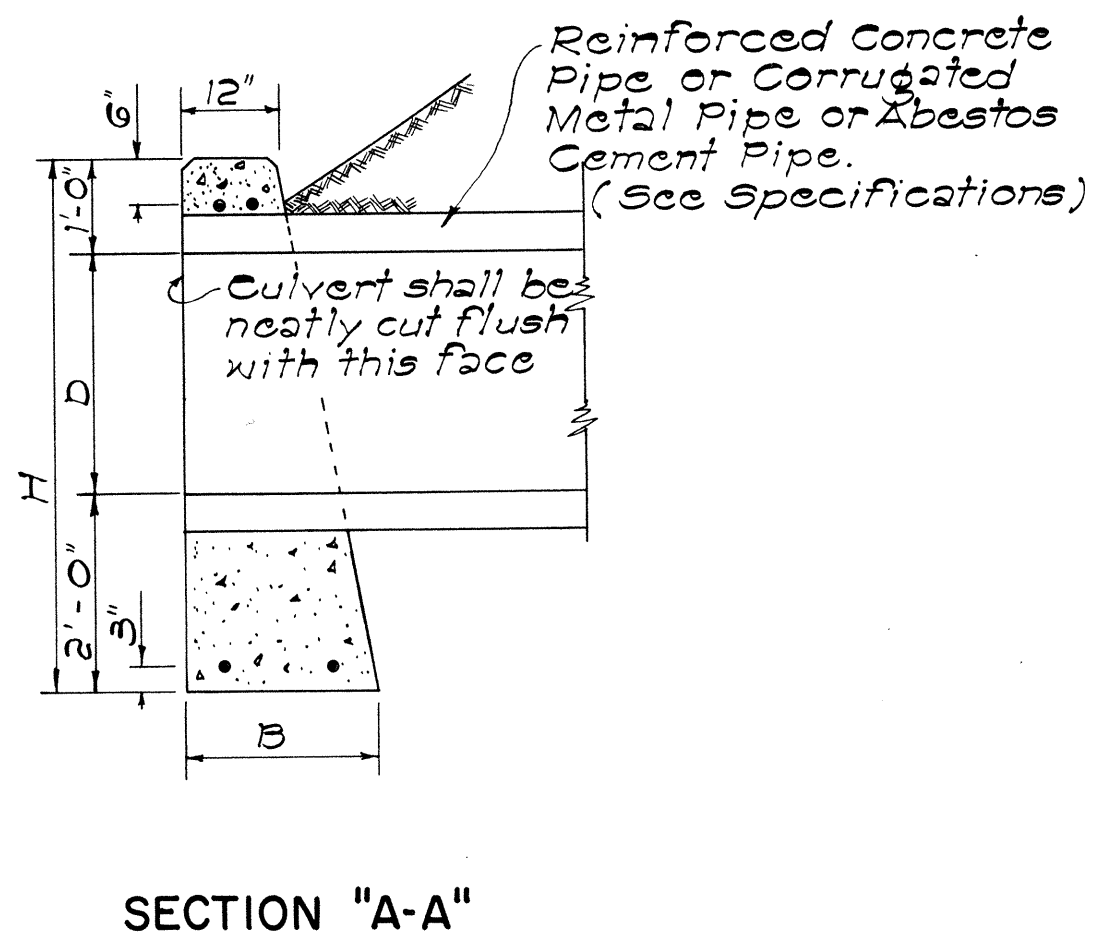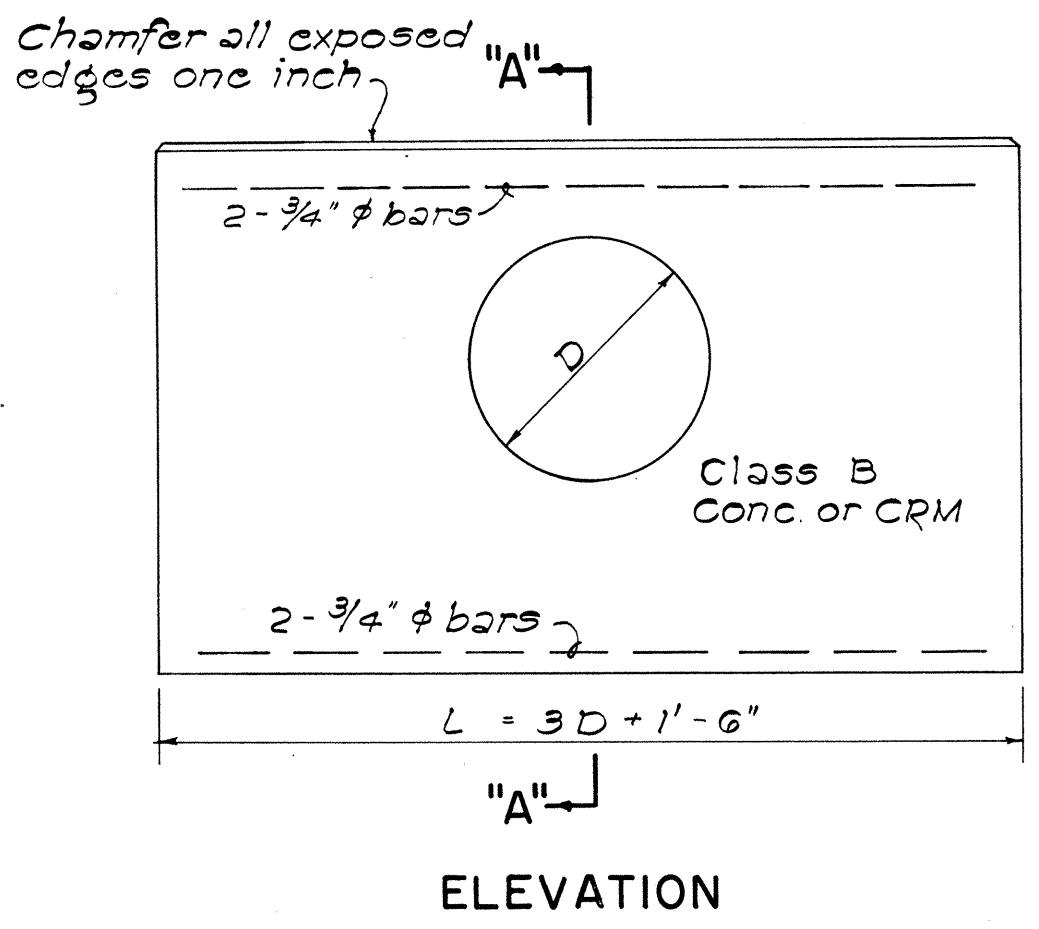



DATA FOR CONC. HEADWALL				CL. B CONC. FOR R.C.P.	CL. B CONC. FOR C.M.P.	Steel For One Headwall	
D	B	L	H	Cu. Yd.	Cu. Yd.	No. of Bars	Length Lbs.
18"	1'-6"	6'-0"	4'-6"	1.12	1.17	4	34' 5'-6" 33
24"	1'-6"	7'-6"	5'-0"	1.52	1.60	4	34' 7'-0" 42
30"	2'-0"	9'-0"	5'-6"	2.36	2.49	4	34' 8'-6" 51
36"	2'-0"	10'-6"	6'-0"	2.94	3.13	4	34' 10'-0" 60
42"	2'-6"	12'-0"	6'-6"	4.19	4.47	4	34' 11'-6" 69
48"	2'-6"	13'-6"	7'-0"	5.01	5.36	4	34' 13'-0" 78

DATA - MASONRY HEADWALL				CRM FOR R.C.P.	CRM FOR C.M.P.
D	B	L	H	Cu. Yd.	Cu. Yd.
18"	1'-9"	6'-0"	4'-6"	1.24	1.29
24"	2'-0"	7'-6"	5'-0"	1.83	1.92
30"	2'-3"	9'-0"	5'-6"	2.56	2.70
36"	2'-6"	10'-6"	6'-0"	3.45	3.66


DETAIL OF HEADWALL
Scale: 1/2" = 1'-0"

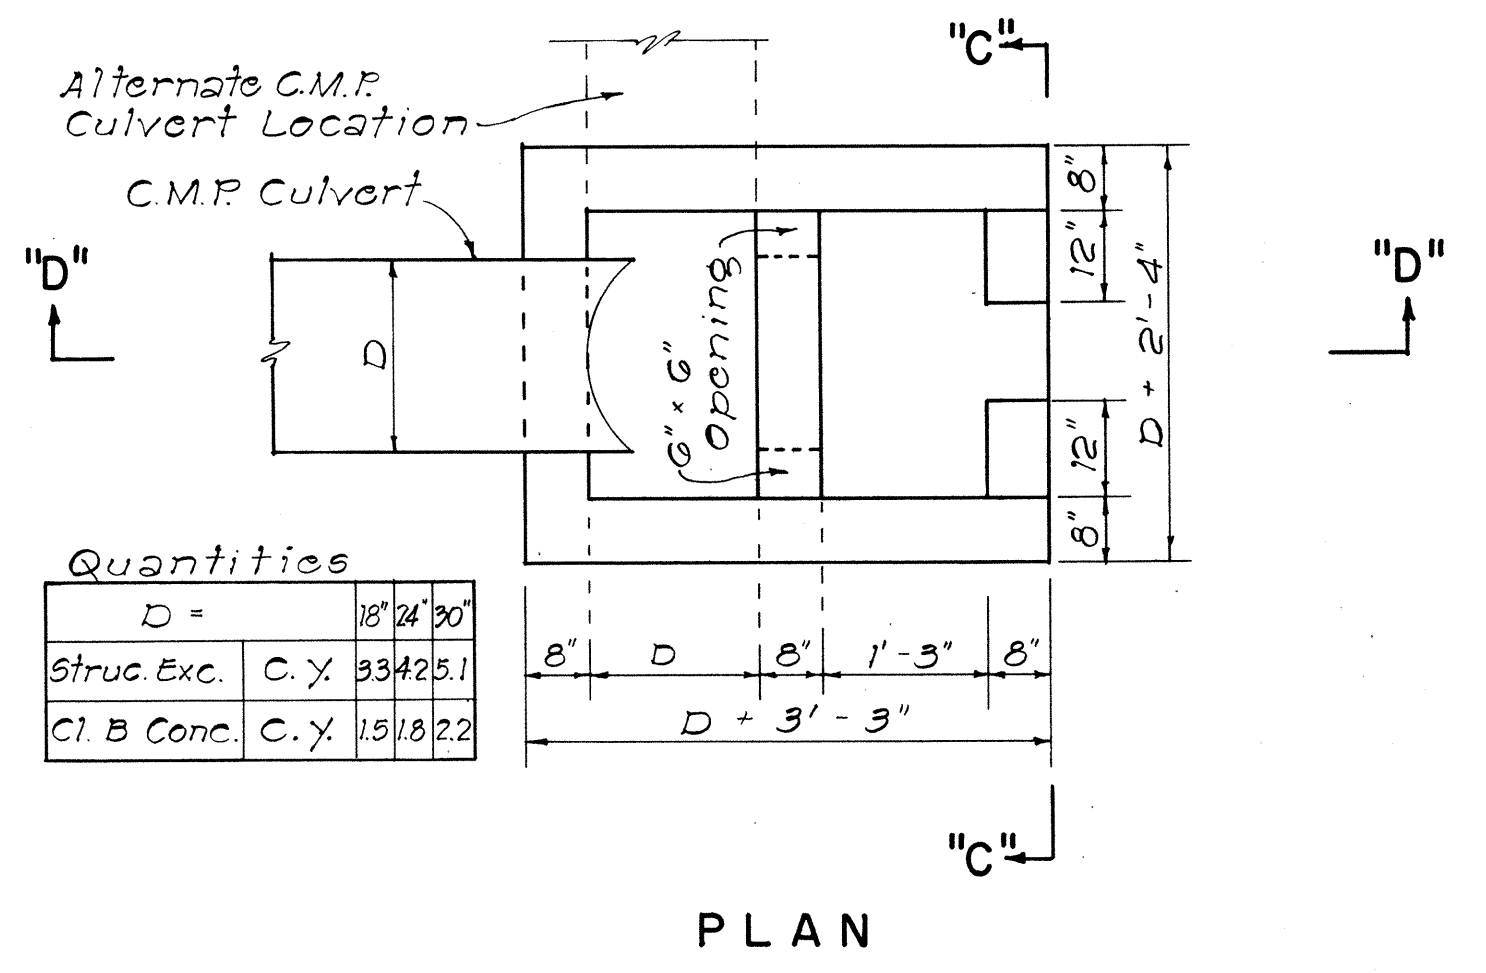

DETAILS OF CONC. DROP BOX AT
OUTLET OF CULVERT PIPE
NOT TO SCALE

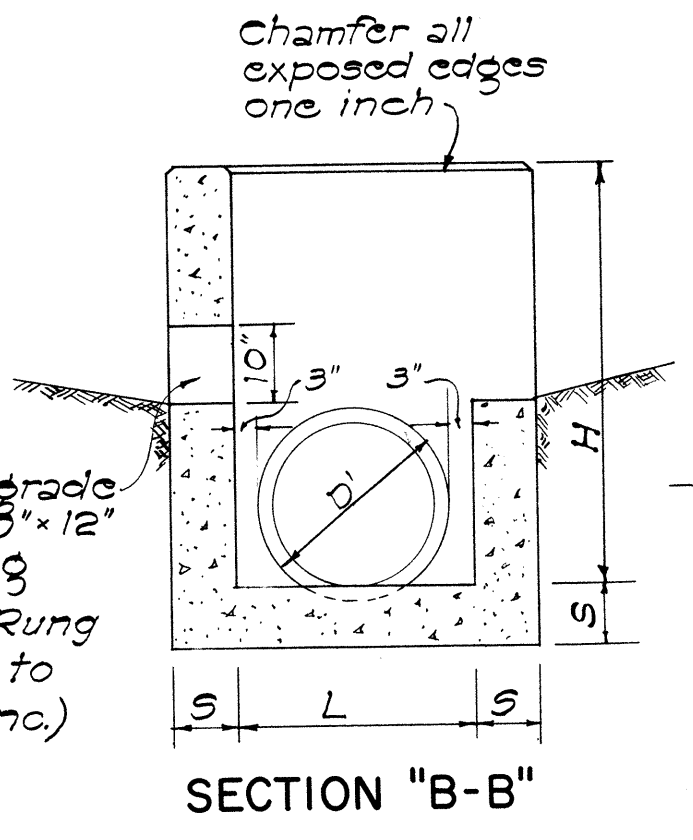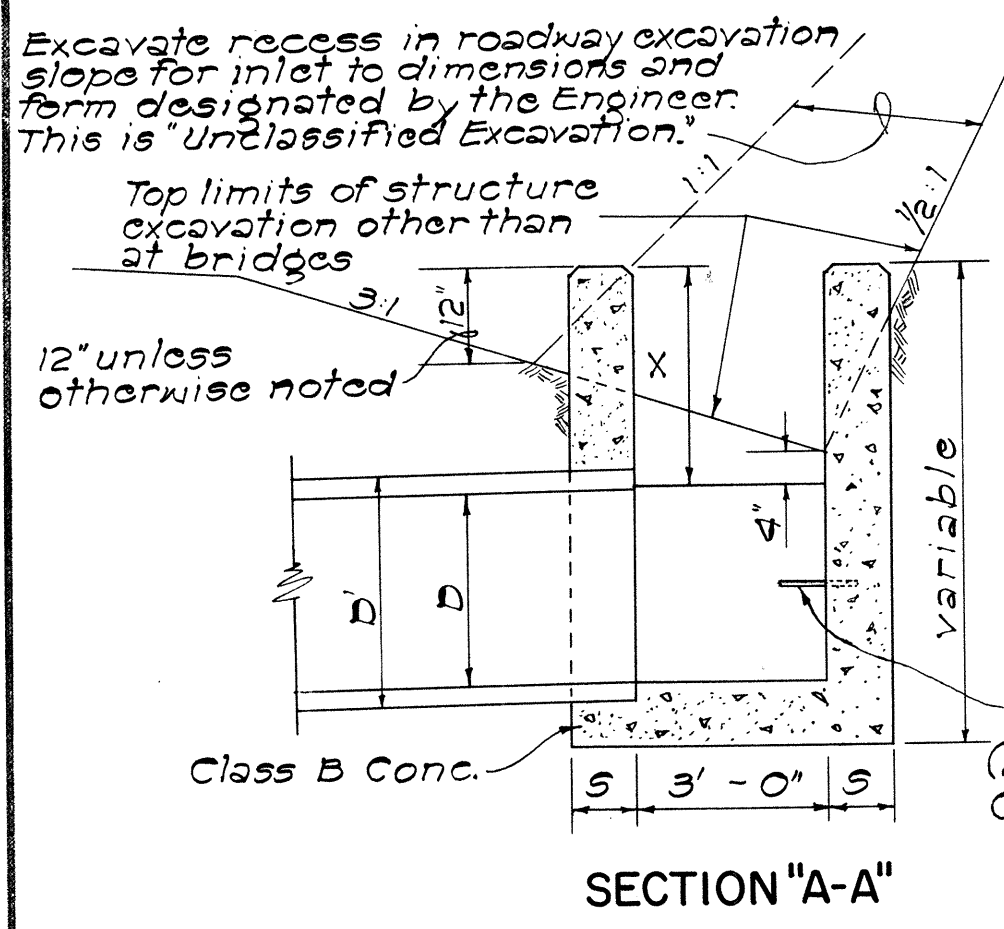

Note: When subgrade is below top of jacket, it shall be fully compacted to this line and then re-excavated (struc. exc.) to proper subgrade. This surface shall be rolled again.

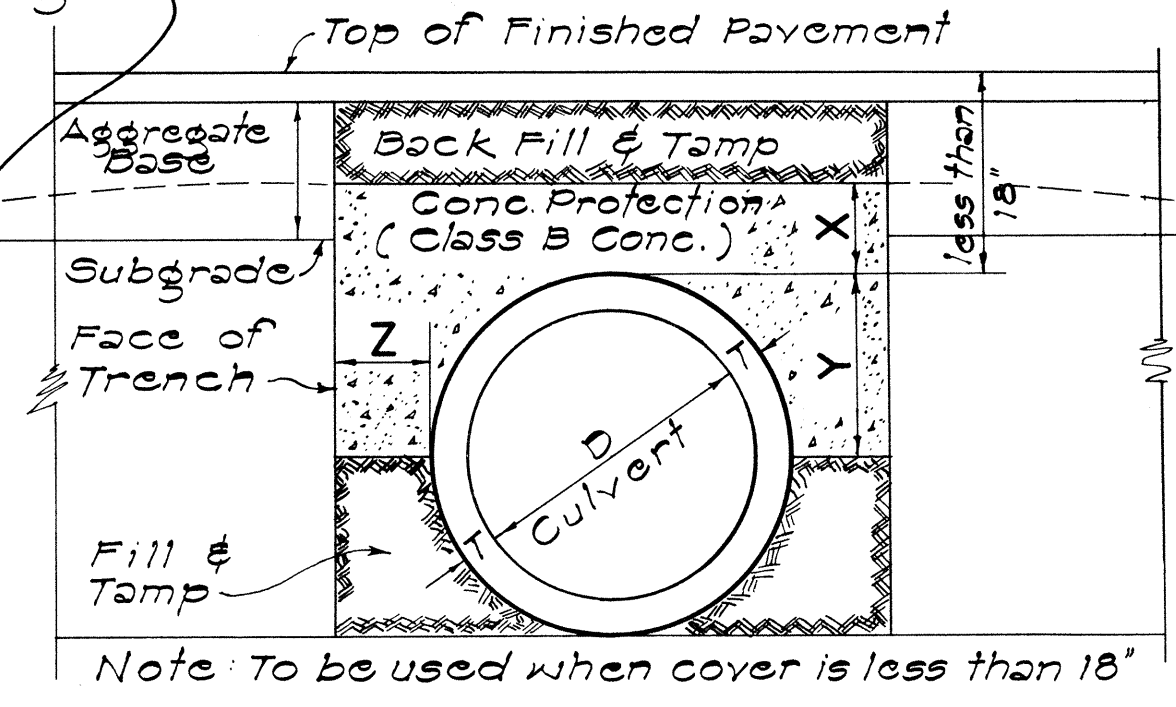

DATA FOR CONCRETE PROTECTION OVER CULVERTS		
X	Y	Z
6" for 18" D	$\frac{D}{2} + T$	Z must be from pipe to face of trench
7" for 24" D		Minimum = X
8" for 30" D		Maximum pay quantity will be Z = 12"
9" for 36" D		
10" for 42" D		
11" for 48" D		
12 for 54" D		

SECT. OF CULVERT WITH CONC. PROTECTION
Scale: 1" = 1'-0"

DETAIL OF CONCRETE DROP INTAKE
Scale: 1/2" = 1'-0"

GENERAL NOTES

- Culvert shall enter and leave Drop Intake from any position and in the direction indicated by the plans or ordered by the Engineer.
- D shall be the maximum outside dimension of the culvert at the Drop Intake wall.
- Manhole Rungs (16" o.c.) are required when "H" is greater than 4 feet 6 inches. Only one rung (12 inches from the bottom) is required if "H" is 4 feet 6 inches or less. Manhole Rungs may be placed at any location as ordered by the Engineer.

APPROVAL RECOMMENDED:
HYDRAULIC DESIGN ENGINEER 12-17-69 DATE

APPROVED:
ASSISTANT CHIEF, ENGINEERING 12-17-69 DATE

NO.	REVISION	APPROVED BY	DATE

STATE OF HAWAII
DEPARTMENT OF TRANSPORTATION
HIGHWAYS DIVISION

STANDARD DETAILS

DROP INTAKE, HEADWALL & CONCRETE PROTECTION

Scale: As Noted Date: Aug. 1967


SHEET No. 19D OF 25 SHEETS DH 10

SURVEY PLOTTED BY	DATE
DRAWN BY	
TRACED BY	
CHECKED BY	
NOTE BOOK	
NO.	


FED. ROAD DIST. NO.	STATE	FED. AID PROJ. NO.	FISCAL YEAR	SHEET NO.	TOTAL SHEETS
HAWAII	HAW.	I-HI-1(90)13	1972	60	202

GENERAL NOTES


- All concrete shall be Class "B" unless otherwise noted.
- Exposed edges of all drainage structures shall be chamfered one inch.
- Culvert shall enter and leave Drop Intake from any position and in the direction indicated by the plans or ordered by the Engineer.
- Manhole Rungs (16" o.c.) are req'd. when "H" is greater than 4'-6" Only one rung (12 inches from the bottom) is required if "H" is 4'-6" or less. Manhole Rungs may be placed at any location as ordered by the Engineer.

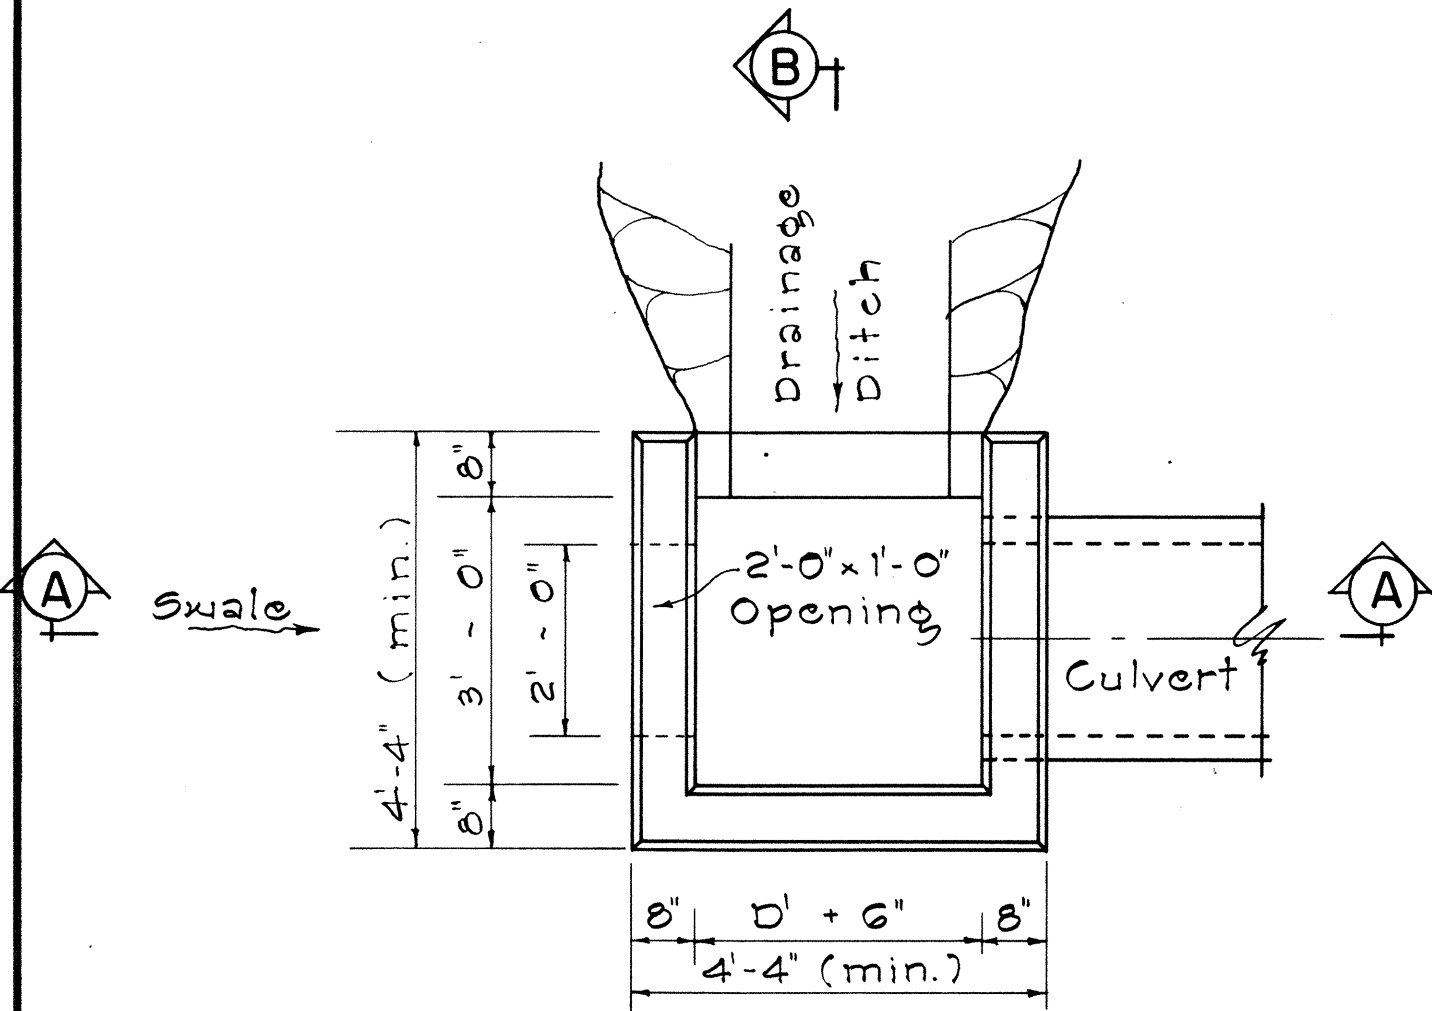

PLAN

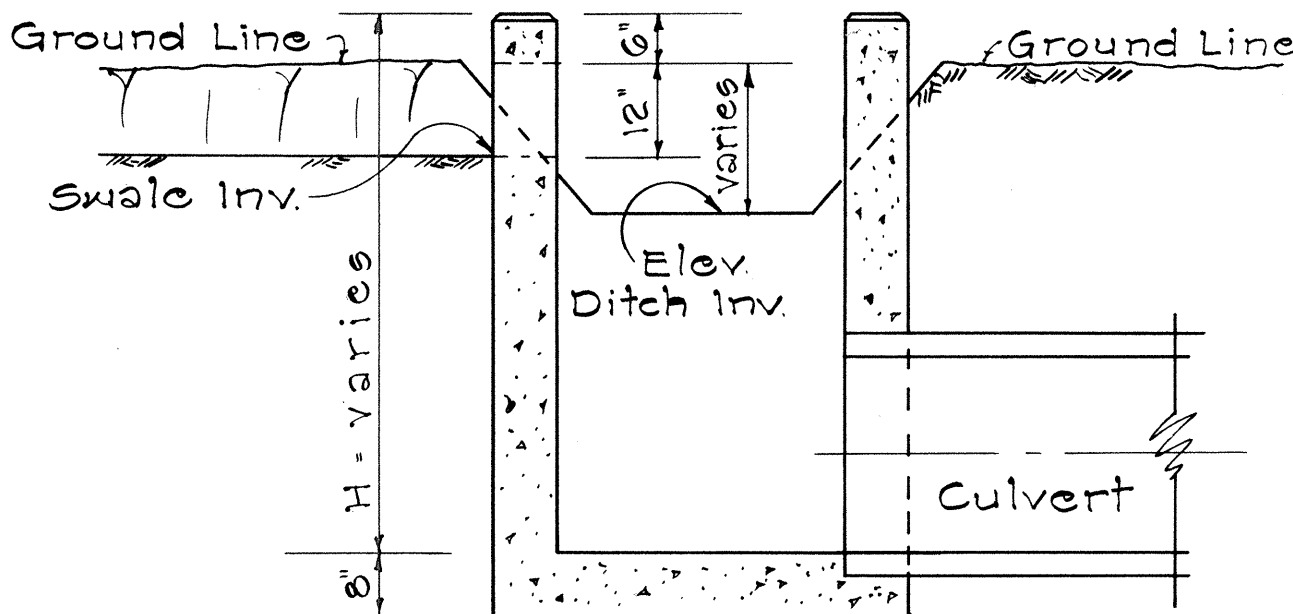


SECTION "A-A"

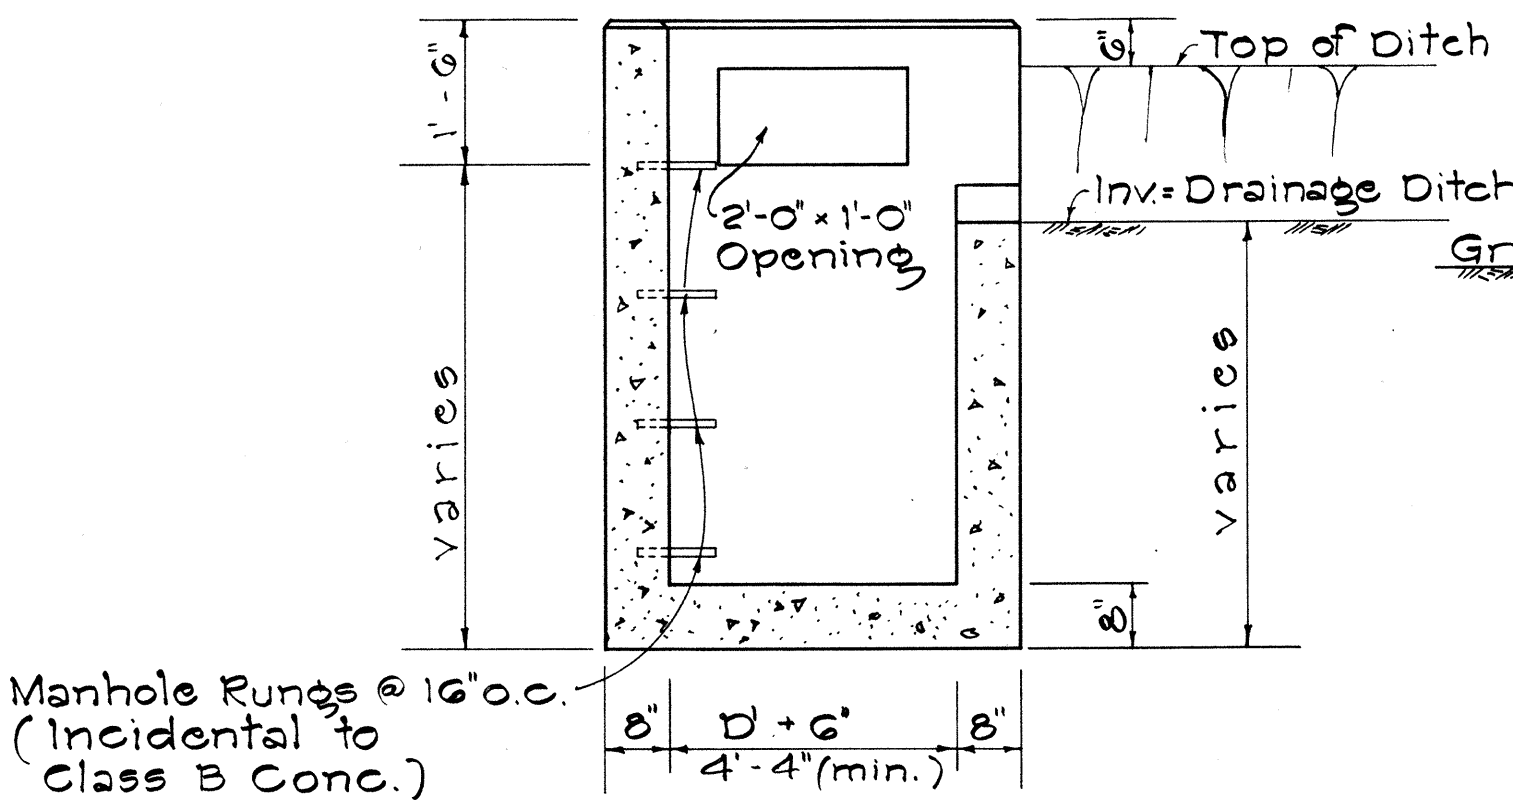


SECTION "B-B"

TYPE "A"
CONCRETE DROP INTAKE


Scale: 1/2" = 1'-0"

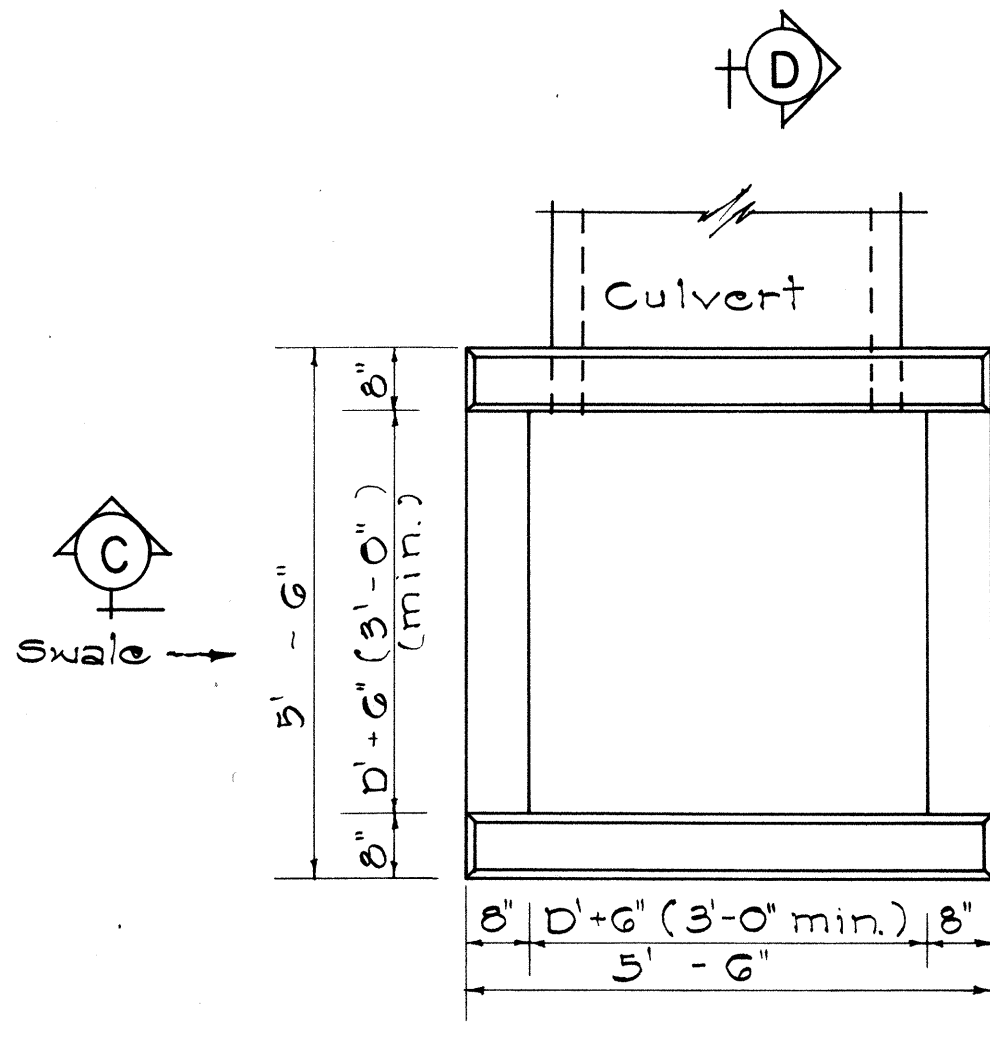

PLAN

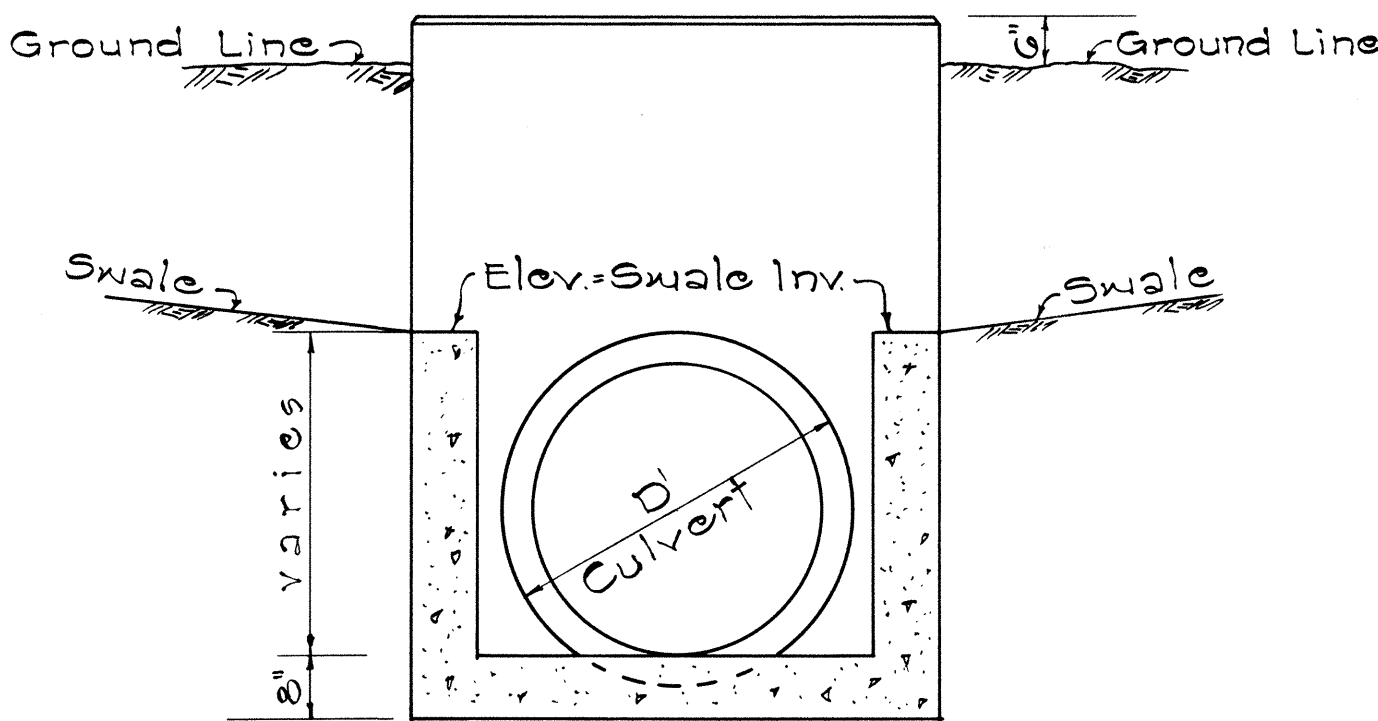


SECTION "C-C"

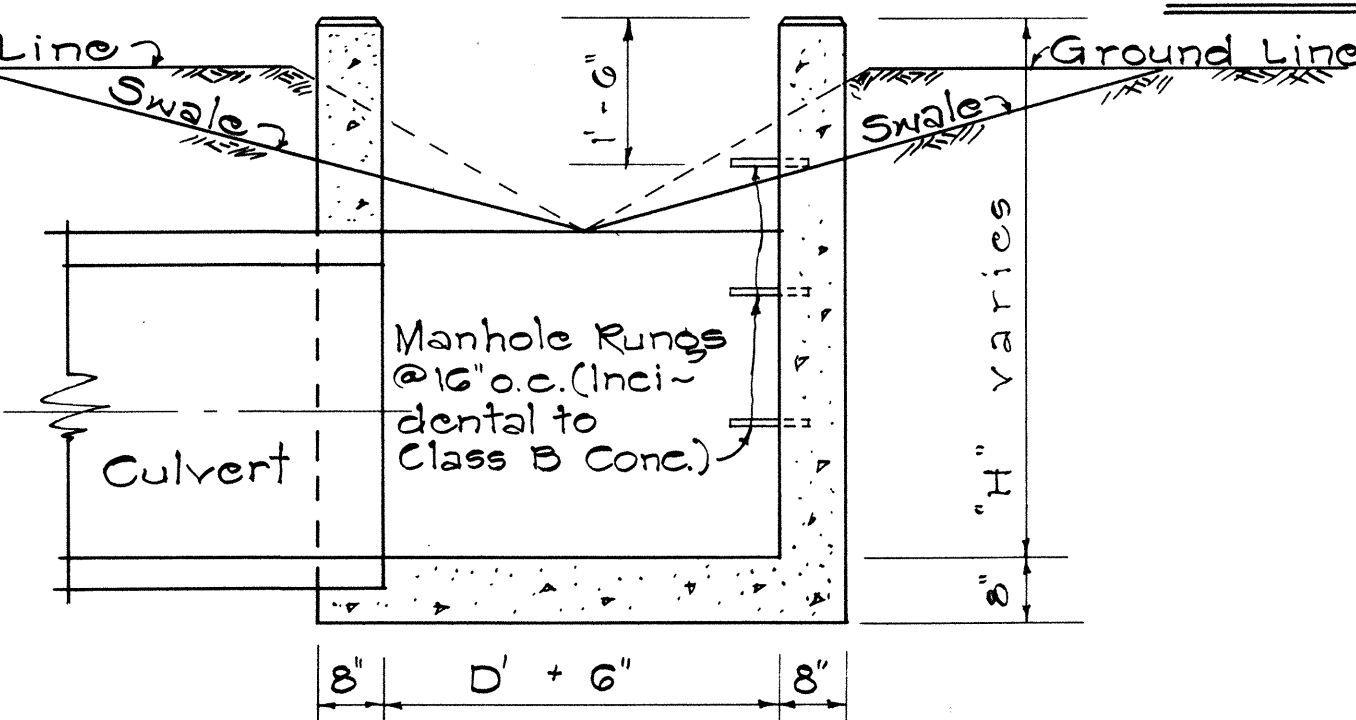


SECTION "D-D"

TYPE "B"
CONCRETE DROP INTAKE

Scale: 1/2" = 1'-0"

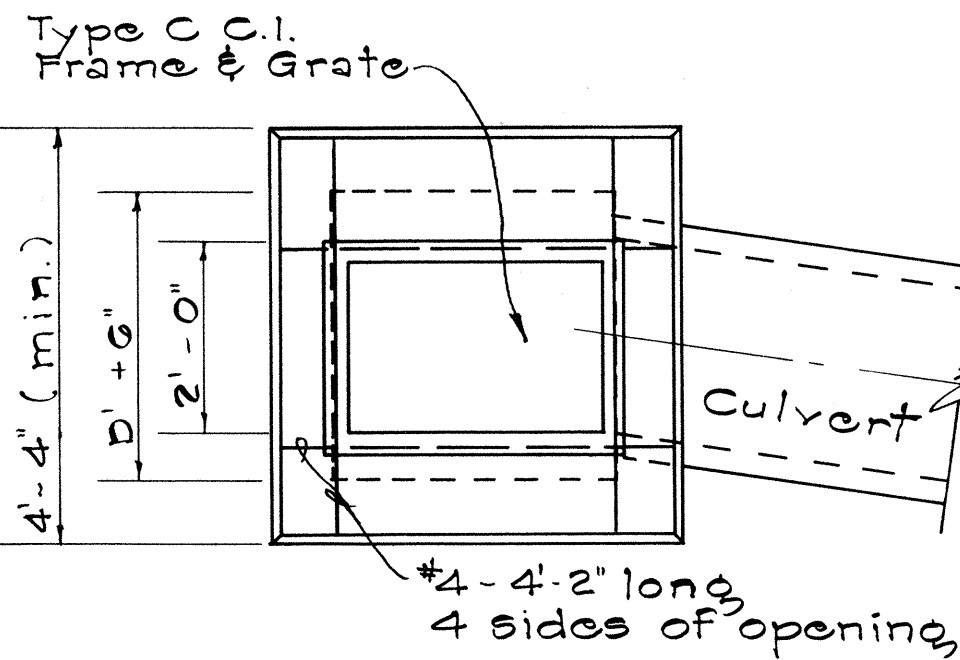


PLAN

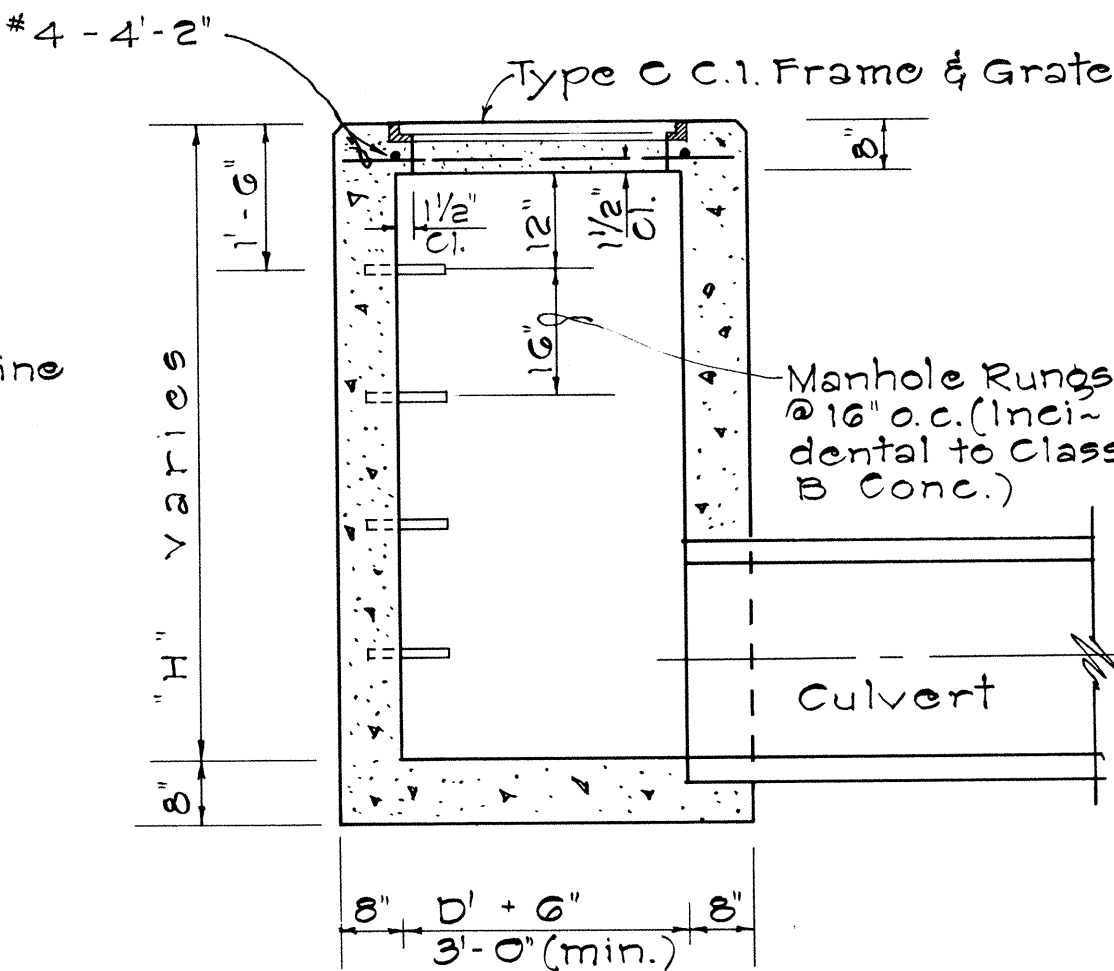


SECTION "E-E"

TYPE "C" GRATED
CONCRETE DROP INTAKE


Scale: 1/2" = 1'-0"

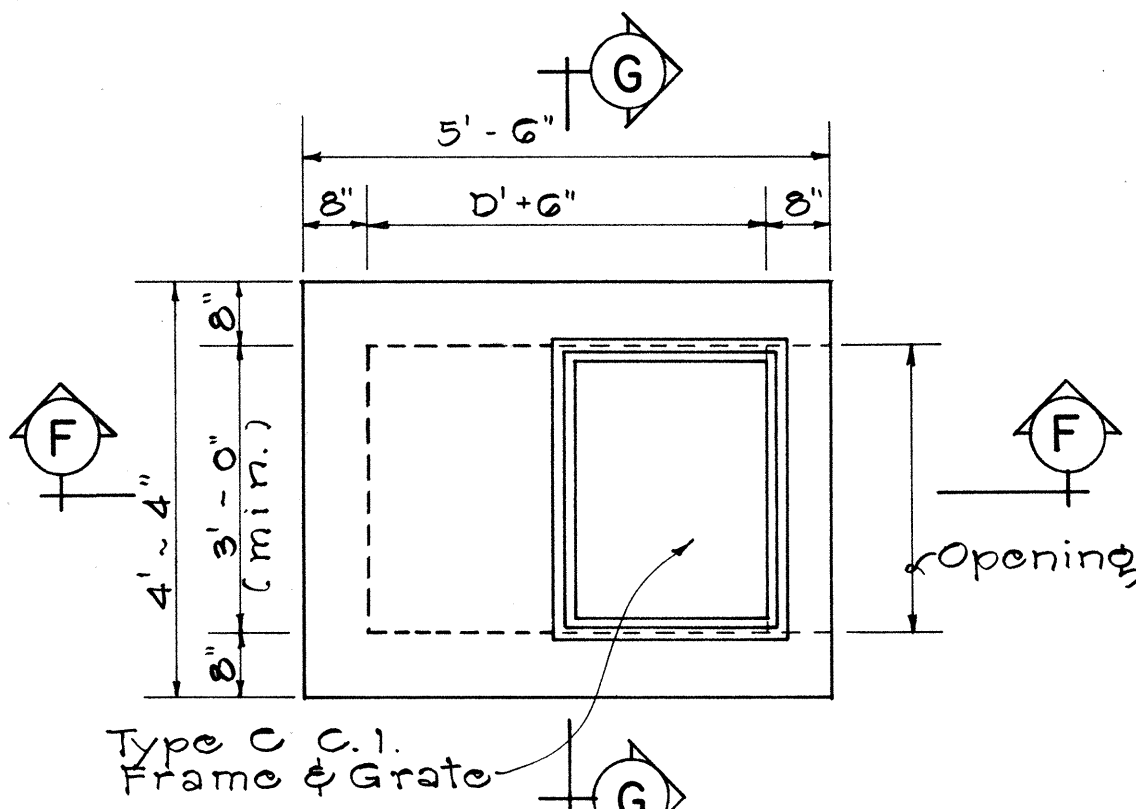

PLAN

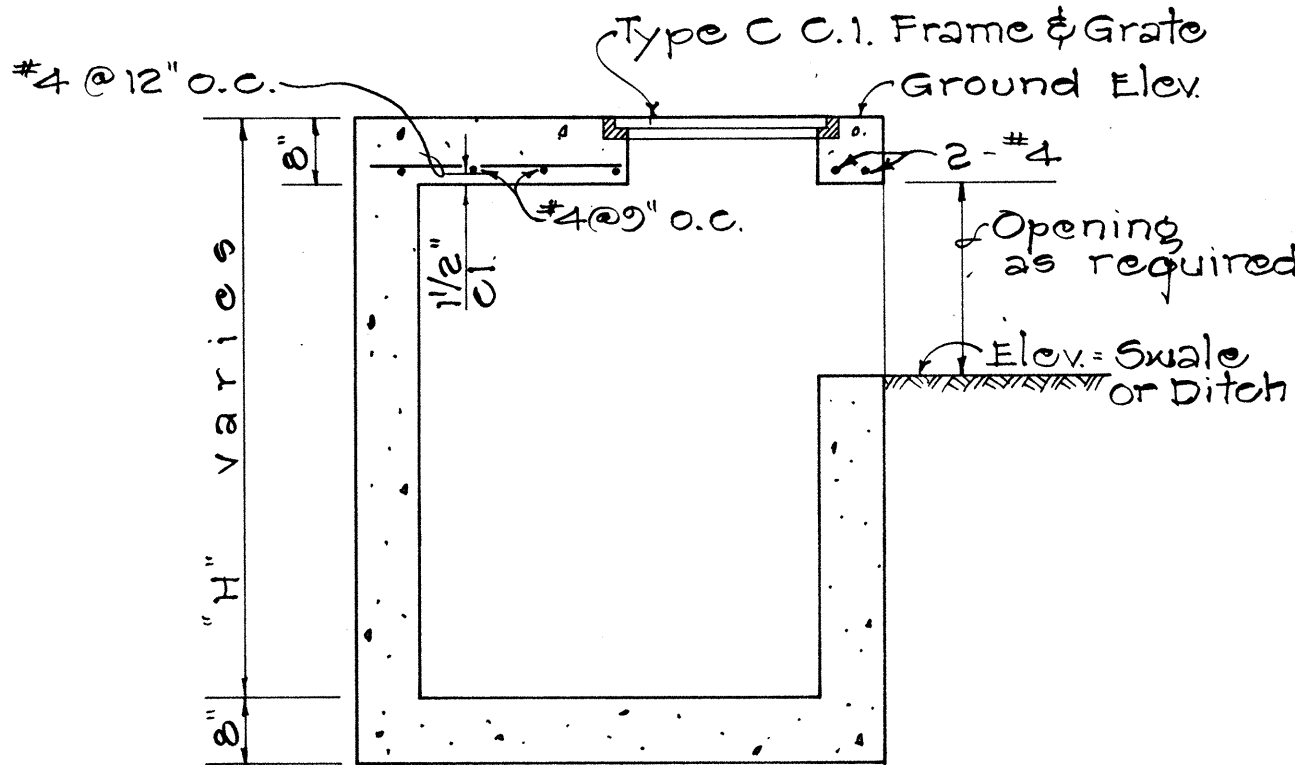

SECTION "F-F"

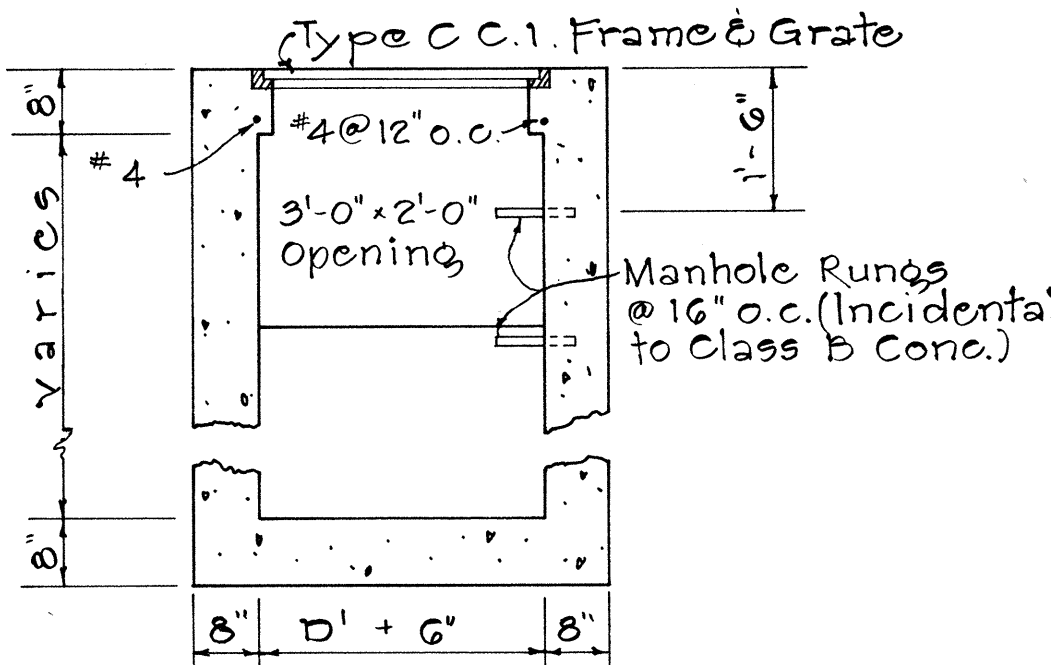

SECTION "G-G"

TYPE "D" GRATED
CONCRETE DROP INTAKE

Scale: 1/2" = 1'-0"

APPROVAL RECOMMENDED:
HYDRAULIC DESIGN ENGINEER
APPROVED:
ASSISTANT CHIEF, ENGINEERING

12-17-69
DATE

12-17-69
DATE


NO.	REVISION	APPROVED BY	DATE

STATE OF HAWAII
DEPARTMENT OF TRANSPORTATION
HIGHWAYS DIVISION
STANDARD DETAILS
TYPE "A", "B", "C", AND "D"
CONCRETE DROP INTAKE


Scale: As Noted
Date: July, 1969
SHEET No. 20D OF 25 SHEETS

FED. ROAD DIST. NO.	STATE	FED. AID PROJ. NO.	FISCAL YEAR	SHEET NO.	TOTAL SHEETS
HAWAII	HAWAII	I-HI-1(90):13	1972	61	202

NOTE:
Reinforced concrete manhole walls (See detail of plain manhole) shall be used for portions below the water table.

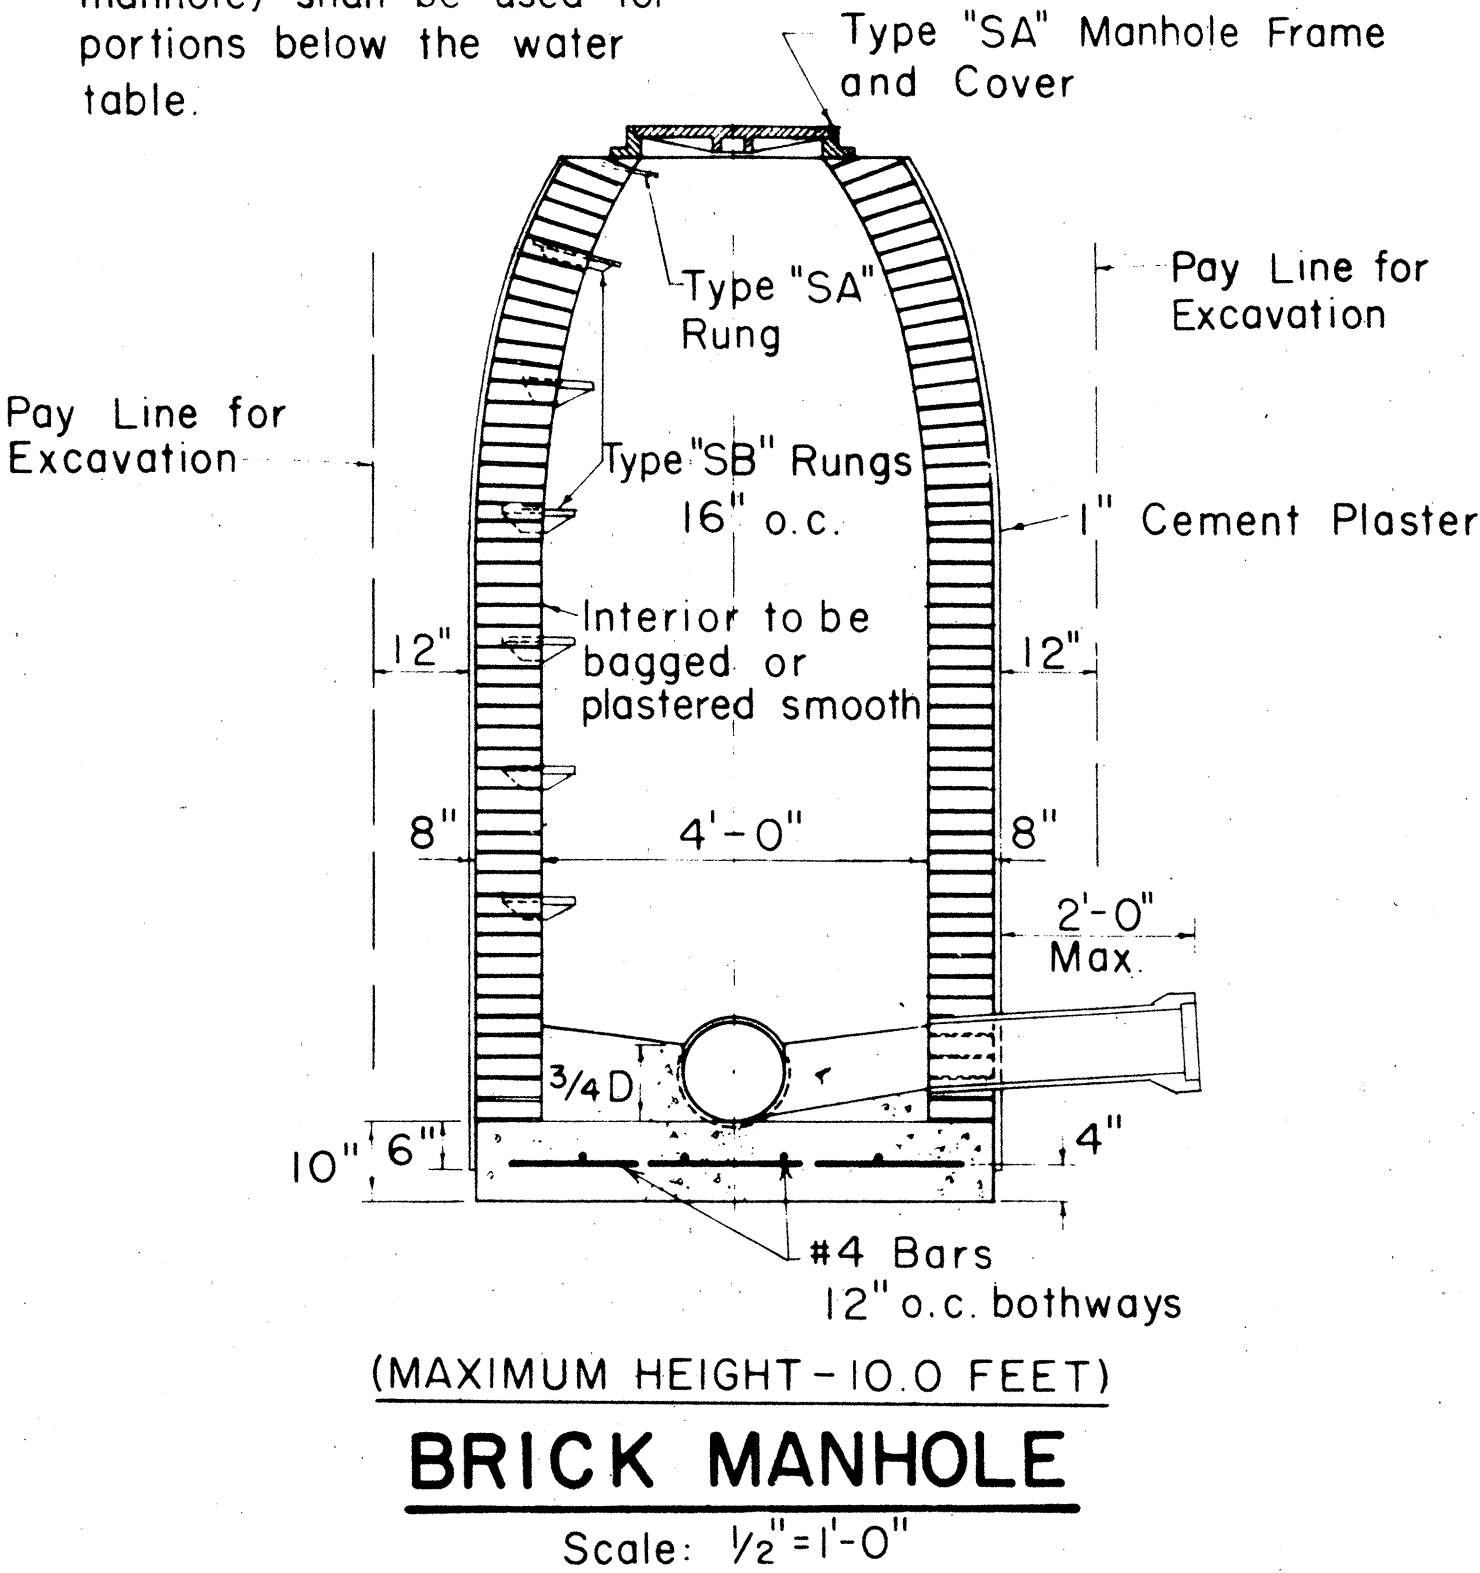

Payment for excavation for manholes shall be made under the item "Structure Excavation other than at Bridges" and shall be measured to one foot outside of walls from original ground elevation to authorized bottom elevation. Payment for manhole walls (brick, concrete, or cast-in-place concrete) shall include brick, mortar, concrete, reinforcing steel, cast iron steps, galvanized wrought iron rungs, and plastering, and be paid for under the item "Walls for Sewer Manhole." Payment for manhole bases shall be made under the item "Class B Concrete other than in Bridges" and "Reinforcing Steel other than in Bridges."

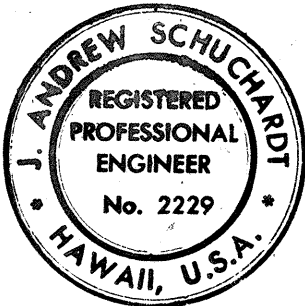

THIS WORK WAS PREPARED BY ME OR UNDER MY SUPERVISION.

J. Andrew Schuchardt

STATE OF HAWAII
DEPARTMENT OF TRANSPORTATION
HIGHWAYS DIVISION
DIVISION OF SEWERS
CITY & COUNTY OF HONOLULU


SEWERS: PRE- CAST AND
BRICK MANHOLE DETAILS

INTERSTATE ROUTE H-1
PROJECT NO I-HI-1(90):13


Scales: As Noted
Date: DEC. 24, 1970

APPROVED:

J. Andrew Schuchardt 1/4/71
Chief, Division of Sewers 61 DATE

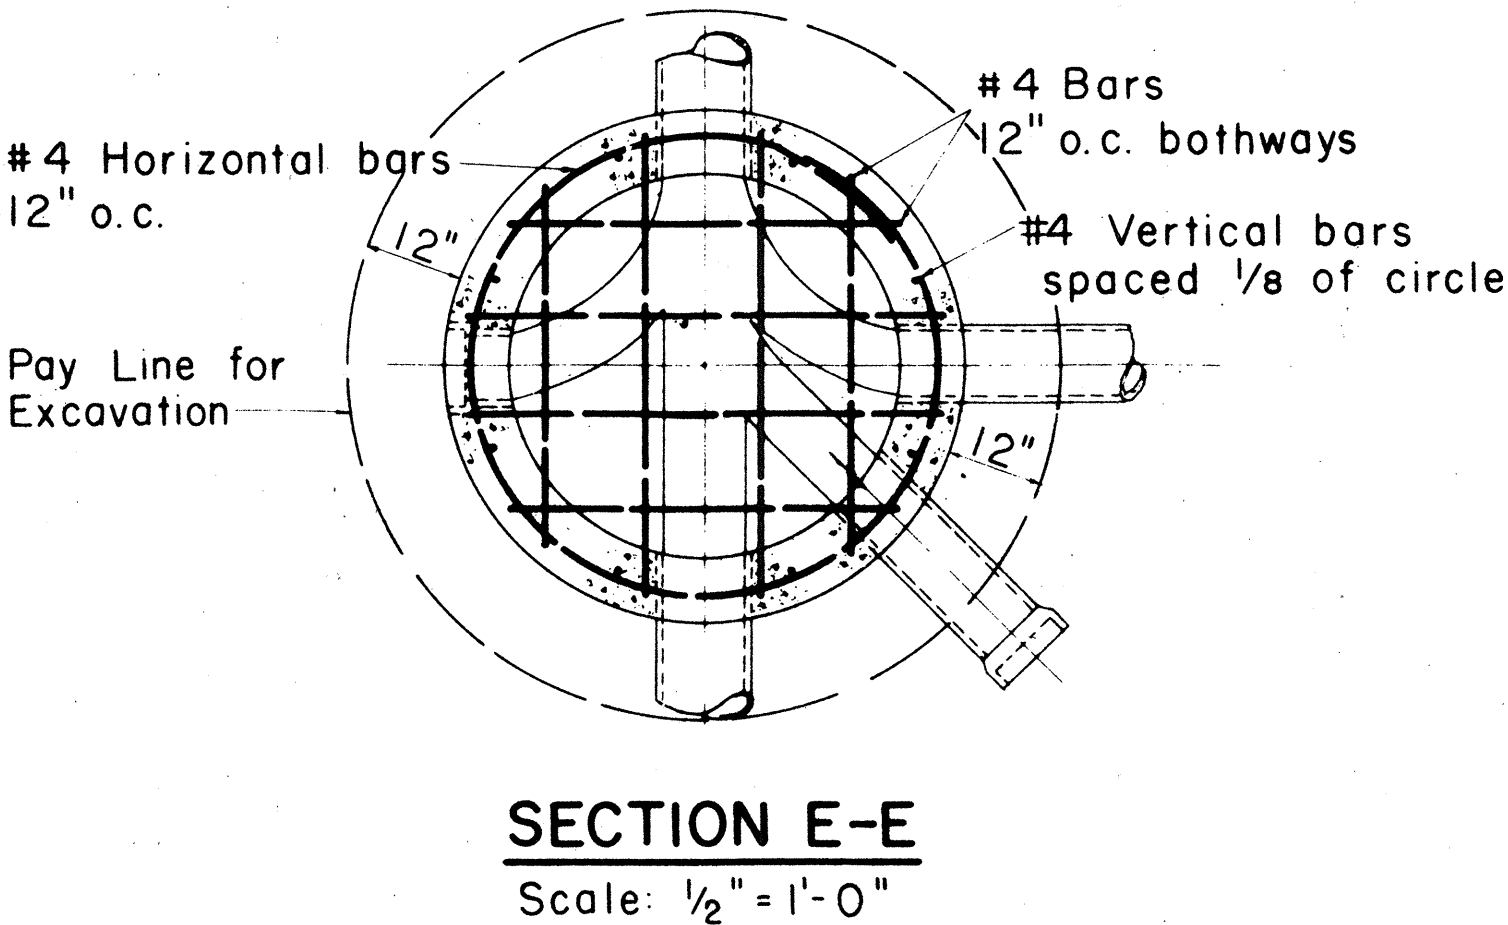

SECTION E-E
Scale: 1/2" = 1'-0"

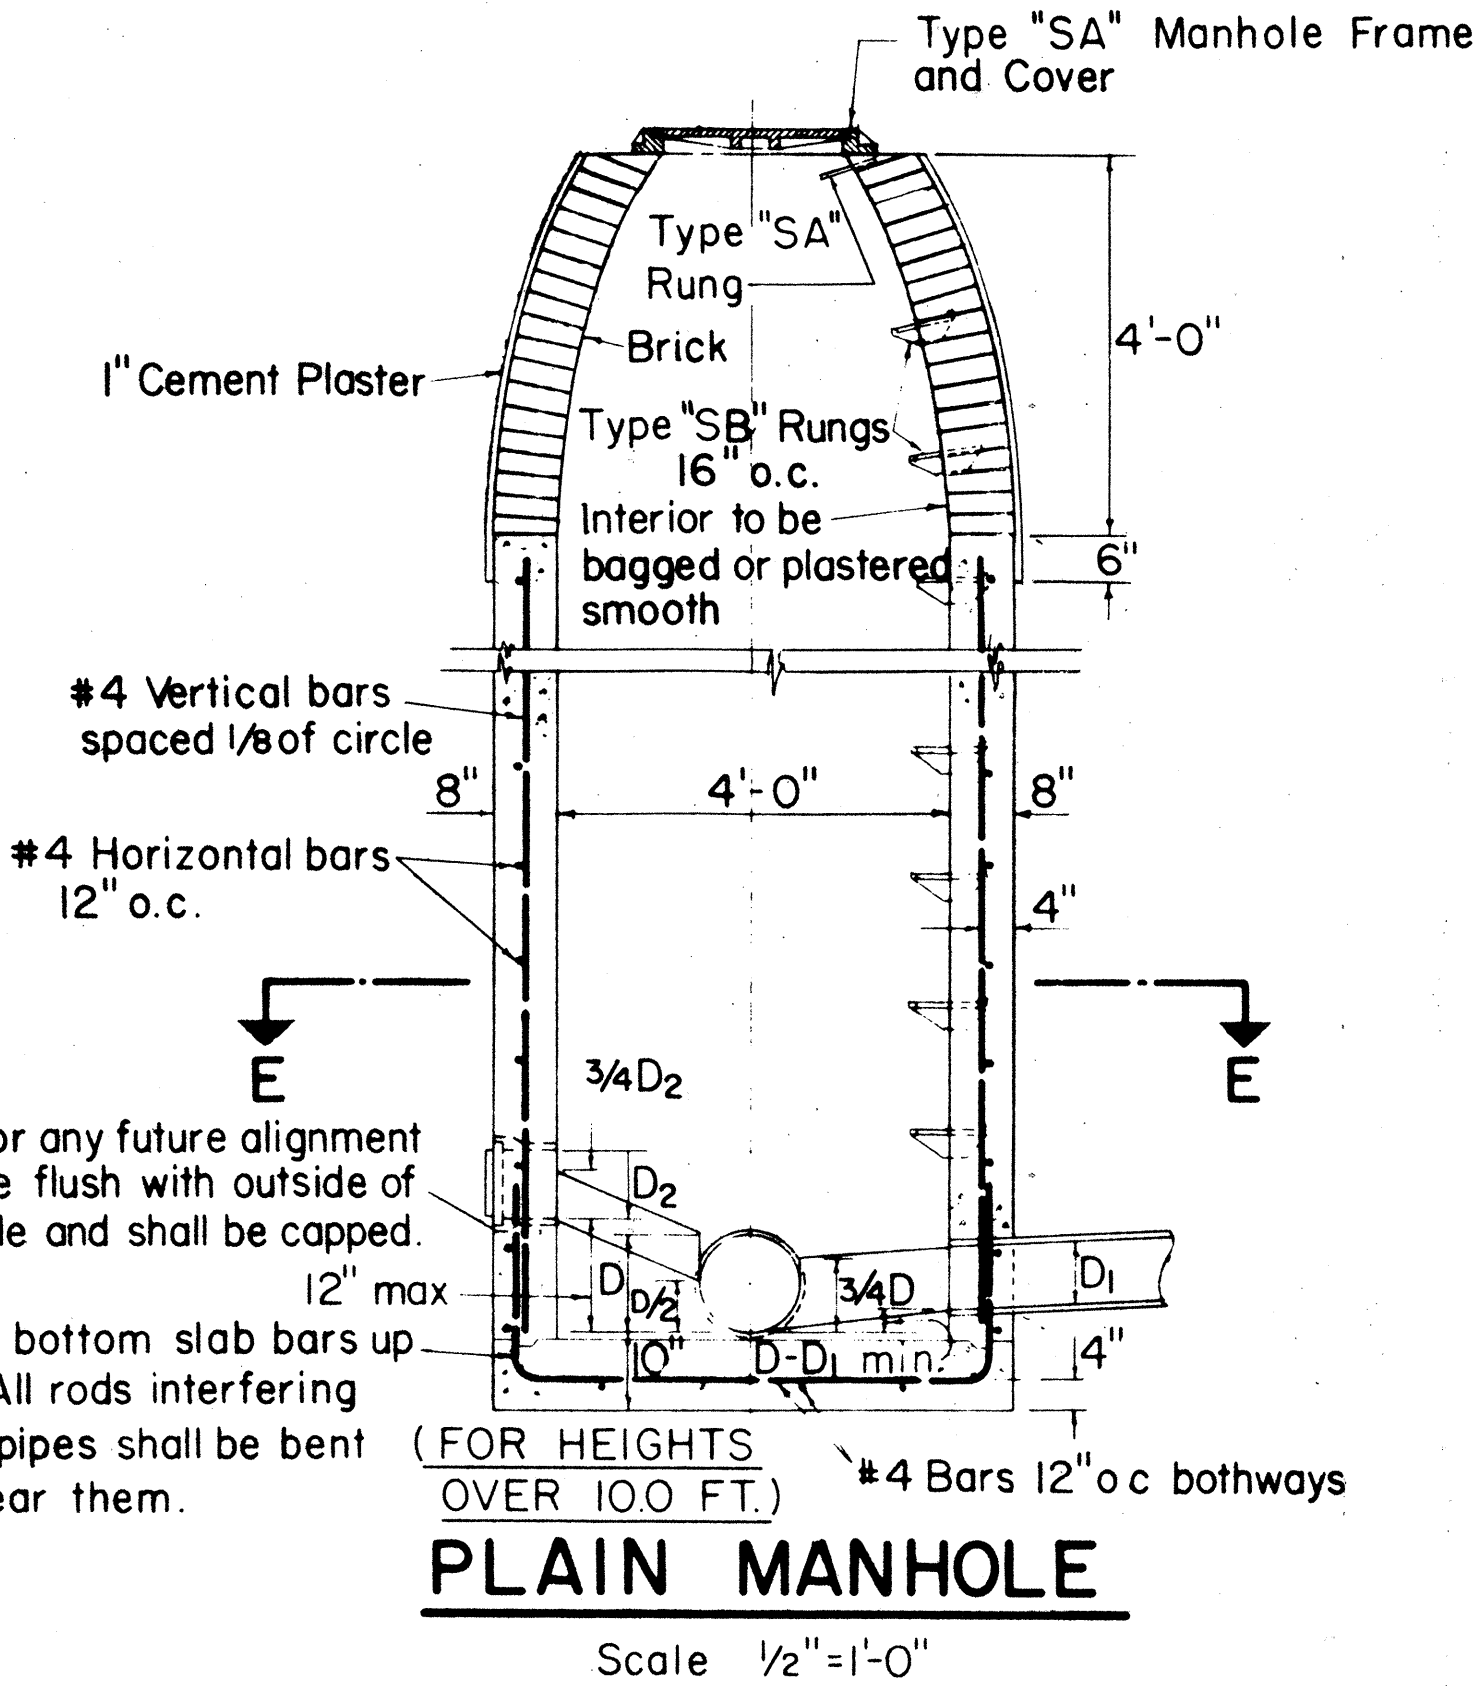

PLAIN MANHOLE


Scale 1/2" = 1'-0"

Stub for any future alignment shall be flush with outside of manhole and shall be capped.

Bend bottom slab bars up 24" All rods interfering with pipes shall be bent to clear them.

(FOR HEIGHTS OVER 10.0 FT.)

#4 Bars 12" o.c. bothways

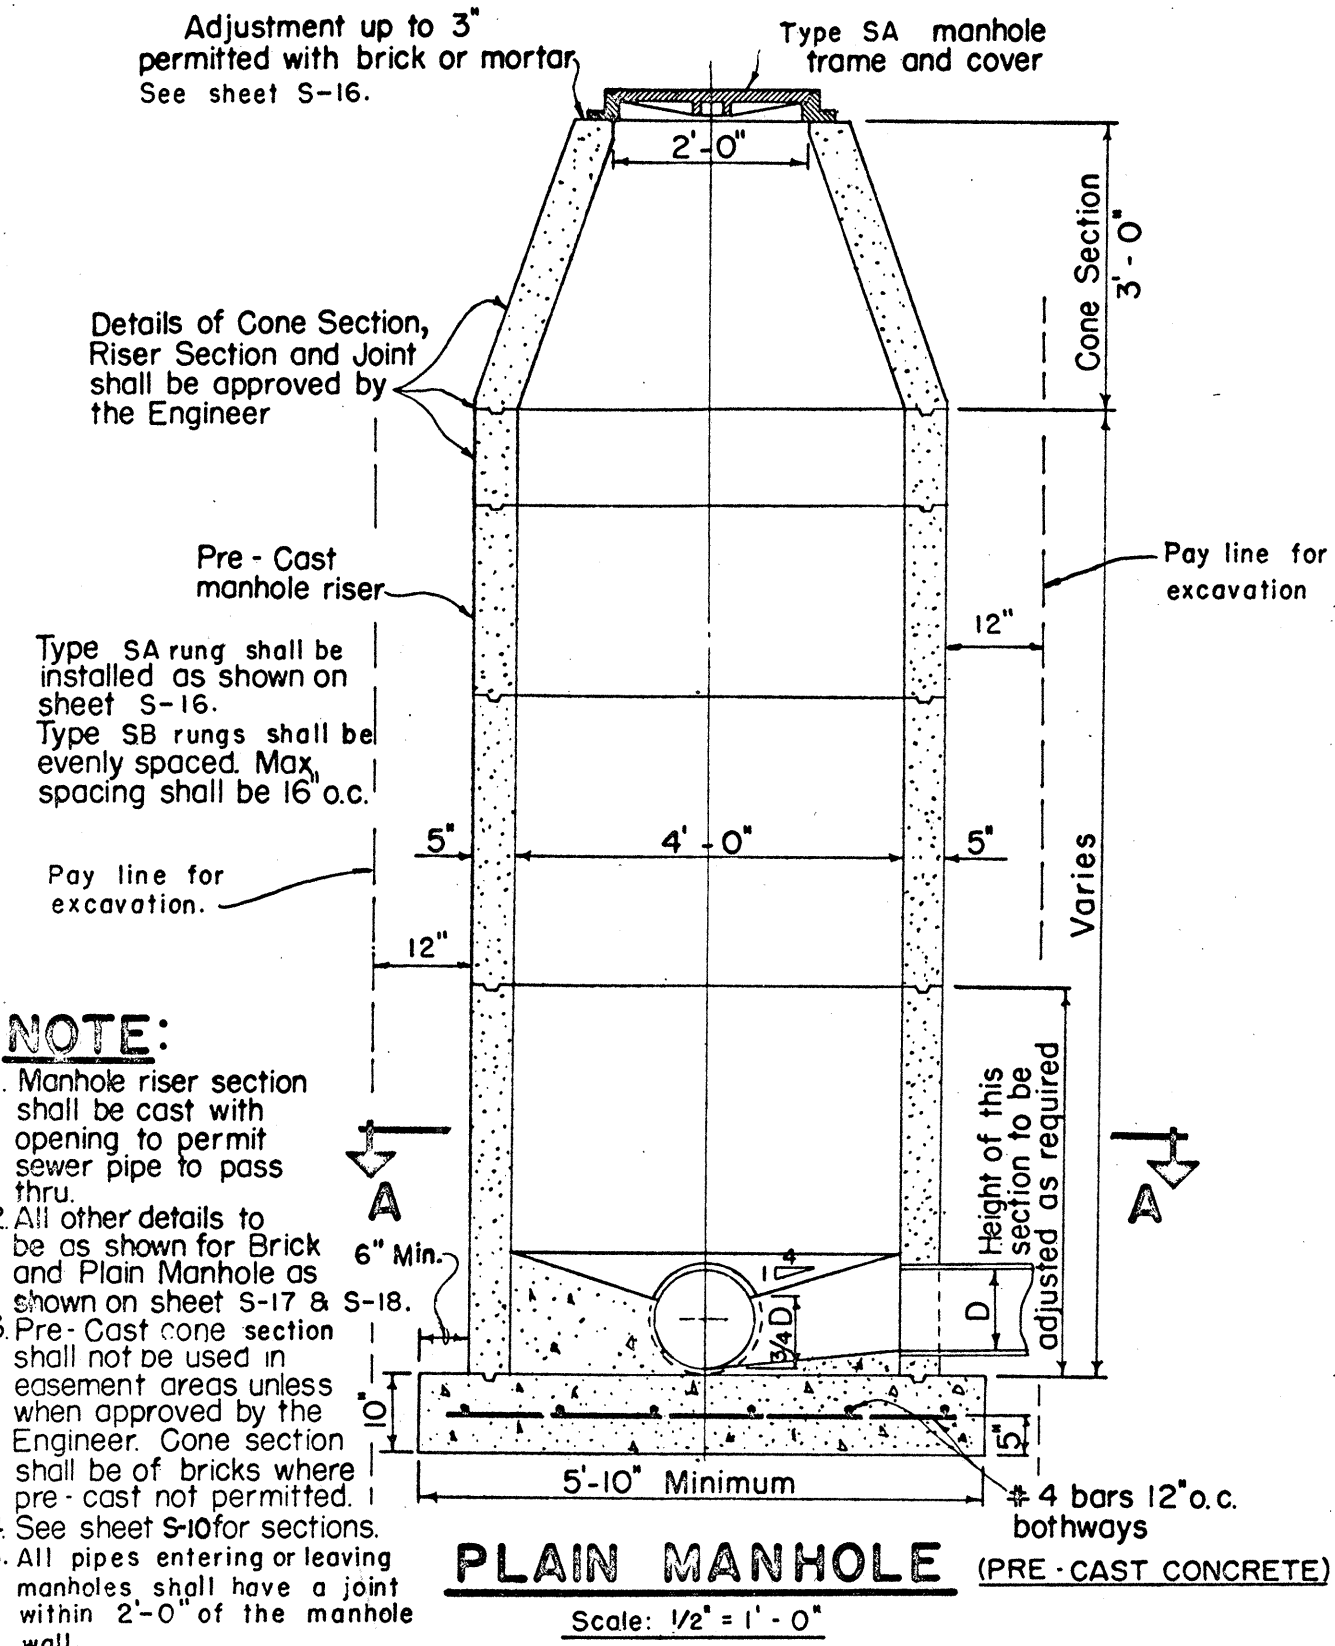


PLAIN MANHOLE

Scale: 1/2" = 1'-0"


- NOTE:
- Manhole riser section shall be cast with opening to permit sewer pipe to pass thru.
 - All other details to be as shown for Brick and Plain Manhole as shown on sheet S-17 & S-18.
 - Pre-Cast cone section shall not be used in easement areas unless when approved by the Engineer. Cone section shall be of bricks where pre-cast not permitted.
 - See sheet S-10 for sections.
 - All pipes entering or leaving manholes shall have a joint within 2'-0" of the manhole wall.

Where sewer runs straight thru the manhole, the Contractor may lay pipe thru manhole with the manhole invert and base poured together. After concrete has hardened, the upper portion of pipe within the manhole shall be carefully broken out. All unevenness shall be patched with mortar.

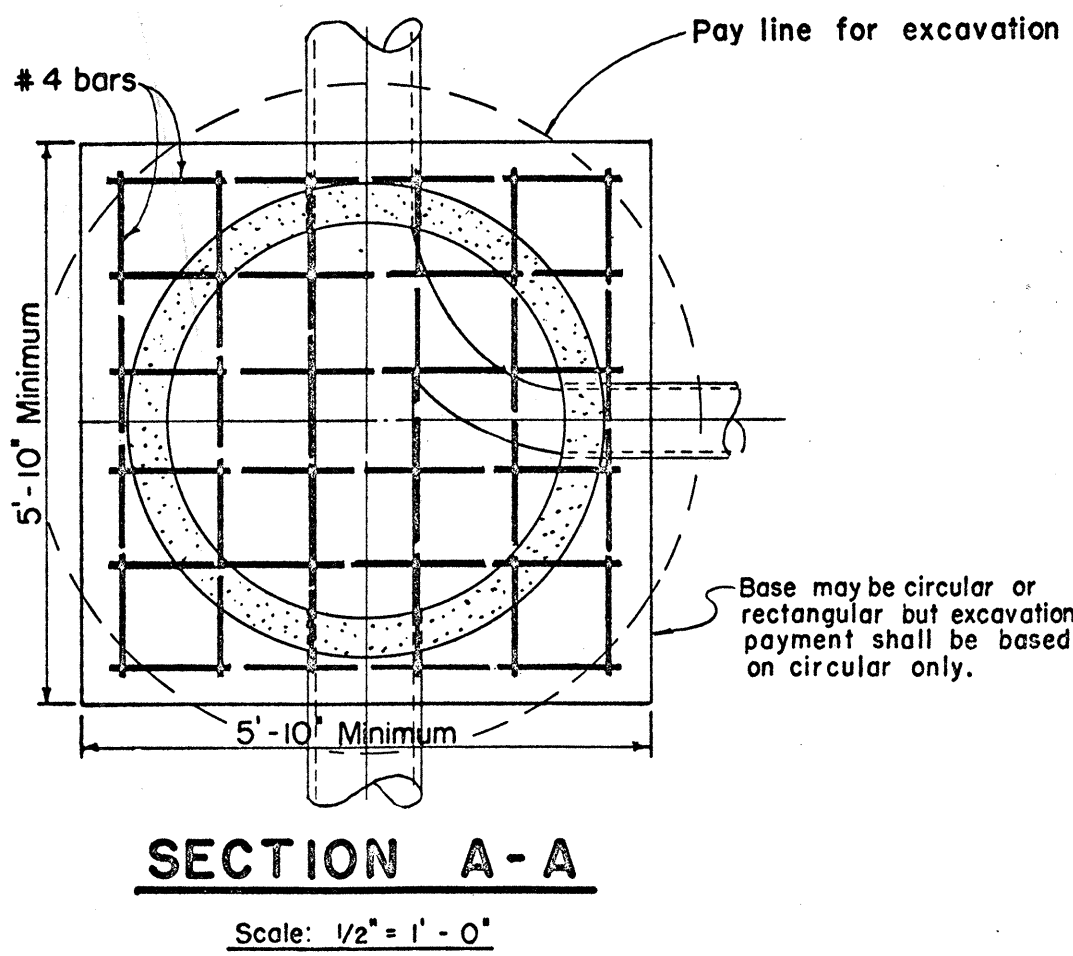

SECTION A-A

Scale: 1/2" = 1'-0"

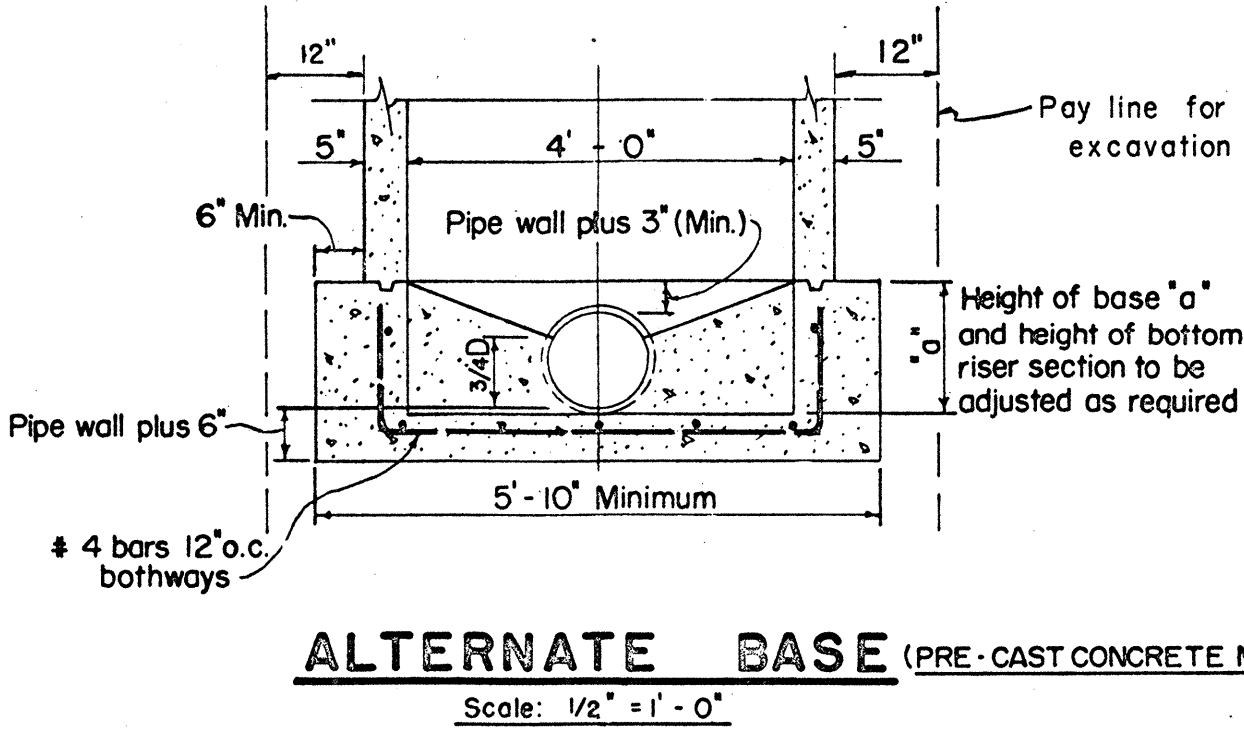

ALTERNATE BASE (PRE-CAST CONCRETE M.H.)

Scale: 1/2" = 1'-0"

NOTE


- Manhole rungs shall not be aligned above any flow line except in drop manhole.
- No rungs shall be installed in manholes less than 3' high.
- When not otherwise noted, manhole stubs shall be sloped as follows:

Pipe Size	Rise Per Foot
6"	1/8"
8"	3/32"
10"	1/16"
12"	1/16"

- All reinforcing rods interfering with pipes shall be bent to clear them.
- Bar lap to be 40 diameters in length.
- All class C concrete to be incidental to class B concrete.


- Manhole wall to be of reinforced concrete to height 1' above normal ground water table.
- All pipes entering or leaving manholes shall have a joint within 2'-0" of the manhole wall.

FED. ROAD DIST. NO.	STATE	FED. AID PROJ. NO.	FISCAL YEAR	SHEET NO.	TOTAL SHEETS
HAWAII	HAWAII	I-HI-(90)13	1972	63	202

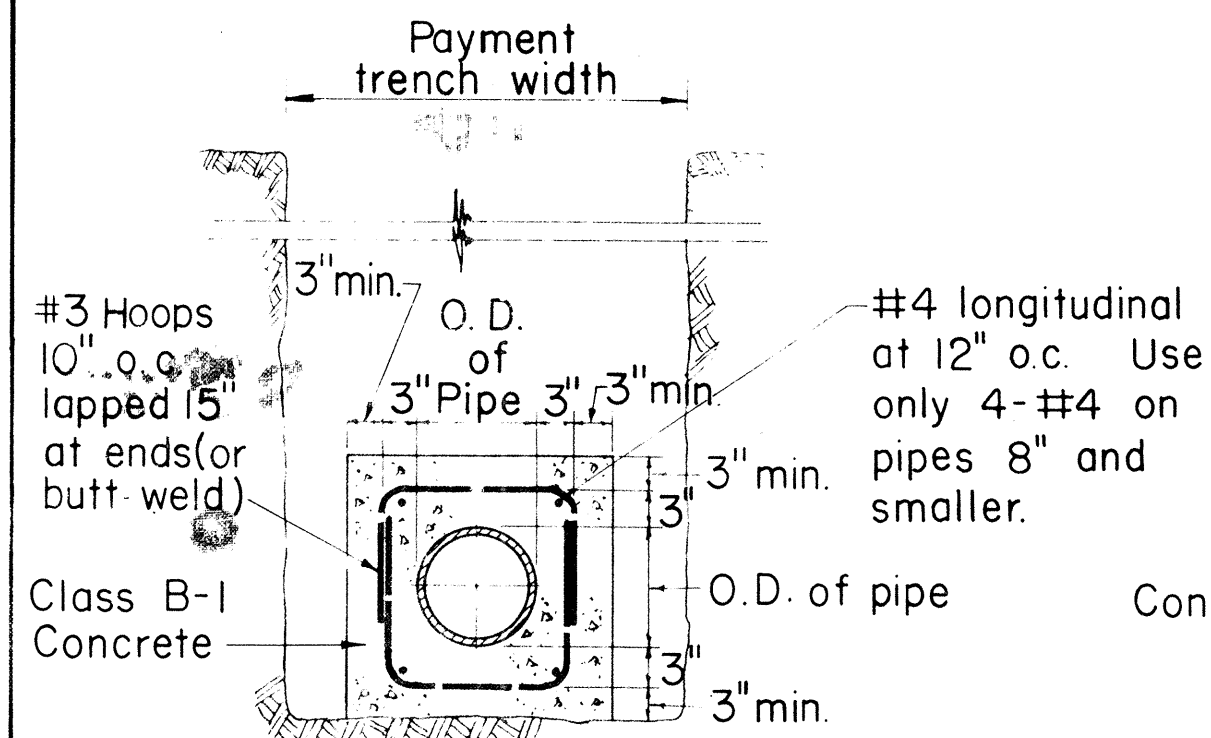

DETAIL OF CONCRETE JACKET


Scale: 3/4" = 1' - 0"

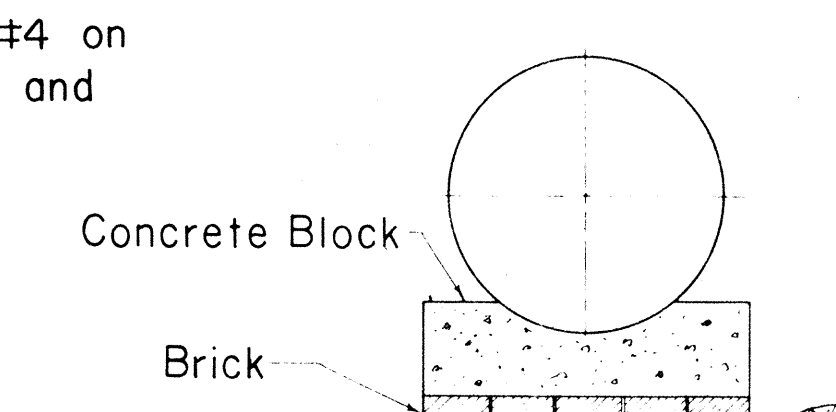

METHOD OF USING BRICKS UNDER CONCRETE BLOCKS


Not To Scale

Contractor shall set Concrete Blocks on undisturbed ground. Where ground is too low, the contractor shall not heap up dirt under the Concrete Block but use Concrete Bricks to take up the deficiency, scraping away beneath Concrete Block to give sufficient room for Brick

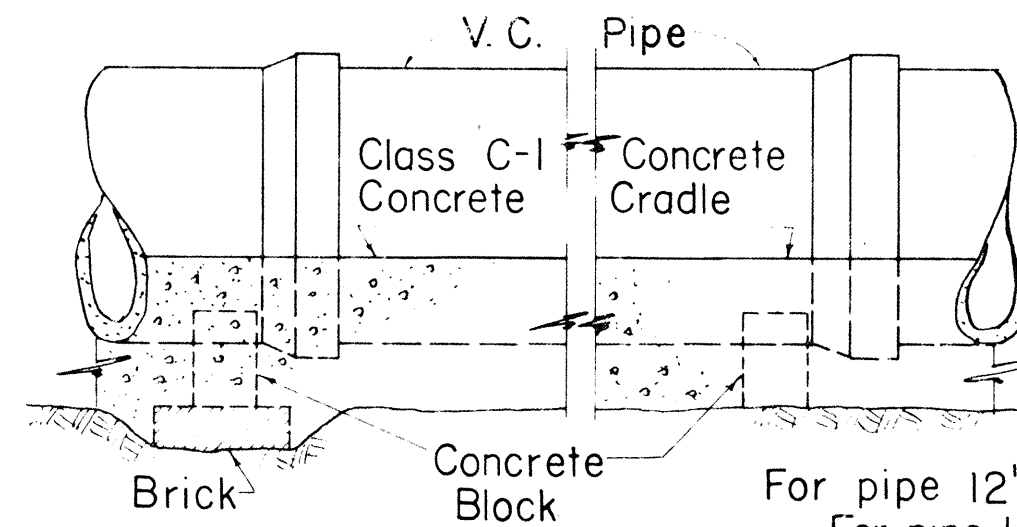



ELEVATION SHOWING METHOD OF LAYING PIPE

Not To Scale

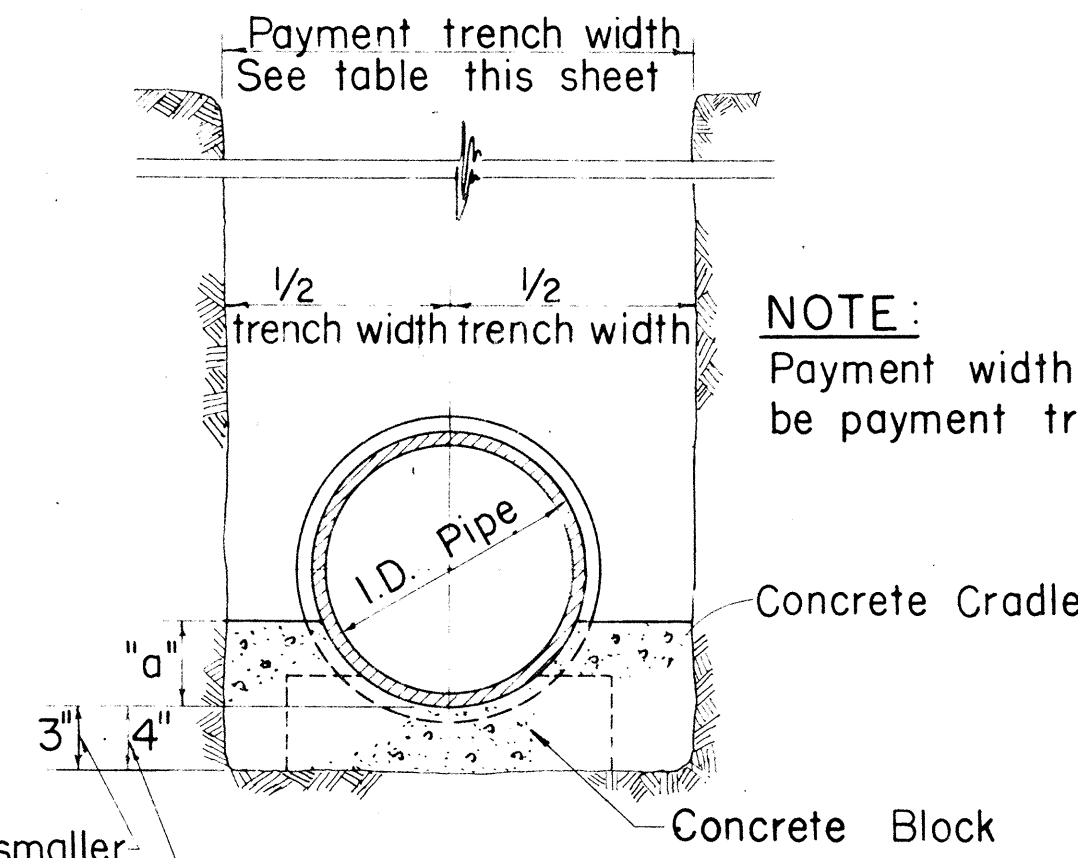

CONCRETE CRADLE FOR VITRIFIED CLAY PIPE


Not To Scale

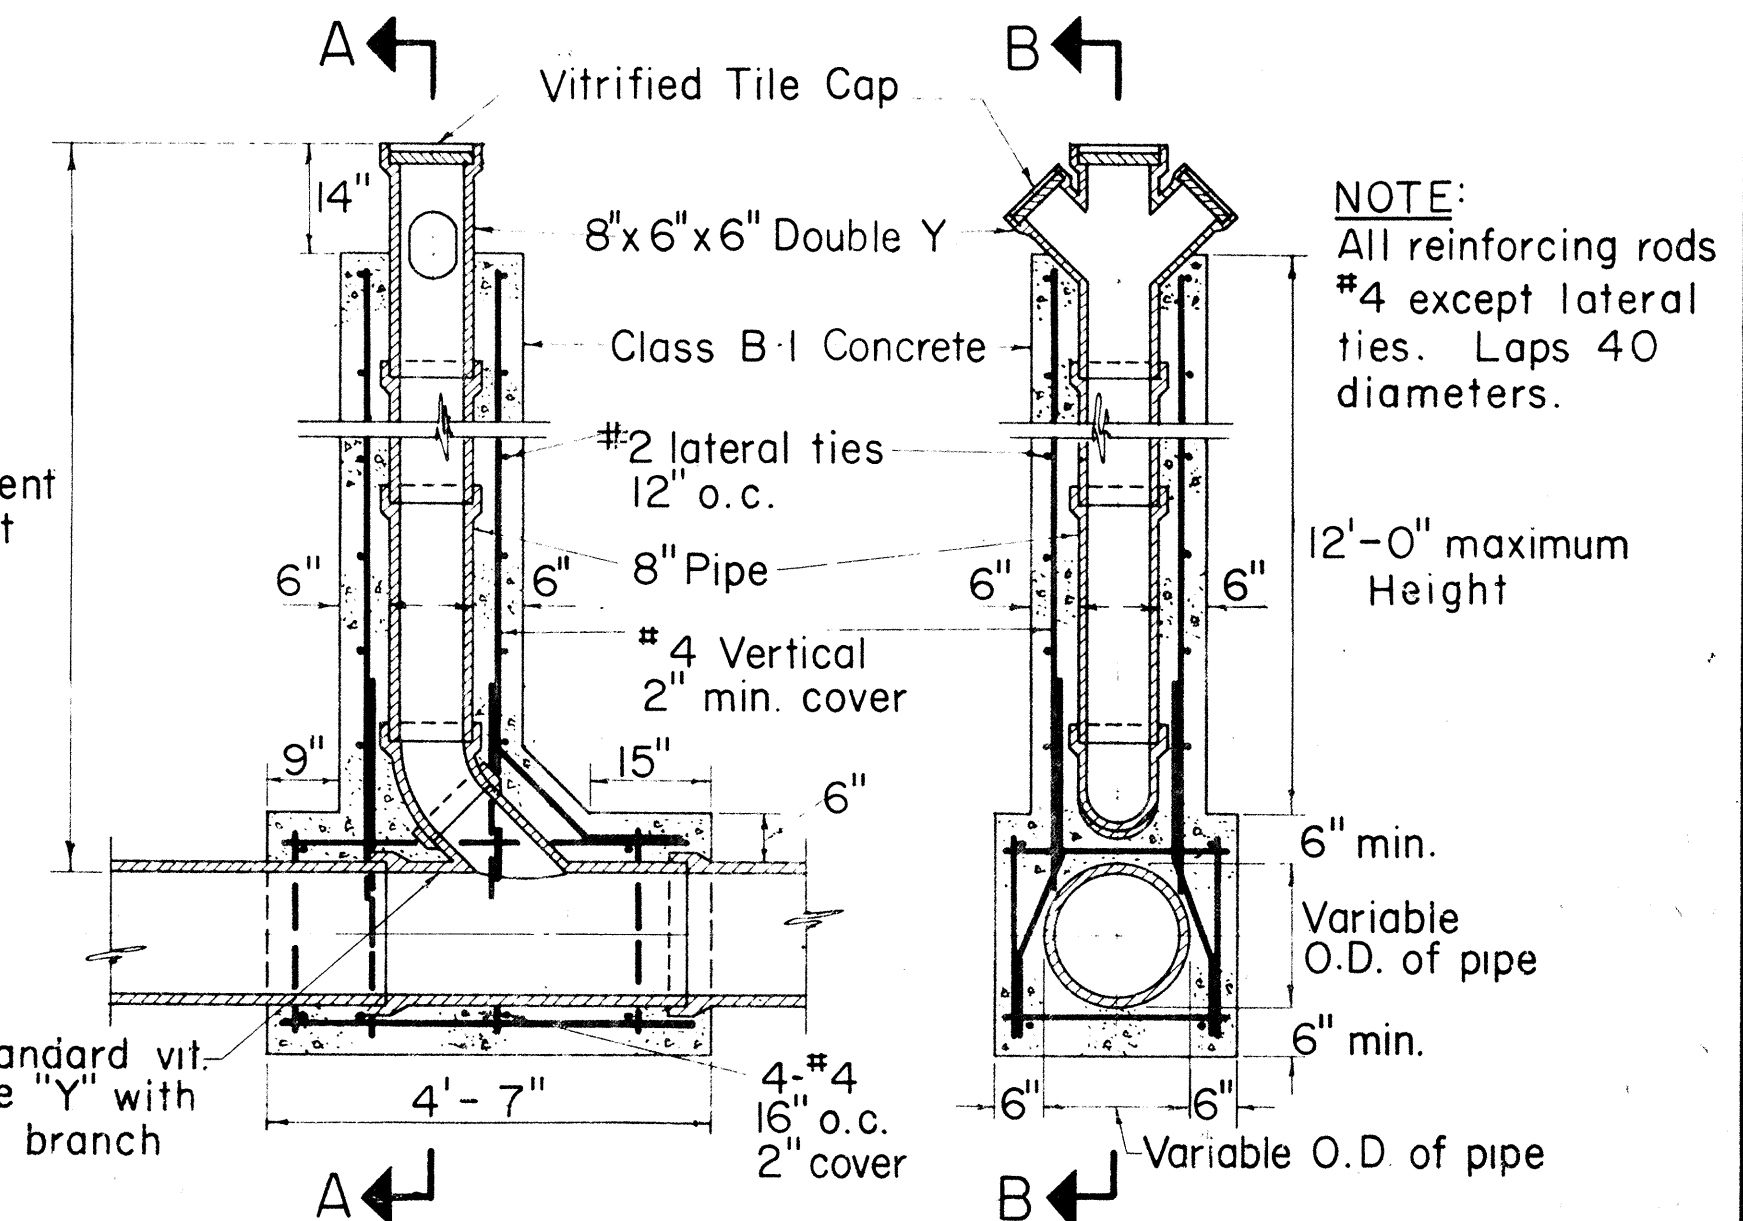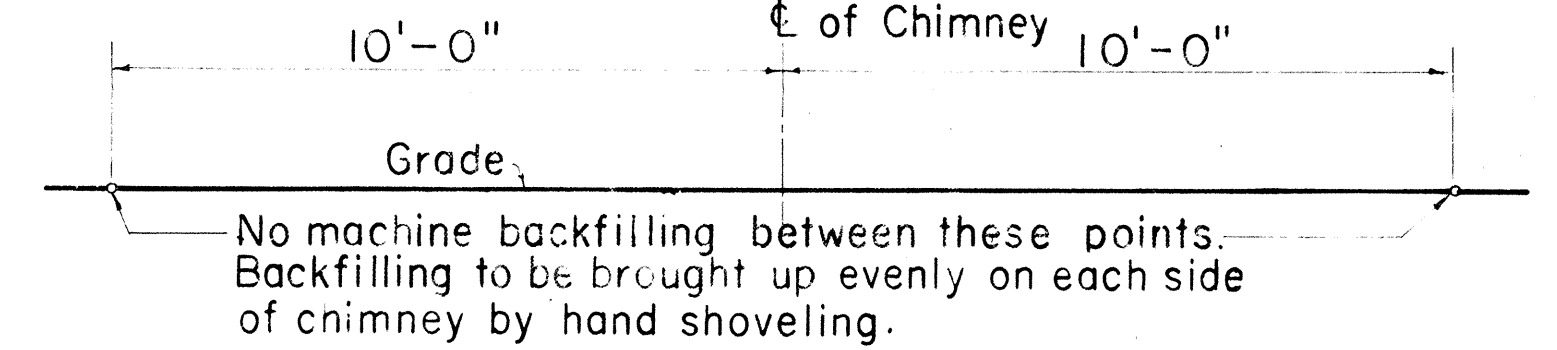

SECTION B-B SECTION A-A DETAILS OF CHIMNEY


Scale: 1/2" = 1' - 0"

Payment quantities for trench excavation, crushed rock fill, crushed rock cradle, and crushed rock sub-base shall be computed using payment trench widths as shown in the table of "Trench Widths". No payment shall be made for excess quantities resulting from trench widths greater than the payment trench widths shown.

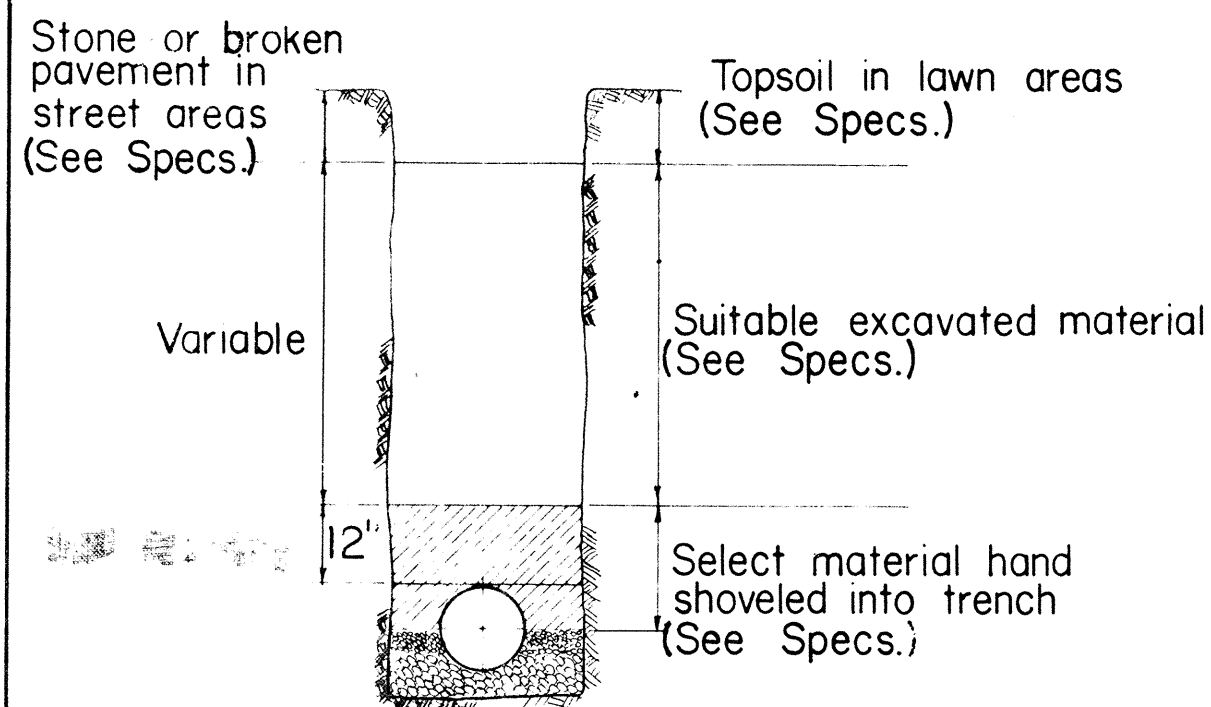


METHOD OF BACKFILL

Not To Scale

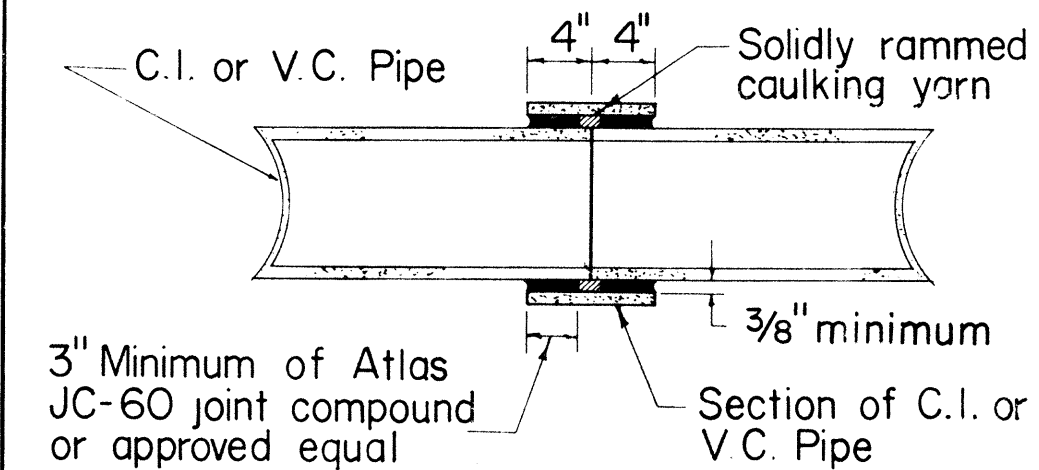


BUTT JOINT DETAIL

Scale: 1" = 1' - 0"

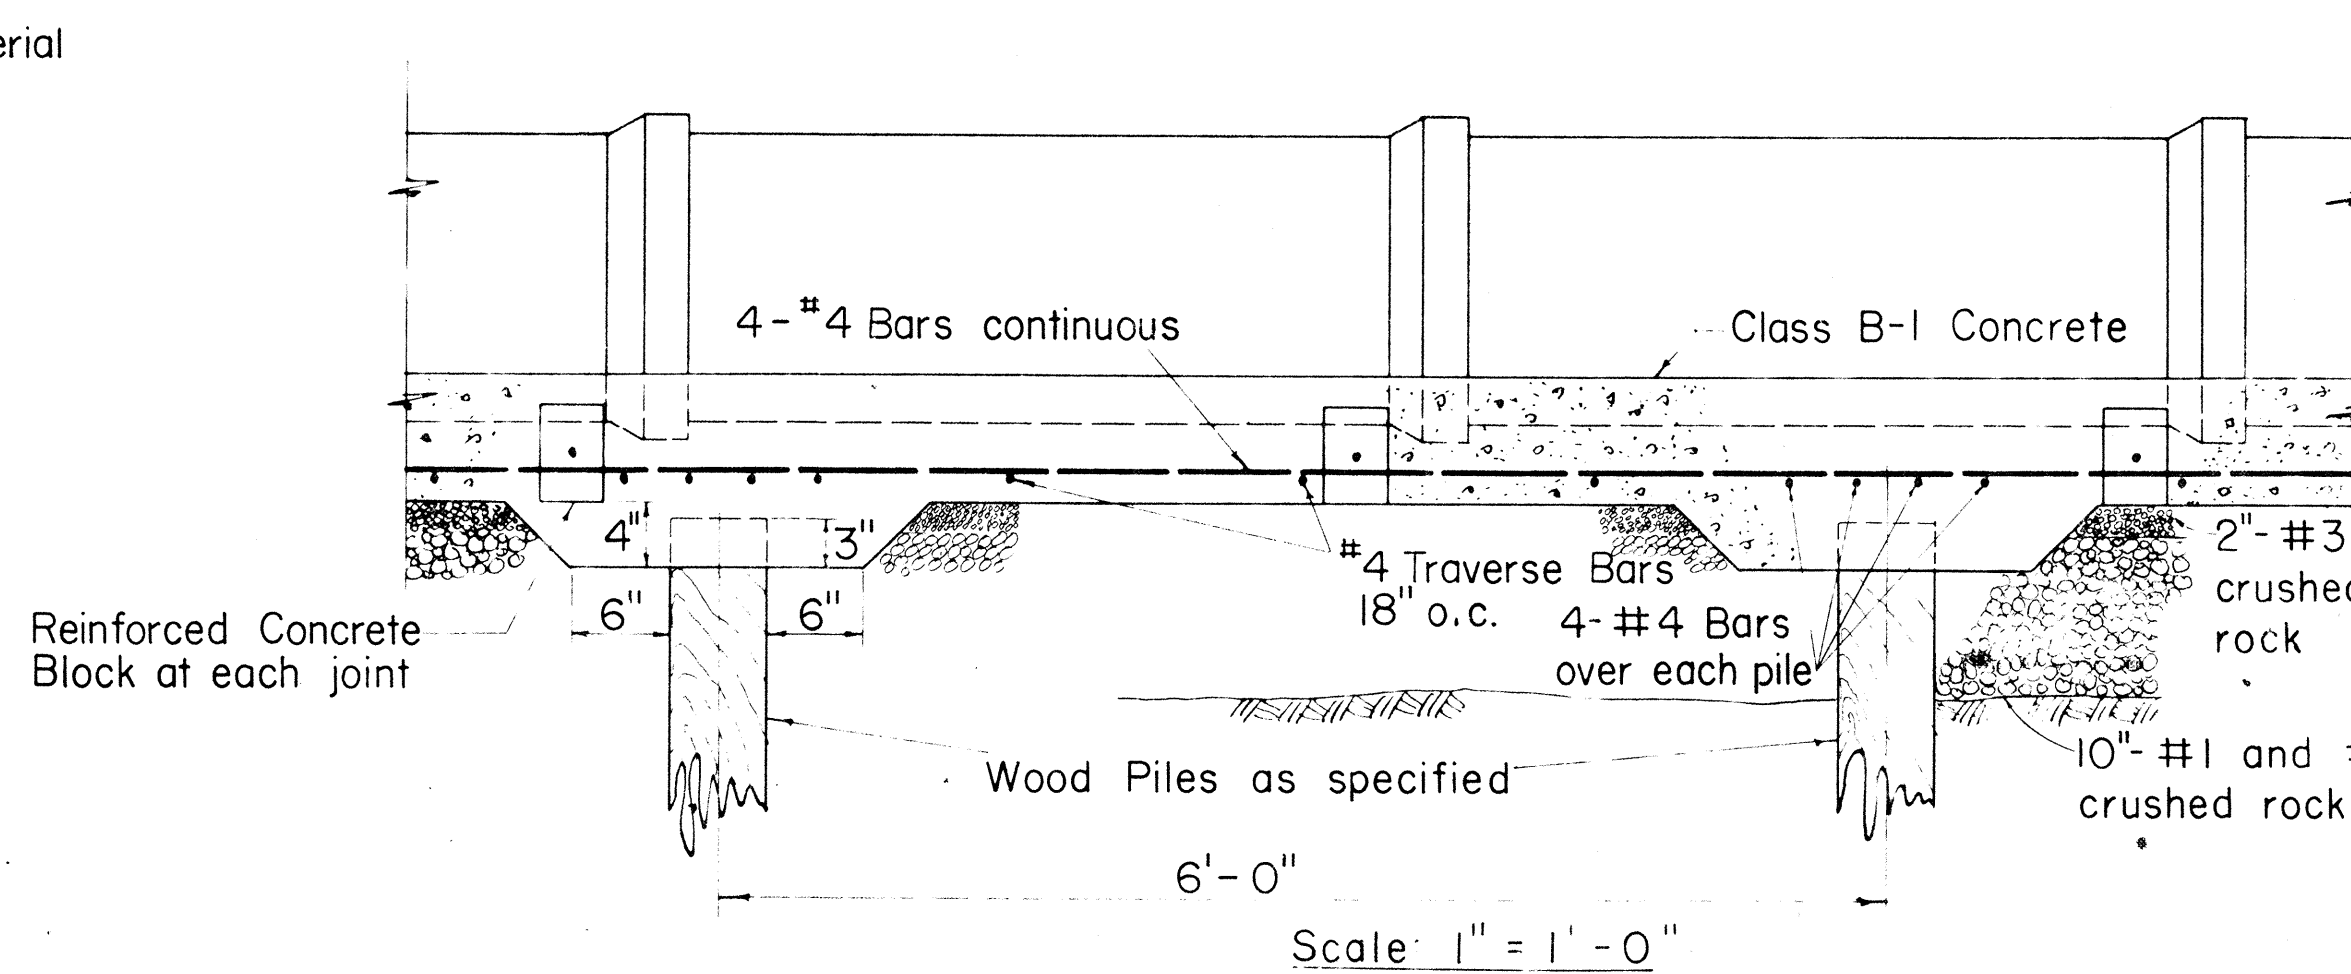


DETAIL OF REINFORCED CONCRETE CRADLE ON WOOD PILES (FOR 6, 8, 10 & 12 IN. V.C. PIPE)

DETAIL OF REINFORCED CONCRETE CRADLE WITHOUT PILES SIMILAR EXCEPT FOR WOOD PILES AND PILE CAPS

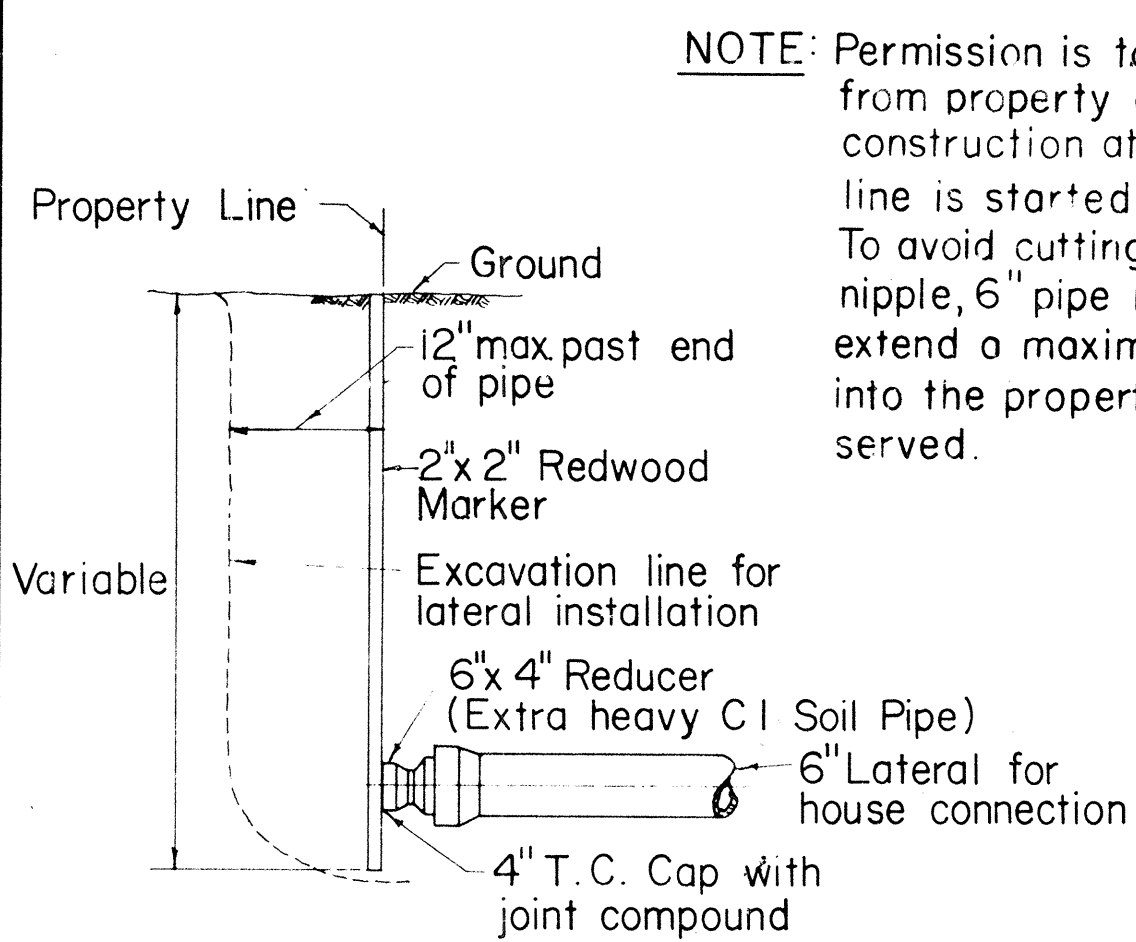

DETAIL AT PROPERTY LINE


NOTE: Permission is to be secured from property owner before construction at property line is started. To avoid cutting of short nipple, 6" pipe may extend a maximum of 12" into the property to be served.

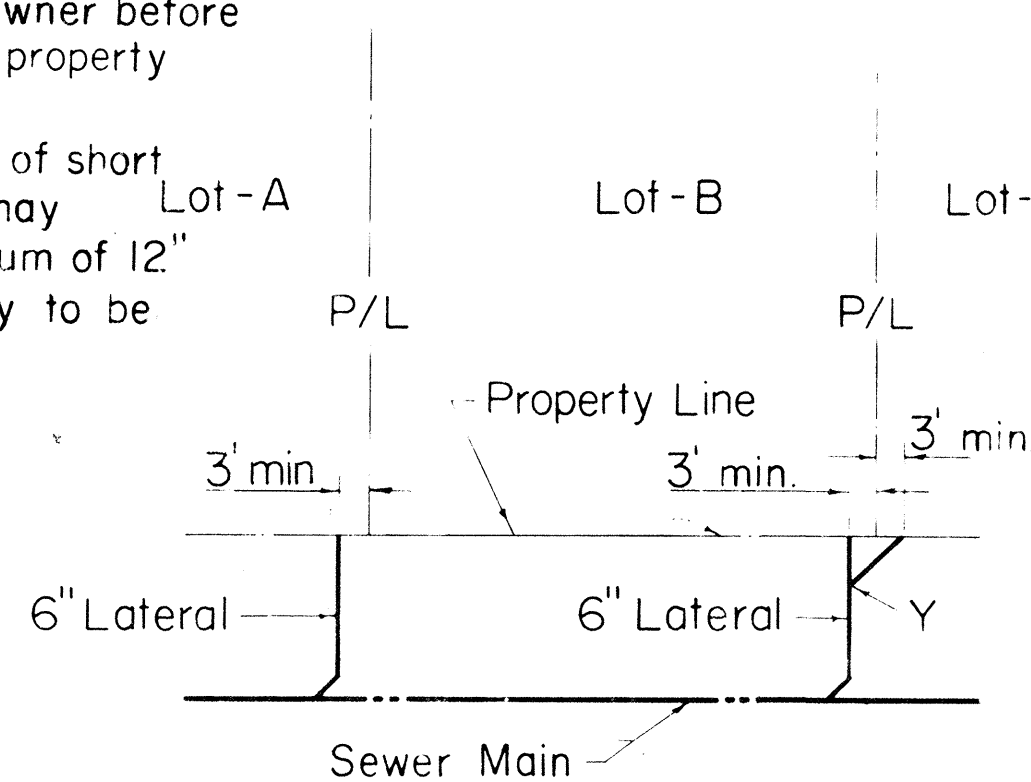

LAYOUT


CONSTRUCTION OF LATERALS

Not To Scale

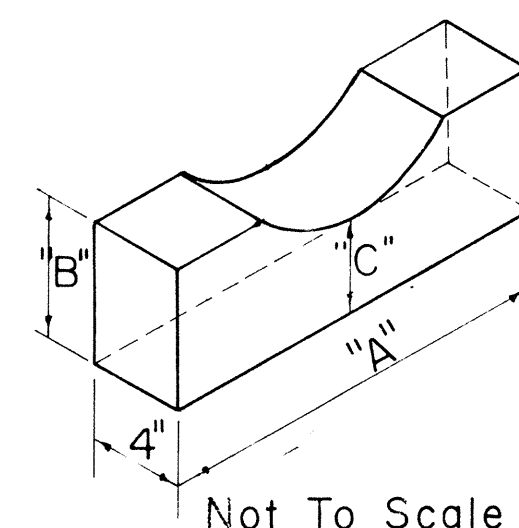


DETAIL OF PRECAST CONC. PIPE BLOCK

PIPE SIZE	"A"	"B"	"C"
6"	1'-2"	6"	3"
8"	1'-5"	6"	3"
10"	1'-7"	6"	3"
12"	1'-7"	6"	3"
15"	1'-8"	6"	4"
18"	1'-9"	6"	4"
21"	1'-10"	6"	4"
24"	1'-11"	6"	4"
27"	2'-0"	6"	4"
30"	2'-3"	6"	4"

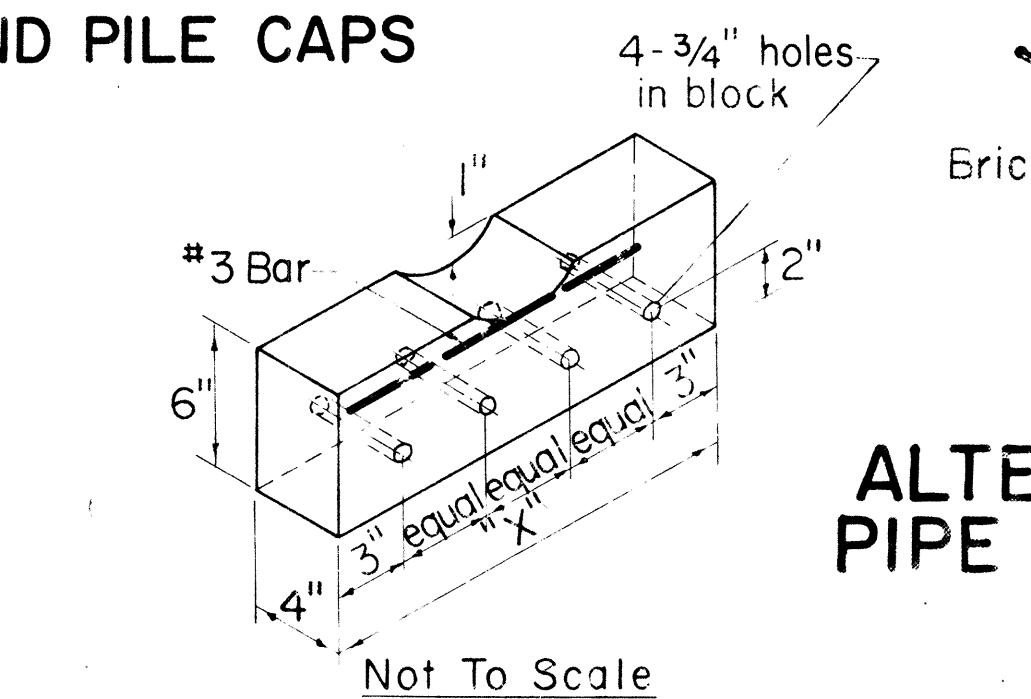

DETAIL OF CONC. PIPE BLOCK FOR REINF. CRADLE

PIPE SIZE	"X"
6"	1'-6"
8"	1'-6"
10"	1'-8"
12"	1'-8"
15"	1'-10"
18"	1'-10"
21"	2'-0"
24"	2'-0"
27"	2'-0"
30"	2'-0"

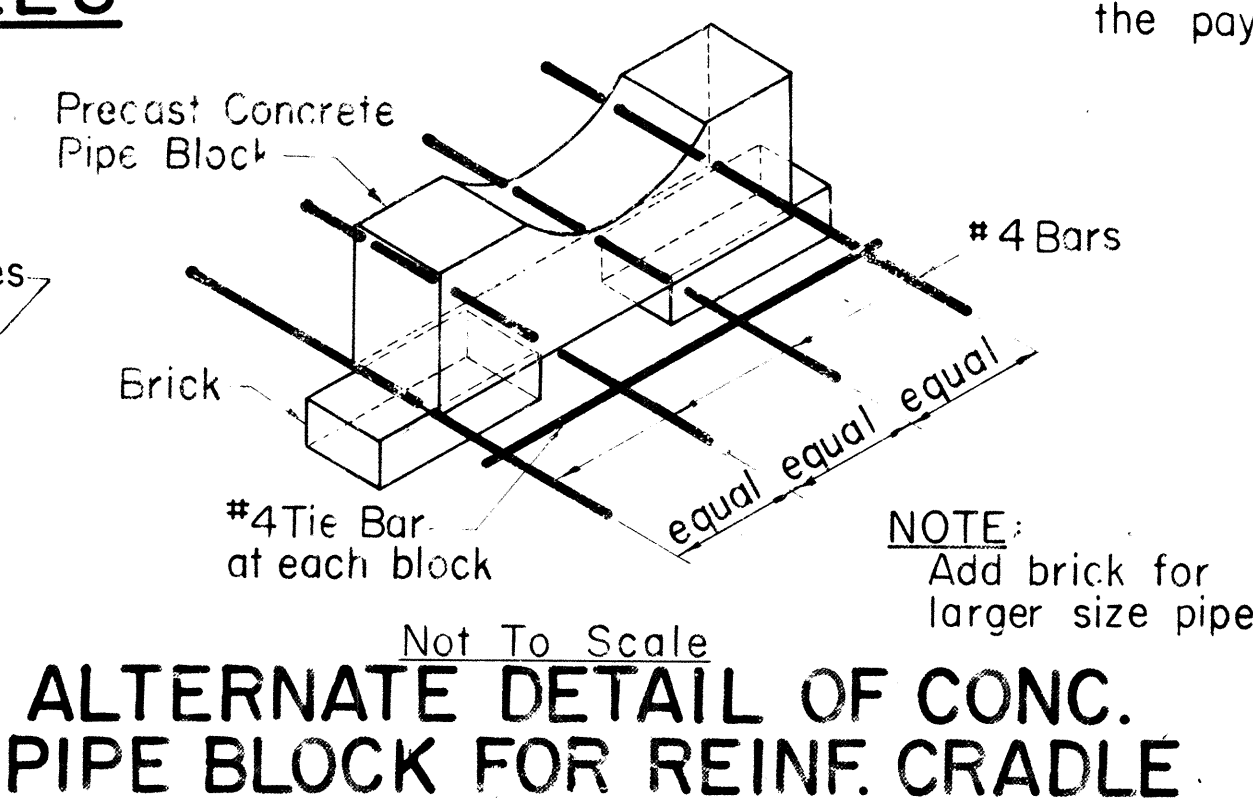

ALTERNATE DETAIL OF CONC. PIPE BLOCK FOR REINF. CRADLE

APPROVED:

CHIEF, DIVISION OF SEWERS
DATE 4/4/71

STATE OF HAWAII
DEPARTMENT OF TRANSPORTATION
HIGHWAYS DIVISION
DIVISION OF SEWERS
CITY & COUNTY OF HONOLULU

STANDARD DETAILS
SEWERS - CONCRETE JACKET
& MISCELLANEOUS DETAILS

Scales: As Noted
Date: DEC. 24, 1970

SHEET NO. 23 OF 25 SHEETS