INDEX TO DRAWINGS DESCRIPTION SHEET NO. TITLE SHEET GENERAL PLAN TYPICAL SECTIONS 7-9 ALIGNMENT PLANS PROFILES & SUPERELEVATION 10-16 | DIAGRAMS 17-19 RAMP TERMINAL DETAILS ROADWAY CONSTRUCTION PLANS & DETAILS DRAINAGE & UTILITY 41 - 63 | PLANS & DETAILS BORING LOCATION PLAN, 64-71 R/W, FENCE LINE, BORING LOGS AND SOIL STABILIZATION DETAILS \*72-89 | SIGNING PLANS & DETAILS HIGHWAY LIGHTING & 90-99 ELECTRICAL 100 - 125 STRUCTURE NO. 11 126 - 133 | STRUCTURES NO. 14 & NO. 15 134 - 140 TYPICAL DETAILS 141 - 149 STANDARD DETAILS 150 - 156 HALAWA STREAM STRUCTURE CROSS SECTION KEY & 157- 197 CROSS SECTIONS SUPPLEMENT SHEET NOS 424, 484, 714, 1084, 8 1194 # CO 885-1 & CO 885-2

STATE OF HAWAII

DEPARTMENT OF TRANSPORTATION
HIGHWAYS DIVISION

HIGHWAYS DIVIS

"AS BUILT"

PLANS FOR

CONSTRUCTION OF A PORTION OF

## INTERSTATE ROUTE H-I

HALAWA INTERCHANGE


SOUTH OF MOANALUA ROAD

FEDERAL AID INTERSTATE PROJECT NO. I-HI-I(90):13

DISTRICT OF EWA

|   | NEW TOTAL SHEET NO. = 204  |                                  | SCALES:                                    |                                |  |             |  |
|---|--|----------------------------------|--|--------------------------------|--|-------------|--|
|   | all  |                                  |  |                                |  |             | a vince of the control of the contro |
|   |  |                                  | PLANS                                      |                                |  |             |  |
| , |  | HALAWA HEIGHTS                   | PROFILES                                   |                                |  |             |  |
|   | STREE  |                                  | DETAIL ROADWAY PLANS                       |                                | ,  |             |  |
|   |  |                                  | CROSS SECTIONS HOR. I" = 10' VER. I" = 10' |                                |  |             |  |
|   | imakan'i   |                                  | VER. 1 = 10                                |                                |  |             |  |
| 1 | THE RESERVE THE PROPERTY OF TH | RONS/                            |  | *                              |  |             |  |
|   | MOANA  |                                  |  |                                |  |             |  |
|   | ROA  | HALAWA HEIGHTS                   |  | QUARRY                         | ***<br>**  |             | DES  |
|   |  | BEGIN PROJE                      | ECT NORTH                                  |                                |  |             | DHV  |
|   | CTREET   | RELOC. HALA<br>B STA. 27+8       | 30.42                                      |                                |  |             | ж. <sup>1</sup>  |
|   | HALESIM  | TY ACCESS AS TO EXTENSION TO SE  | ANIMAL QUARANTINE                          |                                |  |             | D  |
|   | PROPOSED<br>HONOLULU STADIUM<br>SITE   | RAMO                             | STATION                                    |                                |  |             | <b>T</b>   |
|   | RAMP   |                                  | POA  |                                | e de la companya de l |             | <b>V</b>   |
|   |  | PAND PAND                        | NTERSTATE RI                               | OUTE                           |  |             | <b>V</b>   |
|   |  | Halawa Stream RAMP RAMP          | OANAL RAMP M                               |                                |  |             |  |
|   | RAME   | SE NAMI                          | RAMP IN RED HILL N                         |                                |  |             |  |
|   |  | WE RAMP K                        | RESERVATION                                | ION                            |  |             |  |
|   |  | RAMF                             |  | S. J. Commission of the second | e Silver and Silver an | J           |  |
|   |  |                                  | RAMIT                                      |                                |  |             |  |
|   |  |                                  | stream                                     |                                |  |             |  |
|   |  | RELOC. HALAWA HTS RD. \ BECIN DE | END PROJECT                                |                                |  |             |  |
|   | OCATED HALL  | B STA 32+82 74                   | INTERSTATE ROUTE  B STA. 265+37.87         |                                | •  |             | <b>(%</b>  |
|   | REL  |                                  | 252+33.06                                  |                                | <i>t</i>   |             | <b>`</b> .   |
|   | BOULENARIO   | FOSTER VILLAGE                   |  |                                |  |             |  |
|   |  |                                  |  |                                |  |             |  |
| 2 |  | LAYOUT PL                        | _A N                                       | LENGTH OF                      | PROJECT:   | 0.247       | MILES  |
|   |  |                                  |  |                                |  | <del></del> | ,  |

SCALE: |" = 500'

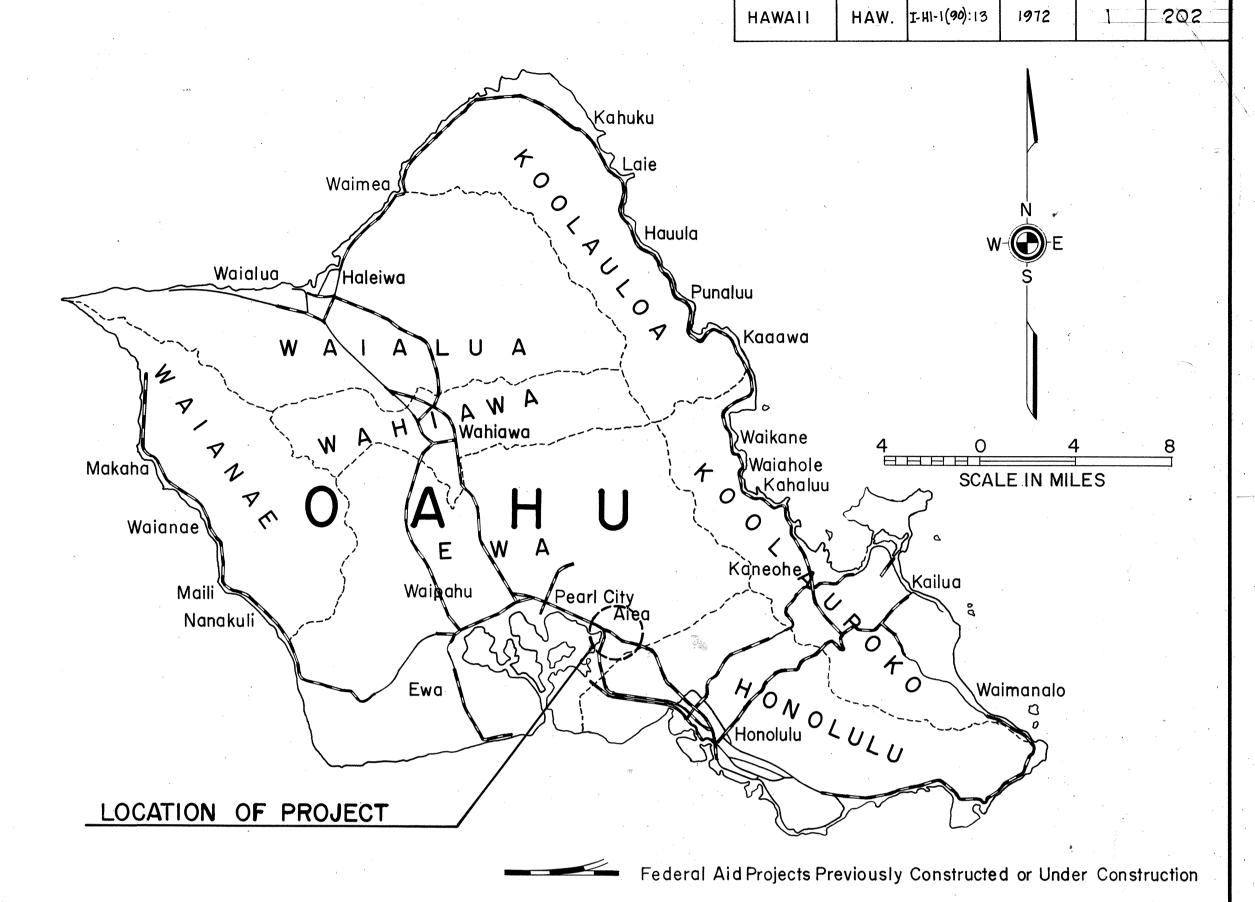

FED. ROAD DIST. NO. FED. AID FISCAL SHEET TOTAL PROJ. NO. YEAR NO. SHEETS

## NOTE:

ALL CHANGES MADE DURING CONSTRUCTION HAVE BEEN INCORPORATED ON THESE PLANS IN RED EXCEPT CHANGES IN THE ORIGINAL THEORETICAL QUANTITIES. FOR ACTUAL QUANTITIES, REFER TO PROJECT LEDGER AND/OR COMPUTATION BOOK.

## DESIGN CLASSIFICATION

 DESIGN ADT (1990).
 43,329

 DHV.
 4,854

 D.
 60/40

 T.
 5 %

 V.
 50 MPH

Mer. 24.197

DATE

DEPARTMENT OF TRANSPORTATION
FEDERAL HIGHWAY ADMINISTRATION
APPROVED:

4-25.7

|    | DEPARTMENT OF TRANSPORTATION STATE OF HAWAII |
|----|--|
| ٠. | APPROVED:                                    |
|    | munny Lee 4/5/7                              |
|    | FOR DIR. OF TRANSPORTATION DATE              |

j