IN	DEX TO DRAWINGS		
SHEET NO.	DESCRIPTION		
1	TITLE SHEET		
2	TYPICAL SECTIONS, GENERAL NOTES & MISC. DETAILS		
3-6	ROADWAY PLANS		
7-10	PAVEMENT MARKINGS		
	TYPICAL DETAIL-RAISED PAVEMENT MARKERS		
<i>I</i>			
-			
with the second			
N	,		
š.			
	• •		



STATE OF HAWAII

DEPARTMENT OF TRANSPORTATION HIGHWAYS DIVISION


HONOLULU, HAWAII


"AS - BUILT"

PLANS FOR

HALAWA HEIGHTS ROAD RESURFACING ULUNE STREET TO FERNRIDGE PLACE PROJECT NO. 710B-01-75M

DISTRICT OF EWA ISLAND OF OAHU

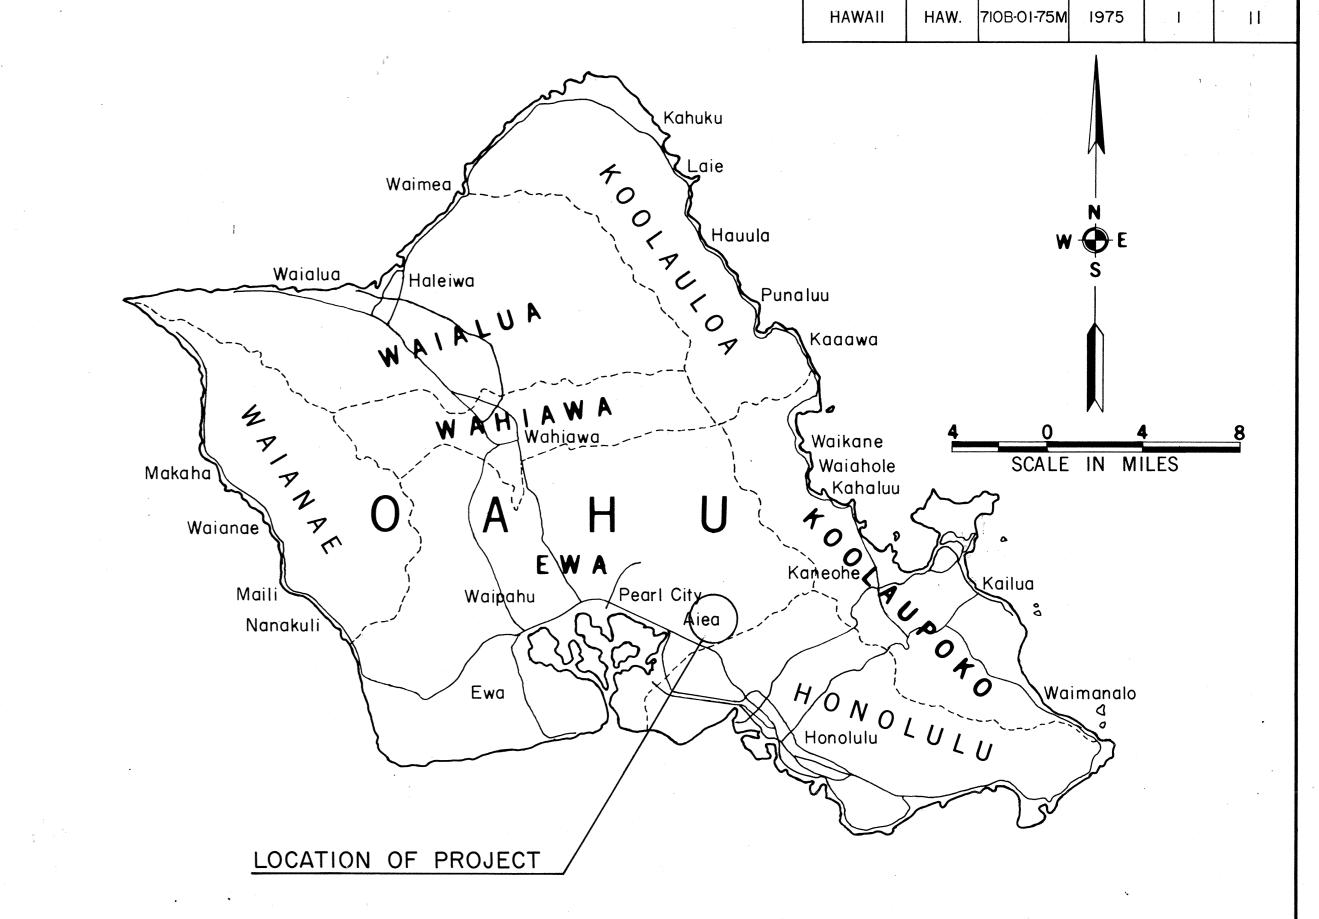

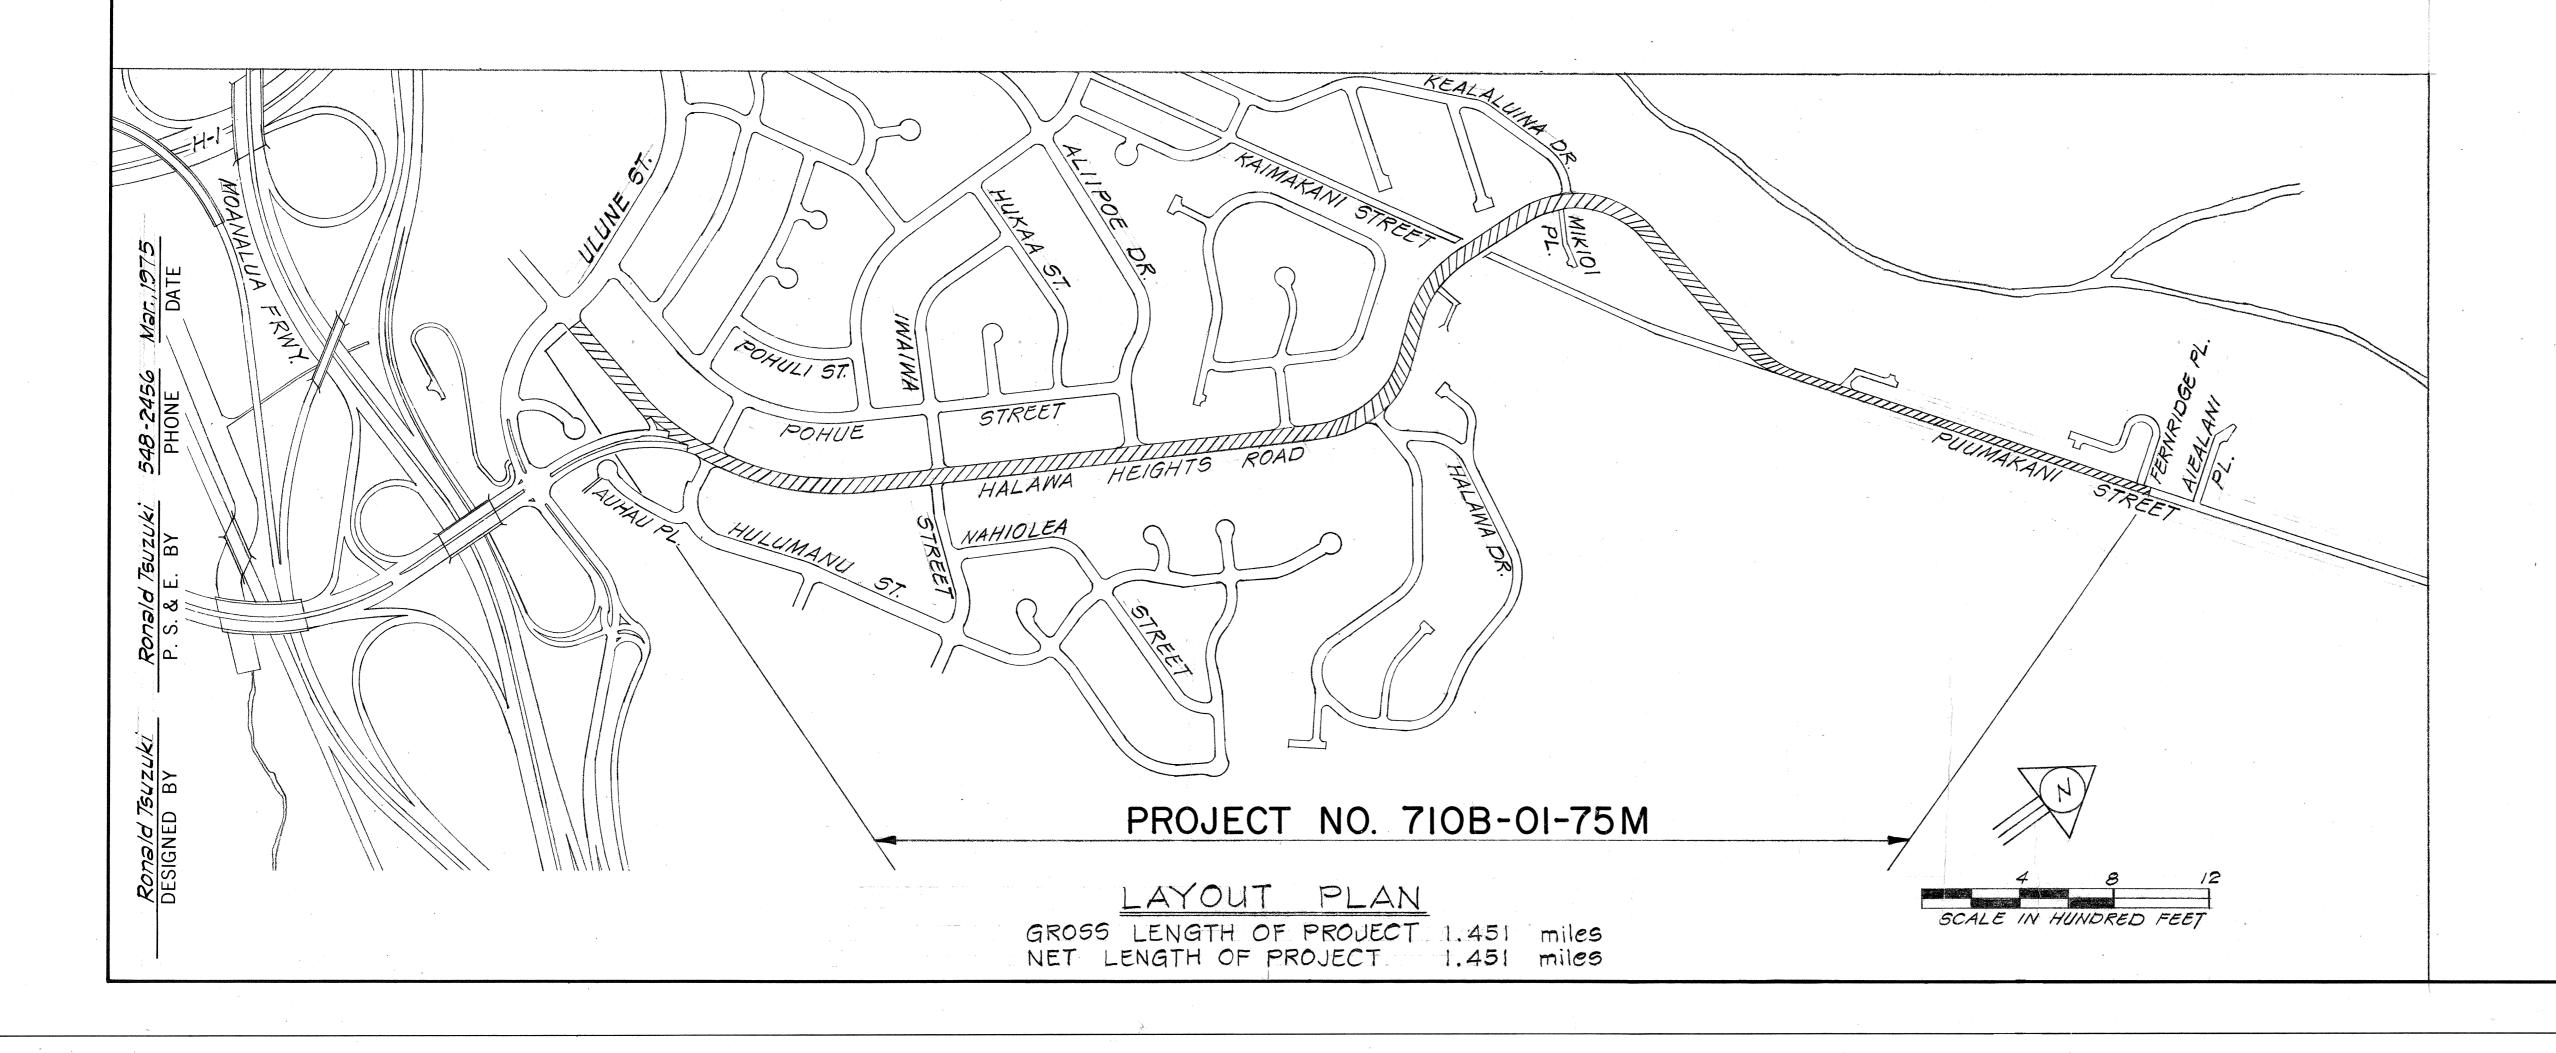

NO CHANGES WERE MADE DURING CONSTRUCTION ON THESE PLANS EXCEPT CHANGES IN THE ORIGINAL THEORETICAL QUANTITIES. FOR ACTUAL QUANTITIES, REFER TO PROJECT LEDGER AND/OR COMPUTATION BOOK.

R. T. Susaki 10-12-83

In RESIDENT ENGINEER DATE

DEPARTMENT OF TRANSPOR	TATION
STATE OF HAWAII	
APPROVED:	
6. alvey thright	4/8/25
DIR. OF TRANSPORTATION	DATE