




FED. ROAD DIST. NO.	STATE	PROJ. NO.	FISCAL YEAR	SHEET NO.	TOTAL SHEETS
HAWAII	HAW.	710B-01-75M	1975	2	11

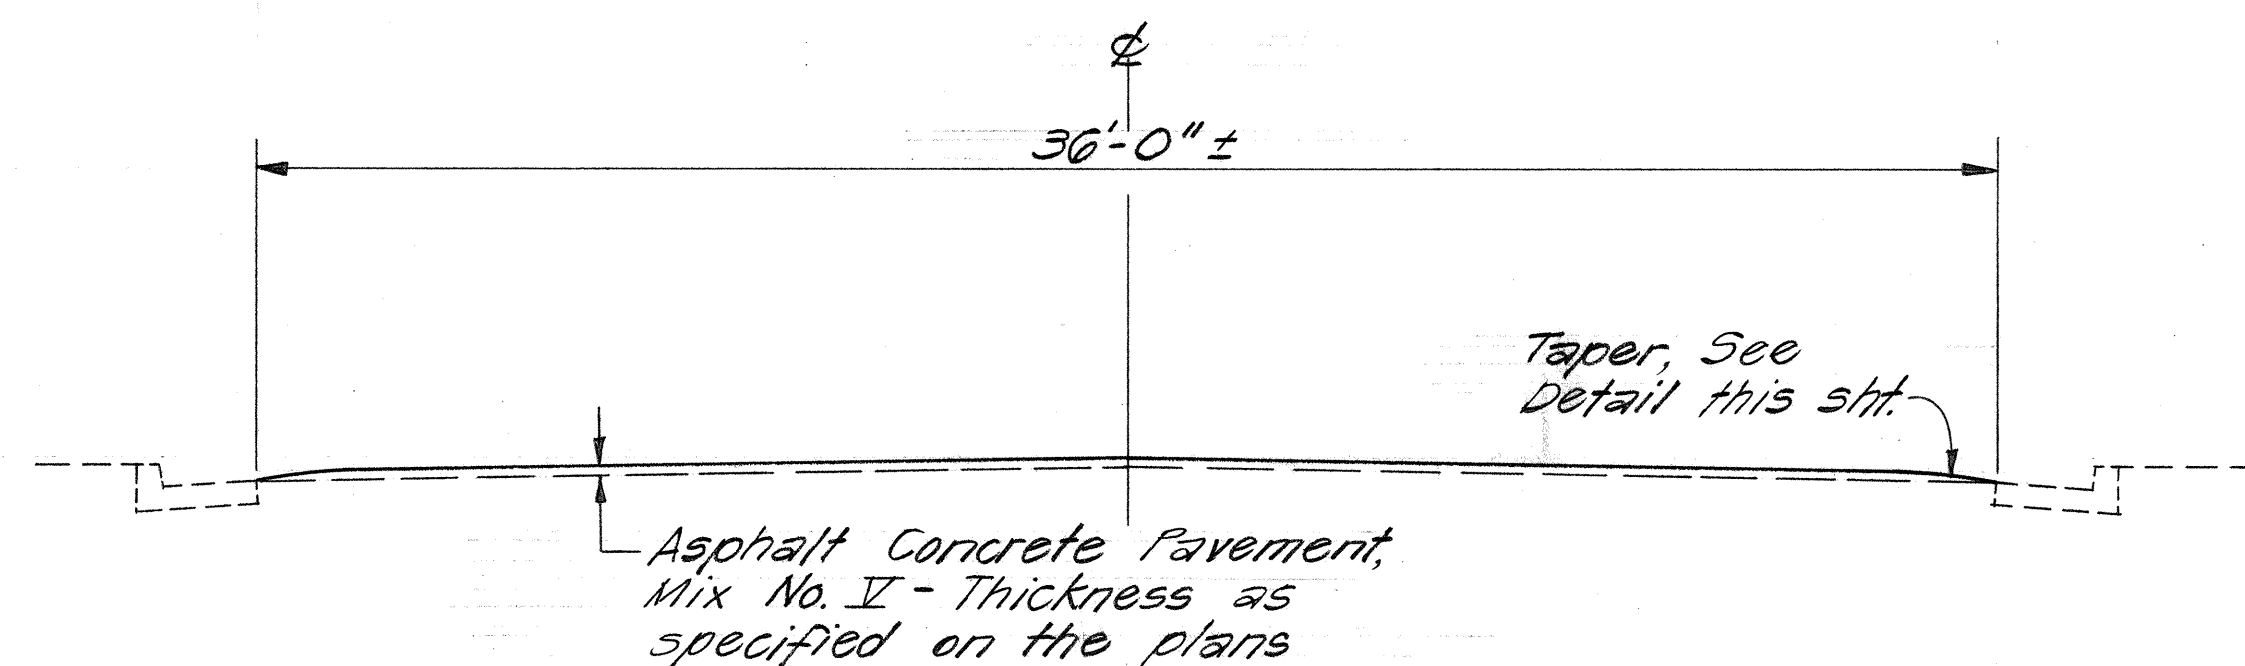


TYPICAL SECTION
STA. 116+25 TO STA. 149+90
Scale: 1/4" = 1'-0"

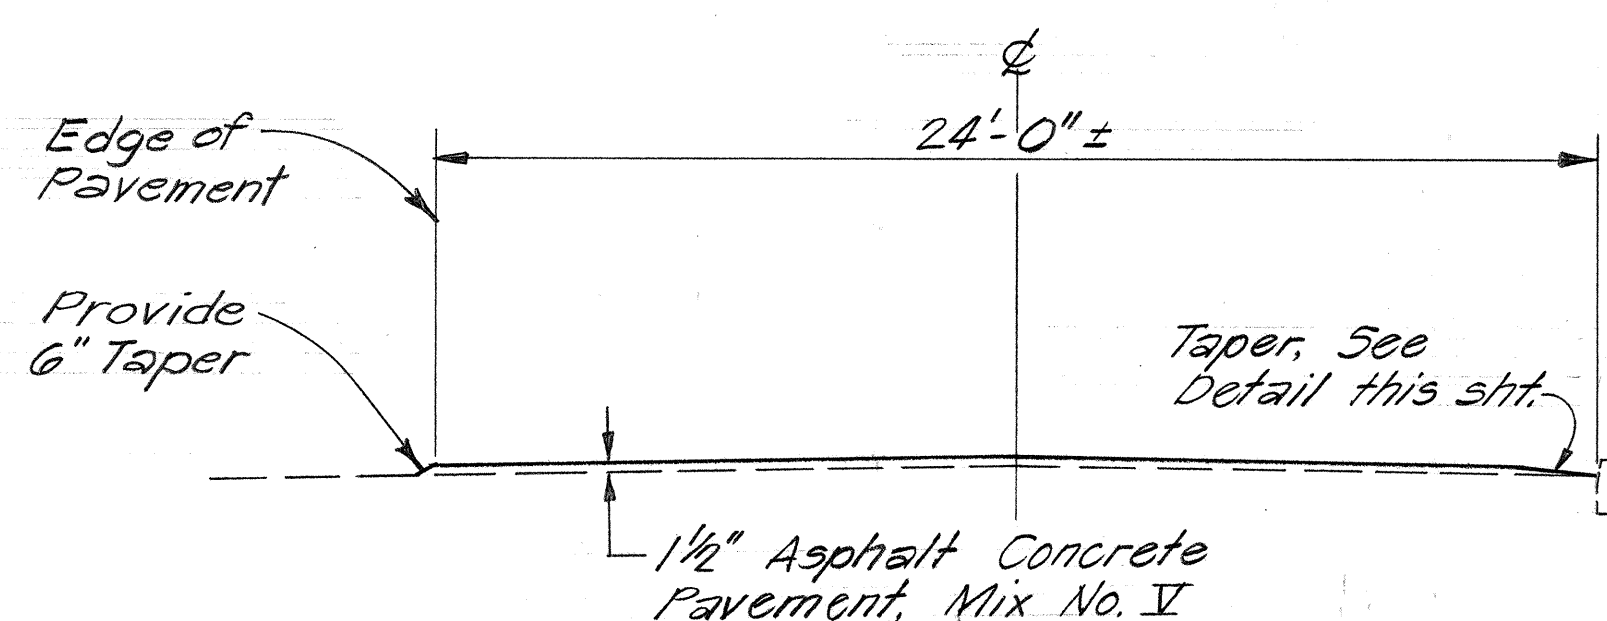


TYPICAL SECTION
STA. 149+90 TO STA. 192+88
Scale: 1/4" = 1'-0"

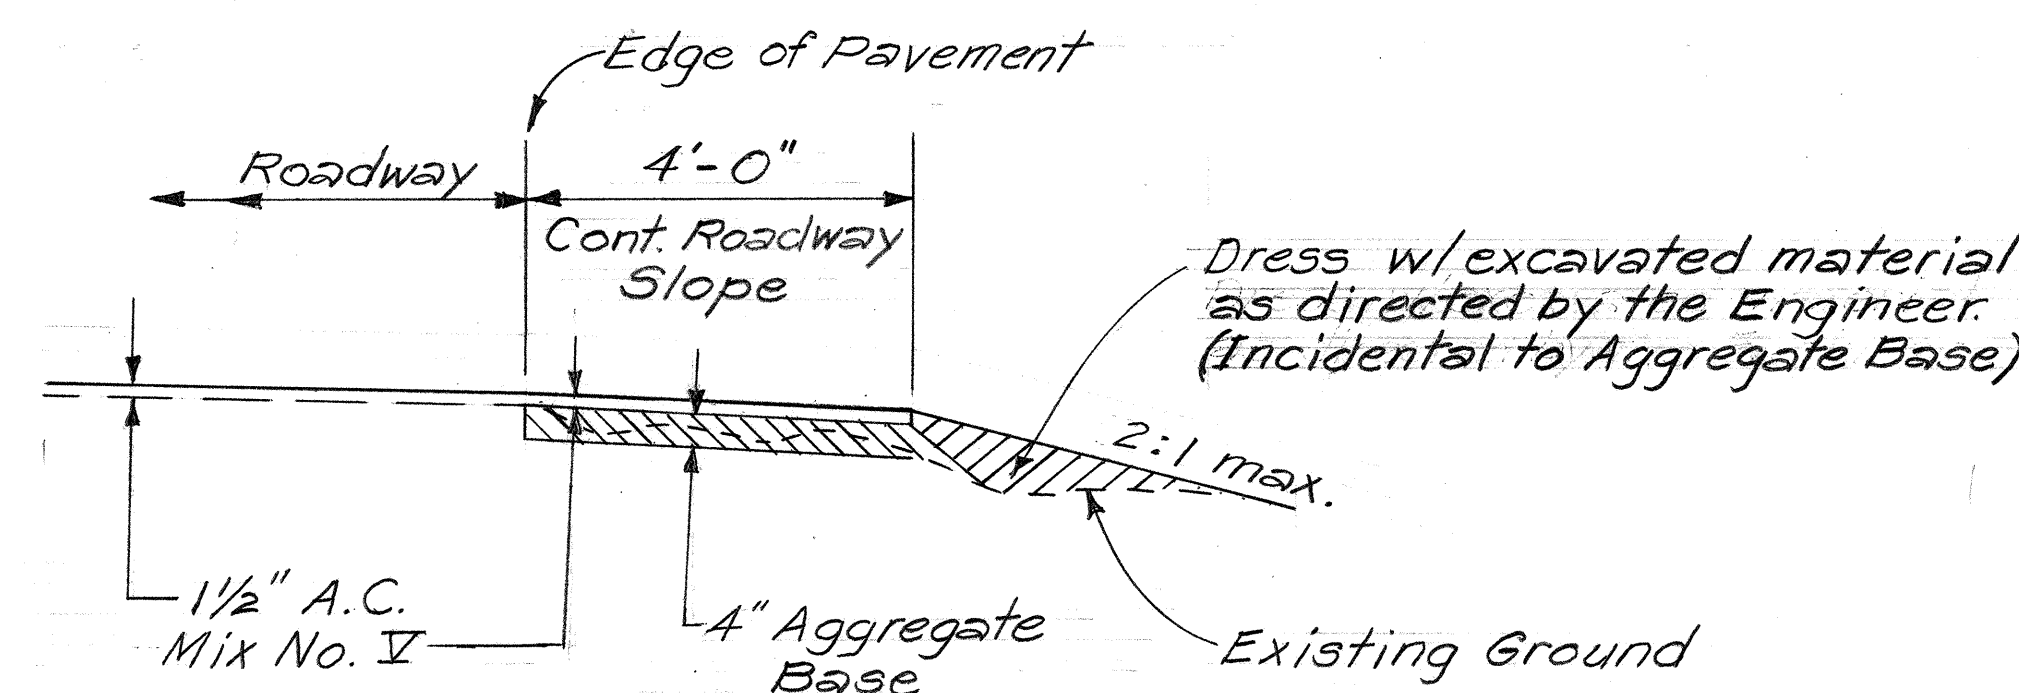


TYPICAL SHOULDER SECTION
STA. 152+55 TO STA. 161+60 RIGHT
Scale: 1/2" = 1'-0"

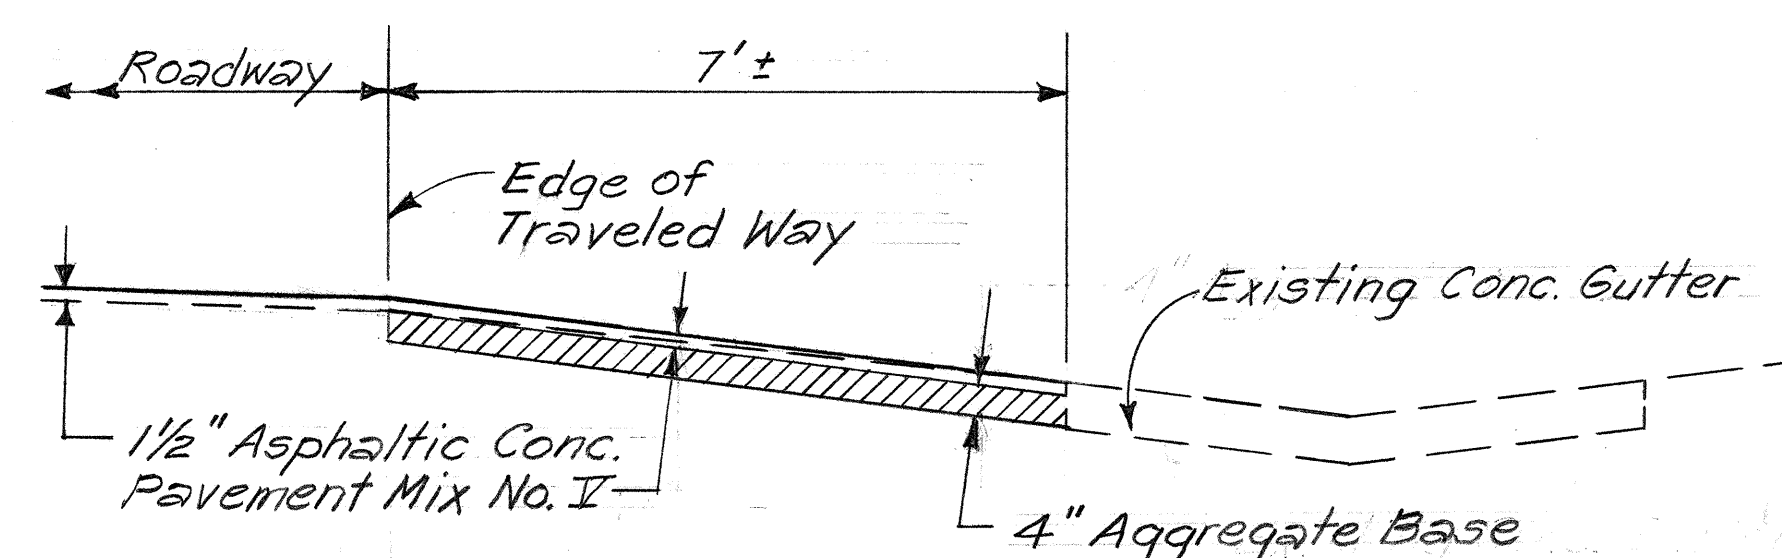


TYPICAL SHOULDER SECTION
STA. 161+60 TO STA. 166+80 RIGHT
Scale: 1/2" = 1'-0"

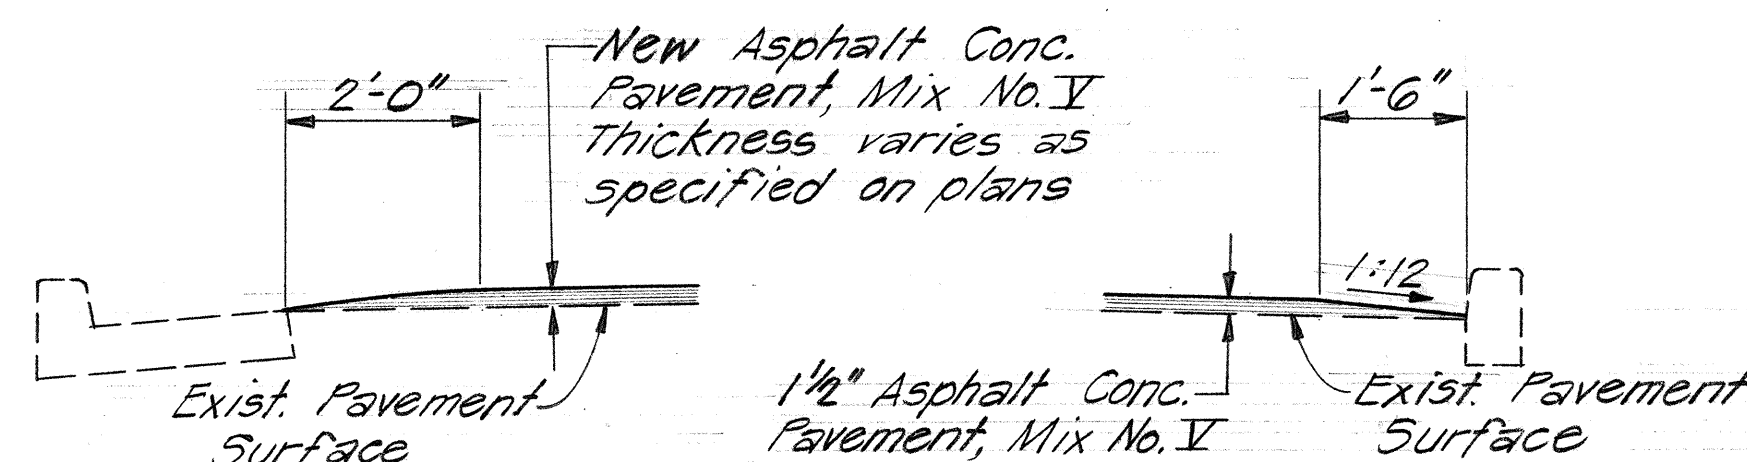

CURB & GUTTER DETAIL
Scale: 1/2" = 1'-0"

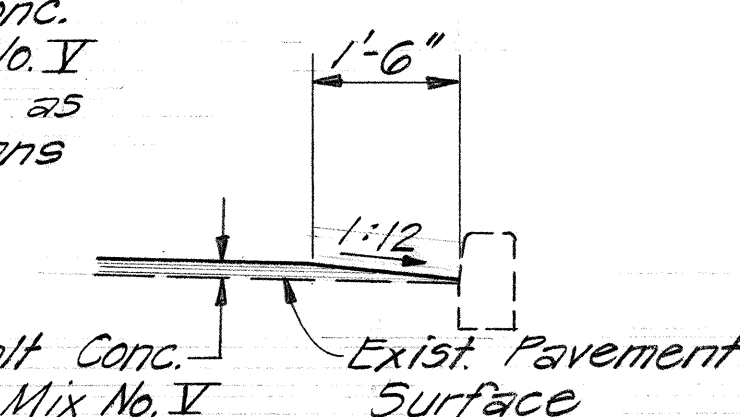


CURB DETAIL
Scale: 1/2" = 1'-0"

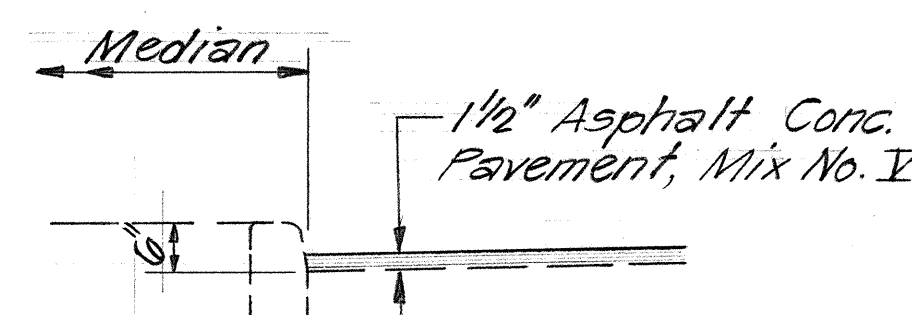

CURBED MEDIAN DETAIL
Scale: 1/2" = 1'-0"

GENERAL NOTES

- Any holes or depressions encountered in the existing pavement shall be cleaned of loose material and filled and compacted with A.C. pavement, mix no. II prior to resurfacing. Payment incidental to A.C. pavement.
- Smooth riding transitions shall be provided at the beginning and end of project and at all street and driveway connections.

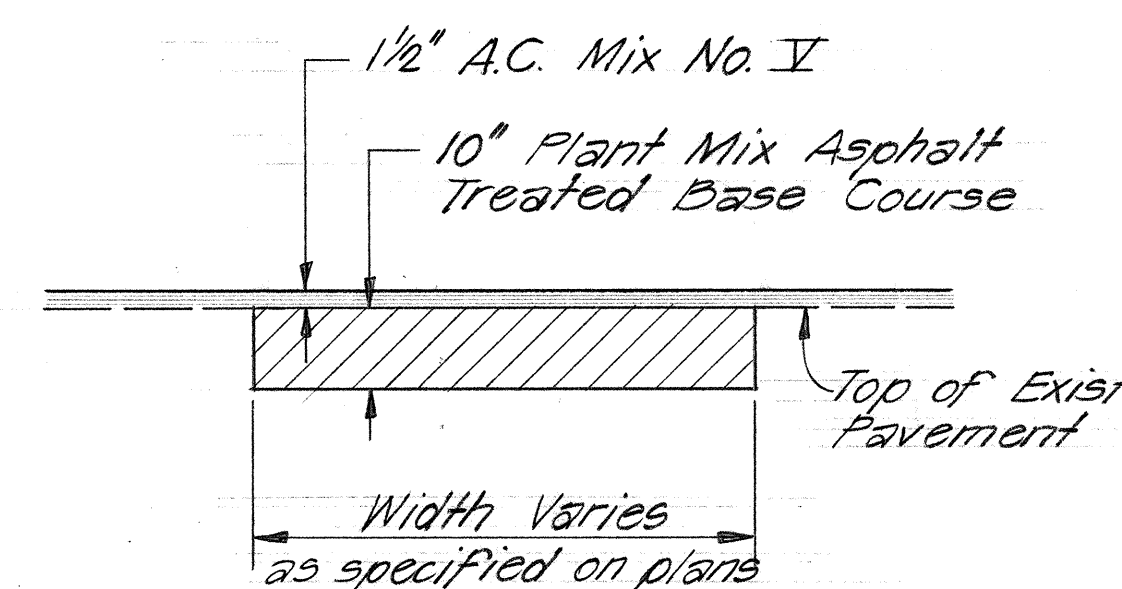

TYPICAL SECTION
AREA OF RECONSTRUCTION
Scale: 1/2" = 1'-0"

STATE OF HAWAII
DEPARTMENT OF TRANSPORTATION
HIGHWAYS DIVISION

TYPICAL SECTIONS, GENERAL NOTES, & MISC. DETAILS

HALAWA HEIGHTS RD RESURFACING
PROJ. NO. 710B-01-75M

Scale: As Shown Date: March 1975

SHEET NO. 1 OF 1 SHEETS