


FED. ROAD DIST. NO.	STATE	PROJ. NO.	FISCAL YEAR	SHEET NO.	TOTAL SHEETS
HAWAII	HAW.	7241A-01-90	1990	4	5

DATE	
DESIGNED BY	
CHECKED BY	
NO.	

R	R	R	
Y	Y	Y	
G	↑	←	
A-1	C-1	B-2	B-3
A-2	C-2	*C-3	B-4
B-1	H-1	F-2	C-4
D-1		*G-1	C-5
E-1			D-3
E-2			D-2
F-1			F-3
H-2			I-1

* PROGRAMMABLE VISIBILITY HEAD
SIGNAL INDICATIONS

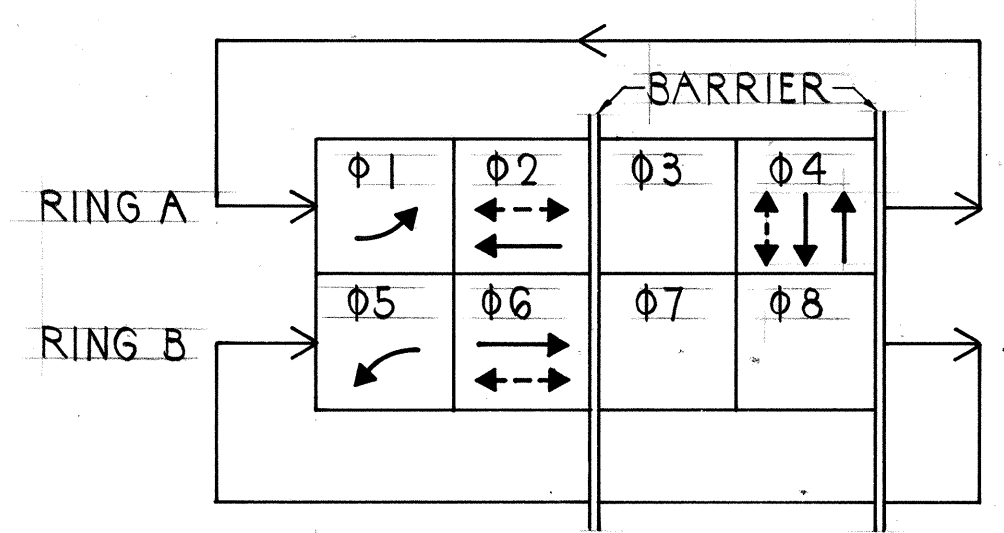


PHASE DIAGRAM
 MODEL 170 CONTROLLER
 MODEL 332 CABINET

- NOTES:
1. STOP SIGN SHALL BE REMOVED AFTER TRAFFIC SIGNAL BECOMES OPERATIONAL
 2. RESTRIPE ALL EXISTING STOP LINES, CROSSWALKS, SOLID LANE LINES AND TRAFFIC ISLANDS AT THE KAHUAPAANI-MANANAI/ALA ALII INTERSECTION.

6-14-90	Revised Mast Arm Spread and Signal Head Spacing at ©. Revised Traffic Signal Standard to Type II Standard with 20' Mast arm at ©.
---------	---

DATE	REVISION
STATE OF HAWAII DEPARTMENT OF TRANSPORTATION HIGHWAYS DIVISION TRAFFIC SIGNAL PLAN KAHUAPAANI STREET TRAFFIC SIGNALS AT MANANAI PLACE / ALA ALII STREET PROJECT NO. 7241A-01-90 SCALE: AS NOTED DATE: SHEET No. 1 OF 1 SHEETS	

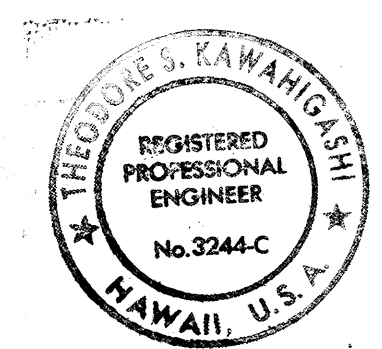

THIS WORK WAS PREPARED BY ME
 OR UNDER MY SUPERVISION
Theodore S. Kawaharagi

Change Order not processed **C.O.4**