


TSS AND SIGNAL FACE SCHEDULE		
	TSS	SIGNAL MESSAGE
(A)	TYPE II TSS	(1) P(R + Y + ←)
		(2) (R + Y + G)
		(3) (R + Y + G)
		(4) (R + Y + G)
		(5) (H + M)
		(6) (R + Y + G)
		(7) (H + M)

NOTES:

1. ALL STRUCTURES, PAVEMENTS, UTILITIES, LANDSCAPING AND OTHER TOPOGRAPHICAL FEATURES SHOWN ON THE INTERSECTION PLAN ARE EXISTING OR NEW AND ARE TO REMAIN IN THE FINISHED WORK UNLESS NOTED OR INDICATED OTHERWISE.
2. SEE CIVIL SHEETS FOR WORK ON ROADWAY CONSTRUCTION, TRAFFIC SIGNS AND MARKINGS AND TRAFFIC CONTROL.
3. NO REMOVAL OF TRAFFIC SIGNAL EQUIPMENT AND/OR DEMOLITION OF BASES AND TSPB'S SHALL COMMENCE UNTIL NEW BASES, TSPB'S, CONDUITS, CABLES AND OTHER TRAFFIC SIGNAL EQUIPMENT HAVE BEEN INSTALLED IN ACCORDANCE WITH THE TRAFFIC SIGNAL PLAN AND ARE READY FOR OPERATION.
4. THE CONTRACTOR SHALL FURNISH AND INSTALL ONE 2" PVC CONDUIT BETWEEN EACH NEW TRAFFIC SIGNAL STANDARD AND ADJACENT PULLBOX. THE CONTRACTOR SHALL ALSO FURNISH AND INSTALL A SUFFICIENT NUMBER AND LENGTH OF TYPE 5 CABLES TO SERVICE EACH SIGNAL FACE TO BE MOUNTED ON EACH TRAFFIC SIGNAL STANDARD BETWEEN EACH SIGNAL FACE AND ADJACENT PULLBOX.
5. GROUND WIRE SHALL BE FURNISHED AND INSTALLED AS REQUIRED BY THE NEC CODE.

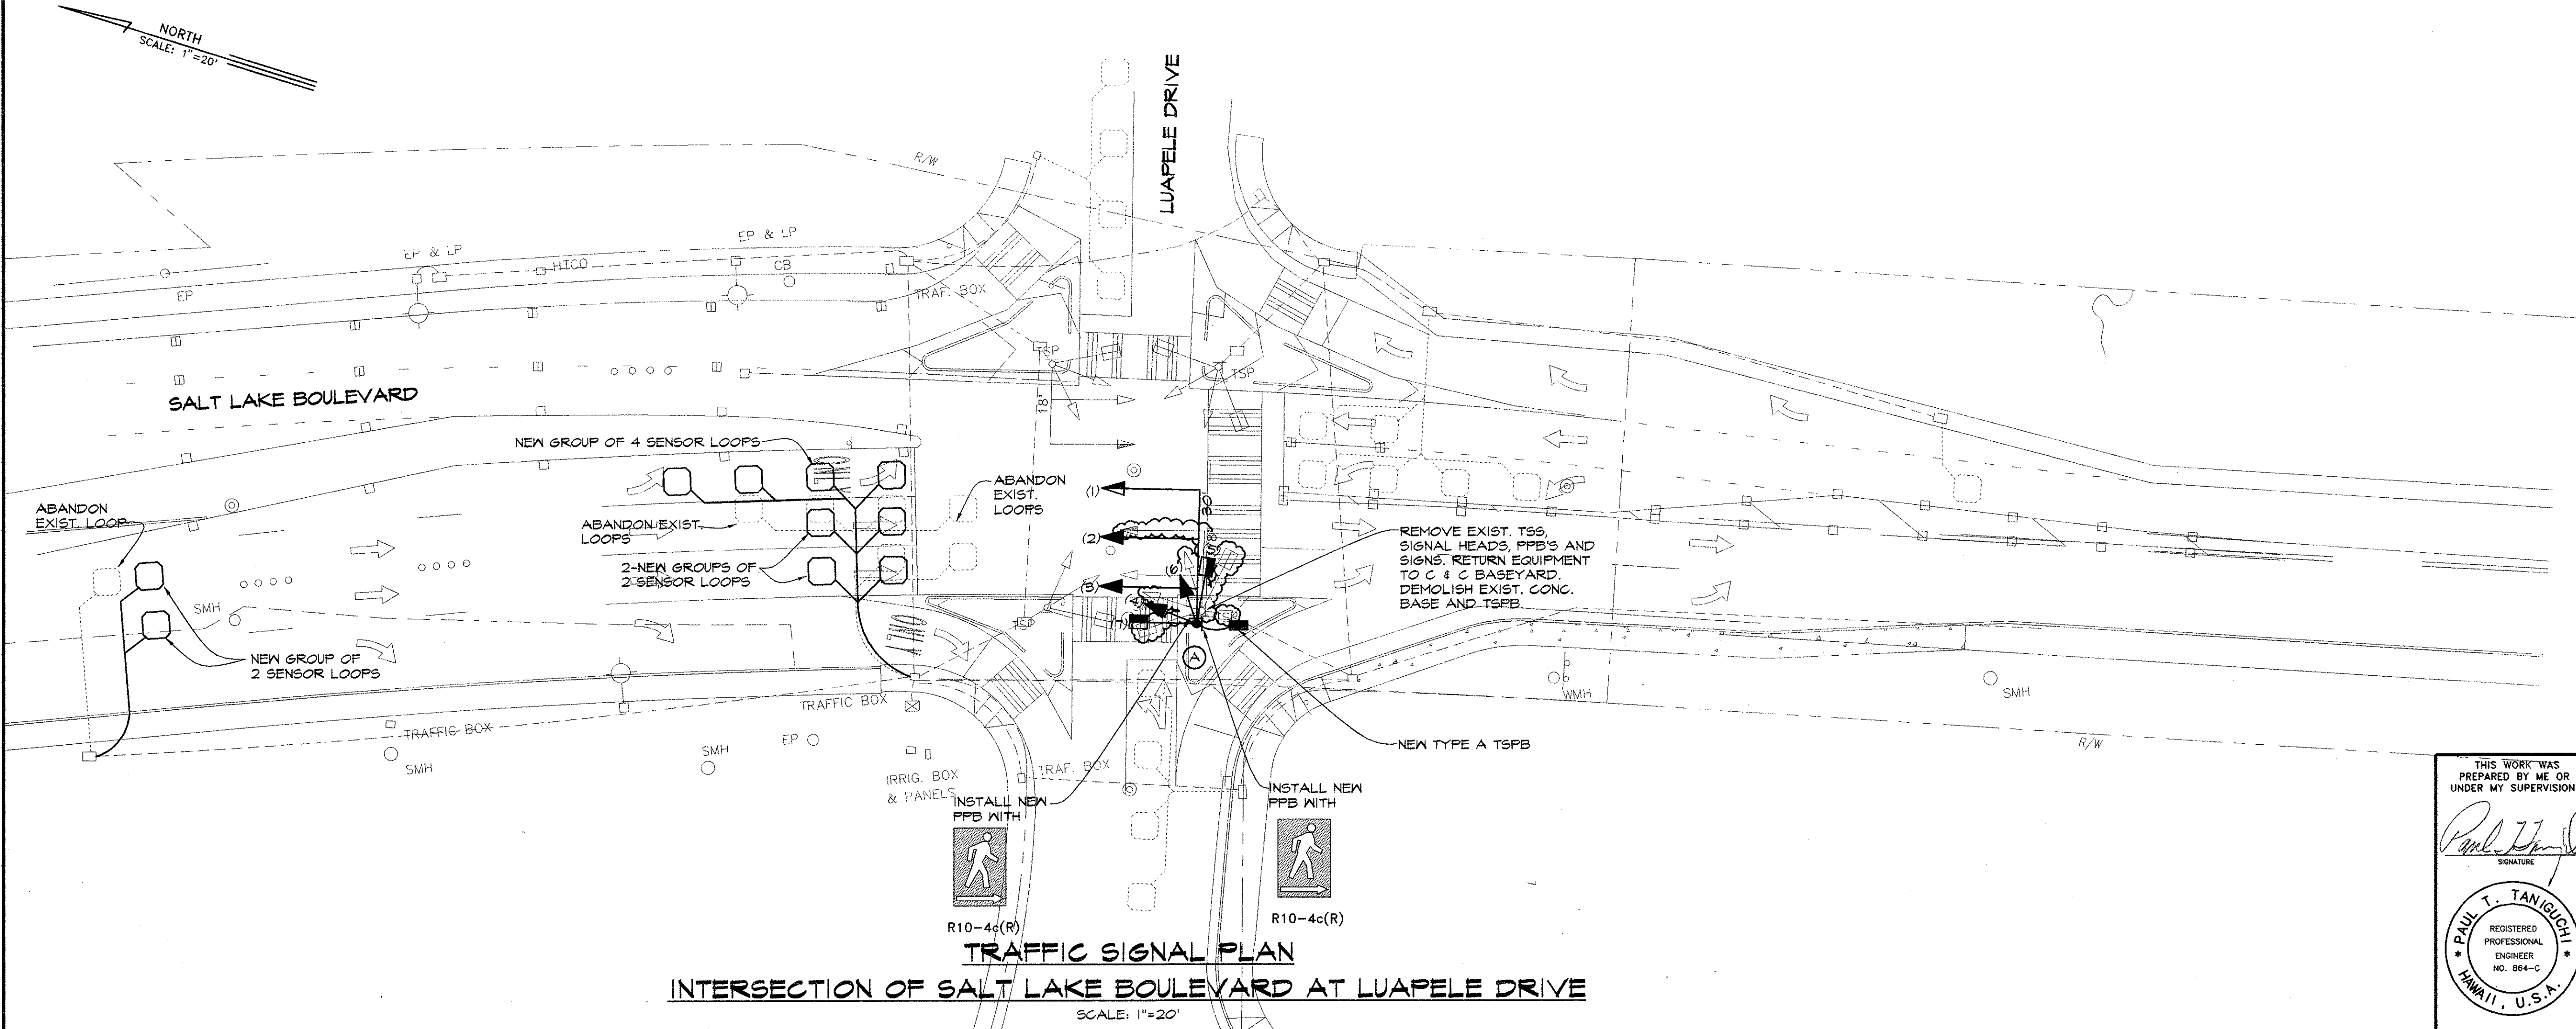

TRAFFIC SIGNAL PLAN
INTERSECTION OF SALT LAKE BOULEVARD AT LUAPELE DRIVE
SCALE: 1"=20'

REVISION	DATE	DESCRIPTION	BY	APPR'D.
 GRAY, HONG, BILLS & ASSOCIATES, INC. CONSULTING ENGINEERS 119 MERCHANT ST. SUITE 607				
SALT LAKE BOULEVARD IMPROVEMENTS AT STADIUM MARKETPLACE T.M.K.: 9 - 9 - 02 HALAWA, EWA, OAHU, HAWAII				
INTERSECTION OF SALT LAKE BLVD. AT LUAPELE DRIVE REVISIONS TO TRAFFIC SIGNAL SYSTEM				
ENGINEER	DRAWN BY	CHECKED BY	APPROVED BY:	
CHIEF, ELECTRICAL & MAINTENANCE SERVICES DIVISION DEPT. OF TRANSPORTATION SERVICES				

THIS WORK WAS
PREPARED BY ME OR
UNDER MY SUPERVISION.

REGISTERED
PROFESSIONAL
ENGINEER
NO. 864-C
HAWAII, U.S.A.