



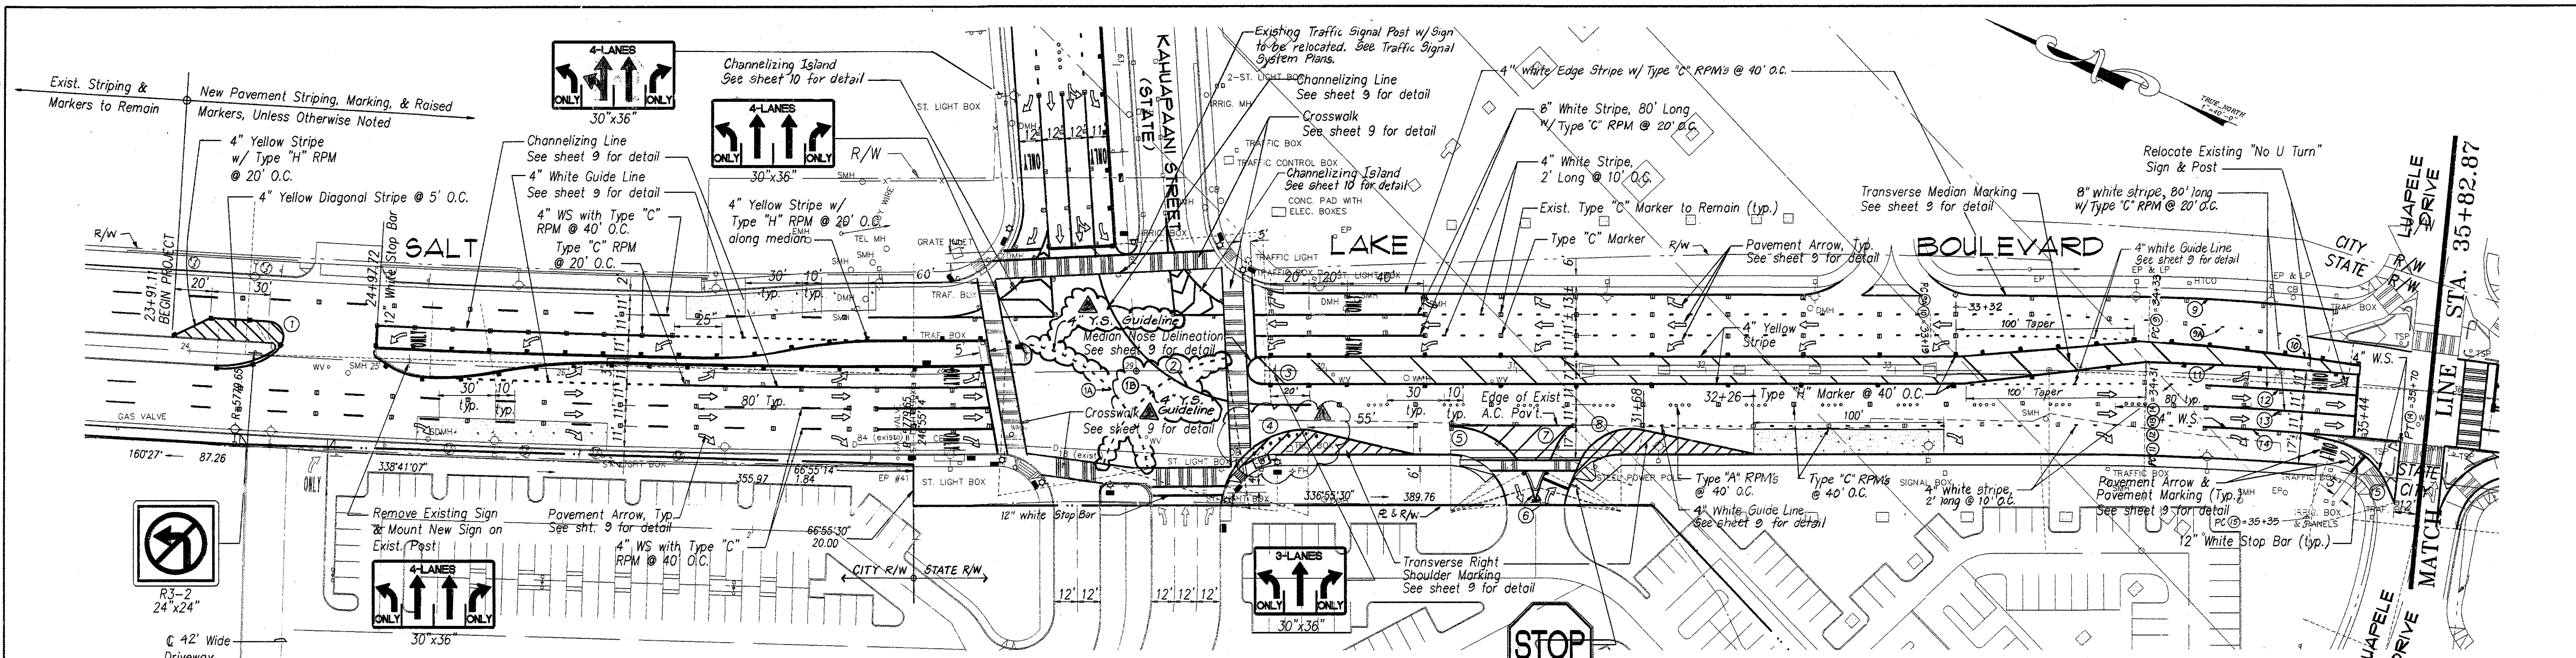

CURVE DATA															
Station	1	2	3	4	5	6	7	8	9	10	11	12	13	14	15
Δ	144'33"	85'58'32"	71'23'38"	90'00"	53'04'28"	10'05'16"	22'46'29"	79'27'56"	5'38'54"	9'03'46"	77'36'10"	9'03'46"	69'54'36"		
Δ/2	72'16'30"	42'59'16"	35'41'49"	45'00"	26'32'14"	5'02'38"	11'23'14.5"	39'43'58"	2'49'27"	4'31'53"	38'48'05"	4'31'53"	31'57'18"		
R	8.00	90.00	45.00	13.00	44.50	44.50	44.50	30.00	991.15	1400.00	80.00	1411.00	80.00		
T	25.03	83.89	32.33	13.00	22.24	3.93	8.98	24.94	48.90	110.95	64.32	111.83	49.90		
Ch	15.24	122.73	52.51	18.38	39.79	7.82	17.62	38.35	97.67	221.21	100.26	222.95	84.68		
Lc	20.18	135.05	56.07	20.42	41.25	7.83	17.73	41.61	97.71	221.44	106.35	223.18	89.24		

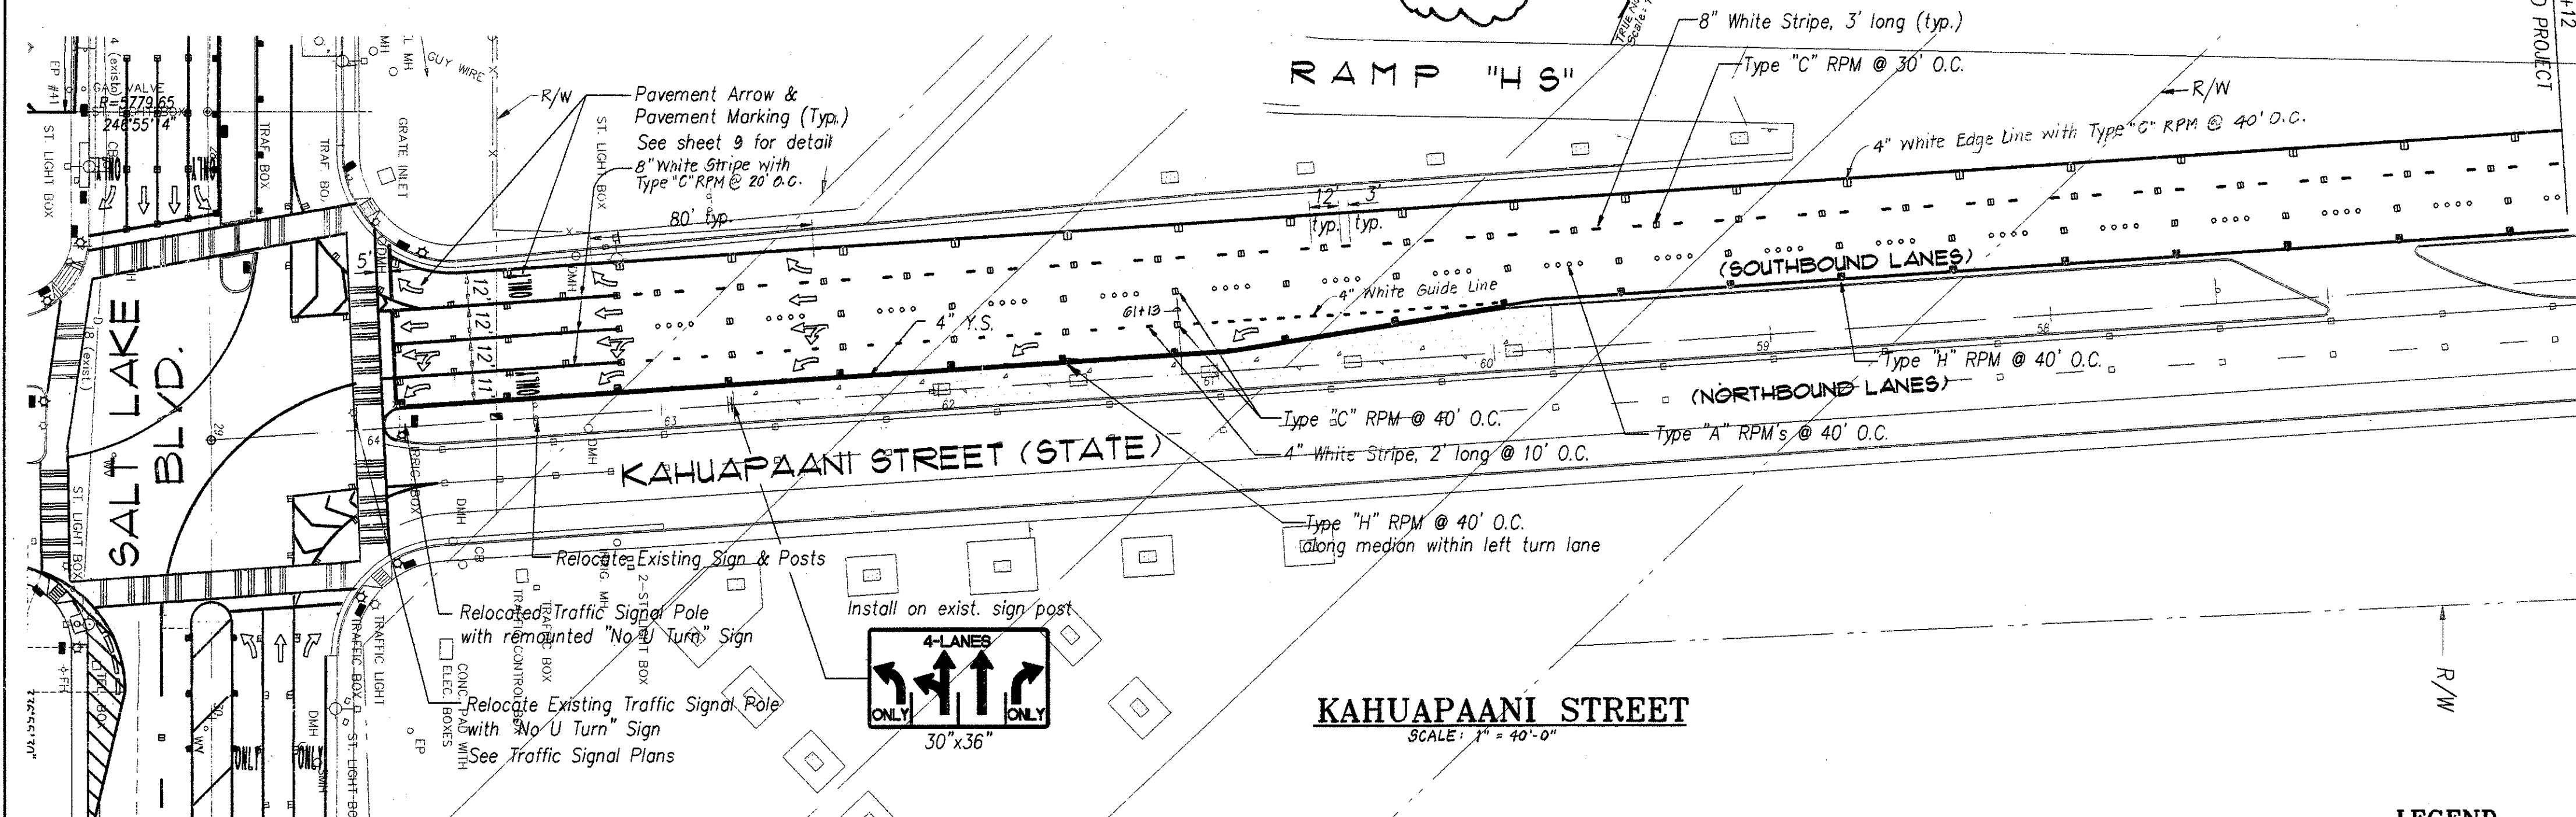

CURVE DATA															
Station	1	2	3	4	5	6	7	8	9	10	11	12	13	14	15
Δ	3'23'42"	2'25'12"	2'26'03"	3'12'17"	52'42'09"	68'36'43"	68'36'43"	4'35'14"	3'32'42"	2'34'06"	21'52'54"				
Δ/2	1'41'51"	1'12'36"	1'13'01.5"	1'36'08.5"	26'23'04.5"	34'18'21.5"	34'18'21.5"	2'17'37"	1'46'21"	1'17'03"	10'56'25.5"				
R	1905.00	1894.00	1883.00	1872.00	40.00	42.00	42.00	1200.00	1189.00	1894.00	2874				
T	56.45	40.00	40.00	52.36	19.81	28.66	28.66	48.06	36.80	42.46	64.39				
Ch	112.86	79.99	79.99	104.69	35.51	47.34	47.34	96.05	73.56	84.89	8.63				
Lc	112.87	80.00	80.00	104.70	36.79	50.30	50.30	96.07	73.57	84.90	8.68				


CURVE DATA															
Station	1	2	3	4	5	6	7	8	9	10	11	12	13	14	15
Δ	3'23'42"	2'25'12"	2'26'03"	3'12'17"	52'42'09"	68'36'43"	68'36'43"	4'35'14"	3'32'42"	2'34'06"	21'52'54"				
Δ/2	1'41'51"	1'12'36"	1'13'01.5"	1'36'08.5"	26'23'04.5"	34'18'21.5"	34'18'21.5"	2'17'37"	1'46'21"	1'17'03"	10'56'25.5"				
R	1905.00	1894.00	1883.00	1872.00	40.00	42.00	42.00	1200.00	1189.00	1894.00	2874				
T	56.45	40.00	40.00	52.36	19.81	28.66	28.66	48.06	36.80	42.46	64.39				
Ch	112.86	79.99	79.99	104.69	35.51	47.34	47.34	96.05	73.56	84.89	8.63				
Lc	112.87	80.00	80.00	104.70	36.79	50.30	50.30	96.07	73.57	84.90	8.68				

SALT LAKE BOULEVARD
SCALE: 1" = 40'-0"

KAHUAPAANI STREET
SCALE: 1" = 40'-0"

STRIPING PLAN
Scale in Feet

- LEGEND**
- New Traffic Signal Pullbox, See Traffic Signal Plans
 - Type A Raised Pavement Marker [RPM]
 - Type C Raised Pavement Marker [RPM]
 - Type J Raised Pavement Marker [RPM]
 - Type H Raised Pavement Marker [RPM]
 - Y.S. - Yellow Stripe
 - W.S. - White Stripe

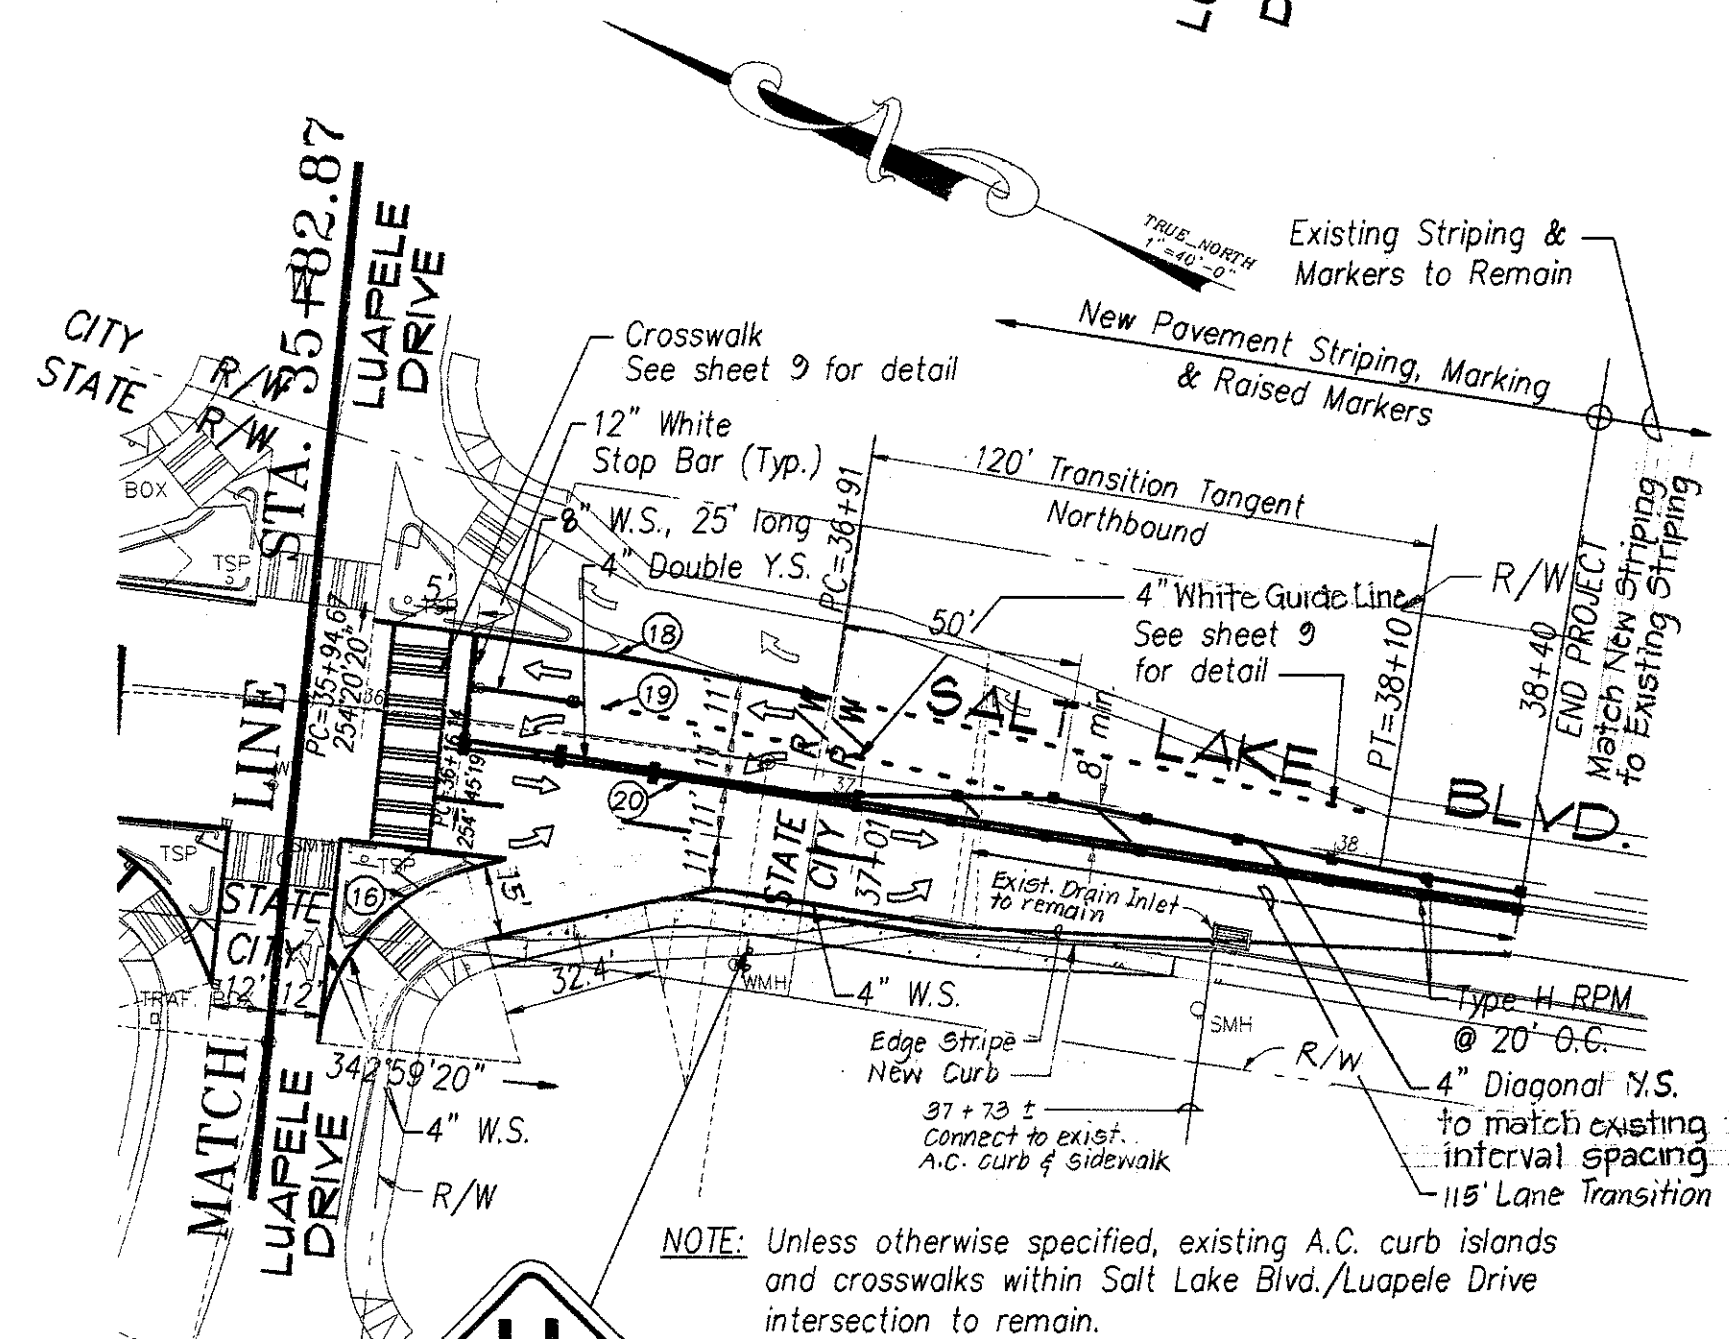

SALT LAKE BOULEVARD
SCALE: 1" = 40'-0"

REVISION	DATE	DESCRIPTION	BY	APPR'D.
12-11-93		Added Guidelines	GHB	
11-24-93		ELIMINATE CURB AT AT&T BOX & PROVIDE FLEET PLANTATION	GHB	

GRAY, HONG, BILLS & ASSOCIATES, INC.
CONSULTING ENGINEERS
119 MERCANT ST. SUITE 607
HALAWA, EWA, OAHU, HAWAII

SALT LAKE BOULEVARD IMPROVEMENTS AT STADIUM MARKETPLACE
UNDER THE PROVISIONS OF ORDINANCE NO. 2412, AS AMENDED
T.M.K.: 9 - 9 - 02
HALAWA, EWA, OAHU, HAWAII

STRIPING PLAN

ENGINEER	RS	DRAWN BY	JS	CHECKED BY	
APPROVED BY:					

THIS WORK WAS PREPARED BY ME OR UNDER MY SUPERVISION:

RECORD DRAWINGS

FILE	POCKET	FOLDER	NO.

SHEET **7** OF **20** SHEETS