



FED. ROAD DIST. NO.	STATE	FED. AID PROJ. NO.	FISCAL YEAR	SHEET NO.	TOTAL SHEETS
HAWAII	HAW.	STP-724(1)	1995		42


ADD.24S-1

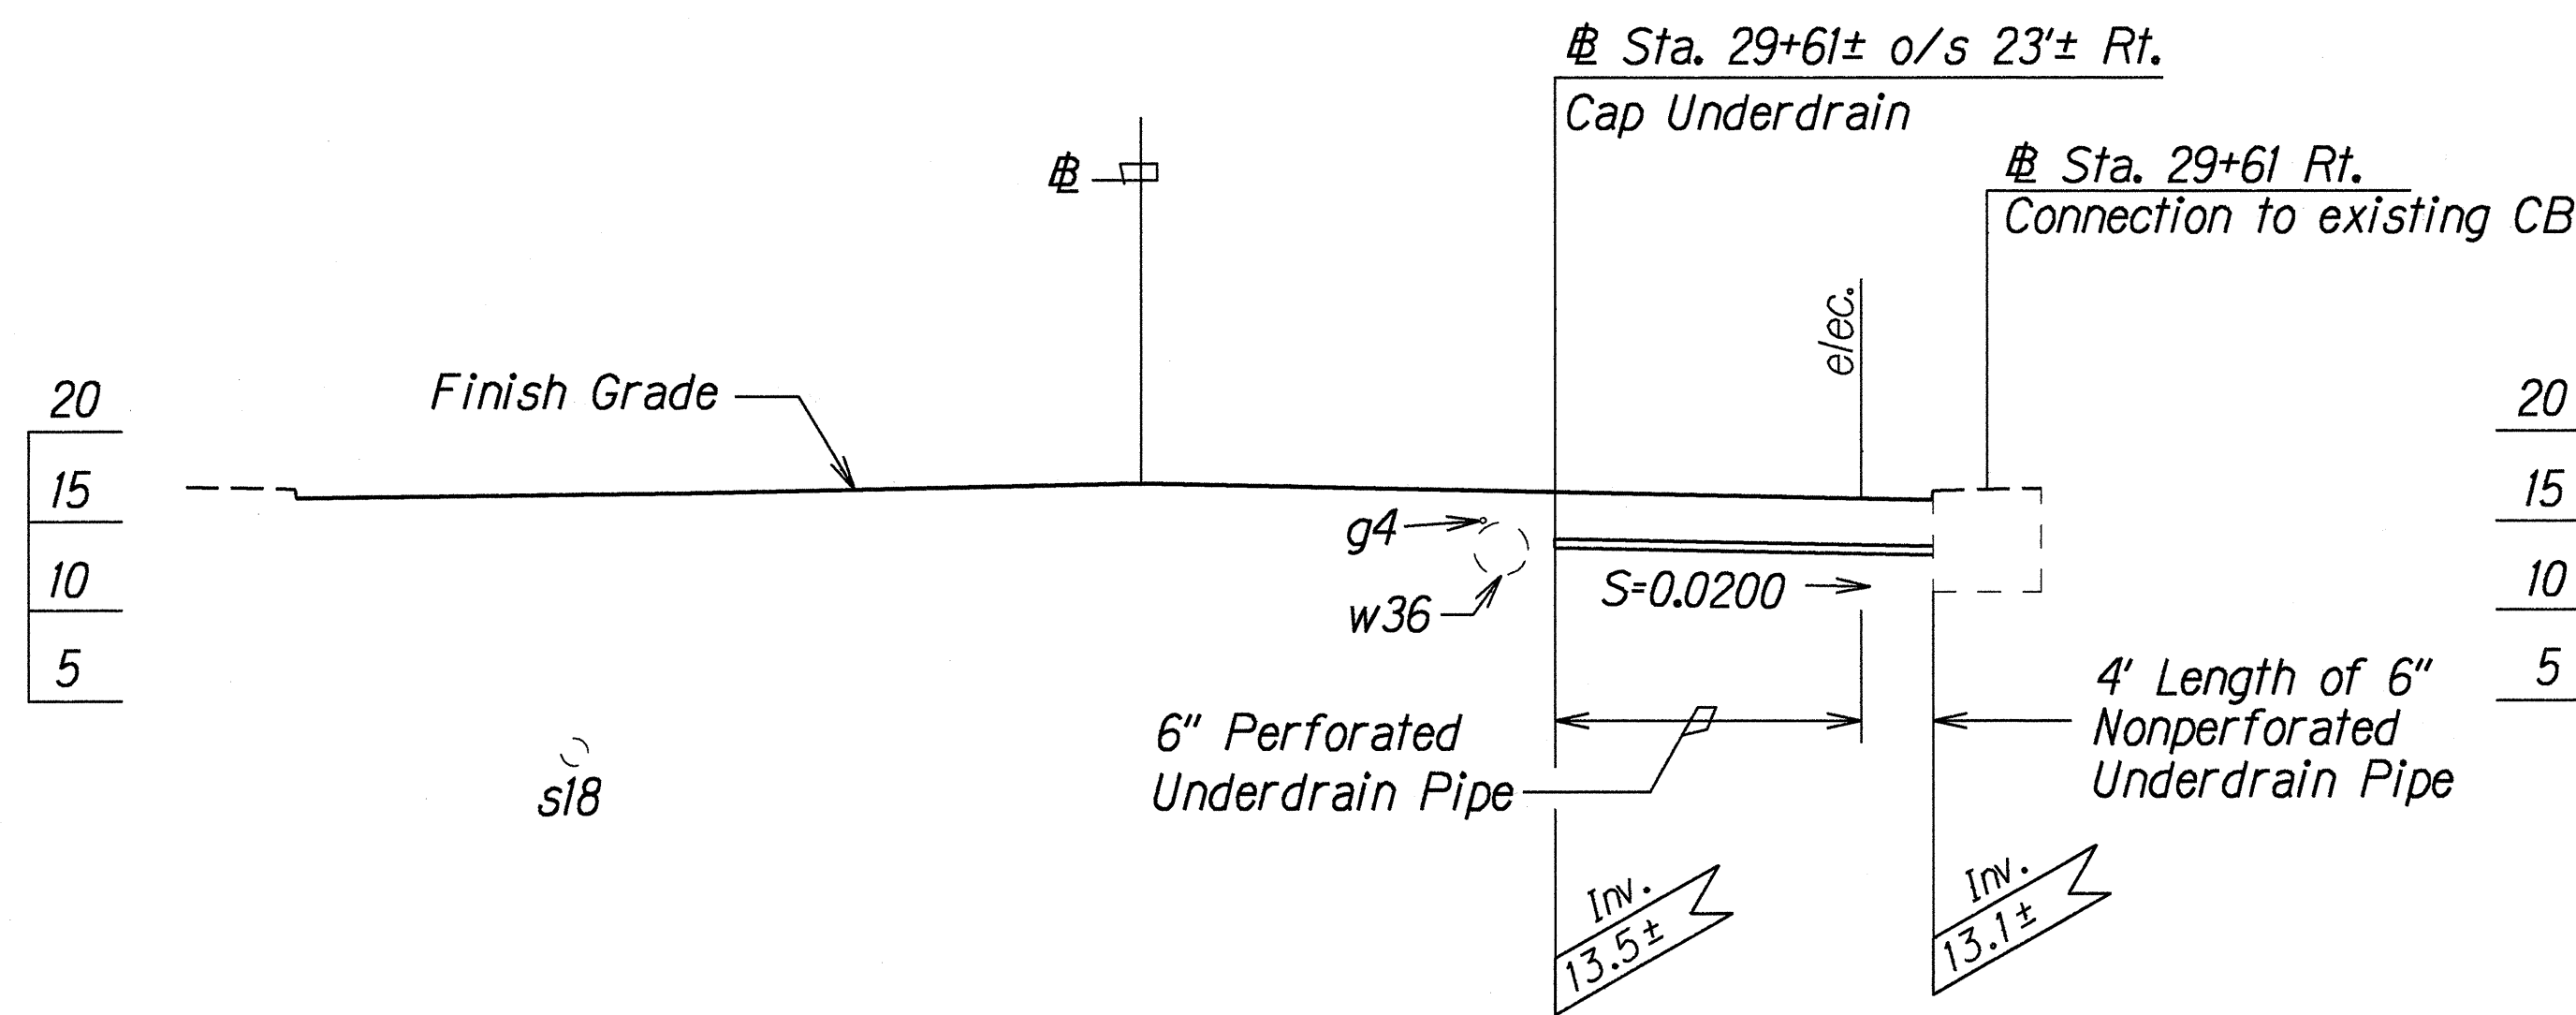


UNDERDRAIN PROFILE - STA. 29+61±

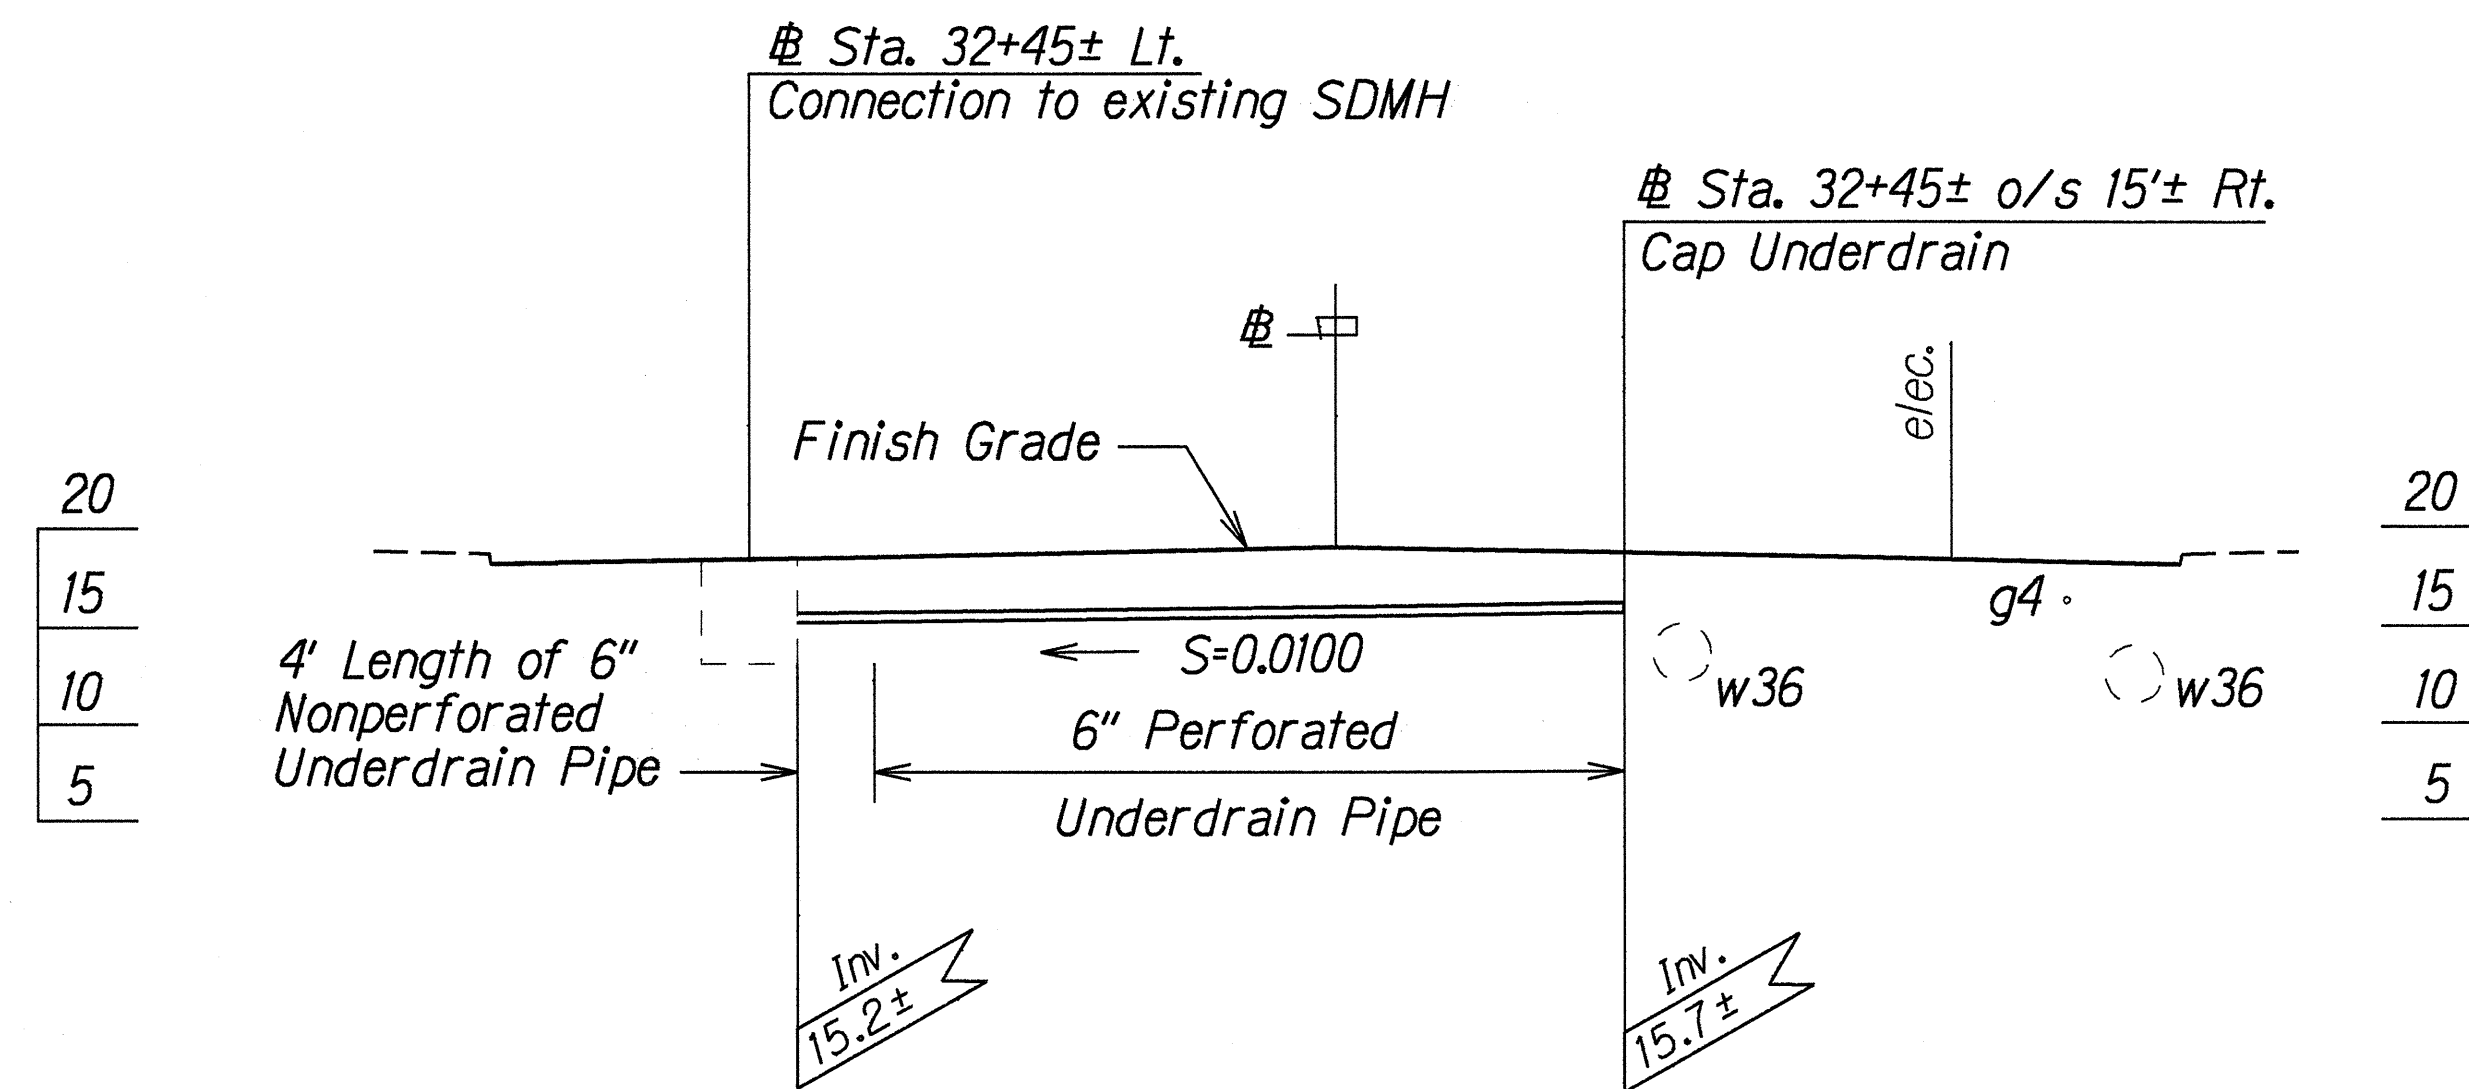

UNDERDRAIN PROFILE - STA. 32+45±

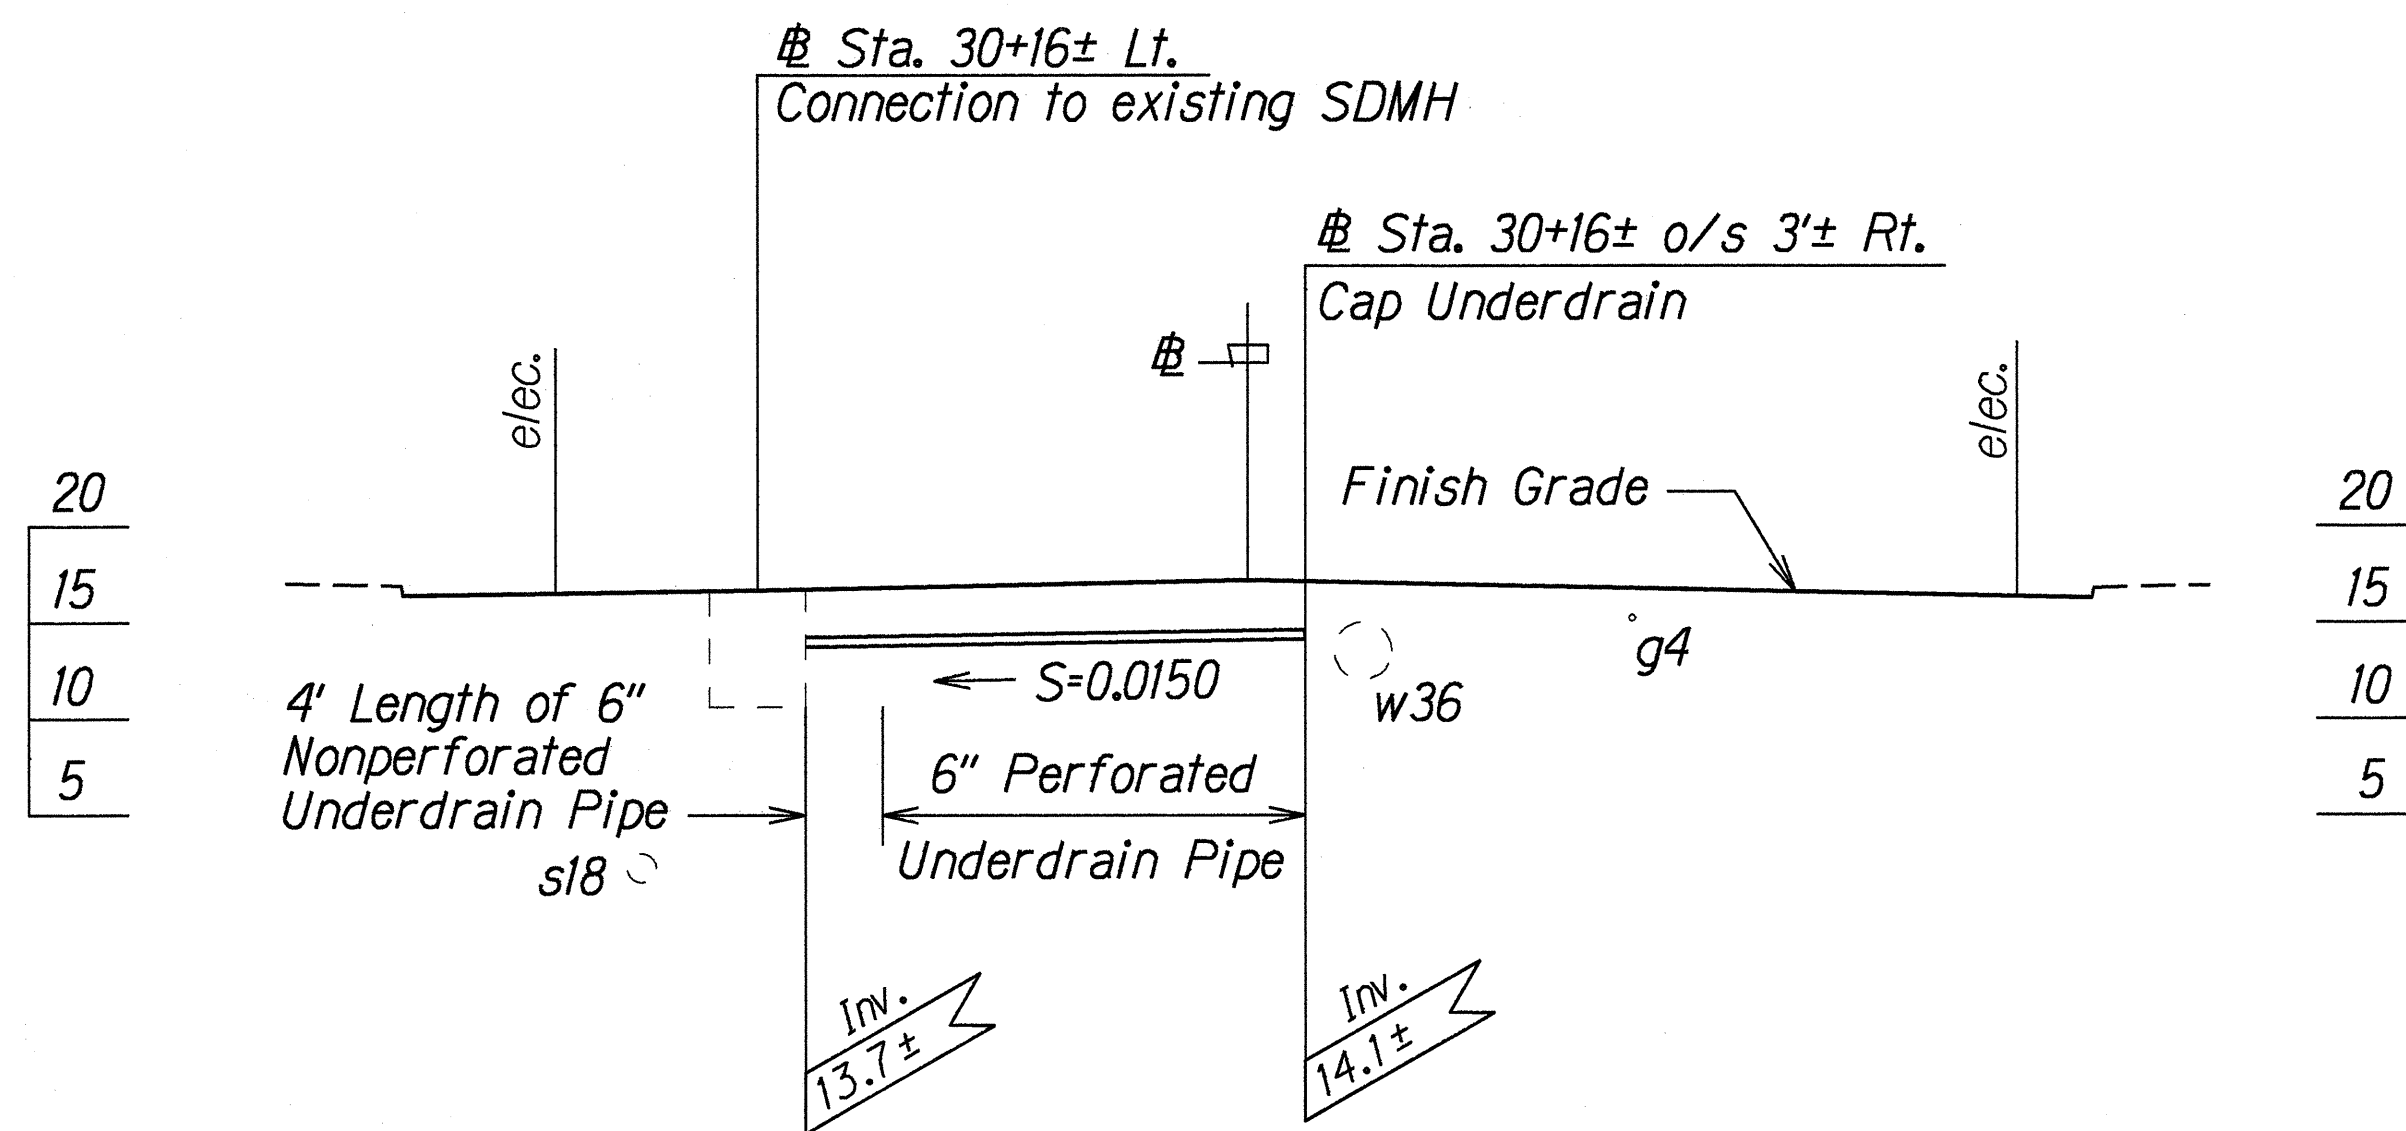

UNDERDRAIN PROFILE - STA. 30+16±

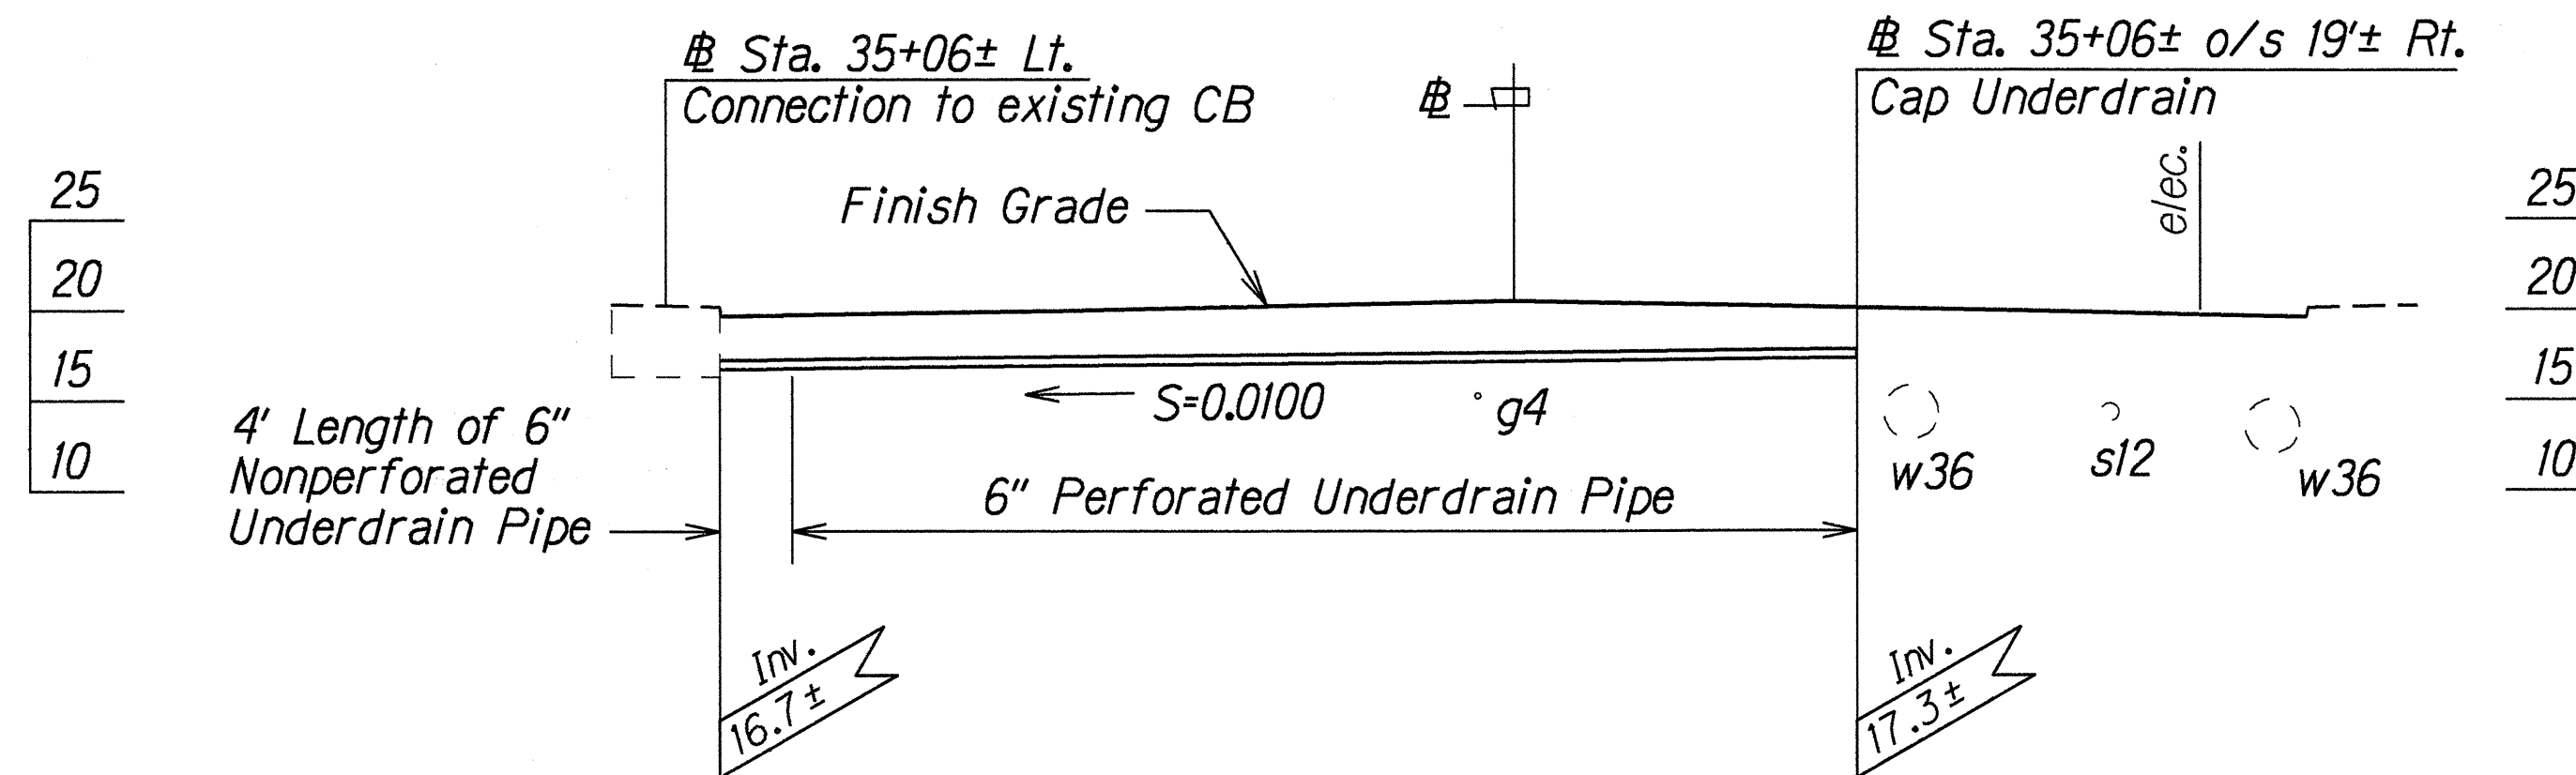

UNDERDRAIN PROFILE - STA. 35+06±

DESIGNED BY	DATE
DRAWN BY	6/13/95
CHECKED BY	
NOTED BY	
QUANTITIES BY	
REVISIONS BY	

6/13/95	Added sheet to show transverse underdrain profiles
DATE	REVISION

STATE OF HAWAII DEPARTMENT OF TRANSPORTATION HIGHWAYS DIVISION
DRAINAGE PROFILES
KAHUAPAANI ST. RESURFACING
Ulune St. to Salt Lake Blvd.
Fed. Aid Project No. STP-724(1)
Scale: 1"=10' Date: June 1995
SHEET No. H2A OF 4 SHEETS

ADD. 24 S-1