




FED. ROAD DIST. NO.	STATE	FED. AID PROJ. NO.	FISCAL YEAR	SHEET NO.	TOTAL SHEETS
HAWAII	HAW.	STP-724(1)	1995	14	42

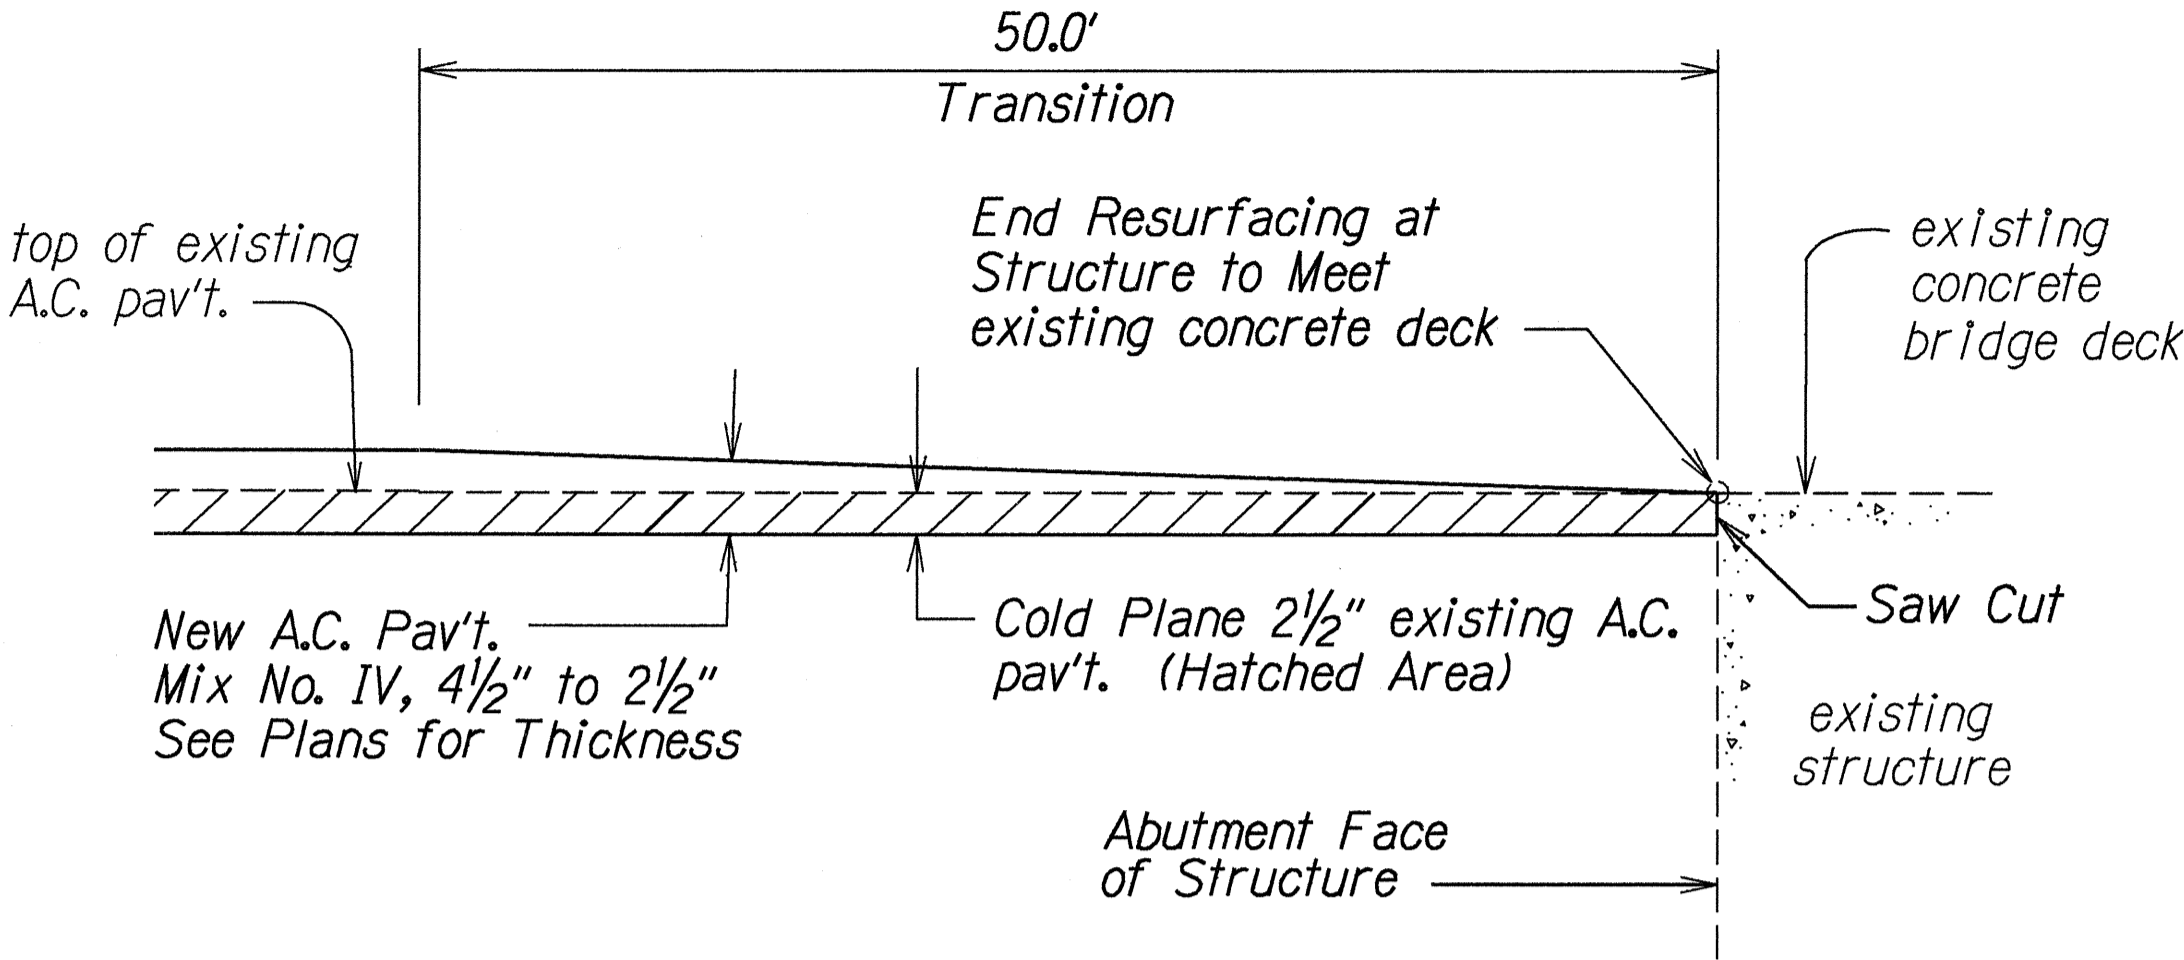


COLD PLANED TRANSITION AT STRUCTURE
DETAIL
Not to Scale

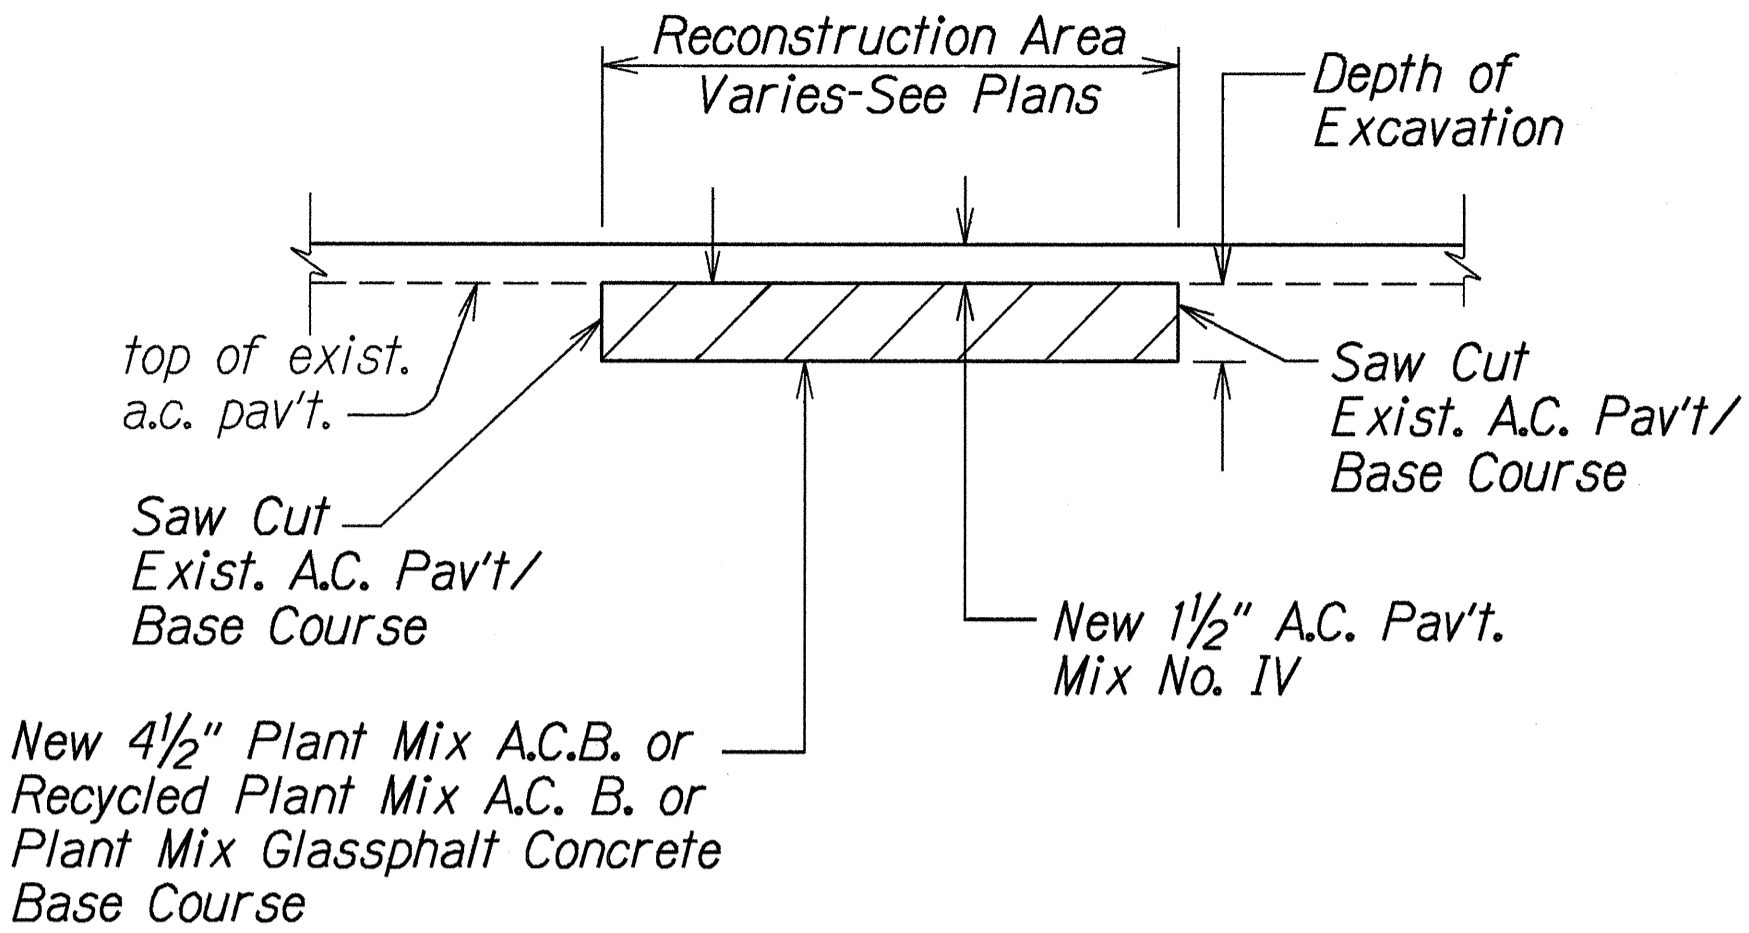


A.C. PAVEMENT RECONSTRUCTION DETAIL
Not To Scale

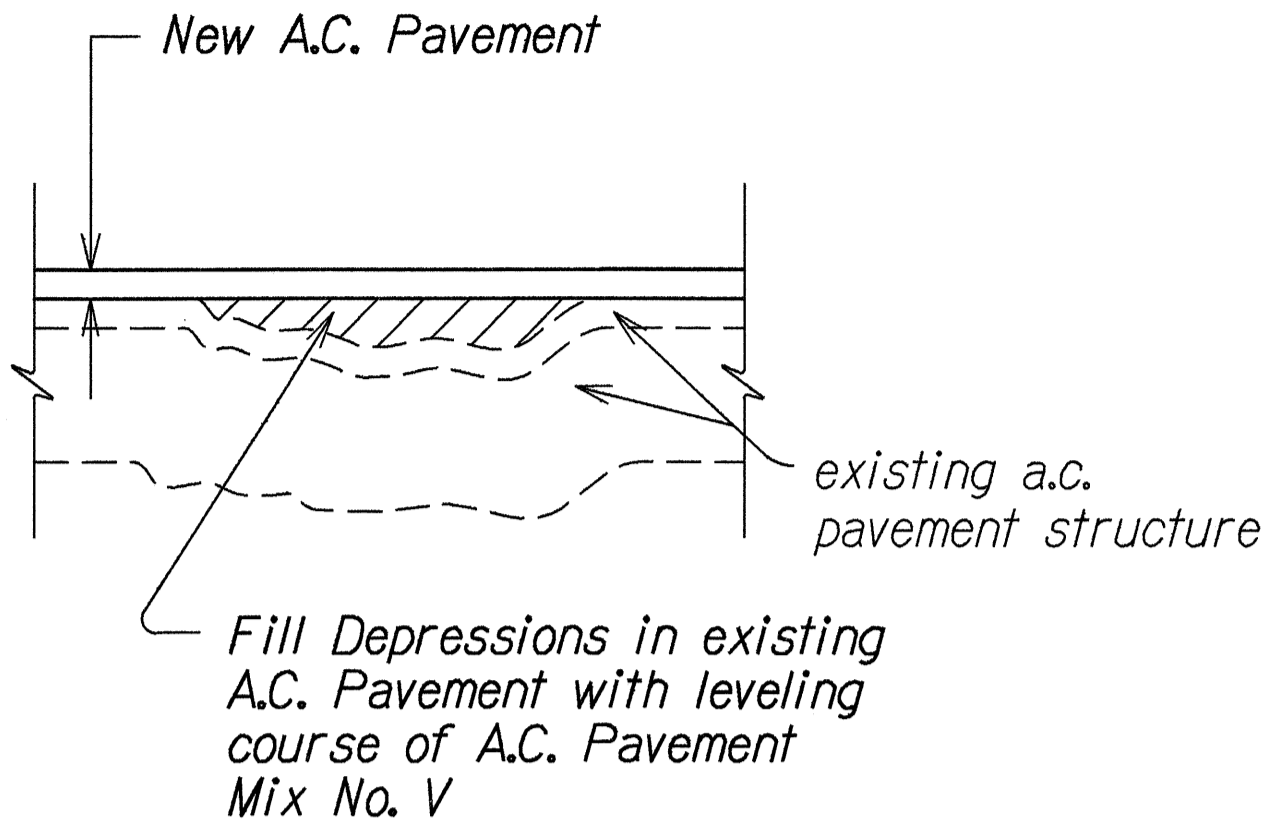


LEVELING COURSE DETAIL
Not To Scale

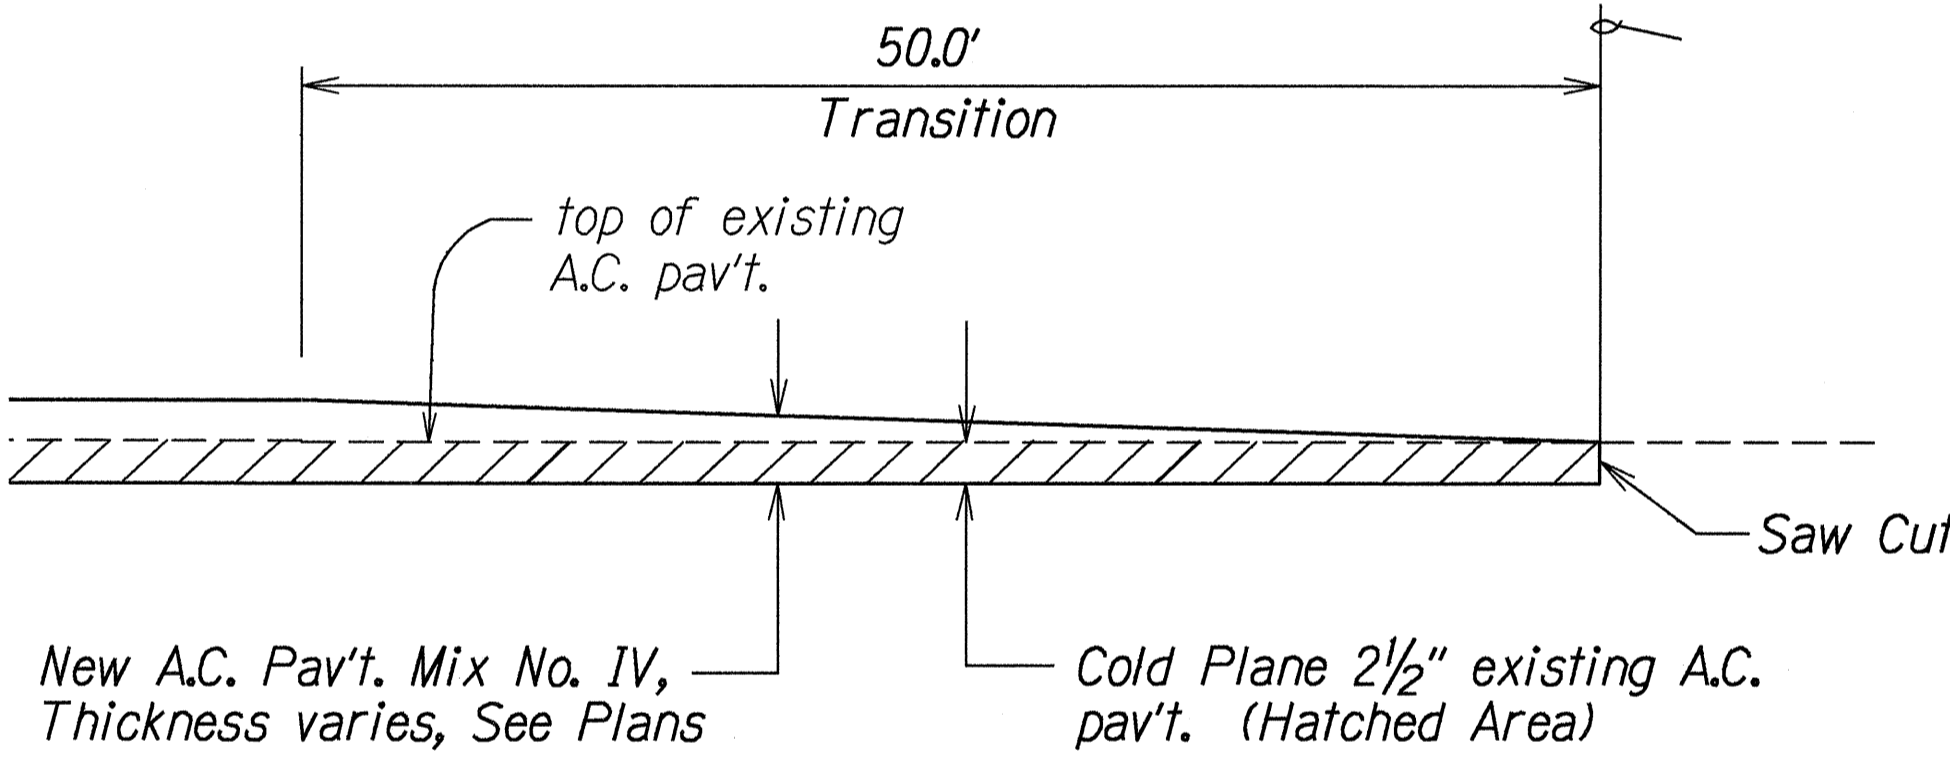

COLD PLANED TRANSITION TO EXISTING A.C. PAVEMENT DETAIL
Not to Scale

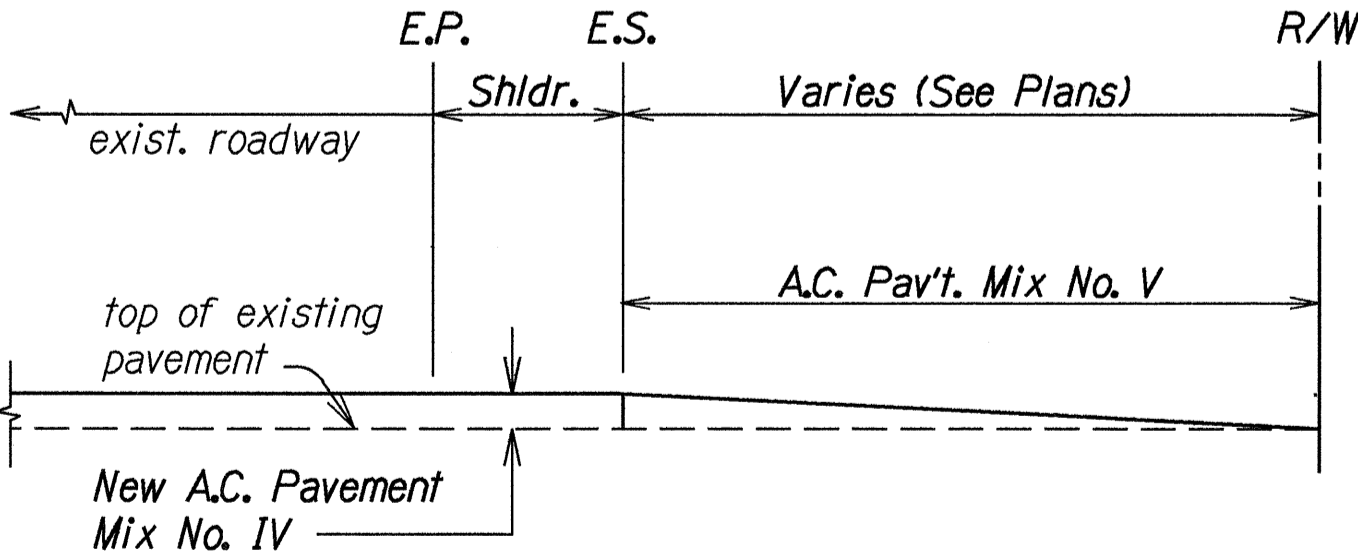

TYPICAL DETAIL AT ALA ALII ST. & MANANAI PL.
Not to Scale

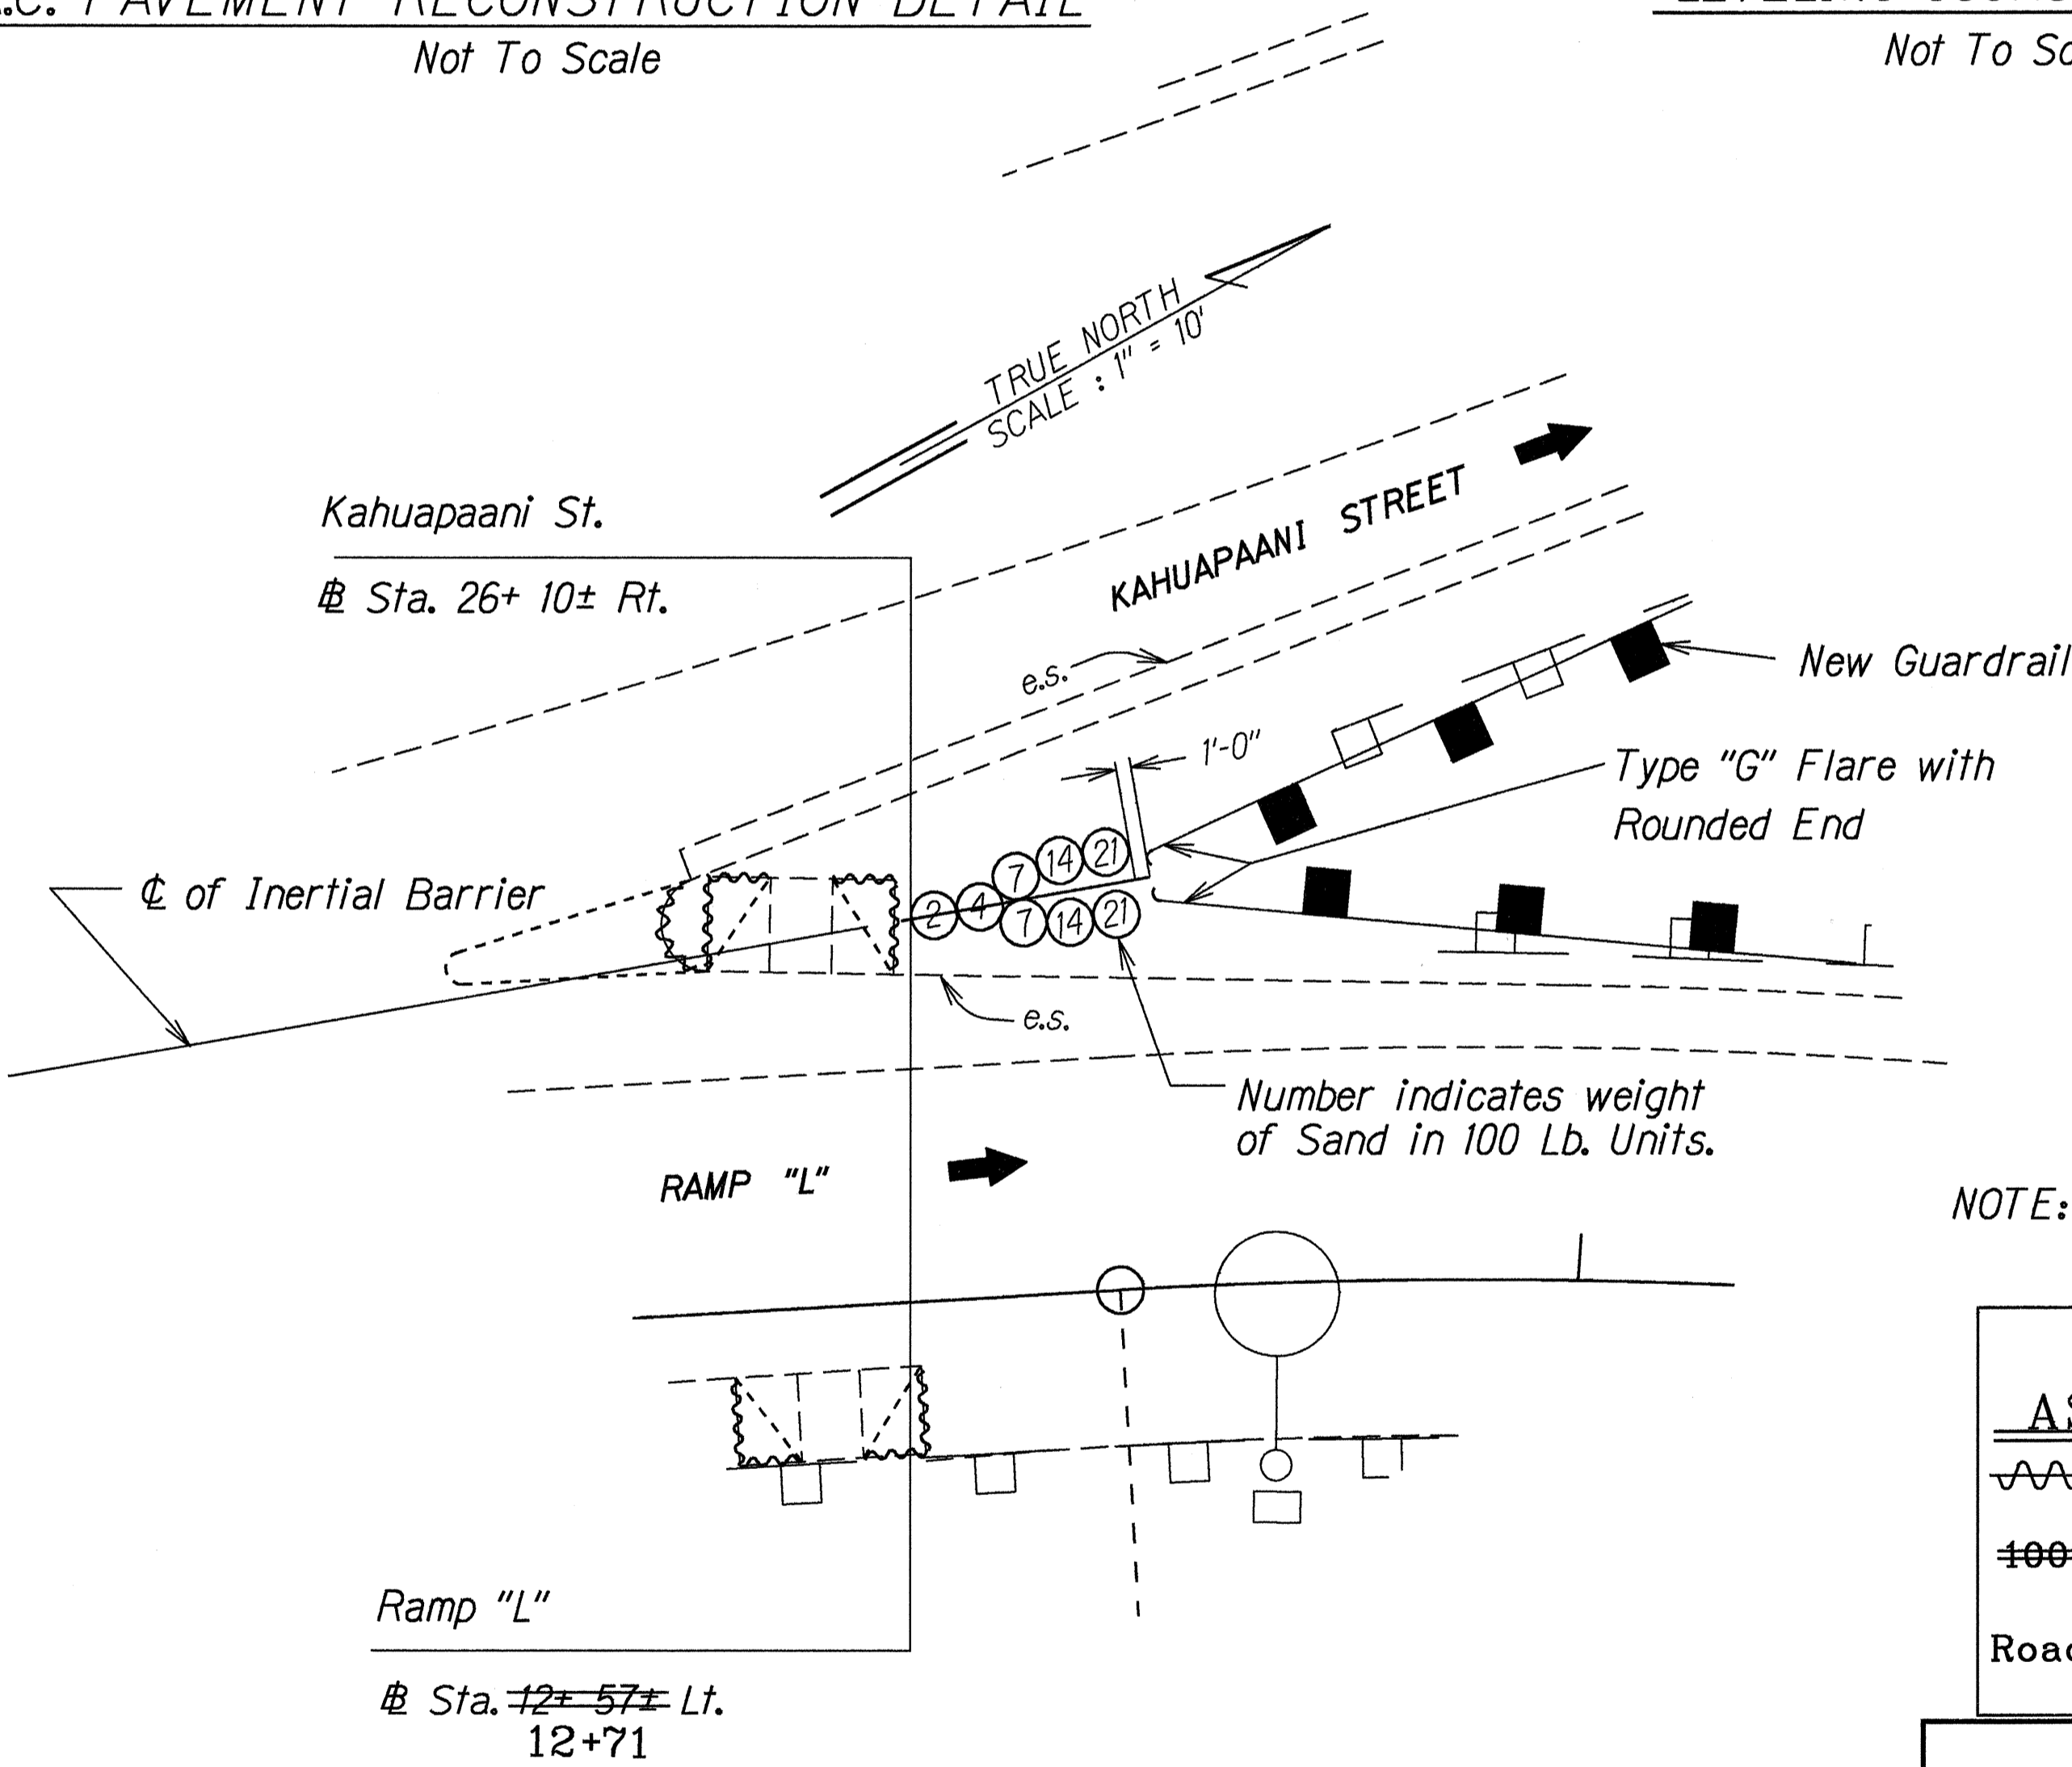

TYPICAL DETAIL - INERTIAL BARRIER INSTALLATION
KAHUAPAANI ST. & STA. 26+10± RT. AND RAMP "L" & STA. 12+57± LT.
Not to Scale

NOTE: All work shall be approved as directed by the Engineer.

LEGEND FOR AS-BUILT POSTINGS	
	Squiggly line for as-built deletion
	Double line for as-built deletion
Roadway	Text for as-built posting

STATE OF HAWAII
DEPARTMENT OF TRANSPORTATION
HIGHWAYS DIVISION

MISCELLANEOUS DETAILS
KAHUAPAANI STREET RESURFACING
Ulune Street To Salt Lake Blvd.
Fed. Aid. Project No. STP-724(1)

Scale: 1"=40'
Date: May, 1995

SHEET No. 1 OF 1 SHEETS

ORIGINAL PLAN	DATE
SURVEY PLOTTED BY	5/25/95
DRAWN BY	G. Kawahito
DESIGNED BY	K. Ito
CHECKED BY	delm
NOTES	delm
DATE	5/25/95