


FED. ROAD DIST. NO.	STATE	FED. AID PROJ. NO.	FISCAL YEAR	SHEET NO.	TOTAL SHEETS
HAWAII	HAW.	STP-724(I)	1995	15	42

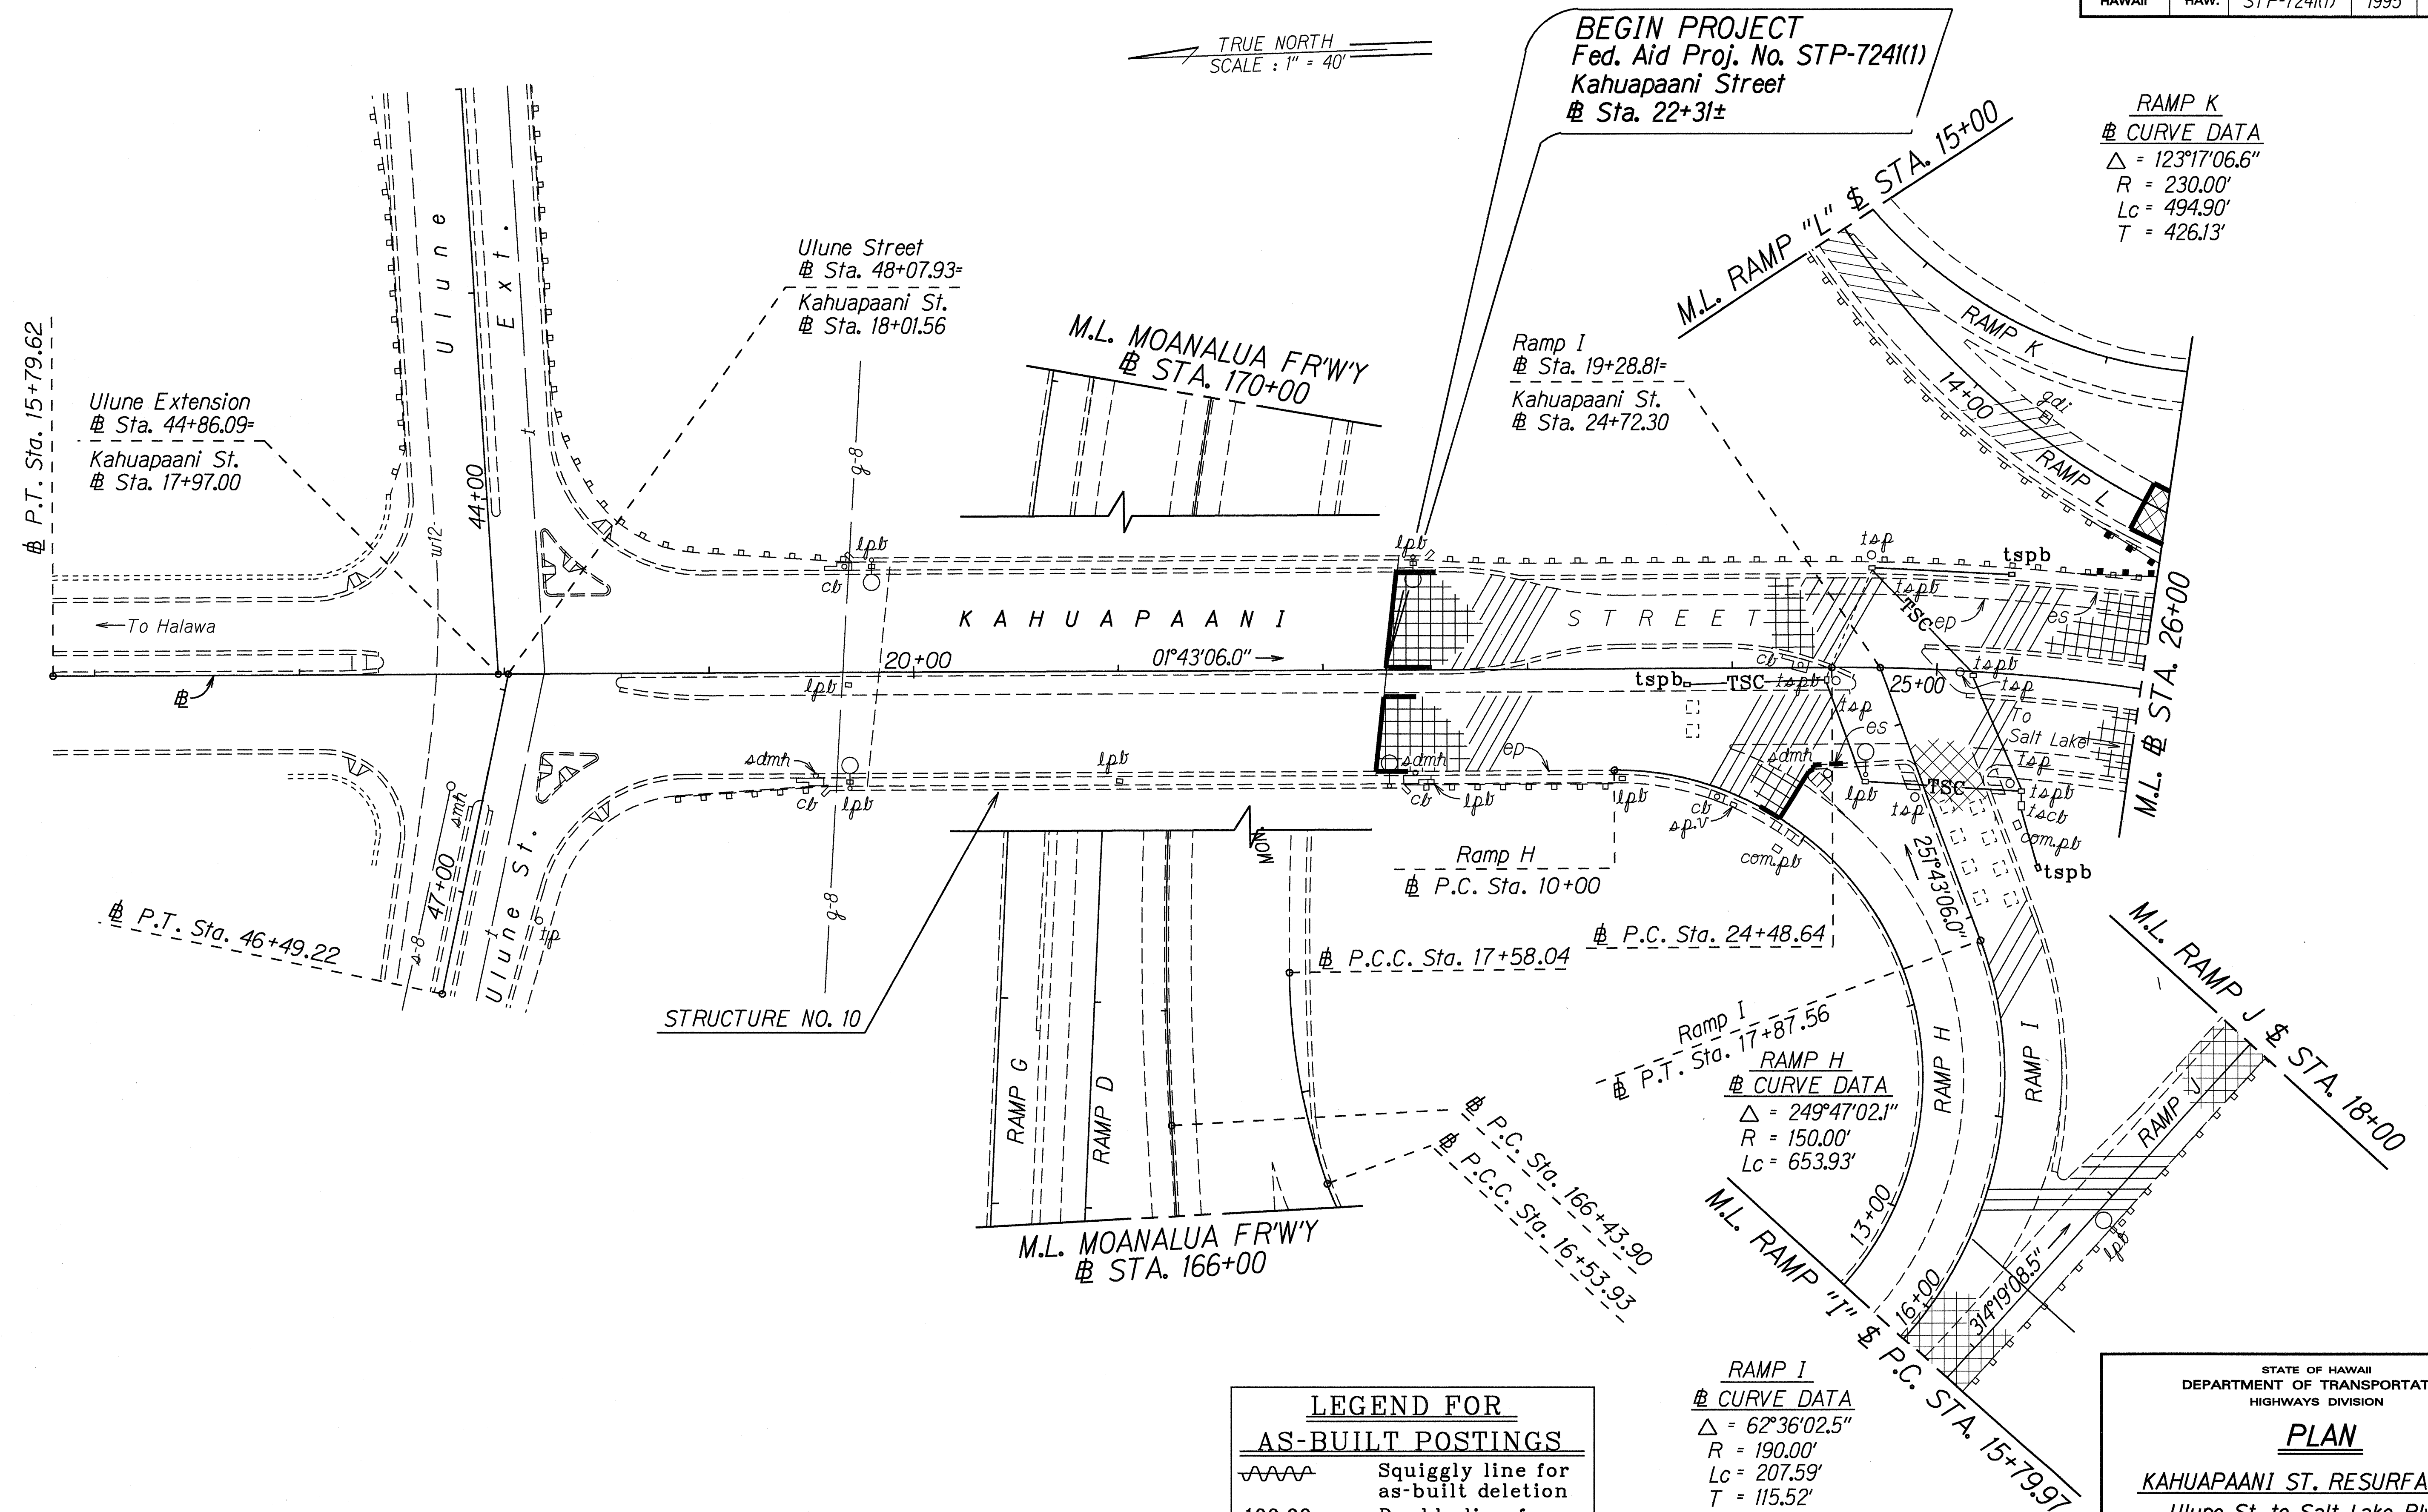

ORIGINAL PLAN	SURVEY PLOTTED BY _____	DATE _____
	DRAWN BY <i>M. Howells</i>	6-1-95
NOTE BOOK	TRACED BY _____	
<i>ddLmH</i>	DESIGNED BY <i>K. Ing</i>	
<i>ikahdpl</i>	QUANTITIES BY _____	
No. _____	CHECKED BY _____	

LEGEND FOR
AS-BUILT POSTINGS

	Squiggly line for as-built deletion
	Double line for as-built deletion
Roadway	Text for as-built posting

RAMP 1
CURVE DATA
 $\Delta = 62^{\circ}36'02.5''$
 $R = 190.00'$
 $L_c = 207.59'$
 $T = 115.52'$

STATE OF HAWAII
DEPARTMENT OF TRANSPORTATION
HIGHWAYS DIVISION


PLAN

KAHUAPAANI ST. RESURFACING
Ulune St. to Salt Lake Blvd.
Fed. Aid. Project No. STP-7241(1)

Scale: 1"=40' Date: May 1995

SHEET No. 1 OF 8 SHEETS

FED. ROAD DIST. NO.	STATE	FED. AID PROJ. NO.	FISCAL YEAR	SHEET NO.	TOTAL SHEETS
HAWAII	HAW.	STP-724(1)	1995	17	42

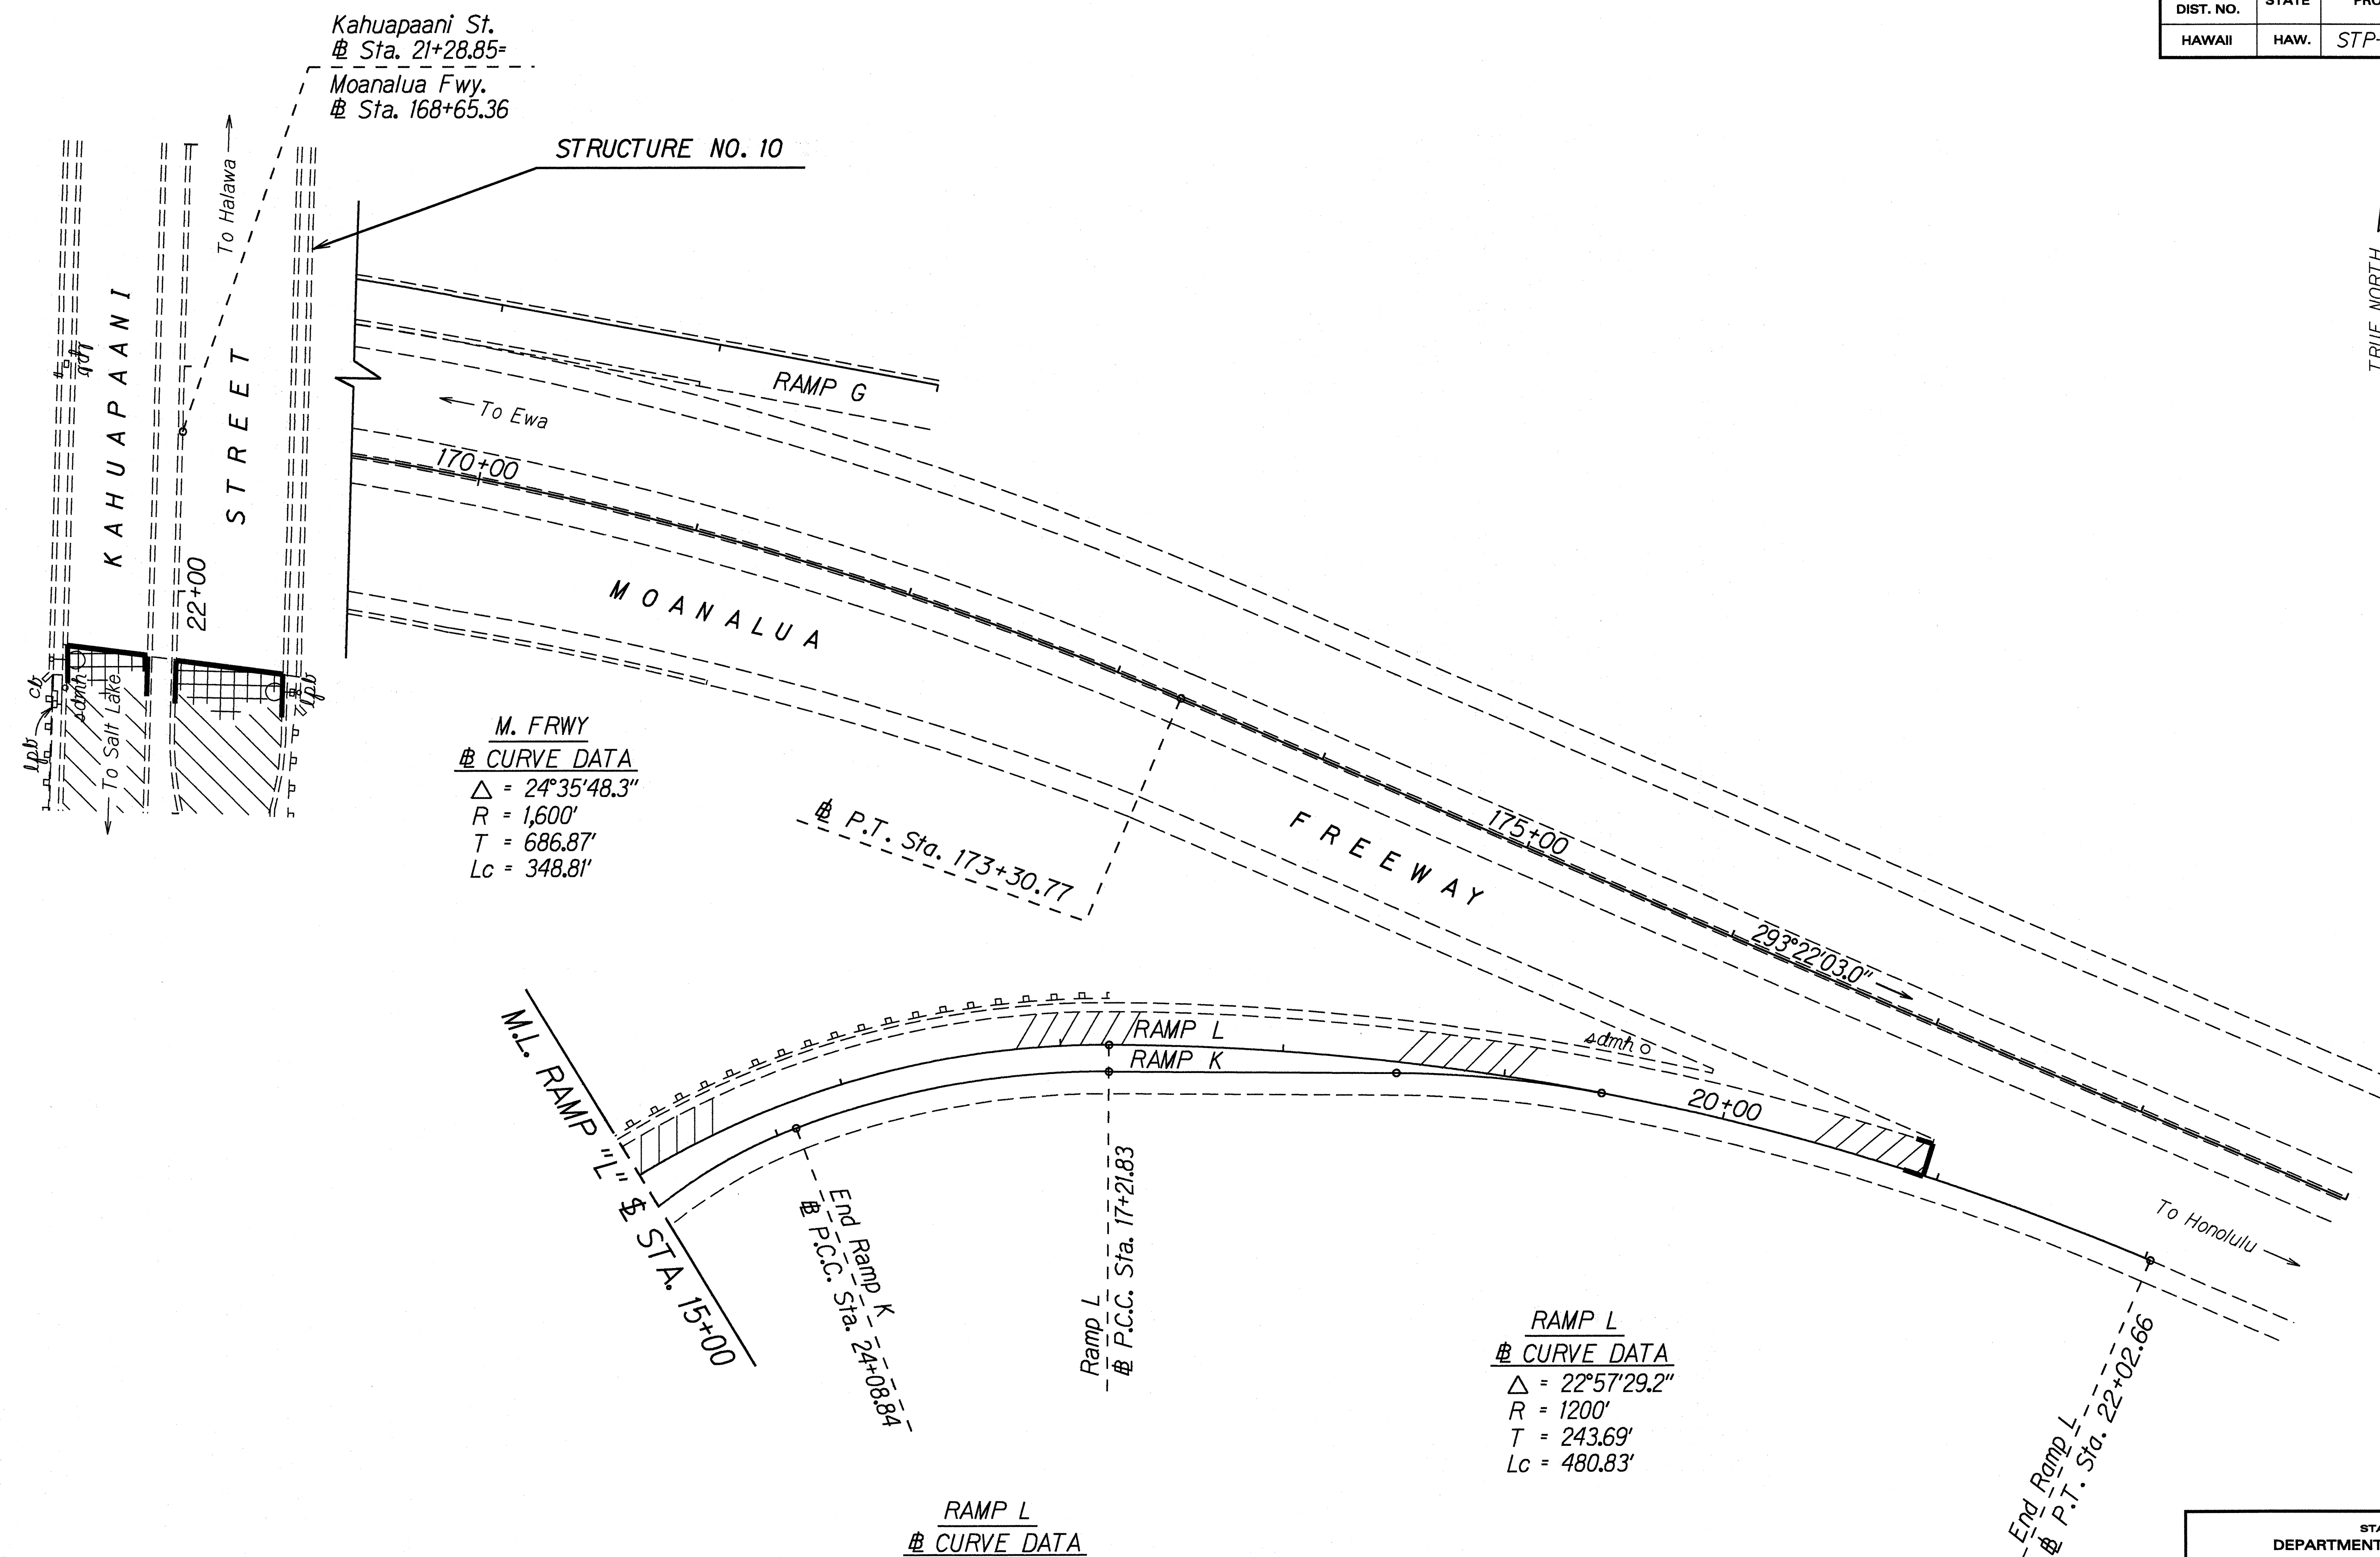

TRUE NORTH
SCALE: 1" = 40'

ORIGINAL PLAN	DATE
SURVEY PLOTTED BY	6-1-95
DRAWN BY	M. Hovells
DESIGNED BY	K. Iq
CHECKED BY	dd/mh
IN CHARGE	N. Keadoo

STATE OF HAWAII
DEPARTMENT OF TRANSPORTATION
HIGHWAYS DIVISION


PLAN

KAHUPAANI ST. RESURFACING
 Ulune St. to Salt Lake Blvd.
 Fed. Aid. Project No. STP-724(1)

Scale: 1"=40' Date: May 1995

SHEET No. 3 OF 8 SHEETS

FED. ROAD DIST. NO.	STATE	FED. AID PROJ. NO.	FISCAL YEAR	SHEET NO.	TOTAL SHEETS
HAWAII	HAW.	STP-724(1)	1995	18	42

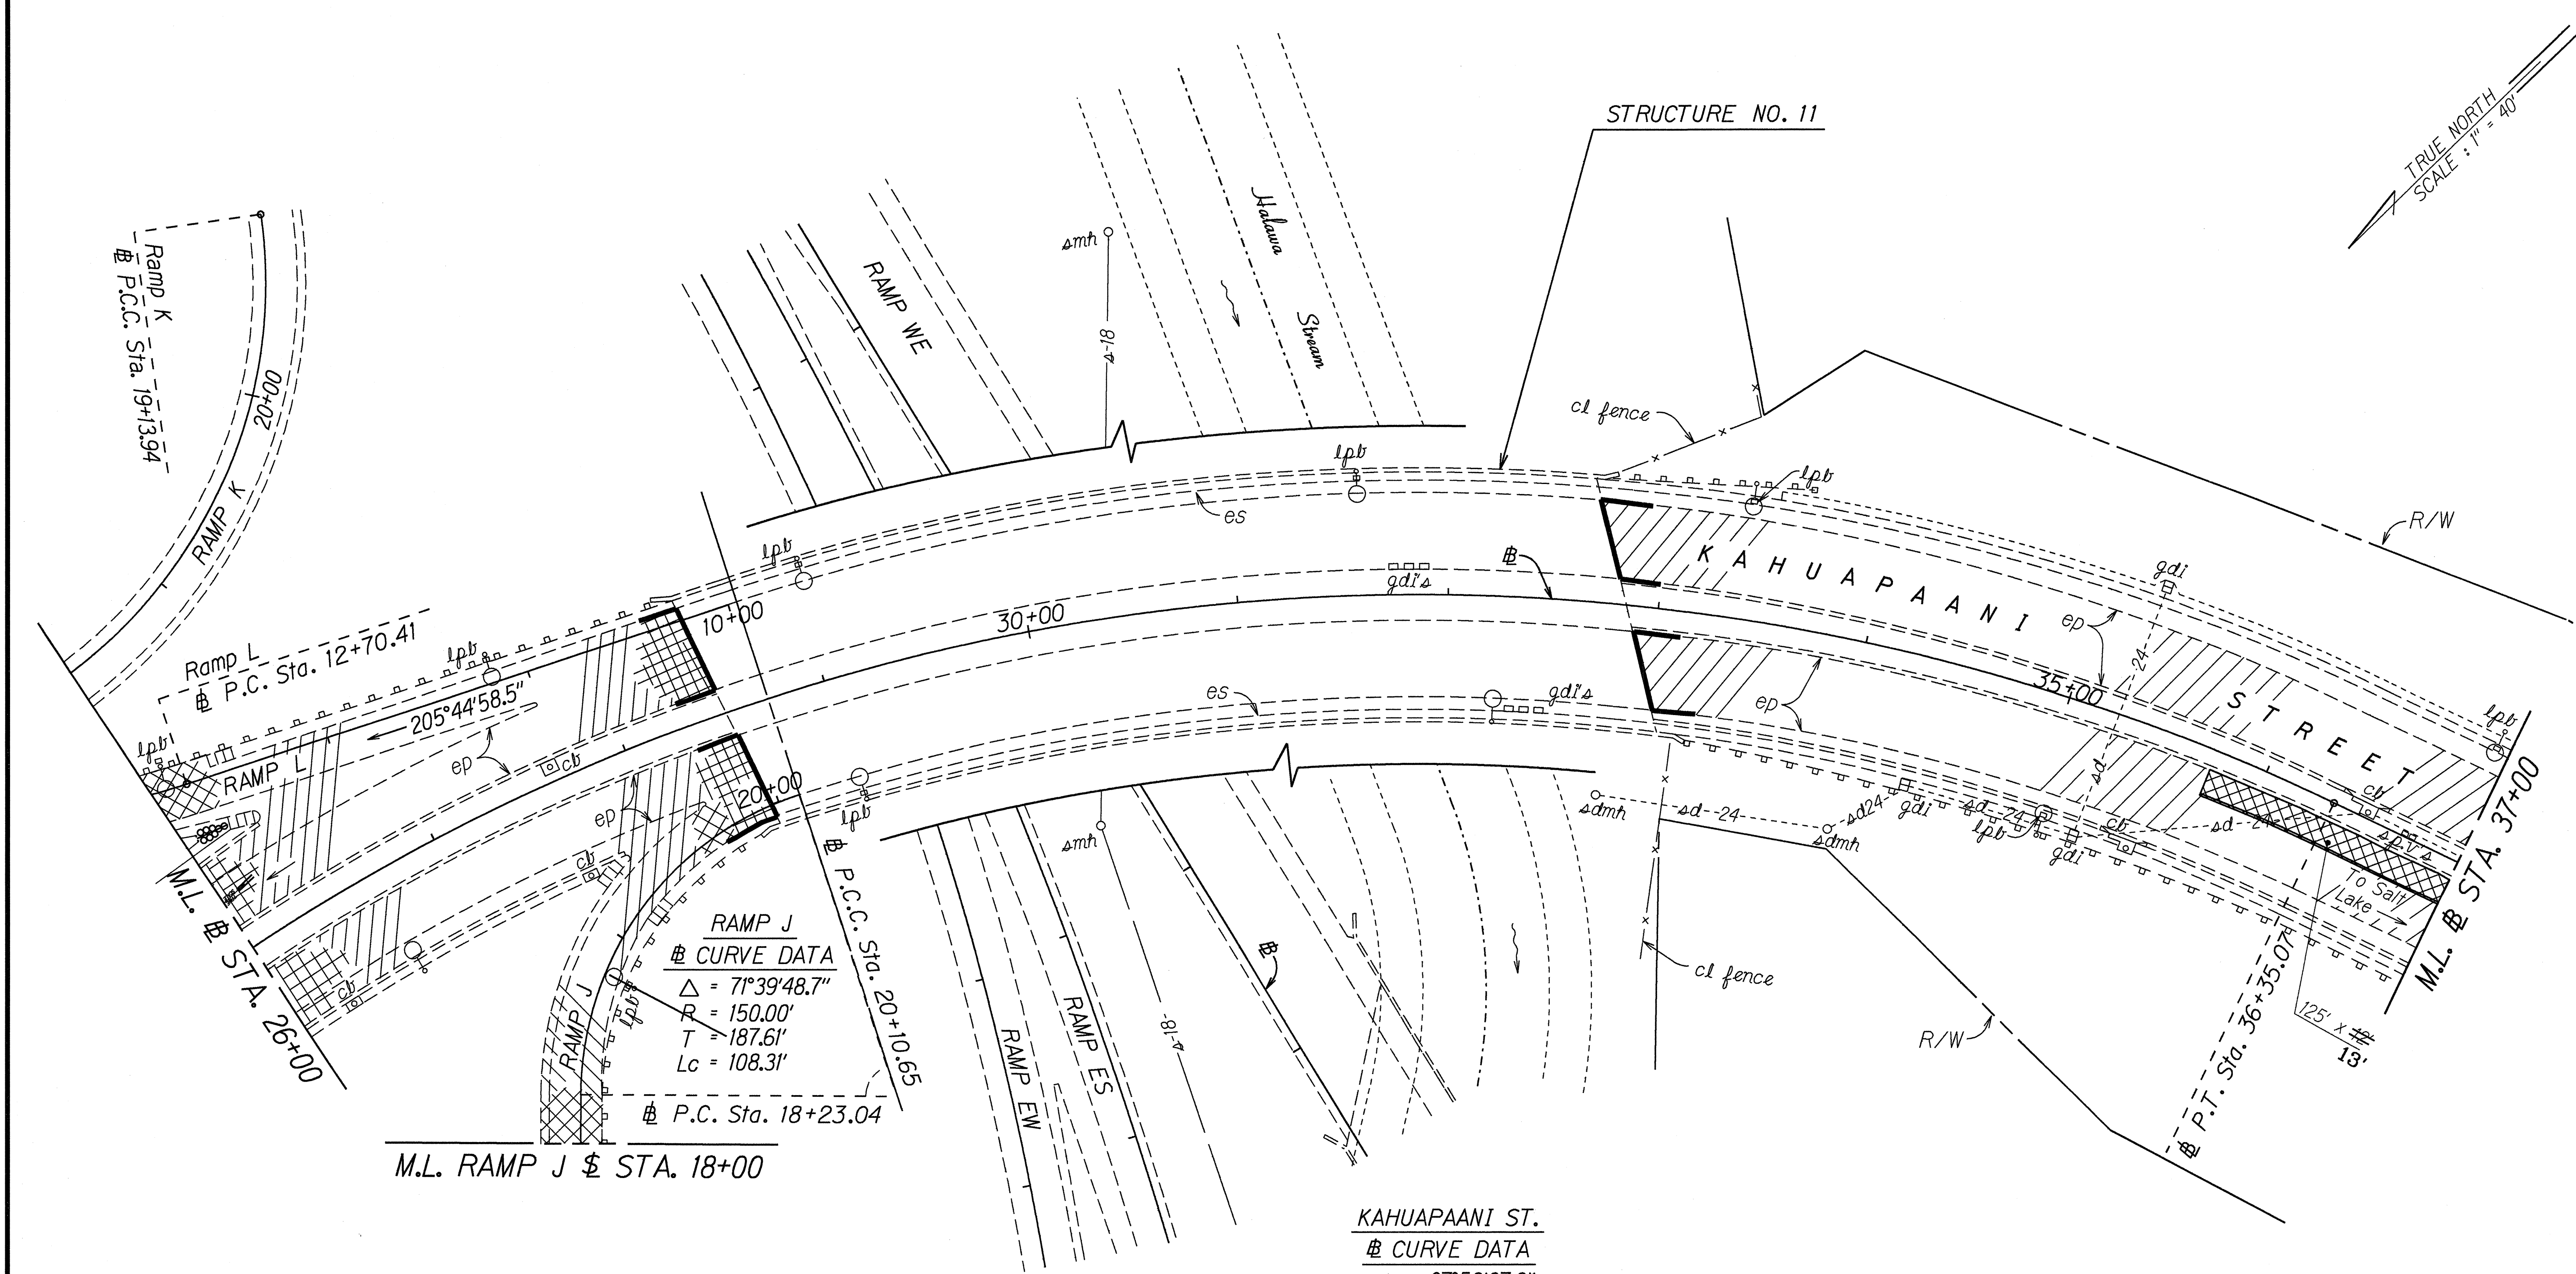

DATE	6/1/95
SURVEY PLANNED BY	
DRAWN BY	M. Howell
DESIGNED BY	J. Ma
NOTED BY	
QUANTITIES BY	
CHECKED BY	

LEGEND FOR AS-BUILT POSTINGS	
	Squiggly line for as-built deletion
	Double line for as-built deletion
Roadway	Text for as-built posting


STATE OF HAWAII
DEPARTMENT OF TRANSPORTATION
HIGHWAYS DIVISION

PLAN

KAHUAPAANI ST. RESURFACING
 Ulune St. to Salt Lake Blvd.
 Fed. Aid Project No. STP-724(1)

Scale: 1"=40' Date: May 1995

FED. ROAD DIST. NO.	STATE	FED. AID PROJ. NO.	FISCAL YEAR	SHEET NO.	TOTAL SHEETS
HAWAII	HAW.	STP-724(1)	1995	19	42

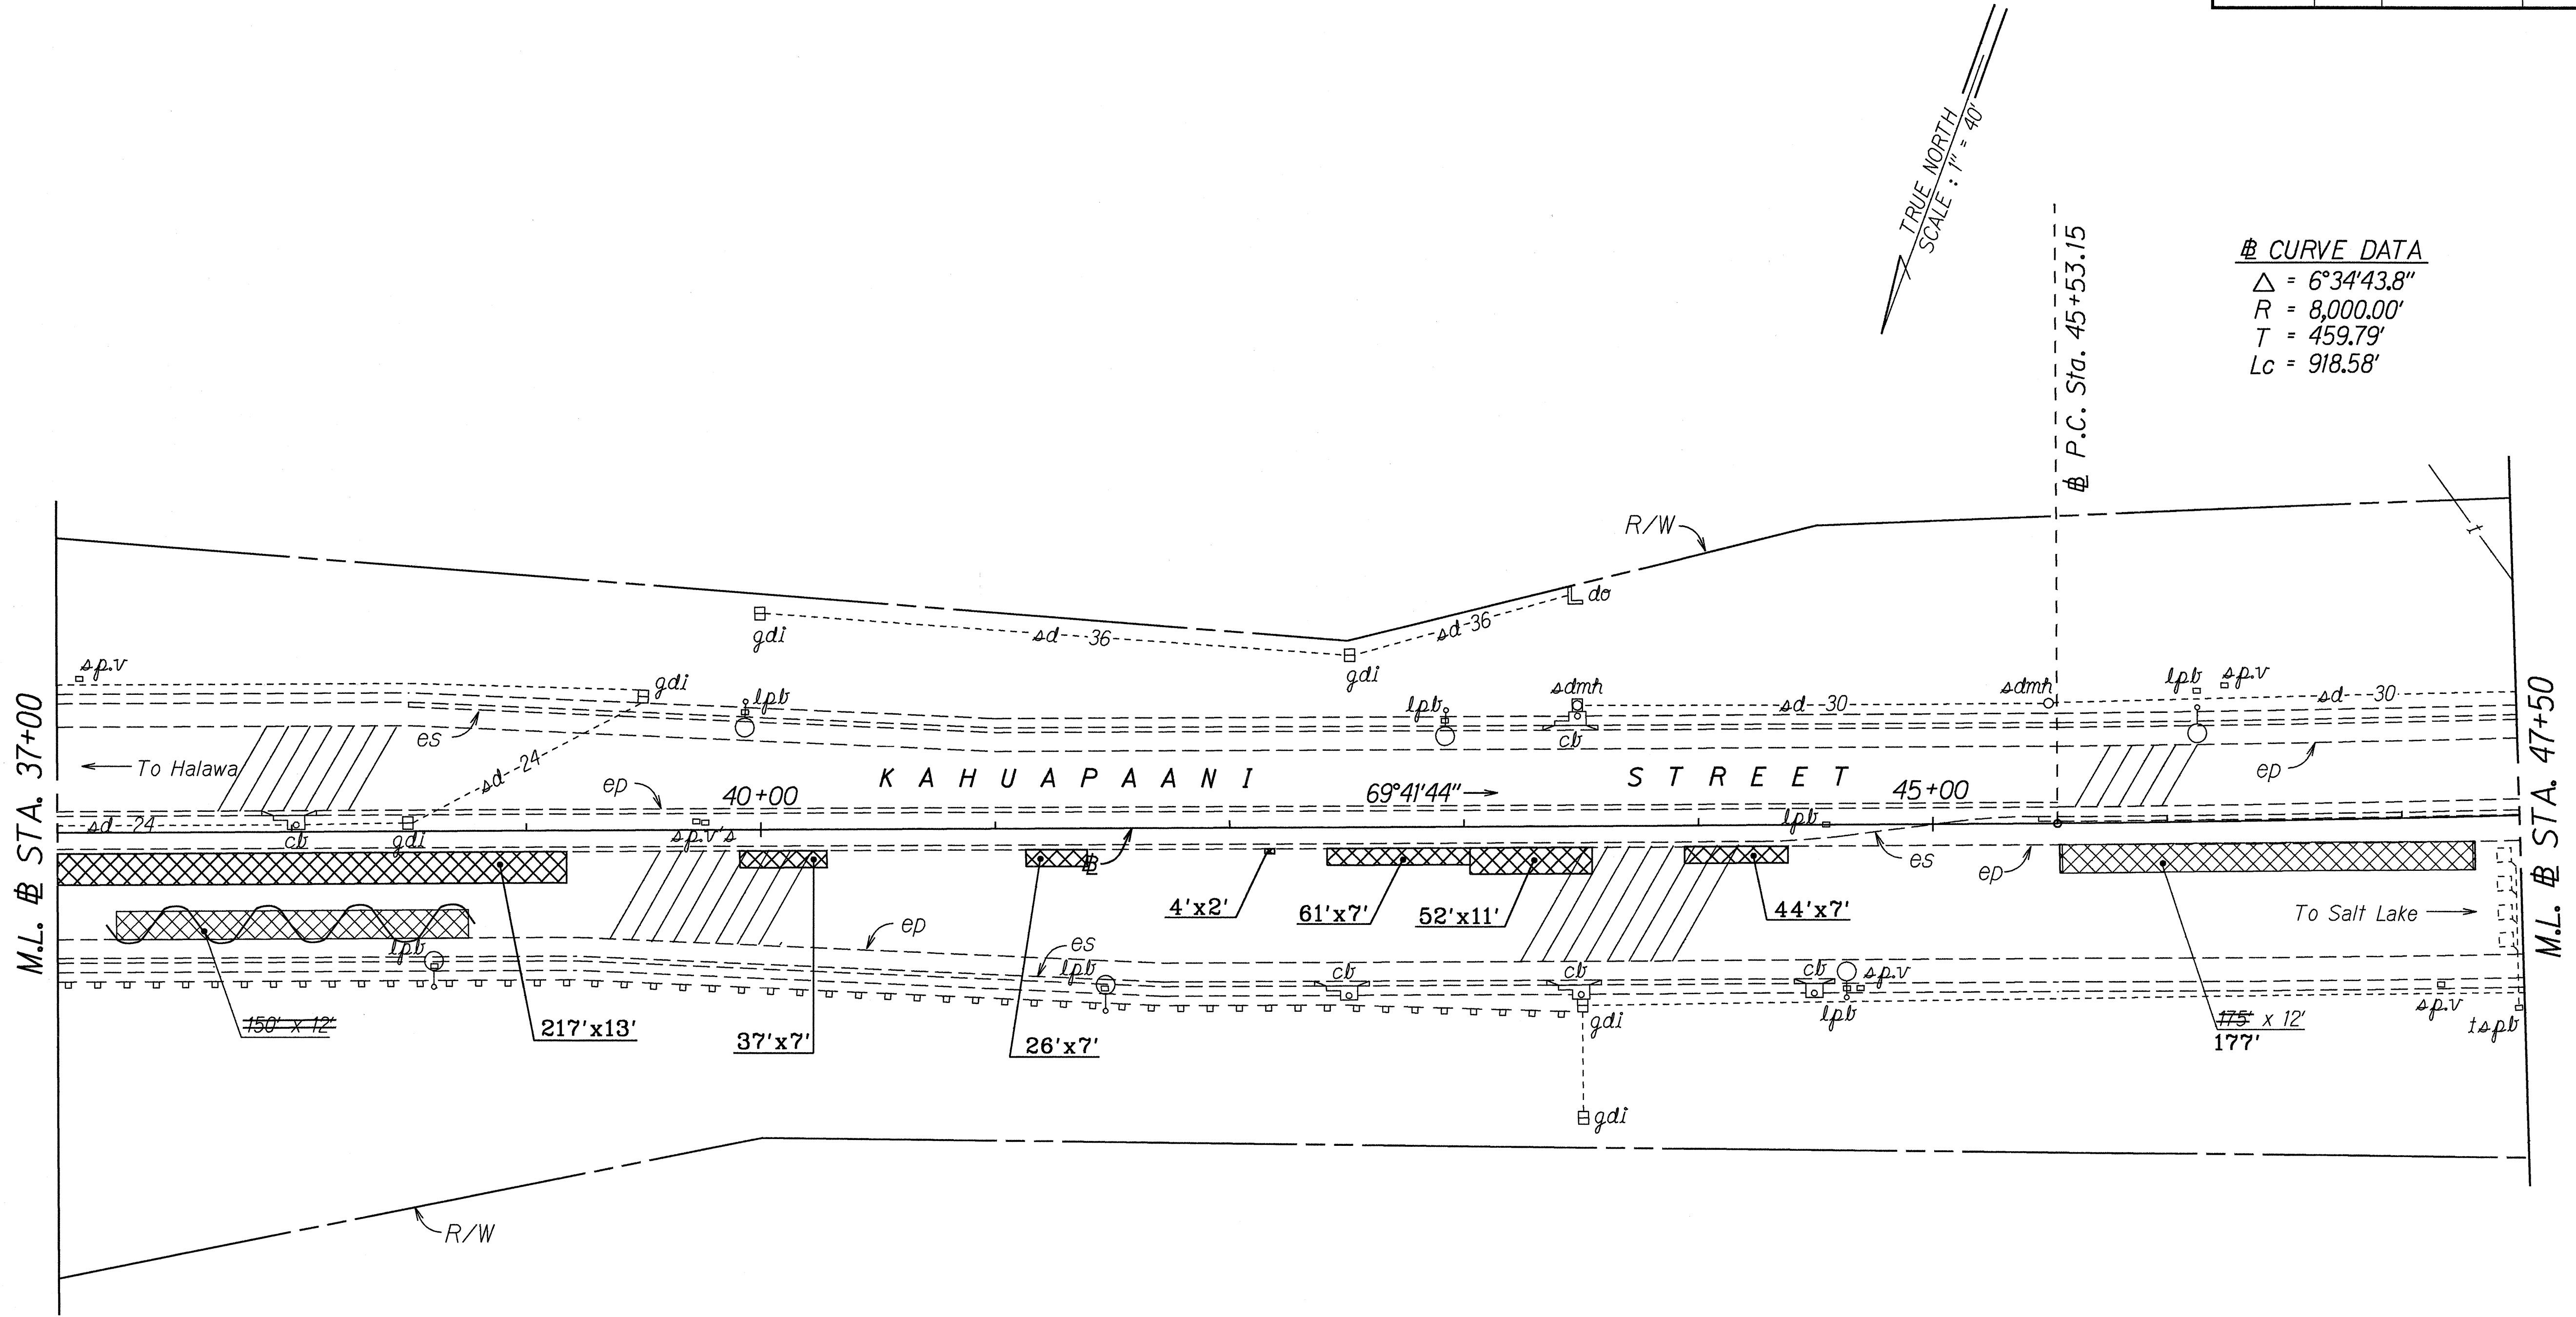

DESIGNED BY	DATE
TRACED BY	5-31-95
NOTES	
QUANTITIES BY	
CHECKED BY	

LEGEND FOR AS-BUILT POSTINGS	
	Squiggly line for as-built deletion
	Double line for as-built deletion
Roadway	Text for as-built posting


STATE OF HAWAII
DEPARTMENT OF TRANSPORTATION
HIGHWAYS DIVISION

PLAN
KAHUPAANI ST. RESURFACING
Ulune St. to Salt Lake Blvd.
Fed. Aid Project No. STP-724(1)
Scale: 1"=40' Date: May 1995

SHEET No. 5 OF 8 SHEETS

"AS-BUILT"

FED. ROAD DIST. NO.	STATE	FED. AID PROJ. NO.	FISCAL YEAR	SHEET NO.	TOTAL SHEETS
HAWAII	HAW.	STP-724(1)	1995	20	42

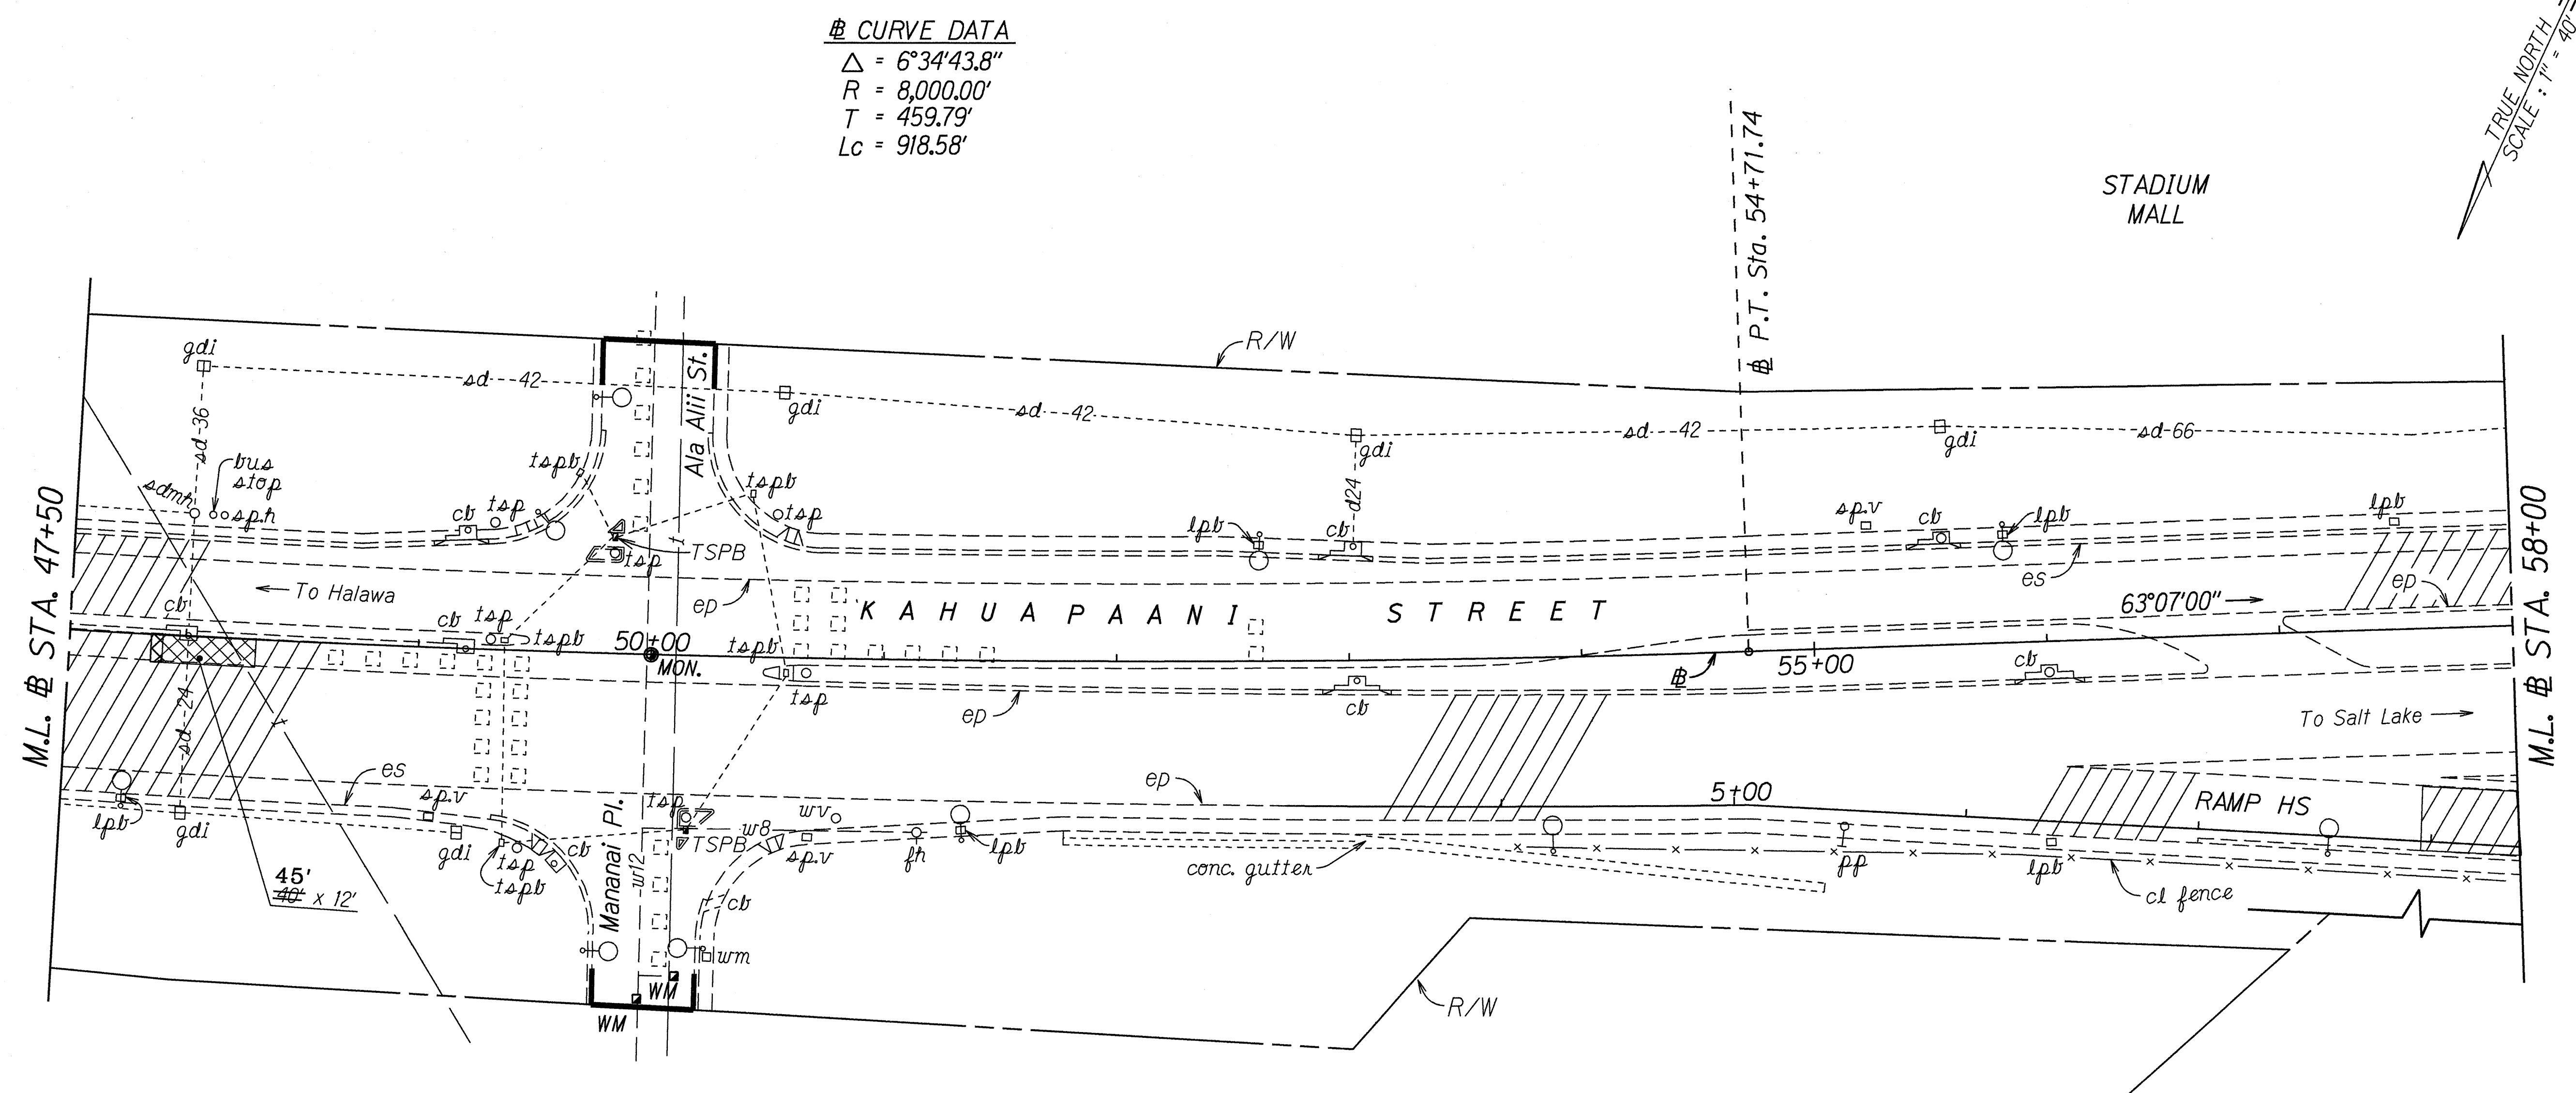

CURVE DATA
 $\Delta = 6^{\circ}34'43.8''$
 $R = 8,000.00'$
 $T = 459.79'$
 $Lc = 918.58'$

TRUE NORTH
SCALE: 1" = 40'

ORIGINAL PLAN	DATE
SURVEY PLOTTED BY	5-3-95
DRAWN BY M. Hovells	
TRACED BY K. K. Ng	
CHECKED BY N. Kehn	

CROSSPOINTE

LEGEND FOR AS-BUILT POSTINGS	
	Squiggly line for as-built deletion
	Double line for as-built deletion
Roadway	Text for as-built posting

STATE OF HAWAII
DEPARTMENT OF TRANSPORTATION
HIGHWAYS DIVISION

PLAN


KAHUPAANI ST. RESURFACING
Ulune St. to Salt Lake Blvd.
Fed. Aid Project No. STP-724(1)

Scale: 1"=40' Date: May 1995

SHEET No. 6 OF 8 SHEETS

"AS-BUILT"

FED. ROAD DIST. NO.	STATE	FED. AID PROJ. NO.	FISCAL YEAR	SHEET NO.	TOTAL SHEETS
HAWAII	HAW.	STP-724(1)	1995	21	42

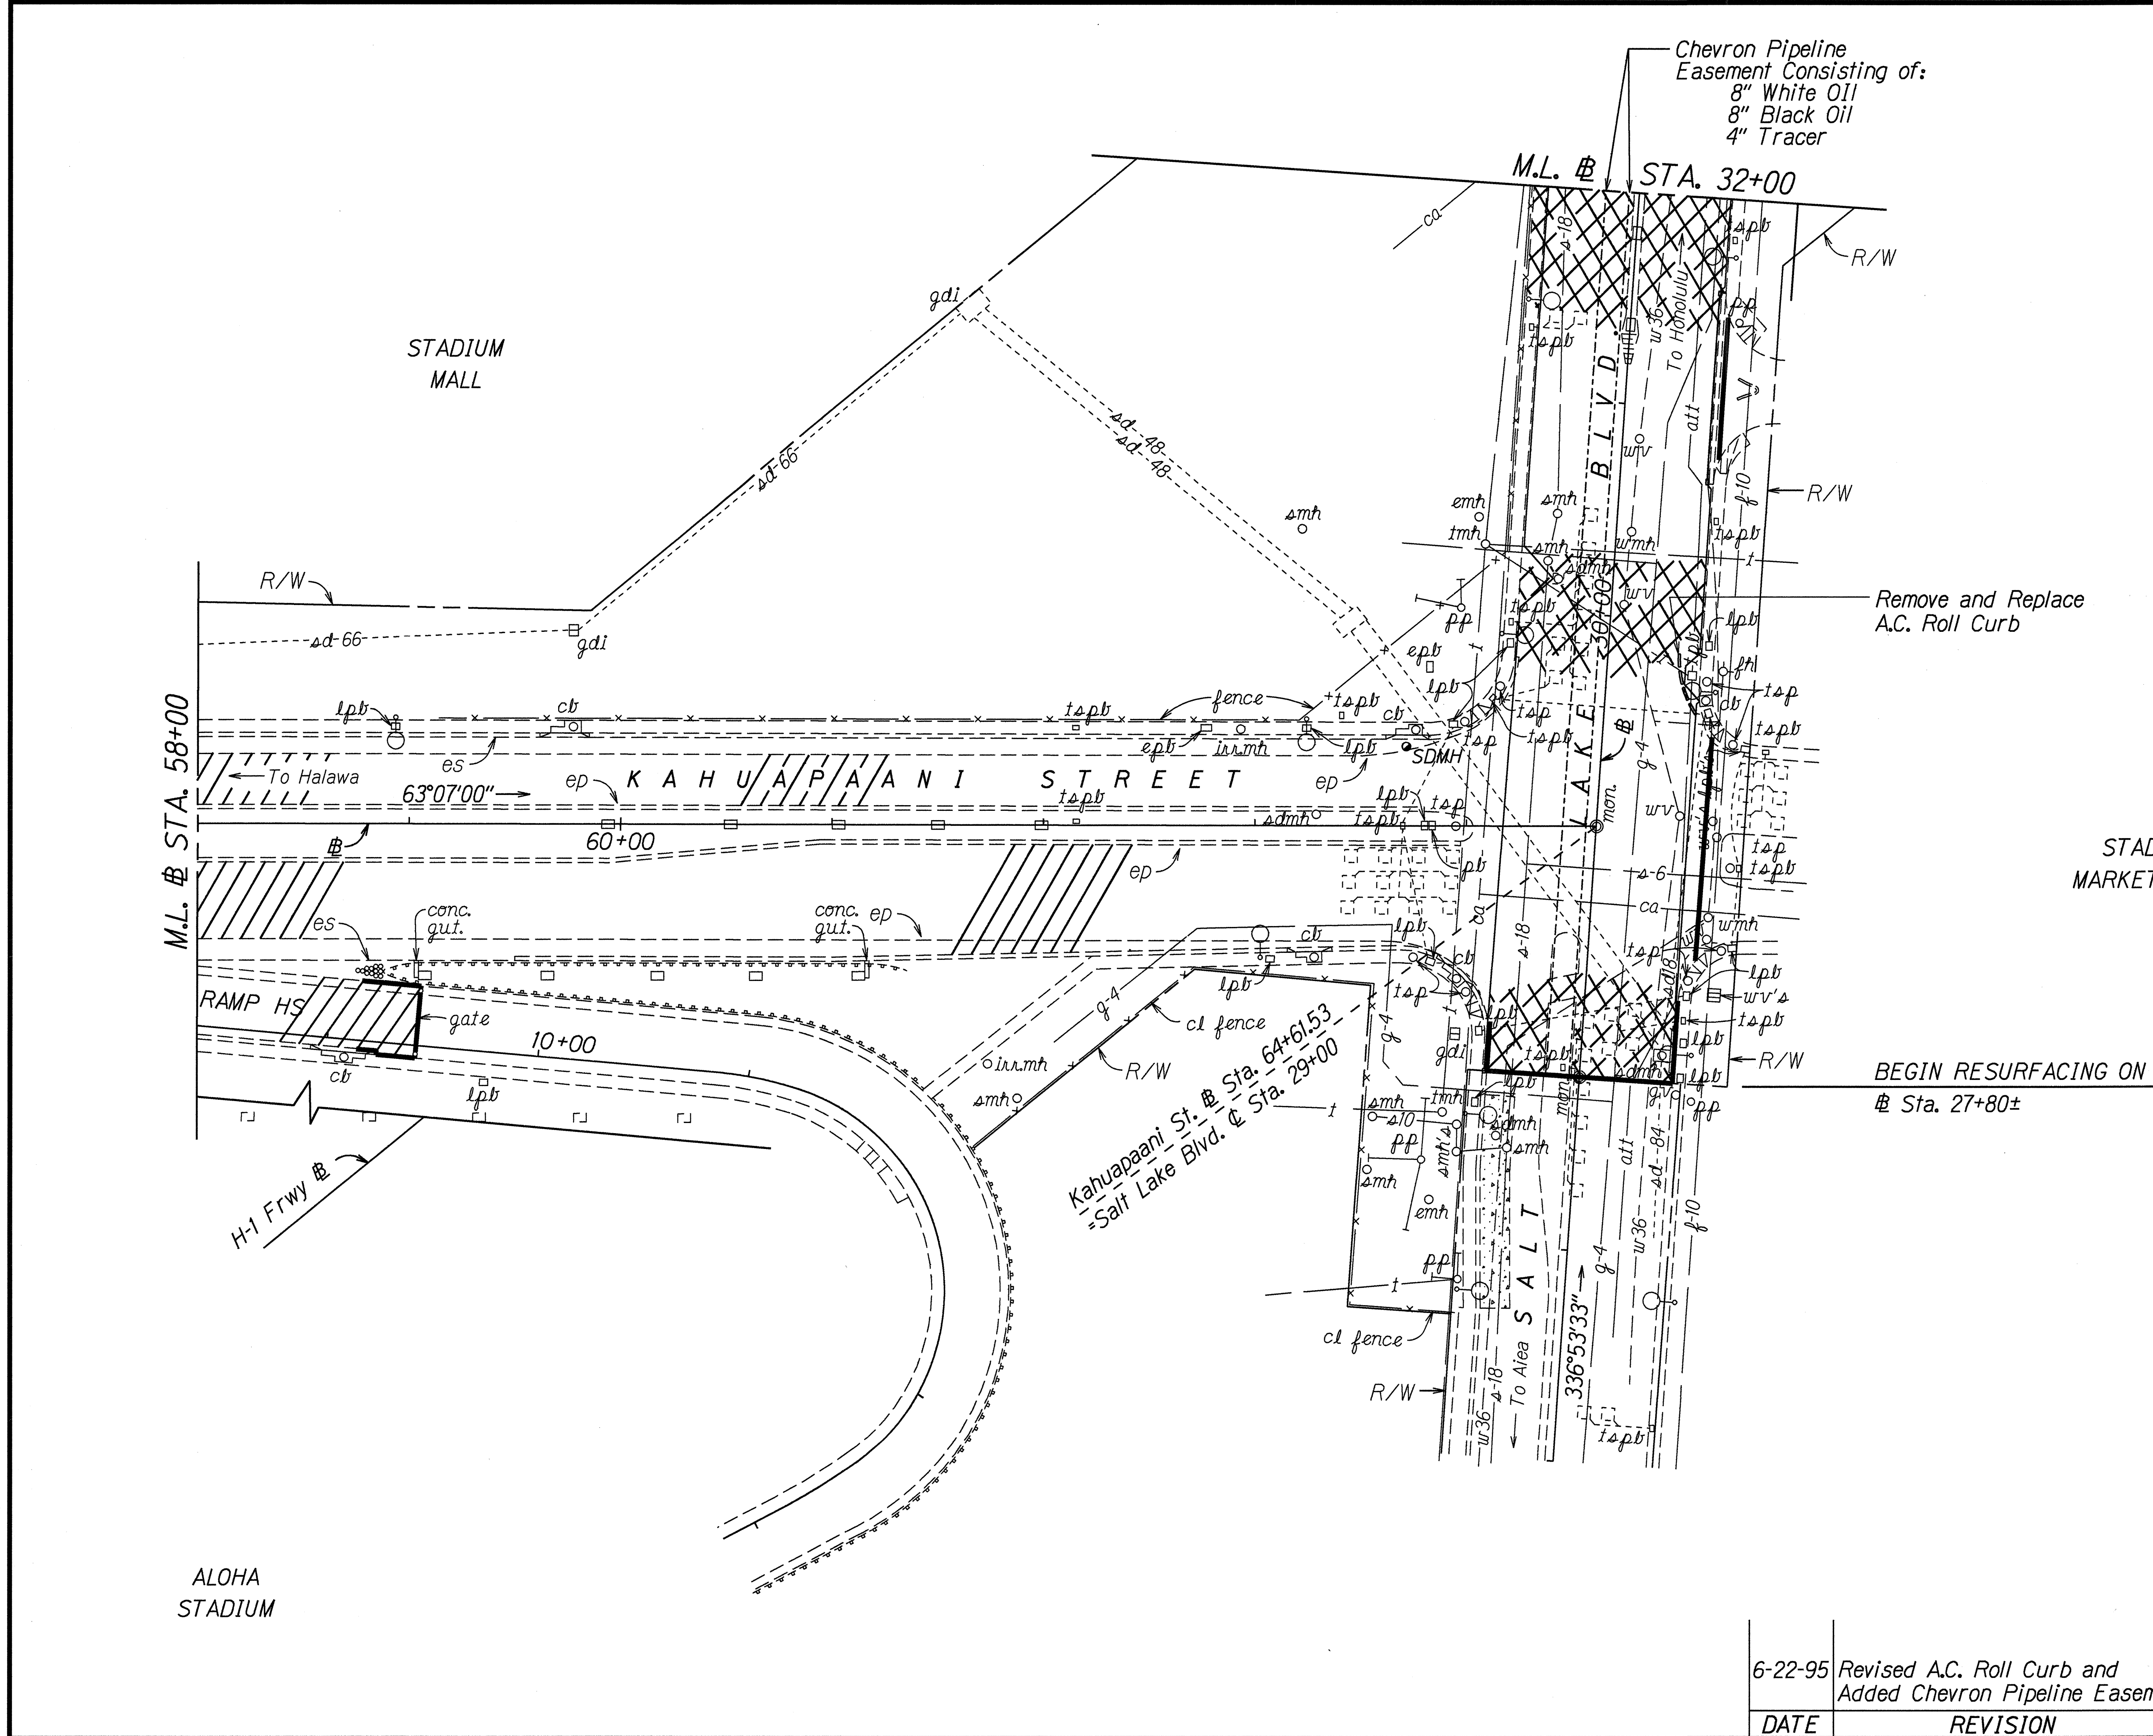

ORIGINAL PLAN	DATE
SURVEY PLOTTED BY	6-22-95
DRAWN BY	
NOTED BY	
CHECKED BY	
DATE	

6-22-95	Revised A.C. Roll Curb and Added Chevron Pipeline Easement	Scale: 1"=40'	Date: May 1995
DATE	REVISION	SHEET No. 7 OF 8 SHEETS	

STATE OF HAWAII
DEPARTMENT OF TRANSPORTATION
HIGHWAYS DIVISION

PLAN
KAHUPAANI ST. RESURFACING
Ulune St. to Salt Lake Blvd.
Fed. Aid Project No. STP-724(1)

