


INDEX TO DRAWINGS	
SHEET NO.	DESCRIPTION
1	TITLE SHEET
2	STANDARD PLAN SUMMARY
3	GENERAL NOTES AND LEGEND
4	NPDES GENERAL NOTES
5 - 13	TYPICAL SECTIONS
14	MISCELLANEOUS DETAILS
15 - 22	PLANS
23	DRAINAGE PLAN
24	DRAINAGE PROFILE
25 - 26	DRAINAGE DETAILS
27	PAVEMENT MARKING LEGEND, DETAILS & NOTES
28 - 35	PAVEMENT MARKING & SIGNING PLAN
36 - 37	SIGN DETAILS
38	DESTINATION SIGN DETAILS
39	DESTINATION SIGN FRAME LAYOUT
40	SWING SIGN BRACKET DETAIL
41	LOOP DETECTOR DETAILS
42	TRAFFIC SUMMARIES



STATE OF HAWAII
DEPARTMENT OF TRANSPORTATION
HIGHWAYS DIVISION
HONOLULU, HAWAII
"AS-BUILT"
PLANS FOR
KAHUAPAANI STREET RESURFACING
ULUNE STREET TO SALT LAKE BLVD.
FEDERAL AID PROJECT NO. STP-7241(1)
DISTRICT OF EWA
ISLAND OF OAHU

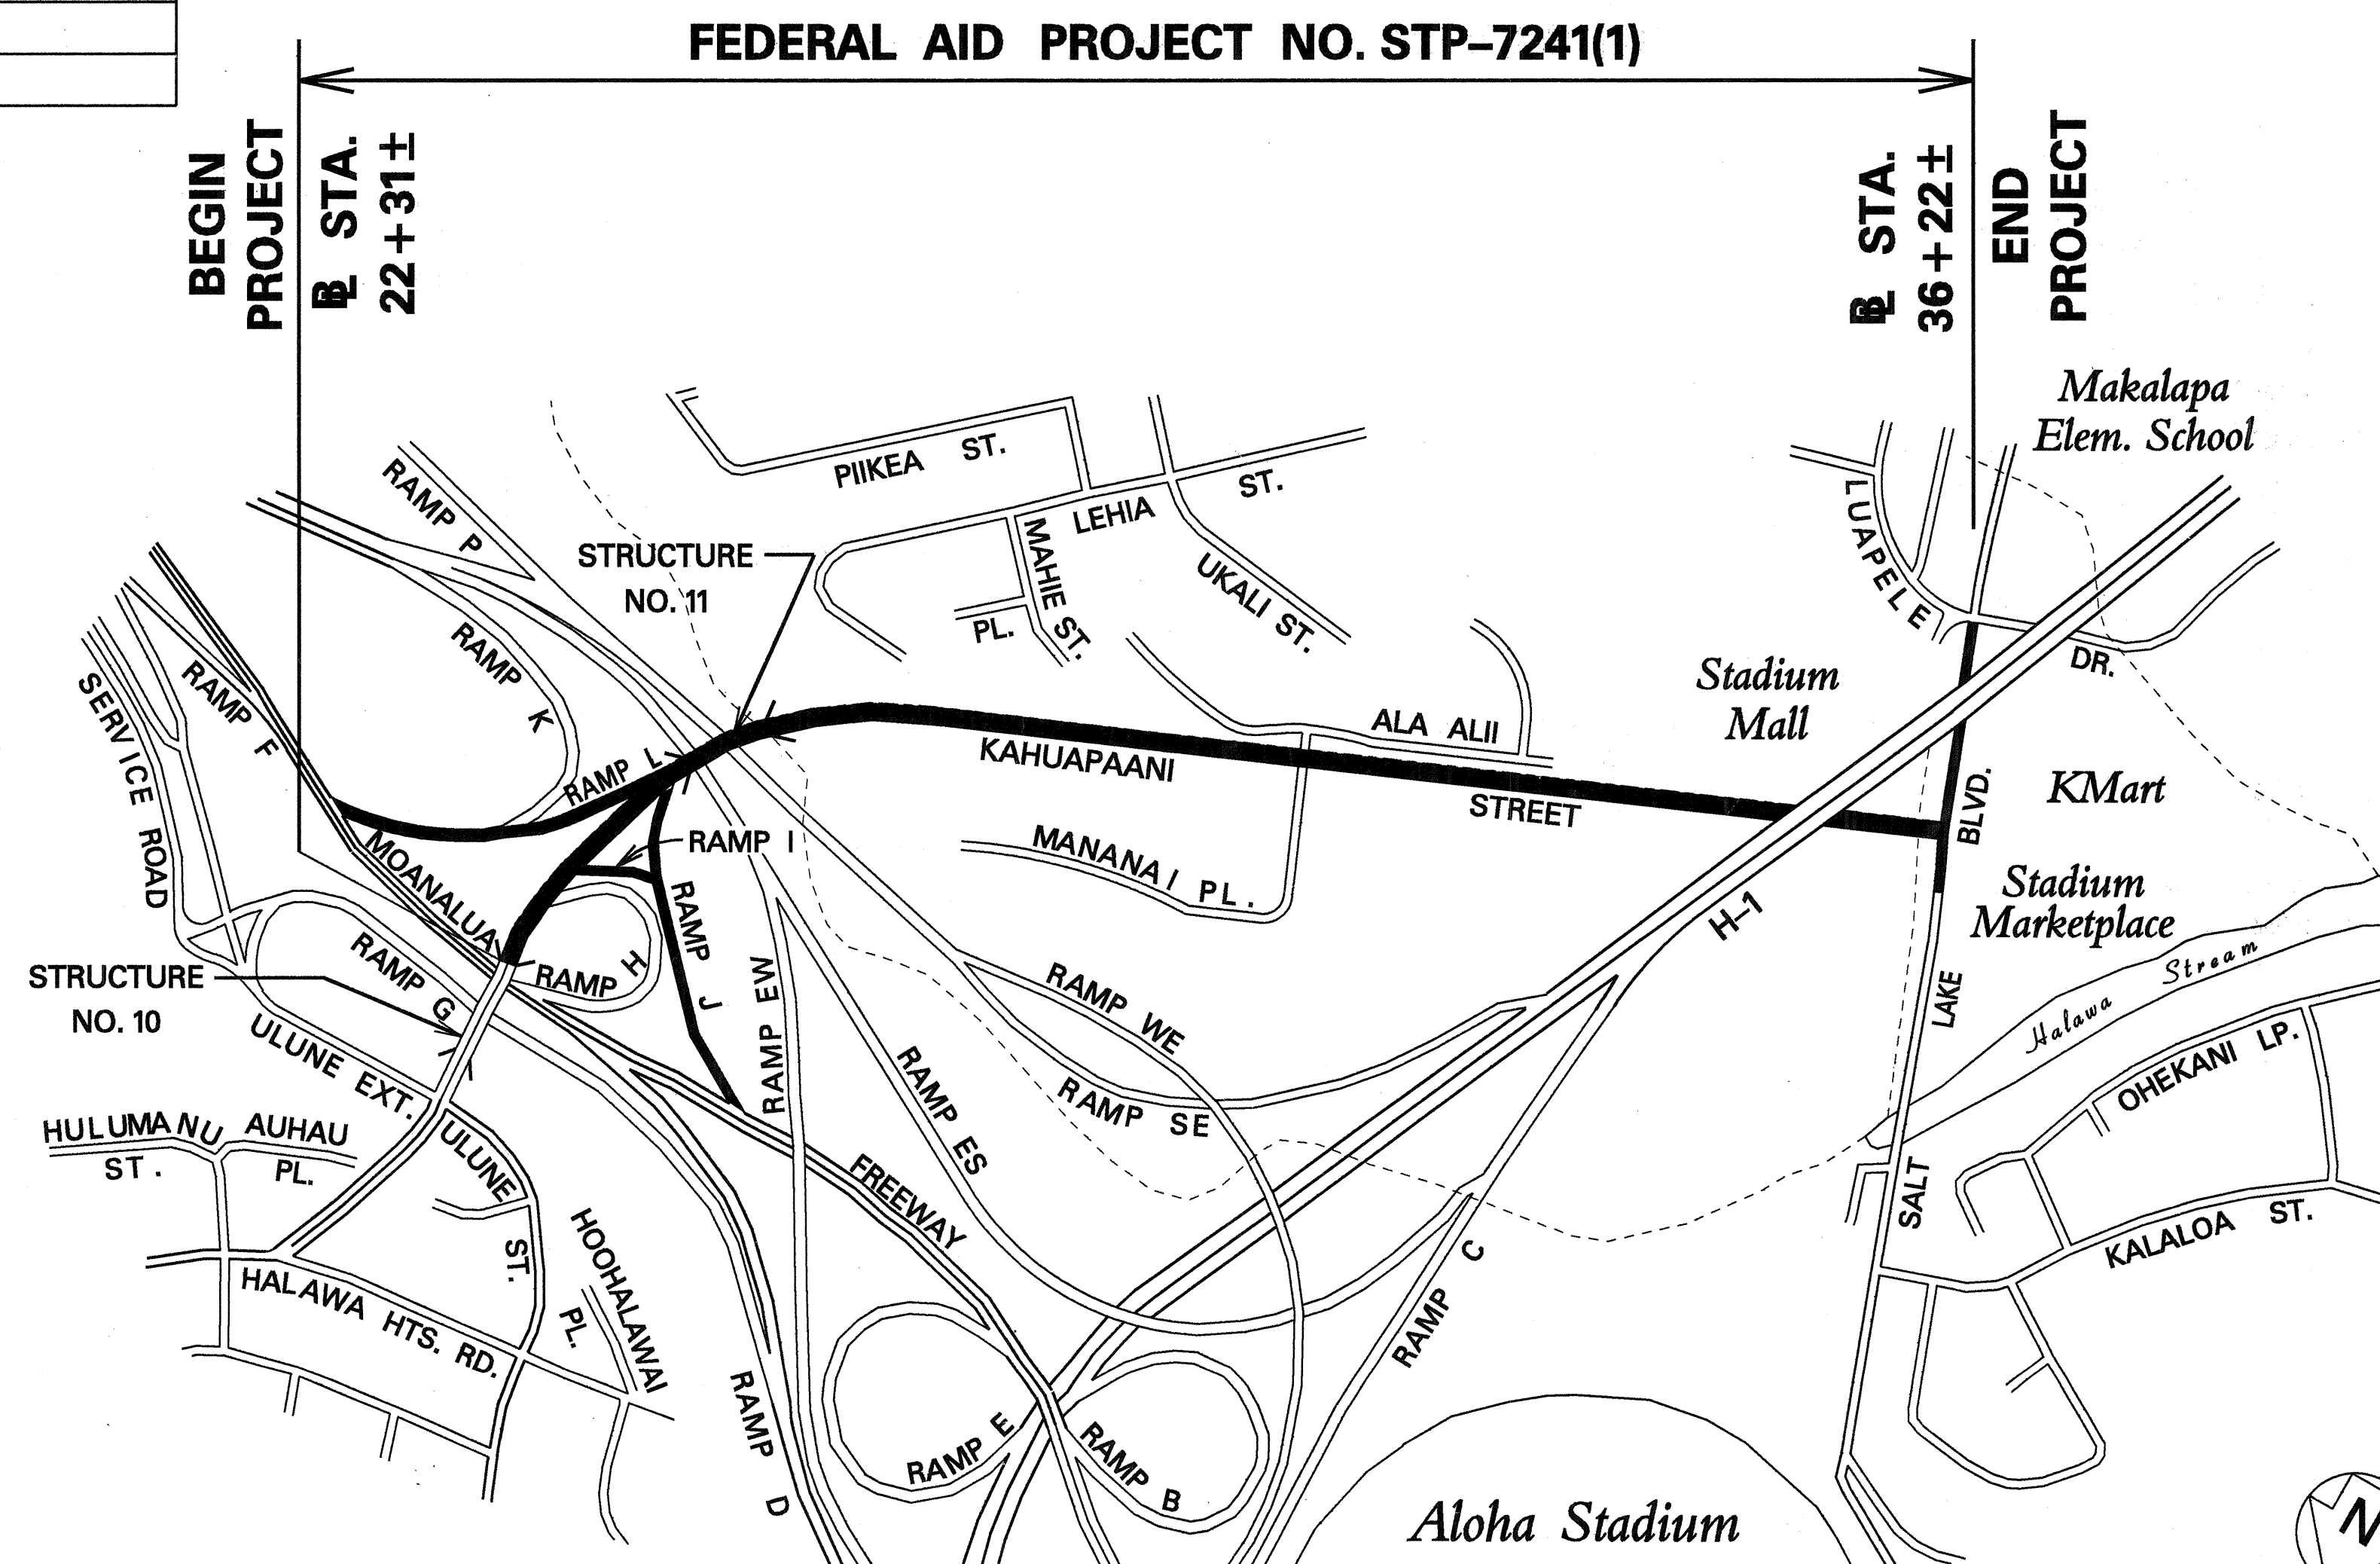

LAYOUT PLAN

LENGTH OF PROJECT.....0.86 MILES

FED. ROAD DIST. NO.	STATE	FED. AID PROJ. NO.	FISCAL YEAR	SHEET NO.	TOTAL SHEETS
HAWAII	HAW.	STP-7241(1)	1995	1	42

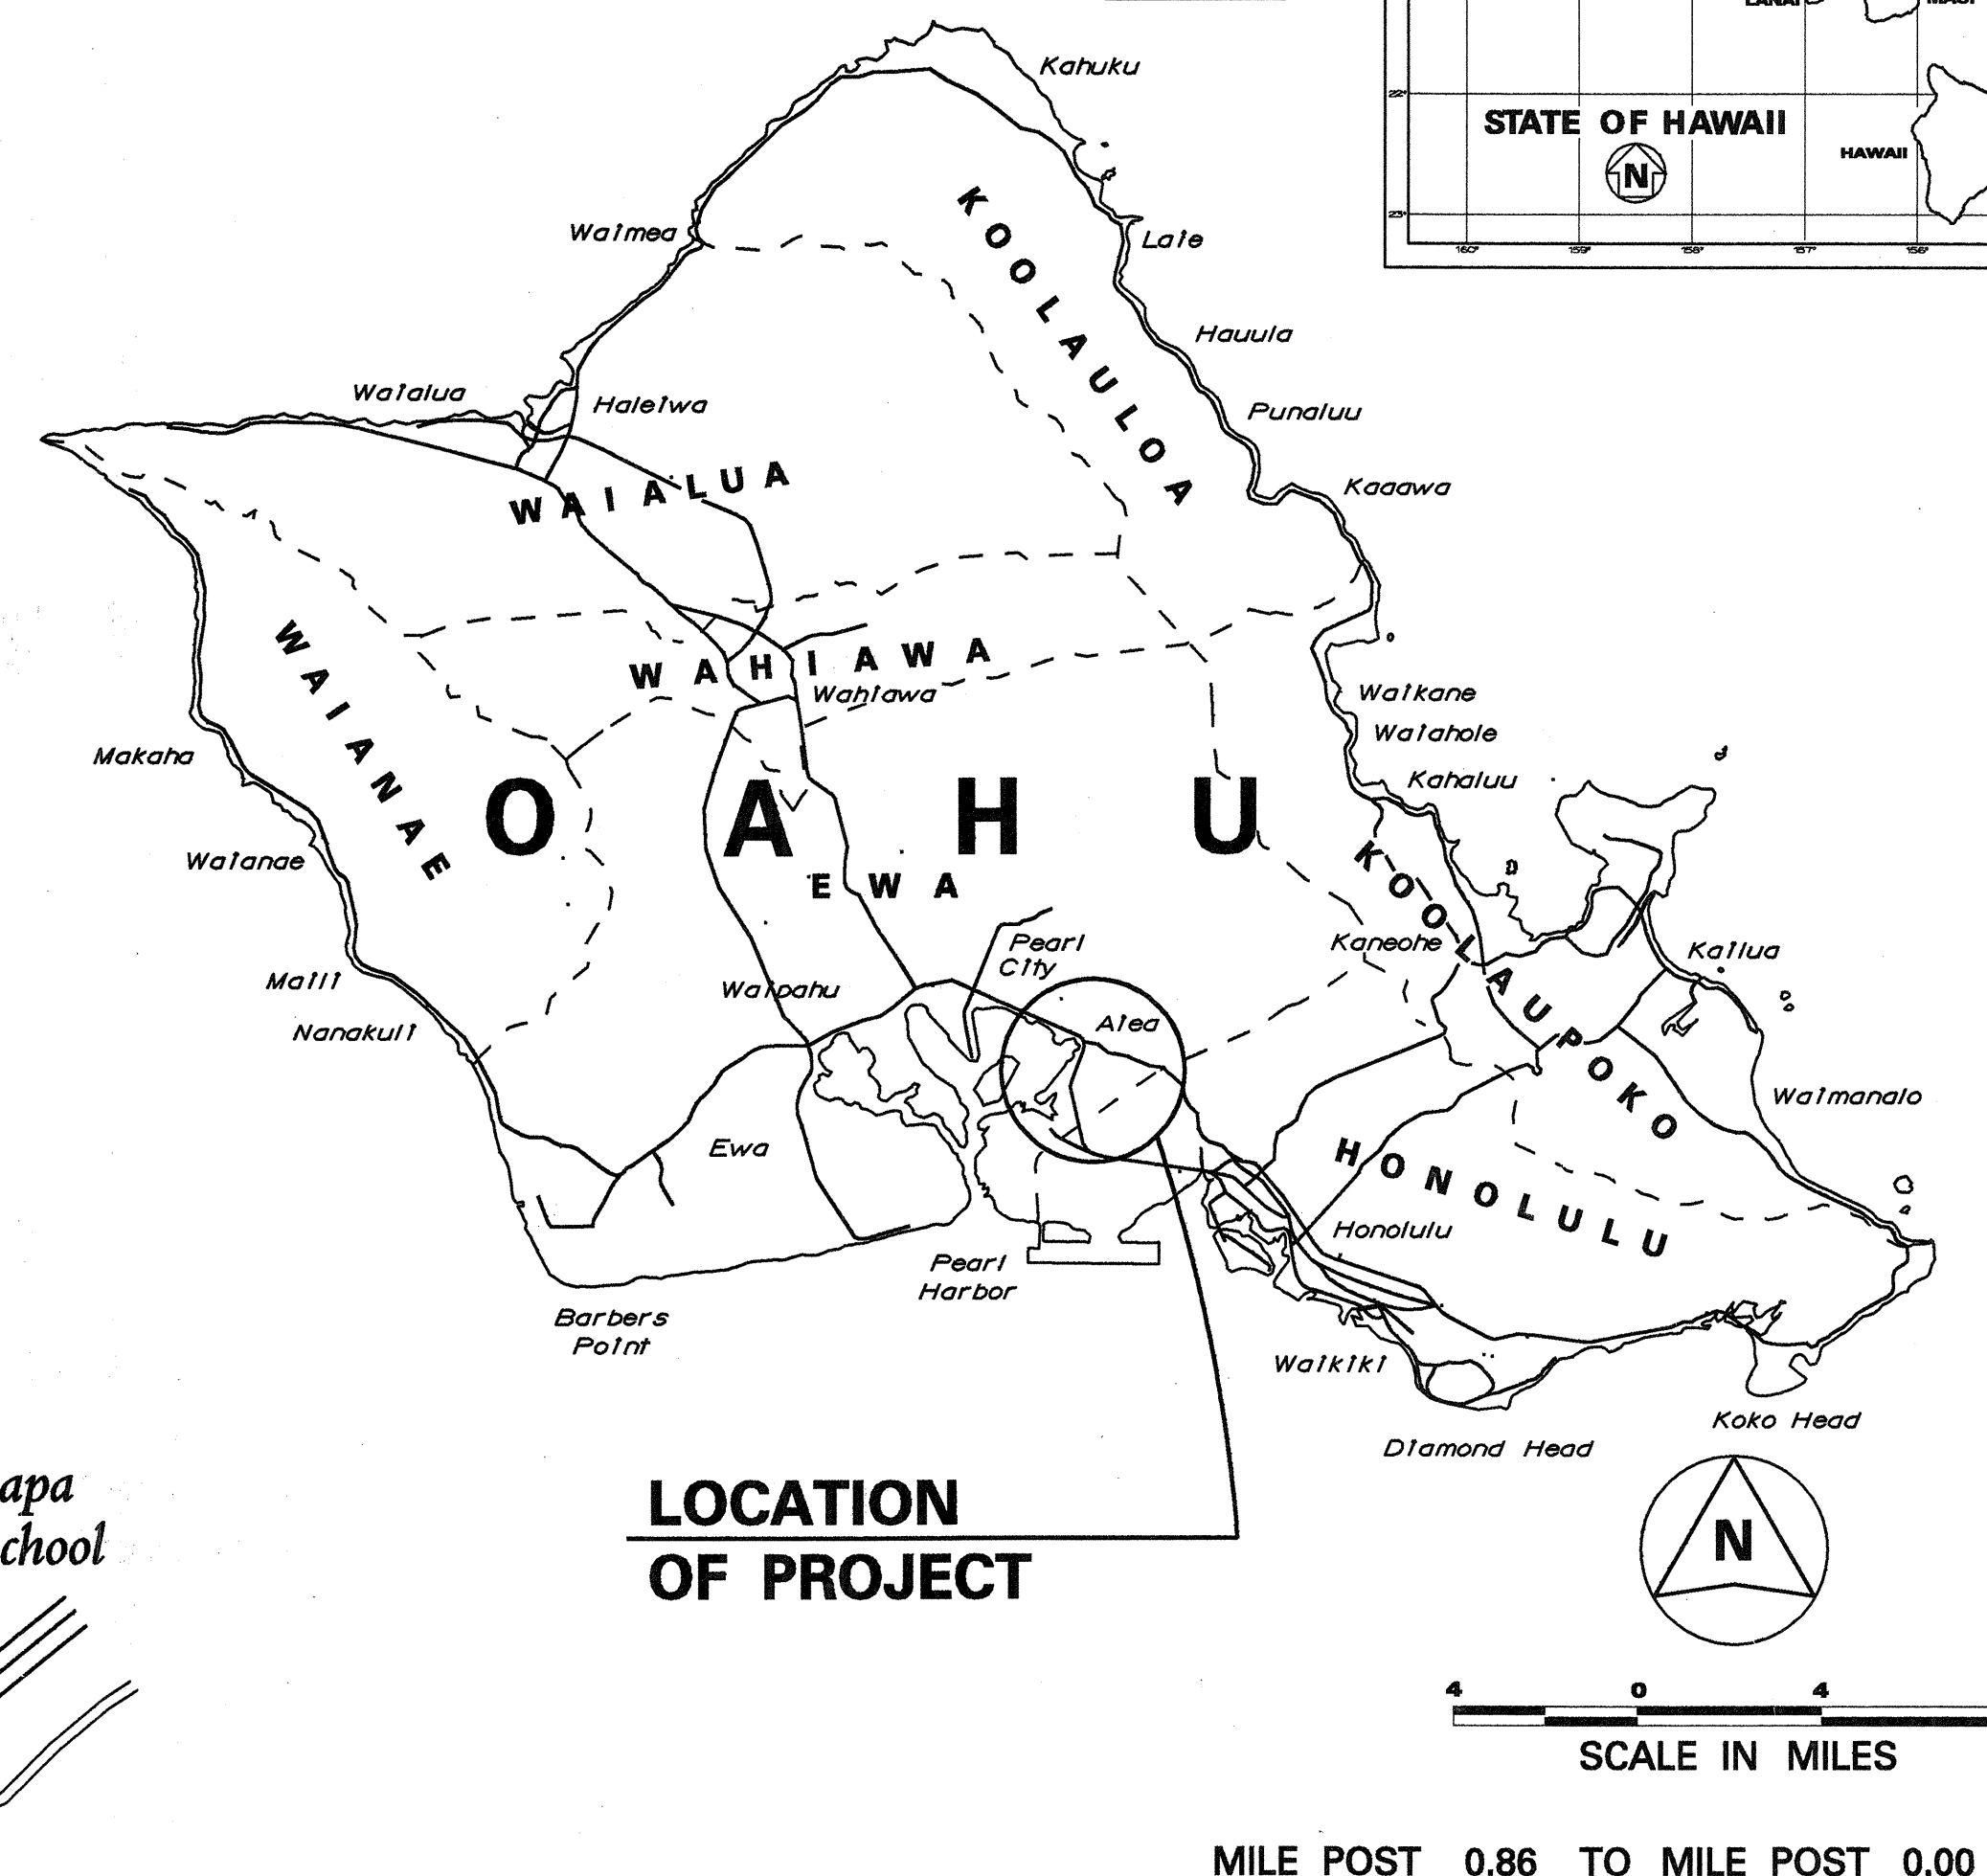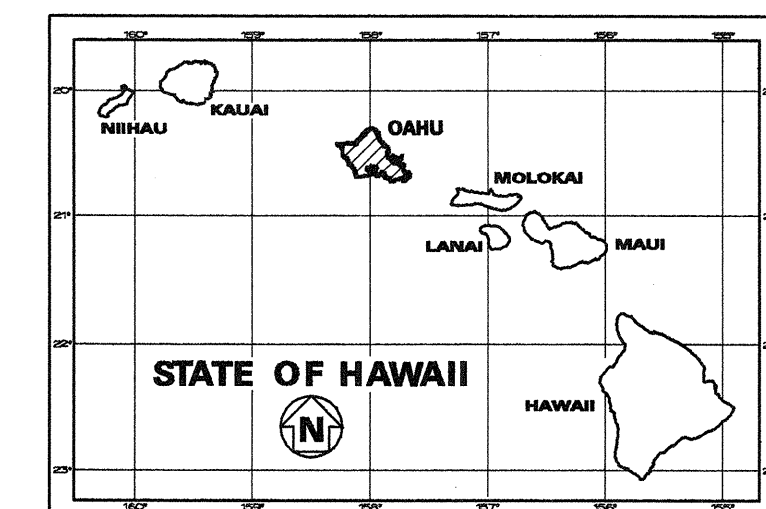

LOCATION OF PROJECT

MILE POST 0.86 TO MILE POST 0.00

DESIGN DESIGNATION

ADT (1995).....	31,800
ADT (2005).....	50,200
DHV	4,300
D	65/35
T24.....	5.0 %
V	45 M.P.H.

CHANGES MADE DURING CONSTRUCTION HAVE BEEN NOTED ON THESE PLANS AND CHECKED BY:

[Signature] 8/14/97
RESIDENT ENGINEER DATE

DEPARTMENT OF TRANSPORTATION STATE OF HAWAII	
APPROVED:	6/10/95
<i>[Signature]</i>	
DIR. OF TRANSPORTATION	DATE

UNIT D
DESIGNED BY
ALLAN NISHIMURA
P.S. & E. BY
587-2244
PHONE
MAY 1995
DATE

